

# INDEX OF SHEETS

SEE SHEET 2

## STATE OF TEXAS DEPARTMENT OF TRANSPORTATION

### PLANS OF PROPOSED ROUTINE MAINTENANCE CONTRACT

PROJECT NO.: RMC 6376-34-001

### US 69 JEFFERSON COUNTY

NET LENGTH OF ROADWAY = 000.00 FT. = 0.000 MI.  
NET LENGTH OF BRIDGE = 1660.00 FT. = 0.314 MI.  
NET LENGTH OF PROJECT = 1660.00 FT. = 0.314 MI.

LIMITS: FROM: US69-IH10 ENTRANCE RAMP  
TO: (NBI 20-124-0-0028-13-221)

FOR THE CONSTRUCTION OF MISCELLANEOUS WORK,  
CONSISTING OF BEARING PADS REPLACEMENT AND CONCRETE REPAIR.

FHWA TEXAS DIVISION	MAINTENANCE PROJECT		SHEET NO.
	RMC 6376-34-001		1
STATE	DISTRICT	COUNTY	
TEXAS	BMT	JEFFERSON	
CONTROL	SECTION	JOB	HIGHWAY NO.
6376	34	001	US 69

MGR. NO. 050  
MAINT. SECT. - 02

DESIGN SPEED = N/A  
A.D.T. (2018) = 109,046  
A.D.T. (2038) = 151,680

FINAL PLANS

LETTING DATE: \_\_\_\_\_

DATE CONTRACTOR BEGAN WORK: \_\_\_\_\_

DATE WORK WAS COMPLETED & ACCEPTED: \_\_\_\_\_


FINAL CONTRACT COST: \$ \_\_\_\_\_

CONTRACTOR : \_\_\_\_\_

BEGIN PROJECT  
RMC 6375-34-001  
STA 235+00  
RM 522+0.930



END PROJECT  
RMC 6375-34-001  
STA 251+60  
RM 552+1.244

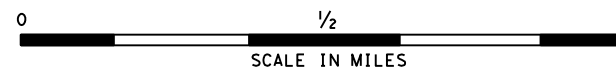

EXCEPTIONS: NONE  
EQUATIONS: NONE  
RAILROAD CROSSINGS: NONE

REQUIRED SIGNS SHALL BE IN ACCORDANCE WITH  
BC (1)-14 THRU BC (12)-14 AND THE "TEXAS MANUAL  
ON UNIFORM TRAFFIC CONTROL DEVICES".



SUBMITTED FOR LETTING: 2/26/2021

DocuSigned by:  
*Andrew C. Lee*  
PROJECT ENGINEER

RECOMMENDED FOR LETTING: 2/26/2021

DocuSigned by:  
*Mark N. Goff, P.E.*  
DIRECTOR OF OPERATIONS

APPROVED FOR LETTING: 2/26/2021

DocuSigned by:  
*Abad Bohine*  
DISTRICT ENGINEER

SPECIFICATIONS ADOPTED BY THE TEXAS DEPARTMENT OF TRANSPORTATION,  
NOVEMBER 1, 2014 AND SPECIFICATION ITEMS LISTED AND DATED AS FOLLOWS,  
SHALL GOVERN ON THIS PROJECT: REQUIRED CONTRACT PROVISIONS FOR  
ALL FEDERAL-AID CONSTRUCTION CONTRACTS (FORM FHWA 1273, MAY 2012)

# INDEX OF SHEETS

**SHEET DESCRIPTION**

**GENERAL**

- 1 TITLE SHEET
- 2 INDEX OF SHEETS
- 3-4 GENERAL NOTES
- 5 QUANTITY SHEET
- 6 QUANTITY SUMMARY
- 7 SEQUENCE OF WORK

**TRAFFIC CONTROL PLAN**


- 8 SB US 69 TO IH 10 - TCP CLOSURE
- ## 9-20 BC (1)-14 THRU BC (12)-14
- ## 21 TCP(6-1)-12
- ## 22 TCP(6-2)-12
- ## 23 TCP(6-6)-12
- ## 24 WZ (RS)-16

**BRIDGE AS-BUILTS**

- 25 BRIDGE LAYOUT ELEMENT "F" 2 OF 7
- 26 INTERIOR BENT NOS 2-6 & 11-14 ELEMENT "F"
- 27 BEAM LAYOUT (SPANS 1-3) ELEMENT "F"
- 28 330' PRESTR. CONC. BEAM UNIT (SPANS 1, 2, 3) ELEMENT "F"
- 29 GpA-2
- 30 Gp B-2 (MOD)
- 31 CONCRETE BARRIER RAIL AND TRAFFIC RAIL TY 501

**ENVIRONMENTAL ISSUES**

- 32 ENVIRONMENTAL PERMITS, ISSUES AND COMMITMENTS

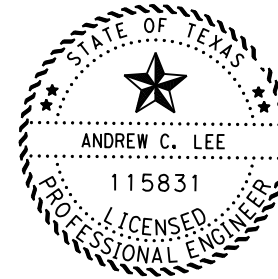

THE STANDARD SHEETS SPECIFICALLY IDENTIFIED WITH A "##" HAVE BEEN ISSUED BY ME AND ARE APPLICABLE TO THIS PROJECT.

DocuSigned by: Andrew C. Lee 3/4/2021  
PROFESOR 1102411...  
 NAME DATE

**US 69**

**INDEX OF SHEETS**



FHWA TEXAS DIVISION		FEDERAL AID PROJECT NO.		SHEET NO.
				2
STATE	DISTRICT	COUNTY		
TEXAS	BMT	JEFFERSON		
CONTROL	SECTION	JOB	HIGHWAY NO.	
6376	34	001	US 69	

FILE: T:\BMTDESIGN\Projects\0028-13-xxx\* IH10-US69\*Bear.ing\RMC\DCN\INDEX OF SHEETS.dgn  
 DATE: 2/23/2021 9:31:44 AM

**Project Number:** RMC 6376-34-001  
**County:** Jefferson  
**Highway:** US 69

Sheet \_\_\_\_\_

**GENERAL NOTES:**

This project includes plans, which are not part of the bid proposal. Plans may be viewed online or downloaded from the website at:

[http://www.txdot.gov/business/contractors\\_consultants/plans\\_online.htm](http://www.txdot.gov/business/contractors_consultants/plans_online.htm)

Plans may be ordered from any of the plan reproduction companies shown on the web at:

[http://www.txdot.gov/business/contractors\\_consultants/repro\\_companies.htm](http://www.txdot.gov/business/contractors_consultants/repro_companies.htm)

Contractor questions on this project are to be emailed to the following individuals:

Name Kenneth Wiemers, P.E.

Email [Kenneth.Wiemers@txdot.gov](mailto:Kenneth.Wiemers@txdot.gov)

Name Kevin Grissom, E.I.T.

Email [Kevin.Grissom@txdot.gov](mailto:Kevin.Grissom@txdot.gov)

Contractor questions will only be accepted through email, phone, and in-person by the above individuals.

All Contractor questions will be reviewed by the Area Engineer or their assistant. Once a response is developed, it will be posted to TxDOT's Public FTP at the following Address:

<https://ftp.dot.state.tx.us/pub/txdot-info/Pre-Letting%20Responses/>

All questions submitted that generate a response will be posted through this site. The site is organized by District, Project Type (Construction or Maintenance), Letting Date, CCSJ/Project Name.

**Item 6 Control of Materials**

Flammable/combustible materials must be stored at a designated location as approved.

Do not store flammable/combustible materials under or adjacent to Bridge class structures. Daily removal of these materials will be considered incidental work.

**Item 7 Legal Relations and Responsibilities**

Furnish all materials, labor and incidentals required to provide for traffic across the highway and for temporary ingress and egress to private property in accordance with article Section 7.2.4 of the standard specifications at no additional cost to the state. Maintain ingress and egress to the adjacent property at all times. Consider this work to be subsidiary to the various bid Items of the contract.

No significant traffic generator events have been identified in the project limits.

**Project Number:** RMC 6376-34-001  
**County:** Jefferson  
**Highway:** US 69

Sheet 3

**Item 8 Prosecution and Progress**

Compute and charge working days in accordance with Section 8.3.1.4., "Standard Workweek".

Adjoining projects may be in progress during the construction of a portion of this project. Plan and prosecute the sequence of construction and the traffic control plan with adjacent construction projects, if applicable. Manage construction of all phases to minimize disruption to traffic.

Night work **will** be required on this project. If required, nighttime hours will be defined as 9:00 PM until 5:00 AM, Sunday night thru Thursday night. Ensure all lanes are reopened by 5:00 A.M.

Supplemental lighting in addition to lighting on equipment and work vehicles will be required to insure adequate lighting for workers safety and inspection. All operations including planing must be adequately lighted using supplemental lighting. All supplemental lights are subject to the approval of the Engineer. Supplemental lighting will be added to the milling machine and other operations unless otherwise approved. This is considered subsidiary to the various bid Items of the contract.

Schedule work so that all travel lanes are open during non-working hours, nights and weekends, unless otherwise approved.

No simultaneous daytime and nighttime work will be allowed unless otherwise approved.

Work will not be permitted when impending bad weather or low temperatures may impair the quality of work.

Working days will be charged during the observed curing times, even if no other work is being performed.

Notify Area Office and Public Information Officer at least one week in advance of freeway closure for jacking operations and place PCMS at the discretion of the Engineer.

Law enforcement will be considered for this contract under the following conditions unless otherwise directed:

- Work involving controlled access facilities,
- Night work operations that create substantial traffic safety risks for workers and/or road users,
- Major traffic shifts involving high speed (greater than 55 MPH) and/or high-volume roadways (ADT exceeds 10,000),
- Traffic shifts at intersections where unexpected or sudden queuing is anticipated,
- Complex intersections where flaggers may not be able to maintain adequate traffic control.

Provide full-time, off-duty uniformed officers, with transportation jurisdiction and full police powers in the county or city in which the project is located, during construction as directed. The officers must be able to show proof of certification by the Texas Commission on Law

**Project Number:** RMC 6376-34-001  
**County:** Jefferson  
**Highway:** US 69

Sheet \_\_\_\_\_

Enforcement Officers Standards. Officers will be paid by force account, and must be approved. The vehicle used must be a marked law enforcement vehicle in the city or county where the project is located. Complete the daily tracking form provided by the Department and submit invoices that agree with the tracking form for payment at the end of each month approved services were provided.

**Item 354 Planing and Texturing Pavement**

Once bearing pads are replaced, it is anticipated the deck and composite joint will self-correct to original elevations. Ensure milled ACP surface is smooth and bridge joint is not a hazard to motorists. These Items of work will not be paid for directly but will be subsidiary to Item 354.

Complete planing operations the same day bearings are replaced unless otherwise directed by the Engineer.

Depth of level-up is expected to vary. No additional payment will be made for milling that exceeds specified depth up to twice the pay Item depth (D). Compensation for milling greater than 2 x D will be in accordance with Article 9.7

Remove any and all asphalt materials that may remain on the concrete surface after milling due to irregularities in the underlying section (i.e. scabbing). Up to 1 in of adjacent shifted or faulted concrete slabs may be milled to remove scabs and improve ride.

**Item 429 Concrete Structure Repair**

Spalled areas of bent cap 4 under beams will be repaired using methods outlined in TxDOT Concrete Repair Manual for "intermediate spalls". Should conditions worsen or warrant another repair, this will be done as directed by the Engineer using the Concrete Repair Manual. Additional work will be negotiable at discretion of the Engineer.

**Item 495 Raising Existing Structure**

Submit design calculations and detail sheets bearing the seal of a licensed professional Engineer for all temporary shoring and lift plans no later than two weeks before beginning work. Do not begin work until the design calculations and detail sheets have been approved. The Contractor will be responsible for the complete design, fabrication and removal of any temporary shoring.

**Item 502 Barricades, Signs, and Traffic Handling**

Construct all work zone signs, sign supports, and barricades from material other than wood unless approved otherwise. Metal posts, if used, are to be galvanized. Aluminum signs, if used, will meet the following minimum thickness requirements:

<u>Square Feet</u>	<u>Minimum Thickness</u>
Less than 7.5	0.080 inches
7.5 to 15	0.100 inches

General Notes

Sheet C

**Project Number:** RMC 6376-34-001  
**County:** Jefferson  
**Highway:** US 69

Sheet 4

Greater than 15                      0.125 inches

Furnish additional barricades and signs to maintain traffic and motorist safety when directed. Consider payment for these additional signs and barricades subsidiary to Item 502 and "Safety Contingency".

Use drums as channelizing devices.

Remove all traffic control devices from the right of way when they are not in use. Devices scheduled to be used within 3 days may be placed along the shoulder of the roadway or along the right of way when not in use, or stored in other approved areas on the project. Cover any construction signs that are not in effect and are installed in a fashion that will not allow them to be removed from the right of way easily.

**Item 506 Temporary Erosion, Sedimentation, and Environmental Controls**

It is not anticipated that any erosion, sedimentation, or environmental control devices will be needed on this project. The SW3P for this project will consist of the use of any temporary erosion control measures deemed necessary and as specified under this Item. This work will be paid for in accordance with Article 4.4., "Changes in the Work."

The Contractor will designate a clean out area for concrete trucks. No other area will be allowed without approval of the Engineer.

**Item 6185**

Shadow vehicles with TMA and high intensity rotating, flashing, oscillating or strobe lights are required. Use one TMA preceding every stationary work zone and two TMA's for mobile operations.

Therefore, 2 total shadow vehicles with TMA will be required for this type of work. The contractor will be responsible for determining if one or more of these operations will be ongoing at the same time to determine the total number of TMA's needed for the project.

General Notes

Sheet D



CONTROLLING PROJECT ID 6376-34-001

DISTRICT Beaumont  
HIGHWAY US 69

COUNTY Jefferson

# QUANTITY SHEET

CONTROL SECTION JOB				6376-34-001		TOTAL EST.	TOTAL FINAL
PROJECT ID				A00139713			
COUNTY				Jefferson			
HIGHWAY				US 69			
ALT	BID CODE	DESCRIPTION	UNIT	EST.	FINAL		
	354-6002	PLAN & TEXT ASPH CONC PAV(0" TO 2")	SY	5.000		5.000	
	429-6007	CONC STR REPAIR (VERTICAL & OVERHEAD)	SF	15.000		15.000	
	495-6001	RAISING EXIST STRUCT	LS	1.000		1.000	
	500-6001	MOBILIZATION	LS	100.00%		100.00%	
	502-6001	BARRICADES, SIGNS AND TRAFFIC HANDLING	MO	1.000		1.000	
	4002-6001	REPLACE ELASTOMERIC BEARING PADS	EA	3.000		3.000	
	6001-6002	PORTABLE CHANGEABLE MESSAGE SIGN	EA	3.000		3.000	
	6185-6002	TMA (STATIONARY)	DAY	3.000		3.000	

## SUMMARY OF PLAN ITEMS

LOCATION	354	429	495	4002	6001	6185
	6119	6007	6001	6001	6002	6001
	PLAN & TEXT ASPH CONC PAV (1.5")	CONC STR REPAIR (VERTICAL & OVERHEAD)	RAISING EXIST STRUCT	REPLACE ELASTOMERIC BEARING PADS	PORTABLE CHANGEABLE MESSAGE SIGN	TMA (STATIONARY)
	SY	SF	EA	EA	EA	EA
US 69 SB TO IH 10 WB BRIDGE	5	15	1	3	3	3
<b>TOTAL</b>	<b>5</b>	<b>15</b>	<b>1</b>	<b>3</b>	<b>3</b>	<b>3</b>

FILE: T:\BMTDESIGN\Projects\0028-13-xxx\* IH10-US69\*BearingRMC\DCN\SUMMARIES.dgn  
DATE: 2/22/2021 1:43:34 PM

**US 69  
QUANTITY  
SUMMARY**




FHWA TEXAS DIVISION		FEDERAL AID PROJECT NO.		SHEET NO.
				<b>6</b>
STATE	DISTRICT	COUNTY		
TEXAS	BMT	JEFFERSON		
CONTROL	SECTION	JOB	HIGHWAY NO.	
6376	34	001	US 69	

SEQUENCE OF WORK

1. INSTALL SPECIAL SHORING FOR BRIDGE LIFT (MAY BE DONE DURING DAY AT ENGINEERS DISCRETION).
2. INSTALL TCP FOR FREEWAY DETOUR AND CLOSURE FOLLOWING TCP STANDARDS.
3. IMPLEMENT TCP FOR FREEWAY CLOSURE FOR BRIDGE JACKING.
4. REPAIR SPALLED AREAS OF CONCRETE CAP IN ACCORDANCE WITH TXDOT CONCRETE REPAIR MANUAL FOR "INTERMEDIATE SPALLS".
5. REPLACE SLIPPED BRIDGE BEARINGS.
6. LOWER JACKS RESTORING LOAD PATHS TO BEARING PADS.
7. MILL ACP SURFACE THAT WAS LEVELED UP ON BRIDGE DECK ABOVE THE SAME NIGHT BEARINGS ARE REPLACED.
8. REMOVE TCP AND DEMOBILIZE.

FILE: T:\BMTDESIGN\Projects\0028-13-xxx\*IH10-US69\*BearingRMC\DCN\SEQUENCE OF WORK.dgn  
DATE: 2/23/2021 9:58:54 AM

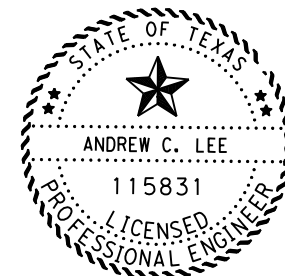

DocuSigned by:  
*Andrew C. Lee*  
F0E9D4E711D2411...


3/4/2021

**US 69**  
**SEQUENCE**  
**OF WORK**



FHWA TEXAS DIVISION		FEDERAL AID PROJECT NO.		SHEET NO.
TEXAS		BMT		7
CONTROL	SECTION	JOB	HIGHWAY NO.	
6376	34	001	US 69	

FILE: T:\BMTDESIGN\Projects\0028-13--xxx\*IH10-US69\*Bearing\RMCDGN\US 69-IH 10 Bearing TCP Layout.dgn  
 DATE: 2/22/2021 1:43:53 PM

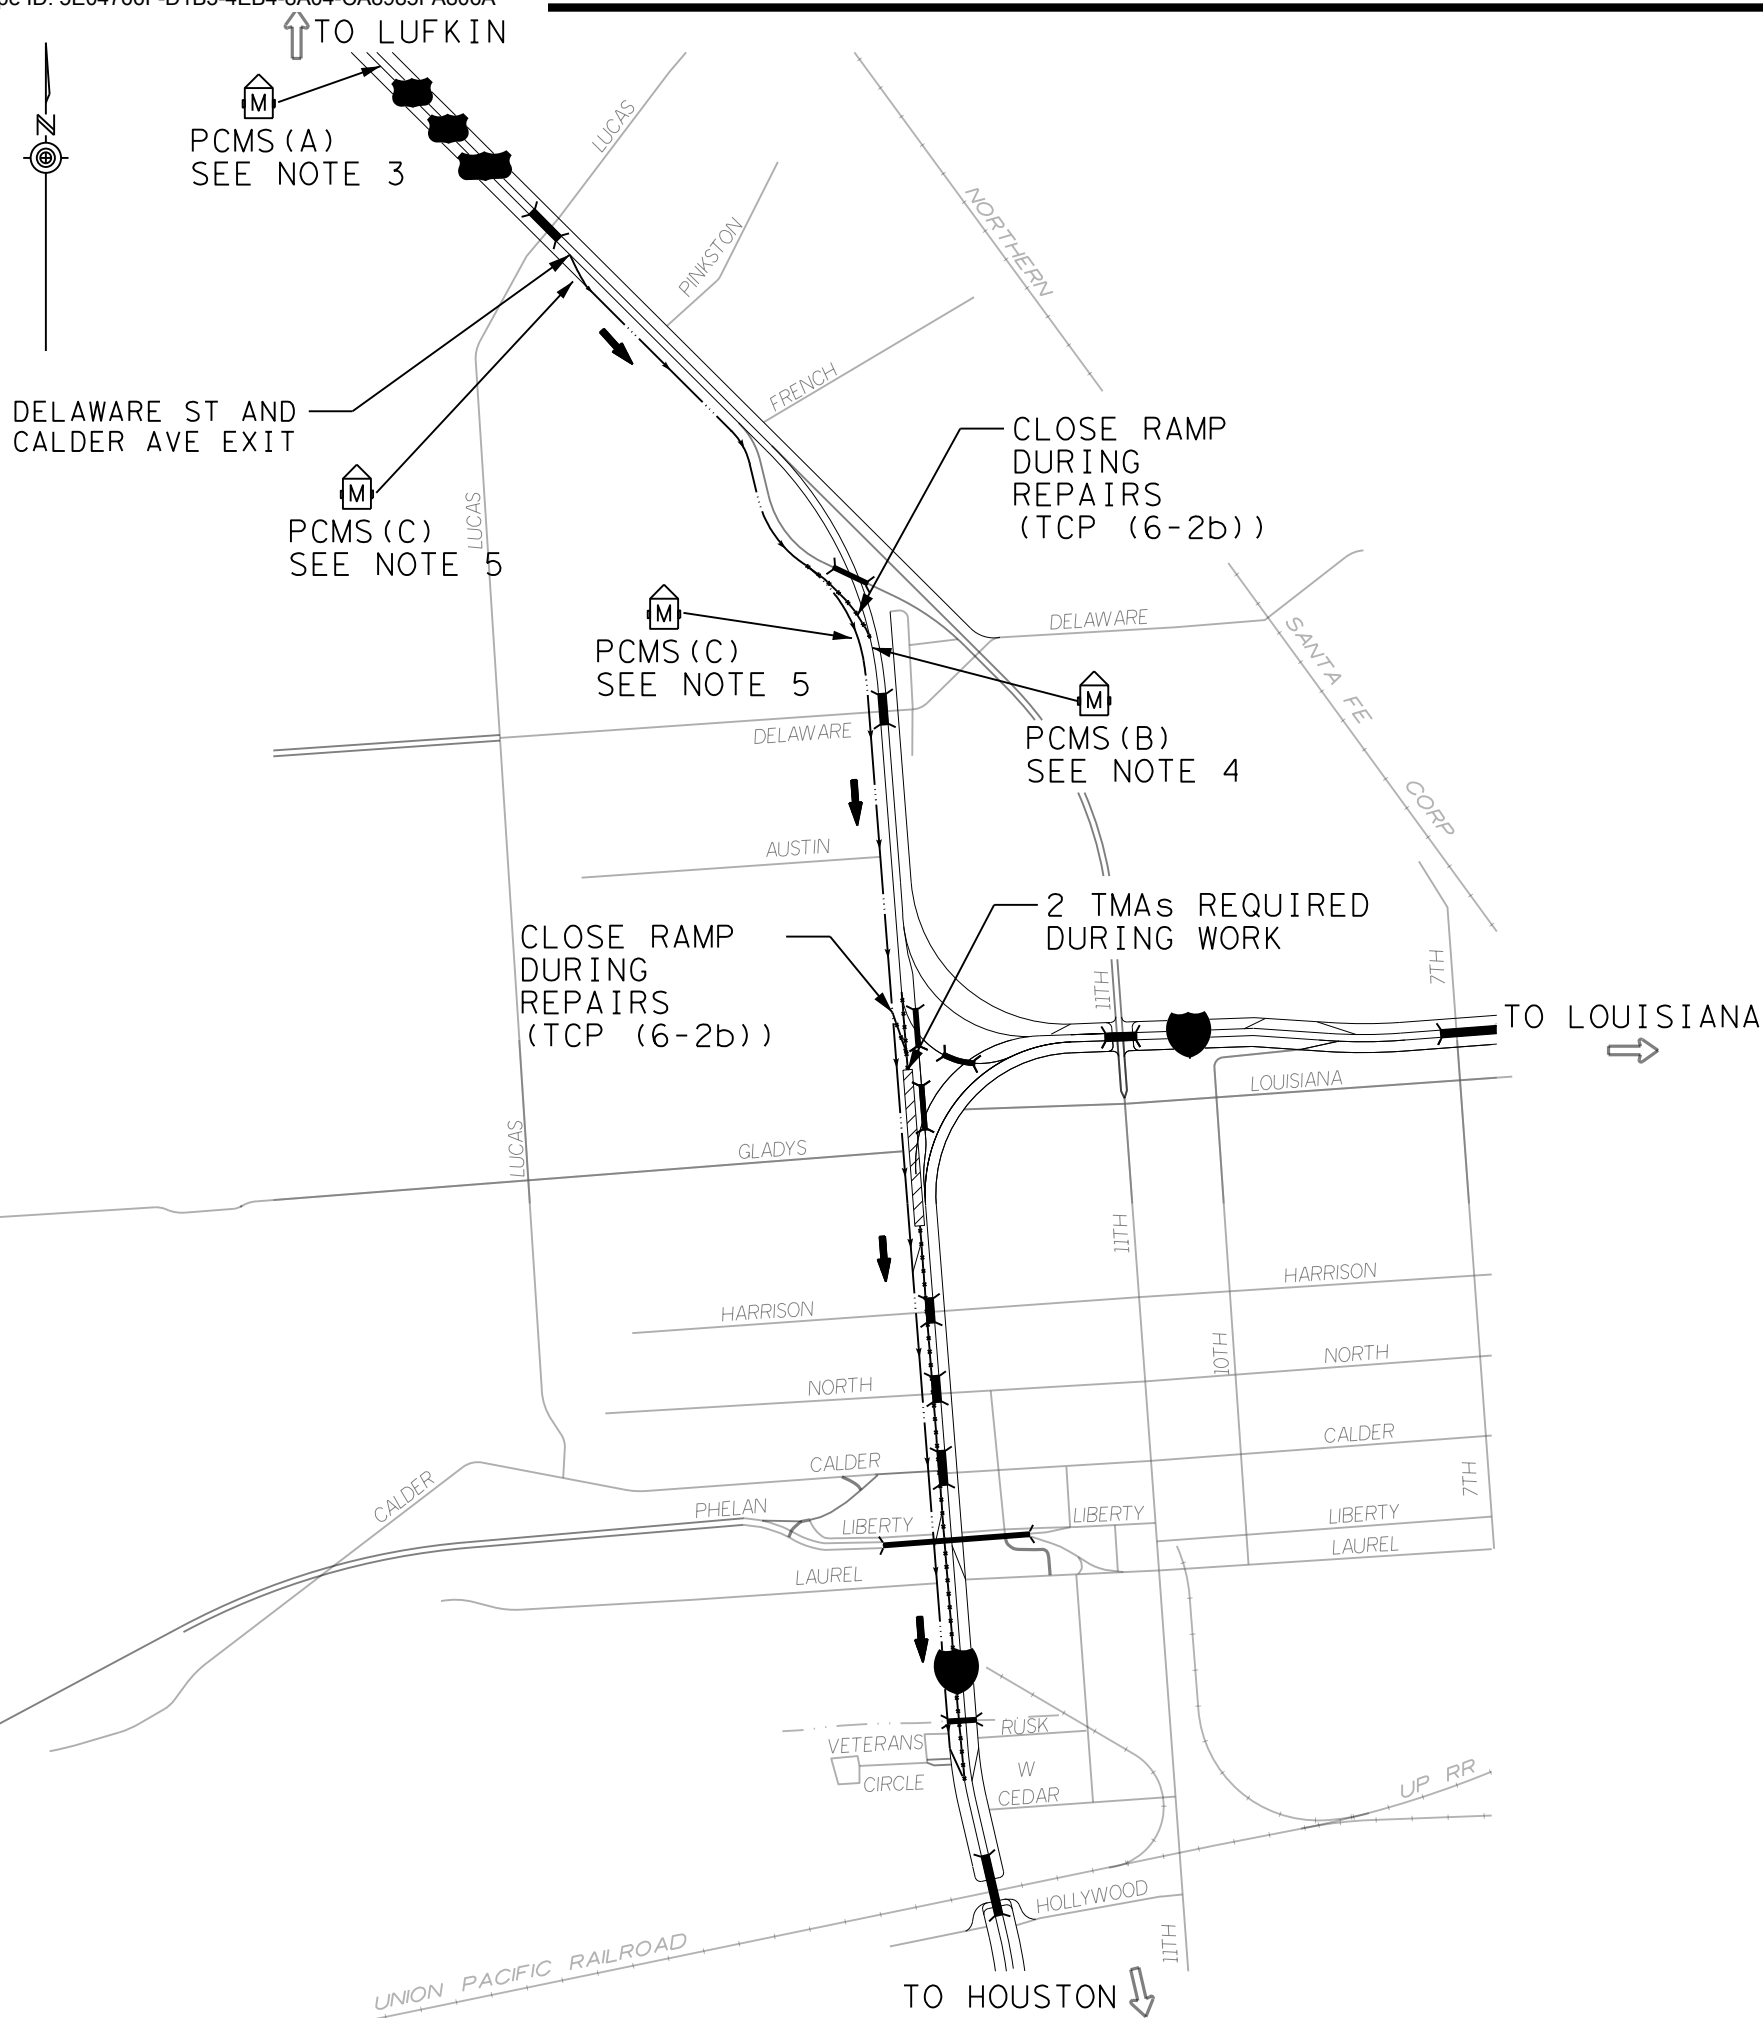

**LEGEND**


- Portable Changeable Message Sign (PCMS)
- Direction of Travel
- Work Area
- IH10 WB Detour Route
- Closed Road

- NOTES:**
- (1) INSTALL TRAFFIC CONTROL DEVICES IN ACCORDANCE WITH TCP (6-1B)-12 & (6-2a)-12
  - (2) CLOSURES TO BE INSTALLED AND REMOVED NIGHTLY
  - (3) PCMS (A) MESSAGE TO BE AS FOLLOWS:
 

<b>PHASE 1:</b> IH-10 WB CLOSED AHEAD	<b>PHASE 2:</b> USE DELAWARE RD EXIT
------------------------------------------------	-----------------------------------------------
  - (4) PCMS (B) MESSAGE TO BE AS FOLLOWS:
 

<b>PHASE 1:</b> RIGHT 2 LANES CLOSED	<b>PHASE 2:</b> MERGE LEFT
-----------------------------------------------	----------------------------------
  - (5) PCMS (C) MESSAGE TO BE AS FOLLOWS:
 

<b>PHASE 1:</b> (AS SHOWN ON TCP 6-2b))	<b>PHASE 2:</b> TONIGHT 8 PM- 5 AM
--------------------------------------------	---------------------------------------------

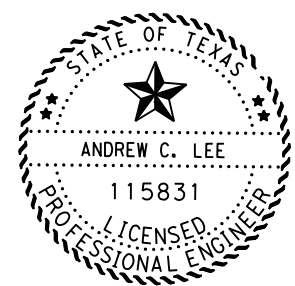

DocuSigned by:  
*Andrew C. Lee*  
 3/4/2021

**SB US 69  
 TO IH 10  
 TCP CLOSURE**  
 NTS

Texas Department of Transportation  
 SHEET 1 OF 1

FHWA TEXAS DIVISION	FEDERAL AID PROJECT NO.	SHEET NO.	8
STATE	DISTRICT	COUNTY	
TEXAS	BMT	JEFFERSON	
CONTROL	SECTION	JOB	HIGHWAY NO.
6376	34	001	IH-10



DISCLAIMER: The use of this standard is governed by the "Texas Engineering Practice Act". No warranty of any kind is made by TxDOT for any purpose whatsoever. TxDOT assumes no responsibility for the conversion of this standard to other formats or for incorrect results or damages resulting from its use.


DATE: 2/22/2021 1:44:02 PM  
 FILE: T:\BMTDESIGN\Projects\0028-13-xxx-IH10-US69\_Bearing\_RMC\DCN\Standards\bc-14.dgn

**BARRICADE AND CONSTRUCTION (BC) STANDARD SHEETS GENERAL NOTES:**

- The Barricade and Construction Standard Sheets (BC sheets) are intended to show typical examples for placement of temporary traffic control devices, construction pavement markings, and typical work zone signs. The information contained in these sheets meet or exceed the requirements shown in the "Texas Manual on Uniform Traffic Control Devices" (TMUTCD).
- The development and design of the Traffic Control Plan (TCP) is the responsibility of the Engineer.
- The Contractor may propose changes to the TCP that are signed and sealed by a licensed professional engineer for approval. The Engineer may develop, sign and seal Contractor proposed changes.
- The Contractor is responsible for installing and maintaining the traffic control devices as shown in the plans. The Contractor may not move or change the approximate location of any device without the approval of the Engineer.
- Geometric design of lane shifts and detours should, when possible, meet the applicable design criteria contained in manuals such as the American Association of State Highway and Transportation Officials (AASHTO), "A Policy on Geometric Design of Highways and Streets," the TxDOT "Roadway Design Manual" or engineering judgment.
- When projects abut, the Engineer(s) may omit the END ROAD WORK, TRAFFIC FINES DOUBLE, and other advance warning signs if the signing would be redundant and the work areas appear continuous to the motorists. If the adjacent project is completed first, the Contractor shall erect the necessary warning signs as shown on these sheets, the TCP sheets or as directed by the Engineer. The BEGIN ROAD WORK NEXT X MILES sign shall be revised to show appropriate work zone distance.
- The Engineer may require duplicate warning signs on the median side of divided highways where median width will permit and traffic volumes justify the signing.
- All signs shall be constructed in accordance with the details found in the "Standard Highway Sign Designs for Texas," latest edition. Sign details not shown in this manual shall be shown in the plans or the Engineer shall provide a detail to the Contractor before the sign is manufactured.
- The temporary traffic control devices shown in the illustrations of the BC sheets are examples. As necessary, the Engineer will determine the most appropriate traffic control devices to be used.
- As shown on BC(2), the OBEY WARNING SIGNS STATE LAW sign, STAY ALERT TALK OR TEXT LATER (see Sign Detail G20-10T) and the WORK ZONE TRAFFIC FINES DOUBLE sign with plaque shall be erected in advance of the CSJ limits. However, the TRAFFIC FINES DOUBLE sign will not be required on projects consisting solely of mobile operation work, such as striping or milling edgeline rumble strips. The BEGIN ROAD WORK NEXT X MILES, CONTRACTOR and END ROAD WORK signs shall be erected at or near the CSJ limits.
- Except for devices required by Note 10, traffic control devices should be in place only while work is actually in progress or a definite need exists.
- The Engineer has the final decision on the location of all traffic control devices.
- Inactive equipment and work vehicles, including workers' private vehicles must be parked away from travel lanes. They should be as close to the right-of-way line as possible, or located behind a barrier or guardrail, or as approved by the Engineer.

**WORKER SAFETY APPAREL NOTES:**

- Workers on foot who are exposed to traffic or to construction equipment within the right-of-way shall wear high-visibility safety apparel meeting the requirements of ISEA "American National Standard for High-Visibility Apparel," or equivalent revisions, and labeled as ANSI 107-2004 standard performance for Class 2 or 3 risk exposure. Class 3 garments should be considered for high traffic volume work areas or night time work.

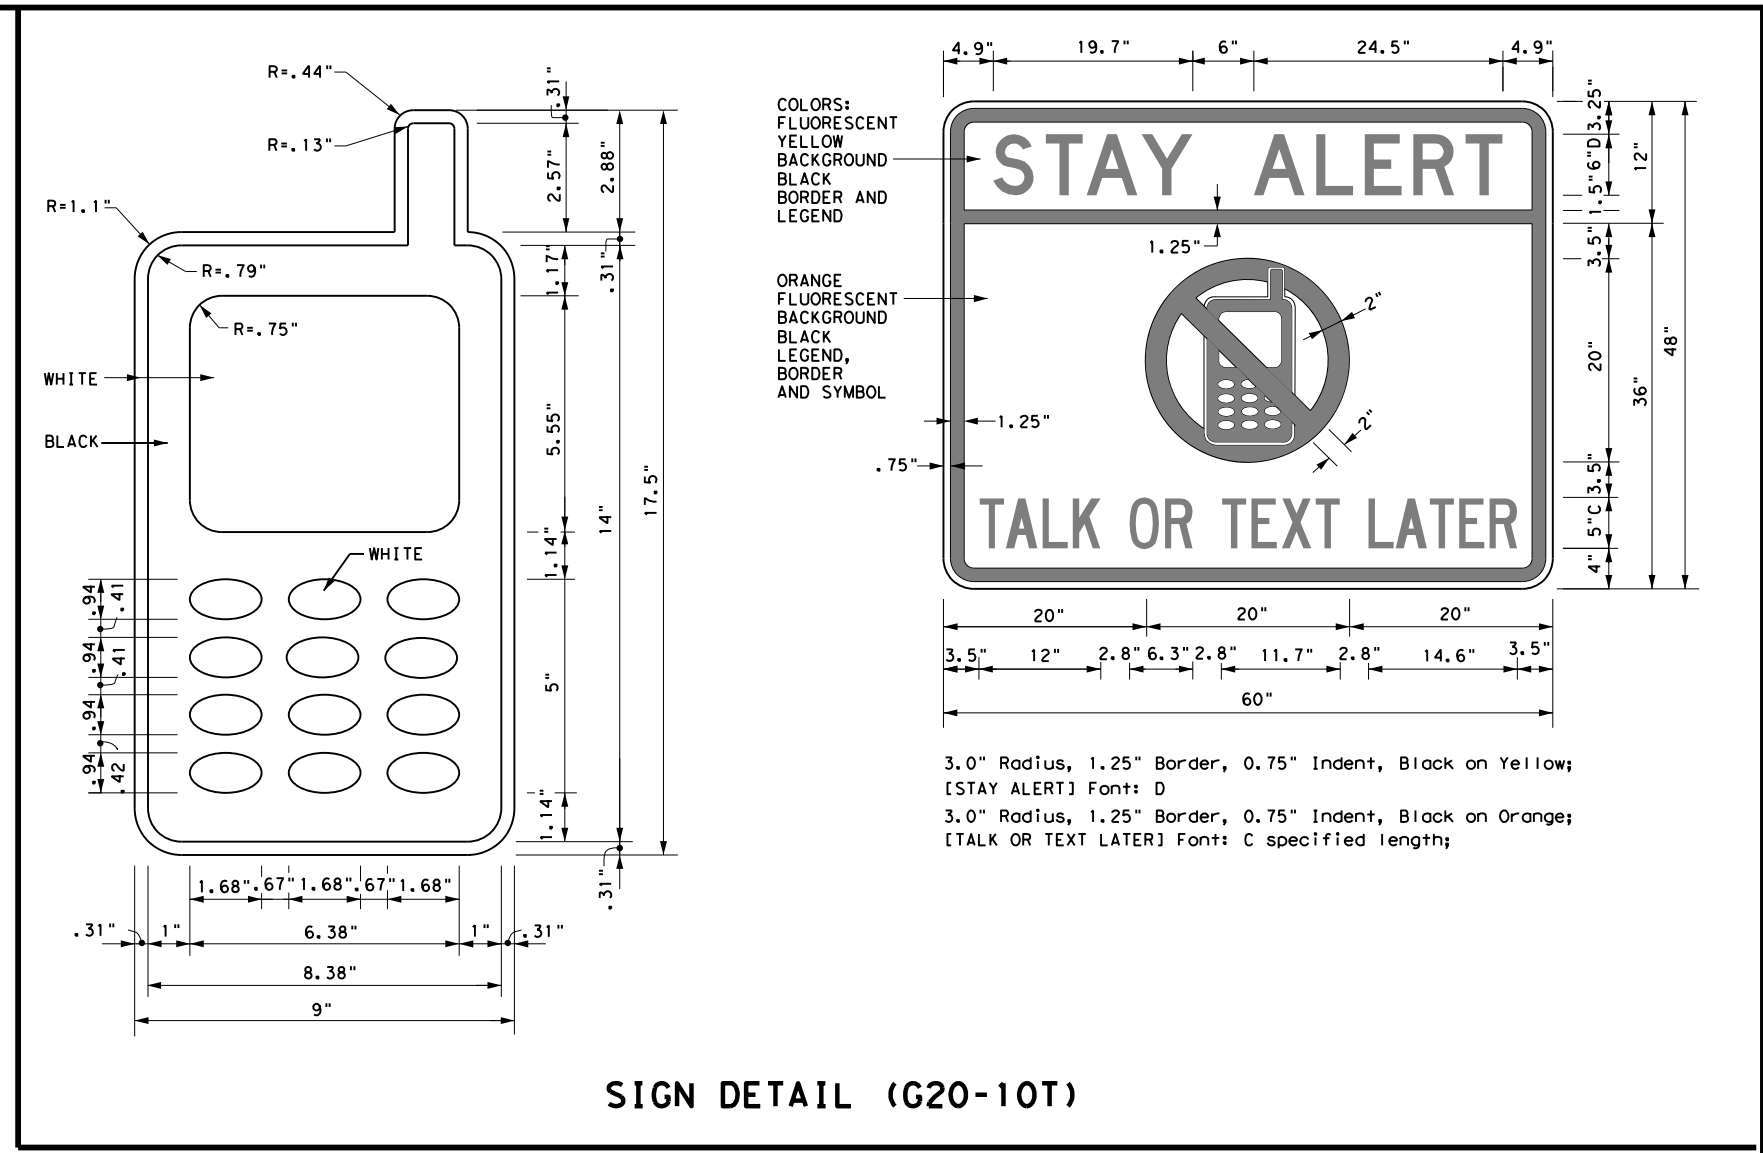

Only pre-qualified products shall be used. The "Compliant Work Zone Traffic Control Devices List" (CWZTCD) describes pre-qualified products and their sources and may be found on-line at the web address given below or by contacting:

Texas Department of Transportation  
 Traffic Operations Division - TE  
 Phone (512) 416-3118


<b>THE DOCUMENTS BELOW CAN BE FOUND ON-LINE AT</b> <a href="http://www.txdot.gov">http://www.txdot.gov</a>	
COMPLIANT WORK ZONE TRAFFIC CONTROL DEVICES LIST (CWZTCD)	
DEPARTMENTAL MATERIAL SPECIFICATIONS (DMS)	
MATERIAL PRODUCER LIST (MPL)	
ROADWAY DESIGN MANUAL - SEE "MANUALS (ONLINE MANUALS)"	
STANDARD HIGHWAY SIGN DESIGNS FOR TEXAS (SHSD)	
TEXAS MANUAL ON UNIFORM TRAFFIC CONTROL DEVICES (TMUTCD)	
TRAFFIC ENGINEERING STANDARD SHEETS	

SHEET 1 OF 12

		<i>Traffic Operations Division Standard</i>
<b>BARRICADE AND CONSTRUCTION GENERAL NOTES AND REQUIREMENTS</b> <b>BC (1) - 14</b>		
FILE: bc-14.dgn	DN: TxDOT	CK: TxDOT
© TxDOT November 2002	CONT: 6376	SECT: 34
REVISIONS	4-03 5-10 8-14	JOB: 001
9-07 7-13	DIST: BMT	COUNTY: JEFFERSON
		HSHEET NO.: 9


DATE: 2/22/2021 1:44:06 PM  
 FILE: T:\BMT\DESIGN\Projects\0028-13-xxx-IH10-US69-Bear\ing\_RMC\DN\Standards\bc-14.dgn  
 DISCLAIMER: The use of this standard is governed by the "Texas Engineering Practice Act". No warranty of any kind is made by TxDOT for any purpose whatsoever. TxDOT assumes no responsibility for incorrect results or damages resulting from its use.

**TYPICAL LOCATION OF CROSSROAD SIGNS**

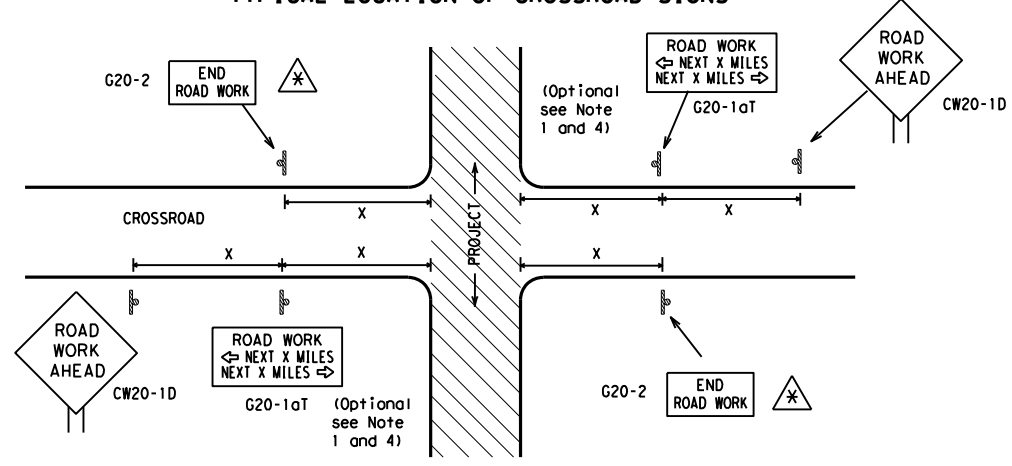

- ⚠ May be mounted on back of "ROAD WORK AHEAD" (CW20-1D) sign with approval of Engineer. (See note 2 below)
- The typical minimum signing on a crossroad approach should be a "ROAD WORK AHEAD" (CW20-1D) sign and a (G20-2) "END ROAD WORK" sign, unless noted otherwise in plans.
  - The Engineer may use the reduced size 36" x 36" ROAD WORK AHEAD (CW20-1D) sign mounted back to back with the reduced size 36" x 18" "END ROAD WORK" (G20-2) sign on low volume crossroads (see Note 4 under "Typical Construction Warning Sign Size and Spacing"). See the "Standard Highway Sign Designs for Texas" manual for sign details. The Engineer may omit the advance warning signs on low volume crossroads. The Engineer will determine whether a road is low volume. This information shall be shown in the plans.
  - Based on existing field conditions, the Engineer/Inspector may require additional signs such as FLAGGER AHEAD, LOOSE GRAVEL, or other appropriate signs. When additional signs are required, these signs will be considered part of the minimum requirements. The Engineer/Inspector will determine the proper location and spacing of any sign not shown on the BC sheets, Traffic Control Plan sheets or the Work Zone Standard Sheets.
  - The "ROAD WORK NEXT X MILES" (G20-1aT) sign shall be required at high volume crossroads to advise motorists of the length of construction in either direction from the intersection. The Engineer will determine whether a roadway is considered high volume.
  - Additional traffic control devices may be shown elsewhere in the plans for higher volume crossroads.
  - When work occurs in the intersection area, appropriate traffic control devices, as shown elsewhere in the plans or as determined by the Engineer/Inspector, shall be in place.

**T-INTERSECTION**

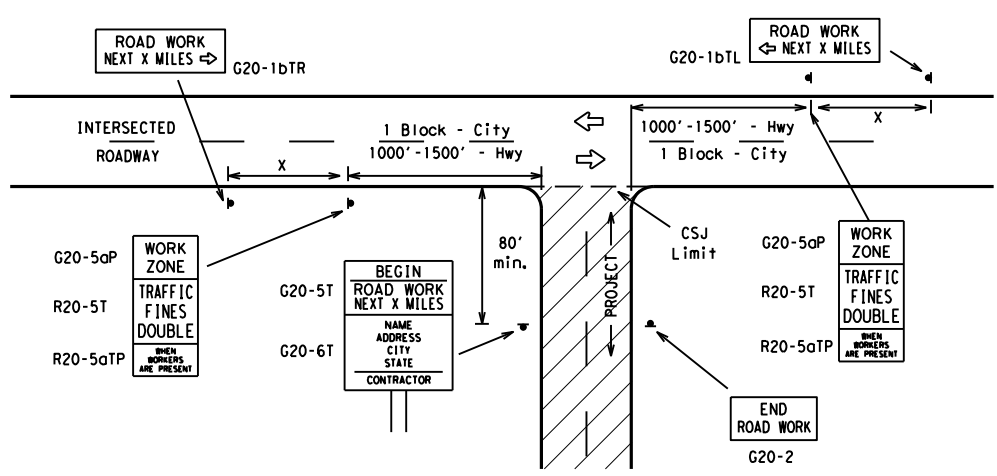

**CSJ LIMITS AT T-INTERSECTION**

- The Engineer will determine the types and location of any additional traffic control devices, such as a flagger and accompanying signs, or other signs, that should be used when work is being performed at or near an intersection.
- If construction closes the road at a T-intersection the Contractor shall place the "CONTRACTOR NAME" (G20-6T) sign behind the Type 3 Barricades for the road closure (see BC(10) also). The "ROAD WORK NEXT X MILES" left arrow (G20-1bTL) and "ROAD WORK NEXT X MILES" right arrow (G20-1bTR) signs shall be replaced by the detour signing called for in the plans.

**TYPICAL CONSTRUCTION WARNING SIGN SIZE AND SPACING<sup>1,5,6</sup>**

Sign Number or Series	SIZE		SPACING	
	Conventional Road	Expressway/Freeway	Posted Speed MPH	Sign Spacing "X" Feet (Approx.)
CW20 <sup>4</sup>	48" x 48"	48" x 48"	30	120
CW21			35	160
CW22			40	240
CW23			45	320
CW25			50	400
CW1, CW2, CW7, CW8, CW9, CW11, CW14	36" x 36"	48" x 48"	55	500 <sup>2</sup>
CW3, CW4, CW5, CW6, CW8-3, CW10, CW12	48" x 48"	48" x 48"	60	600 <sup>2</sup>
			65	700 <sup>2</sup>
			70	800 <sup>2</sup>
			75	900 <sup>2</sup>
			80	1000 <sup>2</sup>
			*	* <sup>3</sup>


\* For typical sign spacings on divided highways, expressways and freeways, see Part 6 of the "Texas Manual on Uniform Traffic Control Devices" (TMUTCD) typical application diagrams or TCP Standard Sheets.

Δ Minimum distance from work area to first Advance Warning sign nearest the work area and/or distance between each additional sign.

**GENERAL NOTES**


- Special or larger size signs may be used as necessary.
- Distance between signs should be increased as required to have 1500 feet advance warning.
- Distance between signs should be increased as required to have 1/2 mile or more advance warning.
- 36" x 36" "ROAD WORK AHEAD" (CW20-1D) signs may be used on low volume crossroads at the discretion of the Engineer. See Note 2 under "Typical Location of Crossroad Signs".
- Only diamond shaped warning sign sizes are indicated.
- See sign size listing in "TMUTCD", Sign Appendix or the "Standard Highway Sign Designs for Texas" manual for complete list of available sign design sizes.

**WORK AREAS IN MULTIPLE LOCATIONS WITHIN CSJ LIMITS**

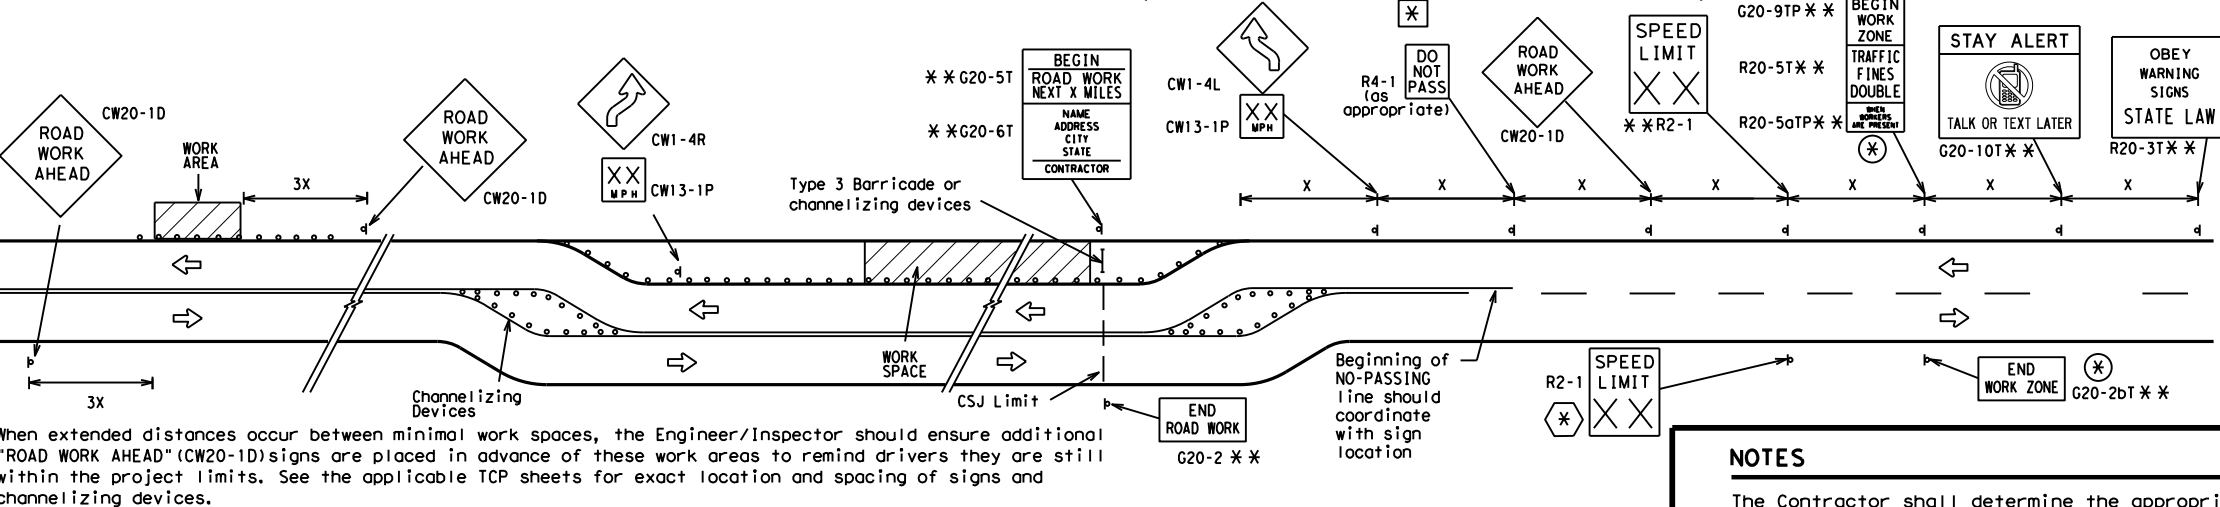


When extended distances occur between minimal work spaces, the Engineer/Inspector should ensure additional "ROAD WORK AHEAD" (CW20-1D) signs are placed in advance of these work areas to remind drivers they are still within the project limits. See the applicable TCP sheets for exact location and spacing of signs and channelizing devices.

**SAMPLE LAYOUT OF SIGNING FOR WORK BEGINNING DOWNSTREAM OF THE CSJ LIMITS**

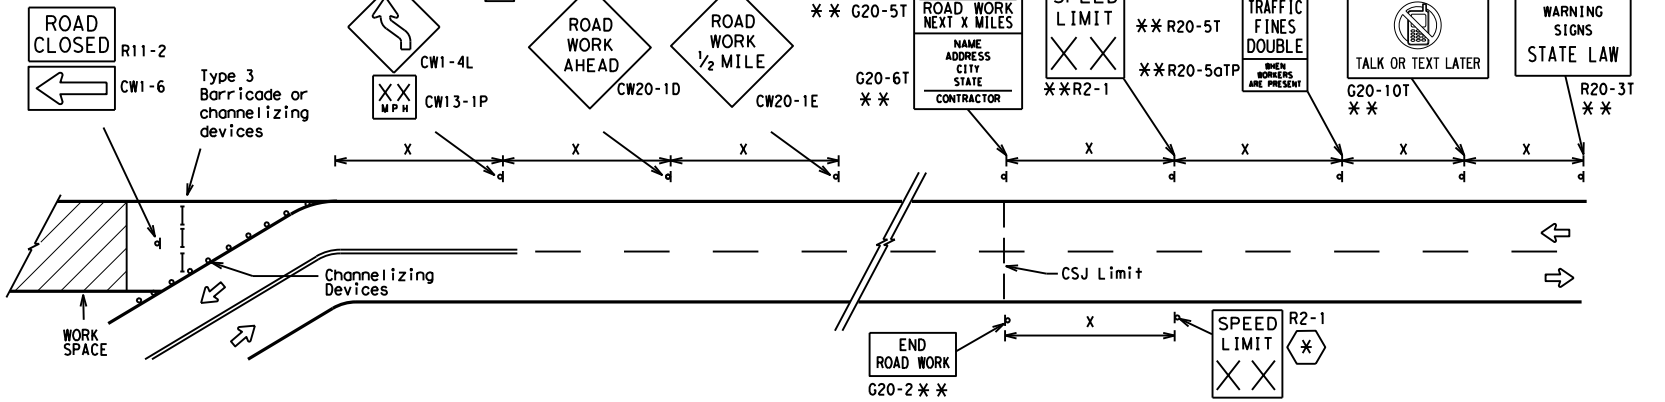

**SAMPLE LAYOUT OF SIGNING FOR WORK BEGINNING AT THE CSJ LIMITS**

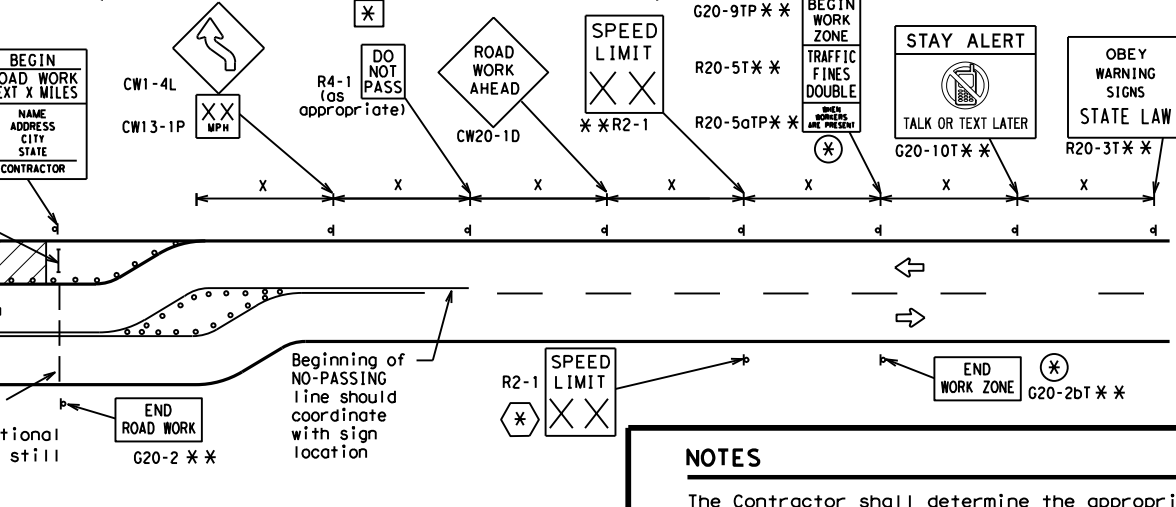

**NOTES**

- The Contractor shall determine the appropriate distance to be placed on the G20-1 series signs and "BEGIN ROAD WORK NEXT X MILES" (G20-5T) sign for each specific project. This distance shall replace the "X" and shall be rounded to the nearest whole mile with the approval of the Engineer. No decimals shall be used.
- ⊗ The "BEGIN WORK ZONE" (G20-9TP) and "END WORK ZONE" (G20-2bT) shall be used as shown on the sample layout when advance signs are required outside the CSJ Limits. They inform the motorist of entering or leaving a part of the work zone lying outside the CSJ Limits where traffic fines may double if workers are present.
- \*\* Required CSJ Limit signing. See Note 10 on BC(1). TRAFFIC FINES DOUBLE signs will not be required on projects consisting solely of mobile operations work.
- ⊗ Area for placement of "ROAD WORK AHEAD" (CW20-1D) sign and other signs or devices as called for on the Traffic Control Plan.
- ⊗ Contractor will install a regulatory speed limit sign at the end of the work zone.

**LEGEND**

—	Type 3 Barricade
○ ○ ○	Channelizing Devices
⊗	Sign
X	See Typical Construction Warning Sign Size and Spacing chart or the TMUTCD for sign spacing requirements.

SHEET 2 OF 12



**BARRICADE AND CONSTRUCTION PROJECT LIMIT**


**BC(2)-14**

FILE: bc-14.dgn	DN: TxDOT	CK: TxDOT	DW: TxDOT	CK: TxDOT
© TxDOT November 2002	CONT	SECT	JOB	HIGHWAY
REVISIONS	6376	34	001	US 69
9-07 8-14	DIST	COUNTY	SHEET NO.	
7-13	BMT	JEFFERSON	10	

# TYPICAL APPLICATION OF WORK ZONE SPEED LIMIT SIGNS

Work zone speed limits shall be regulatory, established in accordance with the "Procedures for Establishing Speed Zones," and approved by the Texas Transportation Commission, or by City Ordinance when within Incorporated City Limits.

Reduced speeds should only be posted in the vicinity of work activity and not throughout the entire project. Regulatory work zone speed signs (R2-1) shall be removed or covered during periods when they are not needed.

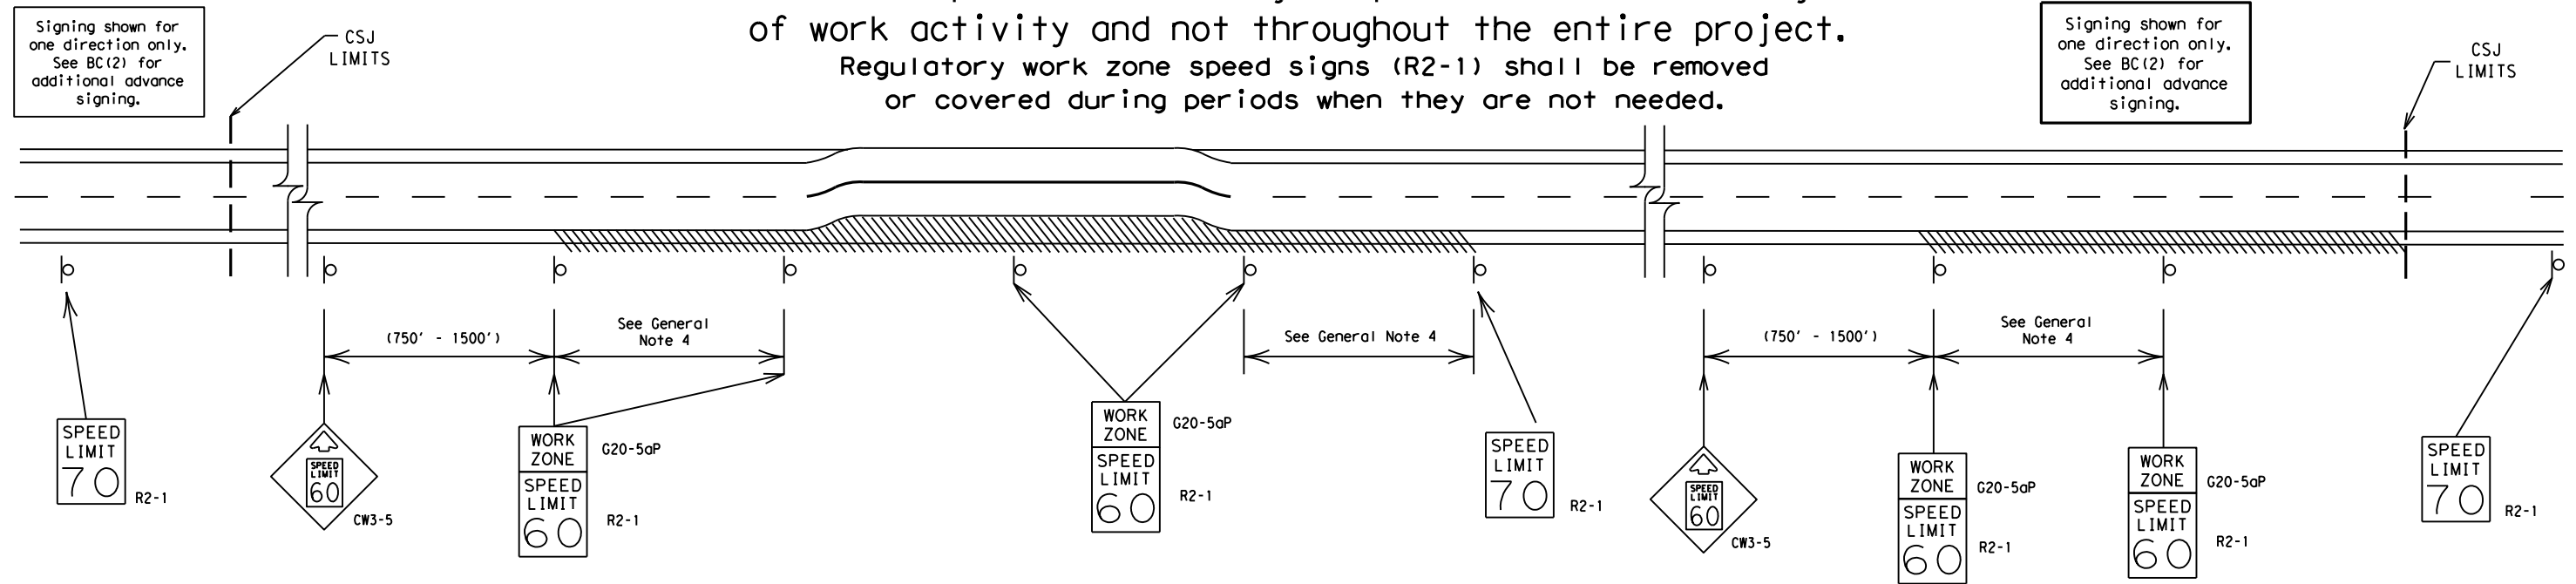

## GUIDANCE FOR USE:

### LONG/INTERMEDIATE TERM WORK ZONE SPEED LIMITS

This type of work zone speed limit should be included on the design of the traffic control plans when restricted geometrics with a lower design speed are present in the work zone and modification of the geometrics to a higher design speed is not feasible.

Long/Intermediate Term Work Zone Speed Limit signs, when approved as described above, should be posted and visible to the motorist when work activity is present. Work activity may also be defined as a change in the roadway that requires a reduced speed for motorists to safely negotiate the work area, including:

- rough road or damaged pavement surface
- substantial alteration of roadway geometrics (diversions)
- construction detours
- grade
- width
- other conditions readily apparent to the driver

As long as any of these conditions exist, the work zone speed limit signs should remain in place.

### SHORT TERM WORK ZONE SPEED LIMITS

This type of work zone speed limit may be included on the design of the traffic control plans when workers or equipment are not behind concrete barrier, when work activity is within 10 feet of the traveled way or actually in the traveled way.

Short Term Work Zone Speed Limit signs should be posted and visible to the motorists only when work activity is present. When work activity is not present, signs shall be removed or covered. (See Removing or Covering on BC(4)).

### GENERAL NOTES

- Regulatory work zone speed limits should be used only for sections of construction projects where speed control is of major importance.
- Regulatory work zone speed limit signs shall be placed on supports at a 7 foot minimum mounting height.
- Speed zone signs are illustrated for one direction of travel and are normally posted for each direction of travel.
- Frequency of work zone speed limit signs should be:
 

40 mph and greater	0.2 to 2 miles
35 mph and less	0.2 to 1 mile
- Regulatory speed limit signs shall have black legend and border on a white reflective background (See "Reflective Sheeting" on BC(4)).
- Fabrication, erection and maintenance of the "ADVANCE SPEED LIMIT" (CW3-5) sign, "WORK ZONE" (G20-5aP) plaque and the "SPEED LIMIT" (R2-1) signs shall not be paid for directly, but shall be considered subsidiary to Item 502.
- Turning signs from view, laying signs over or down will not be allowed, unless as otherwise noted under "REMOVING OR COVERING" on BC(4).
- Techniques that may help reduce traffic speeds include but are not limited to:
  - Law enforcement.
  - Flagger stationed next to sign.
  - Portable changeable message sign (PCMS).
  - Low-power (drone) radar transmitter.
  - Speed monitor trailers or signs.
- Speeds shown on details above are for illustration only. Work Zone Speed Limits should only be posted as approved for each project.
- For more specific guidance concerning the type of work, work zone conditions and factors impacting allowable regulatory construction speed zone reduction see TxDOT form #1204 in the TxDOT e-form system.

DISCLAIMER: The use of this standard is governed by the "Texas Engineering Practice Act". No warranty of any kind is made by TxDOT for any purpose whatsoever. TxDOT assumes no responsibility for the conversion of this standard to other formats or for incorrect results or damages resulting from its use.

DATE: 2/22/2021 1:44:10 PM  
FILE: T:\BMT\DESIGN\Projects\0028-13-xxx\_IH10-US69\_Bear\ing\_RMC\DCN\Standards\bc-14.dgn

SHEET 3 OF 12



## BARRICADE AND CONSTRUCTION WORK ZONE SPEED LIMIT


BC (3) - 14

FILE:	bc-14.dgn	DW:	TxDOT	CK:	TxDOT	DW:	TxDOT	CK:	TxDOT
© TxDOT	November 2002	CONT	SECT	JOB	HIGHWAY				
REVISIONS	6376	34	001	US 69					
9-07	8-14	DIST	COUNTY	SHEET NO.					
7-13	BMT	JEFFERSON	11						

DISCLAIMER: The use of this standard is governed by the "Texas Engineering Practice Act". No warranty of any kind is made by TxDOT for any purpose whatsoever. TxDOT assumes no responsibility for the conversion of this standard to other formats or for incorrect results or damages resulting from its use.

DATE: 2/22/2021 1:44:13 PM  
 FILE: T:\BMT\DESIGN\Projects\0028-13-xxx\_IH10-US69\_Bear\ing\_RMC\DCN\Standards\bc-14.dgn


**TYPICAL MINIMUM CLEARANCES FOR LONG TERM AND INTERMEDIATE TERM SIGNS**

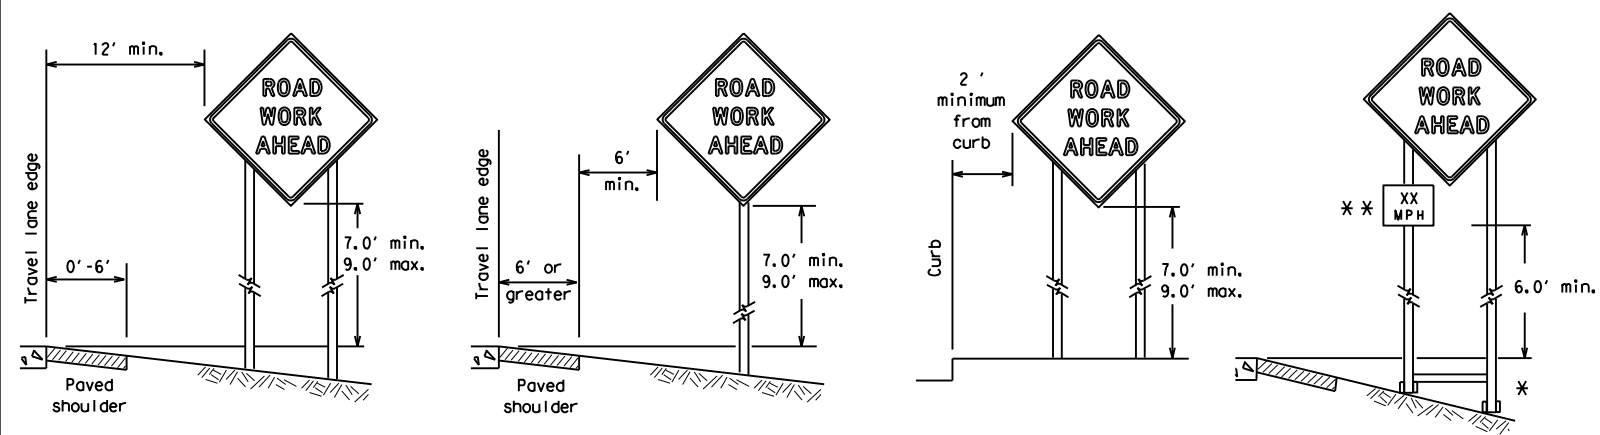

\* When placing skid supports on unlevel ground, the leg post lengths must be adjusted so the sign appears straight and plumb. Objects shall NOT be placed under skids as a means of leveling.

\*\* When plaques are placed on dual-leg supports, they should be attached to the upright nearest the travel lane. Supplemental plaques (advisory or distance) should not cover the surface of the parent sign.

**ATTACHMENT FOR SIGN SUPPORTS**

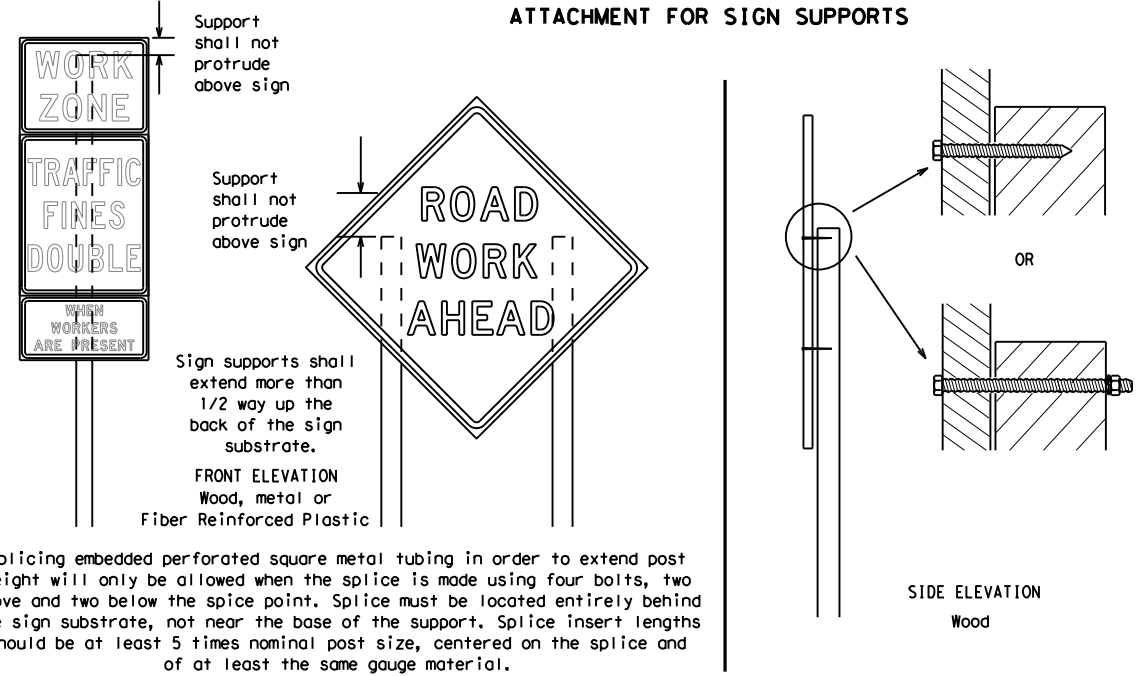

Attachment to wooden supports will be by bolts and nuts or screws. Use TxDOT's or manufacturer's recommended procedures for attaching sign substrates to other types of sign supports

**Nails shall NOT be allowed. Each sign shall be attached directly to the sign support. Multiple signs shall not be joined or spliced by any means. Wood supports shall not be extended or repaired by splicing or other means.**

Support shall not protrude above sign

Support shall not protrude above sign


Sign supports shall extend more than 1/2 way up the back of the sign substrate.

FRONT ELEVATION  
 Wood, metal or Fiber Reinforced Plastic

Splicing embedded perforated square metal tubing in order to extend post height will only be allowed when the splice is made using four bolts, two above and two below the splice point. Splice must be located entirely behind the sign substrate, not near the base of the support. Splice insert lengths should be at least 5 times nominal post size, centered on the splice and of at least the same gauge material.

**STOP/SLOW PADDLES**

1. STOP/SLOW paddles are the primary method to control traffic by flaggers. The STOP/SLOW paddle size should be 24" x 24" as detailed below.
2. When used at night, the STOP/SLOW paddle shall be retroreflectORIZED.
3. STOP/SLOW paddles may be attached to a staff with a minimum length of 6' to the bottom of the sign.
4. Any lights incorporated into the STOP or SLOW paddle faces shall only be as specifically described in Section 6E.03 Hand Signaling Devices in the TMUTCD.

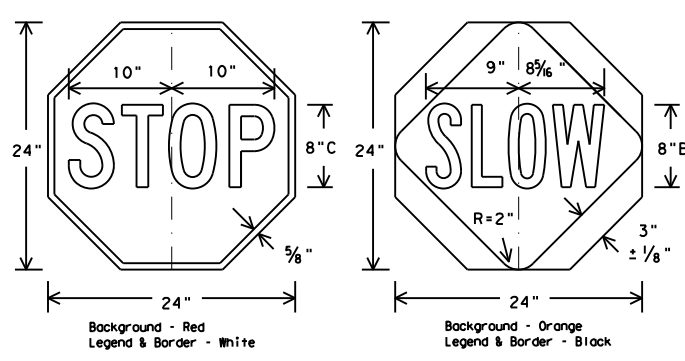

**CONTRACTOR REQUIREMENTS FOR MAINTAINING PERMANENT SIGNS WITHIN THE PROJECT LIMITS**

1. Permanent signs are used to give notice of traffic laws or regulations, call attention to conditions that are potentially hazardous to traffic operations, show route designations, destinations, directions, distances, services, points of interest, and other geographical, recreational, or cultural information. Drivers proceeding through a work zone need the same, if not better route guidance as normally installed on a roadway without construction.
2. When permanent regulatory or warning signs conflict with work zone conditions, remove or cover the permanent signs until the permanent sign message matches the roadway condition.
3. When existing permanent signs are moved and relocated due to construction purposes, they shall be visible to motorists at all times.
4. If existing signs are to be relocated on their original supports, they shall be installed on crashworthy bases as shown on the SMD Standard sheets. The signs shall meet the required mounting heights shown on the BC Sheets or the SMD Standards. This work should be paid for under the appropriate pay item for relocating existing signs.
5. If permanent signs are to be removed and relocated using temporary supports, the Contractor shall use crashworthy supports as shown on the BC sheets or the CWZTCD. The signs shall meet the required mounting heights shown on the BC Sheets or the SMD Standards during construction. This work should be paid for under the appropriate pay item for relocating existing signs.
6. Any sign or traffic control device that is struck or damaged by the Contractor or his/her construction equipment shall be replaced as soon as possible by the Contractor to ensure proper guidance for the motorists. This will be subsidiary to Item 502.

**GENERAL NOTES FOR WORK ZONE SIGNS**

1. Contractor shall install and maintain signs in a straight and plumb condition and/or as directed by the Engineer.
  2. Wooden sign posts shall be painted white.
  3. Barricades shall NOT be used as sign supports.
  4. All signs shall be installed in accordance with the plans or as directed by the Engineer. Signs shall be used to regulate, warn, and guide the traveling public safely through the work zone.
  5. The Contractor may furnish either the sign design shown in the plans or in the "Standard Highway Sign Designs for Texas" (SHSD). The Engineer/Inspector may require the Contractor to furnish other work zone signs that are shown in the TMUTCD but may have been omitted from the plans. Any variation in the plans shall be documented by written agreement between the Engineer and the Contractor's Responsible Person. All changes must be documented in writing before being implemented. This can include documenting the changes in the Inspector's TxDOT diary and having both the Inspector and Contractor initial and date the agreed upon changes.
  6. The Contractor shall furnish sign supports listed in the "Compliant Work Zone Traffic Control Device List" (CWZTCD). The Contractor shall install the sign support in accordance with the manufacturer's recommendations. If there is a question regarding installation procedures, the Contractor shall furnish the Engineer a copy of the manufacturer's installation recommendations so the Engineer can verify the correct procedures are being followed.
  7. The Contractor is responsible for installing signs on approved supports and replacing signs with damaged or cracked substrates and/or damaged or marred reflective sheeting as directed by the Engineer/Inspector.
  8. Identification markings may be shown only on the back of the sign substrate. The maximum height of letters and/or company logos used for identification shall be 1 inch.
  9. The Contractor shall replace damaged wood posts. New or damaged wood sign posts shall not be spliced.
- DURATION OF WORK (as defined by the "Texas Manual on Uniform Traffic Control Devices" Part 6)**
1. The types of sign supports, sign mounting height, the size of signs, and the type of sign substrates can vary based on the type of work being performed. The Engineer is responsible for selecting the appropriate size sign for the type of work being performed. The Contractor is responsible for ensuring the sign support, sign mounting height and substrate meets manufacturer's recommendations in regard to crashworthiness and duration of work requirements.
    - a. Long-term stationary - work that occupies a location more than 3 days.
    - b. Intermediate-term stationary - work that occupies a location more than one daylight period up to 3 days, or nighttime work lasting more than one hour.
    - c. Short-term stationary - daytime work that occupies a location for more than 1 hour in a single daylight period.
    - d. Short, duration - work that occupies a location up to 1 hour.
    - e. Mobile - work that moves continuously or intermittently (stopping for up to approximately 15 minutes.)

**SIGN MOUNTING HEIGHT**

1. The bottom of Long-term/Intermediate-term signs shall be at least 7 feet, but not more than 9 feet, above the paved surface, except as shown for supplemental plaques mounted below other signs.
2. The bottom of Short-term/Short Duration signs shall be a minimum of 1 foot above the pavement surface but no more than 2 feet above the ground.
3. Long-term/Intermediate-term Signs may be used in lieu of Short-term/Short Duration signing.
4. Short-term/Short Duration signs shall be used only during daylight and shall be removed at the end of the workday or raised to appropriate Long-term/Intermediate sign height.
5. Regulatory signs shall be mounted at least 7 feet, but not more than 9 feet, above the paved surface regardless of work duration.

**SIZE OF SIGNS**

1. The Contractor shall furnish the sign sizes shown on BC (2) unless otherwise shown in the plans or as directed by the Engineer.

**SIGN SUBSTRATES**

1. The Contractor shall ensure the sign substrate is installed in accordance with the manufacturer's recommendations for the type of sign support that is being used. The CWZTCD lists each substrate that can be used on the different types and models of sign supports.
2. "Mesh" type materials are NOT an approved sign substrate, regardless of the tightness of the weave.
3. All wooden individual sign panels fabricated from 2 or more pieces shall have one or more plywood cleat, 1/2" thick by 6" wide, fastened to the back of the sign and extending fully across the sign. The cleat shall be attached to the back of the sign using wood screws that do not penetrate the face of the sign panel. The screws shall be placed on both sides of the splice and spaced at 6" centers. The Engineer may approve other methods of splicing the sign face.

**REFLECTIVE SHEETING**

1. All signs shall be retroreflective and constructed of sheeting meeting the color and retro-reflectivity requirements of DMS-8300 for rigid signs or DMS-8310 for roll-up signs. The web address for DMS specifications is shown on BC(1).
2. White sheeting, meeting the requirements of DMS-8300 Type A, shall be used for signs with a white background.
3. Orange sheeting, meeting the requirements of DMS-8300 Type B<sub>FL</sub> or Type C<sub>FL</sub>, shall be used for rigid signs with orange backgrounds.

**SIGN LETTERS**

1. All sign letters and numbers shall be clear, and open rounded type uppercase alphabet letters as approved by the Federal Highway Administration (FHWA) and as published in the "Standard Highway Sign Design for Texas" manual. Signs, letters and numbers shall be of first class workmanship in accordance with Department Standards and Specifications.

**REMOVING OR COVERING**

1. When sign messages may be confusing or do not apply, the signs shall be removed or completely covered.
2. Long-term stationary or intermediate stationary signs installed on square metal tubing may be turned away from traffic 90 degrees when the sign message is not applicable. This technique may not be used for signs installed in the median of divided highways or near any intersections where the sign may be seen from approaching traffic.
3. Signs installed on wooden skids shall not be turned at 90 degree angles to the roadway. These signs should be removed or completely covered when not required.
4. When signs are covered, the material used shall be opaque, such as heavy mil black plastic, or other materials which will cover the entire sign face and maintain their opaque properties under automobile headlights at night, without damaging the sign sheeting.
5. Burlap shall NOT be used to cover signs.
6. Duct tape or other adhesive material shall NOT be affixed to a sign face.
7. Signs and anchor stubs shall be removed and holes backfilled upon completion of work.

**SIGN SUPPORT WEIGHTS**

1. Where sign supports require the use of weights to keep from turning over, the use of sandbags with dry, cohesionless sand should be used.
2. The sandbags will be tied shut to keep the sand from spilling and to maintain a constant weight.
3. Rock, concrete, iron, steel or other solid objects shall not be permitted for use as sign support weights.
4. Sandbags should weigh a minimum of 35 lbs and a maximum of 50 lbs.
5. Sandbags shall be made of a durable material that tears upon vehicular impact. Rubber (such as tire inner tubes) shall NOT be used.
6. Rubber ballasts designed for channelizing devices should not be used for ballast on portable sign supports. Sign supports designed and manufactured with rubber bases may be used when shown on the CWZTCD list.
7. Sandbags shall only be placed along or laid over the base supports of the traffic control device and shall not be suspended above ground level or hung with rope, wire, chains or other fasteners. Sandbags shall be placed along the length of the skids to weigh down the sign support.
8. Sandbags shall NOT be placed under the skid and shall not be used to level sign supports placed on slopes.

**FLAGS ON SIGNS**

1. Flags may be used to draw attention to warning signs. When used the flag shall be 16 inches square or larger and shall be orange or fluorescent red-orange in color. Flags shall not be allowed to cover any portion of the sign face.




**BARRICADE AND CONSTRUCTION TEMPORARY SIGN NOTES**

**BC (4) - 14**

FILE:	bc-14.dgn	DN:	TxDOT	CR:	TxDOT	OW:	TxDOT	CK:	TxDOT
© TxDOT	November 2002	CONT	SECT	JOB	HIGHWAY				
REVISIONS		6376	34	001	US 69				
9-07	8-14	DIST	COUNTY	SHEET NO.					
7-13		BMT	JEFFERSON	12					


DISCLAIMER: The use of this standard is governed by the "Texas Engineering Practice Act". No warranty of any kind is made by TxDOT for any purpose whatsoever. TxDOT assumes no responsibility for the conversion of this standard to other formats or for incorrect results or damages resulting from its use.

DATE: 2/22/2021 1:44:21 PM  
 FILE: T:\BMT\DESIGN\Projects\0028-13-xxx-IH10-US69-Bear\ing\_RMC\DN\Standards\bc-14.dgn

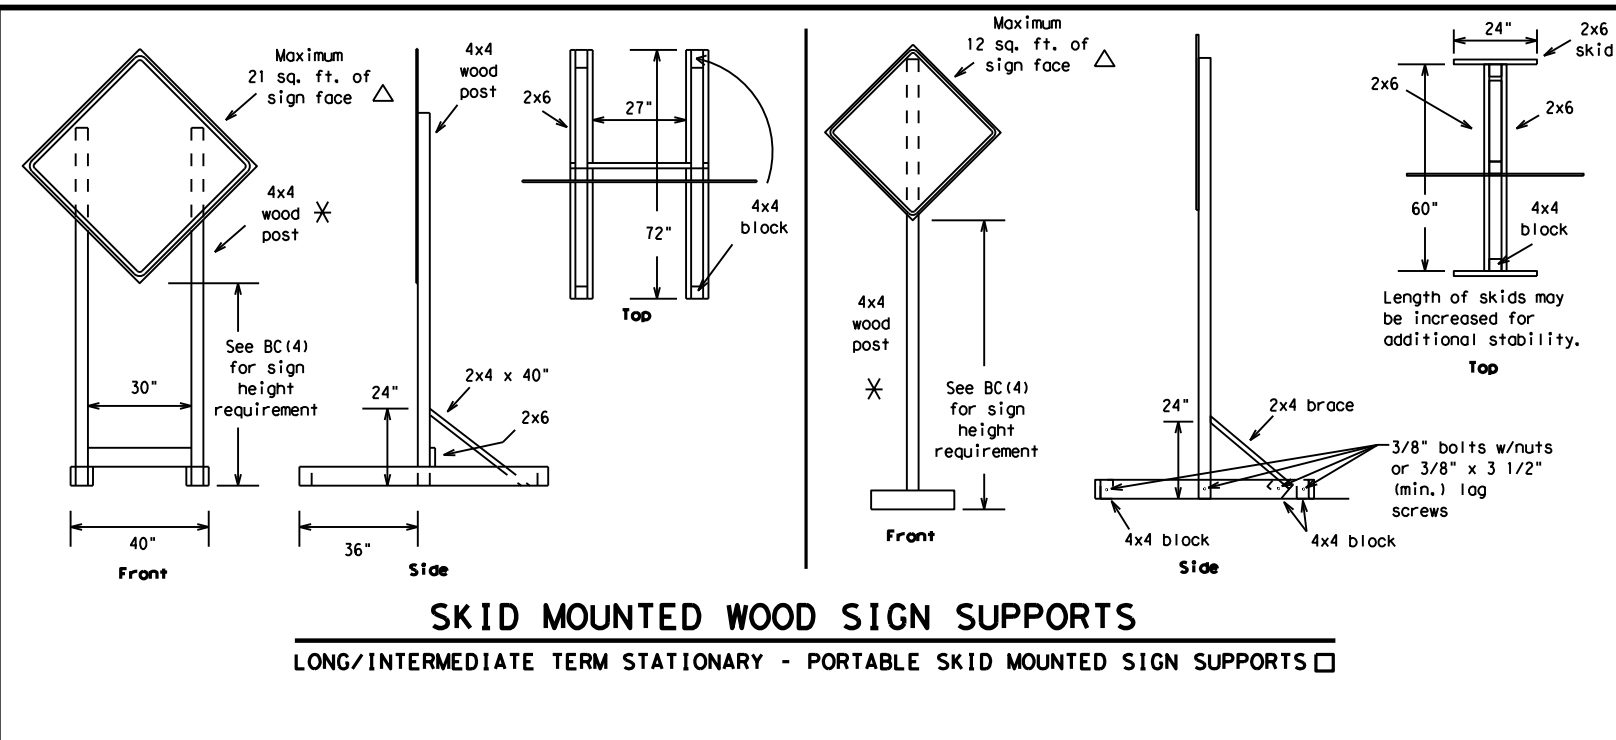


**SKID MOUNTED WOOD SIGN SUPPORTS**

LONG/INTERMEDIATE TERM STATIONARY - PORTABLE SKID MOUNTED SIGN SUPPORTS □

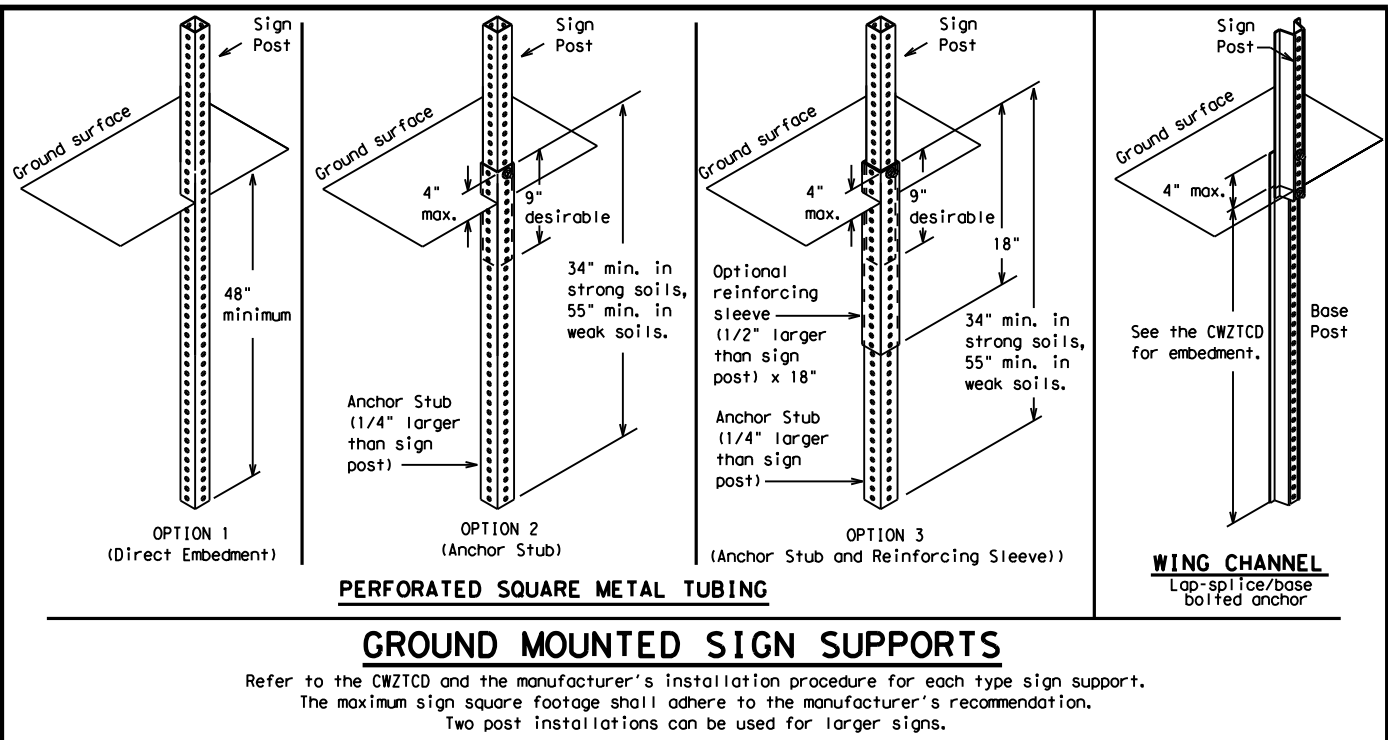


**GROUND MOUNTED SIGN SUPPORTS**

Refer to the CWZTCD and the manufacturer's installation procedure for each type sign support. The maximum sign square footage shall adhere to the manufacturer's recommendation. Two post installations can be used for larger signs.

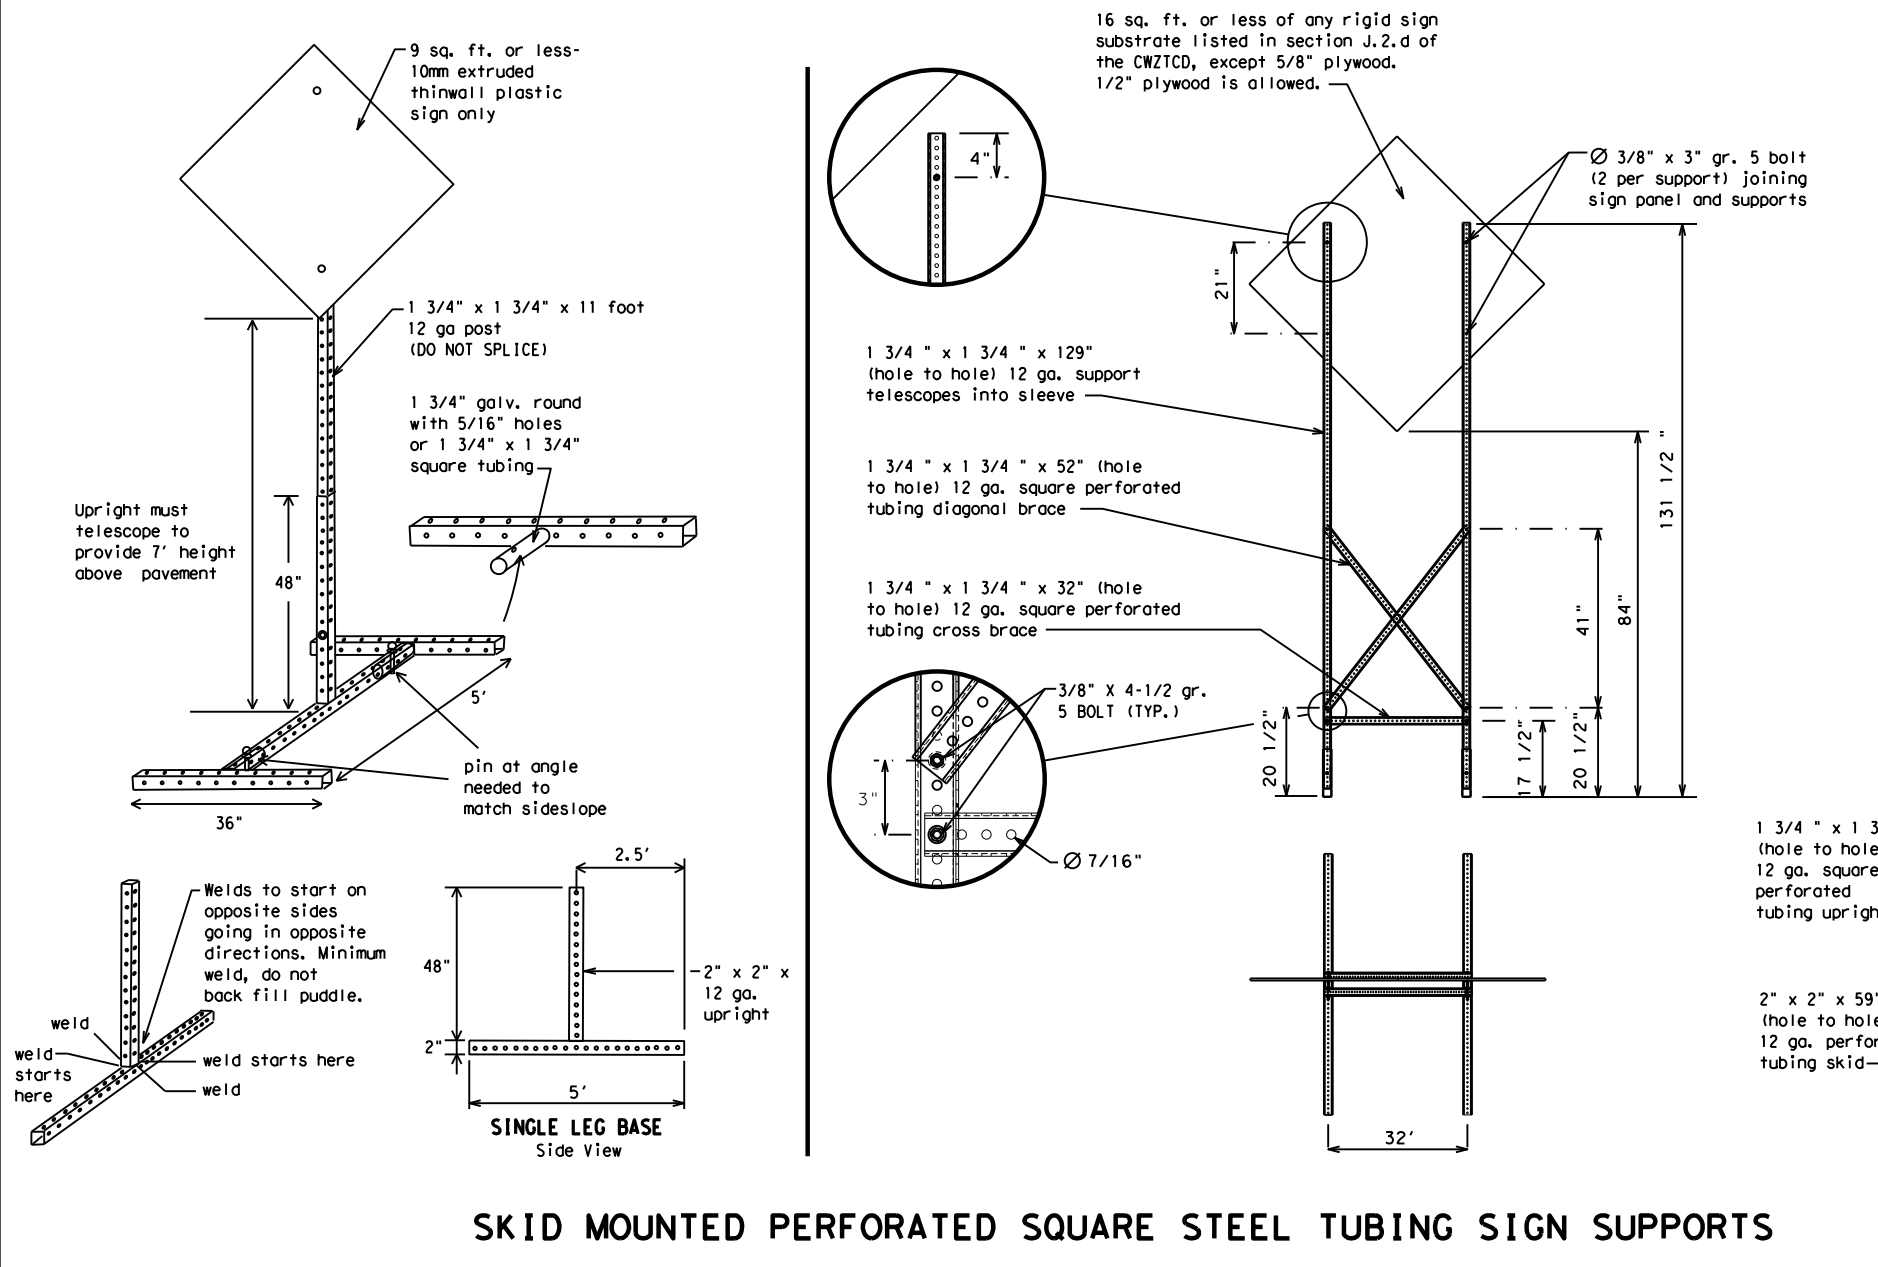


**SKID MOUNTED PERFORATED SQUARE STEEL TUBING SIGN SUPPORTS**

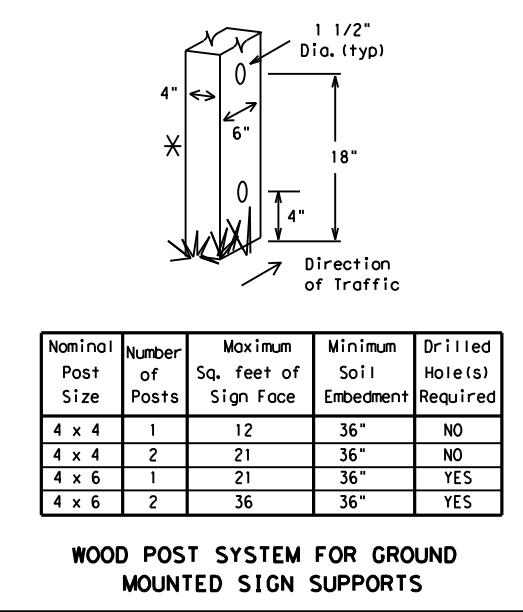


**WOOD POST SYSTEM FOR GROUND MOUNTED SIGN SUPPORTS**

Nominal Post Size	Number of Posts	Maximum Sq. feet of Sign Face	Minimum Soil Embedment	Drilled Holes(s) Required
4 x 4	1	12	36"	NO
4 x 4	2	21	36"	NO
4 x 6	1	21	36"	YES
4 x 6	2	36	36"	YES

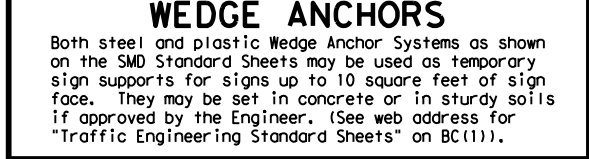

**WEDGE ANCHORS**

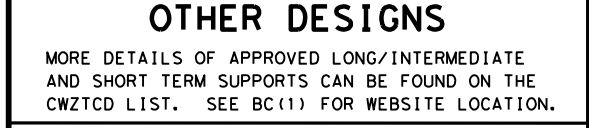

**OTHER DESIGNS**

- GENERAL NOTES**
- Nails may be used in the assembly of wooden sign supports, but 3/8" bolts with nuts or 3/8" x 3 1/2" lag screws must be used on every joint for final connection.
  - No more than 2 sign posts shall be placed within a 7 ft. circle, except for specific materials noted on the CWZTCD List.
  - When project is completed, all sign supports and foundations shall be removed from the project site. This will be considered subsidiary to Item 502.

- See BC(4) for definition of "Work Duration."
- ✱ Wood sign posts MUST be one piece. Splicing will NOT be allowed. Posts shall be painted white.
- △ See the CWZTCD for the type of sign substrate that can be used for each approved sign support.

SHEET 5 OF 12

Traffic Operations Division Standard

**BARRICADE AND CONSTRUCTION TYPICAL SIGN SUPPORT**

**BC(5) - 14**

FILE: bc-14.dgn	DN: TxDOT	CK: TxDOT	DW: TxDOT	CR: TxDOT
© TxDOT November 2002	CONT	SECT	JOB	HIGHWAY
REVISIONS	6376	34	001	US 69
9-07 8-14	DIST	COUNTY	SHEET NO.	
7-13	BMT	JEFFERSON	13	

WHEN NOT IN USE, REMOVE THE PCMS FROM THE RIGHT-OF-WAY OR PLACE THE PCMS BEHIND BARRIER OR GUARDRAIL WITH SIGN PANEL TURNED PARALLEL TO TRAFFIC

# RECOMMENDED PHASES AND FORMATS FOR PCMS MESSAGES DURING ROADWORK ACTIVITIES

(The Engineer may approve other messages not specifically covered here.)

## PORTABLE CHANGEABLE MESSAGE SIGNS

- The Engineer/Inspector shall approve all messages used on portable changeable message signs (PCMS).
- Messages on PCMS should contain no more than 8 words (about four to eight characters per word), not including simple words such as "TO," "FOR," "AT," etc.
- Messages should consist of a single phase, or two phases that alternate. Three-phase messages are not allowed. Each phase of the message should convey a single thought, and must be understood by itself.
- Use the word "EXIT" to refer to an exit ramp on a freeway; i.e., "EXIT CLOSED." Do not use the term "RAMP."
- Always use the route or interstate designation (IH, US, SH, FM) along with the number when referring to a roadway.
- When in use the bottom of a stationary PCMS message panel should be a minimum 7 feet above the roadway, where possible.
- The message term "WEEKEND" should be used only if the work is to start on Saturday morning and end by Sunday evening at midnight. Actual days and hours of work should be displayed on the PCMS if work is to begin on Friday evening and/or continue into Monday morning.
- The Engineer/Inspector may select one of two options which are available for displaying a two-phase message on a PCMS. Each phase may be displayed for either four seconds each or for three seconds each.
- Do not "flash" messages or words included in a message. The message should be steady burn or continuous while displayed.
- Do not present redundant information on a two-phase message; i.e., keeping two lines of the message the same and changing the third line.
- Do not use the word "Danger" in message.
- Do not display the message "LANES SHIFT LEFT" or "LANES SHIFT RIGHT" on a PCMS. Drivers do not understand the message.
- Do not display messages that scroll horizontally or vertically across the face of the sign.
- The following table lists abbreviated words and two-word phrases that are acceptable for use on a PCMS. Both words in a phrase must be displayed together. Words or phrases not on this list should not be abbreviated, unless shown in the TMUTCD.
- PCMS character height should be at least 18 inches for trailer mounted units. They should be visible from at least 1/2 (.5) mile and the text should be legible from at least 600 feet at night and 800 feet in daylight. Truck mounted units must have a character height of 10 inches and must be legible from at least 400 feet.
- Each line of text should be centered on the message board rather than left or right justified.
- If disabled, the PCMS should default to an illegible display that will not alarm motorists and will only be used to alert workers that the PCMS has malfunctioned. A pattern such as a series of horizontal solid bars is appropriate.

DISCLAIMER: The use of this standard is governed by the "Texas Engineering Practice Act". No warranty of any kind is made by TxDOT for any purpose whatsoever. TxDOT assumes no responsibility for the conversion of this standard to other formats or for incorrect results or damages resulting from its use.

DATE: 2/22/2021 1:44:26 PM  
FILE: T:\BMT\DESIGN\Projects\0028-13-xxx-IH10-US69-Bear-Ing-RMC\DN\Standards\bc-14.dgn

WORD OR PHRASE	ABBREVIATION	WORD OR PHRASE	ABBREVIATION
Access Road	ACCS RD	Major	MAJ
Alternate	ALT	Miles	MI
Avenue	AVE	Miles Per Hour	MPH
Best Route	BEST RTE	Minor	MNR
Boulevard	BLVD	Monday	MON
Bridge	BRDG	Normal	NORM
Canal	CANT	North	N
Center	CTR	Northbound	(route) N
Construction Ahead	CONST AHD	Parking	PKING
CROSSING	XING	Road	RD
Detour Route	DETOUR RTE	Right Lane	RT LN
Do Not	DONT	Saturday	SAT
East	E	Service Road	SERV RD
Eastbound	(route) E	Shoulder	SHLDR
Emergency	EMER	Slippery	SLIP
Emergency Vehicle	EMER VEH	South	S
Entrance, Enter	ENT	Southbound	(route) S
Express Lane	EXP LN	Speed	SPD
Expressway	EXPWY	Street	ST
XXXX Feet	XXXX FT	Sunday	SUN
Fog Ahead	FOG AHD	Telephone	PHONE
Freeway	FRWY, FWY	Temporary	TEMP
Freeway Blocked	FWY BLKD	Thursday	THURS
Friday	FRI	To Downtown	TO DWNTN
Hazardous Driving	HAZ DRIVING	Traffic	TRAF
Hazardous Material	HAZMAT	Travelers	TRVLR
High-Occupancy Vehicle	HOV	Tuesday	TUES
Highway	HWY	Time Minutes	TIME MIN
Hour(s)	HR, HRS	Upper Level	UPR LEVEL
Information	INFO	Vehicles (s)	VEH, VEHS
It Is	ITS	Warning	WARN
Junction	JCT	Wednesday	WED
Left	LFT	Weight Limit	WT LIMIT
Left Lane	LFT LN	West	W
Lane Closed	LN CLOSED	Westbound	(route) W
Lower Level	LWR LEVEL	Wet Pavement	WET PVMT
Maintenance	MAINT	Will Not	WONT

Roadway designation # IH-number, US-number, SH-number, FM-number

## Phase 1: Condition Lists

Road/Lane/Ramp Closure List		Other Condition List	
FREEWAY CLOSED X MILE	FRONTAGE ROAD CLOSED	ROADWORK XXX FT	ROAD REPAIRS XXXX FT
ROAD CLOSED AT SH XXX	SHOULDER CLOSED XXX FT	FLAGGER XXXX FT	LANE NARROWS XXXX FT
ROAD CLSD AT FM XXXX	RIGHT LN CLOSED XXX FT	RIGHT LN NARROWS XXXX FT	TWO-WAY TRAFFIC XX MILE
RIGHT X LANES CLOSED	RIGHT X LANES OPEN	MERGING TRAFFIC XXXX FT	CONST TRAFFIC XXX FT
CENTER LANE CLOSED	DAYTIME LANE CLOSURES	LOOSE GRAVEL XXXX FT	UNEVEN LANES XXXX FT
NIGHT LANE CLOSURES	I-XX SOUTH EXIT CLOSED	DETOUR X MILE	ROUGH ROAD XXXX FT
VARIOUS LANES CLOSED	EXIT XXX CLOSED X MILE	ROADWORK PAST SH XXXX	ROADWORK NEXT FRI-SUN
EXIT CLOSED	RIGHT LN TO BE CLOSED	BUMP XXXX FT	US XXX EXIT X MILES
MALL DRIVEWAY CLOSED	X LANES CLOSED TUE - FRI	TRAFFIC SIGNAL XXXX FT	LANES SHIFT *
XXXXXXXX BLVD CLOSED			

\* LANES SHIFT in Phase 1 must be used with STAY IN LANE in Phase 2.

## Phase 2: Possible Component Lists

Action to Take/Effect on Travel List	Location List	Warning List	** Advance Notice List
MERGE RIGHT	AT FM XXXX	SPEED LIMIT XX MPH	TUE-FRI XX AM-X PM
DETOUR NEXT X EXITS	BEFORE RAILROAD CROSSING	MAXIMUM SPEED XX MPH	APR XX-XX X PM-X AM
USE EXIT XXX	NEXT X MILES	MINIMUM SPEED XX MPH	BEGINS MONDAY
STAY ON US XXX SOUTH	PAST US XXX EXIT	ADVISORY SPEED XX MPH	BEGINS MAY XX
TRUCKS USE US XXX N	XXXXXXXX TO XXXXXXX	RIGHT LANE EXIT	MAY X-X XX PM-XX AM
WATCH FOR TRUCKS	US XXX TO FM XXXX	USE CAUTION	NEXT FRI-SUN
EXPECT DELAYS		DRIVE SAFELY	XX AM TO XX PM
REDUCE SPEED XXX FT		DRIVE WITH CARE	NEXT TUE AUG XX
USE OTHER ROUTES			TONIGHT XX PM-XX AM
STAY IN LANE *			

\*\* See Application Guidelines Note 6.

### APPLICATION GUIDELINES

- Only 1 or 2 phases are to be used on a PCMS.
- The 1st phase (or both) should be selected from the "Road/Lane/Ramp Closure List" and the "Other Condition List".
- A 2nd phase can be selected from the "Action to Take/Effect on Travel, Location, General Warning, or Advance Notice Phase Lists".
- A Location Phase is necessary only if a distance or location is not included in the first phase selected.
- If two PCMS are used in sequence, they must be separated by a minimum of 1000 ft. Each PCMS shall be limited to two phases, and should be understandable by themselves.
- For advance notice, when the current date is within seven days of the actual work date, calendar days should be replaced with days of the week. Advance notification should typically be for no more than one week prior to the work.

### WORDING ALTERNATIVES

- The words RIGHT, LEFT and ALL can be interchanged as appropriate.
- Roadway designations IH, US, SH, FM and LP can be interchanged as appropriate.
- EAST, WEST, NORTH and SOUTH (or abbreviations E, W, N and S) can be interchanged as appropriate.
- Highway names and numbers replaced as appropriate.
- ROAD, HIGHWAY and FREEWAY can be interchanged as needed.
- AHEAD may be used instead of distances if necessary.
- FT and MI, MILE and MILES interchanged as appropriate.
- AT, BEFORE and PAST interchanged as needed.
- Distances or AHEAD can be eliminated from the message if a location phase is used.

PCMS SIGNS WITHIN THE R.O.W. SHALL BE BEHIND GUARDRAIL OR CONCRETE BARRIER OR SHALL HAVE A MINIMUM OF FOUR (4) PLASTIC DRUMS PLACED PERPENDICULAR TO TRAFFIC ON THE UPSTREAM SIDE OF THE PCMS, WHEN EXPOSED TO ONE DIRECTION OF TRAFFIC. WHEN EXPOSED TO TWO WAY TRAFFIC, THE FOUR DRUMS SHOULD BE PLACED WITH ONE DRUM AT EACH OF THE FOUR CORNERS OF THE UNIT.

### FULL MATRIX PCMS SIGNS

- When Full Matrix PCMS signs are used, the character height and legibility/visibility requirements shall be maintained as listed in Note 15 under "PORTABLE CHANGEABLE MESSAGE SIGNS" above.
- When symbol signs, such as the "Flagger Symbol" (CW20-7) are represented graphically on the Full Matrix PCMS sign and, with the approval of the Engineer, it shall maintain the legibility/visibility requirement listed above.
- When symbol signs are represented graphically on the Full Matrix PCMS, they shall only supplement the use of the static sign represented, and shall not substitute for, or replace that sign.
- A full matrix PCMS may be used to simulate a flashing arrow board provided it meets the visibility, flash rate and dimming requirements on BC(7), for the same size arrow.

Traffic Operations Division Standard

## BARRICADE AND CONSTRUCTION PORTABLE CHANGEABLE MESSAGE SIGN (PCMS)


### BC (6) - 14

FILE: bc-14.dgn	DN: TxDOT	CR: TxDOT	DW: TxDOT	CK: TxDOT
© TxDOT November 2002	CONT	SECT	JOB	HIGHWAY
REVISIONS	6376	34	001	US 69
9-07 8-14	DIST	COUNTY	SHEET NO.	
7-13	BMT	JEFFERSON	14	

DISCLAIMER: The use of this standard is governed by the "Texas Engineering Practice Act". No warranty of any kind is made by TxDOT for any purpose whatsoever. TxDOT assumes no responsibility for the conversion of this standard to other formats or for incorrect results or damages resulting from its use.


DATE: 2/22/2021 1:44:32 PM  
 FILE: T:\BMT\DESIGN\Projects\0028-13-xxx\_IH10-US69\_Bear\_Ing\_RMC\DCN\Standards\bc-14.dgn

- Barrier Reflectors shall be pre-qualified, and conform to the color and reflectivity requirements of DMS-8600. A list of prequalified Barrier Reflectors can be found at the Material Producer List web address shown on BC(1).
- Color of Barrier Reflectors shall be as specified in the TMUTCD. The cost of the reflectors shall be considered subsidiary to Item 512.

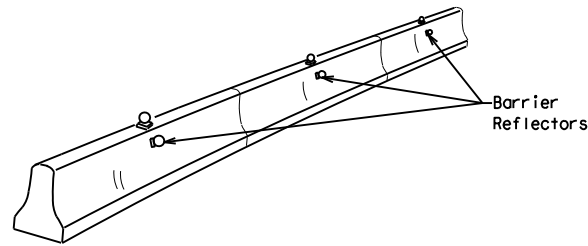


**CONCRETE TRAFFIC BARRIER (CTB)**

- Where traffic is on one side of the CTB, two (2) Barrier Reflectors shall be mounted in approximately the midsection of each section of CTB. An alternate mounting location is uniformly spaced at one end of each CTB. This will allow for attachment of a barrier grapple without damaging the reflector. The Barrier Reflector mounted on the side of the CTB shall be located directly below the reflector mounted on top of the barrier, as shown in the detail above.
- Where CTB separates two-way traffic, three barrier reflectors shall be mounted on each section of CTB. The reflector unit on top shall have two yellow reflective faces (Bi-Directional) while the reflectors on each side of the barrier shall have one yellow reflective face, as shown in the detail above.
- When CTB separates traffic traveling in the same direction, no barrier reflectors will be required on top of the CTB.
- Barrier Reflector units shall be yellow or white in color to match the edgeline being supplemented.
- Maximum spacing of Barrier Reflectors is forty (40) feet.
- Pavement markers or temporary flexible-reflective roadway marker tabs shall NOT be used as CTB delineation.
- Attachment of Barrier Reflectors to CTB shall be per manufacturer's recommendations.
- Missing or damaged Barrier Reflectors shall be replaced as directed by the Engineer.
- Single slope barriers shall be delineated as shown on the above detail.

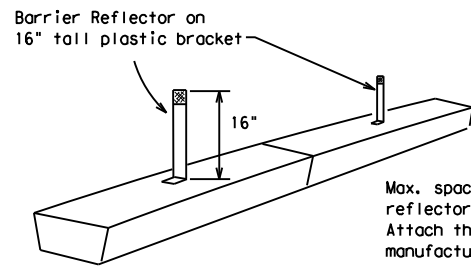

**LOW PROFILE CONCRETE BARRIER (LPCB)**

Max. spacing of barrier reflectors is 20 feet. Attach the delineators as per manufacturer's recommendations.

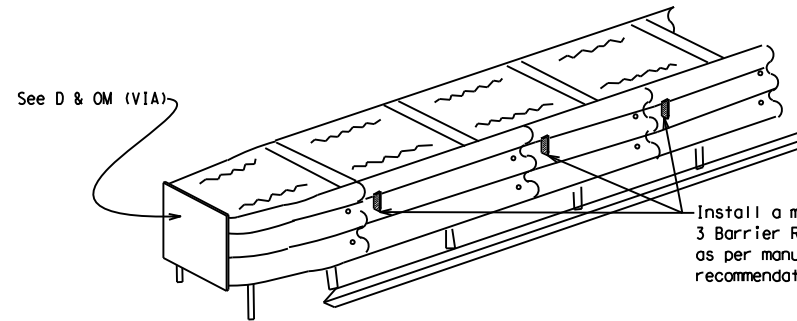

**DELINEATION OF END TREATMENTS**

**END TREATMENTS FOR CTB'S USED IN WORK ZONES**

End treatments used on CTB's in work zones shall meet crashworthy standards as defined in the National Cooperative Highway Research Report 350. Refer to the CWZTCD List for approved end treatments and manufacturers.

**BARRIER REFLECTORS FOR CONCRETE TRAFFIC BARRIER AND ATTENUATORS**

**WARNING LIGHTS**


- Warning lights shall meet the requirements of the TMUTCD.
- Warning lights shall NOT be installed on barricades.
- Type A-Low Intensity Flashing Warning Lights are commonly used with drums. They are intended to warn of or mark a potentially hazardous area. Their use shall be as indicated on this sheet and/or other sheets of the plans by the designation "FL". The Type A Warning Lights shall not be used with signs manufactured with Type B<sub>FL</sub> or C<sub>FL</sub> Sheeting meeting the requirements of Departmental Material Specification DMS-8300.
- Type-C and Type D 360 degree Steady Burn Lights are intended to be used in a series for delineation to supplement other traffic control devices. Their use shall be as indicated on this sheet and/or other sheets of the plans by the designation "SB".
- The Engineer/Inspector or the plans shall specify the location and type of warning lights to be installed on the traffic control devices.
- When required by the Engineer, the Contractor shall furnish a copy of the warning lights certification. The warning light manufacturer will certify the warning lights meet the requirements of the latest ITE Purchase Specifications for Flashing and Steady-Burn Warning Lights.
- When used to delineate curves, Type-C and Type D Steady Burn Lights should only be placed on the outside of the curve, not the inside. The location of warning lights and warning reflectors on drums shall be as shown elsewhere in the plans.

**WARNING LIGHTS MOUNTED ON PLASTIC DRUMS**


- Type A flashing warning lights are intended to warn drivers that they are approaching or are in a potentially hazardous area.
- Type A random flashing warning lights are not intended for delineation and shall not be used in a series.
- A series of sequential flashing warning lights placed on channelizing devices to form a merging taper may be used for delineation. If used, the successive flashing of the sequential warning lights should occur from the beginning of the taper to the end of the merging taper in order to identify the desired vehicle path. The rate of flashing for each light shall be 65 flashes per minute, plus or minus 10 flashes.
- Type C and D steady-burn warning lights are intended to be used in a series to delineate the edge of the travel lane on detours, on lane changes, on lane closures, and on other similar conditions.
- Type A, Type C and Type D warning lights shall be installed at locations as detailed on other sheets in the plans.
- Warning lights shall not be installed on a drum that has a sign, chevron or vertical panel.
- The maximum spacing for warning lights on drums should be identical to the channelizing device spacing.

**WARNING REFLECTORS MOUNTED ON PLASTIC DRUMS AS A SUBSTITUTE FOR TYPE C (STEADY BURN) WARNING LIGHTS**

- A warning reflector or approved substitute may be mounted on a plastic drum as a substitute for a Type C, steady burn warning light at the discretion of the Contractor unless otherwise noted in the plans.
- The warning reflector shall be yellow in color and shall be manufactured using a sign substrate approved for use with plastic drums listed on the CWZTCD.
- The warning reflector shall have a minimum retroreflective surface area (one-side) of 30 square inches.
- Round reflectors shall be fully reflectorized, including the area where attached to the drum.
- Square substrates must have a minimum of 30 square inches of reflectorized sheeting. They do not have to be reflectorized where it attaches to the drum.
- The side of the warning reflector facing approaching traffic shall have sheeting meeting the color and retroreflectivity requirements for DMS 8300-Type B or Type C.
- When used near two-way traffic, both sides of the warning reflector shall be reflectorized.
- The warning reflector should be mounted on the side of the handle nearest approaching traffic.
- The maximum spacing for warning reflectors should be identical to the channelizing device spacing requirements.

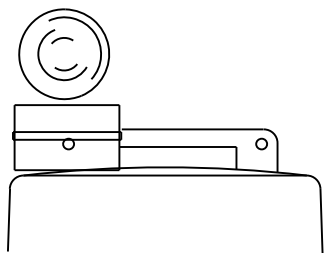


Type C Warning Light or approved substitute mounted on a drum adjacent to the travel way.

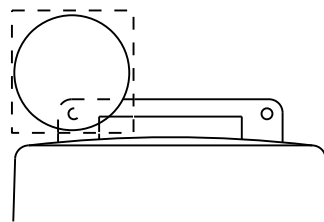

Warning reflector may be round or square. Must have a yellow reflective surface area of at least 30 square inches

Arrow Boards may be located behind channelizing devices in place for a shoulder taper or merging taper, otherwise they shall be delineated with four (4) channelizing devices placed perpendicular to traffic on the upstream side of traffic.

- The Flashing Arrow Board should be used for all lane closures on multi-lane roadways, or slow moving maintenance or construction activities on the travel lanes.
- Flashing Arrow Boards should not be used on two-lane, two-way roadways, detours, diversions or work on shoulders unless the "CAUTION" display (see detail below) is used.
- The Engineer/Inspector shall choose all appropriate signs, barricades and/or other traffic control devices that should be used in conjunction with the Flashing Arrow Board.
- The Flashing Arrow Board should be able to display the following symbols:

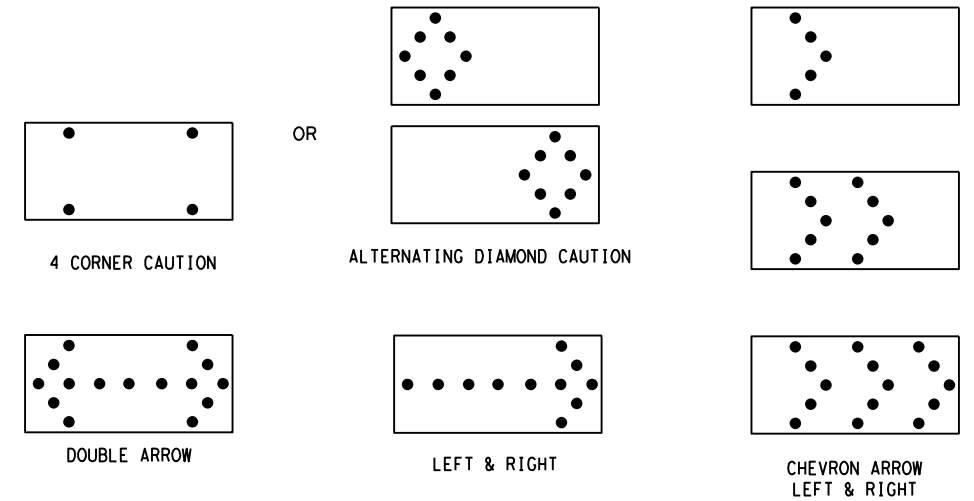

- The "CAUTION" display consists of four corner lamps flashing simultaneously, or the Alternating Diamond Caution mode as shown.
- The straight line caution display is NOT ALLOWED.
- The Flashing Arrow Board shall be capable of minimum 50 percent dimming from rated lamp voltage. The flashing rate of the lamps shall not be less than 25 nor more than 40 flashes per minute.
- Minimum lamp "on time" shall be approximately 50 percent for the flashing arrow and equal intervals of 25 percent for each sequential phase of the flashing chevron.
- The sequential arrow display is NOT ALLOWED.
- The flashing arrow display is the TxDOT standard; however, the sequential Chevron display may be used during daylight operations.
- The Flashing Arrow Board shall be mounted on a vehicle, trailer or other suitable support.
- A Flashing Arrow Board SHALL NOT BE USED to laterally shift traffic.
- A full matrix PCMS may be used to simulate a Flashing Arrow Board provided it meets visibility, flash rate and dimming requirements on this sheet for the same size arrow.
- Minimum mounting height of trailer mounted Arrow Boards should be 7 feet from roadway to bottom of panel.

REQUIREMENTS			
TYPE	MINIMUM SIZE	MINIMUM NUMBER OF PANEL LAMPS	MINIMUM VISIBILITY DISTANCE
B	30 x 60	13	3/4 mile
C	48 x 96	15	1 mile

**ATTENTION**  
 Flashing Arrow Boards shall be equipped with automatic dimming devices.

WHEN NOT IN USE, REMOVE THE ARROW BOARD FROM THE RIGHT-OF-WAY OR PLACE THE ARROW BOARD BEHIND CONCRETE TRAFFIC BARRIER OR GUARDRAIL.

**FLASHING ARROW BOARDS**

SHEET 7 OF 12

**TRUCK-MOUNTED ATTENUATORS**

- Truck-mounted attenuators (TMA) used on TxDOT facilities must meet the requirements outlined in the National Cooperative Highway Research Report No. 350 (NCHRP 350) or the Manual for Assessing Safety Hardware (MASH).
- Refer to the CWZTCD for the requirements of Level 2 or Level 3 TMAs.
- Refer to the CWZTCD for a list of approved TMAs.
- TMAs are required on freeways unless otherwise noted in the plans.
- A TMA should be used anytime that it can be positioned 30 to 100 feet in advance of the area of crew exposure without adversely affecting the work performance.
- The only reason a TMA should not be required is when a work area is spread down the roadway and the work crew is an extended distance from the TMA.



**BARRICADE AND CONSTRUCTION ARROW PANEL, REFLECTORS, WARNING LIGHTS & ATTENUATOR**

**BC (7) - 14**

FILE:	bc-14.dgn	DN:	TxDOT	CR:	TxDOT	DW:	TxDOT	CK:	TxDOT
© TxDOT	November 2002	CONT	SECT	JOB	HIGHWAY				
REVISIONS		6376	34	001	US 69				
9-07	8-14	DIST	COUNTY		SHEET NO.				
7-13		BMT	JEFFERSON		15				

DISCLAIMER: The use of this standard is governed by the "Texas Engineering Practice Act". No warranty of any kind is made by TxDOT for any purpose whatsoever. TxDOT assumes no responsibility for the conversion of this standard to other formats or for incorrect results or damages resulting from its use.

DATE: 2/22/2021 1:44:36 PM  
 FILE: T:\BMTDESIGN\Projects\02028-13-xxx\_IH10-US69\_Bear\_Ing\_RMC\DNVStandards\bc-14.dgn

**GENERAL NOTES**

- For long term stationary work zones on freeways, drums shall be used as the primary channelizing device.
- For intermediate term stationary work zones on freeways, drums should be used as the primary channelizing device but may be replaced in tangent sections by vertical panels, or 42" two-piece cones. In tangent sections one-piece cones may be used with the approval of the Engineer but only if personnel are present on the project at all times to maintain the cones in proper position and location.
- For short term stationary work zones on freeways, drums are the preferred channelizing device but may be replaced in tapers, transitions and tangent sections by vertical panels, two-piece cones or one-piece cones as approved by the Engineer.
- Drums and all related items shall comply with the requirements of the current version of the "Texas Manual on Uniform Traffic Control Devices" (TMUTCD) and the "Compliant Work Zone Traffic Control Devices List" (CWZTCD).
- Drums, bases, and related materials shall exhibit good workmanship and shall be free from objectionable marks or defects that would adversely affect their appearance or serviceability.
- The Contractor shall have a maximum of 24 hours to replace any plastic drums identified for replacement by the Engineer/Inspector. The replacement device must be an approved device.

**GENERAL DESIGN REQUIREMENTS**

Pre-qualified plastic drums shall meet the following requirements:


- Plastic drums shall be a two-piece design; the "body" of the drum shall be the top portion and the "base" shall be the bottom.
- The body and base shall lock together in such a manner that the body separates from the base when impacted by a vehicle traveling at a speed of 20 MPH or greater but prevents accidental separation due to normal handling and/or air turbulence created by passing vehicles.
- Plastic drums shall be constructed of lightweight flexible, and deformable materials. The Contractor shall NOT use metal drums or single piece plastic drums as channelization devices or sign supports.
- Drums shall present a profile that is a minimum of 18 inches in width at the 36 inch height when viewed from any direction. The height of drum unit (body installed on base) shall be a minimum of 36 inches and a maximum of 42 inches.
- The top of the drum shall have a built-in handle for easy pickup and shall be designed to drain water and not collect debris. The handle shall have a minimum of two widely spaced 9/16 inch diameter holes to allow attachment of a warning light, warning reflector unit or approved compliant sign.
- The exterior of the drum body shall have a minimum of four alternating orange and white retroreflective circumferential stripes not less than 4 inches nor greater than 8 inches in width. Any non-reflectORIZED space between any two adjacent stripes shall not exceed 2 inches in width.
- Bases shall have a maximum width of 36 inches, a maximum height of 4 inches, and a minimum of two footholds of sufficient size to allow base to be held down while separating the drum body from the base.
- Plastic drums shall be constructed of ultra-violet stabilized, orange, high-density polyethylene (HDPE) or other approved material.
- Drum body shall have a maximum unballasted weight of 11 lbs.
- Drum and base shall be marked with manufacturer's name and model number.

**RETROREFLECTIVE SHEETING**


- The stripes used on drums shall be constructed of sheeting meeting the color and retroreflectivity requirements of Departmental Materials Specification DMS-8300, "Sign Face Materials." Type A reflective sheeting shall be supplied unless otherwise specified in the plans.
- The sheeting shall be suitable for use on and shall adhere to the drum surface such that, upon vehicular impact, the sheeting shall remain adhered in-place and exhibit no delaminating, cracking, or loss of retroreflectivity other than that loss due to abrasion of the sheeting surface.

**BALLAST**

- Unballasted bases shall be large enough to hold up to 50 lbs. of sand. This base, when filled with the ballast material, should weigh between 35 lbs (minimum) and 50 lbs (maximum). The ballast may be sand in one to three sandbags separate from the base, sand in a sand-filled plastic base, or other ballasting devices as approved by the Engineer. Stacking of sandbags will be allowed, however height of sandbags above pavement surface may not exceed 12 inches.
- Bases with built-in ballast shall weigh between 40 lbs. and 50 lbs. Built-in ballast can be constructed of an integral crumb rubber base or a solid rubber base.
- Recycled truck tire sidewalls may be used for ballast on drums approved for this type of ballast on the CWZTCD list.
- The ballast shall not be heavy objects, water, or any material that would become hazardous to motorists, pedestrians, or workers when the drum is struck by a vehicle.
- When used in regions susceptible to freezing, drums shall have drainage holes in the bottoms so that water will not collect and freeze becoming a hazard when struck by a vehicle.
- Ballast shall not be placed on top of drums.
- Adhesives may be used to secure base of drums to pavement.

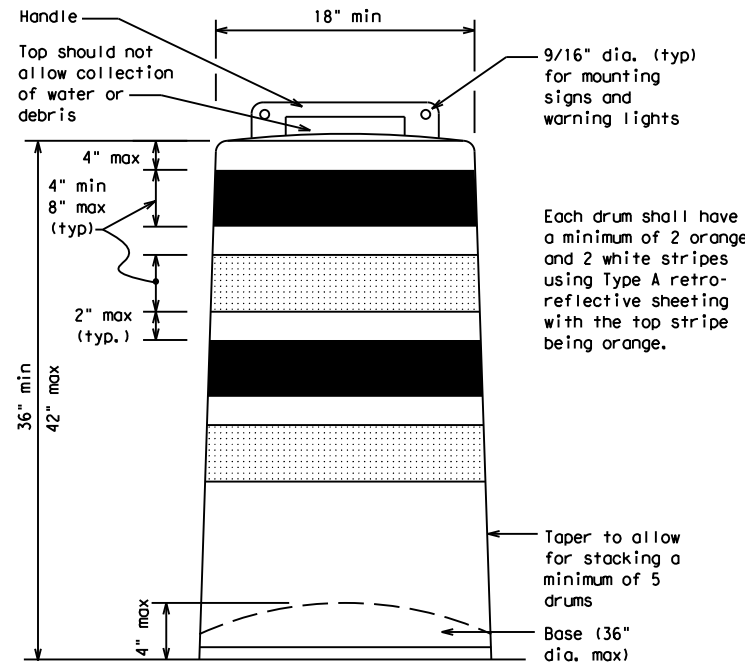


Each drum shall have a minimum of 2 orange and 2 white stripes using Type A retro-reflective sheeting with the top stripe being orange.

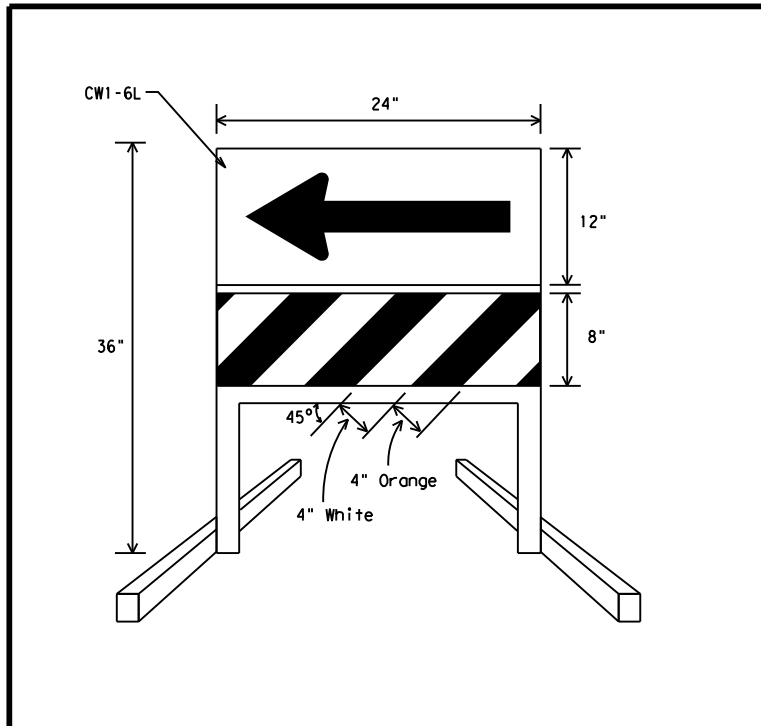


**DIRECTION INDICATOR BARRICADE**

- The Direction Indicator Barricade may be used in tapers, transitions, and other areas where specific directional guidance to drivers is necessary.
- If used, the Direction Indicator Barricade should be used in series to direct the driver through the transition and into the intended travel lane.
- The Direction Indicator Barricade shall consist of One-Direction Large Arrow (CWI-6) sign in the size shown with a black arrow on a background of Type B<sub>FL</sub> or Type C<sub>FL</sub> Orange retroreflective sheeting above a rail with Type A retroreflective sheeting in alternating 4" white and orange stripes sloping downward at an angle of 45 degrees in the direction road users are to pass. Sheetting types shall be as per DMS 8300.
- Double arrows on the Direction Indicator Barricade will not be allowed.
- Approved manufacturers are shown on the CWZTCD List. Ballast shall be as approved by the manufacturers instructions.

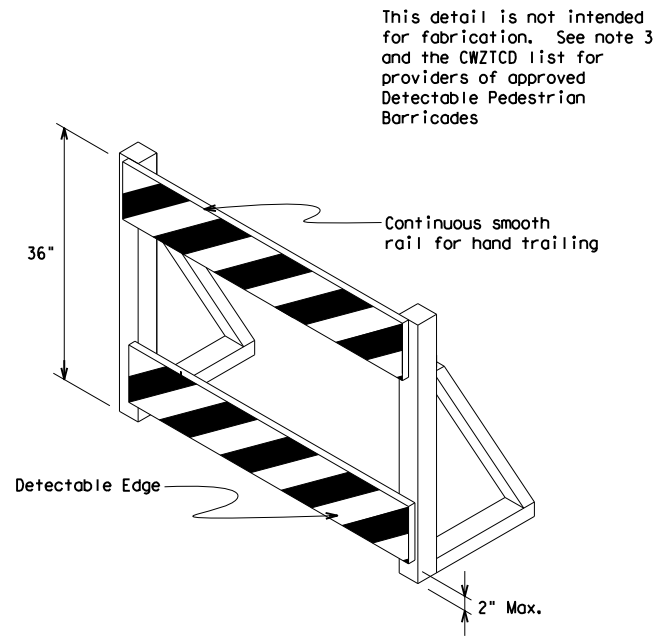

**DETECTABLE PEDESTRIAN BARRICADES**

- When existing pedestrian facilities are disrupted, closed, or relocated in a TTC zone, the temporary facilities shall be detectable and include accessibility features consistent with the features present in the existing pedestrian facility.
- Where pedestrians with visual disabilities normally use the closed sidewalk, a device that is detectable by a person with a visual disability traveling with the aid of a long cane shall be placed across the full width of the closed sidewalk.
- Detectable pedestrian barricades similar to the one pictured above, longitudinal channelizing devices, some concrete barriers, and wood or chain link fencing with a continuous detectable edging can satisfactorily delineate a pedestrian path.
- Tape, rope, or plastic chain strung between devices are not detectable, do not comply with the design standards in the "Americans with Disabilities Act Accessibility Guidelines for Buildings and Facilities (ADAAG)" and should not be used as a control for pedestrian movements.
- Warning lights shall not be attached to detectable pedestrian barricades.
- Detectable pedestrian barricades may use 8" nominal barricade rails as shown on BC(10) provided that the top rail provides a smooth continuous rail suitable for hand trailing with no splinters, burrs, or sharp edges.

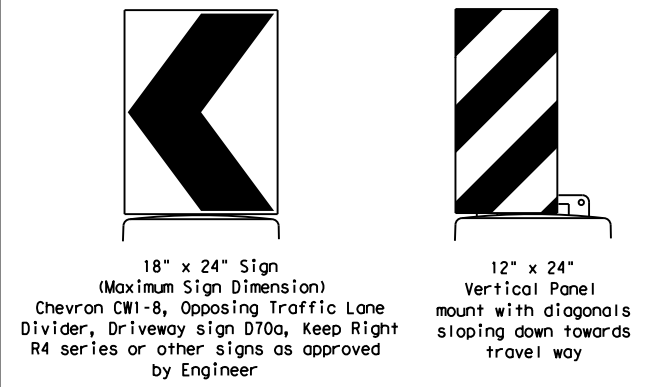

Plywood, Aluminum or Metal sign substrates shall NOT be used on plastic drums

**SIGNS, CHEVRONS, AND VERTICAL PANELS MOUNTED ON PLASTIC DRUMS**

- Signs used on plastic drums shall be manufactured using substrates listed on the CWZTCD.
- Chevrons and other work zone signs with an orange background shall be manufactured with Type B<sub>FL</sub> or Type C<sub>FL</sub> Orange sheeting meeting the color and retroreflectivity requirements of DMS-8300, "Sign Face Material," unless otherwise specified in the plans.
- Vertical Panels shall be manufactured with orange and white sheeting meeting the requirements of DMS-8300 Type A Diagonal stripes on Vertical Panels shall slope down toward the intended traveled lane.
- Other sign messages (text or symbolic) may be used as approved by the Engineer. Sign dimensions shall not exceed 18 inches in width or 24 inches in height, except for the R9 series signs discussed in note 8 below.
- Signs shall be installed using a 1/2 inch bolt (nominal) and nut, two washers, and one locking washer for each connection.
- Mounting bolts and nuts shall be fully engaged and adequately torqued. Bolts should not extend more than 1/2 inch beyond nuts.
- Chevrons may be placed on drums on the outside of curves, on merging tapers or on shifting tapers. When used in these locations they may be placed on every drum or spaced not more than on every third drum. A minimum of three (3) should be used at each location called for in the plans.
- R9-9, R9-10, R9-11 and R9-11a Sidewalk Closed signs which are 24 inches wide may be mounted on plastic drums, with approval of the Engineer.


SHEET 8 OF 12

		Traffic Operations Division Standard	
BARRICADE AND CONSTRUCTION CHANNELIZING DEVICES			
BC (8) - 14			
FILE:	bc-14.dgn	DN:	TxDOT
© TxDOT	November 2002	CR:	TxDOT
REVISIONS		OW:	TxDOT
		CK:	TxDOT
4-03	7-13	CONT	SECT
9-07	8-14	6376	34
		JOB	001
		HIGHWAY	US 69
		DIST	COUNTY
		BMT	JEFFERSON
		SHEET NO.	16




DISCLAIMER: The use of this standard is governed by the "Texas Engineering Practice Act". No warranty of any kind is made by TxDOT for any purpose whatsoever. TxDOT assumes no responsibility for the conversion of this standard to other formats or for incorrect results or damages resulting from its use.

DATE: 2/22/2021 1:44:41 PM  
 FILE: T:\BMT\DESIGN\Projects\0028-13-xxx\_IH10-US69\_Bear\_Ing\_RMC\DCN\Standards\bc-14.dgn

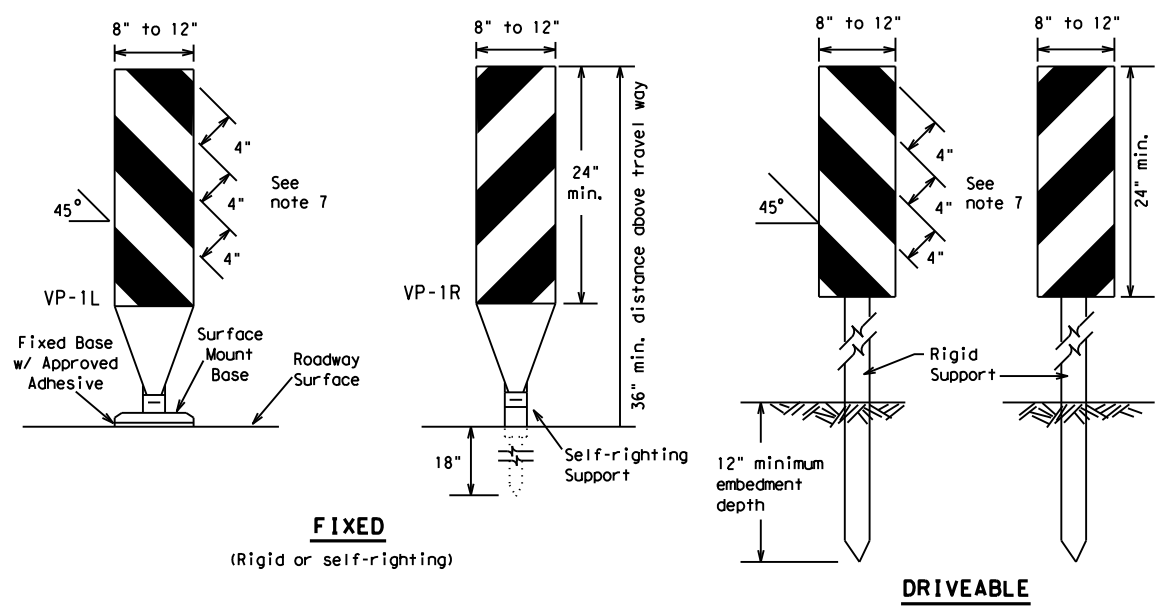

**FIXED**  
(Rigid or self-righting)

**DRIVEABLE**

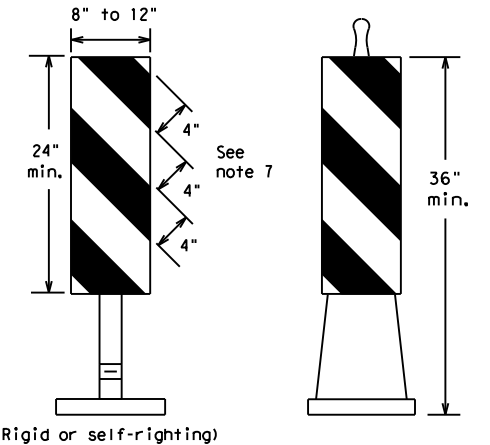


(Rigid or self-righting)

**PORTABLE**


**VERTICAL PANELS (VPs)**

- Vertical Panels (VP's) are normally used to channelize traffic or divide opposing lanes of traffic.
- VP's may be used in daytime or nighttime situations. They may be used at the edge of shoulder drop-offs and other areas such as lane transitions where positive daytime and nighttime delineation is required. The Engineer/Inspector shall refer to the Roadway Design Manual Appendix B "Treatment of Pavement Drop-offs in Work Zones" for additional guidelines on the use of VP's for drop-offs.
- VP's should be mounted back to back if used at the edge of cuts adjacent to two-way two lane roadways. Stripes are to be reflective orange and reflective white and should always slope downward toward the travel lane.
- VP's used on expressways and freeways or other high speed roadways, may have more than 270 square inches of retroreflective area facing traffic.
- Self-righting supports are available with portable base. See "Compliant Work Zone Traffic Control Devices List" (CWZTCD).
- Sheeting for the VP's shall be retroreflective Type A conforming to Departmental Material Specification DMS-8300, unless noted otherwise.
- Where the height of reflective material on the vertical panel is 36 inches or greater, a panel stripe of 6 inches shall be used.

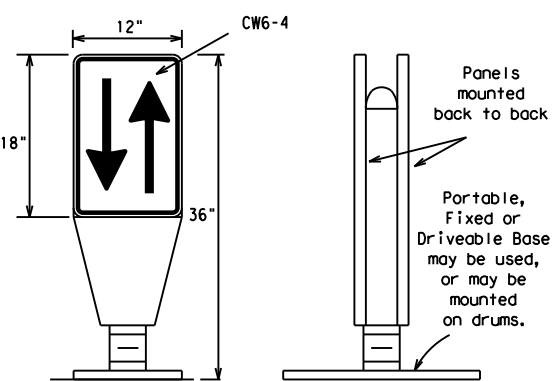

**OPPOSING TRAFFIC LANE DIVIDERS (OTLD)**


- Opposing Traffic Lane Dividers (OTLD) are delineation devices designed to convert a normal one-way roadway section to two-way operation. OTLD's are used on temporary centerlines. The upward and downward arrows on the sign's face indicate the direction of traffic on either side of the divider. The base is secured to the pavement with an adhesive or rubber weight to minimize movement caused by a vehicle impact or wind gust.
- The OTLD may be used in combination with 42" cones or VPs.
- Spacing between the OTLD shall not exceed 500 feet. 42" cones or VPs placed between the OTLD's should not exceed 100 foot spacing.
- The OTLD shall be orange with a black non-reflective legend. Sheeting for the OTLD shall be retroreflective Type B<sub>FL</sub> or Type C<sub>FL</sub> conforming to Departmental Material Specification DMS-8300, unless noted otherwise. The legend shall meet the requirements of DMS-8300.

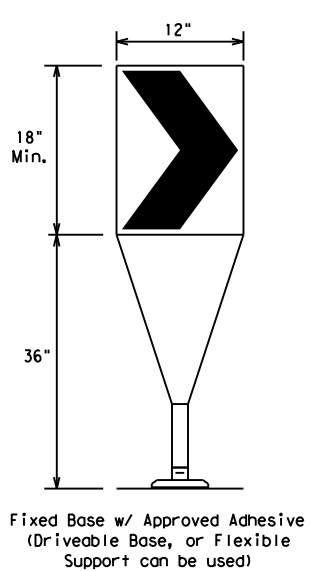

Fixed Base w/ Approved Adhesive (Driveable Base, or Flexible Support can be used)

- The chevron shall be a vertical rectangle with a minimum size of 12 by 18 inches.
- Chevrons are intended to give notice of a sharp change of alignment with the direction of travel and provide additional emphasis and guidance for vehicle operators with regard to changes in horizontal alignment of the roadway.
- Chevrons, when used, shall be erected on the outside of a sharp curve or turn, or on the far side of an intersection. They shall be in line with and at right angles to approaching traffic. Spacing should be such that the motorist always has three in view, until the change in alignment eliminates its need.
- To be effective, the chevron should be visible for at least 500 feet.
- Chevrons shall be orange with a black nonreflective legend. Sheeting for the chevron shall be retroreflective Type B<sub>FL</sub> or Type C<sub>FL</sub> conforming to Departmental Material Specification DMS-8300, unless noted otherwise. The legend shall meet the requirements of DMS-8300.
- For Long Term Stationary use on tapers or transitions on freeways and divided highways self-righting chevrons may be used to supplement plastic drums but not to replace plastic drums.

**CHEVRONS**

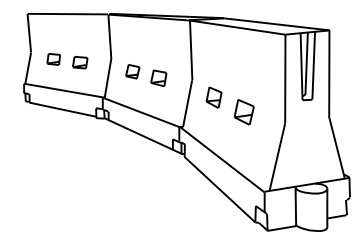

**LONGITUDINAL CHANNELIZING DEVICES (LCD)**

- LCDs are crashworthy, lightweight, deformable devices that are highly visible, have good target value and can be connected together. They are not designed to contain or redirect a vehicle on impact.
- LCDs may be used instead of a line of cones or drums.
- LCDs shall be placed in accordance to application and installation requirements specific to the device, and used only when shown on the CWZTCD list.
- LCDs should not be used to provide positive protection for obstacles, pedestrians or workers.
- LCDs shall be supplemented with retroreflective delineation as required for temporary barriers on BC(7) when placed roughly parallel to the travel lanes.
- LCDs used as barricades placed perpendicular to traffic should have at least one row of reflective sheeting meeting the requirements for barricade rails as shown on BC(10) placed near the top of the LCD along the full length of the device.

**WATER BALLASTED SYSTEMS USED AS BARRIERS**

- Water ballasted systems used as barriers shall not be used solely to channelize road users, but also to protect the work space per the appropriate NCHRP 350 crashworthiness requirements based on roadway speed and barrier application.
- Water ballasted systems used to channelize vehicular traffic shall be supplemented with retroreflective delineation or channelizing devices to improve daytime/nighttime visibility. They may also be supplemented with pavement markings.
- Water ballasted systems used as barriers shall be placed in accordance to application and installation requirements specific to the device, and used only when shown on the CWZTCD list.
- Water ballasted systems used as barriers should not be used for a merging taper except in low speed (less than 45 MPH) urban areas. When used on a taper in a low speed urban area, the taper shall be delineated and the taper length should be designed to optimize road user operations considering the available geometric conditions.
- When water ballasted systems used as barriers have blunt ends exposed to traffic, they should be attenuated as per manufacturer recommendations or flared to a point outside the clear zone.

If used to channelize pedestrians, longitudinal channelizing devices or water ballasted systems must have a continuous detectable bottom for users of long canes and the top of the unit shall not be less than 32 inches in height.

**HOLLOW OR WATER BALLASTED SYSTEMS USED AS LONGITUDINAL CHANNELIZING DEVICES OR BARRIERS**

**GENERAL NOTES**

- Work Zone channelizing devices illustrated on this sheet may be installed in close proximity to traffic and are suitable for use on high or low speed roadways. The Engineer/Inspector shall ensure that spacing and placement is uniform and in accordance with the "Texas Manual on Uniform Traffic Control Devices" (TMUTCD).
- Channelizing devices shown on this sheet may have a driveable, fixed or portable base. The requirement for self-righting channelizing devices must be specified in the General Notes or other plan sheets.
- Channelizing devices on self-righting supports should be used in work zone areas where channelizing devices are frequently impacted by errant vehicles or vehicle related wind gusts making alignment of the channelizing devices difficult to maintain. Locations of these devices shall be detailed elsewhere in the plans. These devices shall conform to the TMUTCD and the "Compliant Work Zone Traffic Control Devices List" (CWZTCD).
- The Contractor shall maintain devices in a clean condition and replace damaged, nonreflective, faded, or broken devices and bases as required by the Engineer/Inspector. The Contractor shall be required to maintain proper device spacing and alignment.
- Portable bases shall be fabricated from virgin and/or recycled rubber. The portable bases shall weigh a minimum of 30 lbs.
- Pavement surfaces shall be prepared in a manner that ensures proper bonding between the adhesives, the fixed mount bases and the pavement surface. Adhesives shall be prepared and applied according to the manufacturer's recommendations.
- The installation and removal of channelizing devices shall not cause detrimental effects to the final pavement surfaces, including pavement surface discoloration or surface integrity. Driveable bases shall not be permitted on final pavement surfaces. The Engineer/Inspector shall approve all application and removal procedures of fixed bases.

Posted Speed * S	Formula L = WS <sup>2</sup> / 60	Minimum Desirable Taper Lengths **			Suggested Maximum Spacing of Channelizing Devices	
		10' Offset	11' Offset	12' Offset	On a Taper	On a Tangent
30	L = WS <sup>2</sup> / 60	150'	165'	180'	30'	60'
35		205'	225'	245'	35'	70'
40	L = WS	265'	295'	320'	40'	80'
45		450'	495'	540'	45'	90'
50	L = WS	500'	550'	600'	50'	100'
55		600'	660'	720'	60'	120'
60	L = WS	650'	715'	780'	65'	130'
65		700'	770'	840'	70'	140'
70	L = WS	750'	825'	900'	75'	150'
75		800'	880'	960'	80'	160'
80	L = WS					
80						

\*\*Taper lengths have been rounded off.  
 L=Length of Taper (FT.) W=Width of Offset (FT.)  
 S=Posted Speed (MPH)

**SUGGESTED MAXIMUM SPACING OF CHANNELIZING DEVICES AND MINIMUM DESIRABLE TAPER LENGTHS**

SHEET 9 OF 12



**BARRICADE AND CONSTRUCTION CHANNELIZING DEVICES**

**BC (9) - 14**

FILE: bc-14.dgn	DN: TxDOT	CK: TxDOT	DW: TxDOT	CR: TxDOT
© TxDOT November 2002	CONT	SECT	JOB	HIGHWAY
REVISIONS	6376	34	001	US 69
9-07 8-14	DIST	COUNTY	SHEET NO.	
7-13	BMT	JEFFERSON	17	


DISCLAIMER: The use of this standard is governed by the "Texas Engineering Practice Act". No warranty of any kind is made by TxDOT for any purpose whatsoever. TxDOT assumes no responsibility for the conversion of this standard to other formats or for incorrect results or damages resulting from its use.

DATE: 2/22/2021 1:44:45 PM  
 FILE: T:\BMT\DESIGN\Projects\0028-13-xxx-IH10-US69\_Bear-Ing\_RMC\DNVStandards\bc-14.dgn


**TYPE 3 BARRICADES**

1. Refer to the Compliant Work Zone Traffic Control Devices List (CWZTCD) for details of the Type 3 Barricades and a list of all materials used in the construction of Type 3 Barricades.
2. Type 3 Barricades shall be used at each end of construction projects closed to all traffic.
3. Barricades extending across a roadway should have stripes that slope downward in the direction toward which traffic must turn in detouring. When both right and left turns are provided, the chevron striping may slope downward in both directions from the center of the barricade. Where no turns are provided at a closed road striping should slope downward in both directions toward the center of roadway.
4. Striping of rails, for the right side of the roadway, should slope downward to the left. For the left side of the roadway, striping should slope downward to the right.
5. Identification markings may be shown only on the back of the barricade rails. The maximum height of letters and/or company logos used for identification shall be 1".
6. Barricades shall not be placed parallel to traffic unless an adequate clear zone is provided.
7. Warning lights shall NOT be installed on barricades.
8. Where barricades require the use of weights to keep from turning over, the use of sandbags with dry, cohesionless sand is recommended. The sandbags will be tied shut to keep the sand from spilling and to maintain a constant weight. Sand bags shall not be stacked in a manner that covers any portion of a barricade rails reflective sheeting. Rock, concrete, iron, steel or other solid objects will NOT be permitted. Sandbags should weigh a minimum of 35 lbs and a maximum of 50 lbs. Sandbags shall be made of a durable material that tears upon vehicular impact. Rubber (such as tire inner tubes) shall not be used for sandbags. Sandbags shall only be placed along or upon the base supports of the device and shall not be suspended above ground level or hung with rope, wire, chains or other fasteners.
9. Sheeting for barricades shall be retroreflective Type A conforming to Departmental Material Specification DMS-8300 unless otherwise noted.


Barricades shall NOT be used as a sign support.

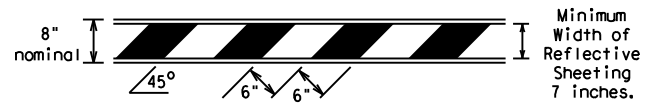

**TYPICAL STRIPING DETAIL FOR BARRICADE RAIL**

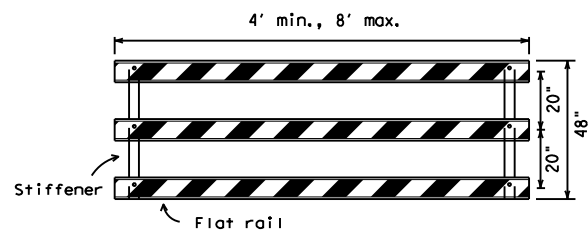


**TYPICAL PANEL DETAIL FOR SKID OR POST TYPE BARRICADES**

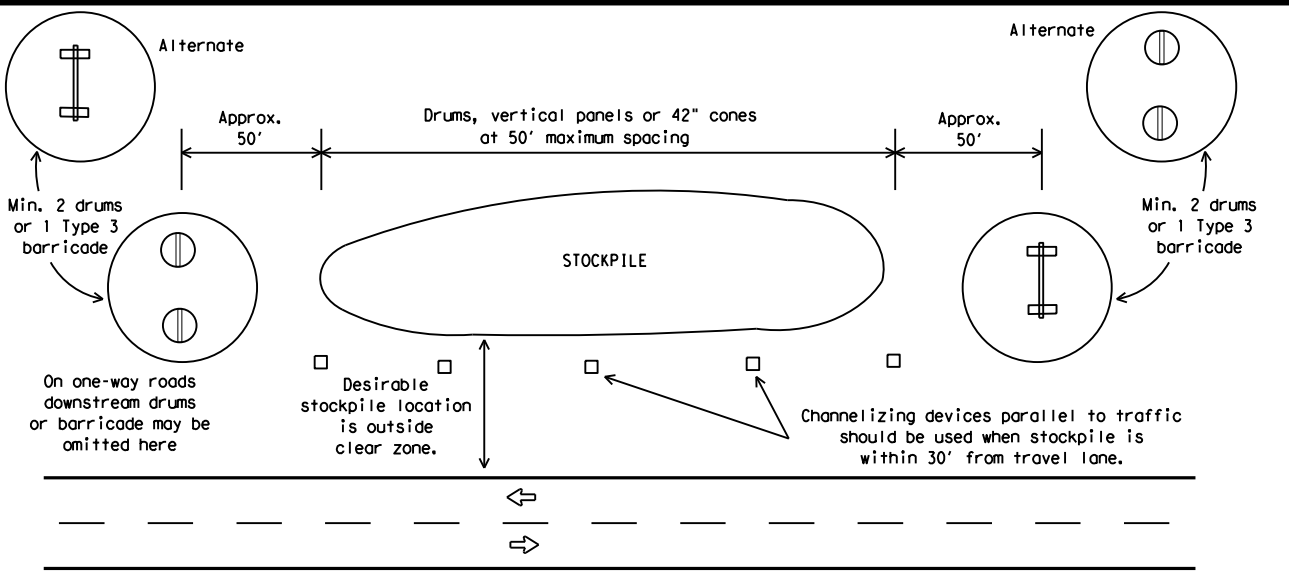

**TRAFFIC CONTROL FOR MATERIAL STOCKPILES**


Each roadway of a divided highway shall be barricaded in the same manner.

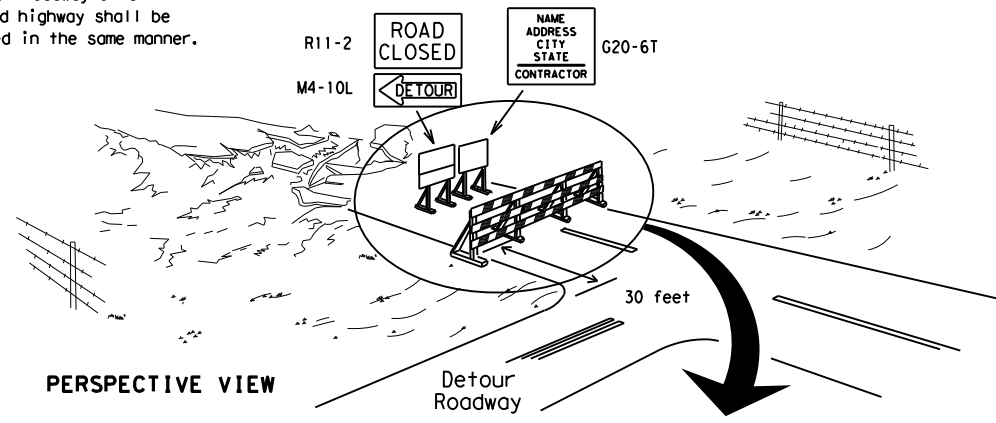

**PERSPECTIVE VIEW**


The three rails on Type 3 barricades shall be reflectorized orange and reflective white stripes on one side facing one-way traffic and both sides for two-way traffic. Barricade striping should slant downward in the direction of detour.

1. Signs should be mounted on independent supports at a 7 foot mounting height in center of roadway. The signs should be a minimum of 10 feet behind Type 3 Barricades.
2. Advance signing shall be as specified elsewhere in the plans.

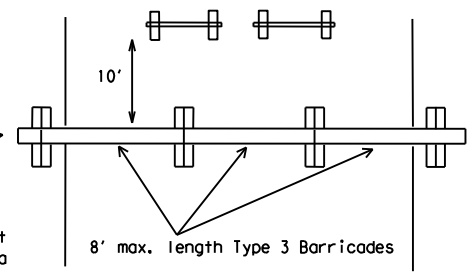


**PLAN VIEW**

**TYPE 3 BARRICADE (POST AND SKID) TYPICAL APPLICATION**

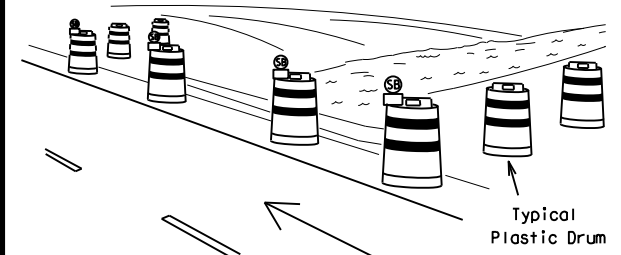

**PERSPECTIVE VIEW**

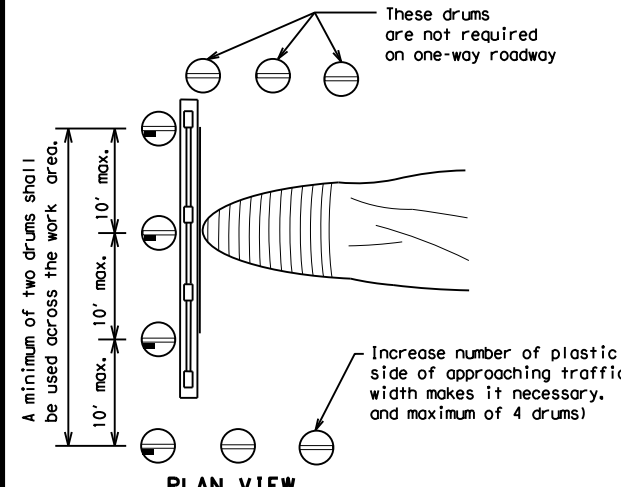


**PLAN VIEW**

**CULVERT WIDENING OR OTHER ISOLATED WORK WITHIN THE PROJECT LIMITS**

1. Where positive redirection capability is provided, drums may be omitted.
2. Plastic construction fencing may be used with drums for safety as required in the plans.
3. Vertical Panels on flexible support may be substituted for drums when the shoulder width is less than 4 feet.
4. When the shoulder width is greater than 12 feet, steady-burn lights may be omitted if drums are used.
5. Drums must extend the length of the culvert widening.


LEGEND	
	Plastic drum
	Plastic drum with steady burn light or yellow warning reflector
	Steady burn warning light or yellow warning reflector

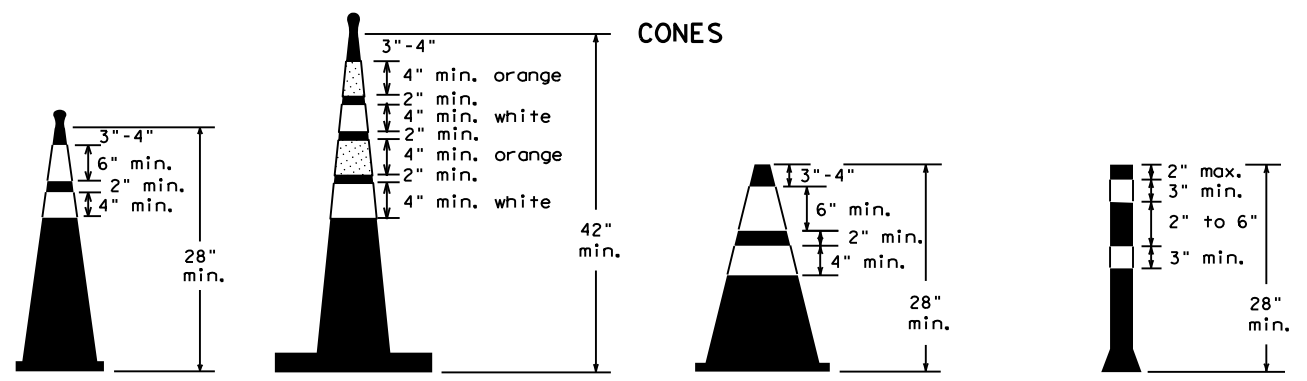

28" Cones shall have a minimum weight of 9 1/2 lbs.  
 42" 2-piece cones shall have a minimum weight of 30 lbs. including base.

1. Traffic cones and tubular markers shall be predominantly orange, and meet the height and weight requirements shown above.
2. One-piece cones have the body and base of the cone molded in one consolidated unit. Two-piece cones have a cone shaped body and a separate rubber base, or ballast, that is added to keep the device upright and in place.
3. Two-piece cones may have a handle or loop extending up to 8" above the minimum height shown, in order to aid in retrieving the device.
4. Cones or tubular markers used at night shall have white or white and orange reflective bands as shown above. The reflective bands shall have a smooth, sealed outer surface and meet the requirements of Departmental Material Specification DMS-8300 Type A.
5. 28" cones and tubular markers are generally suitable for short duration and short-term stationary work as defined on BC(4). These should not be used for intermediate-term or long-term stationary work unless personnel is on-site to maintain them in their proper upright position.
6. 42" two-piece cones, vertical panels or drums are suitable for all work zone durations.
7. Cones or tubular markers used on each project should be of the same size and shape.

THIS DEVICE SHALL NOT BE USED ON PROJECTS LET AFTER MARCH 2014.

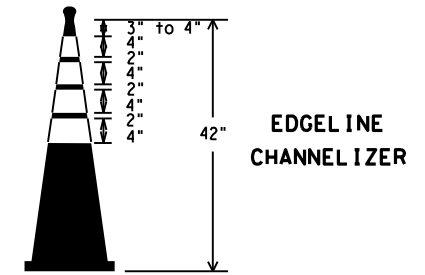

**EDGE LINE CHANNELIZER**

1. This device is intended only for use in place of a vertical panel to channelize traffic by indicating the edge of the travel lane. It is not intended to be used in transitions or tapers.
2. This device shall not be used to separate lanes of traffic (opposing or otherwise) or warn of objects.
3. This device is based on a 42 inch, two-piece cone with an alternate striping pattern: four 4 inch retroreflective bands, with an approximate 2 inch gap between bands. The color of the band should correspond to the color of the edgeline (yellow for left edgeline, white for right edgeline) for which the device is substituted or for which it supplements. The reflectorized bands shall be retroreflective Type A conforming to Departmental Material Specification DMS-8300, unless otherwise noted.
4. The base must weigh a minimum of 30 lbs.

SHEET 10 OF 12

Texas Department of Transportation Traffic Operations Division Standard

**BARRICADE AND CONSTRUCTION CHANNELIZING DEVICES**

**BC (10) - 14**

FILE: bc-14.dgn	DN: TxDOT	CR: TxDOT	DW: TxDOT	CK: TxDOT
© TxDOT November 2002	CONT	SECT	JOB	HIGHWAY
REVISIONS	6376	34	001	US 69
9-07 8-14	DIST	COUNTY	SHEET NO.	
7-13	BMT	JEFFERSON	18	

## WORK ZONE PAVEMENT MARKINGS

### GENERAL

- The Contractor shall be responsible for maintaining work zone and existing pavement markings, in accordance with the standard specifications and special provisions, on all roadways open to traffic within the CSJ limits unless otherwise stated in the plans.
- Color, patterns and dimensions shall be in conformance with the "Texas Manual on Uniform Traffic Control Devices" (TMUTCD).
- Additional supplemental pavement marking details may be found in the plans or specifications.
- Pavement markings shall be installed in accordance with the TMUTCD and as shown on the plans.
- When short term markings are required on the plans, short term markings shall conform with the TMUTCD, the plans and details as shown on the Standard Plan Sheet WZ(STPM).
- When standard pavement markings are not in place and the roadway is opened to traffic, DO NOT PASS signs shall be erected to mark the beginning of the sections where passing is prohibited and PASS WITH CARE signs at the beginning of sections where passing is permitted.
- All work zone pavement markings shall be installed in accordance with Item 662, "Work Zone Pavement Markings."

### RAISED PAVEMENT MARKERS

- Raised pavement markers are to be placed according to the patterns on BC(12).
- All raised pavement markers used for work zone markings shall meet the requirements of Item 672, "RAISED PAVEMENT MARKERS" and Departmental Material Specification DMS-4200 or DMS-4300.

### PREFABRICATED PAVEMENT MARKINGS

- Removable prefabricated pavement markings shall meet the requirements of DMS-8241.
- Non-removable prefabricated pavement markings (foil back) shall meet the requirements of DMS-8240.


### MAINTAINING WORK ZONE PAVEMENT MARKINGS

- The Contractor will be responsible for maintaining work zone pavement markings within the work limits.
- Work zone pavement markings shall be inspected in accordance with the frequency and reporting requirements of work zone traffic control device inspections as required by Form 599.
- The markings should provide a visible reference for a minimum distance of 300 feet during normal daylight hours and 160 feet when illuminated by automobile low-beam headlights at night, unless sight distance is restricted by roadway geometrics.
- Markings failing to meet this criteria within the first 30 days after placement shall be replaced at the expense of the Contractor as per Specification Item 662.

### REMOVAL OF PAVEMENT MARKINGS

- Pavement markings that are no longer applicable, could create confusion or direct a motorist toward or into the closed portion of the roadway shall be removed or obliterated before the roadway is opened to traffic.
- The above shall not apply to detours in place for less than three days, where flaggers and/or sufficient channelizing devices are used in lieu of markings to outline the detour route.
- Pavement markings shall be removed to the fullest extent possible, so as not to leave a discernable marking. This shall be by any method approved by TxDOT Specification Item 677 for "Eliminating Existing Pavement Markings and Markers".
- The removal of pavement markings may require resurfacing or seal coating portions of the roadway as described in Item 677.
- Subject to the approval of the Engineer, any method that proves to be successful on a particular type pavement may be used.
- Blast cleaning may be used but will not be required unless specifically shown in the plans.
- Over-painting of the markings SHALL NOT BE permitted.
- Removal of raised pavement markers shall be as directed by the Engineer.
- Removal of existing pavement markings and markers will be paid for directly in accordance with Item 677, "ELIMINATING EXISTING PAVEMENT MARKINGS AND MARKERS," unless otherwise stated in the plans.
- Black-out marking tape may be used to cover conflicting existing markings for periods less than two weeks when approved by the Engineer.

## Temporary Flexible-Reflective Roadway Marker Tabs

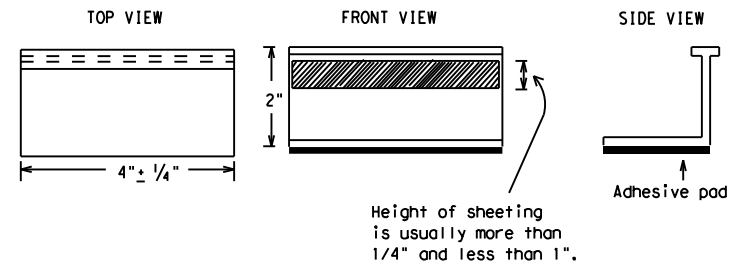

**STAPLES OR NAILS SHALL NOT BE USED TO SECURE  
TEMPORARY FLEXIBLE-REFLECTIVE ROADWAY MARKER  
TABS TO THE PAVEMENT SURFACE**

- Temporary flexible-reflective roadway marker tabs used as guidemarks shall meet the requirements of DMS-8242.
- Tabs detailed on this sheet are to be inspected and accepted by the Engineer or designated representative. Sampling and testing is not normally required, however at the option of the Engineer, either "A" or "B" below may be imposed to assure quality before placement on the roadway.
  - Select five (5) or more tabs at random from each lot or shipment and submit to the Construction Division, Materials and Pavement Section to determine specification compliance.
  - Select five (5) tabs and perform the following test. Affix five (5) tabs at 24 inch intervals on an asphaltic pavement in a straight line. Using a medium size passenger vehicle or pickup, run over the markers with the front and rear tires at a speed of 35 to 40 miles per hour, four (4) times in each direction. No more than one (1) out of the five (5) reflective surfaces shall be lost or displaced as a result of this test.
- Small design variances may be noted between tab manufacturers.
- See Standard Sheet WZ(STPM) for tab placement on new pavements. See Standard Sheet TCP(7-1) for tab placement on seal coat work.

### RAISED PAVEMENT MARKERS USED AS GUIDEMARKS

- Raised pavement markers used as guidemarks shall be from the approved product list, and meet the requirements of DMS-4200.
- All temporary construction raised pavement markers provided on a project shall be of the same manufacturer.
- Adhesive for guidemarks shall be bituminous material hot applied or butyl rubber pad for all surfaces, or thermoplastic for concrete surfaces.

Guidemarks shall be designated as:

- YELLOW - (two amber reflective surfaces with yellow body).
- WHITE - (one silver reflective surface with white body).

DEPARTMENTAL MATERIAL SPECIFICATIONS	
PAVEMENT MARKERS (REFLECTORIZED)	DMS-4200
TRAFFIC BUTTONS	DMS-4300
EPOXY AND ADHESIVES	DMS-6100
BITUMINOUS ADHESIVE FOR PAVEMENT MARKERS	DMS-6130
PERMANENT PREFABRICATED PAVEMENT MARKINGS	DMS-8240
TEMPORARY REMOVABLE, PREFABRICATED PAVEMENT MARKINGS	DMS-8241
TEMPORARY FLEXIBLE, REFLECTIVE ROADWAY MARKER TABS	DMS-8242

A list of prequalified reflective raised pavement markers, non-reflective traffic buttons, roadway marker tabs and other pavement markings can be found at the Material Producer List web address shown on BC(1).

SHEET 11 OF 12



## BARRICADE AND CONSTRUCTION PAVEMENT MARKINGS

**BC(11) - 14**

FILE: bc-14.dgn	DN: TxDOT	CR: TxDOT	DW: TxDOT	CK: TxDOT	
© TxDOT February 1998	CONT	SECT	JOB	HIGHWAY	
REVISIONS		6376	34	001	US 69
2-98	9-07				
1-02	7-13	DIST	COUNTY	SHEET NO.	
11-02	8-14	BMT	JEFFERSON	19	





DISCLAIMER: The use of this standard is governed by the "Texas Engineering Practice Act". No warranty of any kind is made by TxDOT for any purpose whatsoever. TxDOT assumes no responsibility for the conversion of this standard to other formats or for incorrect results or damages resulting from its use.

DATE: 2/22/2021 1:44:50 PM  
FILE: T:\BMT\DESIGN\Projects\0028-13-xxx-IH10-US69-Bear\ing\_RMC\DN\Standards\bc-14.dgn

DISCLAIMER: The use of this standard is governed by the "Texas Engineering Practice Act". No warranty of any kind is made by TxDOT for any purpose whatsoever. TxDOT assumes no responsibility for the conversion of this standard to other formats or for incorrect results or damages resulting from its use.



DATE: 2/22/2021 1:44:54 PM  
 FILE: T:\BMT\DESIGN\Projects\0028-13-xxx\_IH10-US69\_Bear\ing\_RMC\DN\Standards\bc-14.dgn

## PAVEMENT MARKING PATTERNS

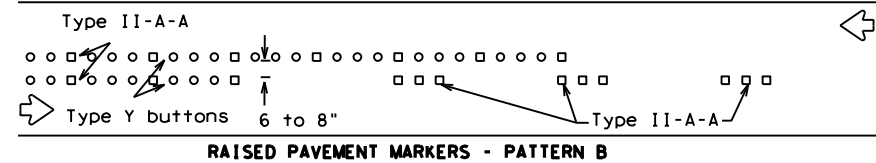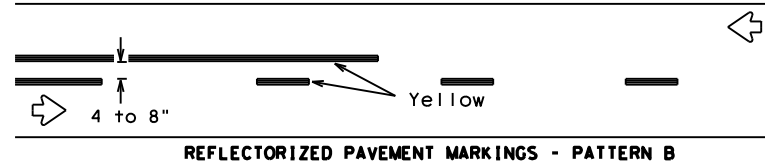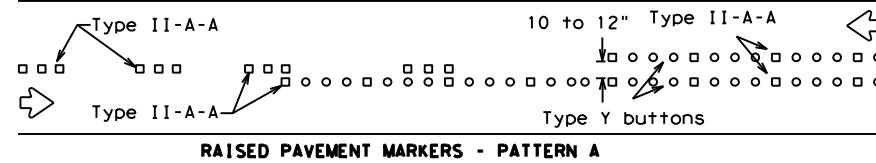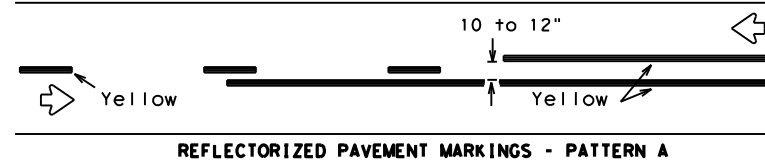



Pattern A is the TxDOT Standard, however Pattern B may be used if approved by the Engineer. Prefabricated markings may be substituted for reflectorized pavement markings.

## CENTER LINE & NO-PASSING ZONE BARRIER LINES FOR TWO-LANE, TWO-WAY HIGHWAYS

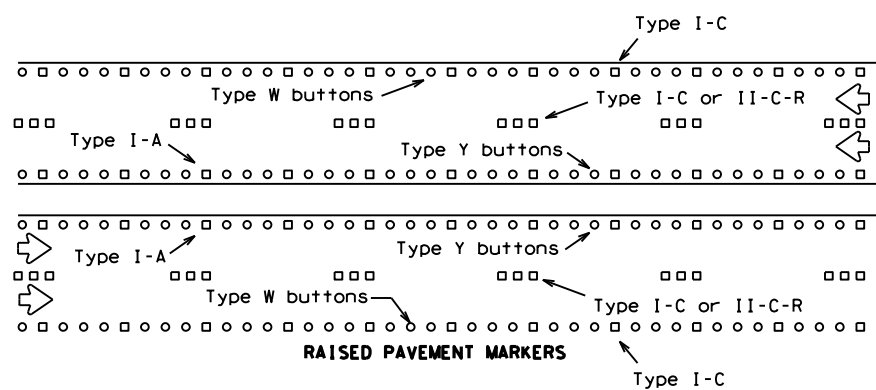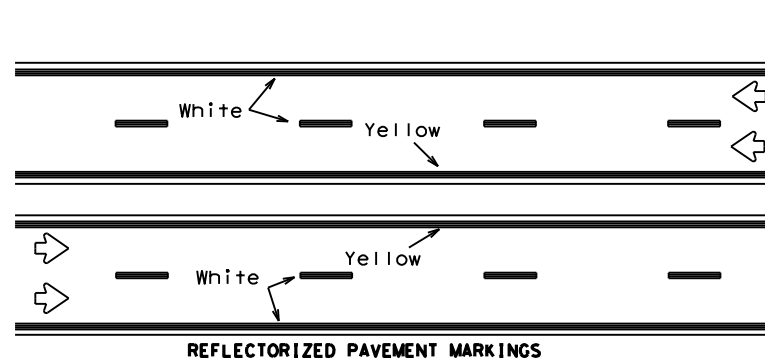



Prefabricated markings may be substituted for reflectorized pavement markings.

## EDGE & LANE LINES FOR DIVIDED HIGHWAY

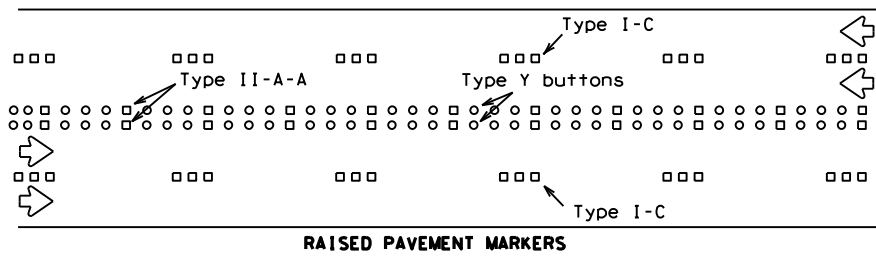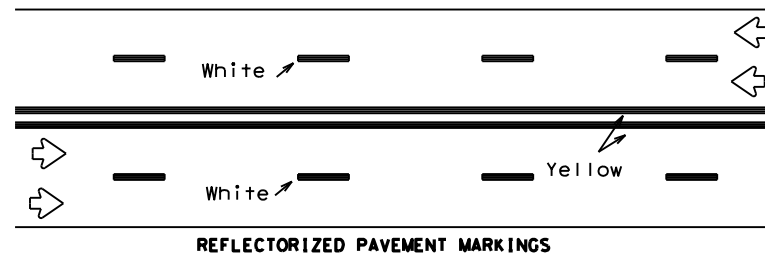

Prefabricated markings may be substituted for reflectorized pavement markings.


## LANE & CENTER LINES FOR MULTILANE UNDIVIDED HIGHWAYS

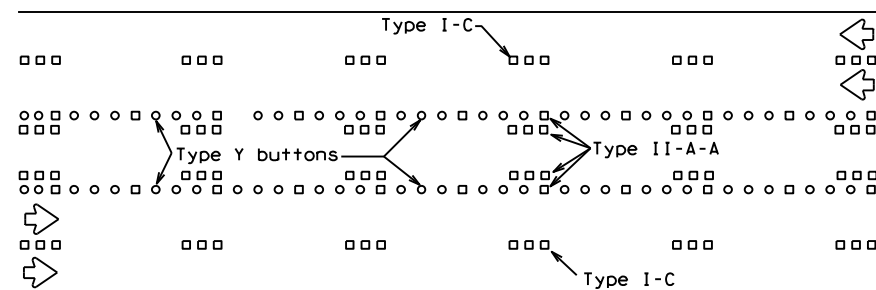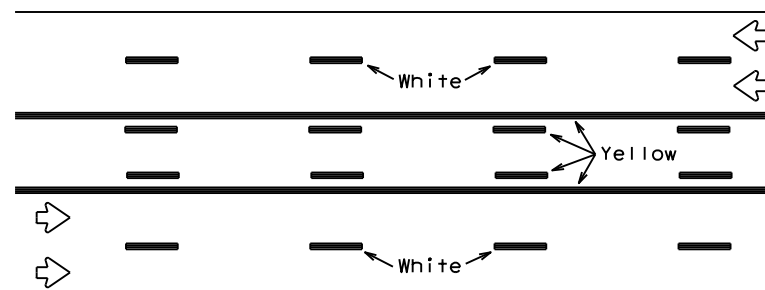



Prefabricated markings may be substituted for reflectorized pavement markings.

## TWO-WAY LEFT TURN LANE


## STANDARD WORK ZONE PAVEMENT MARKINGS DETAILS

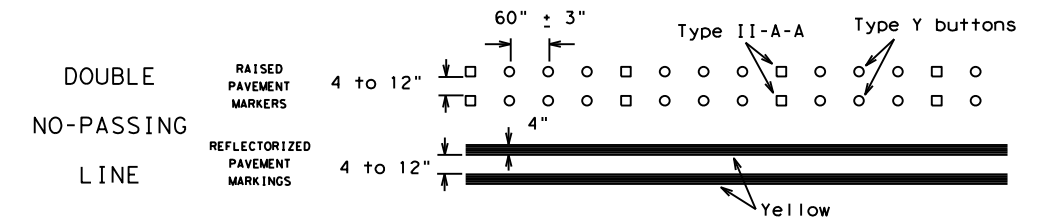


### SOLID LINES

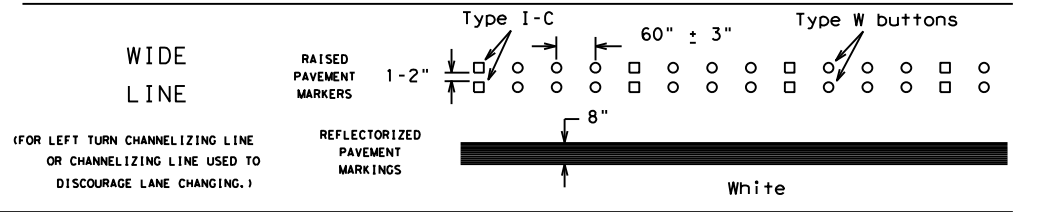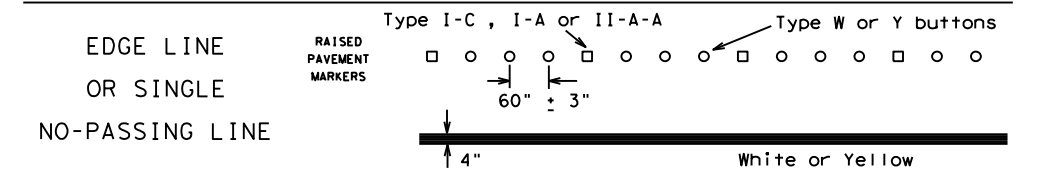

### BROKEN LINES

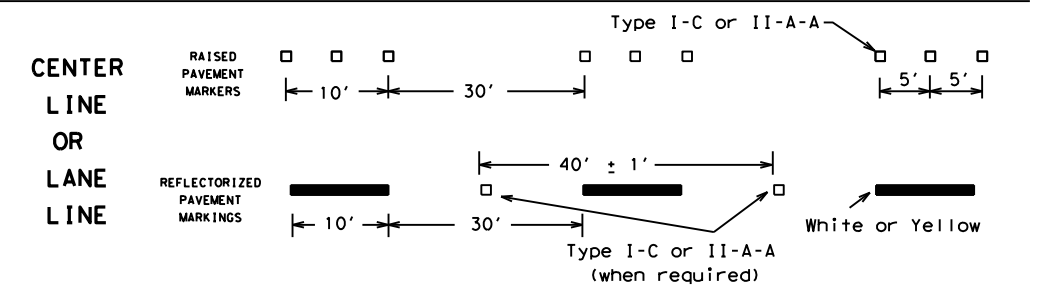


### AUXILIARY OR LANEDROP LINE

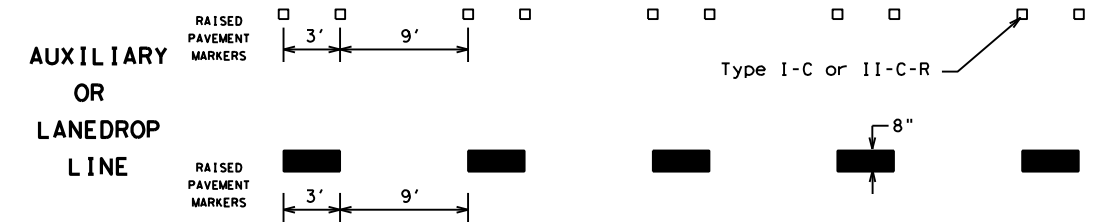

### REMOVABLE MARKINGS WITH RAISED PAVEMENT MARKERS

If raised pavement markers are used to supplement REMOVABLE markings, the markers shall be applied to the top of the tape at the approximate mid length of tape used for broken lines or at 20 foot spacing for solid lines. This allows an easier removal of raised pavement markers and tape.

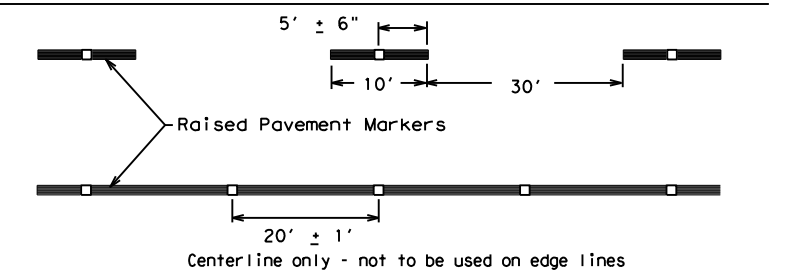

SHEET 12 OF 12

Raised pavement markers used as standard pavement markings shall be from the approved products list and meet the requirements of Item 672 "RAISED PAVEMENT MARKERS."

Texas Department of Transportation  
 Traffic Operations Division Standard


## BARRICADE AND CONSTRUCTION PAVEMENT MARKING PATTERNS

### BC (12) - 14


FILE: bc-14.dgn	DN: TxDOT	CK: TxDOT	DW: TxDOT	CR: TxDOT
© TxDOT February 1998	CONT	SECT	JOB	HIGHWAY
REVISIONS		6376	34	001
1-97	9-07			US 69
2-98	7-13	DIST	COUNTY	SHEET NO.
11-02	8-14	BMT	JEFFERSON	20

DISCLAIMER: The use of this standard is governed by the "Texas Engineering Practice Act". No warranty of any kind is made by TxDOT for any purpose whatsoever. TxDOT assumes no responsibility for the conversion of this standard to other formats or for incorrect results or damages resulting from its use.

DATE: 2/22/2021 1:44:59 PM  
 FILE: T:\BMT\DESIGN\Projects\0028-13-xxx-IH10-US69\_Bear-Ing\_RMC\DCN\Standards\tcp6-1.dgn

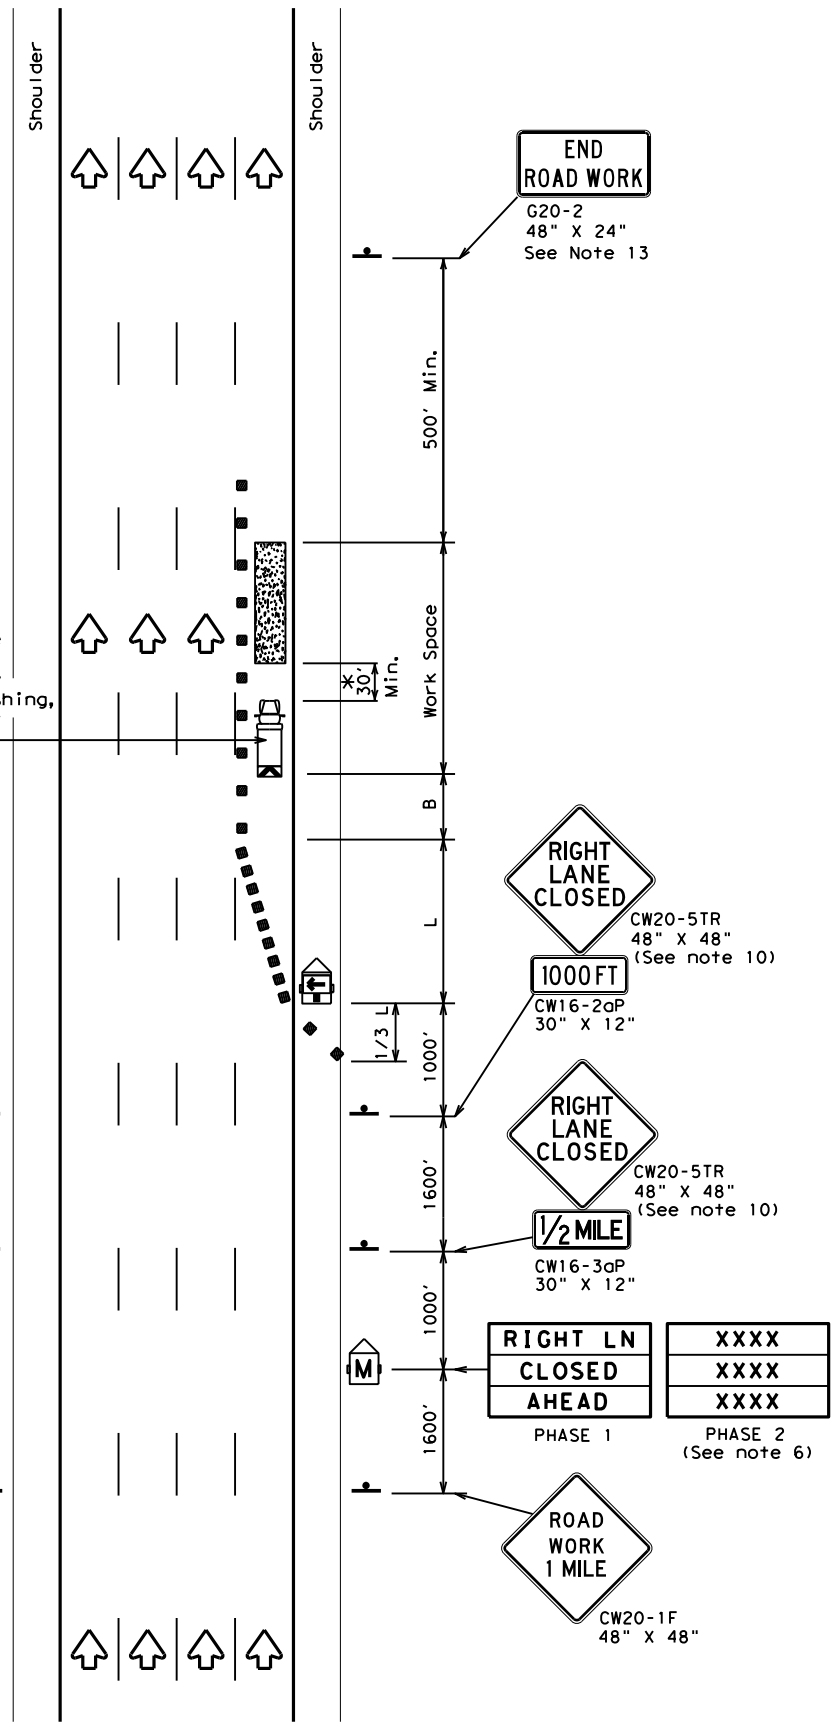

TCP (6-1a)  
**TYPICAL FREEWAY ONE LANE CLOSURE**

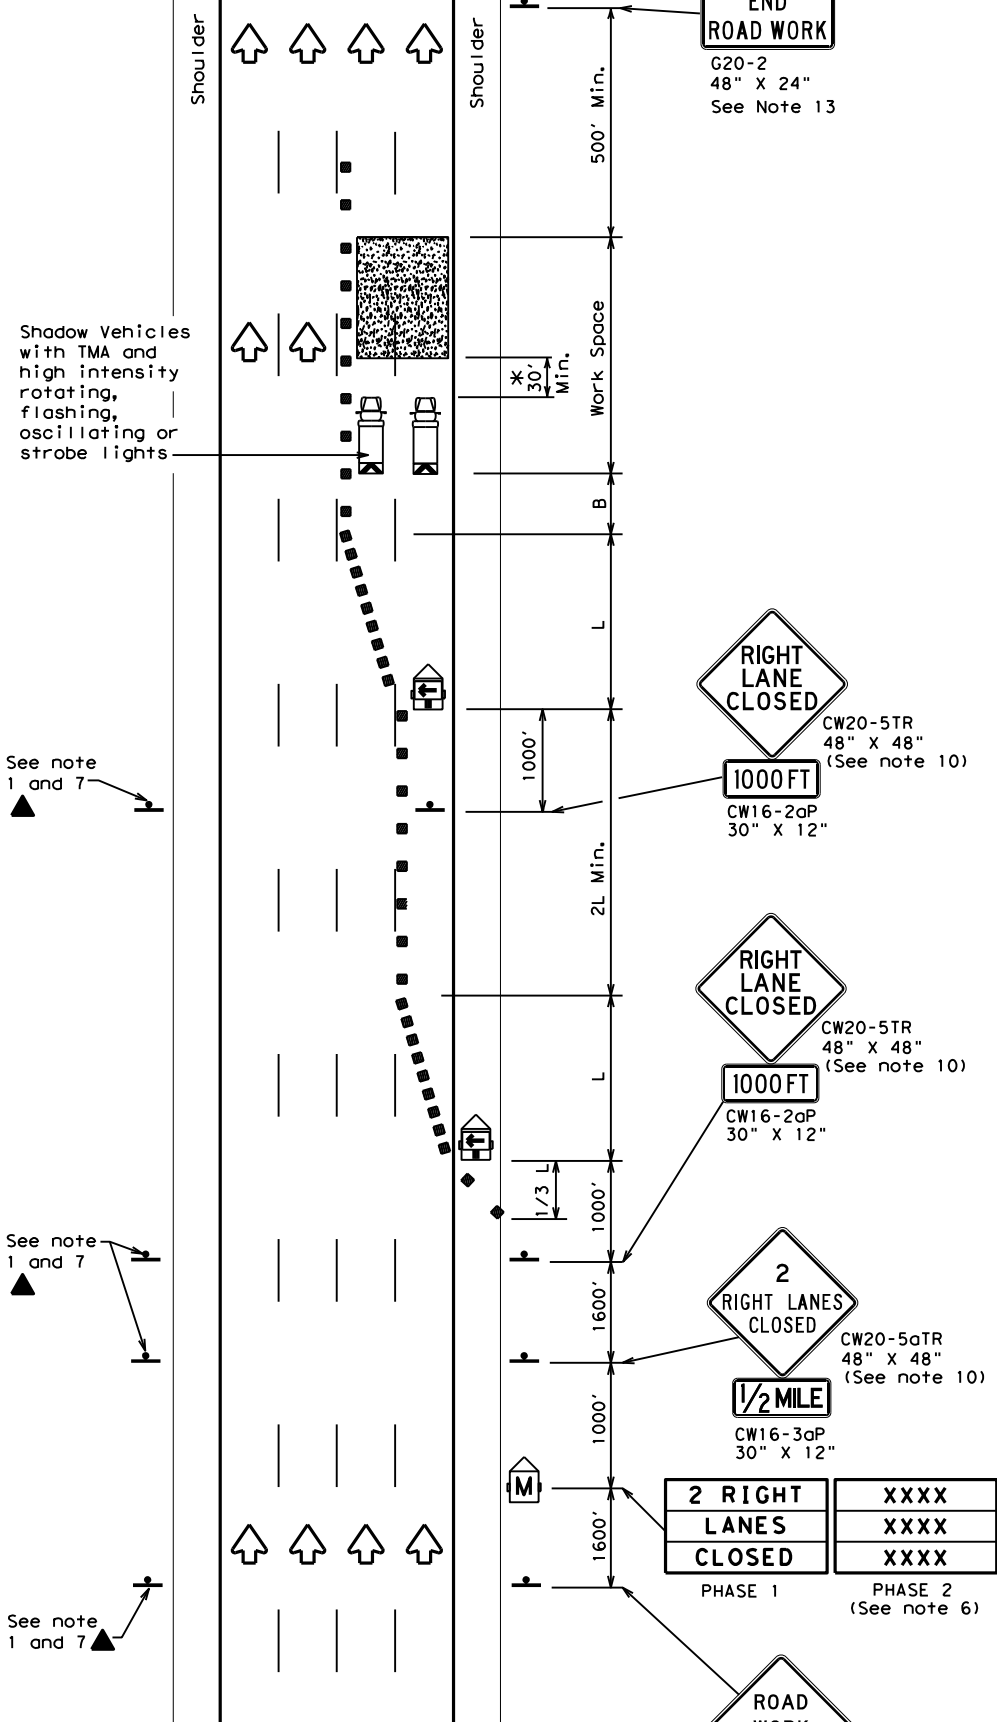

TCP (6-1b)  
**TYPICAL FREEWAY TWO LANE CLOSURE**

LEGEND			
	Type 3 Barricade		Channelizing Devices
	Heavy Work Vehicle		Truck Mounted Attenuator (TMA)
	Trailer Mounted Flashing Arrow Board		Portable Changeable Message Sign (PCMS)
	Sign		Traffic Flow
	Flag		Flagger

Posted Speed	Formula	Minimum Desirable Taper Lengths "L"			Suggested Maximum Spacing of Channelizing Devices		Suggested Longitudinal Buffer Space "B"
		10' Offset	11' Offset	12' Offset	On a Taper	On a Tangent	
45	L = WS	450'	495'	540'	45'	90'	195'
50		500'	550'	600'	50'	100'	240'
55		550'	605'	660'	55'	110'	295'
60		600'	660'	720'	60'	120'	350'
65		650'	715'	780'	65'	130'	410'
70		700'	770'	840'	70'	140'	475'
75		750'	825'	900'	75'	150'	540'
80	800'	880'	960'	80'	160'	615'	

\*\* Taper lengths have been rounded off.  
 L=Length of Taper (FT) W=Width of Offset (FT) S=Posted Speed (MPH)

TYPICAL USAGE				
MOBILE	SHORT DURATION	SHORT TERM STATIONARY	INTERMEDIATE TERM STATIONARY	LONG TERM STATIONARY
	✓	✓	✓	

**GENERAL NOTES**

- All traffic control devices illustrated are REQUIRED. Devices denoted with the triangle symbol may be omitted when stated elsewhere in the plans.
- Drums or 42" cones are the typical channelizing devices. For Intermediate Term Stationary work, drums shall be used on tapers with drums or 42" cones used on tangent sections. Other channelizing devices may be used as directed by the Engineer.
- All construction signs and barricades placed during any phase of work shall remain in place until removal is approved by the Engineer.
- The Engineer may direct the Contractor to furnish additional signs and barricades as required to maintain traffic flow, detours and motorist safety during construction.
- Static message boards or changeable message signs stating the date and duration of ramp or freeway lane closures shall be placed a minimum of seven (7) calendar days in advance of the actual closure.
- Phase 2 of the PCMS message should include appropriate information formatted as shown on BC(6), such as "MERGE LEFT," recommended advisory speed, delay information, or other specific warnings.
- Duplicate construction warning signs should be erected on the medians side of freeways where median width will permit and traffic volume justifies the signing.
- The number of closed lanes may be increased provided the spacing of traffic control devices, taper lengths and tangent lengths meet the requirements of the TMUTCD.
- Warning signs for intermediate term stationary work should be mounted at 7' to the bottom of the sign.
- Warning signs shown shall be appropriately altered for left lane closures. When signs are mounted at 1' height for short term stationary or short duration work, sign versions shown in the SHSD for Texas with distances on the sign face rather than mounted on a plaque below the sign may be used.
- When possible, PCMS units should be located in advance of the last available exit ramp prior to the lane closure to allow motorists an alternate route. They may also be relocated to improve advance warning in case of unanticipated queuing or congestion.
- For Intermediate Term Stationary work at night, floodlights should be used to illuminate the work area and equipment crossings. Floodlights shall not produce a disabling glare condition for road users or workers.
- The END ROAD WORK (G20-2) sign may be omitted when it conflicts with G20-2 signs already in place on the project.

\* A shadow vehicle equipped with a Truck Mounted Attenuator is typically required. A shadow vehicle equipped with a TMA shall be used if it can be positioned 30' to 100' in advance of the area of crew exposure without adversely affecting the work performance.




**TRAFFIC CONTROL PLAN  
 FREEWAY LANE CLOSURES**

**TCP (6-1) - 12**


FILE:	tcp6-1.dgn	DN:	TxDOT	CK:	TxDOT	DW:	TxDOT	CK:	TxDOT
© TxDOT	February 1998	CONT	SECT	JOB	HIGHWAY				
8-12	REVISIONS	6376	34	001	US 69				
	DIST	COUNTY		SHEET NO.					
	BMT	JEFFERSON		21					

DISCLAIMER: The use of this standard is governed by the "Texas Engineering Practice Act". No warranty of any kind is made by TxDOT for any purpose whatsoever. TxDOT assumes no responsibility for the conversion of this standard to other formats or for incorrect results or damages resulting from its use.

DATE: 2/22/2021 1:45:06 PM  
 FILE: T:\BMT\DESIGN\Projects\0028-13-xxx\_IH10-US69\_Bear.Ing\_RMC\DCN\Standards\tcp6-2.dgn

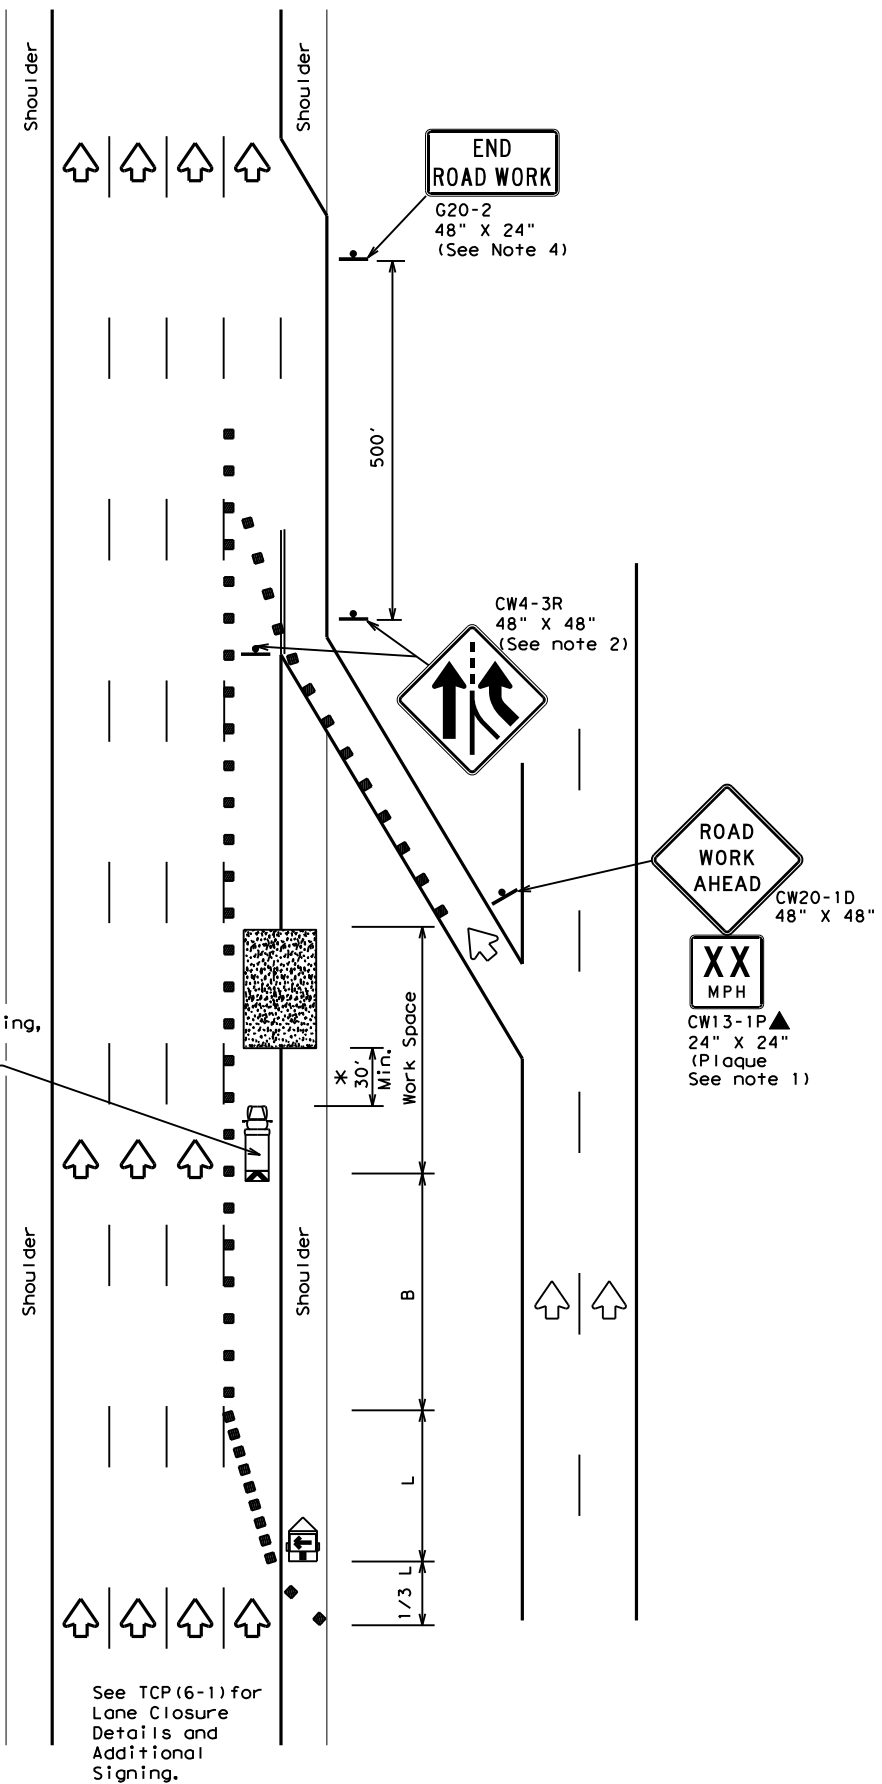

TCP (6-2a)  
**ENTRANCE RAMP OPEN**  
**WORK WITHIN 500' OF RAMP**

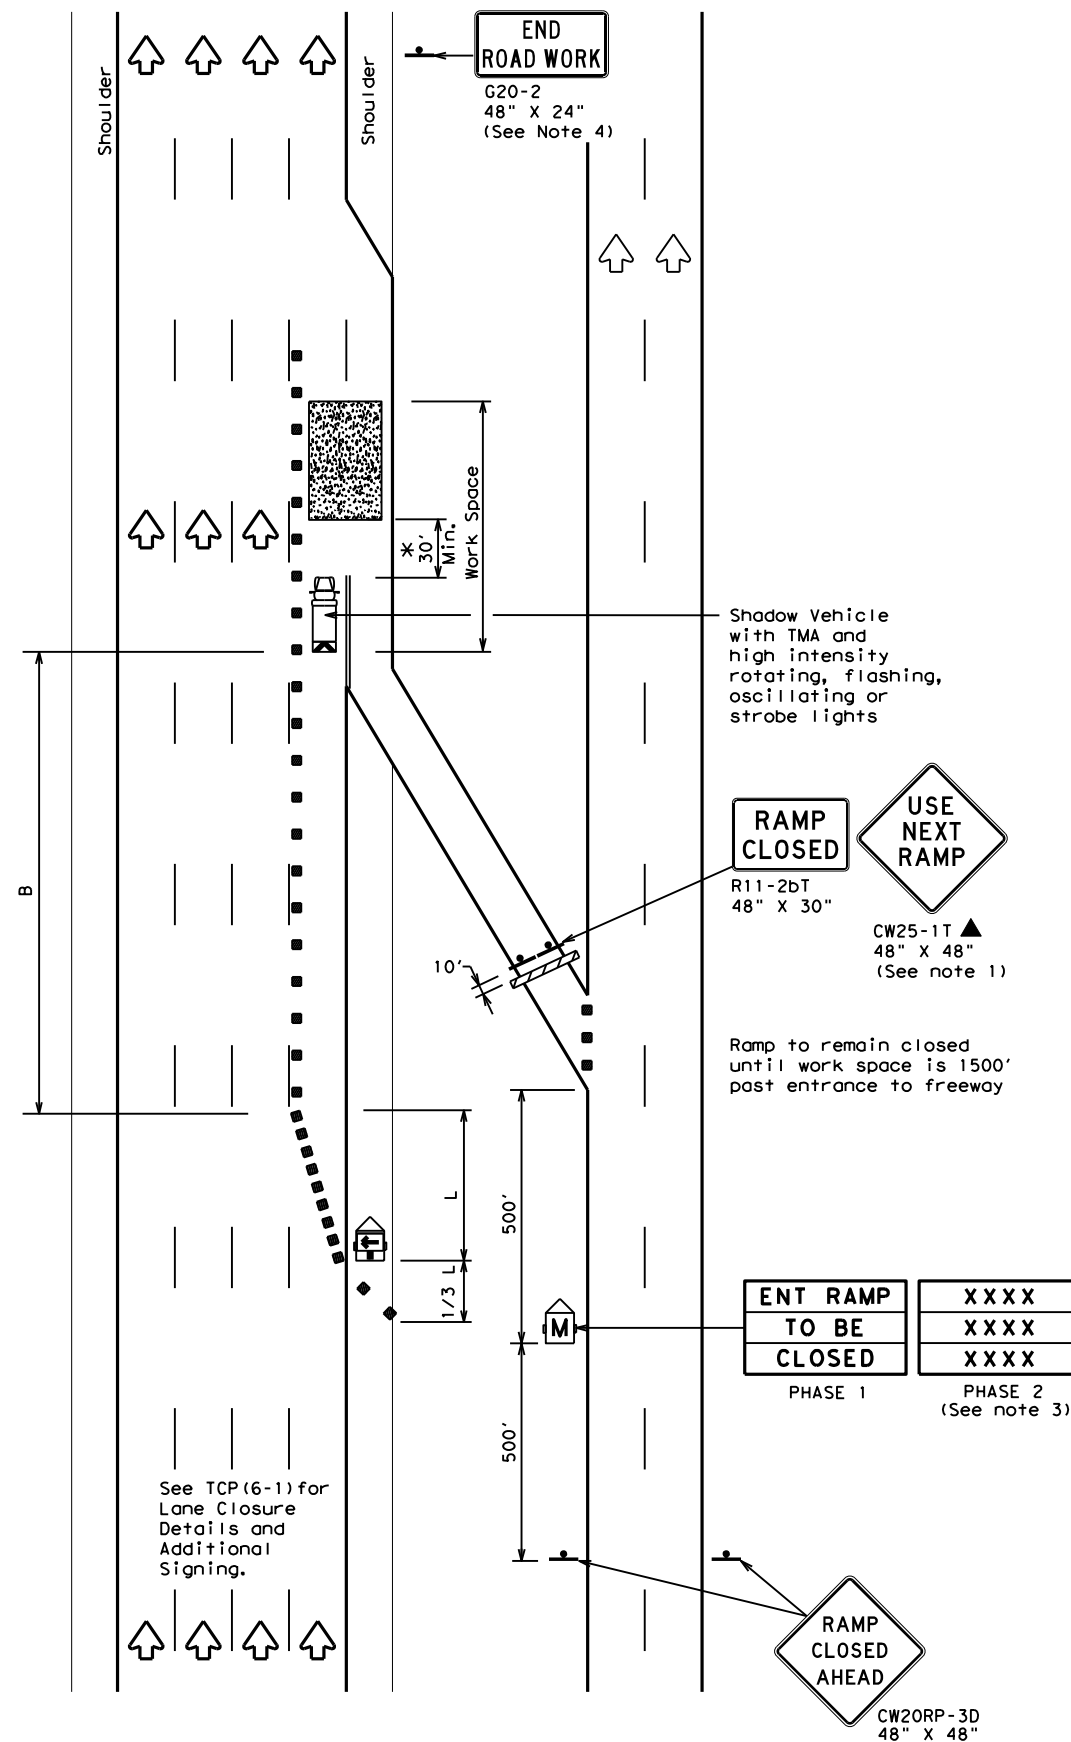

TCP (6-2b)  
**ENTRANCE RAMP CLOSED**

LEGEND			
	Type 3 Barricade		Channelizing Devices
	Heavy Work Vehicle		Truck Mounted Attenuator (TMA)
	Trailer Mounted Flashing Arrow Board		Portable Changeable Message Sign (PCMS)
	Sign		Traffic Flow
	Flag		Flagger

Posted Speed	Formula	Minimum Desirable Taper Lengths "L"			Suggested Maximum Spacing of Channelizing Devices		Suggested Longitudinal Buffer Space "B"
		10' Offset	11' Offset	12' Offset	On a Taper	On a Tangent	
45	L = WS	450'	495'	540'	45'	90'	195'
50		500'	550'	600'	50'	100'	240'
55		550'	605'	660'	55'	110'	295'
60		600'	660'	720'	60'	120'	350'
65		650'	715'	780'	65'	130'	410'
70		700'	770'	840'	70'	140'	475'
75		750'	825'	900'	75'	150'	540'
80		800'	880'	960'	80'	160'	615'

\*\* Taper lengths have been rounded off.  
 L=Length of Taper (FT) W=Width of Offset(FT) S=Posted Speed(MPH)

TYPICAL USAGE				
MOBILE	SHORT DURATION	SHORT TERM STATIONARY	INTERMEDIATE TERM STATIONARY	LONG TERM STATIONARY
	✓	✓	✓	

**GENERAL NOTES**

- All traffic control devices illustrated are REQUIRED. Devices denoted with the triangle symbol may be omitted when stated elsewhere in the plans.
- ADDED LANE Symbol (CW4-3) sign may be omitted when sign between ramp and mainlane can be seen from both roadways.
- See "Advance Notice List" on BC(6) for recommended date and time formatting options for PCMS Phase 2 message.
- The END ROAD WORK (G20-2) sign may be omitted when it conflicts with G20-2 signs already in place on the project.

\*A shadow vehicle equipped with a Truck Mounted Attenuator is typically required. A shadow vehicle equipped with a TMA shall be used if it can be positioned 30' to 100' in advance of the area of crew exposure without adversely affecting the work performance.

Additional requirements for lane closures and advance signing shall be as shown on TCP (6-1) or as directed by the Engineer.




**TRAFFIC CONTROL PLAN**  
**WORK AREA NEAR RAMP**

**TCP (6-2) - 12**

FILE:	tcp6-2.dgn	DN:	TxDOT	CK:	TxDOT	DW:	TxDOT	CK:	TxDOT
©TxDOT	February 1994	CONT	SECT	JOB	HIGHWAY				
REVISIONS		6376	34	001	US 69				
1-97	8-98			DIST	COUNTY	SHEET NO.			
4-98	8-12			BMT	JEFFERSON	22			

DISCLAIMER: The use of this standard is governed by the "Texas Engineering Practice Act". No warranty of any kind is made by TxDOT for any purpose whatsoever. TxDOT assumes no responsibility for the conversion of this standard to other formats or for incorrect results or damages resulting from its use.

DATE: 2/22/2021 1:45:11 PM  
 FILE: T:\BMT\DESIGN\Projects\0028-13-xxx\_IH10-US69\_Bear.Ing\_RMC\Standard\Standard\TCP6-6.dgn

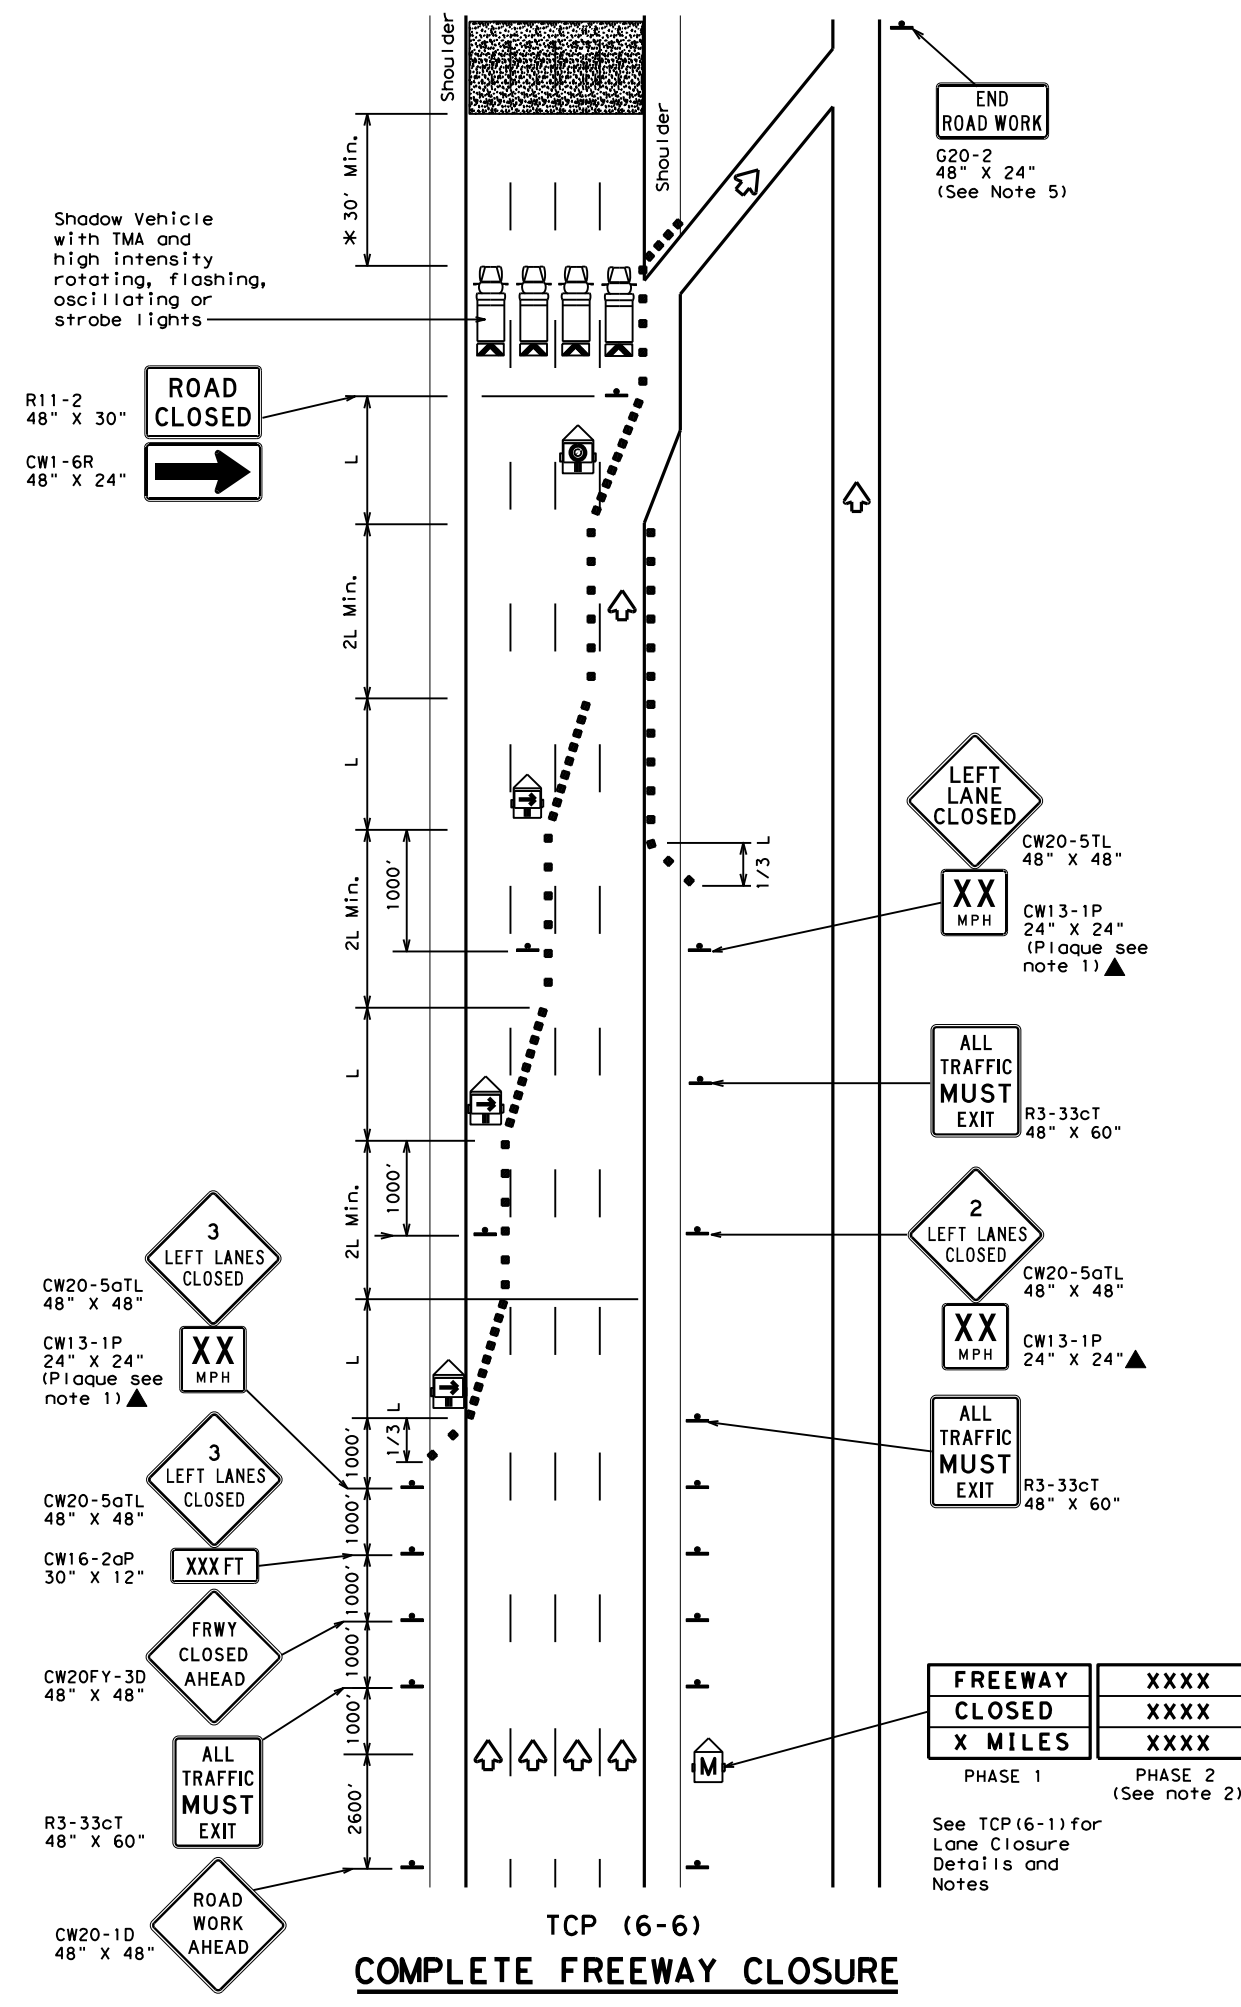

LEGEND			
	Type 3 Barricade		Channelizing Devices
	Heavy Work Vehicle		Truck Mounted Attenuator (TMA)
	Trailer Mounted Flashing Arrow Board		Portable Changeable Message Sign (PCMS)
	Flashing Arrow Board in Caution Mode		Traffic Flow
	Sign		

Posted Speed	Formula	Minimum Desirable Taper Lengths "L"			Suggested Maximum Spacing of Channelizing Devices		Suggested Longitudinal Buffer Space "B"
		10' Offset	11' Offset	12' Offset	On a Taper	On a Tangent	
45	L = WS	450'	495'	540'	45'	90'	195'
50		500'	550'	600'	50'	100'	240'
55		550'	605'	660'	55'	110'	295'
60		600'	660'	720'	60'	120'	350'
65		650'	715'	780'	65'	130'	410'
70		700'	770'	840'	70'	140'	475'
75		750'	825'	900'	75'	150'	540'
80		800'	880'	960'	80'	160'	615'

\*\* Taper lengths have been rounded off.  
 L=Length of Taper (FT) W=Width of Offset (FT) S=Posted Speed (MPH)

TYPICAL USAGE				
MOBILE	SHORT DURATION	SHORT TERM STATIONARY	INTERMEDIATE TERM STATIONARY	LONG TERM STATIONARY
	✓	✓	✓	

- GENERAL NOTES**
- All traffic control devices illustrated are REQUIRED. Devices denoted with the triangle symbol may be omitted when stated elsewhere in the plans.
  - Phase 2 of the PCMS message should include appropriate information formatted as shown on BC(6), such as "MERGE RIGHT," recommended speed, delay, exit information, or other specific warnings.
  - Where queuing is anticipated beyond signing shown, additional PCMS signs, other warning signs, devices or Law Enforcement Officers should be available to warn approaching high speed traffic of the end of the queue, as directed by the Engineer.
  - Entrance ramps located from the advance warning area to the exit ramp should be closed whenever possible.
  - The END ROAD WORK (G20-2) sign may be omitted when it conflicts with G20-2 signs already in place on the project.

\*A shadow vehicle equipped with a Truck Mounted Attenuator is typically required. A shadow vehicle equipped with a TMA shall be used if it can be positioned 30' to 100' in advance of the area of crew exposure without adversely affecting the work performance.

Additional requirements for lane closures and advance signing shall be as shown on TCP (6-1) or as directed by the Engineer.



## TRAFFIC CONTROL PLAN FREEWAY CLOSURE

**TCP (6-6) - 12**


FILE:	tcp6-6.dgn	DN:	TxDOT	CK:	TxDOT	DW:	TxDOT	CK:	TxDOT
©TxDOT	February 1994	CONT	SECT	JOB	HIGHWAY				
REVISIONS		6376	34	001	US 69				
1-97	8-98	DIST	COUNTY	SHEET NO.					
4-98	8-12	BMT	JEFFERSON	23					

DISCLAIMER: The use of this standard is governed by the "Texas Engineering Practice Act". No warranty of any kind is made by TxDOT for any purpose whatsoever. TxDOT assumes no responsibility for the conversion of this standard to other formats or for incorrect results or damages resulting from its use.


DATE: 2/22/2021 1:45:17 PM  
 FILE: T:\BMT\DESIGN\Projects\0028-13-xxx\_IH10-US69\_Bear\ing\_RMC\DCN\Standards\wzrs16.dgn

Warning sign and rumble strip sequence in opposite direction is same as below

Flagger to Flagger (Length of Work Area)	ADT	# of Rumble Strip Arrays
1/8 Mile	< 4,500	1
	≥ 4,500	2
1/4 Mile	< 3,500	1
	≥ 3,500	2
1/2 Mile	< 2,600	1
	≥ 2,600	2
1 Mile	< 1,600	1
	≥ 1,600	2
> 1 Mile	N/A	2

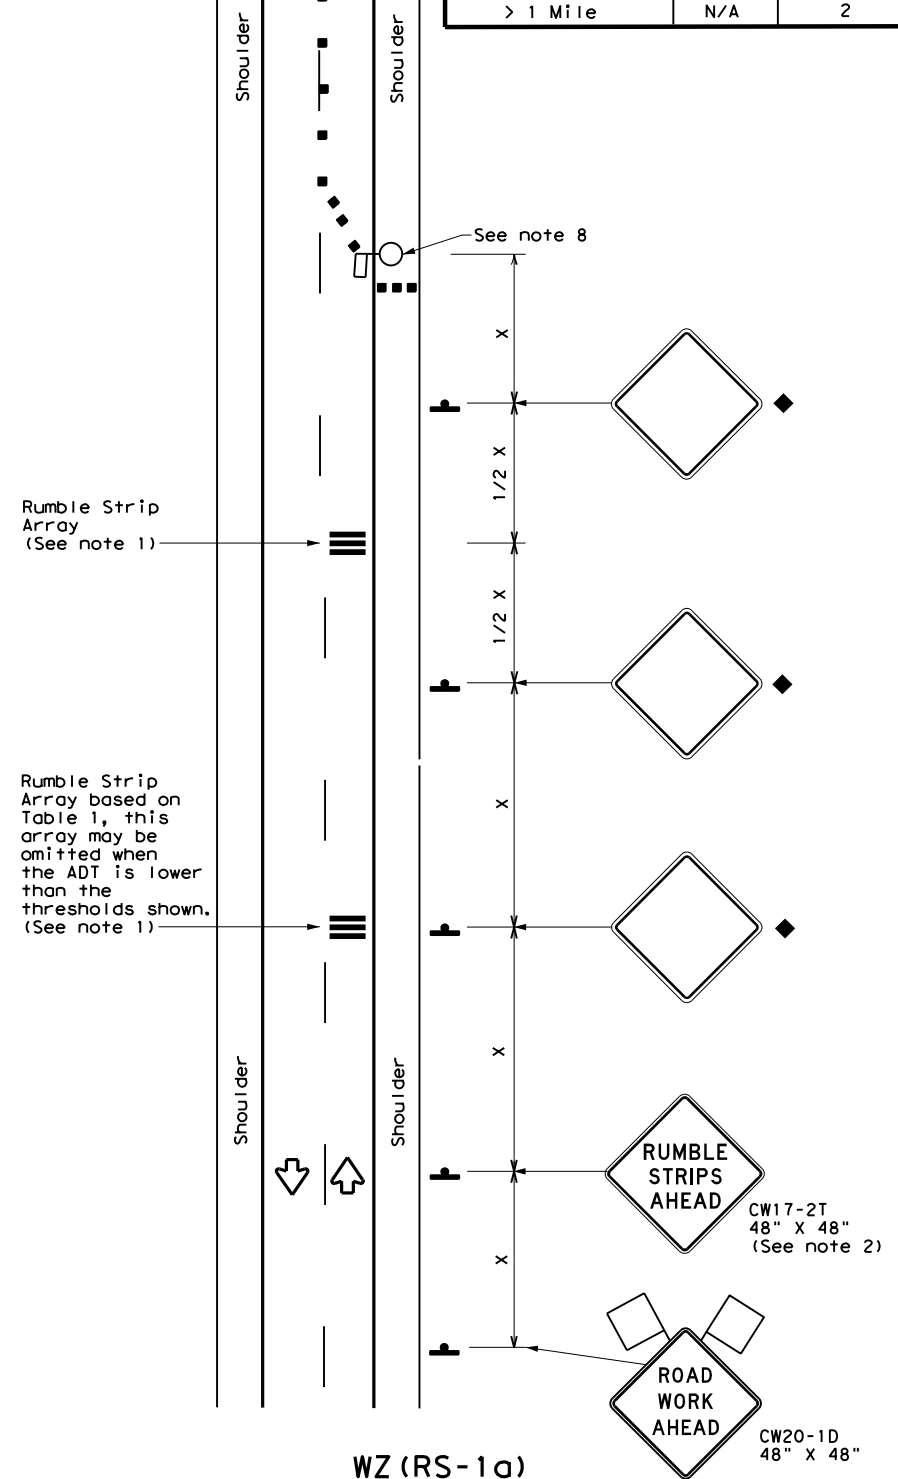

WZ (RS-1a)  
 75 mph or Less  
**RUMBLE STRIPS ON ONE-LANE TWO-WAY APPLICATION**

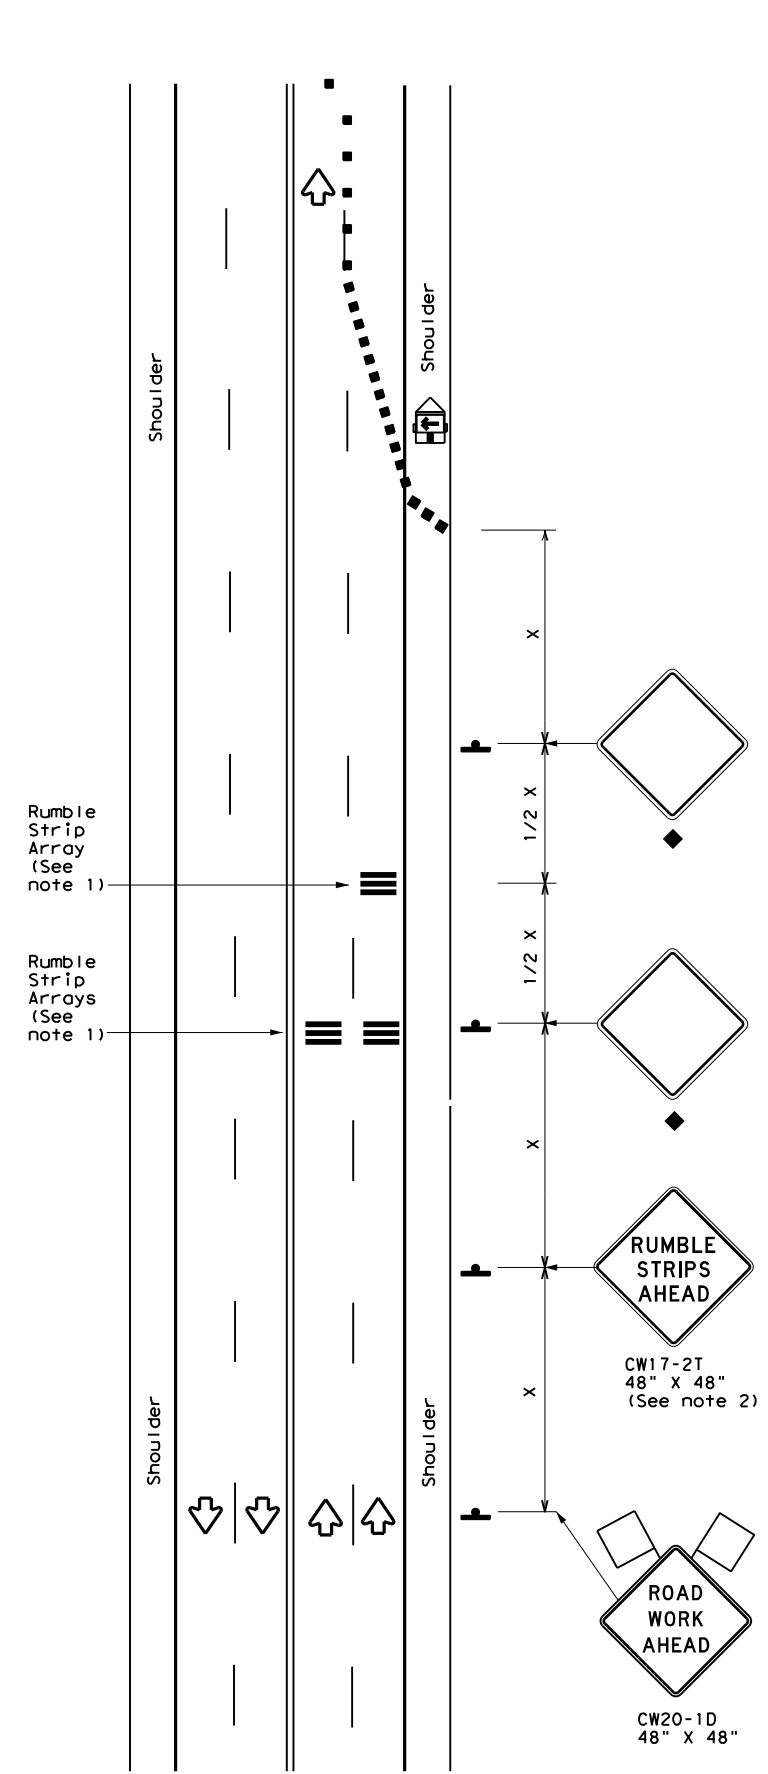

WZ (RS-1b)  
 75 mph or Less  
**RUMBLE STRIPS FOR LANE CLOSURE ON CONVENTIONAL ROADWAY**

**GENERAL NOTES**

- Each Rumble Strip Array should consist of three rumble strips spaced center to center at the spacing shown in Table 2, placed transverse across the lane at locations shown.
- The CW17-2T "RUMBLE STRIPS AHEAD" sign should be located after the CW20-1D "ROAD WORK AHEAD" sign and spaced as shown. If traffic is observed to be queuing, or is expected to queue beyond the Rumble Strips, the CW17-2T sign and the first Rumble Strip Array may be located upstream of the CW20-1D sign as necessary to provide needed warning.
- Temporary Rumble Strips will be considered subsidiary to Item 502, and shall be a product listed on the Compliant Work Zone Traffic Control Devices.
- Removal of the Temporary Rumble Strips should be accomplished before removing the advance warning signs.
- Temporary Rumble Strips should not be used on horizontal curves, loose gravel, soft or bleeding asphalt, heavily rutted pavements or unpaved surfaces.
- Temporary Rumble Strips shall be installed and maintained as per manufacturer's recommendations.
- This standard sheet shall be used in conjunction with other appropriate TCP standard, TMUTCD typical application or project specific detail for the project.
- The one-lane two-way application may utilize a flagger, an AFAD or a portable traffic signal.
- Temporary Rumble Strips may be used on freeways or expressways based on engineering judgment.

Speed	Approximate distance between strips in an Array
≤ 40 MPH	10'
> 40 MPH & ≤ 55 MPH	15'
> 55 MPH	20'

	Type 3 Barricade		Channelizing Devices
	Heavy Work Vehicle		Truck Mounted Attenuator (TMA)
	Trailer Mounted Flashing Arrow Panel		Portable Changeable Message Sign (PCMS)
	Sign		Traffic Flow
	Flag		Flagger

Posted Speed *	Formula	Minimum Desirable Taper Lengths **			Suggested Maximum Spacing of Channelizing Devices		Minimum Sign Spacing "x" Distance	Suggested Longitudinal Buffer Space "B"
		10' Offset	11' Offset	12' Offset	On a Taper	On a Tangent		
30	L = WS <sup>2</sup> / 60	150'	165'	180'	30'	60'	120'	90'
35		205'	225'	245'	35'	70'	160'	120'
40		265'	295'	320'	40'	80'	240'	155'
45	L = WS	450'	495'	540'	45'	90'	320'	195'
50		500'	550'	600'	50'	100'	400'	240'
55		550'	605'	660'	55'	110'	500'	295'
60		600'	660'	720'	60'	120'	600'	350'
65		650'	715'	780'	65'	130'	700'	410'
70		700'	770'	840'	70'	140'	800'	475'
75		750'	825'	900'	75'	150'	900'	540'

\* Conventional Roads Only  
 \*\* Taper lengths have been rounded off.  
 L=Length of Taper (FT) W=Width of Offset (FT)  
 S=Posted Speed (MPH)

MOBILE	SHORT DURATION	SHORT TERM STATIONARY	INTERMEDIATE TERM STATIONARY	LONG TERM STATIONARY
	✓	✓		

◆ Signs are for illustrative purposes only. Signs required may vary depending on the TCP, TMUTCD Typical Application, or project specific details for the project.

Texas Department of Transportation  
 Traffic Operations Division Standard



## TEMPORARY RUMBLE STRIPS

### WZ (RS) - 16

FILE: wzrs16.dgn	DN: TxDOT	CK: TxDOT	DW: TxDOT	CK: TxDOT
© TxDOT November 2012	CONT	SECT	JOB	HIGHWAY
REVISIONS	6376	34	001	US 69
2-14	DIST	COUNTY	SHEET NO.	
4-16	BMT	JEFFERSON	24	





FILE: I:\BMTDESIGN\Projects\0028-13-xxx\*IH10-US69\*Bearing\RMC\DCNAs-Build\Sheets.dgn  
 DATE: 2/25/2021 11:53:01 AM

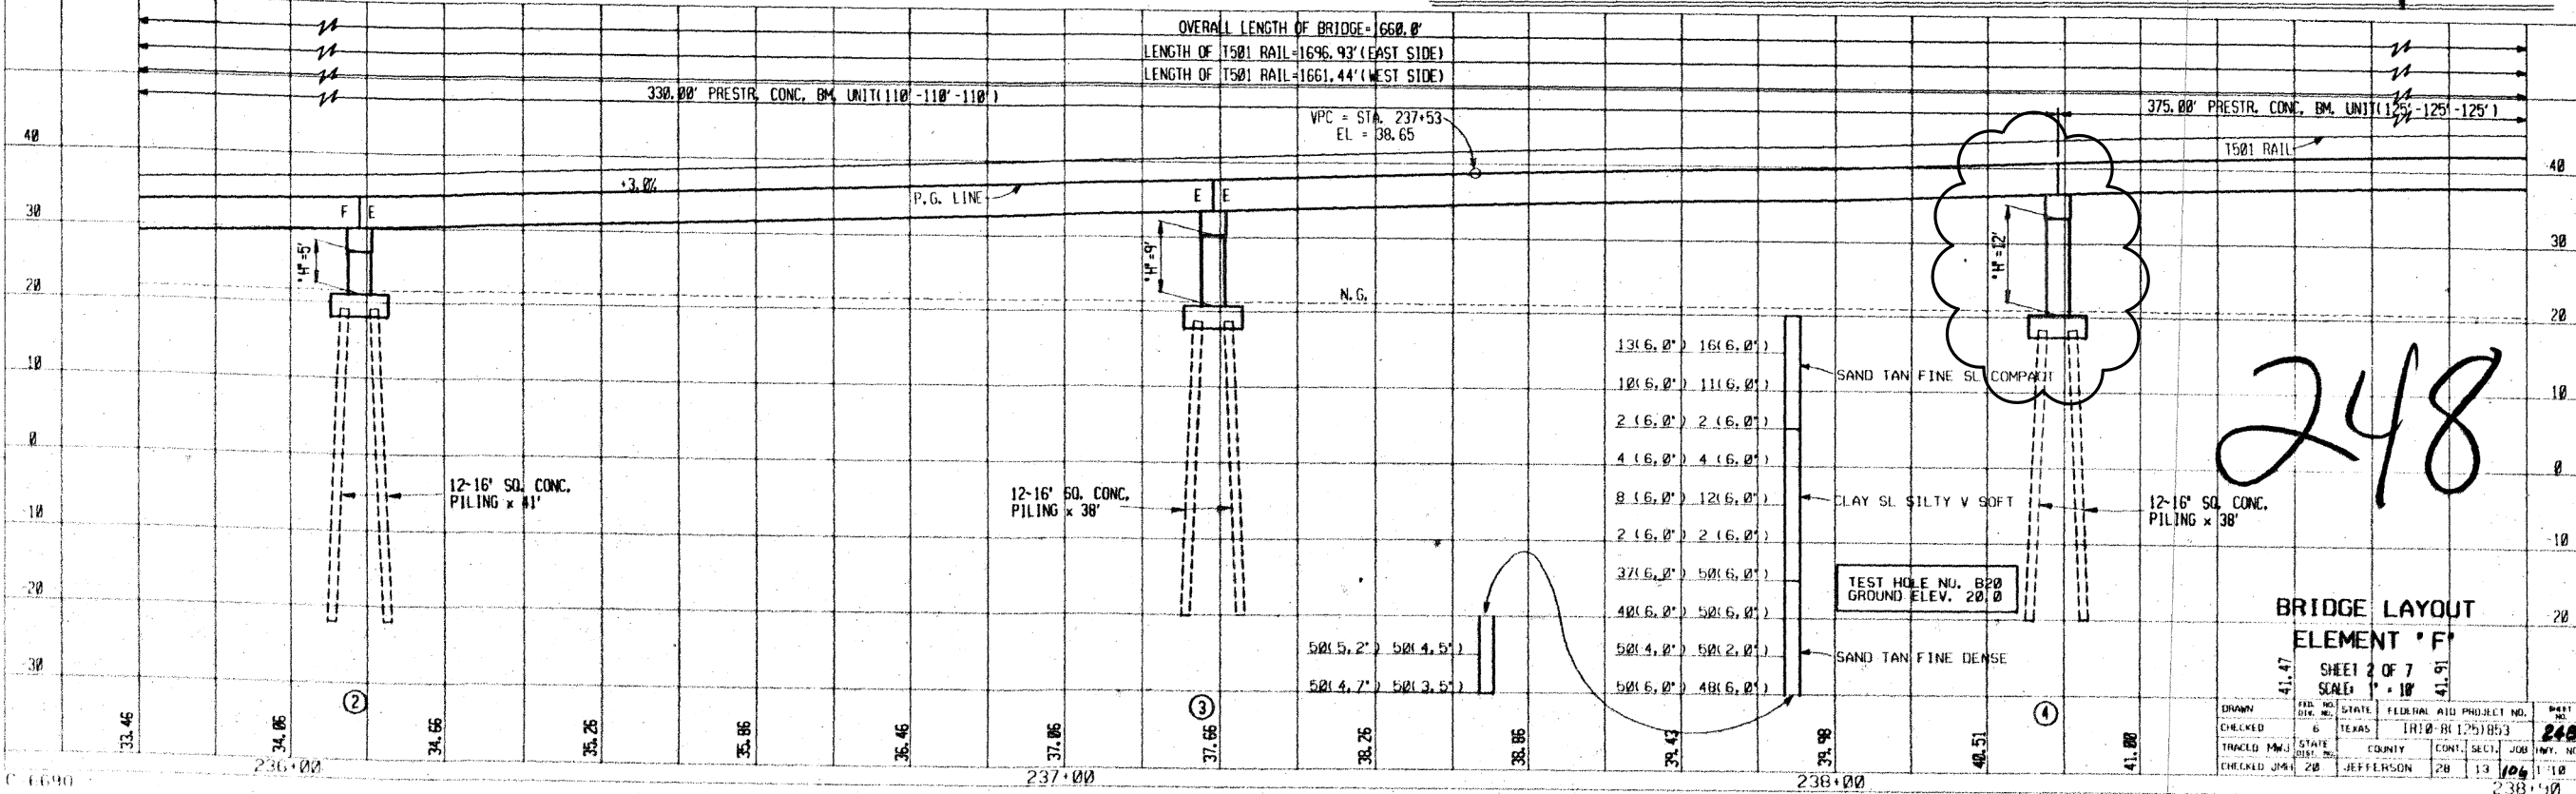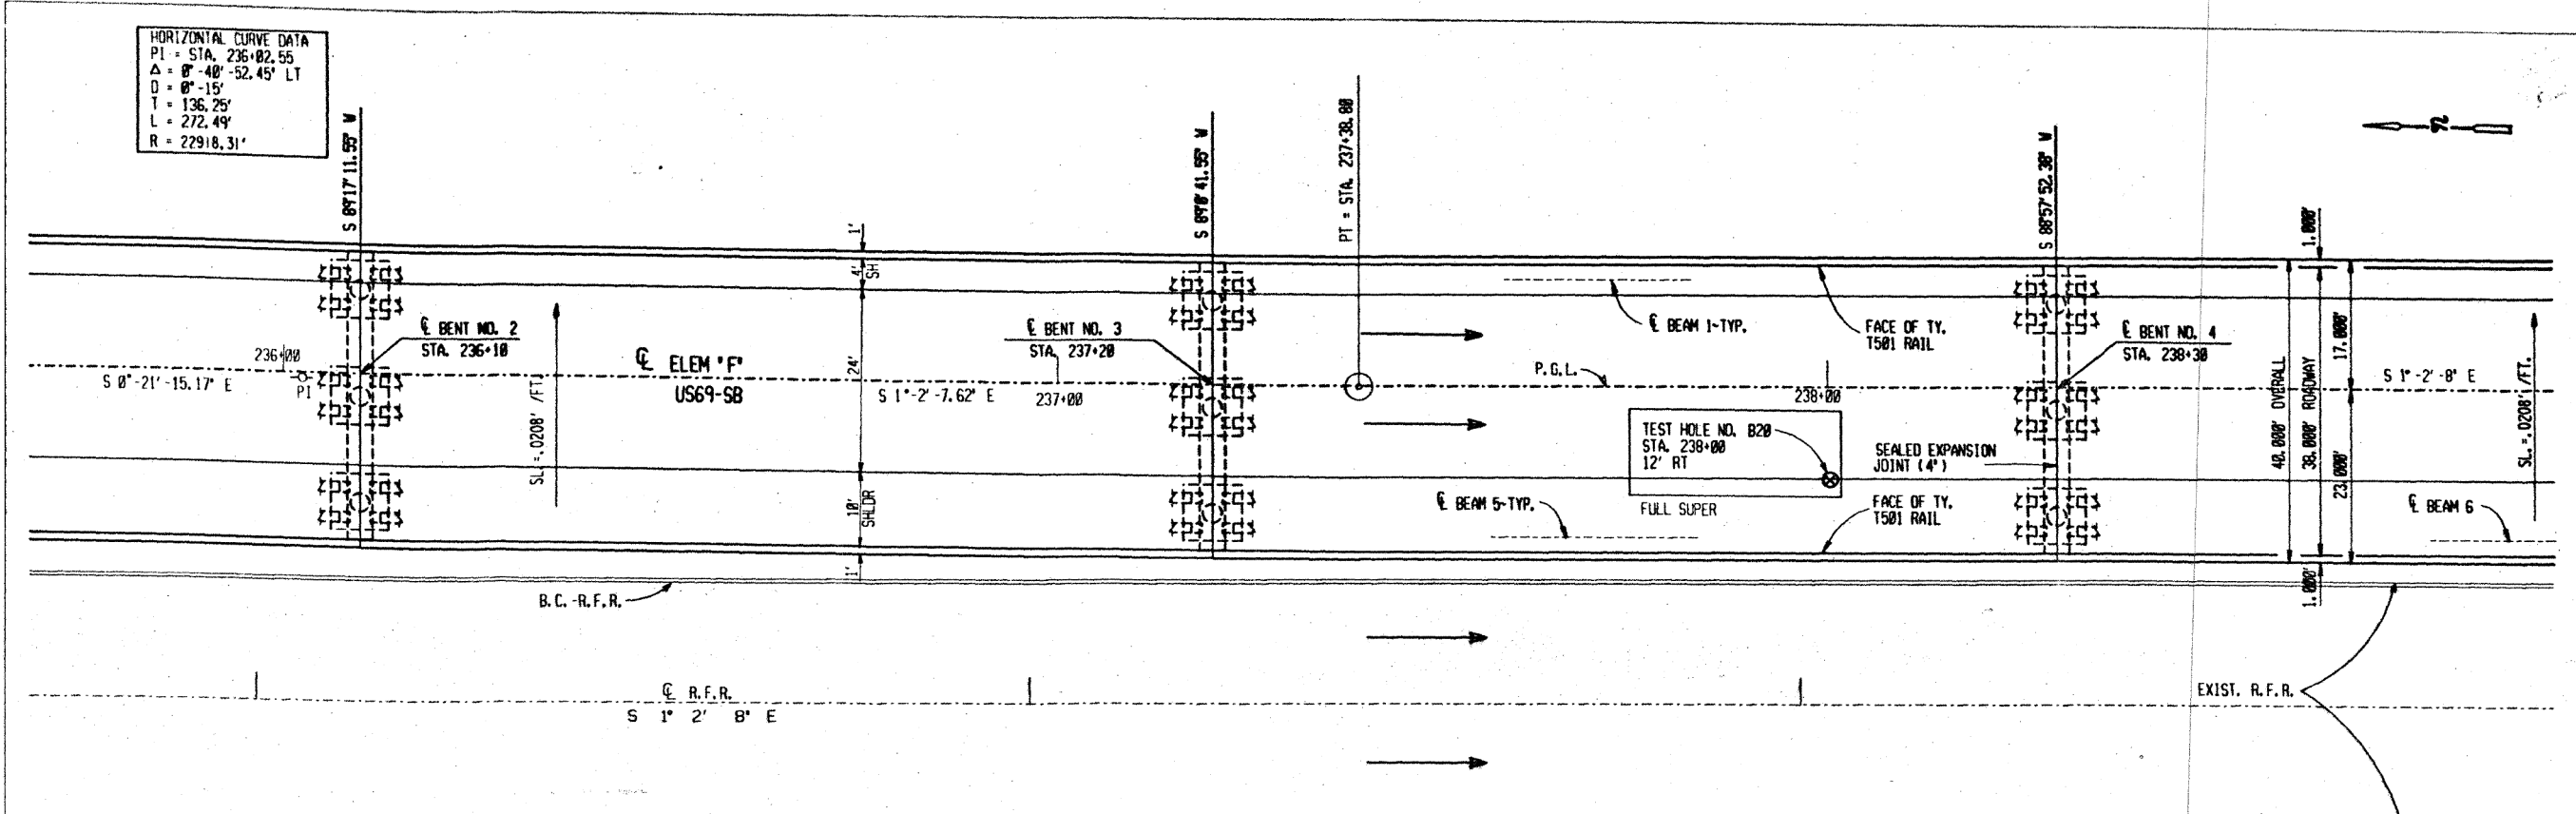


DRAWN	REV. NO.	STATE	FEDERAL AID PROJECT NO.	SHEET NO.
CHECKED	6	TEXAS	IR10-B(125)B53	248
TRACED	MMJ	STATE	COUNTY	JOB
CHECKED	J44	28	JEFFERSON	13
				118
				238+00


FEDERAL AID PROJECT NO.		SHEET NO.	
238+00		25	
STATE	DISTRICT	COUNTY	
TEXAS	BMT	JEFFERSON	
CONTROL	SECTION	JOB	HIGHWAY NO.
6376	34	001	US 69

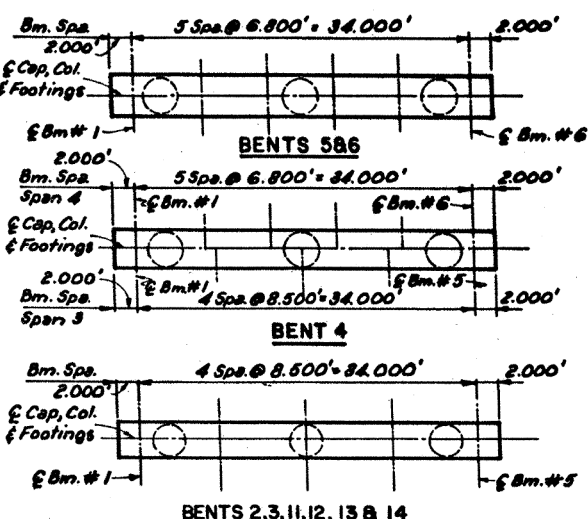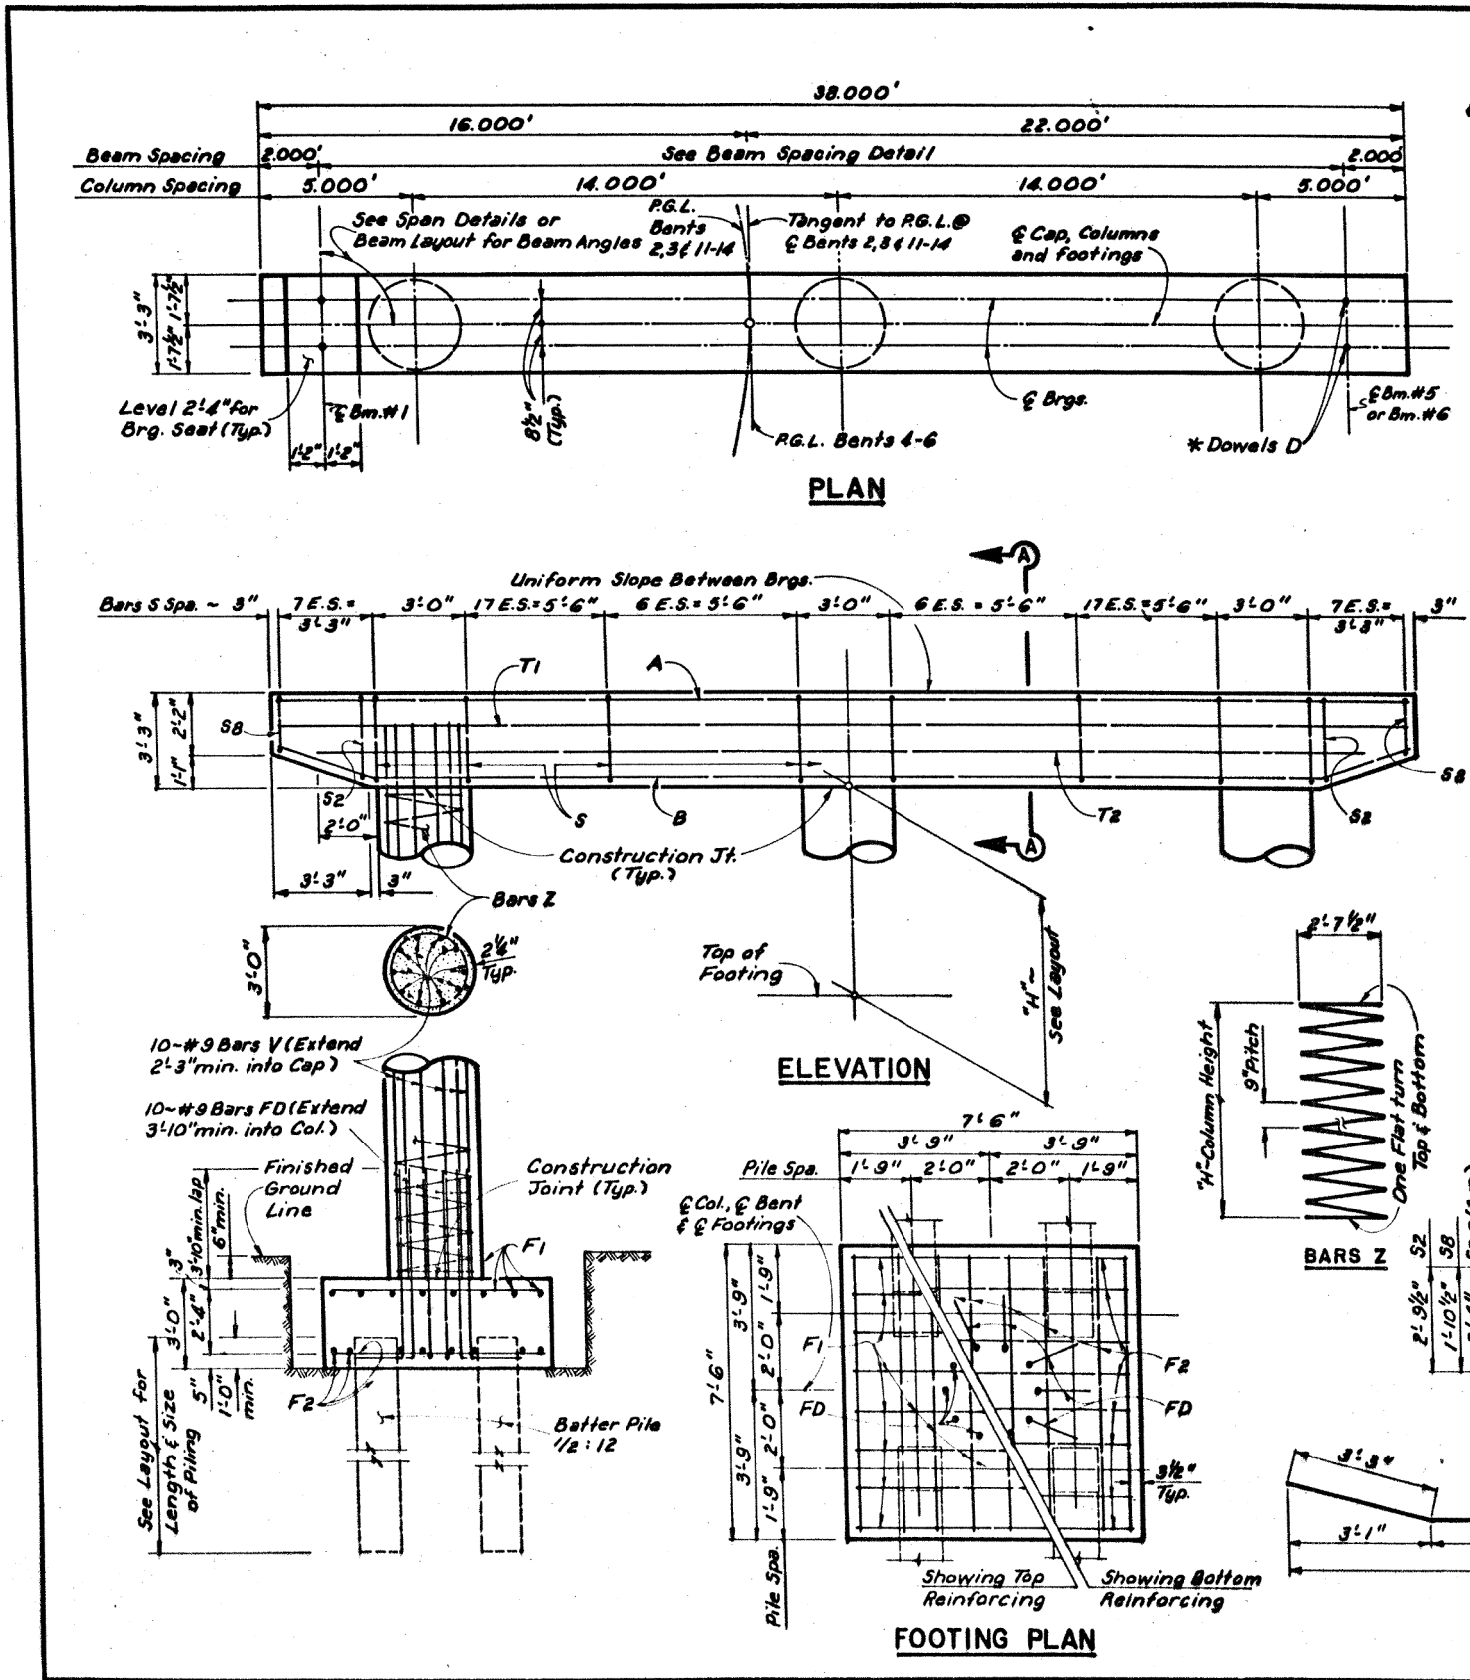

**BEAM SPACING DETAIL**

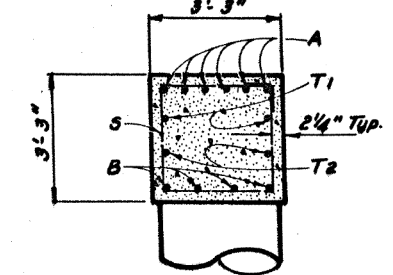

**SECTION A-A**

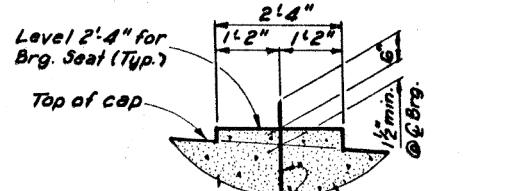

**BEARING SEAT DETAIL**

**• TABLE OF CONSTANT QUANTITIES**

Bar	No.	Size	Length	Weight
A	6	#11	37'-8"	1,201
B	4	#11	38'-0"	808
D	4	1 1/4" Ø	1'-6"	25
S1	50	#5	12'-4"	643
S2-8	14	#5	11'-3" (Av.)	164
T1	2	#5	37'-8"	73
T2	2	#5	35'-0"	73
F1	48	#4	7'-0"	224
F2	48	#8	7'-0"	887
FD	30	#9	7'-11"	808

Reinforcing Steel # L.B. 4,922  
 Class C Concrete (Cap) C.Y. 14.7  
 Class C Concrete (Ftg.) C.Y. 18.8

\* For Contractor's information only  
 \* Omit Dowels D (25 lbs) Bent 4 & (25 lbs) Bent 13  
 All Cap Steel to be Grade 60

**TABLE OF VARIABLE QUANTITIES**


"H"	TOTAL ESTIMATED QUANTITIES						
	Cl. C Conc.	Bars V 30-#8	Bars Z #4	Rainf. 5th #8			
Ft.	C.Y.	Lqth.	Wt.	L.B.	C.Y.		
3	2.4	5'-3"	336	50	100	5,558	35.3
4	3.1	6'-3"	638	61	122	5,682	36.6
5	3.9	7'-3"	740	72	144	5,806	37.4
6	4.7	8'-3"	842	83	166	5,930	38.2
7	5.5	9'-3"	944	94	188	6,054	39.0
8	6.3	10'-3"	1046	105	210	6,178	39.8
9	7.1	11'-3"	1148	116	232	6,302	40.6
10	7.9	12'-3"	1250	127	255	6,427	41.4
11	8.6	13'-3"	1352	138	277	6,551	42.1
12	9.4	14'-3"	1454	149	299	6,675	42.9
13	10.2	15'-3"	1556	160	321	6,799	43.7
14	11.0	16'-3"	1658	171	343	6,923	44.5
15	11.8	17'-3"	1760	182	365	7,047	45.3
16	12.6	18'-3"	1862	193	387	7,171	46.1
17	13.4	19'-3"	1964	204	409	7,295	46.9
18	14.1	20'-3"	2066	215	431	7,419	47.6
19	14.9	21'-3"	2168	226	453	7,543	48.4

Quantities Shown for One Bent only.  
**GENERAL NOTES:**  
 Designed in accordance with A.A.S.H.T.O. 1983 Standard and Interim Specifications.  
 Calculated Pile Load = (Bents 2,3,5,6,11,12) 62 tons/pile (Bent 4) 65 tons/pile & (Bents 5,6) 70 tons/pile  
**HS 20 LOADING**

STATE DEPARTMENT OF HIGHWAYS AND PUBLIC TRANSPORTATION

**INTERIOR BENT NOS. 2-6 & 11-14 ELEMENT "F"**

DATE: MAR 1988	SHEET NO.	PROJECT NO.	NO. OF SHEETS
BY: BMT	257	KH-10-9(125)953	287
CHK: DM			
APP: EAH			
DATE: NRE		JEFFERSON	0028 13 106 TH10

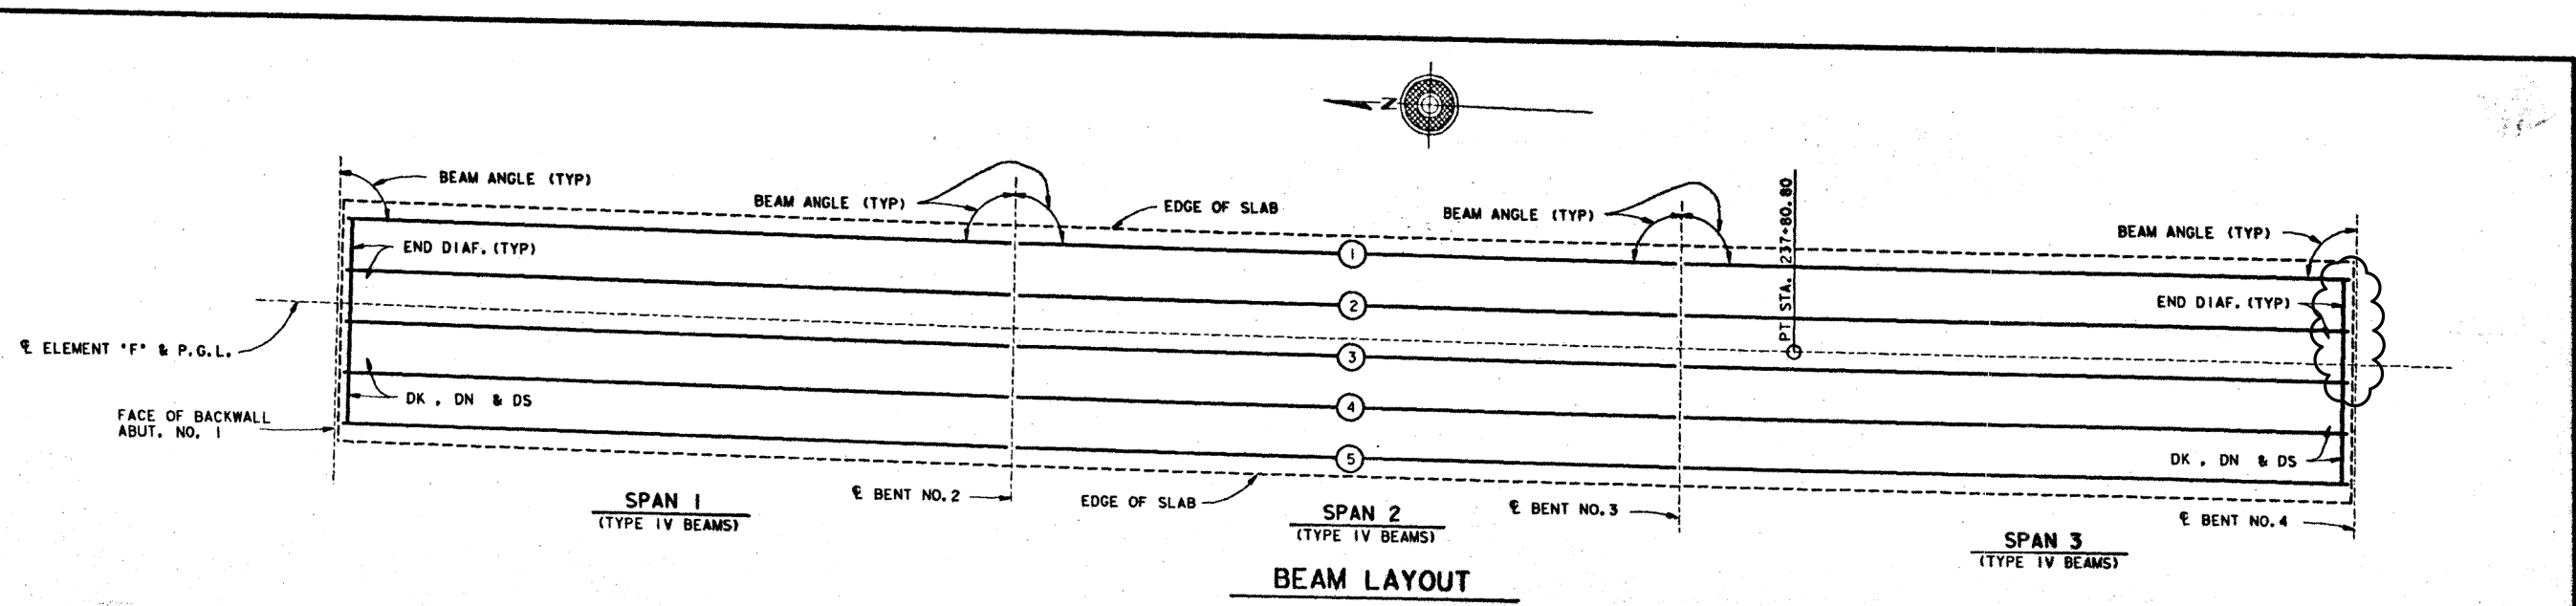

**BEAM LAYOUT**

**BENT REPORT**

BENT NO. 1 (S 89 33 41.55 W)  
DISTANCE BETWEEN STATION LINE AND BEAM 1, 14.0000 L

SPAN	BEAM	BEAM SPAC. (C.L. BENT)	BEAM ANGLE		
			D	M	S
SPAN 1	BEAM 1	0.0000	89 51	45.0	
	BEAM 2	8.5000	89 51	45.0	
	BEAM 3	8.5000	89 51	45.0	
	BEAM 4	8.5000	89 51	45.0	
	BEAM 5	8.5000	89 51	45.0	
	TOTAL	34.0000			

BENT NO. 2 (S 89 17 11.55 W)  
DISTANCE BETWEEN STATION LINE AND BEAM 1, 14.0000 L

SPAN	BEAM	BEAM SPAC. (C.L. BENT)	BEAM ANGLE		
			D	M	S
SPAN 1	BEAM 1	0.0000	89 51	45.0	
	BEAM 2	8.5000	89 51	45.0	
	BEAM 3	8.5000	89 51	45.0	
	BEAM 4	8.5000	89 51	45.0	
	BEAM 5	8.5000	89 51	45.0	
	TOTAL	34.0000			

BENT NO. 3 (S 89 0 41.55 W)  
DISTANCE BETWEEN STATION LINE AND BEAM 1, 14.0000 L

SPAN	BEAM	BEAM SPAC. (C.L. BENT)	BEAM ANGLE		
			D	M	S
SPAN 2	BEAM 1	0.0000	89 51	45.0	
	BEAM 2	8.5000	89 51	45.0	
	BEAM 3	8.5000	89 51	45.0	
	BEAM 4	8.5000	89 51	45.0	
	BEAM 5	8.5000	89 51	45.0	
	TOTAL	34.0000			

BENT NO. 4 (S 88 57 52.38 W)  
DISTANCE BETWEEN STATION LINE AND BEAM 1, 14.0000 L

SPAN	BEAM	BEAM SPAC. (C.L. BENT)	BEAM ANGLE		
			D	M	S
SPAN 3	BEAM 1	0.0000	89 59	45.5	
	BEAM 2	8.5000	89 59	45.5	
	BEAM 3	8.5000	89 59	45.5	
	BEAM 4	8.5000	89 59	45.5	
	BEAM 5	8.5000	89 59	45.5	
	TOTAL	34.0000			

**BEAM REPORT**

SPAN 1

BEAM	HORIZONTAL DISTANCE		TRUE DISTANCE BOT. BM. FLG.
	C-C BENT	C-C BRG.	
BEAM 1	109.9327	108.5160	109.6487
BEAM 2	109.9735	108.5568	109.6895
BEAM 3	110.0143	108.5976	109.7303
BEAM 4	110.0551	108.6384	109.7711
BEAM 5	110.0959	108.6792	109.8118

SPAN 2

BEAM	HORIZONTAL DISTANCE		TRUE DISTANCE BOT. BM. FLG.
	C-C BENT	C-C BRG.	
BEAM 1	109.9327	108.5160	109.6487
BEAM 2	109.9735	108.5568	109.6895
BEAM 3	110.0143	108.5976	109.7303
BEAM 4	110.0551	108.6384	109.7711
BEAM 5	110.0959	108.6792	109.8118

SPAN 3

BEAM	HORIZONTAL DISTANCE		TRUE DISTANCE BOT. BM. FLG.
	C-C BENT	C-C BRG.	
BEAM 1	109.9885	108.5718	109.6986
BEAM 2	109.9955	108.5788	109.7056
BEAM 3	110.0025	108.5858	109.7126
BEAM 4	110.0094	108.5928	109.7196
BEAM 5	110.0164	108.5997	109.7265

• BEAM LENGTHS SHOWN ARE BOTTOM BEAM FLANGE LENGTHS WITH ADJUSTMENTS MADE FOR BEAM SLOPE.

261

HS 20 LOADING

STATE DEPARTMENT OF HIGHWAYS AND PUBLIC TRANSPORTATION

**BEAM LAYOUT**  
(SPANS 1-3)


ELEMENT 'F'

D4522FA2135510313869B101.DGN	PREPARED BY AND FOR USE OF TEXAS SDHP
JUNE, 1988	REVISION
20	6
IRAD-8(105)253	261
JEFFERSON	28 13 106 TH 10


FILE: I:\BMTDESIGN\Projects\0028-13-xxx\*IH10-US69\*Beam\ing\*RMCDGN\As-Built\Sheets.dgn  
DATE: 2/26/2021 11:32:29 AM

FHWA TEXAS DIVISION	FEDERAL AID PROJECT NO.	SHEET NO.
TEXAS	DISTRICT	COUNTY
CONTROL	SECTION	JOB
6376	34	001
		US 69

FILE: I:\BMTDESIGN\Projects\0028-13-xxx\I110-US69\Bearing\RMC\DCN\As-Built\Sheets.dgn  
 DATE: 2/26/2021 11:32:55 AM

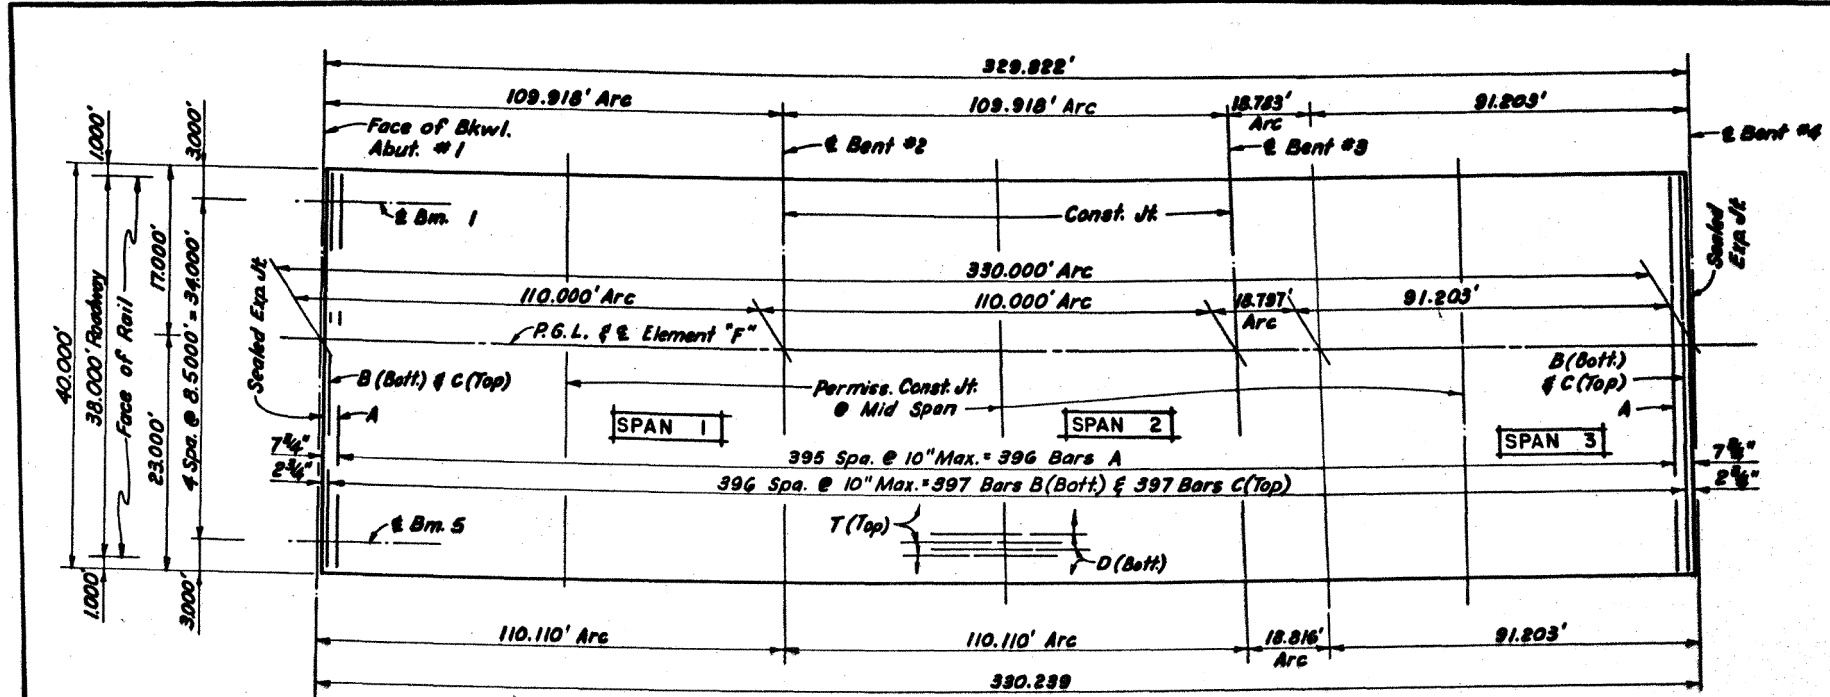


PLAN

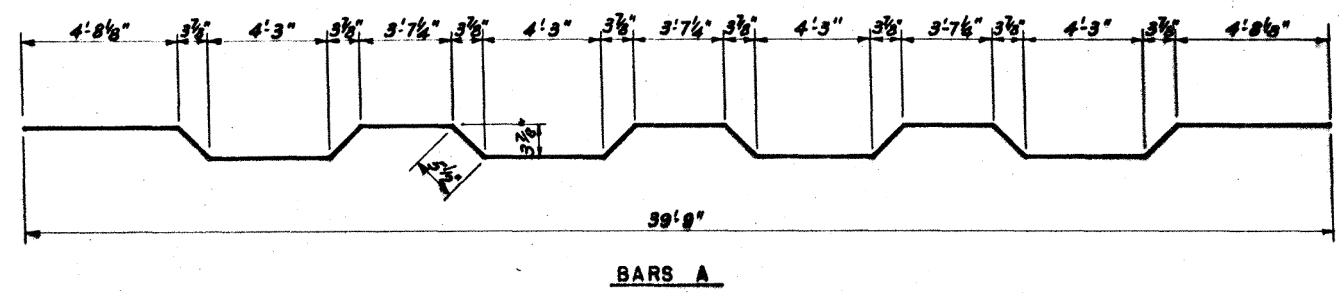


BARS A

Span	"x"	"Δ" S"	"y"
1-2	10"	8 1/4"	5'-4"
3	9 1/4"	8 3/8"	5'-3 1/4"

\* Theoretical value for information only.

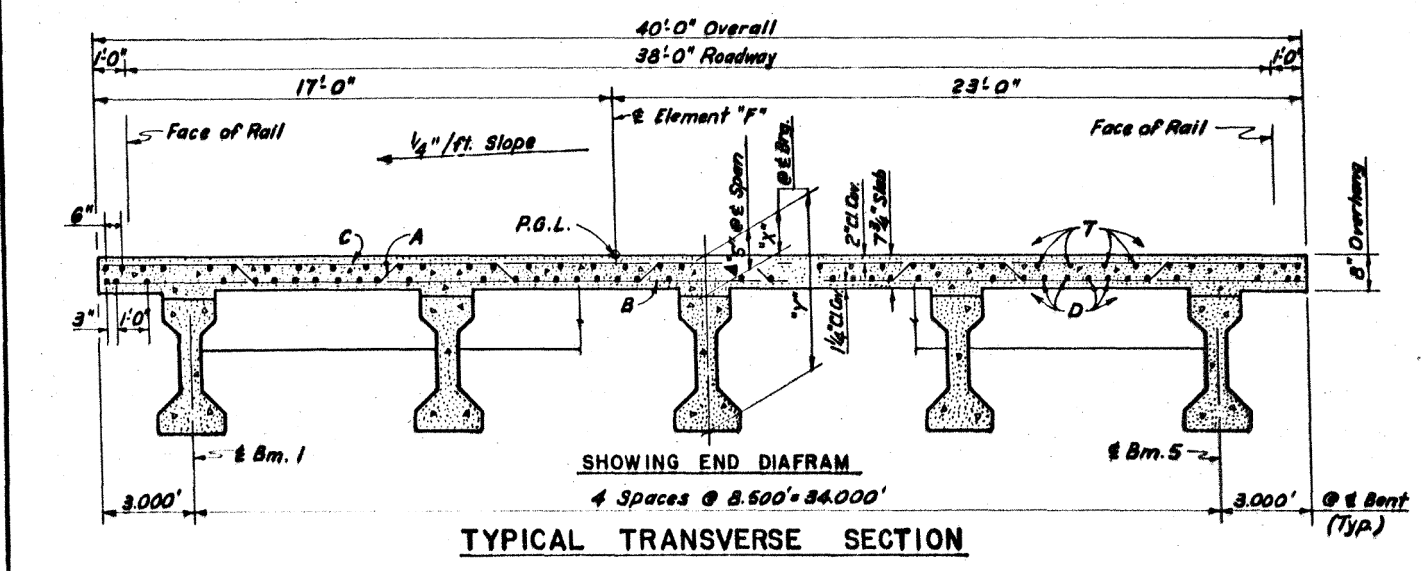

TYPICAL TRANSVERSE SECTION

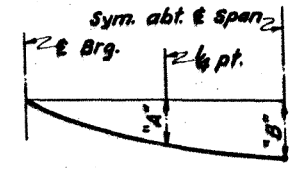

DEAD LOAD DEFLECTION DIAGRAM

Deflections shown are due to cast-in-place concrete only. (E=5 x 10<sup>6</sup>).

Span	"A"	"B"
1-3	0.118"	0.165"

TABLE OF ESTIMATED QUANTITIES

Bar	No.	Size	Length	Weight
A	396	#5	40'-10"	16,864
B	397	#4	39'-9"	10,542
C	397	#5	39'-9"	16,459
D	42	#5	337'-0"	14,763
T	40	#4	335'-9"	8,971
DK	32	#5	6'-6"	217
DS	56	#4	6'-4"	199
DN	2	#8	35'-0"	197

Reinforcing Steel	L.B.	68,208
Prestr. Conc. Brms. (Ty. II)	L.F.	1645.87

Slab	Reinf. Conc. slab ~ S.F.	Cl. 5 Conc. ~ C.Y. +	Diag. slab
1	4400	1.3	108.8
2	4400	-	108.8
3	4400	1.3	108.2
Total	13200		328.4

\* For Contractor's information only.  
 † Includes 5-1'2" Min. Laps.  
 \* Includes 5-1'5" Min. Laps.

262

GENERAL NOTES:  
 Designed in accordance with A.A.S.M.T.O. 1983 Standard & Interim Specifications.  
 Design f<sub>c</sub> = 1200 p.s.i.  
 See "Beam Layout" Sheet for beam lengths, beam angles, diaphragm locations and diaphragm reinforcing locations.  
 The use of PCP shall not be permitted.

HS20 LOADING


STATE DEPARTMENT OF HIGHWAYS AND PUBLIC TRANSPORTATION

330.00' PRESTR. CONC. BEAM UNIT (SPANS 1,2&3)

ELEMENT "F"

DATE: APRIL, 1988	DESIGNER: GMY	CHECKER: DM	APPROVER: BJB
PROJECT: I110-9 (125) P23	SHEET: 262	COUNTY: JEFFERSON	JOB: 0028 18100 I110

FHWA TEXAS DIVISION	FEDERAL AID PROJECT NO.	SHEET NO.
STATE	DISTRICT	COUNTY
TEXAS	BMT	JEFFERSON
CONTROL	SECTION	JOB
6376	34	001
		US 69

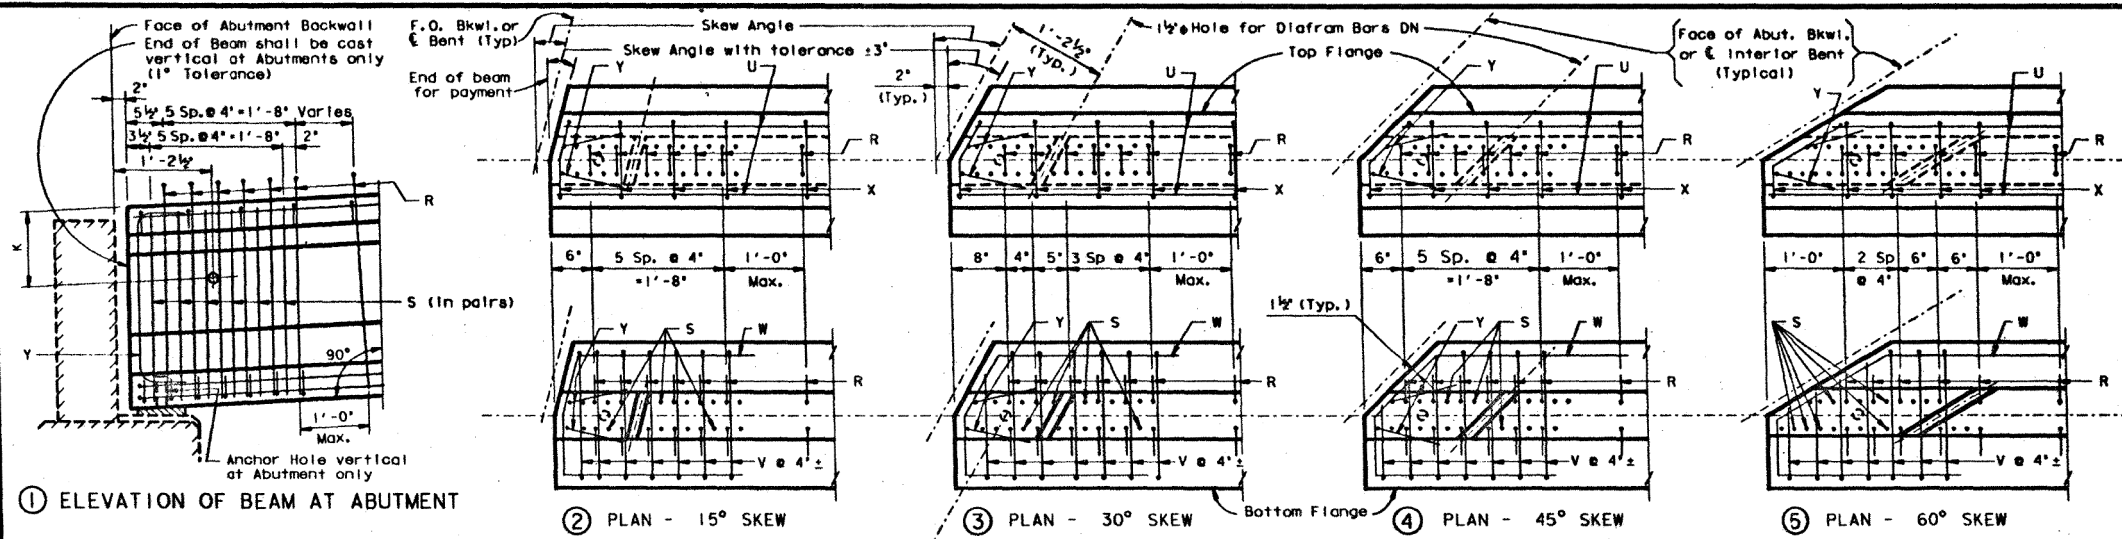

① ELEVATION OF BEAM AT ABUTMENT

② PLAN - 15° SKEW

③ PLAN - 30° SKEW


④ PLAN - 45° SKEW

⑤ PLAN - 60° SKEW

DETAILS OF SKEWED BEAM ENDS


NOTE: Reinforcing patterns shown above are to be used as guides in determining the reinforcement for the actual beam type and the skew angle used. In general, the distance between consecutive Bars R and/or S shall be 2'. This spacing may be varied in order to avoid diaphragm holes, however, a minimum cross sectional area equivalent to that of Bars R and S in square beam end shall be provided.

NOTE: It is permissible for bars or strands to come in contact with materials used in forming anchor and diaphragm holes.

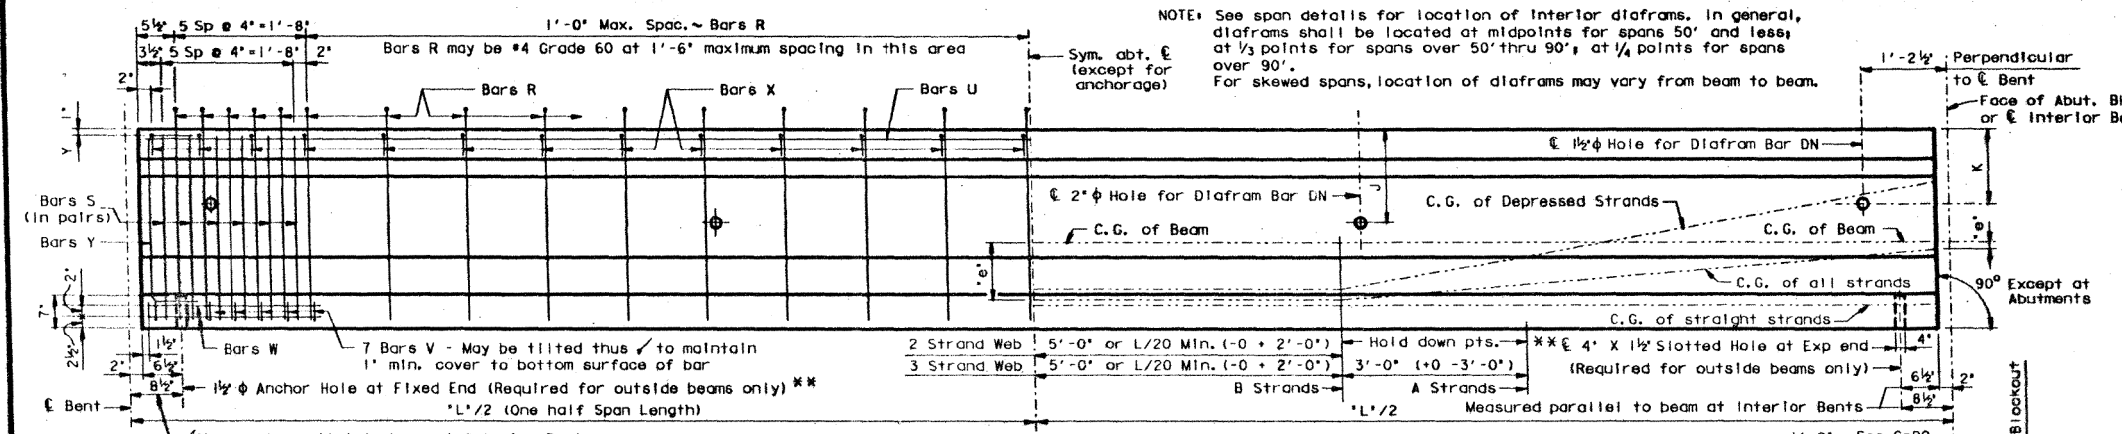

⑥ ELEVATION OF BEAM

NOTE: See span details for location of interior diaphragms. In general, diaphragms shall be located at midpoints for spans 50' and less; at 1/3 points for spans over 50' thru 90'; at 1/4 points for spans over 90'. For skewed spans, location of diaphragms may vary from beam to beam.


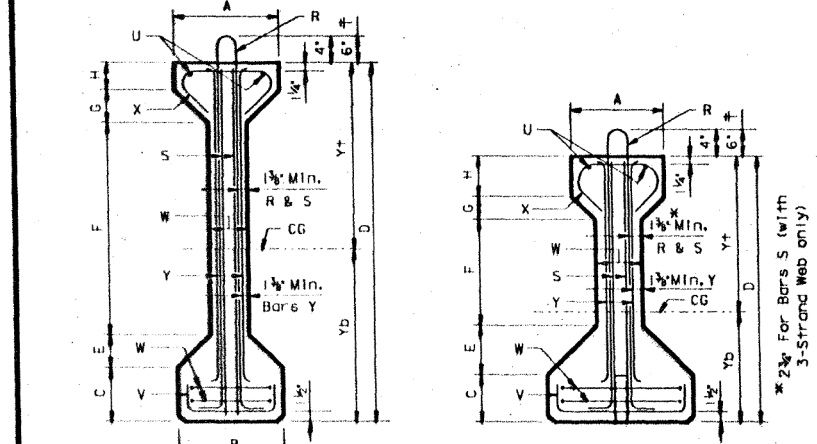


⑦ TYPES 54 72 BEAMS

⑧ TYPES A, B, C, & A. A. S. H. O. IV BEAMS

BEAM TYPE	BEAM DIMENSIONS AND SECTION PROPERTIES											AREA IN. <sup>2</sup>	I IN. <sup>4</sup>	WT/LF LB.		
	A IN.	B IN.	C IN.	D IN.	E IN.	F IN.	G IN.	H IN.	J IN.	K IN.	W IN.				Y <sup>†</sup> IN.	Y <sup>D</sup> IN.
A	12	16	5	28	5	11	3	4	13	15	6	15.39	12.61	275.4	22,658	287
B	12	18	6	34	5 1/2	14	2 1/2	5 1/2	17	15	6 1/2	19.07	14.93	360.3	43,177	375
C	14	22	7	40	7 1/2	16	3 1/2	6	21	15	7	22.91	17.09	494.9	82,602	516
54	16	16	8	54	5	32	5	4	35	15	6	28.47	25.53	493.4	164,022	514
72	22	22	11	72	7 1/2	40 1/2	7 1/2	5 1/2	47	15	7	38.27	33.73	863.4	532,060	899
IV	20	26	8	54	9	23	6	8	33	18	8	29.25	24.75	788.4	260,403	821

Tolerance for Dimensions J & K = (+ 1/4", - 1")  
(Same tolerance to be applied to all holes for a given Diaphragm Bar DN)

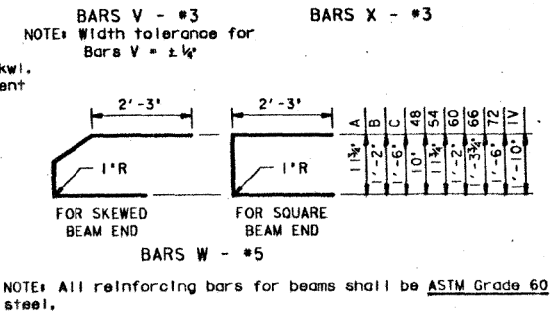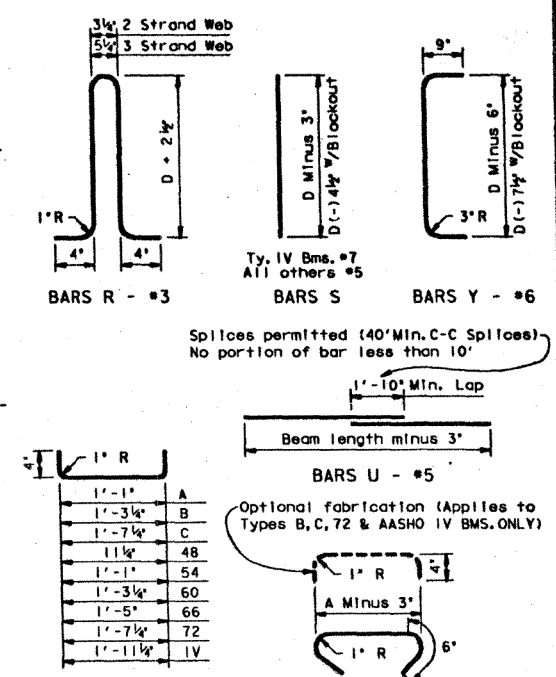

GENERAL NOTES:  
Designed in accordance with current A. A. S. H. T. O. specifications.  
All concrete shall be Class H.  
Bottom corners of all beam flanges and outside corners of exterior beam ends shall be chamfered 1/4" or rounded to a 1/4" Radius.  
The use of diaphragm holes for lifting purposes will not be permitted.

STATE DEPARTMENT OF HIGHWAYS AND PUBLIC TRANSPORTATION

## PRESTRESSED CONCRETE BEAMS

### BEAM DETAILS



# GPa-2

D45112FA21(355116)3867MOD05.DGN PREPARED BY AND FOR USE OF TEXAS SDHPIT  
DATE: JUN 1985  
COUNTY: BELL  
JOB NO: 20 6  
SHEET NO: 5/11  
DRAWN BY: JEFFERSON  
CHECKED BY: JEFFERSON  
DATE: 10/6/85

FILE: I:\BMTDESIGN\Projects\0028-13-xxx\I110-US69\Beam\ing\RMCDGNAs-Bull\11-Sheets.dgn  
DATE: 2/26/2021 11:33:21 AM

FHWA TEXAS DIVISION	FEDERAL AID PROJECT NO.	SHEET NO.
STATE	DISTRICT	COUNTY
TEXAS	BMT	JEFFERSON
CONTROL	SECTION	JOB
6376	34	001
		HIGHWAY NO.
		US 69

FILE: I:\BMD\DESIGN\Projects\0028-13-xxx\I10-0569\Bearing\RC\DNAs-Bul\11-Sheets.dgn  
 DATE: 2/25/2011 11:33:50 AM

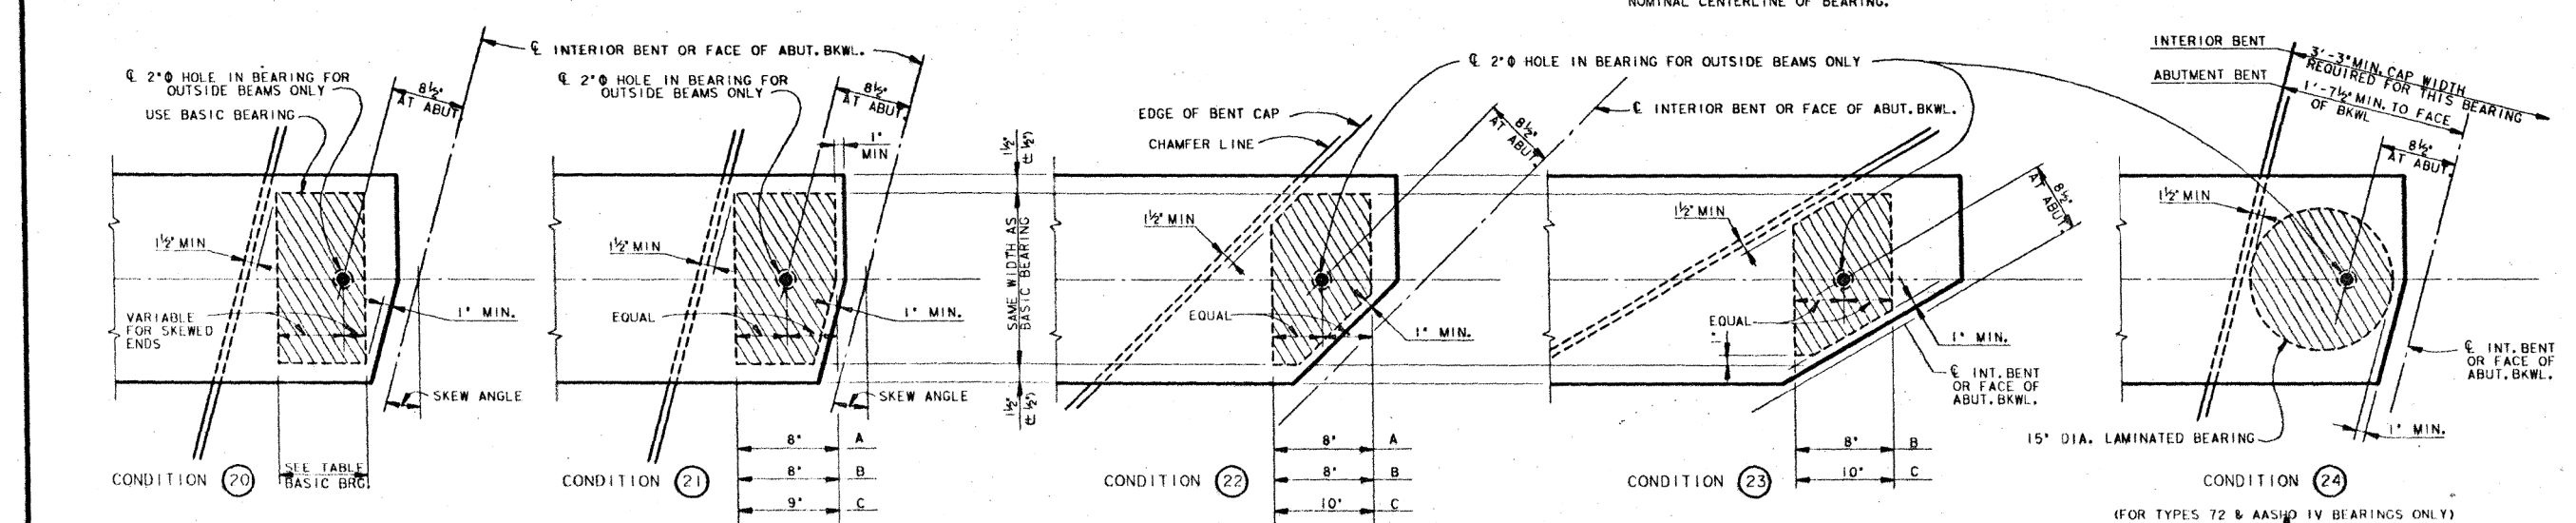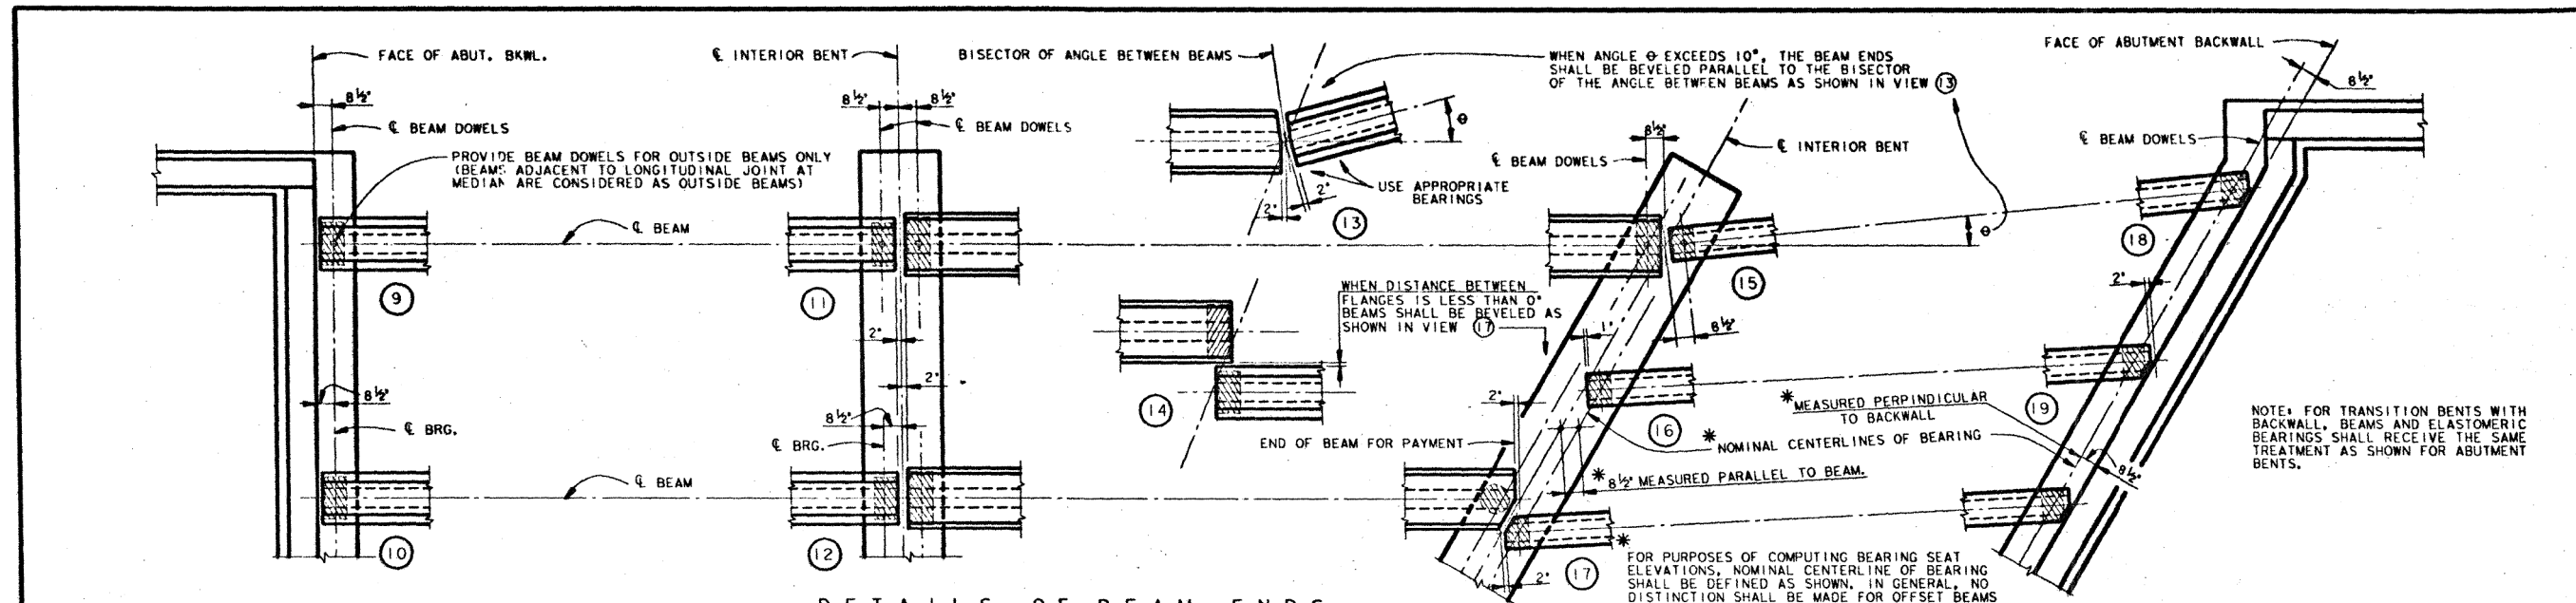


NOTE: BASIC BEARINGS ARE TO BE USED FOR SQUARE BEAM ENDS AND FOR MODERATELY SKEWED BEAM ENDS AS COVERED IN CONDITION (20). HOLES IN BEARINGS FOR SQUARE BEAMS SHALL BE CENTERED IN PAD.

BASIC BEARINGS			
BM. TYPE	SIZE, THICKNESS, T & B	DESCRIPTION	
A	8" x 14" x 3/4"	PLAIN	
B	8" x 16" x 3/4"	PLAIN	
C	9" x 19" x 1"	PLAIN	
54	9" x 14" x 1 1/4"	LAMINATED	
72	9" x 20" x 1 1/4"	LAMINATED	
IV	9" x 22" x 1 1/4"	LAMINATED	
▲ C-1	9" x 19" x 1 1/4"	LAMINATED	
▲ C-2	9" x 19" x 2 1/4"	LAMINATED	
▲ IV-1	9" x 22" x 2 1/4"	LAMINATED	

BEARINGS FOR BEVELED BEAM ENDS					
BM. TYPE	CONDITION (20)	CONDITION (21)	CONDITION (22)	CONDITION (23)	CONDITION (24)
A	0° THRU 20°	20° THRU 30°	OVER 30°	N/A	N/A
B	0° THRU 15°	15° THRU 30°	30° THRU 55°	OVER 55°	N/A
C	0° THRU 10°	10° THRU 20°	20° THRU 50°	OVER 50°	N/A
54	0° THRU 10°	10° THRU 25°	OVER 25°	N/A	N/A
72	0° THRU 10°	N/A	N/A	N/A	OVER 10°
IV	0° THRU 8°	N/A	N/A	N/A	OVER 8°
▲ C-1	0° THRU 10°	N/A	N/A	N/A	N/A
▲ C-2	0° THRU 10°	10° THRU 20°	20° THRU 50°	OVER 50°	N/A
▲ IV-1	0° THRU 8°	N/A	N/A	N/A	N/A

GENERAL NOTES:  
 BEAMS SHALL BE SEATED ON ELASTOMERIC BEARINGS OF THE DIMENSIONS SHOWN.  
 BEARINGS SHALL BE FURNISHED WITH THEIR THICKNESS VARYING IN ONE DIRECTION DEPENDING ON THE SLOPE OF THE ERECTED BEAM.  
 CONSTANT THICKNESS BEARINGS MAY BE USED FOR MODERATE BEAM SLOPES IF THE VARIATION IS WITHIN THE ALLOWABLE DIMENSIONAL TOLERANCES GIVEN IN THE SPECIFICATIONS.  
 COST OF FURNISHING AND INSTALLING ELASTOMERIC BEARINGS SHALL BE INCLUDED IN UNIT PRICE BID FOR "PRESTRESSED CONCRETE BEAMS".

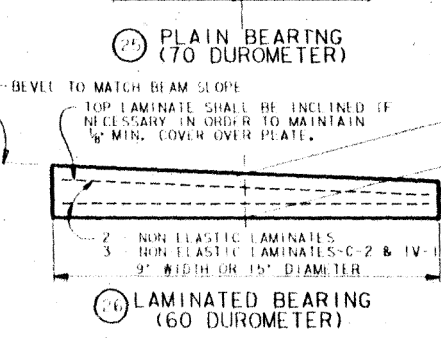

▲ AT ABUTMENT NOS. 1 & 4 FOR HARRISON, NORTH STREET, AND CALDER AVE. OVERPASSES.  
 † AT BENT 2 (FWD), BENT 6 (BOTH) & 10 (BK) ON ELEMENT B.  
 ‡ AT ABUTMENT 1, BENT 4 (BOTH), BENT 7 (BK), BENT 10 (FWD), AND BENT 13 (BK) ON ELEMENT F AND BENT 11 (FWD), BENT 14 (BOTH), AND ABUT. 17 ON ELEMENT E.

SKEW ANGLE OF BEAM END AT ABUTMENT NOS. 1 & 4 FOR HARRISON, NORTH STREET, AND CALDER AVE. OVERPASSES.

318

STATE DEPARTMENT OF HIGHWAYS AND PUBLIC TRANSPORTATION


### PRESTRESSED CONCRETE BEAMS

BEAM ENDS & BEARINGS

Gp B-2 (MOD)

DESIGNED BY: J. FAZELI	STATE PROJECT NO. 133867M001	DATE: JUNE 1985	BY: J. FAZELI
CHECKED BY: J. THO	REVISIONS	NO. 20	DATE: 6/15/85
DATE: 11/0	DATE: 11/0	DATE: 11/0	DATE: 11/0
COUNTY: JEFFERSON		CONTROL SECTION: 0028 13	JOB: 106

FHWA TEXAS DIVISION			FEDERAL AID PROJECT NO.	SHEET NO. 30
STATE	DISTRICT	COUNTY		
TEXAS	BMT	JEFFERSON		
CONTROL	SECTION	JOB	HIGHWAY NO.	
6376	34	001	US 69	

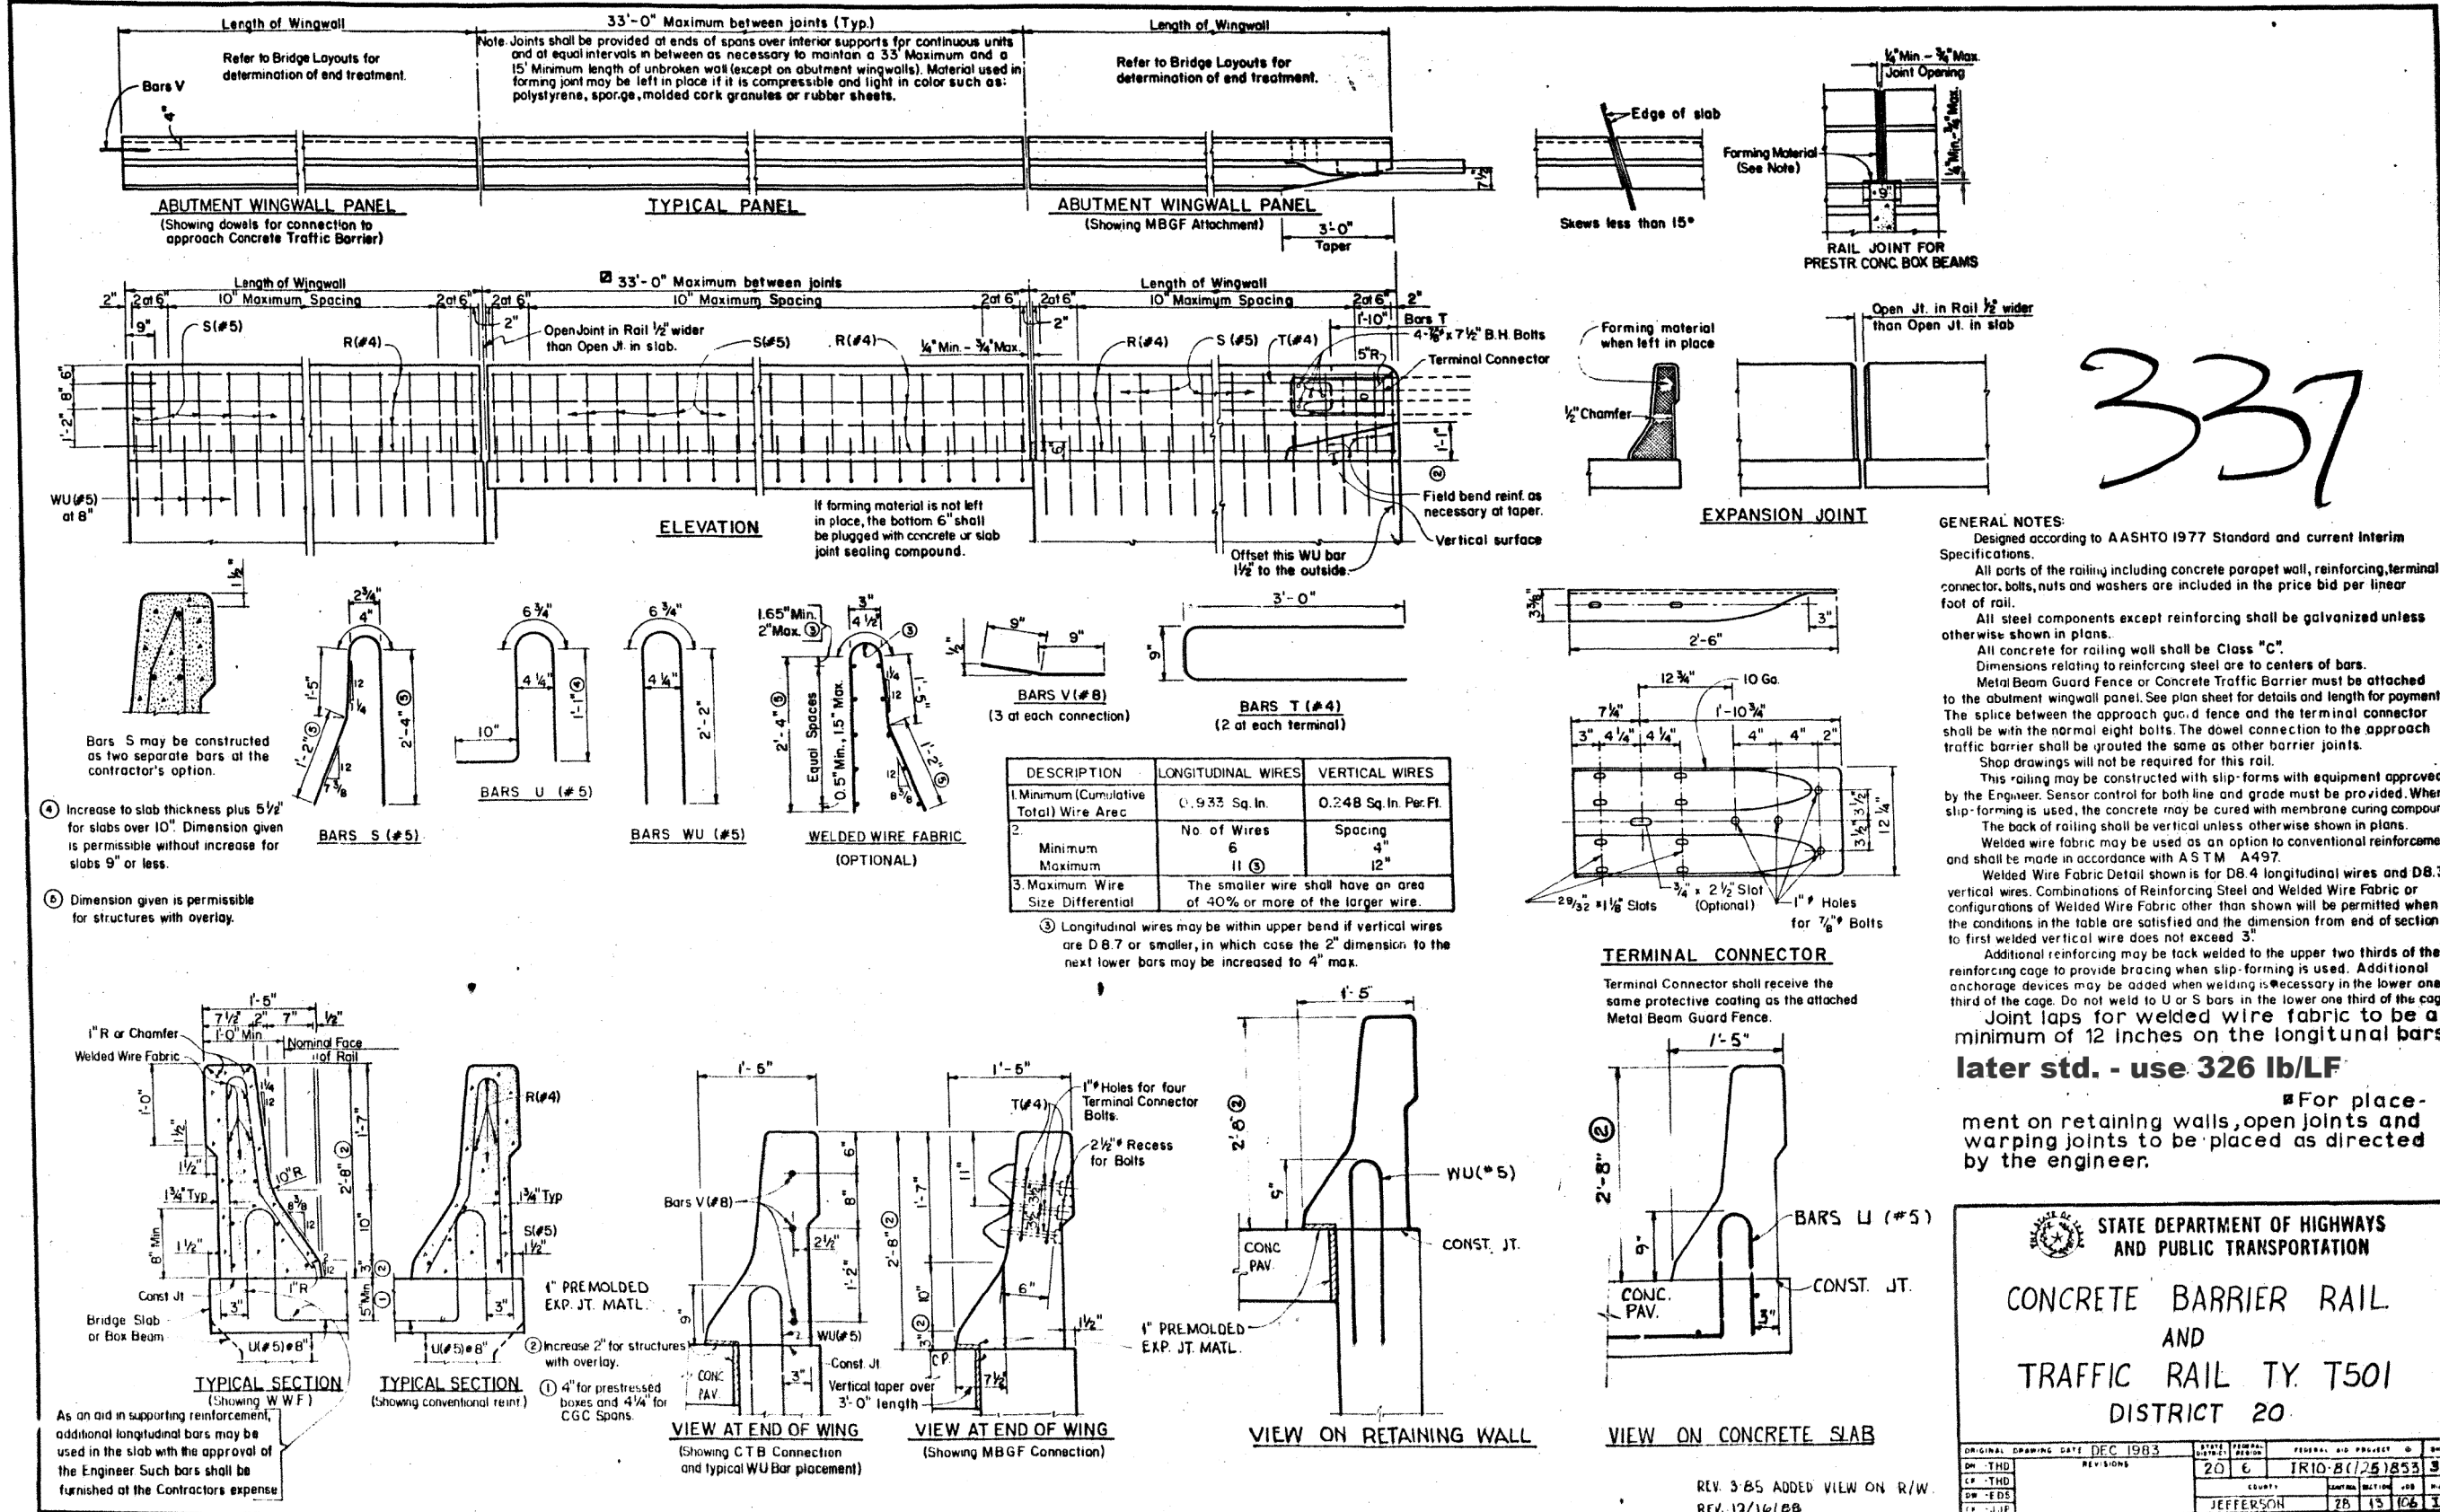

337

STATE DEPARTMENT OF HIGHWAYS AND PUBLIC TRANSPORTATION  
CONCRETE BARRIER RAIL AND TRAFFIC RAIL TY. T501 DISTRICT 20

ORIGINAL DRAWING DATE DEC 1983	DATE FEDERAL AID PROJECT 20 6	FEDERAL AID PROJECT 0 IR10-B(125)853	SHEET 397
DM - THD	REVISIONS	COUNTY JEFFERSON	CONTROL SECTION JOB HIGHWAY NO. 2B 13 106 1-40

REV. 3/85 ADDED VIEW ON R/W.  
REV. 12/16/88

FILE: I:\BMTDESIGN\Projects\0028-13-xxx\I110-US69\Bear\ing\MC\DCNAS-Bull\11-Sheets.dgn  
DATE: 2/26/2021 11:34:17 AM

DISCLAIMER: The use of this standard is governed by the "Texas Engineering Practice Act". No warranty of any kind is made by TxDOT for any purpose whatsoever. TxDOT assumes no responsibility for the conversion of this standard to other formats or for incorrect results or damages resulting from its use.

DATE: 3/4/2021 11:59:52 AM  
 FILE: I:\BMT\DESIGN\Projects\0028-13-xxx\_IH10-US69\_Bear\_Ing\_RMC\DN\Standards\Epic 6-21-2019.dgn

**I. STORMWATER POLLUTION PREVENTION-CLEAN WATER ACT SECTION 402**

TPDES TXR 150000: Stormwater Discharge Permit or Construction General Permit required for projects with 1 or more acres disturbed soil. Projects with any disturbed soil must protect for erosion and sedimentation in accordance with Item 506.

List MS4 Operator(s) that may receive discharges from this project. They may need to be notified prior to construction activities.

- 1. TxDOT - Beaumont District
- 2. \*\*\*\*\*  
 No Action Required     Required Action

Action No.

- 1. Prevent stormwater pollution by controlling erosion and sedimentation in accordance with TPDES Permit TXR 150000
- 2. Comply with the SW3P and revise when necessary to control pollution or as required by the Engineer.
- 3. The project is estimated to involve less than one acre of soil disturbance. In the event the project disturbance acreage becomes equal to or greater than one acre, the CGP is applicable. Contact TxDOT project inspector for coordination with DEQC for necessary action.
- 4. Take measures to prevent construction materials and debris including, but not limited to wastewater (i.e., cooling liquid, etc.) associated with concrete removal from entering any inlets, ditches, or waterways.

**II. WORK IN OR NEAR STREAMS, WATERBODIES AND WETLANDS CLEAN WATER ACT SECTIONS 401 AND 404**

USACE Permit required for filling, dredging, excavating or other work in any water bodies, rivers, creeks, streams, wetlands or wet areas.

The Contractor must adhere to all of the terms and conditions, including Regional conditions for the State of Texas, associated with the following permit(s):

- No Permit Required
- Nationwide Permit 14 - PCN not Required (less than 1/10th acre waters or wetlands affected)
- Nationwide Permit 14 - PCN Required (1/10 to <1/2 acre, 1/3 in tidal waters)
- Individual 404 Permit Required: Permit # \_\_\_\_\_
- Other Nationwide Permit Required: NWP# \_\_\_\_\_

Required Actions: List waters of the US permit applies to, location in project and check Best Management Practices planned to control erosion, sedimentation and post-project TSS.

- 1. Maintain a neat and clean worksite next to the water and do not allow any debris to fall into the water.
- 2. Comply with "Work In or Near Waters/Wetlands Regulatory Requirements and Best Management Practices" section found in the Beaumont District Environmental Field Guide.

The elevation of the ordinary high water marks of any areas requiring work to be performed in the waters of the US requiring the use of a nationwide permit can be found on the Bridge Layouts.

Best Management Practices: N/A

<b>Erosion</b>	<b>Sedimentation</b>	<b>Post-Construction TSS</b>
<input type="checkbox"/> Temporary Vegetation	<input type="checkbox"/> Silt Fence	<input type="checkbox"/> Vegetative Filter Strips
<input type="checkbox"/> Blankets/Matting	<input type="checkbox"/> Rock Berm	<input type="checkbox"/> Retention/Irrigation Systems
<input type="checkbox"/> Mulch	<input type="checkbox"/> Triangular Filter Dike	<input type="checkbox"/> Extended Detention Basin
<input type="checkbox"/> Sodding	<input type="checkbox"/> Sand Bag Berm	<input type="checkbox"/> Constructed Wetlands
<input type="checkbox"/> Interceptor Swale	<input type="checkbox"/> Straw Bale Dike	<input type="checkbox"/> Wet Basin
<input type="checkbox"/> Diversion Dike	<input type="checkbox"/> Brush Berms	<input type="checkbox"/> Erosion Control Compost
<input type="checkbox"/> Erosion Control Compost	<input type="checkbox"/> Erosion Control Compost	<input type="checkbox"/> Mulch Filter Berm and Socks
<input type="checkbox"/> Mulch Filter Berm and Socks	<input type="checkbox"/> Mulch Filter Berm and Socks	<input type="checkbox"/> Compost Filter Berm and Socks
<input type="checkbox"/> Compost Filter Berm and Socks	<input type="checkbox"/> Compost Filter Berm and Socks	<input type="checkbox"/> Vegetation Lined Ditches
	<input type="checkbox"/> Stone Outlet Sediment Traps	<input type="checkbox"/> Sand Filter Systems
	<input type="checkbox"/> Sediment Basins	

**III. CULTURAL RESOURCES**

- No Action Required     Required Action

Action No.

- 1. Refer to TxDOT Standard Specifications in the event historical issues or archeological artifacts are found during construction. Upon discovery of archeological artifacts (bones, burnt rock, flint, pottery, etc.) cease work in the immediate area and contact the Engineer immediately.

**IV. VEGETATION RESOURCES**

- No Action Required     Required Action

Action No.

- 1. Preserve native vegetation to the extent practical. Contractor must adhere to Construction Specification Requirements Specs 162, 164, 192, 193, 506, 730, 751, 752 in order to comply with requirements for invasive species, beneficial landscaping, and tree/brush removal commitments.
- 2. Comply with "Vegetation and Habitat Impacts: Regulatory Requirements and Best Management Practices" section found in the Beaumont District Environmental Field Guide.

**V. FEDERAL LISTED, PROPOSED THREATENED, ENDANGERED SPECIES, CRITICAL HABITAT, STATE LISTED SPECIES, CANDIDATE SPECIES AND MIGRATORY BIRDS.**

- No Action Required     Required Action

Action No.

- 1. If any listed species are noted in the project area, work shall cease and the TxDOT Inspector or DEQC must be notified immediately. Do not harm any encountered species.
- 2. If caves or sinkholes are discovered on site, cease work in the area and contact the TxDOT Inspector or DEQC for guidance.
- 3. Comply with "Wildlife: Regulatory Requirements and Best Management Practices" section found in the Beaumont District Environmental Field Guide.
- 4. Contractor shall maintain compliance with the Migratory Bird Treaty Act (MBTA). No removal of nests, active or inactive, is allowed during nesting season of the species associated with the nest. If demolition of a bridge or bridge class structure is to occur during nesting season, a survey for migratory birds is required no more than 72 hours in advance of demolition. If nests are discovered from February 15 to October 1, contact the TxDOT Inspector or DEQC immediately. Contractor is responsible for implementing all BMPs and complying with guidance provided in the "Migratory Bird Treaty Act (MBTA)" section of the Beaumont District Environmental Field Guide.
- 5. Roadside Appurtenance Maintenance Program BMPs from the Maintenance EA Best Management Practices Summary Report shall be reviewed and implemented where appropriate.

**LIST OF ABBREVIATIONS**

BMP: Best Management Practice	SPCC: Spill Prevention Control and Countermeasure
CGP: Construction General Permit	SW3P: Storm Water Pollution Prevention Plan
DSHS: Texas Department of State Health Services	PCN: Pre-Construction Notification
FHWA: Federal Highway Administration	PSL: Project Specific Location
MOA: Memorandum of Agreement	TCEQ: Texas Commission on Environmental Quality
MOU: Memorandum of Understanding	TPDES: Texas Pollutant Discharge Elimination System
MS4: Municipal Separate Stormwater Sewer System	TPWD: Texas Parks and Wildlife Department
MBTA: Migratory Bird Treaty Act	TxDOT: Texas Department of Transportation
NOT: Notice of Termination	T&E: Threatened and Endangered Species
NWP: Nationwide Permit	USACE: U.S. Army Corps of Engineers
NOI: Notice of Intent	USFWS: U.S. Fish and Wildlife Service

**VI. HAZARDOUS MATERIALS OR CONTAMINATION ISSUES**

- No Action Required     Required Action

General (applies to all projects):

Comply with the Hazard Communication Act (the Act) for personnel who will be working with hazardous materials by conducting safety meetings prior to beginning construction and making workers aware of potential hazards in the workplace. Ensure that all workers are provided with personal protective equipment appropriate for any hazardous materials used. Obtain and keep on-site Material Safety Data Sheets (MSDS) for all hazardous products used on the project, which may include, but are not limited to the following categories: Paints, acids, solvents, asphalt products, chemical additives, fuels and concrete curing compounds or additives. Provide protected storage, off bare ground and covered, for products which may be hazardous. Maintain product labelling as required by the Act.

Maintain an adequate supply of on-site spill response materials, as indicated in the MSDS. In the event of a spill, take actions to mitigate the spill as indicated in the MSDS, in accordance with safe work practices, and contact the District Spill Coordinator immediately. The Contractor shall be responsible for the proper containment and cleanup of all product spills.

Contact the Engineer if any of the following are detected:

- \* Dead or distressed vegetation (not identified as normal)
- \* Trash piles, drums, canister, barrels, etc.
- \* Undesirable smells or odors
- \* Evidence of leaching or seepage of substances
- \* Any other evidence indicating possible hazardous materials or contamination discovered on site.

List below any bridge class structure(s), not including box culverts, being replaced, rehabilitated, removed, extended or modified as part of this project, or state "None", if applicable.

If "None", then no further action is required. Otherwise TxDOT is responsible for completing asbestos assessment/inspection and evaluation for presence of lead.

Provide results below:

Structure Location	PSN	Element	Lead	Asbestos
US 69 SB AT IH 10 WB	201240002813221	Beam & Cap	NONE	NONE

If Asbestos is present, then TxDOT must retain a DSHS licensed asbestos consultant to assist with the notification, develop abatement/mitigation procedures, and perform management activities as necessary.

If Asbestos is not present, then TxDOT is still required to notify DSHS prior to any scheduled demolition.

In either case, the Contractor is responsible for providing the date(s) for abatement activities and/or demolition with careful coordination between the Engineer and asbestos consultant in order to minimize construction delays and subsequent claims.

Hazardous Materials or Contamination Issues Specific to this Project:

Action No.

- 1. Comply with TxDOT Standard Specification 7.12 and Special Provision 006-012 if evidence of hazardous materials or contamination is noted during construction.
- 2. Notify TxDOT Inspector or DEQC of any hazardous materials spills including fuel, hydraulic fluid, etc.

**VII. OTHER ENVIRONMENTAL ISSUES**

(includes regional issues such as Edwards Aquifer District, etc.)

- No Action Required     Required Action

Action No.

- 1. Comply with "General Construction" section found in the Beaumont District Environmental Field Guide.



**ENVIRONMENTAL PERMITS, ISSUES AND COMMITMENTS EPIC**

FILE: epic.dgn	DN: TxDOT	CK: AM	DW: VP	CK: AR
©TxDOT February 2019	CONT	SECT	JOB	HIGHWAY
	6376	34	001	US 69
	DIST	COUNTY	SHEET NO.	
	BMT	JEFFERSON	32	