

INDEX OF SHEETS

SHEET NO.	DESCRIPTION
1	TITLE SHEET
2	INDEX OF SHEETS

STATE OF TEXAS
DEPARTMENT OF TRANSPORTATION

US 60 MAINLANES

FUNCTIONAL CLASSIFICATION = RURAL PRINCIPAL ARTERIAL
CSJ 0169-07-053: SUPER 2 DESIGN SPEED = 60 MPH
CSJ 0169-07-054: IN TOWN DESIGN SPEED = 45 MPH
FROM TIGNOR ST TO SH 152
ADT (2021) = 5,400
ADT (2041) = 7,500
FROM SH 152 TO ROBERTS COUNTY LINE
ADT (2021) = 2,100
ADT (2041) = 2,900

FED. RD. DIV. NO.	PROJECT NO.	SHEET NO.	
6	C 169-7-53, ETC	1	
STATE	DIST.	COUNTY	
TEXAS	AMA	GRAY	
CONT.	SECT.	JOB	HIGHWAY NO.
0169	07	053, ETC	US 60

PLANS OF PROPOSED
STATE HIGHWAY IMPROVEMENT

PROJECT NO. - C 169-7-53, ETC

US 60

GRAY COUNTY

NET LENGTH OF PROJECT: 75,758.79 FT= 14.348 MILES
CSJ 0169-07-053: 68,118.79 FT= 12.901 MILES
CSJ 0169-07-054: 7,640.00 FT = 1.447 MILES

LIMITS: FROM TIGNOR ST TO ROBERTS COUNTY LINE
CSJ 0169-07-053 LIMITS: FROM SL 171 TO ROBERTS COUNTY LINE
CSJ 0169-07-054 LIMITS: FROM TIGNOR ST TO SL 171

FOR THE CONSTRUCTION OF HIGHWAY IMPROVEMENTS AND ROADWAY WIDENING
CONSISTING OF GRADING, PAVEMENT, DRAINAGE EXTENSIONS,
SIGNING & PAVEMENT MARKING

FINAL PLANS AND QUANTITIES
AS CONSTRUCTED

CONTRACTORS NAME: _____


CONTRACTORS ADDRESS: _____

DATE CONTRACTOR BEGAN WORK: _____

DATE WORK WAS COMPLETED & ACCEPTED: _____

FINAL CONTRACT COST: _____

_____, PE AREA ENGINEER DATE

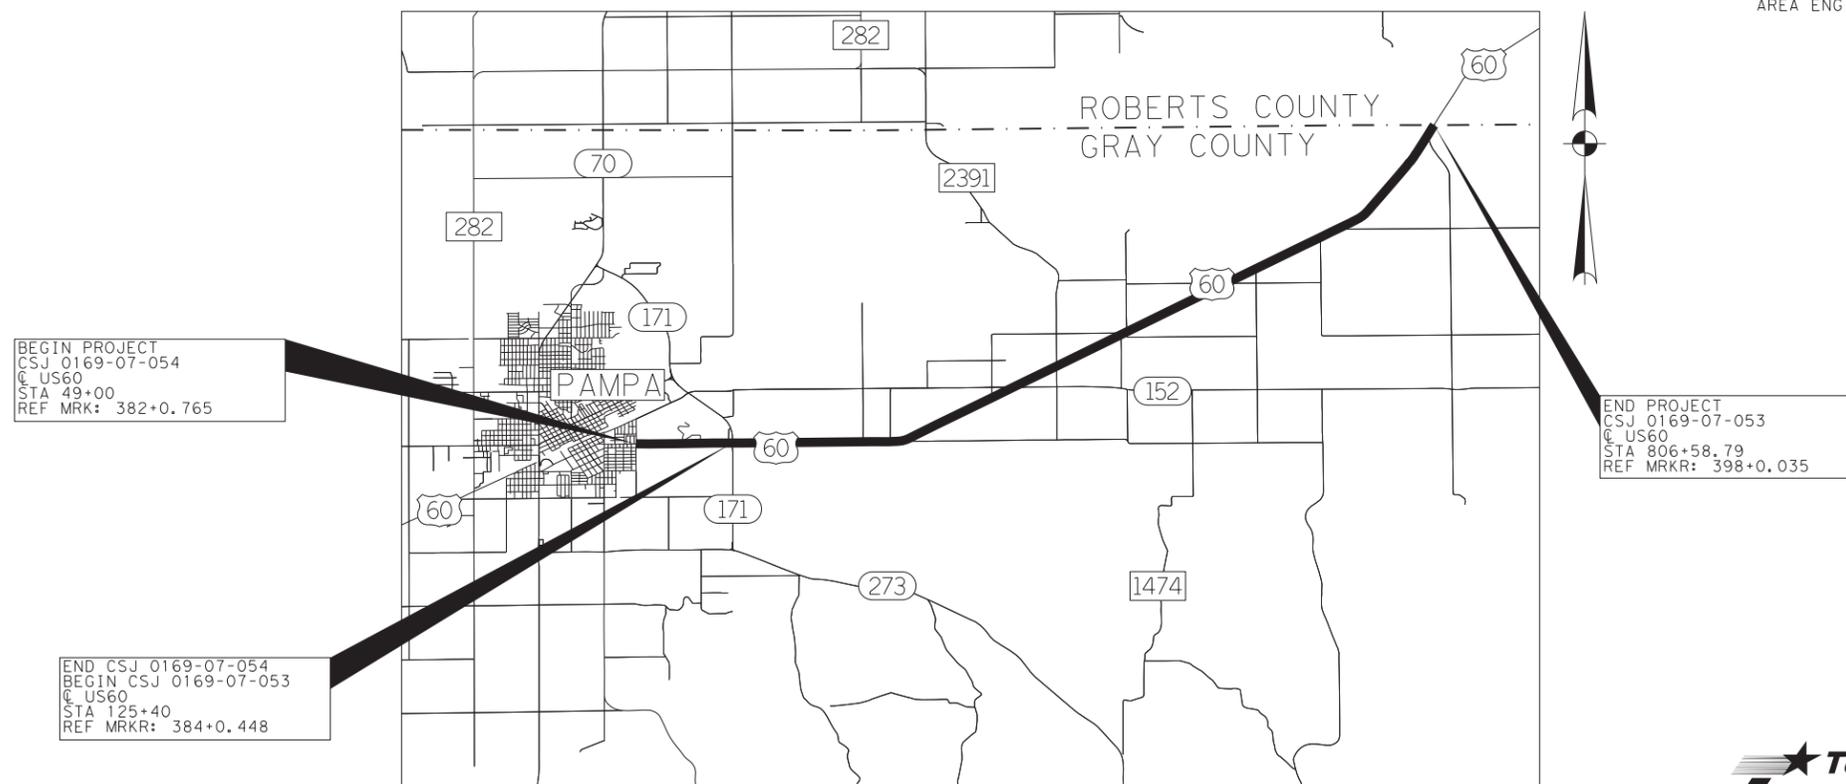

EXCEPTIONS: NONE
EQUATIONS: NONE
RAILROAD CROSSINGS: NONE

CobbFendley
TBPE Firm Registration No. 274
TBPLS Firm Registration No. 100467
13430 Northwest Freeway, Suite 1100
Houston, Texas 77040
713.462.3242 | fax 713.462.3262
www.cobbfendley.com

05/28/2021



Bo L. Ratto

Texas Department of Transportation
© 2021 BY TEXAS DEPARTMENT OF TRANSPORTATION
ALL RIGHTS RESERVED.

RECOMMENDED FOR LETTING: **DocuSigned by:** **Wes Kimmell** DATE: **5/28/2021**

DocuSigned by: **Kit Black** DATE: **6/1/2021**

APPROVED FOR LETTING: **DocuSigned by:** **Blair Johnson** DATE: **6/3/2021**

SPECIFICATIONS ADOPTED BY THE TEXAS DEPARTMENT OF TRANSPORTATION,
NOVEMBER 1, 2014 AND SPECIFICATION ITEMS LISTED AND DATED AS
FOLLOWS, SHALL GOVERN ON THIS PROJECT: SPECIAL LABOR PROVISIONS
FOR STATE PROJECTS (000-008).

FILE: F:\Projects\2019\11004_TxDOT\5x5*PS&E\03_US60*Amor\1\0\ENG\500-USTN\504-General\02-Sheets\US60*GEN-TITLE.dgn
DATE: 5/28/2021 9:33:26 AM

SHEET NO.	DESCRIPTION
	<u>GENERAL</u>
1	TITLE SHEET
2	INDEX OF SHEETS
3	PROJECT LAYOUT
4 - 6	EXISTING TYPICAL SECTIONS
7 - 12	PROPOSED TYPICAL SECTIONS
13 - 13G	GENERAL NOTES
14 - 14B	ESTIMATE & QUANTITY SHEETS
15	REMOVAL QUANTITY SUMMARY
16 - 17	ROADWAY QUANTITY SUMMARY
18	DRIVEWAY QUANTITY SUMMARY
19	MBGF QUANTITY SUMMARY
20	DRAINAGE QUANTITY SUMMARY
21	PAVEMENT MARKINGS QUANTITY SUMMARY
22	SIGNING QUANTITY SUMMARY
23 - 25	US 60 EARTHWORK SUMMARY
26	SH 152 EARTHWORK SUMMARY
27	SW3P QUANTITY SUMMARY

TRAFFIC CONTROL PLAN

28	TCP NARRATIVE
29 - 34	TCP TYPICAL SECTIONS PHASE 2

TRAFFIC CONTROL PLAN STANDARDS

35 - 46	* BC(1)-14 THRU BC(12)-14
47	* TCP (2-1)-18
48	* TCP (2-2)-18
49	* TCP (2-3)-18
50	* TCP (3-1)-13
51	* TCP (3-3)-14
52	* TCP (7-1)-13
53	* WZ (STPM)-13
54	* WZ (UL)-13
55	* WZ (RS)-16

ROADWAY DETAILS

56 - 58	SURVEY CONTROL INDEX MAP
59 - 60	CONTROL SHEET
61	HORIZONTAL ALIGNMENT DATA SHEET
62 - 68	US 60 ROADWAY PLAN & PROFILE
69 - 99	US 60 ROADWAY PLAN
100	SH152 PLAN AND PROFILE
101	SH152 REMOVALS
102	DRIVEWAY AND INTERSECTION LAYOUT

ROADWAY STANDARDS

103	* CRR
104	* GF(31)-19
105	* GF(31)MS-19
106	* SGT(10S)31-16
107	* SGT(12S)31-18
108 - 111	* MB-15(1)
112 - 114	* MB-14(2) THRU MB-14(2B)
115	* TE(HMAC)-11

DRAINAGE DETAILS

116	OVERALL DRAINAGE AREA MAP
117 - 123	DRAINAGE AREA MAP
124	CULVERT HYDRAULIC DATA SHEET
125 - 128	CULVERT EXTENSION LAYOUTS

DRAINAGE STANDARDS

129	* BCS
130	* PW
131 - 132	* SCC-3&4
133 - 134	* SCC-5&6
135 - 137	* SETB-SW-0
138	* PSET-RR
138A	* PSET-RP

UTILITIES

139 - 174	US 60 EXISTING UTILITY PLANS
-----------	------------------------------

SIGNING & PAVEMENT MARKING DETAILS

175 - 185	SUMMARY OF SMALL SIGNS (SOSS)
186 - 220	SIGNING & PAVEMENT MARKING PLANS
221 - 222	US60 & SH171 PAVEMENT MARKINGS
223 - 225	SH152 PAVEMENT MARKINGS
226 - 228	SIGN DETAIL

SIGNING & PAVEMENT MARKING STANDARDS

229	* D&OM(1)-20
230	* D&OM(2)-20
231	* D&OM(3)-20
232	* D&OM(4)-20
233	* D&OM(5)-20
234	* D&OM(VIA)-20
235	* PM(1)-20
236	* PM(2)-20
237	* SMD(GEN)-08
238	* SMD(SLIP-1)-08
239	* SMD(SLIP-2)-08
240	* SMD(SLIP-3)-08
241	* TS2(PL-1)-18
242	* TS2(PL-2)-18
243	* TSR(3)-13 MOD
244	* TSR(4)-13 MOD
245	* TSR(5)-13
246	* RS(2)-13
247	* RS(3)-13
248	* RS(4)-13

ENVIRONMENTAL

249	TxDOT STORM WATER POLLUTION PREVENTION PLAN (SW3P)
250	ENVIRONMENTAL PERMITS ISSUES AND COMMITMENTS (EPIC)
251 - 252	SW3P DRILL SEEDING DETAIL
253 - 264	US 60 SW3P LAYOUT

ENVIRONMENTAL STANDARDS

265	* EC(1)-16
266 - 268	* EC(9)-16
269	* VEGETATION SPECIFICATION SHEET

* THE STANDARD SHEETS SPECIFICALLY IDENTIFIED ABOVE HAVE BEEN SELECTED BY ME OR UNDER MY RESPONSIBLE SUPERVISION AS BEING APPLICABLE TO THIS PROJECT.

Bo L Ratto, P.E. 05/03/2021
DATE

05/03/2021

DOCUMENT IS NOT TO BE USED FOR BIDDING AND NOT INTENDED FOR PERMIT PURPOSES.

BO L. RATTO
113226
TEXAS SERIAL NO. 113226
DATE 4/28/2021

STATE OF TEXAS
BO L. RATTO
113226
LICENSED PROFESSIONAL ENGINEER

Bo L Ratto

REV. NO.	DATE	DESCRIPTION	BY

CobbFendley 13430 Northwest Freeway, Ste. 1100
Houston, Texas 77040
713.462.3242
www.cobbhendley.com

TBPE Firm Registration No. 274
TBPLS Firm Registration No. 100467


Texas Department of Transportation

INDEX OF SHEETS

SHEET 1 OF 1

FED. RD. DIV. NO.	STATE	PROJECT NO.	HIGHWAY NO.		
6	TEXAS	(SEE TITLE SHEET)	US60		
STATE DISTRICT	COUNTY	CONTROL NO.	SECTION NO.	JOB NO.	SHEET NO.
AMA	GRAY	0169	07	053, ETC	2

4/7/2021 7:26:08 AM F:\P\proj\2019\1004_TxDOT_5x5_PSS&E\03_US60_Amtr\11616\ENG\500\UST\IN\504-Gener\02-Sheet\US60_GEN_LAYOUT.dgn

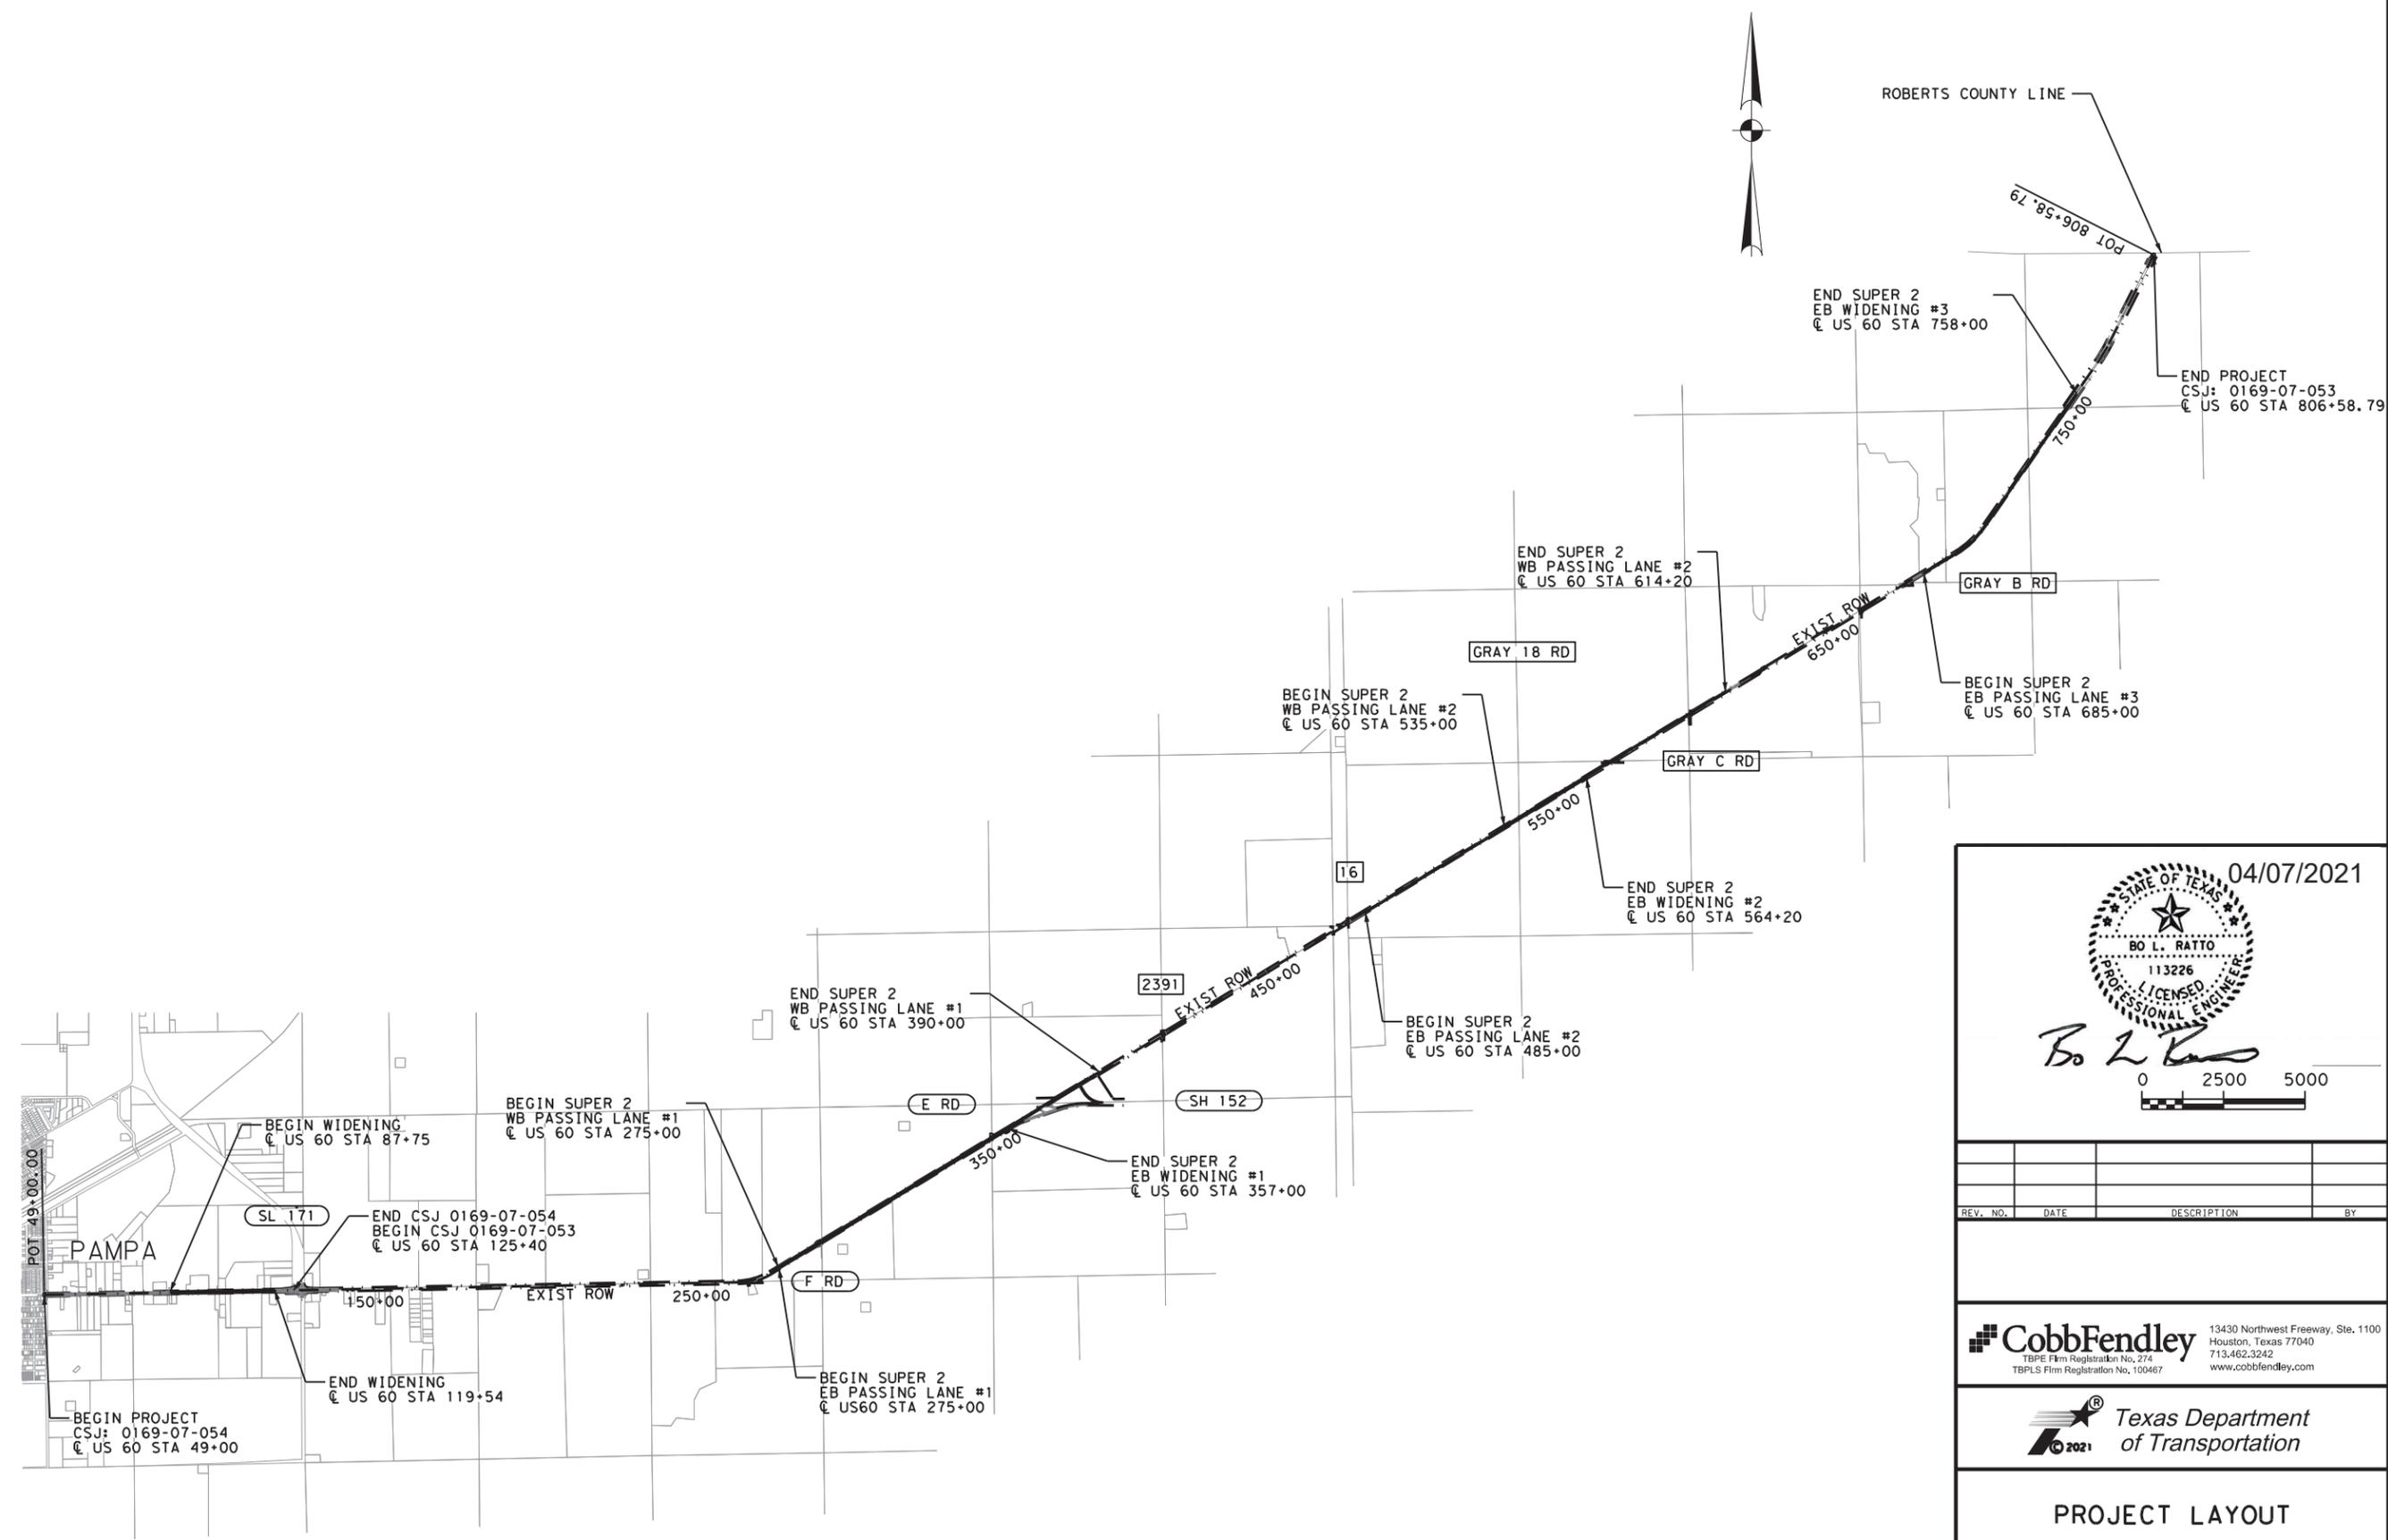

04/07/2021

Bo L. Ratto
PROFESSIONAL ENGINEER

REV. NO.	DATE	DESCRIPTION	BY

CobbFendley 13430 Northwest Freeway, Ste. 1100
Houston, Texas 77040
713.462.3242
www.cobbhendley.com




PROJECT LAYOUT


SHEET 1 OF 1

FED. RD. DIV. NO.	STATE	PROJECT NO.	HIGHWAY NO.		
6	TEXAS	(SEE TITLE SHEET)	US60		
STATE DISTRICT	COUNTY	CONTROL NO.	SECTION NO.	JOB NO.	SHEET NO.
AMA	GRAY	0169	07	053, ETC	3

US60_GEN_LAYOUT.dgn

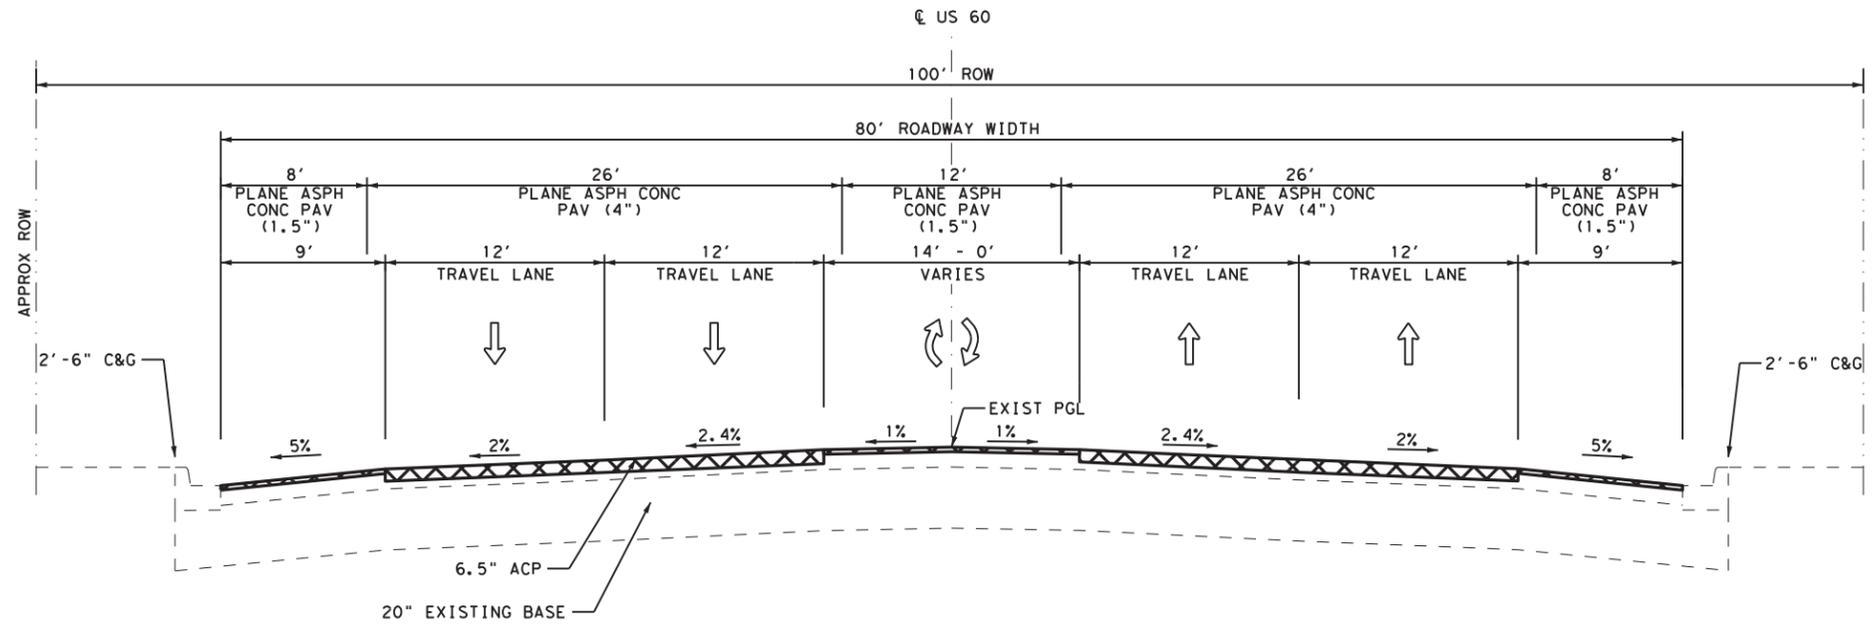

① EXISTING TYPICAL SECTION
 STA 49+00.00 TO STA 54+83.00
 STA 54+83.00 TO STA 58+21.00 TRANSITION TO SECTION ②

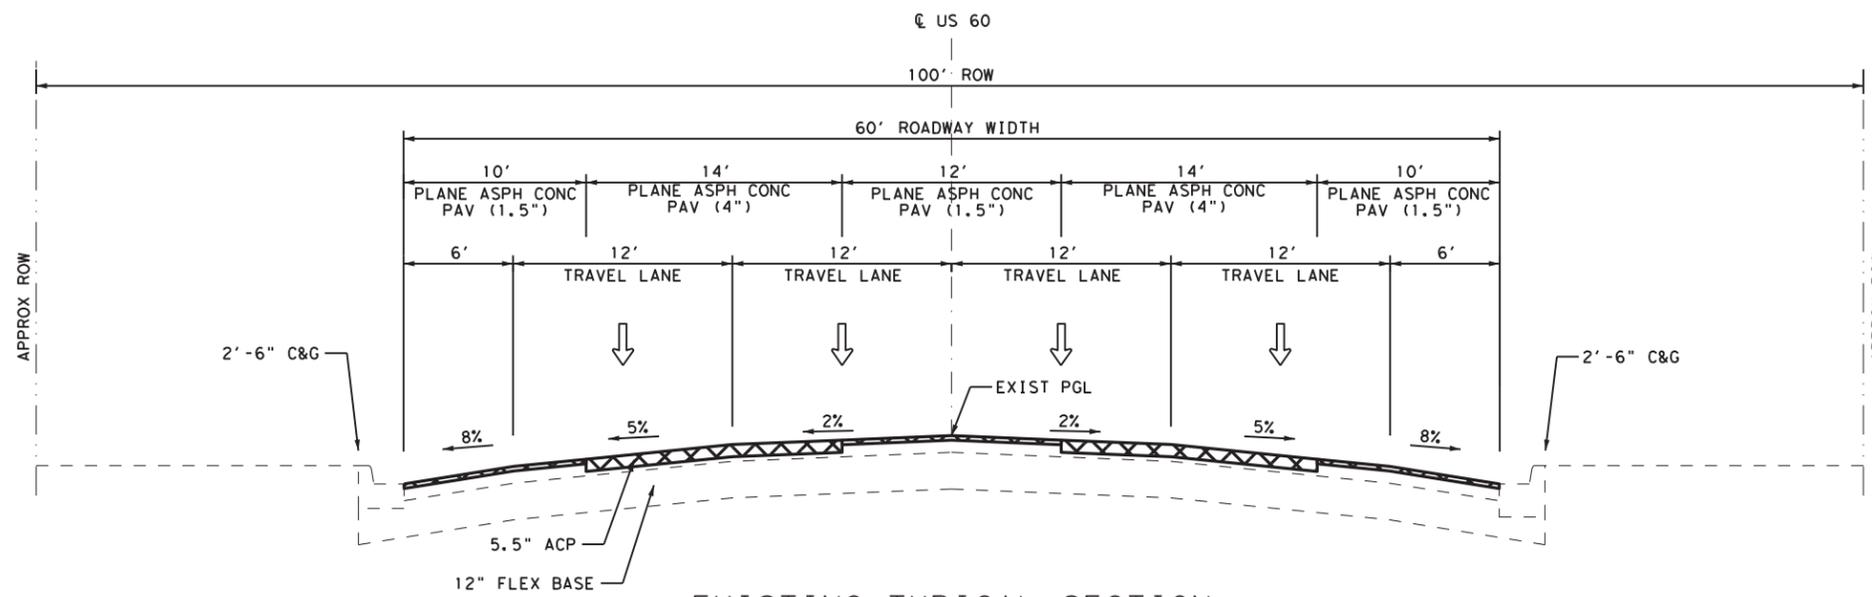

② EXISTING TYPICAL SECTION
 STA 58+21.00 TO STA 86+60.00
 STA 86+60.00 TO STA 91+00.00 TRANSITION TO SECTION ③

05/03/2021

DOCUMENT IS NOT TO BE USED FOR CONSTRUCTION AND NOT INTENDED FOR PERMIT PURPOSES. CONSULT THE ORIGINAL PERMIT PURCHASER FOR ANY CHANGES, ADDITIONS, OR DELETIONS.

BO L. RATTO
 113226
 LICENSED PROFESSIONAL ENGINEER
 TEXAS SERIAL NO. 113226
 DATE 4/27/2021

Bo L. Ratto

0 2.5 5 10 (H)
 0 2.5 5 (V)

REV. NO.	DATE	DESCRIPTION	BY

CobbFendley 13430 Northwest Freeway, Ste. 1100
 Houston, Texas 77040
 713.462.3242
 TBPE Firm Registration No. 274
 TBPLS Firm Registration No. 100467
 www.cobbhendley.com


Texas Department of Transportation

EXISTING TYPICAL SECTIONS

SHEET 1 OF 3


FED. RD. DIV. NO.	STATE	PROJECT NO.	HIGHWAY NO.
6	TEXAS	(SEE TITLE SHEET)	US60
STATE DISTRICT	COUNTY	CONTROL NO.	SECTION NO.
AMA	GRAY	0169	07
		JOB NO.	SHEET NO.
		053, ETC	4

4/15/2021 4:15:20 PM
 F:\P\0\proj\2019\1004_Tx\DOT_5x5_PSS&E\03_US60_Amrt\1161\ENG\500\UST\IN\504-Gener\02-Sheets\US60_GEN-ETYP-01.dgn

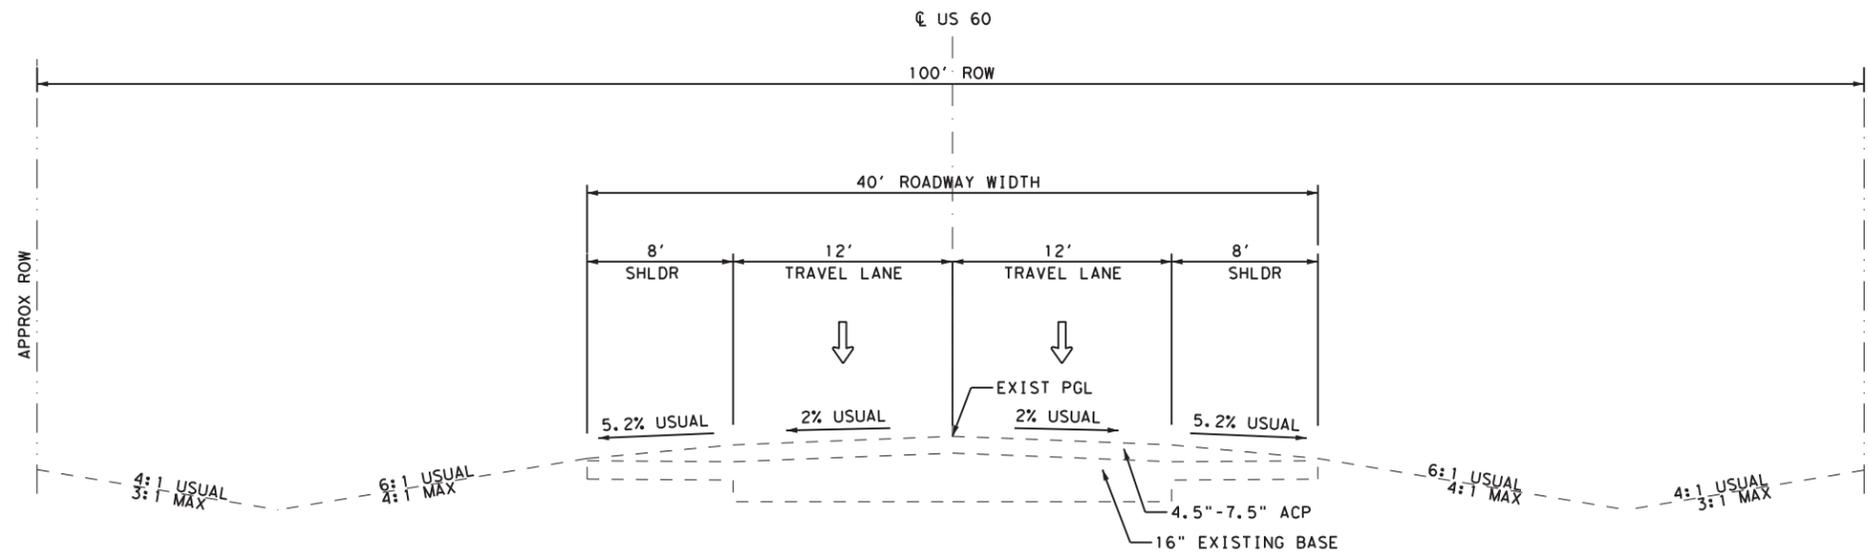

3 EXISTING TYPICAL SECTION

STA 91+00.00 TO STA 117+35.00
 STA 117+35.00 TO STA 125+44.00 TRANSITION TO SECTION 4
 STA 139+18.00 TO STA 215+50.00
 STA 262+00.00 TO STA 789+00.00
 STA 789+00.00 TO STA 798+00.00 TRANSITION FROM 40' TO 52'
 STA 798+00.00 TO END OF PROJECT

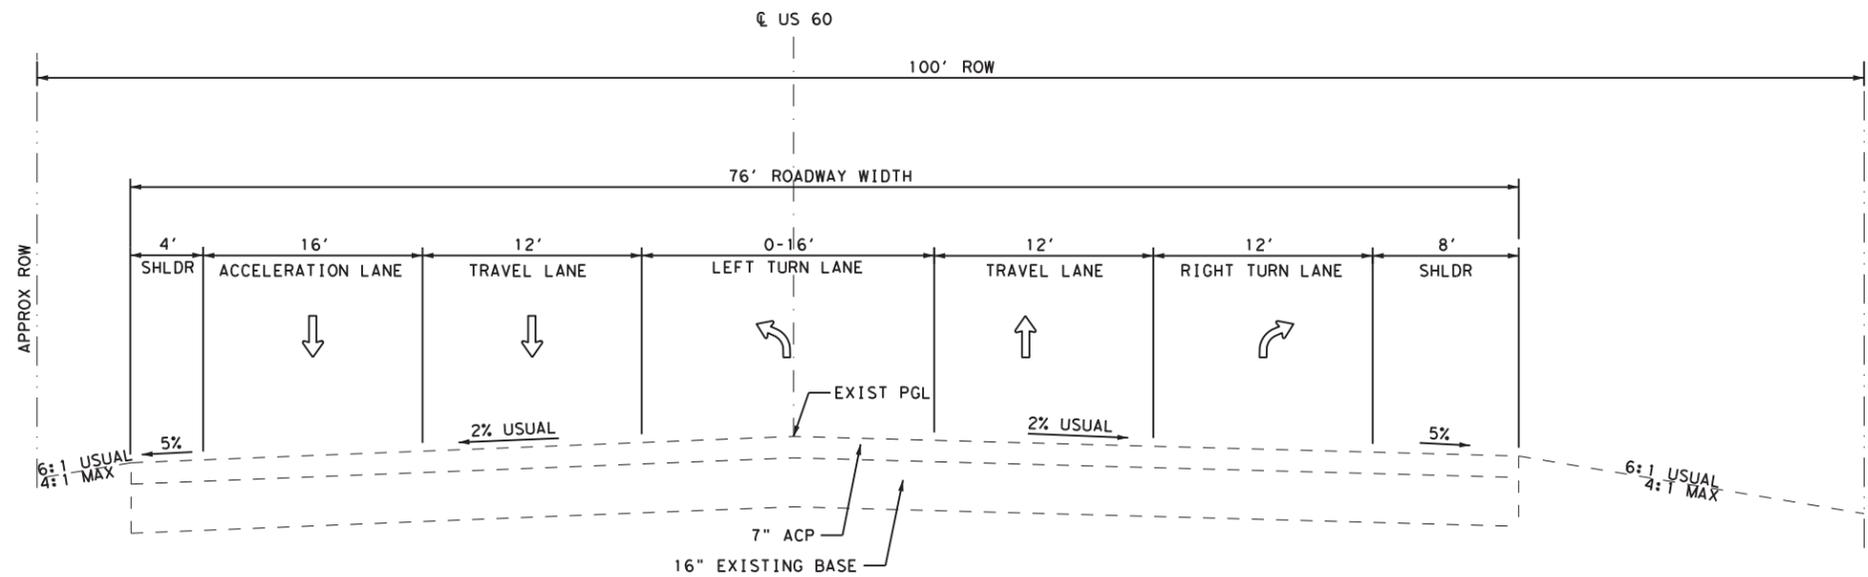

4 EXISTING TYPICAL SECTION

STA 125+44.00 TO STA 128+00.00

05/03/2021

DOCUMENT IS THE PROPERTY OF THE ENGINEER AND NOT
 INTENDED FOR REPRODUCTION, COPYING, OR
 PERMIT PURPOSES WITHOUT THE WRITTEN CONSENT OF THE ENGINEER.

BO L. RATTO
 113226
 LICENSED PROFESSIONAL ENGINEER

Bo L. Ratto

0 2.5 5 10 (H)
 0 2.5 5 (V)

REV. NO.	DATE	DESCRIPTION	BY

CobbFendley 13430 Northwest Freeway, Ste. 1100
 Houston, Texas 77040
 TBPE Firm Registration No. 274 713.462.3242
 TBPLS Firm Registration No. 100467 www.cobbhendley.com




EXISTING TYPICAL SECTIONS


SHEET 2 OF 3

FED. RD. DIV. NO.	STATE	PROJECT NO.	SECTION NO.	JOB NO.	SHEET NO.
6	TEXAS	(SEE TITLE SHEET)	07	053, ETC	5

4/27/2021 4:15:20 PM F:\P\0\jcd\2019\1004_Tx\DOT_5x5_PSS&E\03_US60_Am\116161\NG\500\UST\N\504-Garner\02-Sheets\US60_GEN-ETIP-02.dgn

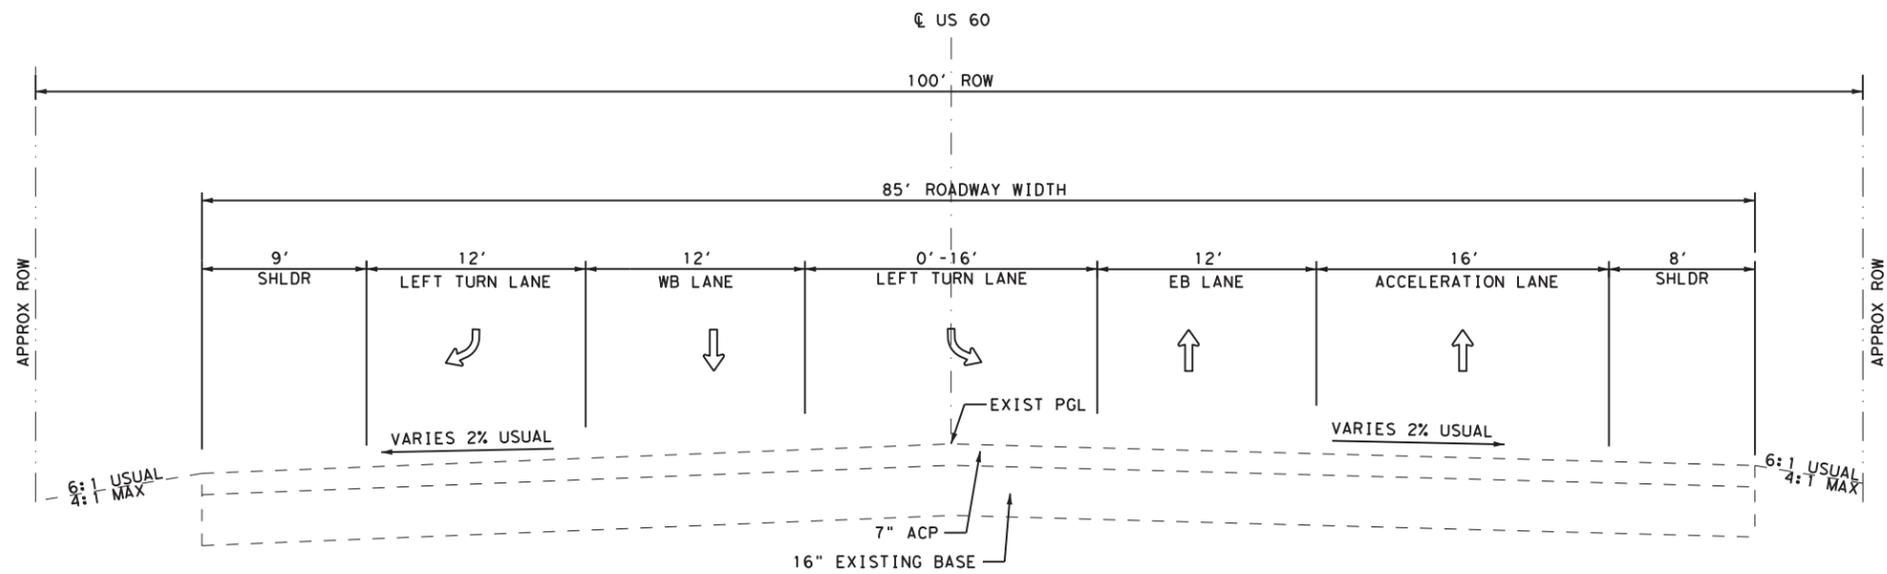

⑤ EXISTING TYPICAL SECTION
 STA 128+00.00 TO STA 132+52.00
 STA 132+52.00 TO STA 139+18.00 TRANSITION TO SECTION ③

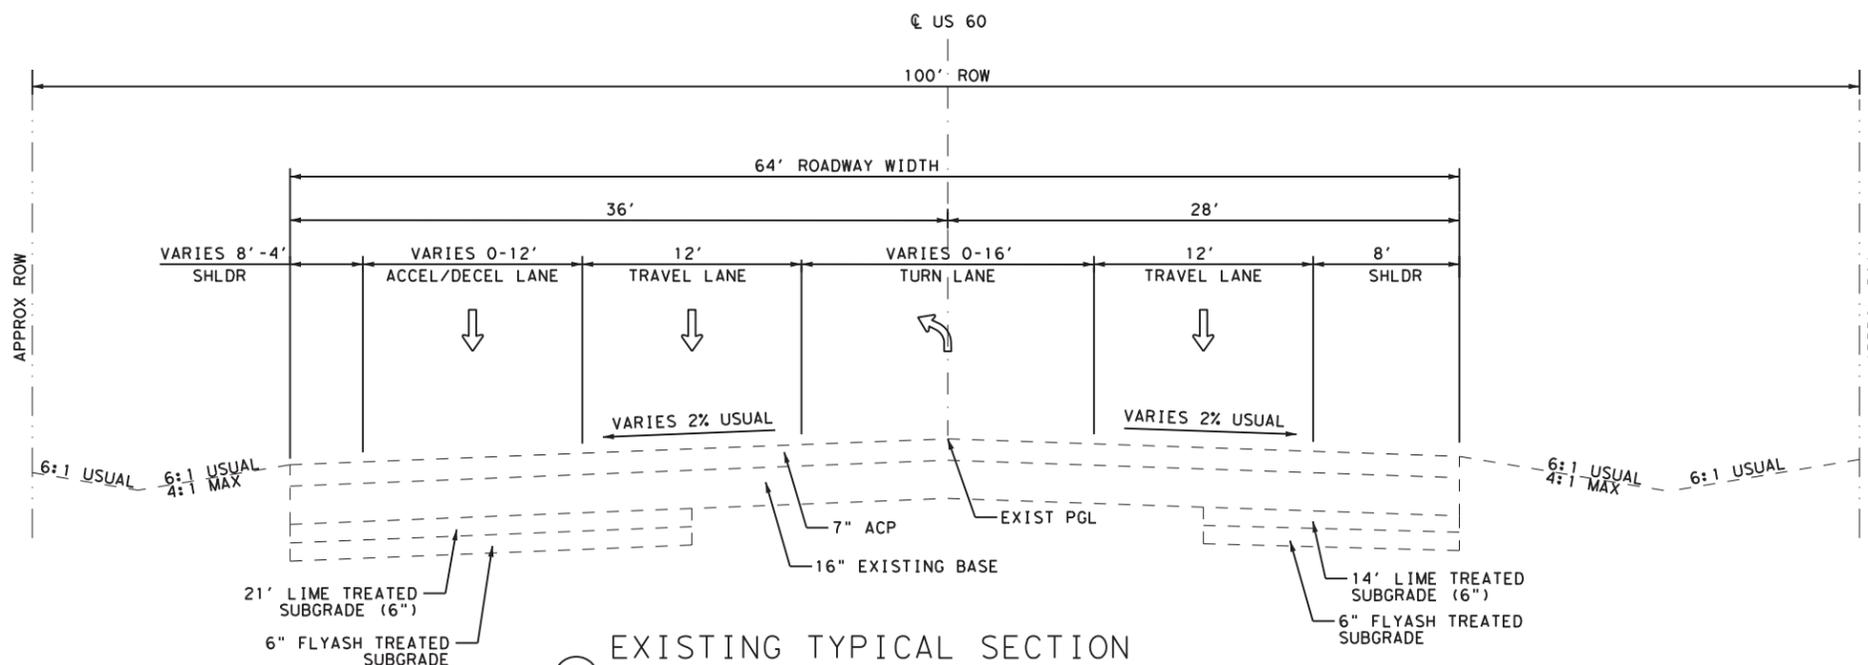

⑥ EXISTING TYPICAL SECTION
 STA 215+50.00 TO STA 262+00.00

04/07/2021

Bo L. Ratto

REV. NO.	DATE	DESCRIPTION	BY

CobbFendley 13430 Northwest Freeway, Ste. 1100
 Houston, Texas 77040
 TBPE Firm Registration No. 274 713.462.3242
 TBPLS Firm Registration No. 100467 www.cobbhendley.com


Texas Department of Transportation

EXISTING TYPICAL SECTIONS


SHEET 3 OF 3

FED. RD. DIV. NO.	STATE	PROJECT NO.	HIGHWAY NO.
6	TEXAS	(SEE TITLE SHEET)	US60
STATE DISTRICT	COUNTY	CONTROL NO.	SECTION NO.
AMA	GRAY	0169	07
		JOB NO.	SHEET NO.
		053, ETC	6

4/7/2021 7:26:09 AM F:\P\j\c\2019\1004_TxDOT_3x5_P5&E\03_US60_Amrt\116\ENG\500\UST\N\504-Gener\02-Sheets\US60_GEN-ETYP-03.dgn

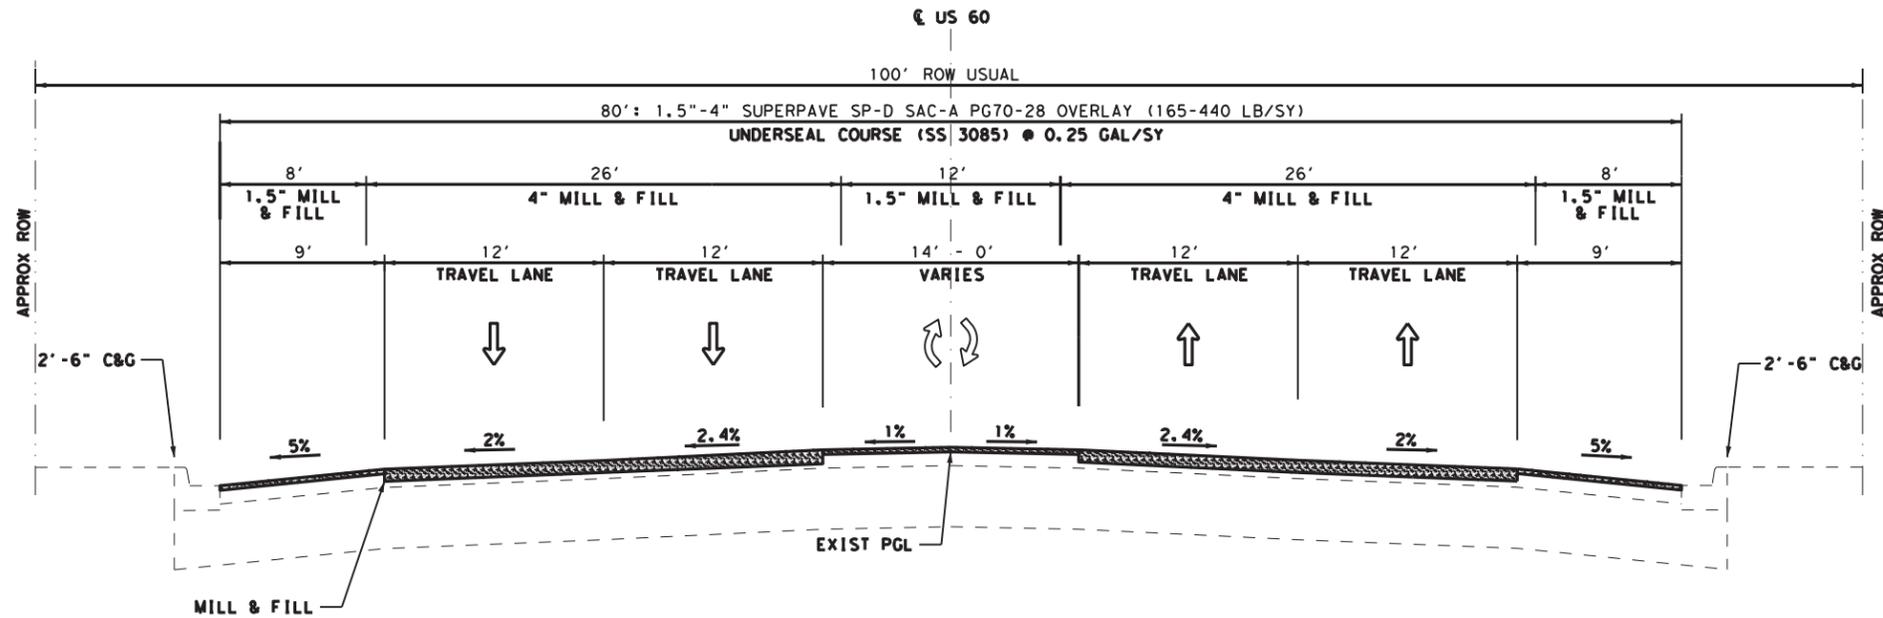

**(A) PROPOSED TYPICAL SECTION
US 60**
STA 49+00.00 TO STA 54+83.00
STA 54+83.00 TO STA 58+21.00 TRANSITION TO TYP B (80' TO 60' - AVG 70')

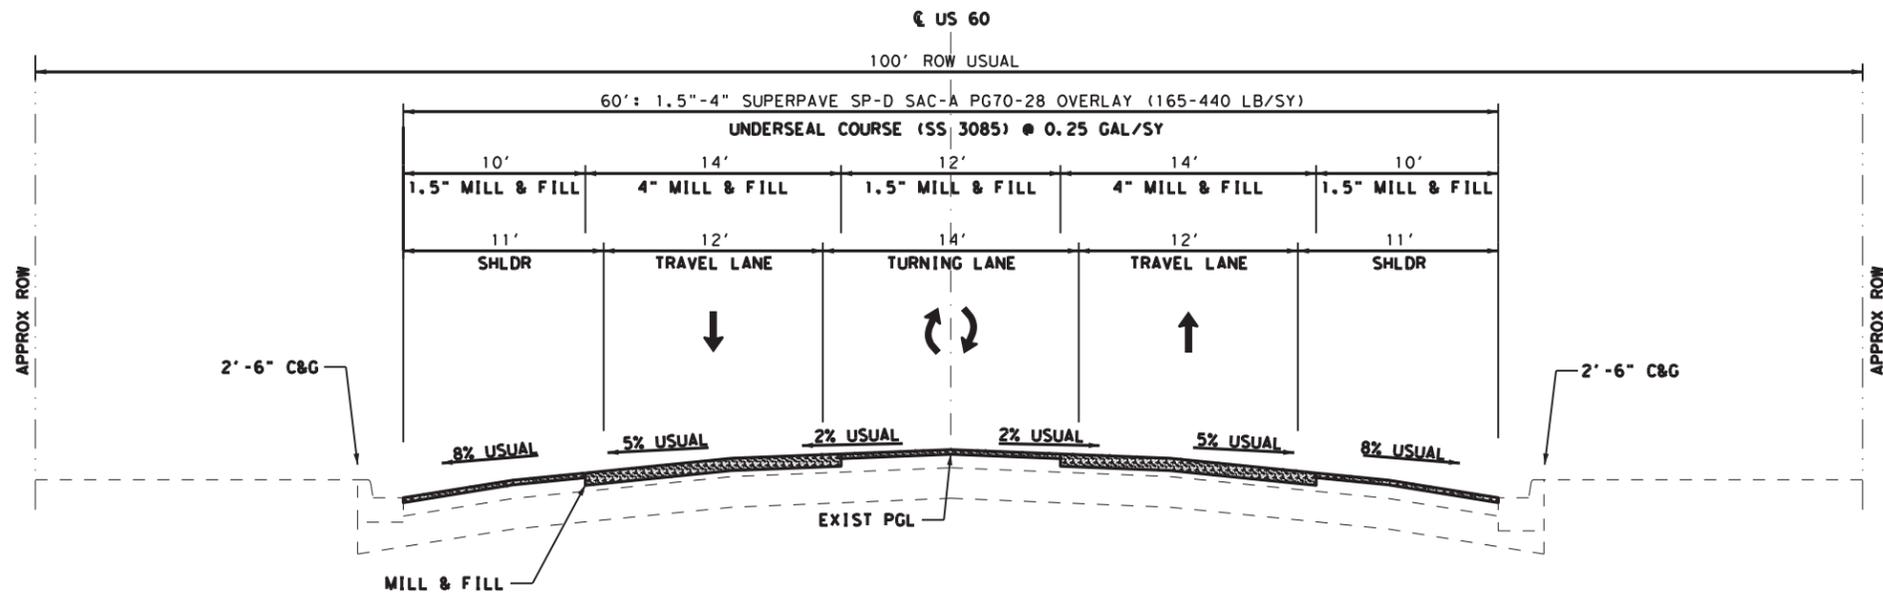

**(B) PROPOSED TYPICAL SECTION
US 60**
STA 58+21.00 TO STA 86+60.00
STA 86+60.00 TO STA 87+75.00 TRANSITION TO TYP C (160' TO 58' - AVG 59')

NOTE:

- CONTRACTOR TO MATCH EXISTING CROSS SLOPE ON OVERLAY SECTIONS

04/07/2021

Bo L. Ratto

REV. NO.	DATE	DESCRIPTION	BY

CobbFendley 13430 Northwest Freeway, Ste. 1100
Houston, Texas 77040
713.462.3242
www.cobbhendley.com


Texas Department of Transportation

PROPOSED TYPICAL SECTIONS

SHEET 1 OF 6

FED. RD. DIV. NO.	STATE	PROJECT NO.	HIGHWAY NO.		
6	TEXAS	(SEE TITLE SHEET)	US60		
STATE DISTRICT	COUNTY	CONTROL NO.	SECTION NO.	JOB NO.	SHEET NO.
AMA	GRAY	0169	07	053, ETC	7

4/7/2021 7:26:10 AM F:\P\j\c\2019\1004_Tx\DOT_5x5_PSS&E\03_US60_Amarr\16\16\16\500\USTN\504-Gener\02-Sheets\US60_GEN\PTYP-A.dgn

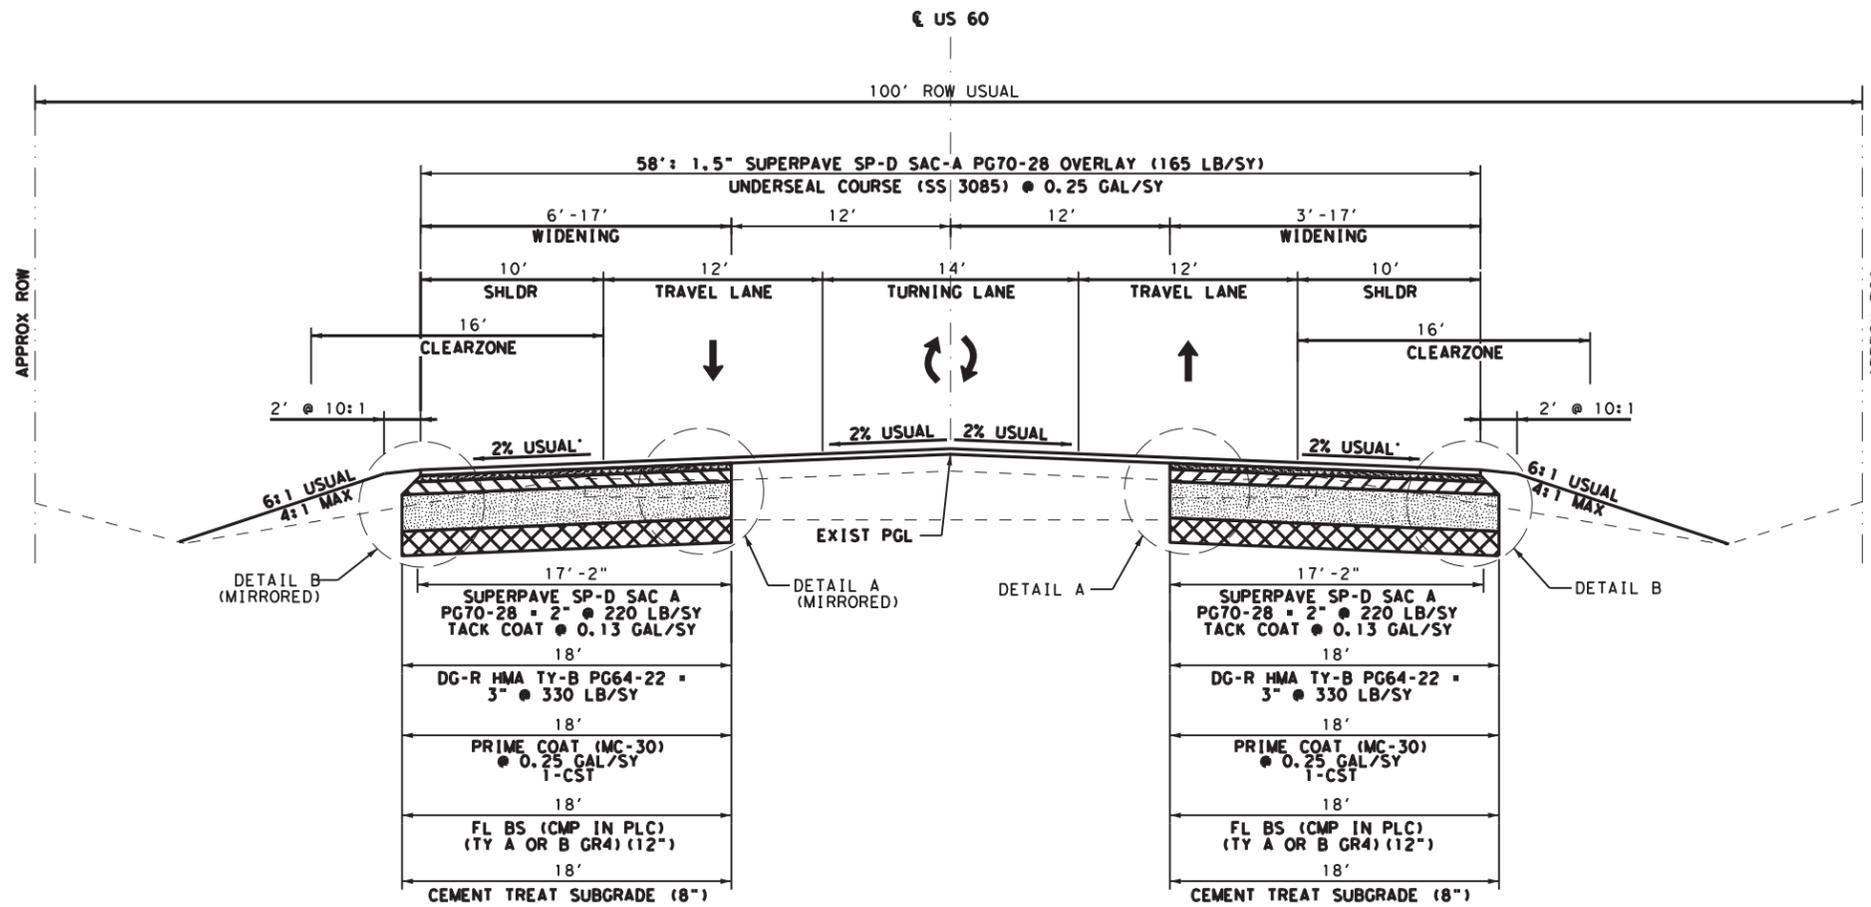



(C) PROPOSED TYPICAL SECTION
US 60
STA 87+75.00 TO STA 119+54.00

- NOTES:
- CONTRACTOR TO MATCH EXISTING CROSS SLOPE ON OVERLAY SECTIONS
 - MATCH EXISTING TRAVEL LANE CROSS SLOPE, NOT EXISTING SHOULDER CROSS SLOPE

04/07/2021

Bo L. Ratto

0 2.5 5 10 (H)
0 2.5 5 (V)

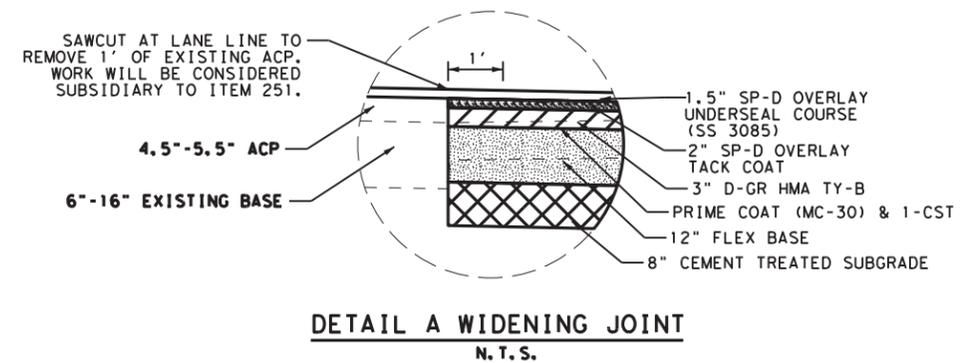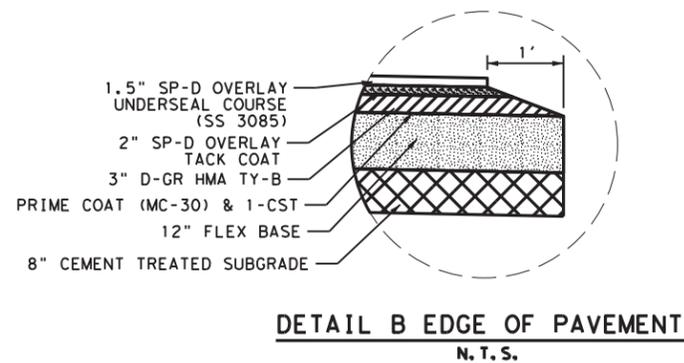

REV. NO.	DATE	DESCRIPTION	BY

CobbFendley 13430 Northwest Freeway, Ste. 1100
Houston, Texas 77040
713.462.3242
www.cobbendley.com


Texas Department of Transportation

PROPOSED TYPICAL SECTIONS

SHEET 2 OF 6

FED. RD. DIV. NO.	STATE	PROJECT NO.	HIGHWAY NO.
6	TEXAS	(SEE TITLE SHEET)	US60
STATE DISTRICT	COUNTY	CONTROL NO.	SECTION NO.
AMA	GRAY	0169	07
		JOB NO.	SHEET NO.
		053, ETC	8


4/7/2021 7:56:11 AM F:\P\p\j\c\2019\1004_Tx\DOT_5x5_PSS&E\03_US60_Am\116161\NG\500\UST\1\504-Gener\02-Sheets\US60_GEN-PTYP-02.dgn

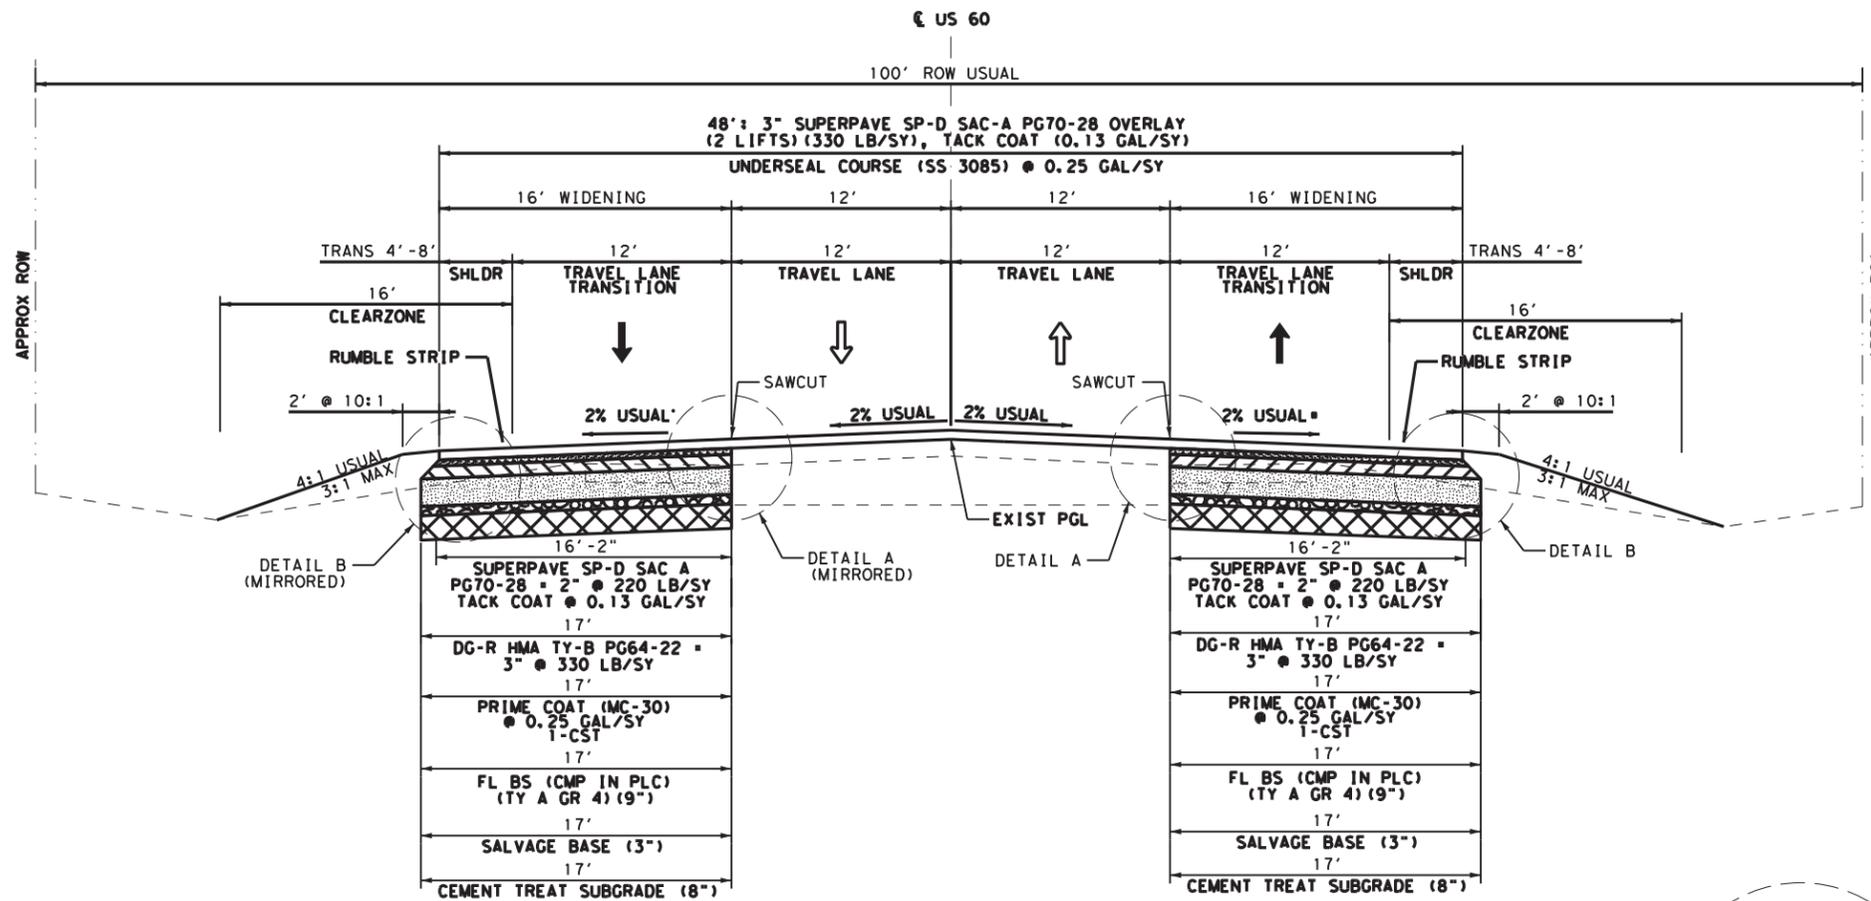

PROPOSED TYPICAL SECTION (SUPER 2)


US 60 EASTBOUND & WESTBOUND

STA 275+00.00 TO STA 284+00.00	TRANS FROM 40' TO 56'
STA 284+00.00 TO STA 357+00.00	
STA 357+00.00 TO STA 362+43.48	TRANS FROM 28' RT TO 52' RT
STA 362+43.48 TO STA 362+43.48	TRANS FROM 28' LT TO 30' LT
STA 362+43.48 TO STA 444+00.00	TRANS FROM 48' TO 56'
STA 444+00.00 TO STA 555+20.00	
STA 555+20.00 TO STA 564+20.00	TRANS FROM 56' TO 48'

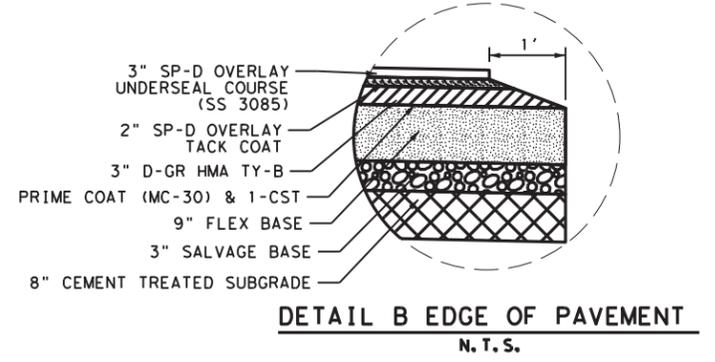


DETAIL B EDGE OF PAVEMENT N.T.S.

- NOTES:
- CONTRACTOR TO MATCH EXISTING CROSS SLOPE ON OVERLAY SECTIONS
 - MATCH EXISTING TRAVEL LANE CROSS SLOPE, NOT EXISTING SHOULDER CROSS SLOPE

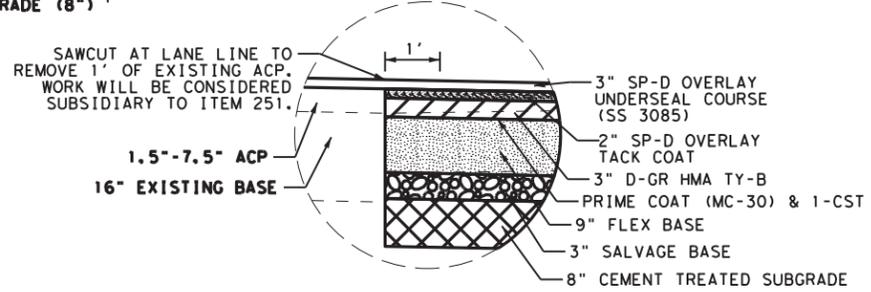

DETAIL A WIDENING JOINT N.T.S.

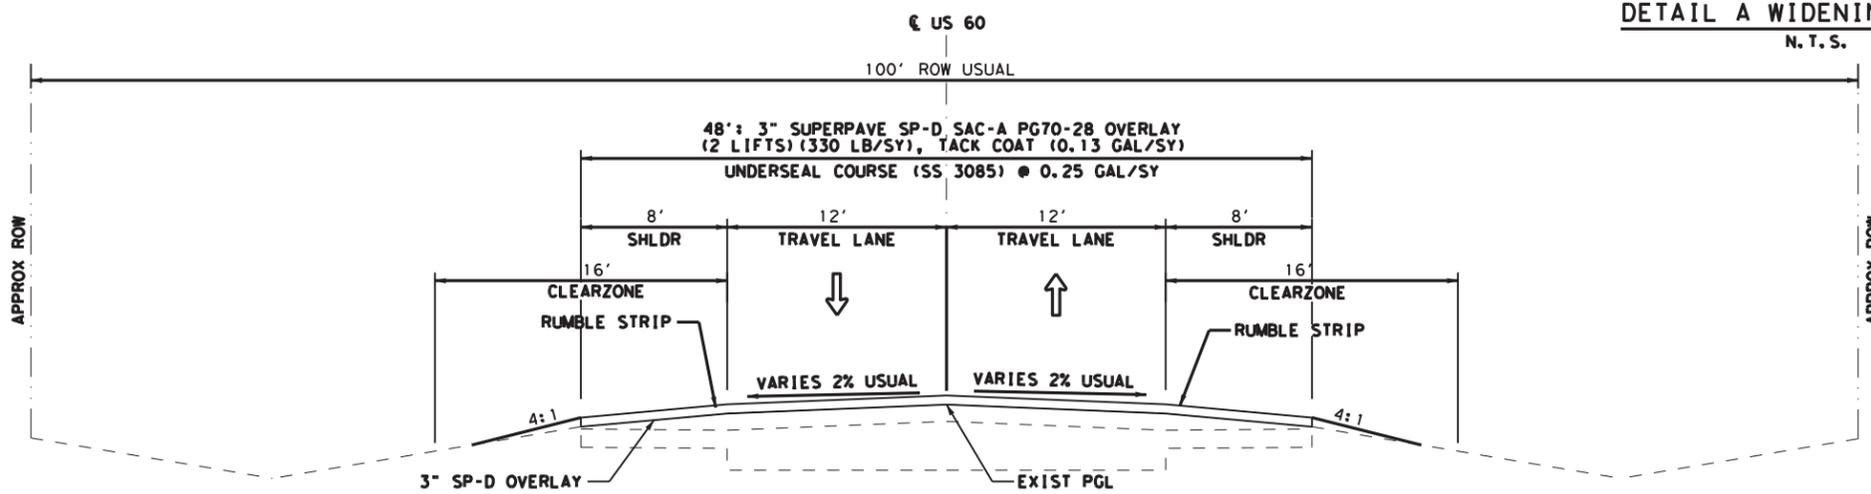

PROPOSED TYPICAL SECTION (OVERLAY)


US 60

STA 139+18.00 TO STA 215+50.00
STA 262+00.00 TO STA 275+00.00
STA 390+00.00 TO STA 485+00.00
STA 614+20.00 TO STA 685+00.00
STA 758+00.00 TO STA 789+00.00

05/17/2021



Bo L. Ratto

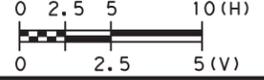

REV. NO.	DATE	DESCRIPTION	BY

CobbFendley 13430 Northwest Freeway, Ste. 1100
Houston, Texas 77040
713.462.3242
www.cobbendley.com




PROPOSED TYPICAL SECTIONS

SHEET 4 OF 6

FED. RD. DIV. NO.	STATE	PROJECT NO.	HIGHWAY NO.
6	TEXAS	(SEE TITLE SHEET)	US60
STATE DISTRICT	COUNTY	CONTROL NO.	SECTION NO.
AMA	GRAY	0169	07
		JOB NO.	SHEET NO.
		053, ETC	10

5/17/2021 9:36:05 AM F:\P\Projects\2019\1004_TxDOT_5x5_PSS&E\03_US60_Amrt\10\16\16\500-UST\1\504-Gen\02-Sheet\US60_GEN-PTT-P-04.dgn

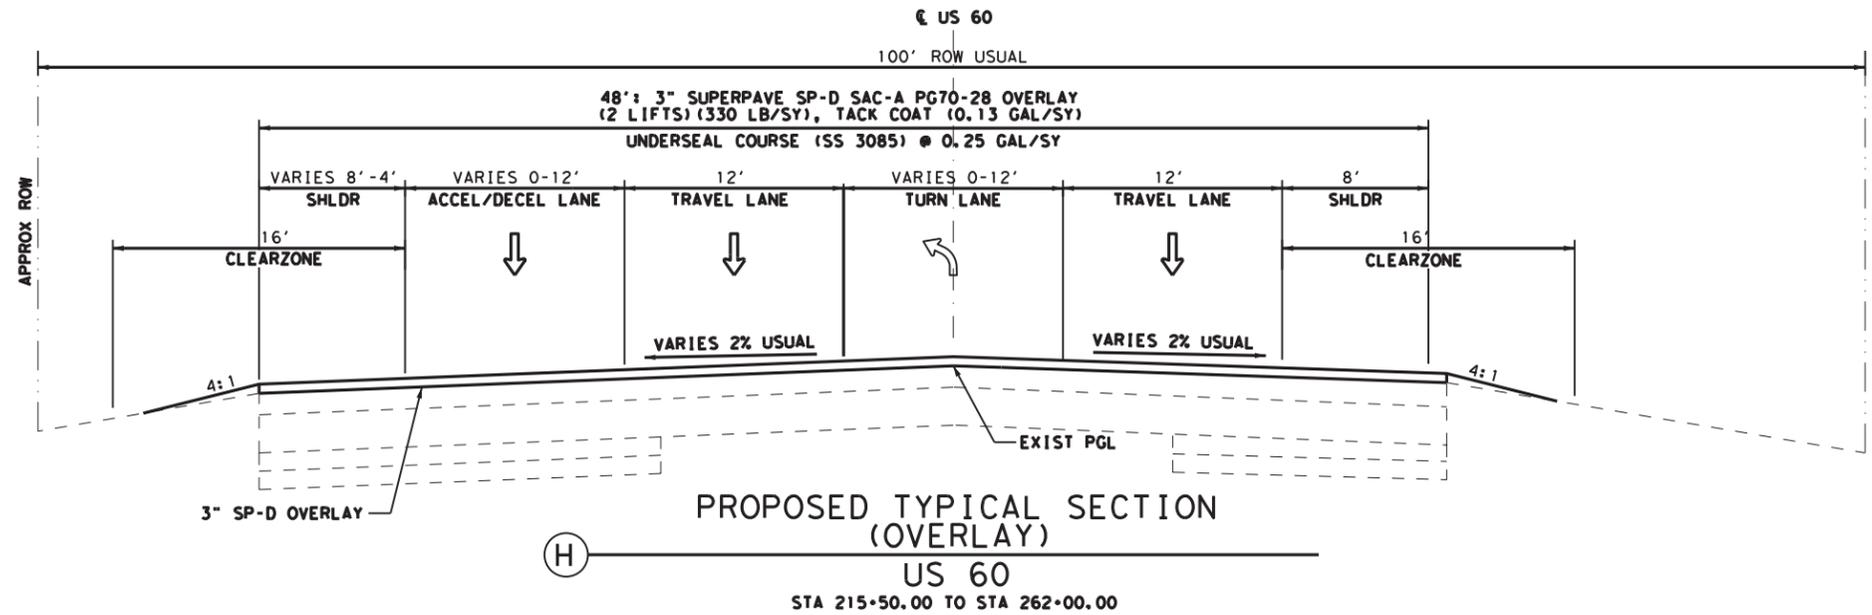


PROPOSED TYPICAL SECTION
(OVERLAY)

US 60
STA 215+50.00 TO STA 262+00.00

NOTE:

- CONTRACTOR TO MATCH EXISTING CROSS SLOPE ON OVERLAY SECTIONS

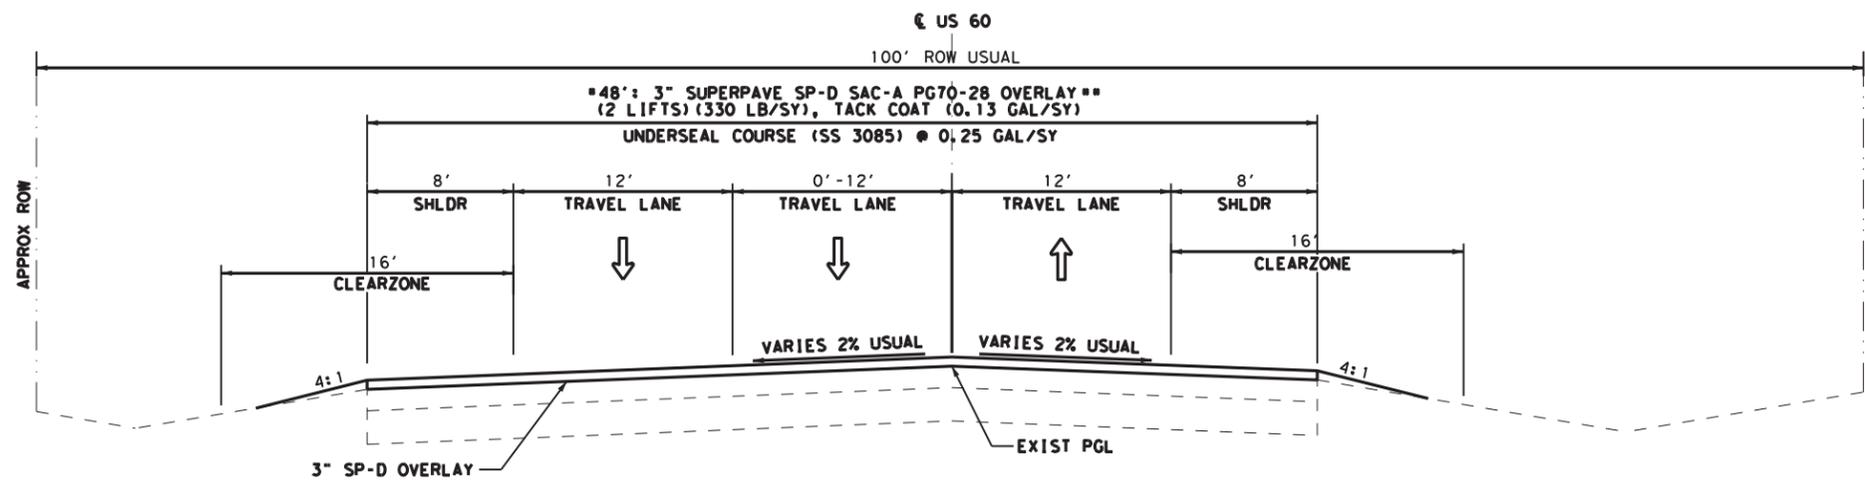

PROPOSED TYPICAL SECTION
(OVERLAY)

US 60
STA 789+00.00 TO END OF PROJECT
* TRANSITION FROM 40" TO 52" FROM STA 789+00.00 TO STA 798+00.00
** STA 804+58.00 TO END OF PROJECT 0" TO 3" PLANING

05/17/2021

Bo L. Ratto

REV. NO.	DATE	DESCRIPTION	BY


CobbFendley 13430 Northwest Freeway, Ste. 1100
Houston, Texas 77040
TBPB Firm Registration No. 274 713.462.3242
TBPB Firm Registration No. 100467 www.cobbhendley.com



PROPOSED
TYPICAL SECTIONS

SHEET 5 OF 6

FED. RD. DIV. NO.	STATE	PROJECT NO.	HIGHWAY NO.		
6	TEXAS	(SEE TITLE SHEET)	US60		
STATE DISTRICT	COUNTY	CONTROL NO.	SECTION NO.	JOB NO.	SHEET NO.
AMA	GRAY	0169	07	053, ETC	11

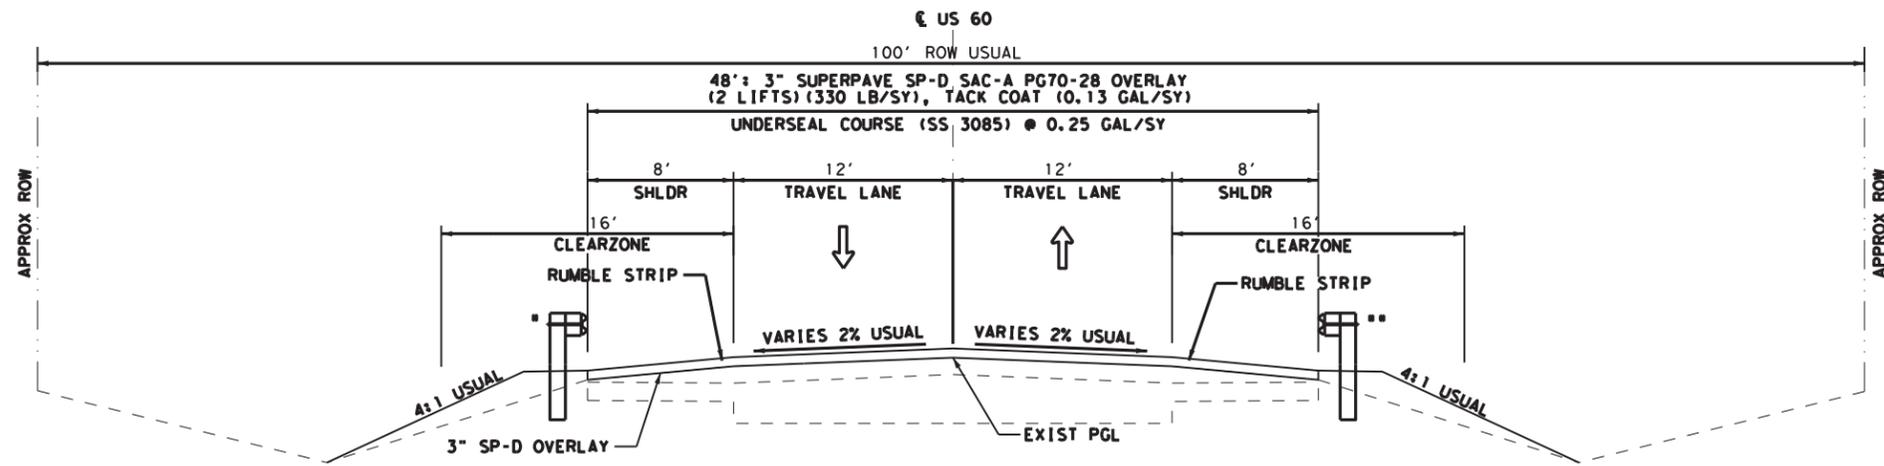


PROPOSED TYPICAL SECTION (OVERLAY WITH MBGF)

(J)

US 60


- STA 758+25.00 TO STA 767+25.00
- STA 769+33.00 TO STA 779+56.00
- STA 783+67.00 TO STA 791+66.00
- ** STA 758+00.00 TO STA 766+05.00
- ** STA 768+34.00 TO STA 778+82.00
- ** STA 782+59.00 TO STA 790+58.00

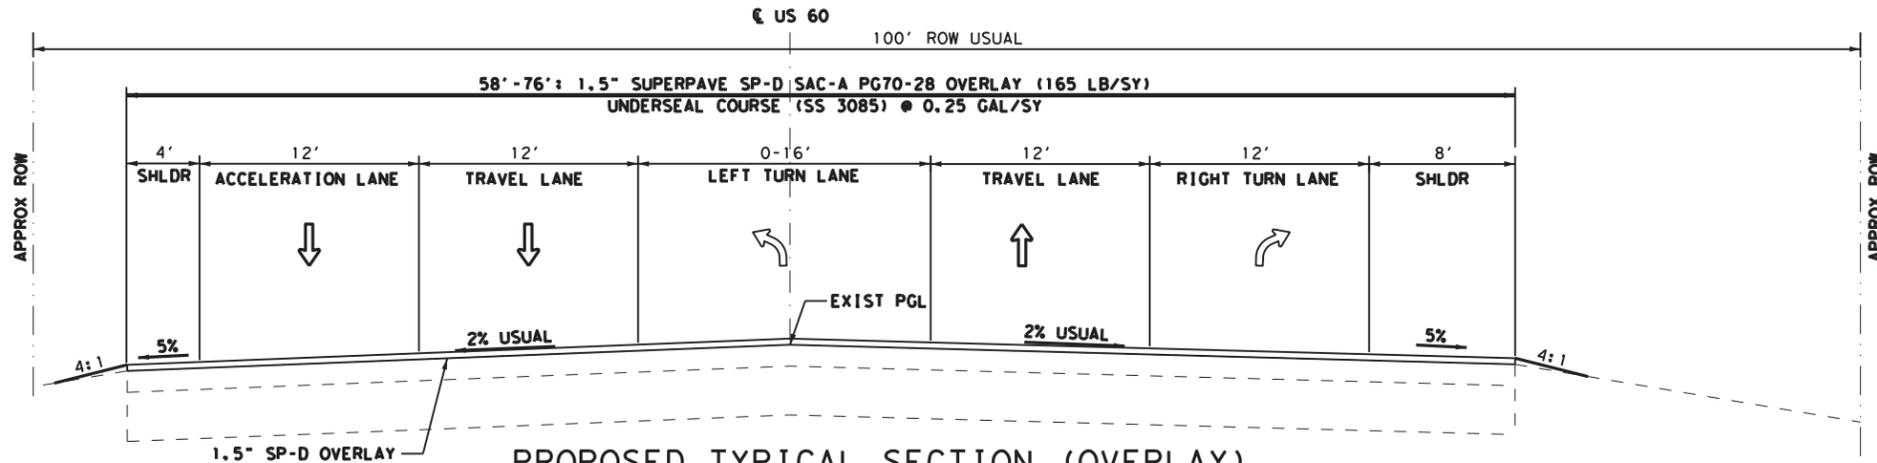

PROPOSED TYPICAL SECTION (OVERLAY)

(K)

STA 119+54.00 TO STA 125+44.00 TRANSITION FROM SECTION (C) TO SECTION (R)
STA 125+44.00 TO STA 128+00.00

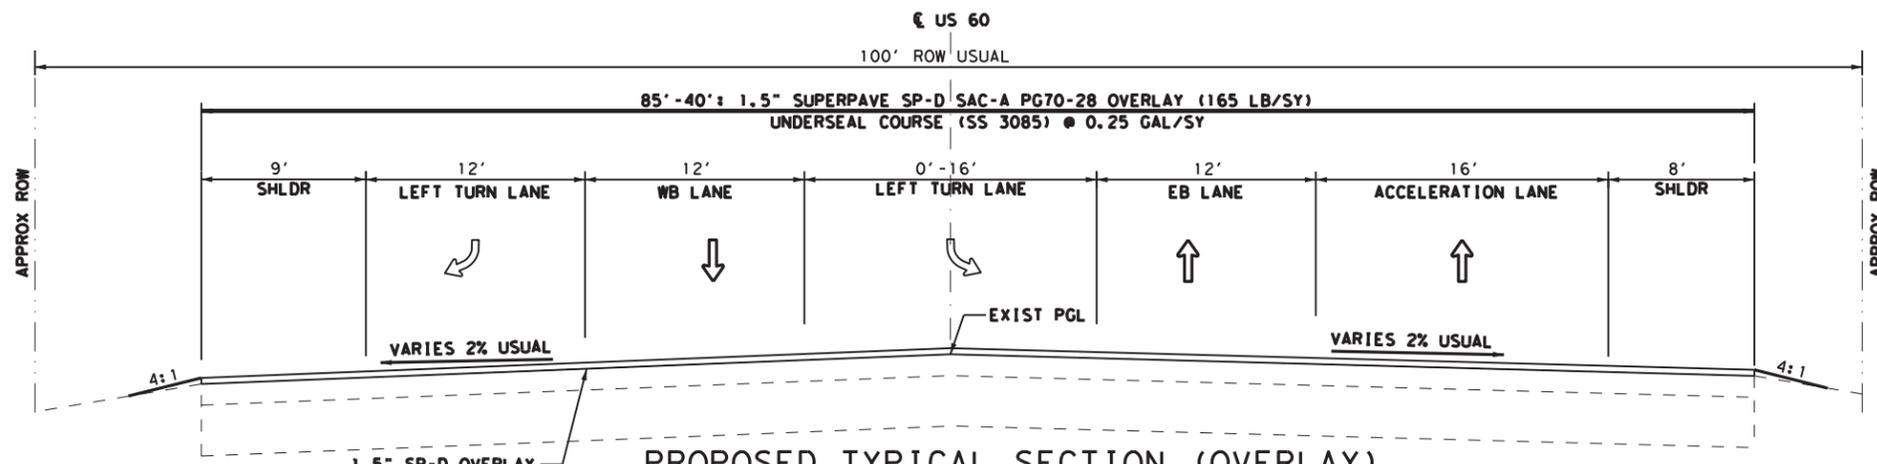

PROPOSED TYPICAL SECTION (OVERLAY)

(L)

STA 128+00.00 TO STA STA 132+52.00
STA 132+52.00 TO STA 139+18.00 TRANSITION TO SECTION (G)

NOTE:

1. CONTRACTOR TO MATCH EXISTING CROSS SLOPE ON OVERLAY SECTIONS

05/17/2021

Bo L. Ratto

REV. NO.	DATE	DESCRIPTION	BY

CobbFendley 13430 Northwest Freeway, Ste. 1100
Houston, Texas 77040
713.462.3242
www.cobbendley.com

Texas Department of Transportation

PROPOSED TYPICAL SECTIONS

SHEET 6 OF 6

FED. RD. DIV. NO.	STATE	PROJECT NO.	HIGHWAY NO.		
6	TEXAS	(SEE TITLE SHEET)	US60		
STATE DISTRICT	COUNTY	CONTROL NO.	SECTION NO.	JOB NO.	SHEET NO.
AMA	GRAY	0169	07	053, ETC	12

5/17/2021 9:36:06 AM F:\P\0\j\c\2019\1004_TxDOT_3x5_PSS&E\03_US60_Amarr\116\116\500\UST\1\504-Gener\02-Sheets\US60_GEN-PTYP-06.dgn

GENERAL NOTES

CSJ: 0169-07-053, ETC				
BASIS OF ESTIMATE FOR CONSTRUCTION				
Item	Description	Unit	Rate	
164	SEEDING		SEE PLAN SHEETS	
166	FERTILIZER		SEE PLAN SHEETS	
275	CEMENT TREAT (8")	SY	3% Cement at 21.6 LBS/SY	
310	PRIME COAT (MC-30)	GAL	0.25 GAL/SY	
314	EMULSION ASPHALT (MULTI) (MS-2 OR SS-1)	GAL	SEE NOTE 2	
316	ASPH (AC-5)	GAL	0.38 GAL/SY	
	AGGR (TY-B GR-4 SAC-B)	CY	110 SY/CY	
3076 ⁽¹⁾	D-GR HMA	TON	3"	330 LB/SY/2000
3076 ⁽³⁾ or 3077 ⁽³⁾	TACK COAT (TRAIL)	GAL	.13 GAL / SY	
3077 ⁽¹⁾	SUPERPAVE MIXTURES	TON	4"	440 LB/SY/2000
		TON	3"	330 LB/SY/2000
		TON	2"	220 LB/SY/2000
		TON	1.5"	165 LB/SY/2000
3085	UNDERSEAL COURSE	GAL	SEE GENERAL NOTE FOR RATE INFORMATION	
NOTE:				
(1)	"D-GR HMA and SUPERPAVE MIXTURES" Weight Based On 110Lbs/SY/In			
(2)	40% Emulsified Asphalt 60% Water Mixture Applied At 0.25 Gal/Sy. Paid using 0.1 Gal/Sy.			
(3)	The TRAIL hot asphalt type options will only be allowed.			

General

Contractor questions on this project are to be addressed to the following individual(s):

TO: Pampa Area Engineer Wes.Kimmell@txdot.gov (interim)
 CC: Assistant Area Engineer Zachary.Mayer@txdot.gov
 Director of Construction Kenneth.Petr@txdot.gov
 Construction Manager Thomas.Nagel@txdot.gov

Contractor questions will be accepted through email, phone, or in person by the above individuals.

All Contractor questions will be reviewed by the Engineer. Once a response is developed, it will be posted to TxDOT's Public FTP at the following Address.

<https://ftp.dot.state.tx.us/pub/txdot-info/Pre-Letting%20Responses/>

All questions submitted that generate responses will be posted through this site. The site is organized by District, Project Type (Construction or Maintenance), Letting Date, CCSJ/Project Name.

Verify all survey control prior to beginning construction. Notify Engineer of any discrepancies in control prior to beginning construction.

There are approximately 8 "reference markers" within the project limits. If a marker needs to be moved for any reason during construction operations, the Contractor is to remove it, install it in a temporary location and then reinstall it in its correct permanent location. Both the temporary and permanent locations are to be on a line that is perpendicular to the original "station" along the roadway. The temporary location is to be at or near the right-of-way. The permanent location is to be directed by the Engineer.

The following Standard Detail Sheets have been modified:

[TSR\(3\)-13](#) (MOD)
[TSR\(4\)-13](#) (MOD)

The Contractor is advised that [45 and 65](#) mph construction speed zones will be applicable for this project. The construction speed zone is to be limited to the actual work areas under construction.

Remove all excess material from bridge substructure resulting from all construction including planing, seal coat and ACP overlays. This work will not be paid for directly, but will be considered subsidiary to various bid items in the contract.

If Contractor damages any sprinkler heads, risers or water lines that are not to be relocated, he or she is required to replace or repair all damage at his or her own expense and to the Engineer's satisfaction.

If portions of the right-of-way is used to store materials, equipment, and other uses with the approval of the Engineer, materials, equipment, etc., must either be located outside the 30 feet traffic safety clearance zone or be adequately protected.

Contractor facilities, such as asphalt plants, concrete plants, rock crushers, etc. are not allowed to be located within Department right of way.

The slopes indicated on the typical sections may be varied when fixed features required slopes are re-established as directed by the Engineer.

Dust caused by construction operations is to be controlled by applying water in conformance with the requirements of Item 204, "Sprinkling". Sprinkling for dust control will not be paid for directly, but will be considered as subsidiary work to the various bid items.

Any work necessary to provide temporary ingress and egress during construction (such as building gravel ramps, etc.) Will not be paid for directly, but will be considered as subsidiary work to the various bid items.

Verify all existing grades, elevations, and cross slopes that will connect to any proposed grades and elevations. If adjustments are warranted, the Contractor is to submit proposed changes to the Engineer for verification.

Item 7 Legal Relations and Responsibilities

No significant traffic generator events identified.

The total area disturbed for this project is approximately 28 acres. The disturbed area in this project, all project locations in the Contract, and the Contractor Project Specific Locations (PSLs), within 1 mile of the project limits, for the Contract will further establish the authorization requirements for storm water discharges. The Department will obtain an authorization to discharge storm water from the Texas Commission on Environmental Quality (TCEQ) for the construction activities shown on the plans. The Contractor is to obtain required authorization from the TCEQ for Contractor PSLs for construction support activities on or off the ROW. When the total area disturbed in the Contract and PSLs within 1 mile of the project limits exceeds 5 acres, provide a copy of the Contractor NOI for PSLs on the ROW to the Engineer and to the local government that operates a separate storm sewer system.

Item 8 Prosecution and Progress

Create, maintain, and submit for approval, a Critical Path Method (CPM) project schedule and a Project Schedule Summary Report (PSSR) using computer software that is fully compatible with the latest version of Primavera Systems, Inc. or Primavera P6.

Item 100 Preparing Right Of Way

Preparing right of way will consist exclusively of mowing the vegetation to the width shown in the plans for Backfilling Pavement Edges. Set mower cutting height to cut as low as practical but no higher than 6 inches. Payment for Preparing Right Of Way will be made only in the case where mowing is actually used.

All tree removal activities are to take place outside nesting season. The nesting season is April 1st thru August 30th.

Remove trees of various diameters as shown on the plans, or as directed. Remove tree stumps to at least 12 in. below the surrounding terrain. Before backfilling holes treat the remainder of the stump with the following herbicide: Manufacture - Dow AgroScience; Product - Remedy or other as approved by the Engineer. Follow manufacture recommendations for herbicide. Backfill holes with acceptable material and compact flush with surrounding areas.

Identify each individual tree proposed to be removed. Obtain approval from the Engineer in the field for each individual tree proposed to be removed prior to any tree being removed.

Item 110 Excavation

Prior to excavation and placement of embankment, the top-soil (6-inch depth) within the areas to be disturbed will be bladed into a windrow, or stockpiled, outside the limits of the fill slope.

After all grading is completed; the top soil (6-inch depth) will be spread over the disturbed areas that will not receive concrete riprap. This work is not paid for directly, but will be considered as subsidiary work to the various bid items.

Item 132 Embankment

The plasticity index for TYB will not exceed 25.

Materials excavated from the project will be allowed to be used on the project as directed by the Engineer.

Item 134 Backfilling Pavement Edges

Mow according to Item 100 just prior to backfill pavement edge operations.

Do not overlay any roadway unless the pavement edges can be backfilled within 24 hours. Preferably, both edges of all roadways should be completely backfilled at the end of each day's overlay operations. Damage to delineators, signs, or other roadside features will be repaired or replaced at the expense of the Contractor.

Item 164 Seeding for Erosion Control

Perform planting operations in accordance with the recommendations contained in the latest version of the TxDOT manual "A Guide to Roadside Vegetation Establishment" developed by the Vegetation Management Section of the Maintenance Division.

Seeding may require more than one mobilization, depending upon the Contractor's sequence of work.

Item 166 Fertilizer

Fertilize all areas of project to be seeded or sodded in accordance with the Amarillo District Vegetation Specification Sheet.

Item 169 Soil Retention Blankets

All Class 1 Slope Protection will be the roll-out type, having netting on both sides. Hydraulically placed materials will not be allowed.

Item 247 Flexible Base

SPECIFICATION FOR FLEX BASE TY A OR B GR 4								
GRADING REQUIREMENTS PERCENT RETAINED – SIEVES SIEVE SIZES INCHES					SOIL CONSTANTS		MAX WET BALL *	MAX % INCREASE IN PASSING # 40 *
1 3/4	7/8	3/8	# 4	# 40	L.L. MAX	P.I. MAX		
0	17-32	40-60	50-70	70-85	40	12	45	20

*Applies to TY A material only.

Item 275 Cement Treatment (Road-Mixed)

The intent of this item is to pulverize existing ACP and blend with the existing flexible base. Consider the existing ACP and flexible base as existing base material, and payment made under this item includes pulverizing the existing materials.

All required moisture added for the mixing and compaction operation is to be injected through the mixing process. Sprinkle the base material to prevent excessive loss of moisture as directed by the Engineer.

Backfill any vertical edge nightly with a material approved by the Engineer and at a minimum slope of 3:1.

Item 300 Asphalts, Oils, and Emulsions

Asphalt from different sources is not to be blended.

The "Open" seasons for applying asphaltic materials and mixtures for the listed items are to be as follows, unless authorized otherwise in writing by the Engineer:

ITEMS	OPEN SEASON
310, 314	All Year
316	From May 1 st through August 31st
316 (Underseal Application)	From April 15 th through October 31st
351, 3076, 3077	From April 15 th through October 31st

Item 305 Salvaging, Hauling, and Stockpiling Reclaimable Asphalt Pavement

Ensure that 100% of the reclaimed material passes a 2-in. sieve.

Stockpile the material at [SH 152/US 60 Intersection](#)

Item 314 Emulsified Asphalt Treatment

A 10 foot (min) wide strip of finished material adjacent to each shoulder is to be treated with an emulsified asphalt mixture. The mixture may be placed in one or more applications at a total rate of 0.25 gallons per square yard, unless directed otherwise by the Engineer. The homogeneous mixture may be composed of approximately 40% asphalt (MS-2 or SS-1) and 60% water, unless directed otherwise by the Engineer.

Item 316 Seal Coat

Place one course surface treatment on finished base course as soon as practical, but no later than 7 calendar days after completion of the base treatment process.

For items of work that include both summer and winter materials or the Asphalt (Multi Option), the Engineer will determine which asphalt to apply based on timing and prevailing weather conditions. The Asphalt (Multi Option) is to consist of the following choices and rates:

- AC-10 @ 0.38 GAL/SY
- CRS-2P @ 0.38 GAL/SY

The rates shown are for estimating purposes and that the Engineer can dictate higher or lower rates based on roadway conditions

Item 320 Equipment for Asphalt Concrete Pavement

A self-propelled, wheel mounted material transfer vehicle (MTV) capable of receiving hot mix from the haul trucks separate from the paver is required on all courses and all types of hot mix for this project. The MTV is to have a minimum storage capacity of approximately 25 tons, and equipped with a pivoting discharge conveyor and a means of completely remixing the hot mix prior to placement. The paver hopper is to be equipped with a separate surge storage insert with a minimum capacity of approximately 20 tons.

If used, the IR bar read out screen must be visible at all times to the Engineer.

When performing any scheduled work during night time hours (sunset to sunrise) all work areas will be fully illuminated using devices designed to not incumber or distract oncoming traffic. All illumination equipment must be approved by the Engineer in writing 48 hours before any scheduled night time work can begin. All associated equipment and labor is considered subsidiary to the item of work and will not be paid for directly.

Item 354 Planing and Texturing Pavement

The material planed from existing roadway is estimated at 2,632 CY for this project.

2,632 CY of this material will be available for the Contractor for use as RAP.

The material planed and not utilized as RAP, is to remain the property of the state. The maximum size of the planed material is to be 2 in. The Contractor is to salvage and stockpile the material within the right-of-way at the following location:

- ◆ *SH 152/US 60 Intersection*

The stockpile(s) will be shaped as directed by the Engineer so that adequate measurement can be done. The excess material is not to be compacted by the equipment used in the stockpiling operation.

Item 420 Concrete Substructures

The Engineer will perform all job control testing for acceptance.

The Engineer will provide strength-testing equipment when required in accordance with the Contract-controlling tests.

Furnish and maintain the following testing equipment.

- ◆ Test Molds
- ◆ Wheelbarrow or other container acceptable for the sampling of the concrete.

Item 432 Riprap

24” tie bars (#3 bars at 18” c-c) are to be used across all construction joints. Tie bars should be 12” into each side of the construction joint. When tying new riprap into existing riprap drill and epoxy grout 8” minimum into existing concrete. This is to be considered subsidiary to the payment for riprap.

Item 462 Concrete Box Culverts and Storm Drains

Joint material for reinforced concrete pipe is to be either cold applied preformed plastic gaskets or cold applied plastic asphalt sewer joint compound.

Backfill pipe up to the springline with granular material. The ponding method of backfilling will be allowed for the granular material only.

Item 464 Reinforced Concrete Pipe

Joint material for all pipes will be cold applied plastic asphalt sewer joint compound.

Bedding for pipe culverts is to be 6 inches of sand. The excavation required to place the sand will not be paid for directly but will be considered subsidiary to this item.

Item 466 Headwalls and Wingwalls

Do not use precast headwalls/wingwalls.

Use Class C concrete for headwalls/wingwalls

Item 467 Safety End Treatment

Pre-cast Safety End Treatments are allowed; however, a cast-in-place concrete apron will be required as shown on the plans & will be subsidiary to the Safety End Treatment.

Use Class C concrete.

Item 496 Removing Structures

Existing driveway culverts are to be retained by the landowner if they desire. If the condition of structure is beyond future use, or is destroyed during removal, it is to be disposed of by the Contractor.

Item 502 Barricades, Signs, and Traffic Handling

The Contractor Force Account “Safety Contingency” that has been established for this project is intended to be utilized for work zone enhancements, to improve the effectiveness of the Traffic Control Plan, that could not be foreseen in the project planning and design stage. These

enhancements will be mutually agreed upon by the Engineer and the Contractor's Responsible Person based on weekly or more frequent traffic management reviews on the project. The Engineer may choose to use existing bid items if it does not slow the implementation of enhancement.

Temporary rumble strips will be required as shown on WZ(RS)-16 regardless of loose gravel, and/or soft or bleeding asphalt. Adjust the traffic control setup such that rumble strips are not placed in areas of heavily rutted pavements, unpaved surfaces, or horizontal curves. Temporary rumble strips will not be allowed on interstate highway.

The Contractor is to have the option of using either plastic drums, vertical panels, grabber cones or a combination where drums are shown as channelizing devices, as approved by the Engineer. Plastic drums are to be used in all transition areas in accordance with BC(8)-14 and WZ(TD)-17.

Furnish and install "soft shoulder" signs as directed by the Engineer. This work will not be paid for directly, but will be considered as subsidiary to item 502, "Barricades, Signs and Traffic Handling".

Provide a 3:1 backfill "safety slope" at the end of the day for any drop off exceeding 2" that is adjacent to a travel lane.

Lane closures are to be limited to a maximum of 5 miles.

If more than one lane closure location is desired a minimum of 2 miles passing zone is required between each location.

Notify the Engineer 24 hours prior to any lane closure.

Item 504 Field Office and Laboratory

The following buildings will be required for this project:

One Type (D) structure, asphalt mix control laboratory

Each building is to be provided before work is begun on the pertinent construction items for which it is needed.

Any laboratory furnished is to be a minimum of 10 ft in width.

Chain link security fence will be required to be placed around the perimeter of all field offices. The dimensions of the fence will be as directed by the Engineer.

The Type D structures are to be equipped with the following in addition to requirements specified under item 504:

- a. Safety equipment
 - (1) One eye wash station
 - (2) One fire extinguisher
 - (3) One first aid kit

Furnish a Type D structure for the asphalt mix control laboratory for the Engineer's exclusive use. In addition to requirements of item 504, this structure is to have a minimum height of 8 feet and provide a minimum 400 square feet gross floor area for permanently located plants or 200 square feet for temporary located plants serving one project. The floor area will be partitioned into a minimum of two interconnected rooms, each room furnished with an exterior door and a minimum of two windows. The floor is to have sufficient strength to support the testing equipment and have an impervious covering.

The Type D structures are to be adequately air conditioned and be furnished with a minimum of one desk, three chairs, one file cabinet, a telephone and one built-in equipment storage cabinet for the storage of nuclear equipment. The cabinet is to be a minimum of 3 feet wide by 2 feet deep by 3 feet high and have provisions for locking security. The structure is to be provided with a 240-volt electrical service entrance. The service is to consist of a minimum of 4 - 120 volt circuits with 20 amp breakers and no more than two grounded convenience outlets per circuit and provisions for a minimum of two 220-volt ovens with vents to the outside. The structure is to have a minimum of 2 convenience outlets per wall, and a utility sink with an adequate clean potable water supply for testing. The state building is to be equipped with at minimum a hot water dispenser or hot water heater capable of generating 1 gallon of water per use at 140° F with adequate water pressure. Space heaters for heating the structure are unacceptable. Portable structures are to be support blocked for stability and are to be tied down.


If needed, each building is to be moved to a new location as directed by the Engineer. Any building that is no longer required on the job after completion of the pertinent construction items may be released to the Contractor upon consent of the Engineer.

Item 506 Temporary Erosion, Sedimentation, and Environmental Controls

Erosion control devices are to be installed as needed in coordination with the work progress, or as directed by the Engineer.

Item 533 Milled Rumble Stripes

Use the applicable option in the table below for installation of the continuous milled depressions, as shown on the Depressed Shoulder Texturing Standard Sheet **RS(4)-13**.

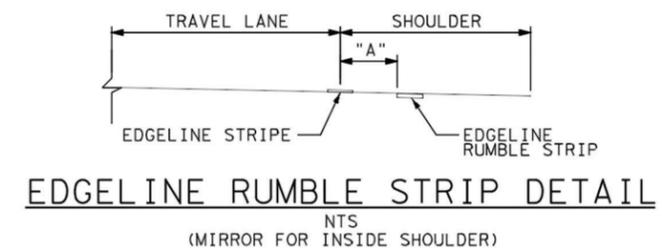

Shoulder Width (SW)	Rumble Strip Width (RS)	Placement "A"	Standard Option RS(1)-13 or RS(4)-13
SW ≤ 2'	8" RS		Option 1
2' < SW < 6'	8" - 16" RS	4" off edgeline*	Option 3
SW ≥ 6'	16" RS	24" off edgeline*	Option 4
*All inside shoulders on divided highways will be placed 4" off the edgeline			

Item 540 Metal Beam Guard Fence

Drive steel posts for metal beam guard fence a minimum of 1/3 of the post length to final specified depth.

Item 542 Removing Metal Beam Guard Fence

All MBGF, GET & TAS materials determined by the Engineer to be salvageable will remain property of the Department. Haul and stockpile all salvageable materials to the TxDOT Maintenance yard in Recreation Park, 12139 Frederick St, Pampa, TX 79065.

Item 544 Guardrail End Treatments

Use Single Guardrail End Treatment (Ty III)(Steel Post).

Item 585 Ride Quality for Pavement Surfaces

Use Surface Test Type B pay adjustment schedule 2 to evaluate ride quality of the travel lanes in accordance with Item 585, "Ride Quality for Pavement Surfaces."

Item 644 Small Roadside Sign Supports and Assemblies

All slip base signs will have a triangular slip base with a 2-bolt clamp to prevent rotation of signpost. Set screw type slip base will not be allowed.

A 7" x 1/2" diameter galvanized rod or #4 rebar is to be installed in the sign stub as shown on SMD(SLIP-1)-08 to prevent rotation of the sign stub in the concrete footing.

The exact locations of the large and small roadside signs are to be as designated by the Engineer.

The existing riprap aprons are to be removed and disposed of as approved by the Engineer. This work is not to be paid for directly, but will be considered subsidiary to the removal of foundations under this item.

Probe before drilling for foundations to determine the location of all utilities and structures. This work will not be paid for directly, but will be considered subsidiary to bid items involved.

Details for standard signs not shown on the signing standards of the signing detail plan sheets are to be in conformance with the department's "Standard Highway Sign Designs for Texas" Manual, Latest Edition.

Install a wrap of retroreflective sheeting conforming to DMS-8300 on all posts for small road sign assemblies. Sign post wraps will not be paid for directly, but are considered subsidiary to Item 644.

Install red sheeting on the posts containing the following signs:
Stop, Yield, Wrong Way & Do Not Enter

Install yellow sheeting on all other small sign posts.

Install all retroreflective wraps at a height of 4 ft. from bottom of the wrap to the edge of the travel lane surface. All retroreflective wraps will cover the full circumference of the sign post for a vertical width of 12 inches.

Item 658 Delineator and Object Marker Assemblies

For all ground mount applications provide hollow or tubular posts embedded in concrete using plastic wedged anchor system.

For all concrete barrier, bridge rail, and guard fence post mounted applications provide hollow or tubular posts with approved anchorage.

Item 662 Work Zone Pavement Markings

The adhesive used for temporary flexible-reflective roadway marker tabs is to be butyl rubber pads.

Item 666 Reflectorized Pavement Markings

Retroreflectivity Requirements:

All Type I markings must meet the minimum retroreflectivity values for edgeline markings, centerline or no passing barrier-line, and lane lines when measured any time after 3 days, but not later than 10 days after application:

- ◆ White markings: 250 millicandelas per square meter per lux (mcd/m²/lx)
- ◆ Yellow markings: 175 mcd/m²/lx

Retroreflectivity Measurements: Mobile or portable retroreflectometers may be used at the Contractor's discretion.

All Type I markings must meet the minimum retroreflectivity values for edgeline markings, centerline or no passing barrier-line, and lane lines when measured any time after 3 days, but not later than 10 days after application.

Item 677 Eliminating Existing Pavement Markings and Markers

Do not remove any existing pavement markings in any area in which the contractor is not able to place work zone pavement markings at the proper location within the same day.

Item 3076 Dense Graded Hot Mix Asphalt

Use aggregate that meets the SAC requirement of class A.

Use of RAS is not allowed.

Only fractionated RAP is allowed.

Provide a laboratory mixture design with the minimum target asphalt binder content shown below:

D-GR HMA TY B 4.6%

When laying ACP on a roadway that has two or more lanes and the work is being done under traffic, then the adjacent lane or lanes are to be overlaid by the end of the following day.

Make a smooth, clean, minimum 1 inch deep butt joint where each end of the new pavement joins the existing pavement. Any method approved by the Engineer can be used to make the joint.

The District Lab will perform a maximum of 2(two) design verification tests. If additional verification tests are needed, the Contractor will be billed \$3,500.00 per each additional verification test required to obtain an approved asphaltic concrete pavement mix design.

Provide a Hot Asphalt type Tracking Resistant Asphalt Interlayer (TRAIL) for tack coat found on the TxDOT Material Producer List. The Emulsified Asphalt options will not be allowed.

If lime is not used as an antistrip agent, then the production and placement testing frequency for the Boil test (TEX-530-C) shown in the table below.

Description	Test Method	Minimum Contractor Testing Frequency	Minimum Engineer Testing Frequency
Boil test	Tex-530-C	1 per lot	1 per 12 sublots

If used, the IR bar read out screen must be visible at all times to the Engineer.

Item 3077 Superpave Mixtures

Use aggregate that meets the SAC requirement of class

A. Only fractionated RAP is allowed.

Use of RAS is not allowed.

When laying ACP on a roadway that has two or more lanes and the work is being done under traffic, then the adjacent lane or lanes are to be overlaid by the end of the following day.

Make a smooth, clean, minimum 1 inch deep butt joint where each end of the new pavement joins the existing pavement. Any method approved by the Engineer can be used to make the joint.

The District Lab will perform a maximum of 2(two) design verification tests. If additional verification tests are needed, the Contractor will be billed \$3,500.00 per each additional verification test required to obtain an approved asphaltic concrete pavement mix design.

Provide a Hot Asphalt type Tracking Resistant Asphalt Interlayer (TRAIL) for tack coat found on the TxDOT Material Producer List. The Emulsified Asphalt options will not be allowed.

If lime is not used as an antistrip agent, then the production and placement testing frequency for the Boil test (TEX-530-C) shown in the table below.

Description	Test Method	Minimum Contractor Testing Frequency	Minimum Engineer Testing Frequency
Boil test	Tex-530-C	1 per lot	1 per 12 sublots

If used, the IR bar read out screen must be visible at all times to the Engineer.

Item 3085 Underseal Course

For estimating purposes the Underseal Course is applied at a rate of 0.25 Gal/SY.

Item	Option	Material	Application Rate	Conversion Rate
316	Seal Coat	AGGR ⁴	110 SY/CY	0.66 ¹
		ASPH ⁵	0.38 Gal/SY	
3002	Spray Applied Underseal Membrane	ASPH	0.25 Gal/SY	1.0 ²
3019	TRAIL-Ultrafuse and Jebro	ASPH	0.15 Gal/SY	1.67 ³

1. Aggregate is considered subsidiary to the asphalt. For estimating purposes 0.66 Gallons of Seal Coat Asphalt is equivalent to 1.0 Gallons of Underseal Course. Refer to Item 316 in these General notes for more information on this option.
2. For estimating purposes 1.0 Gallon of Spray Applied Underseal Membrane is equivalent to 1.0 Gallon of Underseal Course. Refer to Special Specification SS3002 for more information on this item.
3. For estimating purposes 1.67 Gallons of TRAIL is equivalent to 1.0 Gallons of Underseal Course. Refer to Special Specification SS3085 for more information on this item.
4. Use GR4 TY B SAC B in accordance with Item 316
5. Use AC-10 or other equivalent as approved by the Engineer.

<u>Example: If TRAIL Option Is Selected For Use.</u>
A conversion rate of 1.67 will be applied to every one gallon of oil that is used.
If the NET gallons determined after strapping the tank is 1,000 gallons. Then the 1,000 gallons will be multiplied by the 1.67 conversion rate in the table above.
1,000 GAL * 1.67 CR = 1670 gallons for payment.

Ultrafuse and Jebro is the only allowed “seal” for the TRAIL option. None of the “tack” options are allowed.

If the Spray Applied Underseal Membrane or TRAIL options are used, the use of tack is not required.

Item 6001 Portable Changeable Message Sign

Supply 4 Portable Changeable Message Signs (Type II – Lamp Matrix) for this project. This work will be paid at the unit price bid for each unit, which will include any moving, maintenance, and removing of the PCMS. No payment will be made for removing and replacing damaged PCMS. The Portable Changeable Message Signs will become property of the Contractor at the completion of the project.

If the Contractor chooses to have more than one lane closure set-up at a time, provide additional PCMS in accordance with TCP at no additional charge to the department.

Item 6185 Truck Mounted Attenuator (TMA) and Trailer Attenuator (TA)

In addition to the shadow vehicles with truck mounted attenuator (TMA) that are specified as being required on the traffic control plan for this project, provide 0 additional shadow vehicle(s) with TMA for TCP [\(2-1\)-18](#), [\(2-2\)-18](#), [\(2-3\)-18](#), [\(3-1\)-13](#), [\(3-3\)-14](#), [\(7-1\)-13](#) as detailed on the General Notes of this standard sheets.

Therefore, 2 total shadow vehicles with TMA will be required for this type of work. The Contractor will be responsible for determining if one or more of these operations will be ongoing at the same time to determine the total number of TMAs needed for the project.



QUANTITY SHEET

CONTROLLING PROJECT ID 0169-07-053

DISTRICT Amarillo
HIGHWAY US 60

COUNTY Gray

CONTROL SECTION JOB				0169-07-053		0169-07-054		TOTAL EST.	TOTAL FINAL
PROJECT ID				A00122774		A00133040			
COUNTY				Gray		Gray			
HIGHWAY				US 60		US 60			
ALT	BID CODE	DESCRIPTION	UNIT	EST.	FINAL	EST.	FINAL		
	100-6009	PREPARING ROW (TREE) (6" TO 24" DIA)	EA	64.000		8.000		72.000	
	105-6020	REMOVING STAB BASE & ASPH PAV (12")	SY	4,996.000		5,494.000		10,490.000	
	105-6041	REMOVING STAB BASE AND ASPH PAV(8")	SY	1,336.000		595.000		1,931.000	
	110-6001	EXCAVATION (ROADWAY)	CY	12,421.000		1,845.000		14,266.000	
	132-6004	EMBANKMENT (FINAL)(DENS CONT)(TY B)	CY	16,261.000		2,495.000		18,756.000	
	134-6011	BACKFILLING PAVEMENT EDGES	CY	800.000		19.000		819.000	
	150-6001	BLADING	STA			32.000		32.000	
	164-6036	DRILL SEEDING (PERM) (RURAL) (CLAY)	AC	19.860		6.480		26.340	
	164-6053	DRILL SEEDING (TEMP)(WARM OR COOL)	AC	10.410		6.480		16.890	
	169-6003	SOIL RETENTION BLANKETS (CL 1) (TY C)	SY	526.000				526.000	
	247-6228	FL BS (CMP IN PLC)(TY A OR B GR 4)(9")	SY	81,091.000				81,091.000	
	247-6258	FL BS (CMP IN PLC)(TY A OR B GR4)(12")	SY	2,583.000		12,197.000		14,780.000	
	251-6028	REWORK BS MTL (TY B) (8") (DENS CONT)	SY	19,709.000				19,709.000	
	251-6081	REWORK BS MTL (TY B)(12")(DENS CONT)	SY	19,605.000				19,605.000	
	275-6001	CEMENT	TON	904.000		132.000		1,036.000	
	275-6010	CEMENT TREAT (SUBGRADE) (8")	SY	83,674.000		12,197.000		95,871.000	
	310-6009	PRIME COAT (MC-30)	GAL	20,921.000		3,049.000		23,970.000	
	314-6014	EMULS ASPH (EROSN CONT)(MS-2)	GAL	12,137.000		3,919.000		16,056.000	
	316-6001	ASPH (MULTI OPTION)	GAL	31,796.000		4,635.000		36,431.000	
	316-6175	AGGR(TY-B GR-4 SAC-B)	CY	758.000		111.000		869.000	
	354-6021	PLANE ASPH CONC PAV(0" TO 2")	SY	1,174.000				1,174.000	
	354-6041	PLANE ASPH CONC PAV (1.5")	SY			13,444.000		13,444.000	
	354-6057	PLANE ASPH CONC PAV (4")	SY			14,048.000		14,048.000	
	432-6001	RIPRAP (CONC)(4 IN)	CY	223.000		1.000		224.000	
	432-6045	RIPRAP (MOW STRIP)(4 IN)	CY	30.000				30.000	
	462-6045	CONC BOX CULV (3 FT X 2 FT)(EXTEND)	LF	58.000		28.000		86.000	
	462-6046	CONC BOX CULV (3 FT X 3 FT)(EXTEND)	LF	16.000				16.000	
	462-6051	CONC BOX CULV (5 FT X 3 FT)(EXTEND)	LF	7.000				7.000	
	464-6005	RC PIPE (CL III)(24 IN)	LF	104.000				104.000	
	466-6180	WINGWALL (PW - 1) (HW=5 FT)	EA	4.000				4.000	
	467-6101	SET (TY I)(S=3 FT)(HW=2FT)(4:1)(C)	EA	5.000		2.000		7.000	
	467-6172	SET (TY I)(S= 5 FT)(HW= 3 FT)(4:1) (C)	EA	1.000				1.000	
	467-6391	SET (TY II) (24 IN) (RCP) (4: 1) (P)	EA	2.000				2.000	
	496-6006	REMOV STR (HEADWALL)	EA	4.000				4.000	
	496-6007	REMOV STR (PIPE)	LF	306.000				306.000	
	500-6001	MOBILIZATION	LS	100.00%				100.00%	
	502-6001	BARRICADES, SIGNS AND TRAFFIC HANDLING	MO	20.000				20.000	



QUANTITY SHEET

CONTROLLING PROJECT ID 0169-07-053

DISTRICT Amarillo
HIGHWAY US 60

COUNTY Gray

CONTROL SECTION JOB				0169-07-053		0169-07-054		TOTAL EST.	TOTAL FINAL
PROJECT ID				A00122774		A00133040			
COUNTY				Gray		Gray			
HIGHWAY				US 60		US 60			
ALT	BID CODE	DESCRIPTION	UNIT	EST.	FINAL	EST.	FINAL		
	506-6040	BIODEG EROSN CONT LOGS (INSTL) (8")	LF	1,960.000		420.000		2,380.000	
	506-6043	BIODEG EROSN CONT LOGS (REMOVE)	LF	1,960.000		420.000		2,380.000	
	530-6004	DRIVEWAYS (CONC)	SY			101.000		101.000	
	530-6005	DRIVEWAYS (ACP)	SY	2,038.000		493.000		2,531.000	
	530-6008	TURNOUTS (ACP)	SY	85.000		67.000		152.000	
	533-6001	RUMBLE STRIPS (SHOULDER)	LF	131,616.000				131,616.000	
	533-6002	RUMBLE STRIPS (CENTERLINE)	LF	66,276.000				66,276.000	
	540-6002	MTL W-BEAM GD FEN (STEEL POST)	LF	7,150.000				7,150.000	
	542-6001	REMOVE METAL BEAM GUARD FENCE	LF	1,970.000				1,970.000	
	544-6001	GUARDRAIL END TREATMENT (INSTALL)	EA	18.000				18.000	
	544-6003	GUARDRAIL END TREATMENT (REMOVE)	EA	4.000				4.000	
	560-6001	MAILBOX INSTALL-S (TWG-POST) TY 1	EA	3.000		9.000		12.000	
	560-6002	MAILBOX INSTALL-D (TWG-POST) TY 1	EA			9.000		9.000	
	560-6025	RELOCATE EXISTING MAILBOX	EA	3.000		2.000		5.000	
	644-6001	IN SM RD SN SUP&AM TY10BWG(1)SA(P)	EA	27.000		1.000		28.000	
	644-6004	IN SM RD SN SUP&AM TY10BWG(1)SA(T)	EA	57.000		7.000		64.000	
	644-6007	IN SM RD SN SUP&AM TY10BWG(1)SA(U)	EA	2.000		1.000		3.000	
	644-6030	IN SM RD SN SUP&AM TYS80(1)SA(T)	EA	10.000		1.000		11.000	
	644-6068	RELOCATE SM RD SN SUP&AM TY 10BWG	EA	4.000				4.000	
	644-6076	REMOVE SM RD SN SUP&AM	EA	80.000		11.000		91.000	
	658-6060	REMOVE DELIN & OBJECT MARKER ASSMS	EA	50.000		9.000		59.000	
	658-6062	INSTL DEL ASSM (D-SW)SZ 1(BRF)GF2(BI)	EA	65.000				65.000	
	658-6087	INSTL DEL ASSM (D-SY)SZ 1(YFLX)GND(BR)	EA	14.000				14.000	
	658-6099	INSTL OM ASSM (OM-2Z)(WFLX)GND	EA	7.000		1.000		8.000	
	662-6001	WK ZN PAV MRK NON-REMOV (W)4"(BRK)	LF	11,119.000				11,119.000	
	662-6004	WK ZN PAV MRK NON-REMOV (W)4"(SLD)	LF	88,950.000		6,358.000		95,308.000	
	666-6005	REFL PAV MRK TY I (W)4"(DOT)(090MIL)	LF	2,088.000				2,088.000	
	666-6035	REFL PAV MRK TY I (W)8"(SLD)(090MIL)	LF	2,210.000				2,210.000	
	666-6047	REFL PAV MRK TY I (W)24"(SLD)(090MIL)	LF	160.000				160.000	
	666-6054	REFL PAV MRK TY I (W)(ARROW)(100MIL)	EA	5.000				5.000	
	666-6071	REFL PAV MRK TY I(W)(LNDP ARW)(090MIL)	EA	8.000				8.000	
	666-6078	REFL PAV MRK TY I (W)(WORD)(100MIL)	EA	4.000				4.000	
	672-6007	REFL PAV MRKR TY I-C	EA	522.000		14.000		536.000	
	672-6009	REFL PAV MRKR TY II-A-A	EA	2,760.000		326.000		3,086.000	
	3076-6001	D-GR HMA TY-B PG64-22	TON	13,806.000		2,013.000		15,819.000	
	3077-6058	SP MIXESSP-DSAC-A PG70-28	TON	65,163.000		7,538.000		72,701.000	
	3077-6075	TACK COAT	GAL	51,108.000		1,509.000		52,617.000	

DISTRICT	COUNTY	CCSJ	SHEET
Amarillo	Gray	0169-07-053	14A



QUANTITY SHEET

CONTROLLING PROJECT ID 0169-07-053

DISTRICT Amarillo
HIGHWAY US 60

COUNTY Gray

CONTROL SECTION JOB				0169-07-053		0169-07-054		TOTAL EST.	TOTAL FINAL
PROJECT ID				A00122774		A00133040			
COUNTY				Gray		Gray			
HIGHWAY				US 60		US 60			
ALT	BID CODE	DESCRIPTION	UNIT	EST.	FINAL	EST.	FINAL		
	3085-6001	UNDERSEAL COURSE	GAL	90,525.000		13,169.000		103,694.000	
	6001-6002	PORTABLE CHANGEABLE MESSAGE SIGN	EA	4.000				4.000	
	6024-6002	HPPM W/RET REQ TY I(W)4"(BRK)(090MIL)	LF	8,633.000		278.090		8,911.090	
	6024-6005	HPPM W/RET REQ TY I(W)4"(SLD)(090MIL)	LF	146,115.000		11,957.000		158,072.000	
	6024-6014	HPPM W/RET REQ TY I(Y)4"(BRK)(090MIL)	LF	6,304.000		3,259.000		9,563.000	
	6024-6017	HPPM W/RET REQ TY I(Y)4"(SLD)(090MIL)	LF	102,802.000		13,035.000		115,837.000	
	6185-6002	TMA (STATIONARY)	DAY	200.000				200.000	
	6185-6003	TMA (MOBILE OPERATION)	HR	80.000				80.000	
	18	EROSION CONTROL MAINTENANCE: CONTRACTOR FORCE ACCOUNT WORK (PART)	LS	1.000				1.000	
		SAFETY CONTINGENCY: CONTRACTOR FORCE ACCOUNT WORK (PARTICIPATING)	LS	1.000				1.000	

SUMMARY OF ROADWAY ITEMS																
LOCATION		110	132	150	247	247	251	251	275	275	310	316	316	530	530	533
		6001	6004	6001	6228	6258	6028	6081	6001	6010	6009	6001	6175	6005	6004	6001
		EXCAVATION	EMBANKMENT	BLADING	FL BS (CMP	FL BS (CMP	REWORK BS	REWORK BS	CEMENT	CEMENT	PRIME	ASPH	AGGR (TY-B	DRIVEWAYS	DRIVEWAYS	RUMBLE
		(ROADWAY)	(FINAL) (DENS		IN PLC) (TY	IN PLC) (TY	MTL (TY B)	MTL (TY B)	21.6 LBS/SY	TREAT	COAT	(MULTI	GR-4	(ACP)	(CONC)	STRIPS
			CONT) (TY B)		A OR B, GR	OR B	(8") (DENS	(12") (DENS		(SUBGRADE)	(MC-30)	OPTION)	SAC-B)			(SHOULDER)
FROM	TO	CY	CY	STA	SY	SY	SY	SY	TON	SY	GAL	GAL	CY	SY	SY	LF
49+00	54+83															
54+83	58+21															
58+21	86+60															
86+60	87+75															
87+75	119+54	1845	2495	32			12197		132	12197	3049	4635	111	493	101	
119+54	125+40															
CSJ 0169-07-054 TOTAL		1845	2495	32			12197		132	12197	3049	4635	111	493	101	
125+40	139+18															
139+18	215+50													58		14926
215+50	262+00													160		9300
262+00	275+00															2600
275+00	284+00	474	392		2800			1400	30	2800	700	1064	25			1800
284+00	362+68	4751	6379		29531			14766	319	29531	7383	11222	268	288		14916
362+68	386+40	667	895		6213			3107	67	6213	1553	2361	56			4208
386+40	390+00	166	12		665			333	7	665	166	253	6			548
390+00	485+00	3	19											735		19000
485+00	489+50	59	120		650		306		7	650	163	247	6			900
489+50	535+00	742	1320		8594		4044		93	8594	2149	3266	78			9100
535+00	544+00	633	348		3000		1412		32	3000	750	1140	27			1800
544+00	555+20	916	414		4231		1991		46	4231	1058	1608	38			2240
555+20	564+20	606	292		3000		1412		32	3000	750	1140	27			1800
564+20	609+70	880	1162		8594		4044		93	8594	2149	3266	78	609		9100
609+70	614+20	23	239		650		306		7	650	163	247	6			900
614+20	685+00	3	4											171		14160
685+00	689+50	58	72		650		306		7	650	163	247	6			900
689+50	749+00	996	2014		11212		5276		121	11212	2803	4261	102	17		11900
749+00	758+00	31	491		1300		612		14	1300	325	494	12			1800
758+00	789+00	323	1164													6200
789+00	798+00															1800
798+00	806+59															1718
SH 152 SHEET 1 OF 1		1090	924				2583		28	2583	646	982	23			
CSJ 0169-07-053 TOTAL		12421	16261		81091		2583		904	83674	20921	31796	758	2038		131616
PROJECT TOTALS		14266	18756	32	81091		14780		1035	95871	23970	36431	869	2531	101	131616

SUMMARY OF WORKZONE TRAFFIC CONTROL ITEMS			
LOCATION		662	662
		6001	6004
		WK ZN PAV	WK ZN PAV
		MRK	MRK
		NON-REMOV	NON-REMOV
		(W) 4" (BRK)	(W) 4" (SLD)
From	To	LF	LF
Phase 2: 3-Lane EB			
CSJ: 0169-07-054			
87+75	119+54		3179
Phase 2: EB Super 2			
CSJ: 0169-07-053			
275+00	368+60	2340	18720
485+00	564+20	1980	15840
685+00	758+00	1825	14600
Phase 2: EB with MBGF			
CSJ: 0169-07-053			
285+85	290+85	125	1000
Phase 2: 3-Lane WB			
CSJ: 0169-07-054			
87+75	119+54		3179
Phase 2: WB Super 2			
CSJ: 0169-07-053			
275+00	385+00	2750	22000
535+00	614+20	1980	15840
Phase 2: WB with MBGF			
CSJ: 0169-07-053			
287+15	291+90	119	950
CSJ: 0169-07-054 TOTAL			6358
CSJ: 0169-07-053 TOTAL		11119	88950
PROJECT TOTALS		11119	95308

05/17/2021



Bo L. Ratto

REV. NO.	DATE	DESCRIPTION	BY



CobbFendley

TBPE Firm Registration No. 274
TBPLS Firm Registration No. 100467

13430 Northwest Freeway, Ste. 1100
Houston, Texas 77040
713.462.3242
www.cobbhendley.com



Texas Department of Transportation

ROADWAY QUANTITY SUMMARY

SHEET 1 OF 2

FED. RD. DIV. NO.	STATE	PROJECT NO. (SEE TITLE SHEET)		HIGHWAY NO.
6	TEXAS	0169	07	US60
STATE DISTRICT	COUNTY	CONTROL NO.	SECTION NO.	JOB NO.
AMA	GRAY	0169	07	053, ETC
				SHEET NO.
				16

5/17/2021 9:36:07 AM F:\P\Projects\2019\1004_TxDOT_3x5_PSS\03_US60_Amarillo\1616\US60-USTN\04-Gener\02-Sheets\US60_GEN-SUM-ROAD.dgn

SUMMARY OF ROADWAY ITEMS										
LOCATION		533	3076	3077	3077	3077	3077	3077	3085	432
		6002	6001	6058	6058	6058	6058	6075	6001	6001
		RUMBLE STRIPS (CENTERLINE)	D-GR HMA TY-B PG64-22 330 LBS/SY	OVERLAY SP MIXES SP-D SAC-A PG70-28 165 LBS/SY	OVERLAY SP MIXES SP-D SAC-A PG70-28 440 LBS/SY	WIDENING SP MIXES SP-D SAC-A PG70-28 220 LBS/SY	OVERLAY SP MIXES SP-D SAC-A PG70-28 330 LBS/SY	TACK COAT 0.13 GAL/SY	UNDERSEAL COURSE 0.25 GAL/SY	RIPRAP (CONC) (4 IN)
FROM	TO	LF	TON	TON	TON	TON	TON	GAL	GAL	CY
49+00	54+83			150	741				1296	
54+83	58+21			93	331				657	
58+21	86+60			833	1943				4732	
86+60	87+75			93					188	
87+75	119+54		2013	1690		1277		1509	5122	1
119+54	125+40			388					1175	
CSJ 0169-07-054 TOTAL			2013	3246	3015	1277		1509	13169	1
125+40	139+18			1216					3685	
139+18	215+50	7632					3731		8480	
215+50	262+00	4650					5456	4299	8267	
262+00	275+00	1300					953	751	1444	
275+00	284+00	900	462		290		792	966	1200	
284+00	362+43	7843	4873		3089	8052	9994	12200		186
362+43	386+40	2104	1025		659	2109	2441	3196		
386+40	390+00	188	110		70	337	347	510		
390+00	485+00	9500				6967	5489	10556		
485+00	489+50	450	107		67	363	365	550		
489+50	535+00	4550	1418		899	4004	4217	6067		
535+00	544+00	900	495		312	858	1044	1300		
544+00	555+20	1120	698		443	1150	1429	1742		
555+20	564+20	900	495		312	858	1044	1300		
564+20	609+70	4550	1418		899	4087	4283	6193		
609+70	614+20	450	107		67	363	365	550		
614+20	685+00	7080				5192	4091	7867		
685+00	689+50	450	107		67	363	365	550		
689+50	749+00	5950	1850		1177	5236	5516	7933		
749+00	758+00	900	215		134	726	730	1100		37
758+00	789+00	3100				2273	1791	3444		
789+00	798+00	900				759	598	1150		
798+00	806+59	859				819	645	1240		
SH 152 SHEET 1 OF 1			426			15		336		
CSJ 0169-07-053 TOTAL		66276	13806	1216		8498	55449	51108	90525	223
PROJECT TOTALS		66276	15819	4462	3015	9775	55449	52617	103694	224

5/17/2021 9:36:07 AM F:\P\Projects\2019\1004_TxDOT_5x5_PSS&E\03_US60_Amarillo\ENGIN\500-UST\IN\504-Gener\02-Sheets\US60_GEN-SUM-ROAD.dgn

05/17/2021



Bo L. Ratto

REV. NO.	DATE	DESCRIPTION	BY



13430 Northwest Freeway, Ste. 1100
Houston, Texas 77040
713.462.3242
www.cobbhendley.com



Texas Department
of Transportation

ROADWAY QUANTITY SUMMARY

SHEET **2** OF **2**

FED. RD. DIV. NO.	STATE	PROJECT NO.		HIGHWAY NO.
6	TEXAS	(SEE TITLE SHEET)		US60
STATE DISTRICT	COUNTY	CONTROL NO.	SECTION NO.	JOB SHEET NO.
AMA	GRAY	0169	07	053, ETC 17

US60-GEN-SUM-ROAD.dgn

4/7/2021 7:26:15 AM F:\P\J\2019\1004_TxDOT_5x5_PSS&E\03_US60_Amarr\116\ENG\500\USTN\504-Gener\02-Sheets\US60_GEN-SUM-DRIVE.dgn

DRIVEWAY SUMMARY												
STATION	DRIVEWAY NUMBER	LT/RT	LOCATION	EXISTING SURFACE	PROPOSED DRIVEWAY DIMENSIONS					530 6005	530 6004	
					W1	W2	R1	R2	L	DRIVEWAYS (ACP)	DRIVEWAYS (CONC)	
											SY	SY
US 60												
90+87.00	1	RT	US 60	CONCRETE	52	22	24	24	15		47	
92+52.00	2	RT	US 60	CONCRETE	56	26	24	24	15		54	
93+35.00	3	RT	US 60	ASPHALT	48	18	24	24	15	41		
94+44.00	4	RT	US 60	ASPHALT	60	30	24	24	15	61		
96+36.00	5	RT	US 60	GRAVEL	50	20	24	24	15	44		
101+10.00	6	RT	US 60	ASPHALT	42	12	24	24	15	31		
101+89.00	7	LT	US 60	ASPHALT	48	18	24	24	15	41		
103+04.00	8	LT	US 60	GRAVEL	42	12	24	24	15	31		
103+40.00	9	RT	US 60	ASPHALT	54	24	24	24	15	51		
105+64.00	10	RT	US 60	GRAVEL	40	10	24	24	15	27		
107+91.00	11	RT	US 60	GRAVEL	42	12	24	24	15	31		
108+14.00	12	RT	US 60	GRAVEL	46	16	24	24	15	37		
110+06.00	13	RT	US 60	GRAVEL	42	12	24	24	15	31		
115+64.00	14	LT	US 60	GRAVEL	42	12	24	24	15	31		
117+66.00	15	LT	US 60	ASPHALT	46	16	24	24	15	37		
153+60.54	16	RT	US 60	ASPHALT	MATCH EXISTING					18		
143+62.27	17	RT	US 60	ASPHALT	MATCH EXISTING					21		
153+60.54	18	RT	US 60	ASPHALT	MATCH EXISTING					19		
226.05.24	19	RT	US 60	ASPHALT	MATCH EXISTING					32		
231+09.69	20	LT	US 60	ASPHALT	36	18	9	10	4	11		
232+68.65	21	LT	US 60	ASPHALT	51	21	16	14	4	13		
234+32.59	22	RT	US 60	ASPHALT	MATCH EXISTING					17		
234+46.29	23	LT	US 60	ASPHALT	MATCH EXISTING					23		
254+62.20	24	RT	US 60	ASPHALT	MATCH EXISTING					32		
256+62.44	25	LT	US 60	ASPHALT	MATCH EXISTING					32		
296+26.83	26	RT	US 60	ASPHALT	50	20	24	24	15	44		
320+18.00	27	RT	US 60	GRAVEL	50	20	24	24	15	44		
351+60.11	28	LT	US 60	GRAVEL	82	32	40	40	25	119		
356+39.00	29	RT	US 60	ASPHALT	74	43	24	24	15	81		
387+70.82	30	RT	US 60	ASPHALT	MATCH EXISTING					77		
412+22.13	31	RT	US 60	ASPHALT	MATCH EXISTING					159		
412+52.93	32	LT	US 60	ASPHALT	MATCH EXISTING					160		
473+48.94	33	RT	US 60	ASPHALT	MATCH EXISTING					41		
476+06.29	34	LT	US 60	ASPHALT	MATCH EXISTING					53		
478+40.87	35	RT	US 60	ASPHALT	MATCH EXISTING					215		
479+08.40	36	LT	US 60	ASPHALT	MATCH EXISTING					30		
572+52.34	37	LT	US 60	ASPHALT	98	36	24	50	21	136		
573+83.88	38	RT	US 60	ASPHALT	MATCH EXISTING					240		
601+17.69	39	RT	US 60	ASPHALT	MATCH EXISTING					139		
601+95.17	40	LT	US 60	ASPHALT	67	24	31	139	28	94		
626+43.76	41	RT	US 60	GRAVEL	MATCH EXISTING					21		
627+80.29	42	LT	US 60	ASPHALT	MATCH EXISTING					41		
662+19.24	43	RT	US 60	ASPHALT	MATCH EXISTING					35		
662+63.16	44	LT	US 60	GRAVEL	MATCH EXISTING					20		
667+98.64	45	LT	US 60	ASPHALT	MATCH EXISTING					11		
678+29.91	46	RT	US 60	ASPHALT	MATCH EXISTING					43		
693+25.62	47	LT	US 60	ASPHALT	MATCH EXISTING					17		

* QUANTITY INCLUDED IN PERTINENT SUMMARY.

04/07/2021



Bo L Ratto

REV. NO.	DATE	DESCRIPTION	BY


 13430 Northwest Freeway, Ste. 1100
 Houston, Texas 77040
 TBPE Firm Registration No. 274 713.462.3242
 TBPLS Firm Registration No. 100467 www.cobbhendley.com


 Texas Department of Transportation

DRIVEWAY QUANTITY SUMMARY

SHEET 1 OF 1

FED. RD. DIV. NO.	STATE	PROJECT NO.	HIGHWAY NO.		
6	TEXAS	(SEE TITLE SHEET)	US60		
STATE DISTRICT	COUNTY	CONTROL NO.	SECTION NO.	JOB NO.	SHEET NO.
AMA	GRAY	0169	07	053, ETC	18

US60-GEN-SUM-DRIVE.dgn

SUMMARY OF MBGF ITEMS						
LOCATION		432	540	542	544	544
		6045	6002	6001	6001	6003
		RIPRAP (MOW STRIP) (4 IN)	MTL W-BEAM GD FEN (STEEL POST)	REMOVE METAL BEAM GUARD FENCE	GUARDRAIL END TREATMENT (INSTALL)	GUARDRAIL END TREATMENT (REMOVE)
FROM	TO	CY	LF	LF	EA	EA
49+00	54+83					
54+83	58+21					
58+21	86+60					
86+60	87+75					
87+75	119+54					
119+54	125+40					
CSJ 0169-07-054 TOTAL						
125+40	138+00					
138+00	215+50					
215+50	262+00					
262+00	275+00					
275+00	284+00					
284+00	362+68	22	1150	1324	4	2
362+68	381+00			396		
381+00	385+00					
385+00	485+00					
485+00	489+50					
489+50	535+00					
535+00	544+00					
544+00	555+20					
555+20	564+20					
564+20	609+70			250		2
609+70	614+20					
614+20	685+00					
685+00	689+50					
689+50	749+00		160		1	
749+00	758+00	8	465		1	
758+00	789+00		4950		10	
789+00	798+00		425		2	
798+00	806+59					
SH 152 SHEET 1 OF 1						
CSJ 0169-07-053 TOTAL		30	7150	1970	18	4
PROJECT TOTALS		30	7150	1970	18	4

SUMMARY OF ROADWAY ITEMS					
LOCATION		530	560	560	560
		6008	6001	6002	6025
		TURNOUTS (ACP)	MAILBOX INSTALL-S (TWG-POST) TY 1	MAILBOX INSTALL-D (TWG-POST) TY 1	RELOCATE EXISTING MAILBOX
FROM	TO	SY	EA	EA	EA
49+00	54+83				
54+83	58+21				
58+21	86+60				
86+60	87+75				
87+75	119+54	67	9	9	2
119+54	125+40				
CSJ 0169-07-054 TOTAL					
125+40	138+00				
138+00	215+50				
215+50	262+00				
262+00	275+00				
275+00	284+00				
284+00	362+68	85	3		3
362+68	381+00				
381+00	385+00				
385+00	485+00				
485+00	489+50				
489+50	535+00				
535+00	544+00				
544+00	555+20				
555+20	564+20				
564+20	609+70				
609+70	614+20				
614+20	685+00				
685+00	689+50				
689+50	749+00				
749+00	758+00				
758+00	789+00				
789+00	798+00				
798+00	806+59				
SH 152 SHEET 1 OF 1					
CSJ 0169-07-053 TOTAL		85	3		3
PROJECT TOTALS		152	12	9	5

04/07/2021



Bo L. Ratto

REV. NO.	DATE	DESCRIPTION	BY

CobbFendley 13430 Northwest Freeway, Ste. 1100
Houston, Texas 77040
713.462.3242
www.cobbendley.com

 **Texas Department of Transportation**

**MBGF
QUANTITY SUMMARY**

FED. RD. DIV. NO.	STATE	PROJECT NO.	HIGHWAY NO.
6	TEXAS	(SEE TITLE SHEET)	US60
STATE DISTRICT	COUNTY	CONTROL NO.	SECTION NO.
AMA	GRAY	0169	07
		JOB NO.	SHEET NO.
		053, ETC	19

4/7/2021 7:26:16 AM F:\P\J\1616\2019\1004_Tx\DOT_5x5_PSS&E\03_US60_Amar\11616\1616\500-UST\IN\504-Gener\02-Sheets\US60_GEN\SUM\MBGF.dgn

US60_GEN\SUM\MBGF.dgn

SUMMARY OF DRAINAGE ITEMS								
LOCATION	462 6045	462 6046	462 6051	464 6005	466 6180	467 6101	467 6172	467 6391
	CONC BOX CULV (3 FT X 2 FT) (EXTEND)	CONC BOX CULV (3 FT X 3 FT) (EXTEND)	CONC BOX CULV (5 FT X 3 FT) (EXTEND)	RC PIPE (CL III) (24 IN)	WINGWALL (PW - 1) (HW=5 FT)	SET (TY I) (S=3 FT) (HW=2FT) (4:1) (C)	SET (TY I) (S= 5 FT) (HW= 3 FT) (4:1) (C)	SET (TY II) (24 IN) (RCP) (4:1) (P)
	LF	LF	LF	LF	EA	EA	EA	EA
110+63	28					2		
CSJ 0169-07-054 TOTAL	28					2		
289+05		16			4			
348+11	27					2		
370+44			7				1	
503+73	11					1		
571+74	11					1		
600+74	9					1		
SH 152 SHEET 1 OF 1				104				2
CSJ 0169-07-053 TOTAL	58	16	7	104	4	5	1	2
PROJECT TOTALS	86	16	7	104	4	7	1	2

4/7/2021 7:26:16 AM F:\P\proj\2019\1004_Tx\DOT_5x5_PSS&E\03_US60_Amar\116\ENG\500\UST\IN\504-Genet\02-Sheets\US60_GEN-SUM-DRAIN.dgn


 04/07/2021
 Bo L. Ratto

REV. NO.	DATE	DESCRIPTION	BY


13430 Northwest Freeway, Ste. 1100
Houston, Texas 77040
713.462.3242
www.cobbhendley.com



DRAINAGE QUANTITY SUMMARY

SHEET 1 OF 1

FED. RD. DIV. NO.	STATE	PROJECT NO.	HIGHWAY NO.
6	TEXAS	(SEE TITLE SHEET)	US60
STATE DISTRICT	COUNTY	CONTROL NO.	SECTION NO.
AMA	GRAY	0169	07
		JOB NO.	SHEET NO.
		053, ETC	20

US60-GEN-SUM-DRAIN.dgn

4/7/2021 7:26:17 AM F:\P\j\c\2019\1004_Tx\DOT_5x3_PSS&E\03_US60_Amarr\1616\ING\500-UST\IN\504-Gener\02-Sheets\US60_GEN-SUM-SPM.dgn

SUMMARY OF PAVEMENT MARKING ITEMS												
LOCATION	666 6005	666 6035	666 6047	666 6054	666 6071	666 6078	672 6007	672 6009	6024 6002	6024 6005	6024 6014	6024 6017
	REFL PAV MRK TY I (W)4" (DOT) (090MIL)	REFL PAV MRK TY I (W)8" (SLD) (090MIL)	REFL PAV MRK TY I (W)24" (SLD) (090MIL)	REFL PAV MRK TY I (W) (ARROW) (100MIL)	REFL PAV MRK TY I (W) (LNDP ARW) (090MIL)	REFL PAV MRK TY I (W) (WORD) (100MIL)	REFL PAV MRKR TY I-C	REFL PAV MRKR TY II-A-A	HPPM W/RET REQ TY I (W)4" (BR K) (090MIL)	HPPM W/RET REQ TY I (W)4" (S LD) (090MIL)	HPPM W/RET REQ TY I (Y)4" (B RK) (090MIL)	HPPM W/RET REQ TY I (Y)4" (S LD) (090MIL)
	LF	LF	LF	EA	EA	EA	EA	EA	LF	LF	LF	LF
SHEET 1 OF 35							14	106	278	3288	1059	4235
SHEET 2 OF 35								110		4317	1100	4400
SHEET 3 OF 35								110		4352	1100	4400
SHEET 4 OF 35												
CSJ 0169-07-054 TOTAL							14	326	278	11957	3259	13035
SHEET 5 OF 35								45		3600	450	
SHEET 6 OF 35								55		4314	550	
SHEET 7 OF 35								55		4400	550	
SHEET 8 OF 35								55		4400	550	952
SHEET 9 OF 35							14	177	267	5225	59	7141
SHEET 10 OF 35							9	134	169	4901		6206
SHEET 11 OF 35	288				1		15	95	288	4400		4400
SHEET 12 OF 35	78				1		52	110	1022	4400		4400
SHEET 13 OF 35	75						52	110	1025	4400		4400
SHEET 14 OF 35	550						28	110	550	4324		4400
SHEET 15 OF 35				1			28	110	550	5207		4400
SHEET 16 OF 35							5	107	97	4339	275	3626
SHEET 17 OF 35								55		4151	550	
SHEET 18 OF 35								55		4400	550	
SHEET 19 OF 35								55		4400	550	
SHEET 20 OF 35	100							65		4061	450	800
SHEET 21 OF 35	13						27	110	538	4400		4400
SHEET 22 OF 35							28	110	550	4400		4400
SHEET 23 OF 35	501				4		17	110	324	4400		4400
SHEET 24 OF 35	5						28	110	550	4182		4400
SHEET 25 OF 35							28	110	550	4400		4400
SHEET 26 OF 35	113						14	93	268	4327	170	3040
SHEET 27 OF 35								55		4400	550	
SHEET 28 OF 35								55		4310	550	
SHEET 29 OF 35	50							60		4298	500	400
SHEET 30 OF 35	63						25	110	489	4400		4400
SHEET 31 OF 35							28	110	550	4400		4400
SHEET 32 OF 35	253				2		10	110	197	4400		4400
SHEET 33 OF 35								95		4400		4400
SHEET 34 OF 35								75		4400		4400
SHEET 35 OF 35							11	48	215	1817		1918
INTERSECTION OF US 60 & SH 171												
SHEET 1 OF 2		1642	160	4		4	104	6	435	6888		6860
SHEET 2 OF 2										1000		2000
INTERSECTION OF US 60 & SH 152												
SHEET 1 OF 3		568								2145		1604
SHEET 2 OF 3										1156		1072
SHEET 3 OF 3										1070		1183
CSJ 0169-07-053 TOTAL	2088	2210	160	5	8	4	522	2760	8633	146115	6304	102802
PROJECT TOTALS	2088	2210	160	5	8	4	536	3086	8911	158072	9563	115837

04/07/2021



Bo L. Ratto

REV. NO.	DATE	DESCRIPTION	BY

CobbFendley 13430 Northwest Freeway, Ste. 1100
Houston, Texas 77040
713.462.3242
www.cobbendley.com



PAVEMENT MARKINGS QUANTITY SUMMARY

SHEET 1 OF 1

FED. RD. DIV. NO.	STATE	PROJECT NO.	HIGHWAY NO.
6	TEXAS	(SEE TITLE SHEET)	US60
STATE DISTRICT	COUNTY	CONTROL NO.	SECTION NO.
AMA	GRAY	0169	07
		JOB NO.	SHEET NO.
		053, ETC	21

US60-GEN-SUM-SPM.dgn

4/7/2021 7:26:17 AM F:\P\0\02\2019\1004_Tx\DOT_5x5_P5&E\03_US60_Amarr\116\16\16\500-UST\IN\504-Gener\02-Sheets\US60_GEN-SUM-SIGNS.dgn

SUMMARY OF SIGNING ITEMS										
LOCATION	644 6001	644 6004	644 6007	644 6030	644 6068	644 6076	658 6087	658 6099	658 6060	658 6062
	IN SM RD SN SUP&AM TY10BWG (1) SA (P)	IN SM RD SN SUP&AM TY10BWG (1) SA (T)	IN SM RD SN SUP&AM TY10BWG (1) SA (U)	IN SM RD SN SUP&AM TYS80 (1) S A (T)	RELOCATE SM RD SN SUP&AM TY 10BWG	REMOVE SM RD SN SUP&AM	INSTR DEL ASSM (D-SY) SZ 1 (YFLX) GND (BR)	INSTR OM ASSM (OM-2Z) (W FLX) GND	REMOVE DELIN & OBJECT MARKER ASSMS	INSTR DEL ASSM (D-SW) GF2 (BI)
	EA	EA	EA	EA	EA	EA	EA	EA	EA	EA
SHEET 1 OF 35										
SHEET 2 OF 35										
SHEET 3 OF 35	1	4	1			7		1	6	
SHEET 4 OF 35		3		1		4			3	
CSJ 0169-07-054 TOTAL	1	7	1	1		11		1	9	
SHEET 5 OF 35										
SHEET 6 OF 35		6				4				
SHEET 7 OF 35		2				2				
SHEET 8 OF 35										
SHEET 9 OF 35		3				3				
SHEET 10 OF 35		2				2				
SHEET 11 OF 35		1								9
SHEET 12 OF 35	1	2				1				3
SHEET 13 OF 35		2		1		2				
SHEET 14 OF 35	1	5				6		2	2	
SHEET 15 OF 35	1	4	2	1		19		1	10	
SHEET 16 OF 35	1	2		1	1	3				
SHEET 17 OF 35	5			1		6				
SHEET 18 OF 35	1			1		2				
SHEET 19 OF 35							7			
SHEET 20 OF 35	2	3				5				
SHEET 21 OF 35	1			1				1	1	
SHEET 22 OF 35	1			1		1				
SHEET 23 OF 35		2							6	
SHEET 24 OF 35		5				5		1	5	
SHEET 25 OF 35		2		1		2			3	
SHEET 26 OF 35	1	2				3				
SHEET 27 OF 35	1	1				2				
SHEET 28 OF 35		2				3				
SHEET 29 OF 35		4				5			5	
SHEET 30 OF 35	1								15	
SHEET 31 OF 35		1		1						
SHEET 32 OF 35	1	1				1			1	5
SHEET 33 OF 35		1				1				27
SHEET 34 OF 35	1	1		1		2				21
SHEET 35 OF 35		1								
SH 152 SHEET 1 OF 1	8	2			3		7	2	2	
CSJ 0169-07-053 TOTAL	27	57	2	10	4	80	14	7	50	65
PROJECT TOTALS	28	64	3	11	4	91	14	8	59	65

04/07/2021



Bo L. Ratto

REV. NO.	DATE	DESCRIPTION	BY



CobbFendley

TBPE Firm Registration No. 274
TBPLS Firm Registration No. 100467

13430 Northwest Freeway, Ste. 1100
Houston, Texas 77040
713.462.3242
www.cobbhendley.com



Texas Department of Transportation

SIGNING QUANTITY SUMMARY

SHEET 1 OF 1					
FED. RD. DIV. NO.	STATE	PROJECT NO.		HIGHWAY NO.	
6	TEXAS	(SEE TITLE SHEET)		US60	
STATE DISTRICT	COUNTY	CONTROL NO.	SECTION NO.	JOB NO.	SHEET NO.
AMA	GRAY	0169	07	053, ETC	22

US60_GEN-SUM-SIGNS.dgn

SUMMARY OF EARTHWORK QUANTITIES							
STATION	END AREA		DISTANCE BETWEEN X-S	VOLUME		CUMULATIVE VOLUME	
	EXCAVATION	EMBANKMENT		110	132	EXCAVATION	EMBANKMENT
				6001	6004		
SF	SF	FT	EXCAVATION (ROADWAY) CY	EMBANKMENT (FINAL) (DENS CONT) (TY B) CY	CY	CY	
US 60 CSJ:0169-07-053							
370+00	8	0	100	35	5	7272	9531
371+00	10	3	100	38	14	7311	9546
372+00	10	5	100	35	16	7346	9562
373+00	9	4	100	20	48	7366	9610
374+00	2	22	100	5	83	7371	9693
375+00	0	23	100	1	93	7372	9786
376+00	0	27	100	0	98	7372	9884
377+00	0	26	100	1	84	7373	9967
378+00	1	19	100	3	61	7375	10028
379+00	1	14	100	6	46	7381	10074
380+00	2	11	100	8	36	7389	10111
381+00	2	8	100	16	25	7404	10135
382+00	6	5	100	24	17	7428	10152
383+00	6	4	100	50	8	7478	10160
384+00	21	0	100	77	0	7556	10160
385+00	21	0	100	89	0	7644	10160
386+00	27	0	100	93	0	7737	10160
387+00	23	0	100	74	1	7811	10161
388+00	17	0	100	52	2	7863	10163
389+00	11	0	100	30	4	7893	10166
390+00	5	0	100	10	6	7902	10172
391+00	0	0	100	0	10	7902	10182
484+00	0	0	100	0	2	7902	10184
485+00	0	1	100	3	7	7905	10190
486+00	2	3	100	10	11	7915	10201
487+00	3	3	100	16	13	7931	10215
488+00	5	4	100	17	23	7947	10237
489+00	4	8	100	17	28	7964	10265
490+00	5	7	100	19	24	7984	10289
491+00	6	6	100	21	22	8004	10310
492+00	6	6	100	19	22	8024	10332
493+00	5	6	100	18	25	8042	10357
494+00	5	7	100	17	30	8059	10387
495+00	4	9	100	15	34	8074	10421
496+00	4	9	100	14	38	8088	10459
497+00	3	11	100	12	43	8099	10502
498+00	3	12	100	10	52	8110	10553
499+00	3	15	100	7	60	8117	10613
500+00	1	17	100	5	63	8122	10677
501+00	1	17	100	7	61	8128	10738
502+00	2	16	100	10	59	8138	10797
503+00	3	16	100	7	63	8145	10860
504+00	1	18	100	5	58	8150	10918
505+00	2	13	100	14	38	8164	10956
506+00	6	7	100	21	27	8185	10982
507+00	6	7	100	19	25	8204	11007
508+00	5	6	100	17	23	8221	11030
509+00	5	6	100	17	22	8238	11052
510+00	5	6	100	18	22	8256	11074
511+00	5	6	100	20	23	8276	11097
512+00	5	7	100	19	24	8295	11122
513+00	5	6	100	18	24	8313	11146
514+00	5	7	100	19	24	8331	11169
515+00	5	6	100	17	23	8349	11192
516+00	4	6	100	16	22	8365	11214
517+00	4	6	100	17	20	8381	11234
518+00	5	5	100	19	18	8401	11252
519+00	6	5	100	19	19	8420	11271
520+00	5	5	100	17	21	8436	11292
521+00	4	6	100	16	24	8452	11315
522+00	4	7	100	16	25	8468	11340
523+00	4	7	100	17	25	8485	11365
524+00	5	6	100	16	24	8500	11389
525+00	4	6	100	13	25	8513	11414
526+00	3	7	100	14	26	8527	11440

SUMMARY OF EARTHWORK QUANTITIES							
STATION	END AREA		DISTANCE BETWEEN X-S	VOLUME		CUMULATIVE VOLUME	
	EXCAVATION	EMBANKMENT		110	132	EXCAVATION	EMBANKMENT
				6001	6004		
SF	SF	FT	EXCAVATION (ROADWAY) CY	EMBANKMENT (FINAL) (DENS CONT) (TY B) CY	CY	CY	
US 60 CSJ:0169-07-053							
527+00	4	7	100	17	24	8544	11463
528+00	5	6	100	20	21	8564	11484
529+00	6	5	100	21	18	8585	11503
530+00	6	5	100	19	20	8603	11522
531+00	5	6	100	16	22	8620	11545
532+00	4	6	100	16	21	8636	11565
533+00	5	5	100	17	19	8652	11584
534+00	4	5	100	16	20	8668	11604
535+00	4	6	100	38	26	8706	11630
536+00	16	9	100	61	33	8768	11663
537+00	17	9	100	64	34	8832	11697
538+00	18	9	100	68	35	8900	11732
539+00	19	9	100	71	37	8972	11769
540+00	19	11	100	73	40	9044	11809
541+00	20	11	100	74	41	9118	11850
542+00	20	12	100	73	44	9191	11894
543+00	20	12	100	73	44	9265	11938
544+00	20	12	100	75	40	9339	11978
545+00	20	10	100	75	36	9414	12014
546+00	20	10	100	78	38	9492	12052
547+00	22	11	100	80	40	9572	12093
548+00	21	11	100	79	42	9651	12135
549+00	21	12	100	83	42	9734	12177
550+00	24	11	100	90	38	9824	12215
551+00	25	10	100	91	36	9915	12250
552+00	24	9	100	90	35	10005	12285
553+00	24	9	100	86	35	10091	12320
554+00	22	10	100	84	34	10175	12354
555+00	23	9	100	81	37	10256	12391
556+00	20	11	100	79	38	10334	12429
557+00	22	9	100	72	38	10407	12467
558+00	17	11	100	66	42	10473	12508
559+00	19	12	100	72	35	10545	12543
560+00	20	7	100	72	32	10617	12575
561+00	19	10	100	69	33	10686	12608
562+00	18	7	100	66	29	10751	12637
563+00	18	8	100	64	28	10816	12664
564+00	17	7	100	46	19	10861	12683
565+00	7	3	100	26	13	10887	12696
566+00	6	3	100	19	18	10906	12714
567+00	4	6	100	12	28	10918	12742
568+00	2	9	100	9	37	10927	12778
569+00	3	11	100	10	39	10937	12817
570+00	3	10	100	14	37	10951	12855
571+00	4	10	100	25	23	10975	12878
572+00	9	3	100	39	7	11015	12884
573+00	12	1	100	34	21	11048	12905
574+00	6	10	100	21	37	11069	12942
575+00	5	10	100	23	21	11092	12962
576+00	7	1	100	28	12	11120	12974
577+00	8	5	100	27	19	11147	12993
578+00	7	5	100	25	22	11172	13014
579+00	6	6	100	21	24	11192	13038
580+00	5	7	100	20	22	11212	13060
581+00	6	5	100	22	18	11234	13078
582+00	6	5	100	23	18	11257	13095
583+00	6	5	100	24	16	11281	13111
584+00	7	4	100	24	15	11305	13126
585+00	6	4	100	24	14	11329	13140
586+00	7	4	100	24	14	11353	13154
587+00	6	4	100	24	15	11377	13169
588+00	6	4	100	24	14	11401	13183
589+00	7	4	100	24	13	11425	13196
590+00	6	3	100	25	13	11449	13209
591+00	7	4	100	26	13	11475	13222

CSJ: 0169-07-053 SHEET TOTAL	
110-6001	132-6004
EXCAVATION	EMBANKMENT
CY	CY
4306	3865

05/17/2021



Bo L. Ratto

REV. NO.	DATE	DESCRIPTION	BY

CobbFendley 13430 Northwest Freeway, Ste. 1100
Houston, Texas 77040
713.462.3242
www.cobbendley.com

 **Texas Department of Transportation**

US 60 EARTHWORK SUMMARY

SHEET 2 OF 3

FED. RD. DIV. NO.	STATE	PROJECT NO.	HIGHWAY NO.
6	TEXAS	(SEE TITLE SHEET)	US60
STATE DISTRICT	COUNTY	CONTROL NO.	SECTION NO.
AMA	GRAY	0169	07
		JOB NO.	SHEET NO.
		053, ETC	24

5/17/2021 9:36:09 AM F:\P\j\1625\2019\1004_Tx\DOT_3x3_PSS\03_US60_Amrt\1625\1004-UST\1625\04-Gen\02-Sheets\US60_GEN-SUM-EM.dgn

SUMMARY OF EARTHWORK QUANTITIES							
STATION	END AREA		DISTANCE BETWEEN X-S	VOLUME		CUMULATIVE VOLUME	
	EXCAVATION	EMBANKMENT		110	132	EXCAVATION	EMBANKMENT
				6001	6004		
SF	SF	FT	EXCAVATION (ROADWAY) CY	EMBANKMENT (FINAL) (DENS CONT) (TY B) CY	CY	CY	
SH 152 CSJ: 0169-07-053							
10+00	0	0	100	58	2	58	2
11+00	32	1	100	112	38	171	40
12+00	29	19	100	65	167	236	207
13+00	6	71	100	18	322	253	529
14+00	3	103	100	10	267	263	796
15+00	2	41	100	46	86	309	882
16+00	23	5	100	134	11	443	892
17+00	50	0	100	184	2	626	894
18+00	50	1	200	250	21	877	915
20+00	18	5	100	213	9	1090	924
20+58	97	0	0	0	0	1090	924

CSJ: 0169-07-053 PROJECT TOTAL	
110-6001	132-6004
EXCAVATION	EMBANKMENT
CY	CY
1090	924

4/7/2021 7:26:20 AM F:\Proj\2019\1004_Tx\DOT_5x5_P5&E\03_US60_Amar\11616\NG500-UST\N504-Gen\02-Sheets\US60_GEN_SUM_EW.dgn

04/07/2021



Bo L Ratto

REV. NO.	DATE	DESCRIPTION	BY



13430 Northwest Freeway, Ste. 1100
Houston, Texas 77040
713.462.3242
www.cobbhendley.com



Texas Department of Transportation

SH 152
EARTHWORK SUMMARY

SHEET 1 OF 1

FED. RD. DIV. NO.	STATE	PROJECT NO.	HIGHWAY NO.
6	TEXAS	(SEE TITLE SHEET)	US60
STATE DISTRICT	COUNTY	CONTROL NO.	SECTION NO.
AMA	GRAY	0169	07
			JOB NO.
			053, ETC
			SHEET NO.
			26

US60_GEN_SUM_EW.dgn

SUMMARY OF EROSION CONTROL ITEMS								
LOCATION		134	164	164	169	314	506	506
		6011	6053	6036	6003	6014	6040	6043
		BACKFILLING PAVEMENT EDGES	DRILL SEEDING (TEMP) (W ARM OR COOL)	DRILL SEEDING (PERM) (RURAL) (CLAY)	SOIL RETENTION BLANKETS (CL 1) (TY C)	EMULS ASPH (EROSN CONT) (MS -2)	BIODEG EROSN CONT LOGS (INSTL) (8")	BIODEG EROSN CONT LOGS (REMOVE)
From	To	CY	AC	AC	SY	GAL	LF	LF
49+00	119+54	19	6.48	6.48		3919	420	420
CSJ 0169-07-054 TOTAL		19	6.48	6.48		3919	420	420
119+54	215+50	30		3.50				
262+00	275+00	56		2.73				
275+00	362+68		2.08		346	4871	900	900
362+68	381+00	15	0.42	0.42		509		
381+00	385+00	2	0.09	0.08		111	60	60
385+00	485+00	97		4.59				
485+00	489+50	4	0.10	0.10		125		
489+50	535+00	26	1.15			1394	200	200
535+00	564+20		1.34			1622		
564+20	609+70	18	1.04	1.04		1264	460	460
609+70	614+20	2	0.18	0.18		213	20	20
615+00	685+00	283		3.21			0	0
685+00	689+50	2	0.10	0.10		125		
689+50	749+00	24	1.43	1.43	131	1653	240	240
749+00	758+00	2	0.32	0.32	49	250	80	80
760+00	806+59	239	2.14	2.14				
CSJ 0169-07-053 TOTAL		800	10.41	19.86	526	12137	1960	1960
PROJECT TOTALS		819	16.88	26.33	526	16056	2380	2380

05/17/2021



Bo L. Ratto

REV. NO.	DATE	DESCRIPTION	BY

CobbFendley 13430 Northwest Freeway, Ste. 1100
Houston, Texas 77040
713.462.3242
www.cobbhendley.com



**SW3P
QUANTITY SUMMARY**

SHEET 1 OF 1

FED. RD. DIV. NO.	STATE	PROJECT NO.	HIGHWAY NO.
6	TEXAS	(SEE TITLE SHEET)	US60
STATE DISTRICT	COUNTY	CONTROL NO.	SECTION NO.
AMA	GRAY	0169	07
		JOB NO.	SHEET NO.
		053, ETC	27

5/17/2021 9:36:10 AM F:\P\j\c\2019\1004_T\DOT_5x5_P&E\03_US60_Amar\161616\500-UST\N\04-Gen\02-Sheets\US60_GEN-SW3P.dgn

US60_GEN-SUM-SW3P.dgn

GENERAL NOTES

1. THE CONTRACTOR MAY USE A DIFFERENT CONSTRUCTION PHASING AND TRAFFIC CONTROL PLAN. ANY VARIATION FROM THE PLANS SHALL BE FORMALLY SUBMITTED TO THE ENGINEER FOR REVIEW AND APPROVAL. ANY CHANGES PROPOSED TO THE CONTRACTOR WILL BE SIGNED AND SEALED BY A PROFESSIONAL ENGINEER.
2. THE CONTRACTOR WILL NOT BEGIN ANY WORK ASSOCIATED WITH A CHANGE IN THE PLANS WITHOUT THE ENGINEER'S APPROVAL IN WRITING.
3. THE CONTRACTOR SHALL MAINTAIN ACCESS TO DRIVEWAYS AND LOCAL STREETS AT ALL TIMES. THE CONTRACTOR SHALL OBTAIN PERMISSION FROM THE RESPECTIVE PROPERTY OWNERS 24 HOURS PRIOR TO THE CONTRACTOR CONSTRUCTING PROPOSED DRIVEWAYS.
4. UNLESS OTHERWISE NOTED, CONSTRUCTION OF TEMPORARY DRIVEWAYS, ROAD, AND STREET CROSSINGS WILL BE SUBSIDIARY TO THE VARIOUS BID ITEMS.
5. USE ONLY TEMPORARY REMOVABLE PAVEMENT MARKINGS ON FINAL PAVEMENT SURFACES.
6. REFER TO STANDARD WZ(UL) FOR SIGNING OF EDGE CONDITIONS/UNEVEN LANES.
7. REFER TO STANDARD BC (10) CULVERT WIDENING DETAILS FOR CULVERT EXTENSIONS

CONSTRUCTION SEQUENCE AND TCP

PHASE 1

OBJECTIVE: EXTEND CULVERTS IN AREAS OF WIDENING.

1. INSTALL TRAFFIC CONTROL DEVICES INCLUDING ADVANCED WARNING SIGNS.
2. PLACE SW3P DEVICES NEEDED FOR THIS PHASE.
3. EXTEND CULVERTS AND INSTALL PROPOSED SET'S

PHASE 2

OBJECTIVE: CONSTRUCT SUPER 2 LANES, SH 152, AND SHOULDER (3-LANE) WIDENING.

IT WILL BE NECESSARY TO BACKFILL PAVEMENT EDGES WITH 3:1 OR FLATTER SLOPES AT THE END OF EACH WORKING DAY OR ONCE WORK HAS CEASED WITHIN THE AREA.

THE CONTRACTOR WILL ONLY BE ALLOWED TO PERFORM WORK ON ONE SIDE OF THE ROADWAY AT A TIME, THROUGH COMPLETION, BEFORE STARTING ON THE OPPOSITE SIDE.

1. PLACE SW3P DEVICE NEEDED FOR THIS PHASE.
2. REMOVE CONFLICTING SIGNING AND MARKINGS. PLACE WORK ZONE SIGNING AND CHANNELIZATION DEVICES PER TXDOT BC AND TCP STANDARDS, THE LATEST EDITION OF THE TEXAS MUTCD, AND AS DIRECTED BY THE ENGINEER.
3. USE EXISTING EDGELINE TO MATCH EXISTING CROSS SLOPE AND WIDEN PAVEMENT. REFER TO TRAFFIC CONTROL PLAN TYPICAL SECTIONS FOR WIDENING THE PAVEMENT IN AREAS THAT HAVE EXISTING METAL BEAM GUARD FENCE.
4. REMOVE CHANNELIZATION DEVICES TO OPEN THE SUPER 2 12' PASSING LANE, 4' AND 10' SHOULDER AFTER PAVEMENT WIDENING IS COMPLETED. PLACE WORKZONE STRIPING ON US 60 EASTBOUND & WESTBOUND AS SHOWN ON THE PHASE 2 TCP TYPICAL SECTIONS.
5. EXISTING SH 152 CONFIGURATION TO REMAIN IN PLACE UNTIL NEW LANE IS BUILT SO TRAFFIC PATTERNS ARE NOT INTERRUPTED.

PHASE 3

OBJECTIVE: PLACE 2" OVERLAY AT SUPER 2 WIDENING LOCATION, 1.5"/4" MILL & FILL AT CURB & GUTTER SECTION AND INSTAL MBGF AT STEEP SLOPE LOCATIONS. SEE PROPOSED TYPICAL SECTIONS A AND B FOR MILL & FILL INFORMATION, AND PROPOSED TYPICAL SECTION J FOR MBGF LOCATIONS.

1. PLACE SW3P DEVICE NEEDED FOR THIS PHASE.
2. REMOVE CONFLICTING SIGNING AND MARKINGS. PLACE WORK ZONE SIGNING AND CHANNELIZATION DEVICES PER TXDOT BC AND TCP STANDARDS, THE LATEST EDITION OF THE TEXAS MUTCD, AND AS DIRECTED BY THE ENGINEER.
3. PLACE SUPERPAVE MIXTURES (FULL WIDTH) IN ACCORDANCE WITH TCP (7-1) AND USE EXISTING EDGE LINE TO MATCH CROSS SLOPE FOR PAVEMENT WIDENING.
4. AFTER FINAL SURFACE IS PLACED, PERFORM FINAL GRADING AND PERMANENT SEEDING.
5. INSTALL PERMANENT SIGNING AND PAVEMENT MARKINGS ACCORDING TO LATEST EDITION OF TEXAS MUTCD, SINGING AND PAVEMENT MARKING STANDARDS, SINGING AND PAVEMENT MARKING LAYOUTS, OR AS DIRECTED BY THE ENGINEER. UTILIZE TCP (3-1) AND TCP (3-3).
6. PERFORM FINAL PROJECT CLEANUP AND REMOVE ALL PROJECT BARRICADES, TEMPORARY SIGNS, AND SW3P ONCE AUTHORIZED OR DIRECTED BY THE AREA ENGINEER.

4/7/2021 7:56:22 AM F:\Proj\62019\1004_TxDOT_5x5_P5&E\03_US60_Amarr\1616\ENG\500-UST\N\SI\1-TCPO2-Sheet\US60_TCP-NARRATIVE.dgn

04/07/2021



Bo L Ratto

REV. NO.	DATE	DESCRIPTION	BY



13430 Northwest Freeway, Ste. 1100
Houston, Texas 77040
713.462.3242
www.cobbhendley.com

TBPE Firm Registration No. 274
TBPLS Firm Registration No. 100467



**TCP
NARRATIVE**



SHEET 1 OF 1

FED. RD. DIV. NO.	STATE	PROJECT NO.	HIGHWAY NO.
6	TEXAS	(SEE TITLE SHEET)	US60
STATE DISTRICT	COUNTY	CONTROL NO.	SECTION NO.
AMA	GRAY	0169	07
			JOB NO.
			053, ETC
			SHEET NO.
			28

US60_TCP-NARRATIVE.dgn


LEGEND

- ← EXIST TRAFFIC FLOW
- PROP TRAFFIC FLOW
- ▨ WORK ZONE THIS PHASE
- 🚧 CONSTRUCTION CONE
- A WK ZN PAV MRK NON REMOV (W) 4" (BRK)
- B WK ZN PAV MRK NON REMOV (W) 4" (SLD)

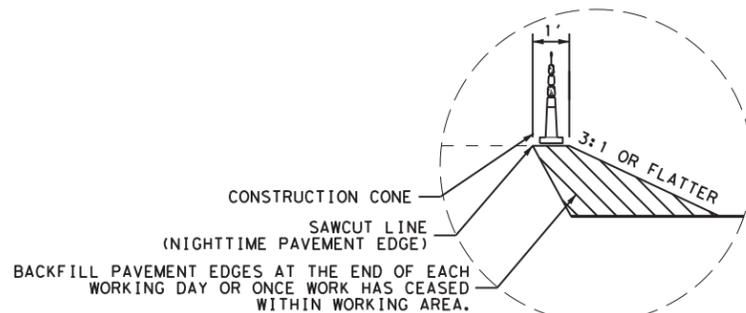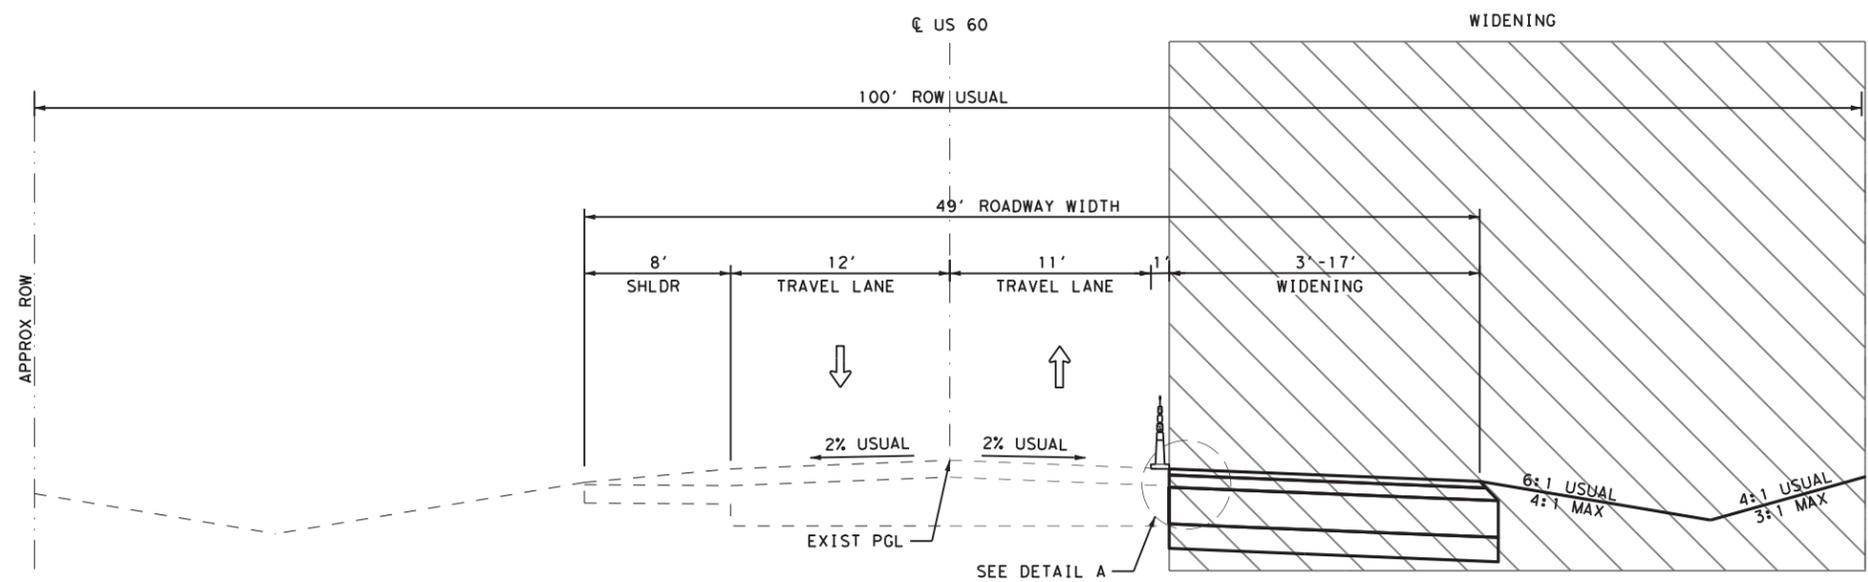

NOTE:

1. NIGHTTIME EDGE CONDITION WORK IS SUBSIDIARY TO ITEM 502.

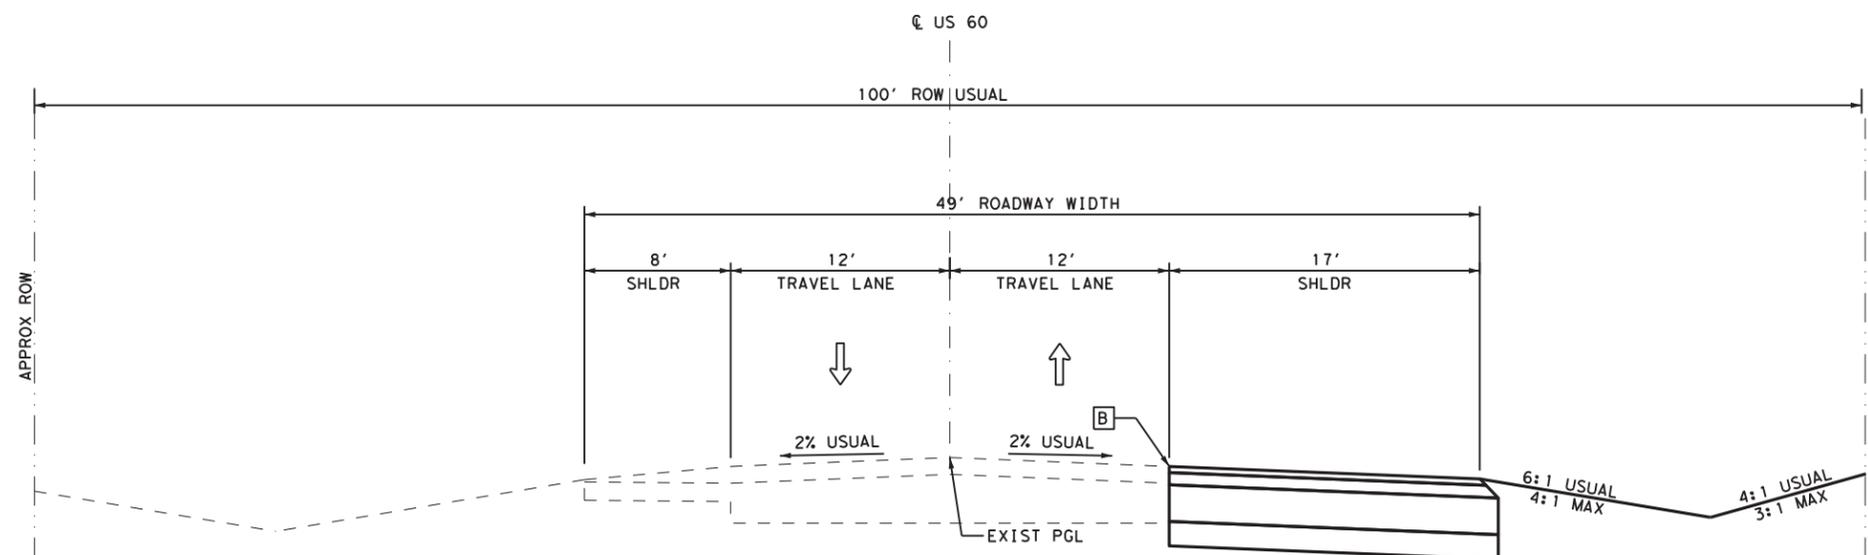

PHASE 2
3 LANE WIDENING EASTBOUND
STA 87+75.00 TO STA 119+54.00

04/07/2021

Bo L. Ratto

REV. NO.	DATE	DESCRIPTION	BY

CobbFendley 13430 Northwest Freeway, Ste. 1100
Houston, Texas 77040
713.462.3242
www.cobbhendley.com





TCP
TYPICAL SECTIONS
PHASE 2

SHEET 1 OF 6


FED. RD. DIV. NO.	STATE	PROJECT NO.	HIGHWAY NO.		
6	TEXAS	(SEE TITLE SHEET)	US60		
STATE DISTRICT	COUNTY	CONTROL NO.	SECTION NO.	JOB NO.	SHEET NO.
AMA	GRAY	0169	07	053, ETC	29

LEGEND

- EXIST TRAFFIC FLOW
- PROP TRAFFIC FLOW
- WORK ZONE THIS PHASE
- CONSTRUCTION CONE
- WK ZN PAV MRK NON REMOV (W) 4" (BRK)
- WK ZN PAV MRK NON REMOV (W) 4" (SLD)

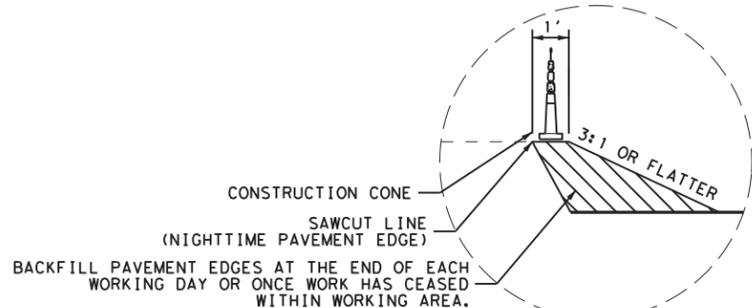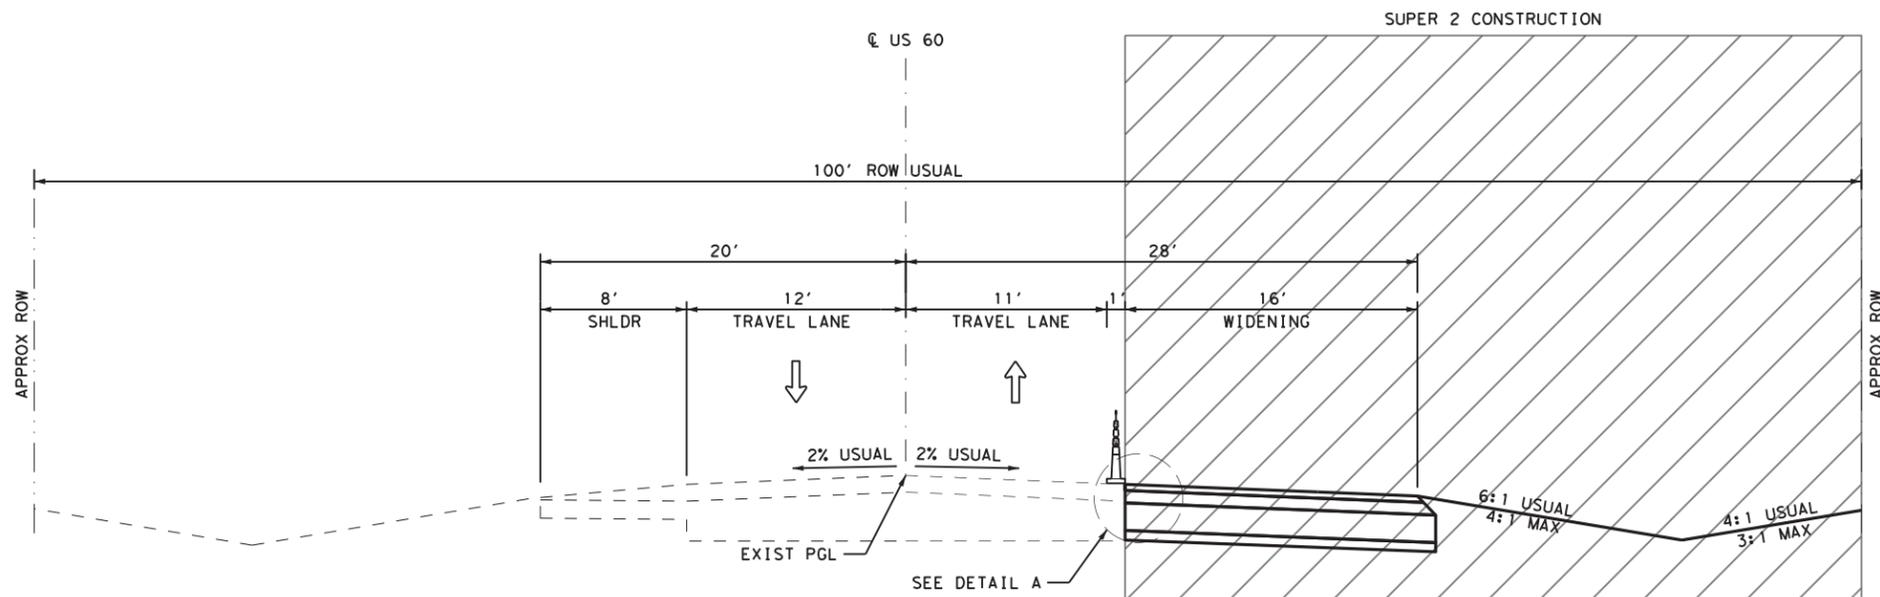

DETAIL A NIGHTTIME EC

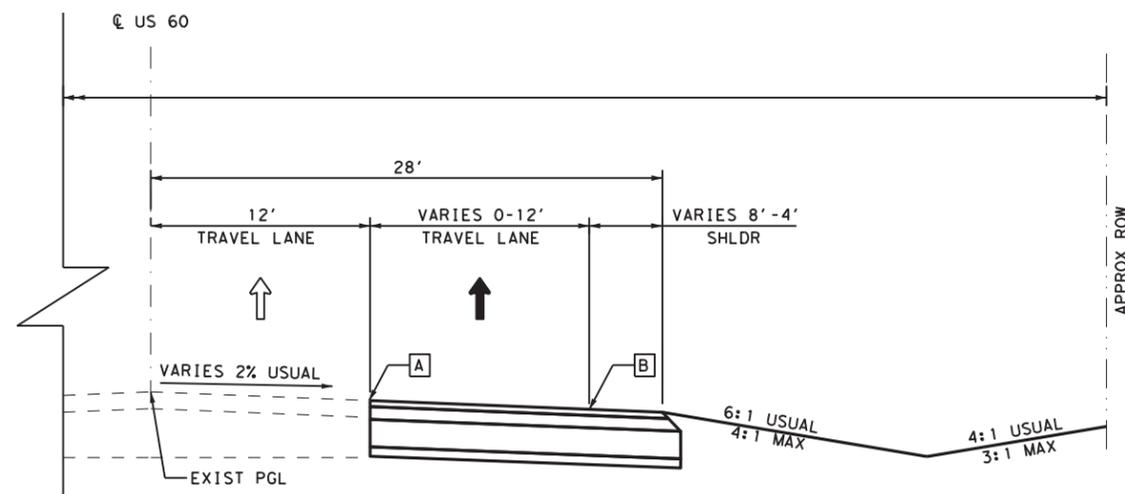

PHASE 2

US 60 EASTBOUND SUPER 2

STA 275+00.00 TO STA 362+43.48
 STA 485+00.00 TO STA 564+20.00
 STA 685+00.00 TO STA 758+00.00

- NOTE:
- NIGHTTIME EDGE CONDITION WORK IS SUBSIDIARY TO ITEM 502.

04/07/2021

Bo L. Ratto

REV. NO.	DATE	DESCRIPTION	BY

CobbFendley 13430 Northwest Freeway, Ste. 1100
 Houston, Texas 77040
 TBPE Firm Registration No. 274 713.462.3242
 TBPLS Firm Registration No. 100467 www.cobbhendley.com


Texas Department of Transportation

TCP
 TYPICAL SECTIONS
 PHASE 2


FED. RD. DIV. NO.	STATE	PROJECT NO.	HIGHWAY NO.
6	TEXAS	(SEE TITLE SHEET)	US60
STATE DISTRICT	COUNTY	CONTROL NO.	SECTION NO.
AMA	GRAY	0169	07
			JOB NO.
			053, ETC
			SHEET NO.
			30

4/7/2021 7:56:23 AM F:\Proj\6212019\1004_TxDOT_5x5_P5&E\03_US60_Amarillo\ENGIN\6000\UST\N\SHL\TCP\02-Sheets\US60_TCP-PH2-TYP-02.dgn

US60_TCP-PH2-TYP-02.dgn

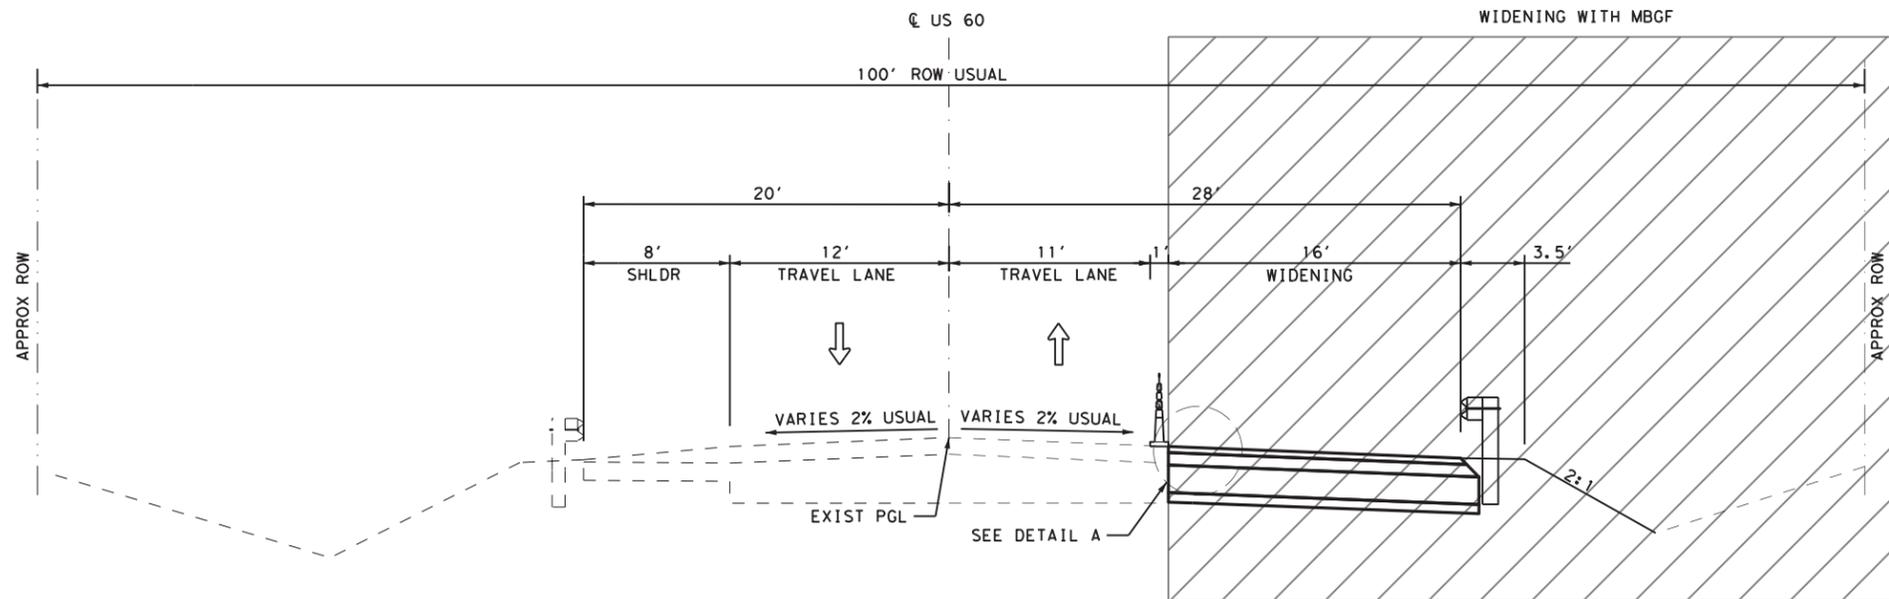


- LEGEND**
- EXIST TRAFFIC FLOW
 - PROP TRAFFIC FLOW
 - WORK ZONE THIS PHASE
 - CONSTRUCTION CONE
 - WK ZN PAV MRK NON REMOV (W) 4" (BRK)
 - WK ZN PAV MRK NON REMOV (W) 4" (SLD)

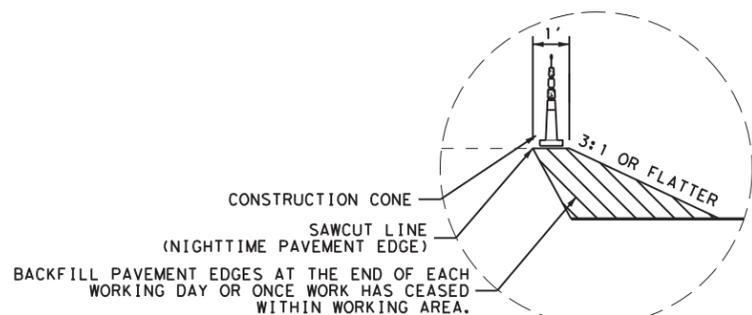

DETAIL A NIGHTTIME EC

NOTE:

1. NIGHTTIME EDGE CONDITION WORK IS SUBSIDIARY TO ITEM 502.

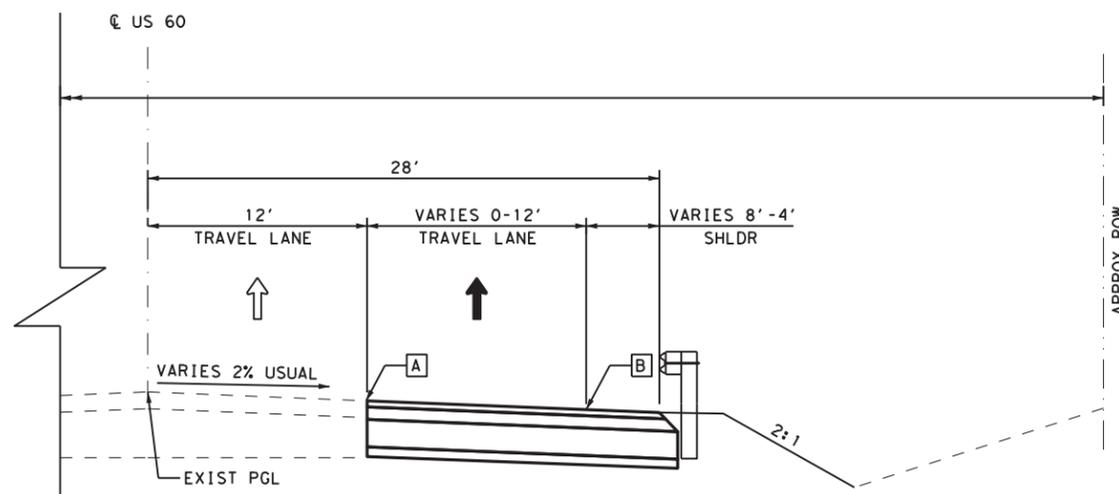

PHASE 2
PAVEMENT WIDENING WITH MBGF
EASTBOUND

STA 285+50.00 TO STA 291+25.00
 STA 747+40.00 TO STA 751+65.00
 STA 757+00.00 TO STA 758+00.00

04/07/2021

Bo L. Ratto

0 2.5 5 10 (H)
0 2.5 5 (V)

REV. NO.	DATE	DESCRIPTION	BY

CobbFendley 13430 Northwest Freeway, Ste. 1100
 Houston, Texas 77040
 TBPE Firm Registration No. 274 713.462.3242
 TBPLS Firm Registration No. 100467 www.cobbhendley.com

Texas Department of Transportation



TCP
TYPICAL SECTIONS
PHASE 2

SHEET **3** OF **6**


FED. RD. DIV. NO.	STATE	PROJECT NO.	HIGHWAY NO.		
6	TEXAS	(SEE TITLE SHEET)	US60		
STATE DISTRICT	COUNTY	CONTROL NO.	SECTION NO.	JOB NO.	SHEET NO.
AMA	GRAY	0169	07	053, ETC	31

LEGEND

- EXIST TRAFFIC FLOW
- PROP TRAFFIC FLOW
- WORK ZONE THIS PHASE
- CONSTRUCTION CONE
- WK ZN PAV MRK NON REMOV (W) 4" (BRK)
- WK ZN PAV MRK NON REMOV (W) 4" (SLD)

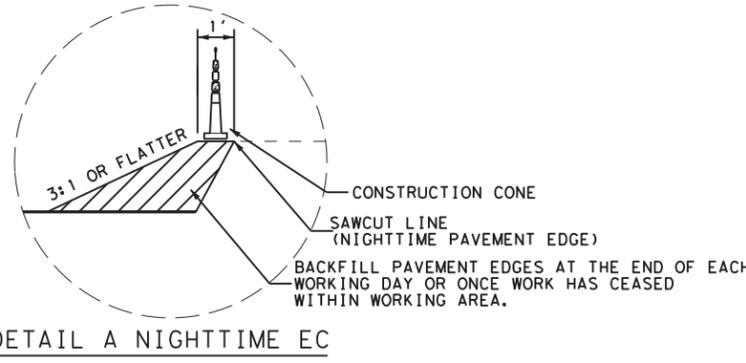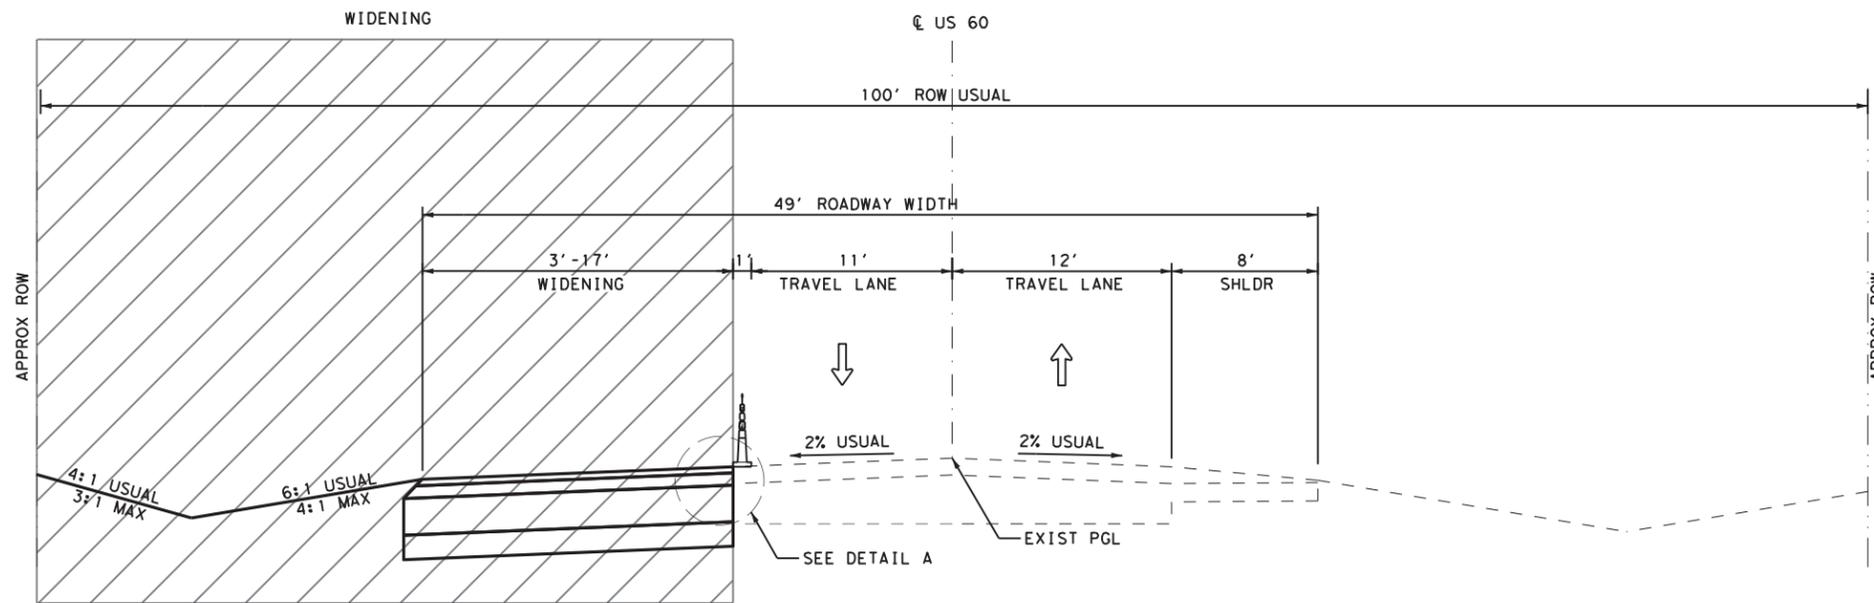

NOTE:
1. NIGHTTIME EDGE CONDITION WORK IS SUBSIDIARY TO ITEM 502.

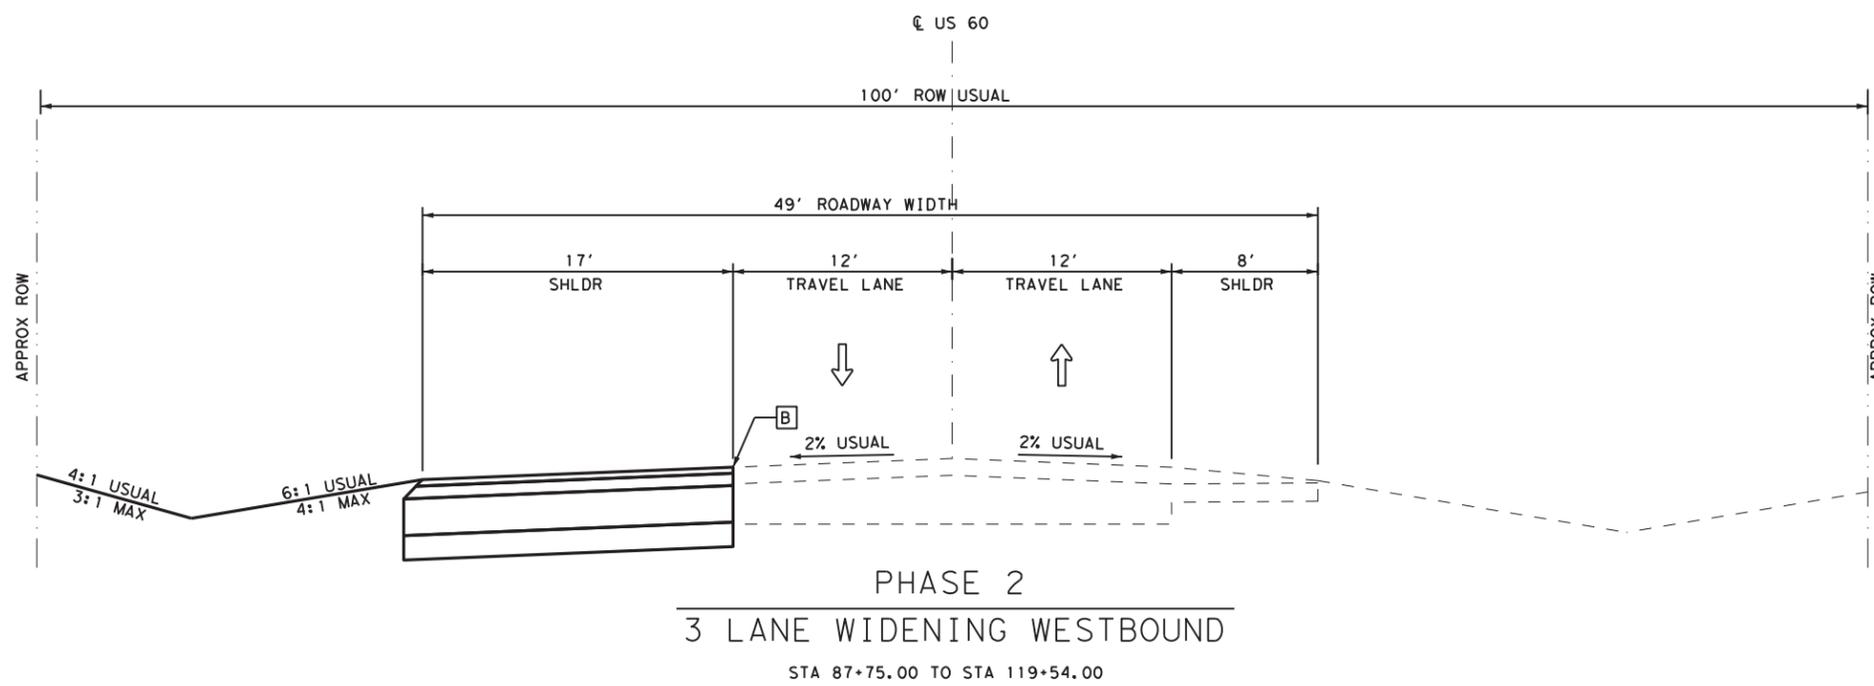

PHASE 2
3 LANE WIDENING WESTBOUND
STA 87+75.00 TO STA 119+54.00

04/07/2021

Bo L. Ratto

REV. NO.	DATE	DESCRIPTION	BY

CobbFendley 13430 Northwest Freeway, Ste. 1100
Houston, Texas 77040
713.462.3242
www.cobbhendley.com

Texas Department of Transportation


TCP
TYPICAL SECTIONS
PHASE 2
SHEET 4 OF 6

FED. RD. DIV. NO.	STATE	PROJECT NO.	HIGHWAY NO.
6	TEXAS	(SEE TITLE SHEET)	US60
STATE DISTRICT	COUNTY	CONTROL NO.	SECTION NO.
AMA	GRAY	0169	07
		JOB NO.	SHEET NO.
		053, ETC	32

4/7/2021 7:26:24 AM F:\Proj\6212019\1004_Tx\DOT_5x5_PSS\03_US60_Amarr\11616\ENG\500\UST\N\SHL\TCP\02-Sheets\US60_TCP-PH2-TYP-04.dgn


DATE: 4/7/2021 7:26:26 AM
 FILE: F:\Projects\2019\11004.TxDOT_5x5_P&E\03_US60_Amarillo\ENG\500-USTN\511\11004\BC(2)-14.dgn
 The use of this standard is governed by the "Texas Engineering Practice Act". No warranty of any kind is made by TxDOT for any purpose whatsoever. TxDOT assumes no responsibility for incorrect results or damages resulting from its use.

TYPICAL LOCATION OF CROSSROAD SIGNS

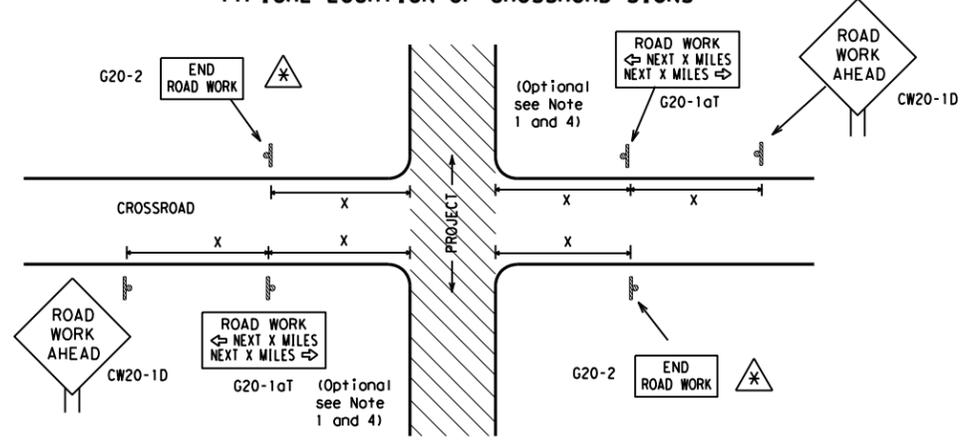

- ⚠ May be mounted on back of "ROAD WORK AHEAD" (CW20-1D) sign with approval of Engineer. (See note 2 below)
- The typical minimum signing on a crossroad approach should be a "ROAD WORK AHEAD" (CW20-1D) sign and a (G20-2) "END ROAD WORK" sign, unless noted otherwise in plans.
 - The Engineer may use the reduced size 36" x 36" ROAD WORK AHEAD (CW20-1D) sign mounted back to back with the reduced size 36" x 18" "END ROAD WORK" (G20-2) sign on low volume crossroads (see Note 4 under "Typical Construction Warning Sign Size and Spacing"). See the "Standard Highway Sign Designs for Texas" manual for sign details. The Engineer may omit the advance warning signs on low volume crossroads. The Engineer will determine whether a road is low volume. This information shall be shown in the plans.
 - Based on existing field conditions, the Engineer/Inspector may require additional signs such as FLAGGER AHEAD, LOOSE GRAVEL, or other appropriate signs. When additional signs are required, these signs will be considered part of the minimum requirements. The Engineer/Inspector will determine the proper location and spacing of any sign not shown on the BC sheets, Traffic Control Plan sheets or the Work Zone Standard Sheets.
 - The "ROAD WORK NEXT X MILES" (G20-1aT) sign shall be required at high volume crossroads to advise motorists of the length of construction in either direction from the intersection. The Engineer will determine whether a roadway is considered high volume.
 - Additional traffic control devices may be shown elsewhere in the plans for higher volume crossroads.
 - When work occurs in the intersection area, appropriate traffic control devices, as shown elsewhere in the plans or as determined by the Engineer/Inspector, shall be in place.

T-INTERSECTION

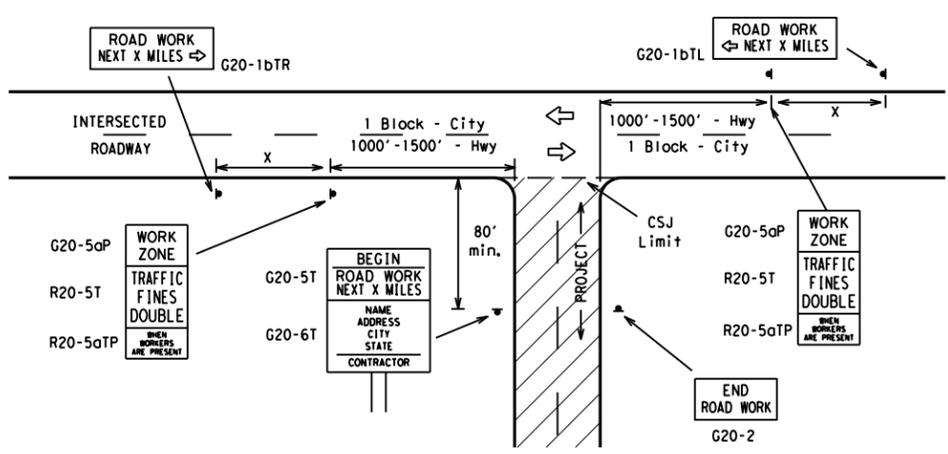

CSJ LIMITS AT T-INTERSECTION

- The Engineer will determine the types and location of any additional traffic control devices, such as a flagger and accompanying signs, or other signs, that should be used when work is being performed at or near an intersection.
- If construction closes the road at a T-intersection the Contractor shall place the "CONTRACTOR NAME" (G20-6T) sign behind the Type 3 Barricades for the road closure (see BC(10) also). The "ROAD WORK NEXT X MILES" left arrow (G20-1bTL) and "ROAD WORK NEXT X MILES" right arrow (G20-1bTR) signs shall be replaced by the detour signing called for in the plans.

TYPICAL CONSTRUCTION WARNING SIGN SIZE AND SPACING^{1,5,6}

Sign Number or Series	SIZE		SPACING	
	Conventional Road	Expressway/Freeway	Posted Speed MPH	Sign Spacing "X" Feet (Approx.)
CW20 ⁴	48" x 48"	48" x 48"	30	120
CW21			35	160
CW22			40	240
CW23			45	320
CW25			50	400
CW1, CW2, CW7, CW8, CW9, CW11, CW14	36" x 36"	48" x 48"	55	500 ²
CW3, CW4, CW5, CW6, CW8-3, CW10, CW12	48" x 48"	48" x 48"	60	600 ²
			65	700 ²
			70	800 ²
			75	900 ²
			80	1000 ²
			*	* ³


* For typical sign spacings on divided highways, expressways and freeways, see Part 6 of the "Texas Manual on Uniform Traffic Control Devices" (TMUTCD) typical application diagrams or TCP Standard Sheets.

Δ Minimum distance from work area to first Advance Warning sign nearest the work area and/or distance between each additional sign.

GENERAL NOTES


- Special or larger size signs may be used as necessary.
- Distance between signs should be increased as required to have 1500 feet advance warning.
- Distance between signs should be increased as required to have 1/2 mile or more advance warning.
- 36" x 36" "ROAD WORK AHEAD" (CW20-1D) signs may be used on low volume crossroads at the discretion of the Engineer. See Note 2 under "Typical Location of Crossroad Signs".
- Only diamond shaped warning sign sizes are indicated.
- See sign size listing in "TMUTCD", Sign Appendix or the "Standard Highway Sign Designs for Texas" manual for complete list of available sign design sizes.

WORK AREAS IN MULTIPLE LOCATIONS WITHIN CSJ LIMITS

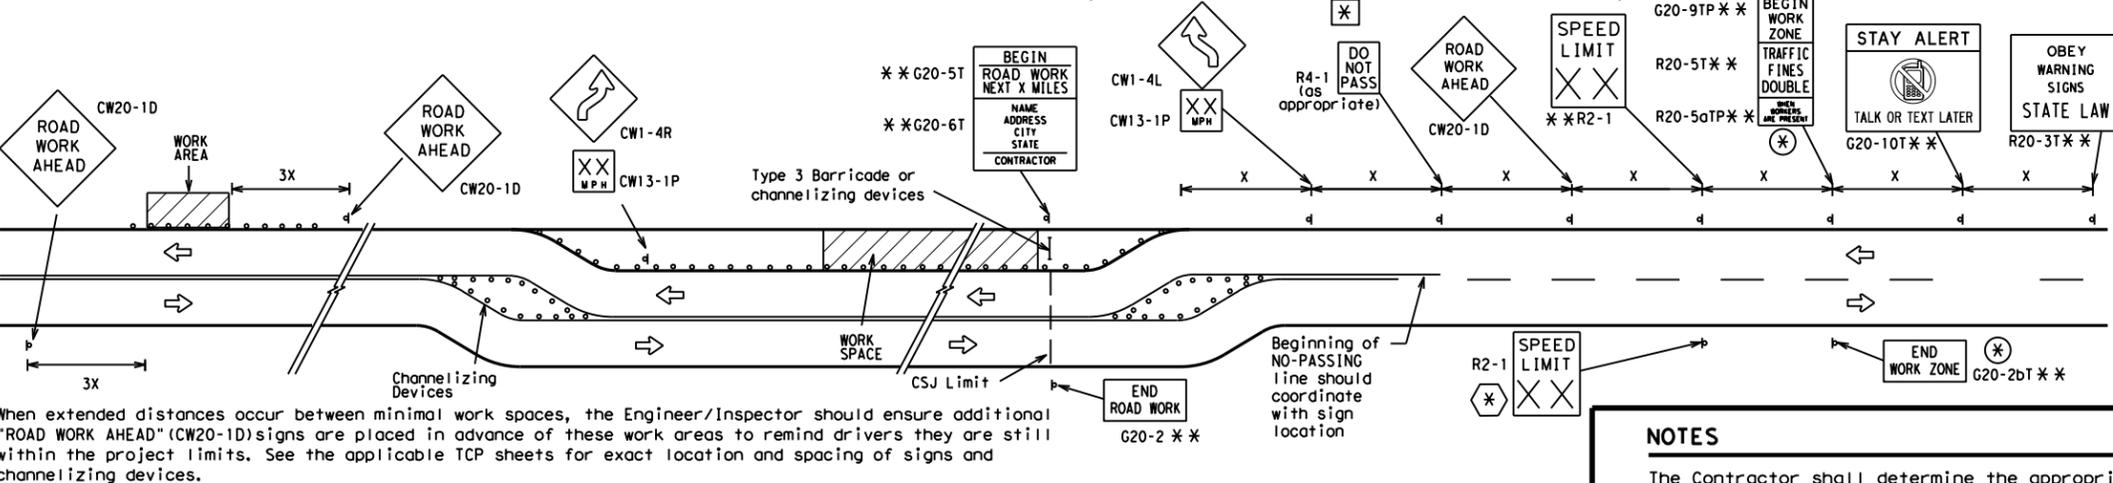


When extended distances occur between minimal work spaces, the Engineer/Inspector should ensure additional "ROAD WORK AHEAD" (CW20-1D) signs are placed in advance of these work areas to remind drivers they are still within the project limits. See the applicable TCP sheets for exact location and spacing of signs and channelizing devices.

SAMPLE LAYOUT OF SIGNING FOR WORK BEGINNING DOWNSTREAM OF THE CSJ LIMITS

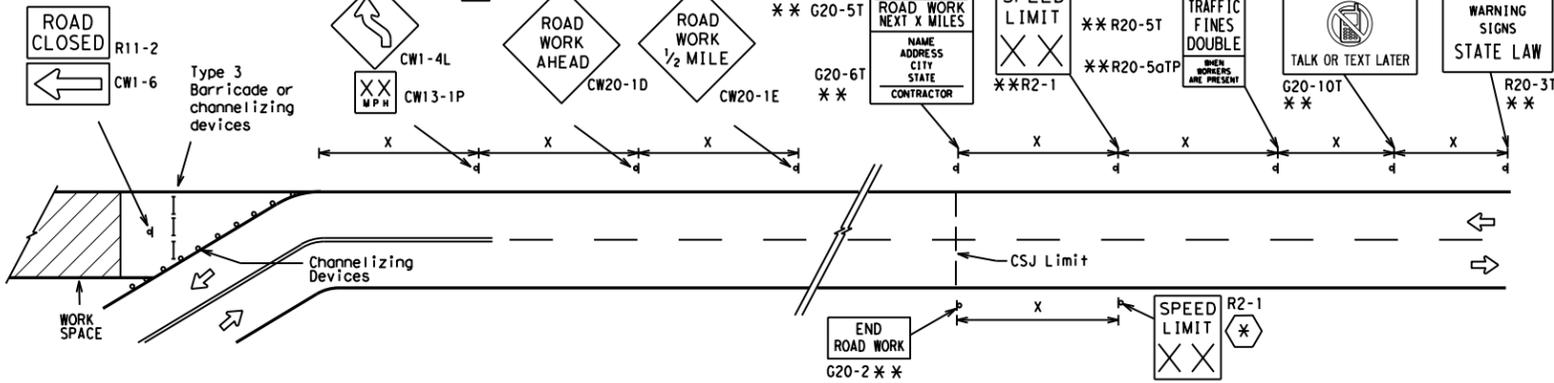

SAMPLE LAYOUT OF SIGNING FOR WORK BEGINNING AT THE CSJ LIMITS

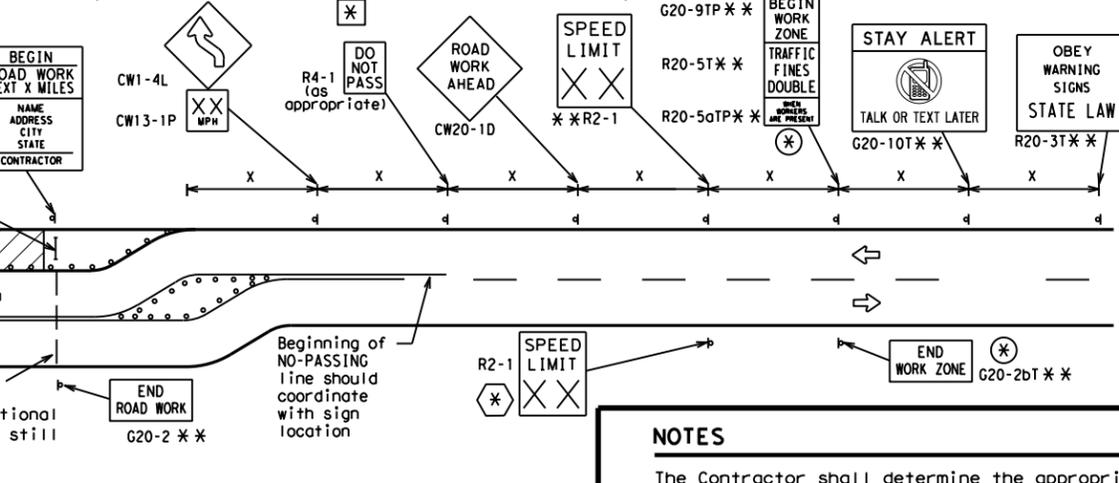

NOTES

- The Contractor shall determine the appropriate distance to be placed on the G20-1 series signs and "BEGIN ROAD WORK NEXT X MILES" (G20-5T) sign for each specific project. This distance shall replace the "X" and shall be rounded to the nearest whole mile with the approval of the Engineer. No decimals shall be used.
- ⊗ The "BEGIN WORK ZONE" (G20-9TP) and "END WORK ZONE" (G20-2bT) shall be used as shown on the sample layout when advance signs are required outside the CSJ Limits. They inform the motorist of entering or leaving a part of the work zone lying outside the CSJ Limits where traffic fines may double if workers are present.
- ** Required CSJ Limit signing. See Note 10 on BC(1). TRAFFIC FINES DOUBLE signs will not be required on projects consisting solely of mobile operations work.
- ⊗ Area for placement of "ROAD WORK AHEAD" (CW20-1D) sign and other signs or devices as called for on the Traffic Control Plan.
- ⊗ Contractor will install a regulatory speed limit sign at the end of the work zone.

LEGEND

—	Type 3 Barricade
○ ○ ○	Channelizing Devices
⊗	Sign
X	See Typical Construction Warning Sign Size and Spacing chart or the TMUTCD for sign spacing requirements.


SHEET 2 OF 12

BARRICADE AND CONSTRUCTION PROJECT LIMIT

BC(2)-14

FILE: bc-14.dgn	DN: TxDOT	CR: TxDOT	OW: TxDOT	CK: TxDOT
© TxDOT November 2002	CONT	SECT	JOB	HIGHWAY
REVISIONS	0169	07	053, ETC	US60
9-07 8-14	DIST	COUNTY	SHEET NO.	
7-13	AMA	GRAY		36


TYPICAL MINIMUM CLEARANCES FOR LONG TERM AND INTERMEDIATE TERM SIGNS

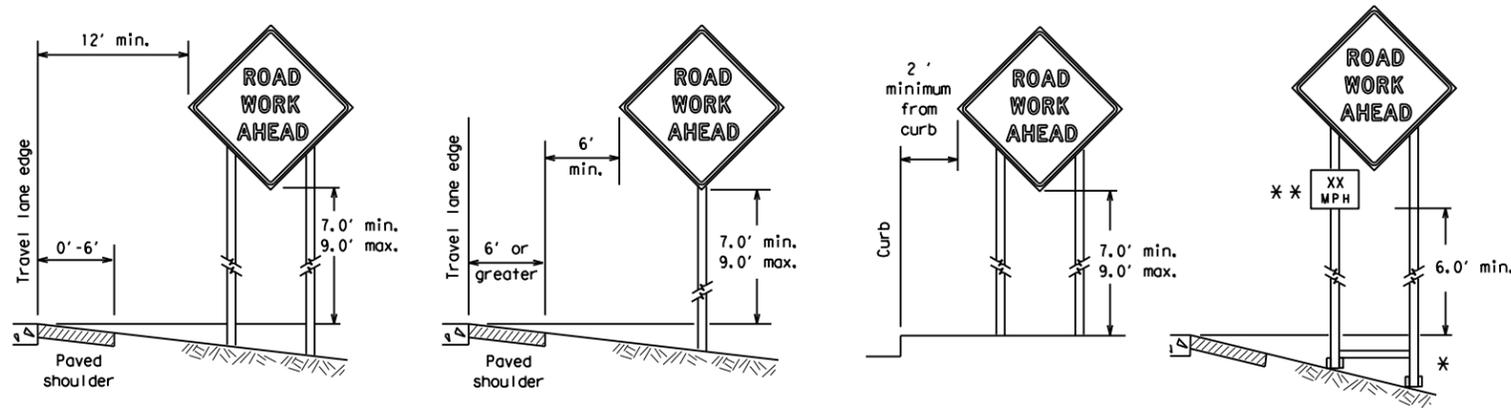

* When placing skid supports on unlevel ground, the leg post lengths must be adjusted so the sign appears straight and plumb. Objects shall NOT be placed under skids as a means of leveling.

** When plaques are placed on dual-leg supports, they should be attached to the upright nearest the travel lane. Supplemental plaques (advisory or distance) should not cover the surface of the parent sign.

ATTACHMENT FOR SIGN SUPPORTS

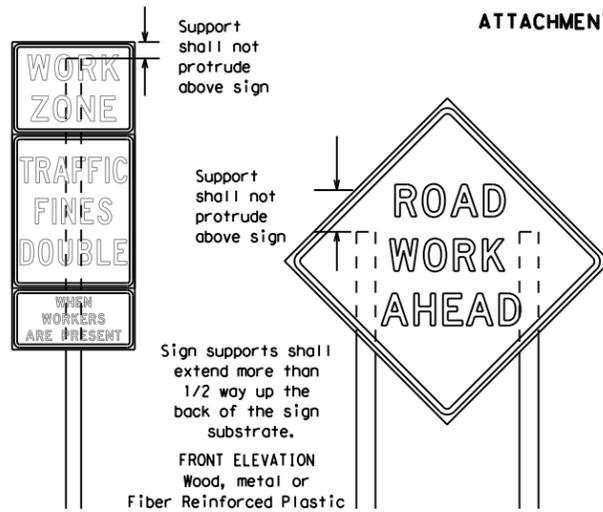

Support shall not protrude above sign


Support shall not protrude above sign

Sign supports shall extend more than 1/2 way up the back of the sign substrate.

FRONT ELEVATION
Wood, metal or
Fiber Reinforced Plastic

Splicing embedded perforated square metal tubing in order to extend post height will only be allowed when the splice is made using four bolts, two above and two below the splice point. Splice must be located entirely behind the sign substrate, not near the base of the support. Splice insert lengths should be at least 5 times nominal post size, centered on the splice and of at least the same gauge material.


Attachment to wooden supports will be by bolts and nuts or screws. Use TxDOT's or manufacturer's recommended procedures for attaching sign substrates to other types of sign supports

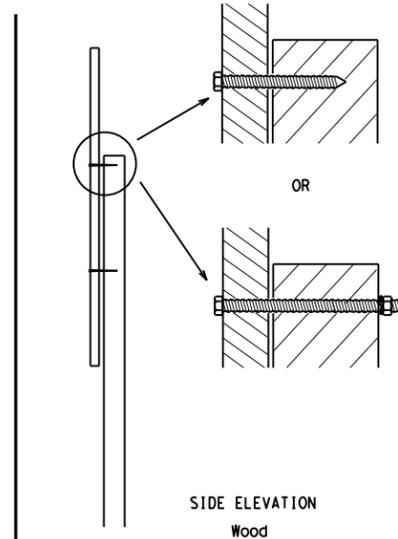

Nails shall NOT be allowed.
Each sign shall be attached directly to the sign support. Multiple signs shall not be joined or spliced by any means. Wood supports shall not be extended or repaired by splicing or other means.

STOP/SLOW PADDLES

- STOP/SLOW paddles are the primary method to control traffic by flaggers. The STOP/SLOW paddle size should be 24" x 24" as detailed below.
- When used at night, the STOP/SLOW paddle shall be retroreflectORIZED.
- STOP/SLOW paddles may be attached to a staff with a minimum length of 6' to the bottom of the sign.
- Any lights incorporated into the STOP or SLOW paddle faces shall only be as specifically described in Section 6E.03 Hand Signaling Devices in the TMUTCD.

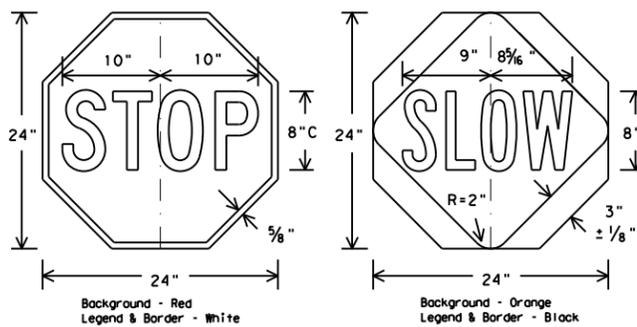

CONTRACTOR REQUIREMENTS FOR MAINTAINING PERMANENT SIGNS WITHIN THE PROJECT LIMITS

- Permanent signs are used to give notice of traffic laws or regulations, call attention to conditions that are potentially hazardous to traffic operations, show route designations, destinations, directions, distances, services, points of interest, and other geographical, recreational, or cultural information. Drivers proceeding through a work zone need the same, if not better route guidance as normally installed on a roadway without construction.
- When permanent regulatory or warning signs conflict with work zone conditions, remove or cover the permanent signs until the permanent sign message matches the roadway condition.
- When existing permanent signs are moved and relocated due to construction purposes, they shall be visible to motorists at all times.
- If existing signs are to be relocated on their original supports, they shall be installed on crashworthy bases as shown on the SMD Standard sheets. The signs shall meet the required mounting heights shown on the BC Sheets or the SMD Standards. This work should be paid for under the appropriate pay item for relocating existing signs.
- If permanent signs are to be removed and relocated using temporary supports, the Contractor shall use crashworthy supports as shown on the BC sheets or the CWZTCD. The signs shall meet the required mounting heights shown on the BC Sheets or the SMD Standards during construction. This work should be paid for under the appropriate pay item for relocating existing signs.
- Any sign or traffic control device that is struck or damaged by the Contractor or his/her construction equipment shall be replaced as soon as possible by the Contractor to ensure proper guidance for the motorists. This will be subsidiary to Item 502.

GENERAL NOTES FOR WORK ZONE SIGNS

- Contractor shall install and maintain signs in a straight and plumb condition and/or as directed by the Engineer.
 - Wooden sign posts shall be painted white.
 - Barricades shall NOT be used as sign supports.
 - All signs shall be installed in accordance with the plans or as directed by the Engineer. Signs shall be used to regulate, warn, and guide the traveling public safely through the work zone.
 - The Contractor may furnish either the sign design shown in the plans or in the "Standard Highway Sign Designs for Texas" (SHSD). The Engineer/Inspector may require the Contractor to furnish other work zone signs that are shown in the TMUTCD but may have been omitted from the plans. Any variation in the plans shall be documented by written agreement between the Engineer and the Contractor's Responsible Person. All changes must be documented in writing before being implemented. This can include documenting the changes in the Inspector's TxDOT diary and having both the Inspector and Contractor initial and date the agreed upon changes.
 - The Contractor shall furnish sign supports listed in the "Compliant Work Zone Traffic Control Device List" (CWZTCD). The Contractor shall install the sign support in accordance with the manufacturer's recommendations. If there is a question regarding installation procedures, the Contractor shall furnish the Engineer a copy of the manufacturer's installation recommendations so the Engineer can verify the correct procedures are being followed.
 - The Contractor is responsible for installing signs on approved supports and replacing signs with damaged or cracked substrates and/or damaged or marred reflective sheeting as directed by the Engineer/Inspector.
 - Identification markings may be shown only on the back of the sign substrate. The maximum height of letters and/or company logos used for identification shall be 1 inch.
 - The Contractor shall replace damaged wood posts. New or damaged wood sign posts shall not be spliced.
- DURATION OF WORK (as defined by the "Texas Manual on Uniform Traffic Control Devices" Part 6)**
- The types of sign supports, sign mounting height, the size of signs, and the type of sign substrates can vary based on the type of work being performed. The Engineer is responsible for selecting the appropriate size sign for the type of work being performed. The Contractor is responsible for ensuring the sign support, sign mounting height and substrate meets manufacturer's recommendations in regard to crashworthiness and duration of work requirements.
 - Long-term stationary - work that occupies a location more than 3 days.
 - Intermediate-term stationary - work that occupies a location more than one daylight period up to 3 days, or nighttime work lasting more than one hour.
 - Short-term stationary - daytime work that occupies a location for more than 1 hour in a single daylight period.
 - Short, duration - work that occupies a location up to 1 hour.
 - Mobile - work that moves continuously or intermittently (stopping for up to approximately 15 minutes.)

SIGN MOUNTING HEIGHT

- The bottom of Long-term/Intermediate-term signs shall be at least 7 feet, but not more than 9 feet, above the paved surface, except as shown for supplemental plaques mounted below other signs.
- The bottom of Short-term/Short Duration signs shall be a minimum of 1 foot above the pavement surface but no more than 2 feet above the ground.
- Long-term/Intermediate-term Signs may be used in lieu of Short-term/Short Duration signing.
- Short-term/Short Duration signs shall be used only during daylight and shall be removed at the end of the workday or raised to appropriate Long-term/Intermediate sign height.
- Regulatory signs shall be mounted at least 7 feet, but not more than 9 feet, above the paved surface regardless of work duration.

SIZE OF SIGNS

- The Contractor shall furnish the sign sizes shown on BC (2) unless otherwise shown in the plans or as directed by the Engineer.

SIGN SUBSTRATES

- The Contractor shall ensure the sign substrate is installed in accordance with the manufacturer's recommendations for the type of sign support that is being used. The CWZTCD lists each substrate that can be used on the different types and models of sign supports.
- "Mesh" type materials are NOT an approved sign substrate, regardless of the tightness of the weave.
- All wooden individual sign panels fabricated from 2 or more pieces shall have one or more plywood cleat, 1/2" thick by 6" wide, fastened to the back of the sign and extending fully across the sign. The cleat shall be attached to the back of the sign using wood screws that do not penetrate the face of the sign panel. The screws shall be placed on both sides of the splice and spaced at 6" centers. The Engineer may approve other methods of splicing the sign face.

REFLECTIVE SHEETING

- All signs shall be retroreflective and constructed of sheeting meeting the color and retro-reflectivity requirements of DMS-8300 for rigid signs or DMS-8310 for roll-up signs. The web address for DMS specifications is shown on BC(1).
- White sheeting, meeting the requirements of DMS-8300 Type A, shall be used for signs with a white background.
- Orange sheeting, meeting the requirements of DMS-8300 Type B_{FL} or Type C_{FL}, shall be used for rigid signs with orange backgrounds.

SIGN LETTERS

- All sign letters and numbers shall be clear, and open rounded type uppercase alphabet letters as approved by the Federal Highway Administration (FHWA) and as published in the "Standard Highway Sign Design for Texas" manual. Signs, letters and numbers shall be of first class workmanship in accordance with Department Standards and Specifications.

REMOVING OR COVERING

- When sign messages may be confusing or do not apply, the signs shall be removed or completely covered.
- Long-term stationary or intermediate stationary signs installed on square metal tubing may be turned away from traffic 90 degrees when the sign message is not applicable. This technique may not be used for signs installed in the median of divided highways or near any intersections where the sign may be seen from approaching traffic.
- Signs installed on wooden skids shall not be turned at 90 degree angles to the roadway. These signs should be removed or completely covered when not required.
- When signs are covered, the material used shall be opaque, such as heavy mil black plastic, or other materials which will cover the entire sign face and maintain their opaque properties under automobile headlights at night, without damaging the sign sheeting.
- Burlap shall NOT be used to cover signs.
- Duct tape or other adhesive material shall NOT be affixed to a sign face.
- Signs and anchor stubs shall be removed and holes backfilled upon completion of work.

SIGN SUPPORT WEIGHTS

- Where sign supports require the use of weights to keep from turning over, the use of sandbags with dry, cohesionless sand should be used.
- The sandbags will be tied shut to keep the sand from spilling and to maintain a constant weight.
- Rock, concrete, iron, steel or other solid objects shall not be permitted for use as sign support weights.
- Sandbags should weigh a minimum of 35 lbs and a maximum of 50 lbs. Sandbags shall be made of a durable material that tears upon vehicular impact. Rubber (such as tire inner tubes) shall NOT be used.
- Rubber ballasts designed for channelizing devices should not be used for ballast on portable sign supports. Sign supports designed and manufactured with rubber bases may be used when shown on the CWZTCD list.
- Sandbags shall only be placed along or laid over the base supports of the traffic control device and shall not be suspended above ground level or hung with rope, wire, chains or other fasteners. Sandbags shall be placed along the length of the skids to weigh down the sign support.
- Sandbags shall NOT be placed under the skid and shall not be used to level sign supports placed on slopes.

FLAGS ON SIGNS

- Flags may be used to draw attention to warning signs. When used the flag shall be 16 inches square or larger and shall be orange or fluorescent red-orange in color. Flags shall not be allowed to cover any portion of the sign face.

SHEET 4 OF 12



BARRICADE AND CONSTRUCTION TEMPORARY SIGN NOTES






BC (4) - 14

FILE:	bc-14.dgn	DW:	TxDOT	CK:	TxDOT	DW:	TxDOT	CK:	TxDOT
© TxDOT	November 2002	CONT	SECT	JOB	HIGHWAY				
REVISIONS		0169	07	053, ETC	US60				
9-07	8-14	DIST	COUNTY	SHEET NO.					
7-13		AMA	GRAY	38					

DISCLAIMER: The use of this standard is governed by the "Texas Engineering Practice Act". No warranty of any kind is made by TxDOT for any purpose whatsoever. TxDOT assumes no responsibility for the conversion of this standard to other formats or for incorrect results or damages resulting from its use.

DATE: 4/7/2021 7:26:27 AM
FILE: F:\Projects\2019\11004.TxDOT_5x5_PS&E\03_US60_Amarillo\ENG\500-USTN\511.1-TCP\05-Standards\bc-14.dgn

DATE: 4/7/2021 7:26:27 AM
 FILE: F:\Projects\2019\11004.TxDOT_5x5_PS&E_V03_US60_Amarillo\ENG\500-USTN\511_1111\CP\05-Standards\bc-14.dgn
 DISCLAIMER: The use of this standard is governed by the "Texas Engineering Practice Act". No warranty of any kind is made by TxDOT for any purpose whatsoever. TxDOT assumes no responsibility for the conversion of this standard to other formats or for incorrect results or damages resulting from its use.

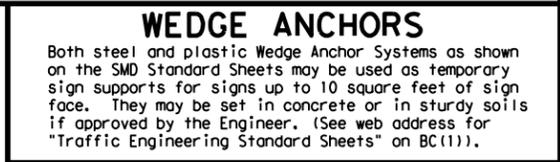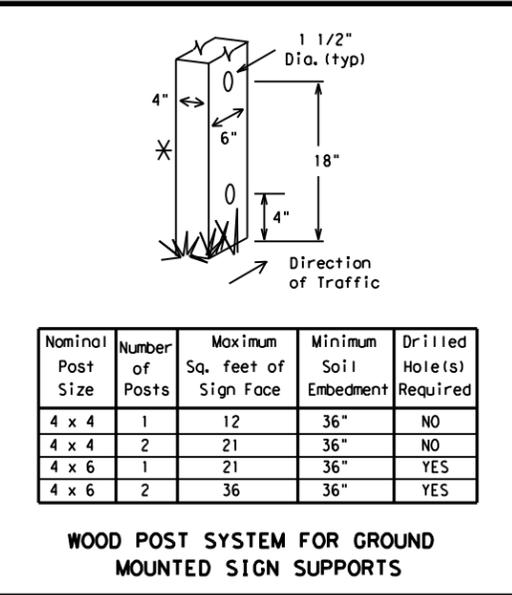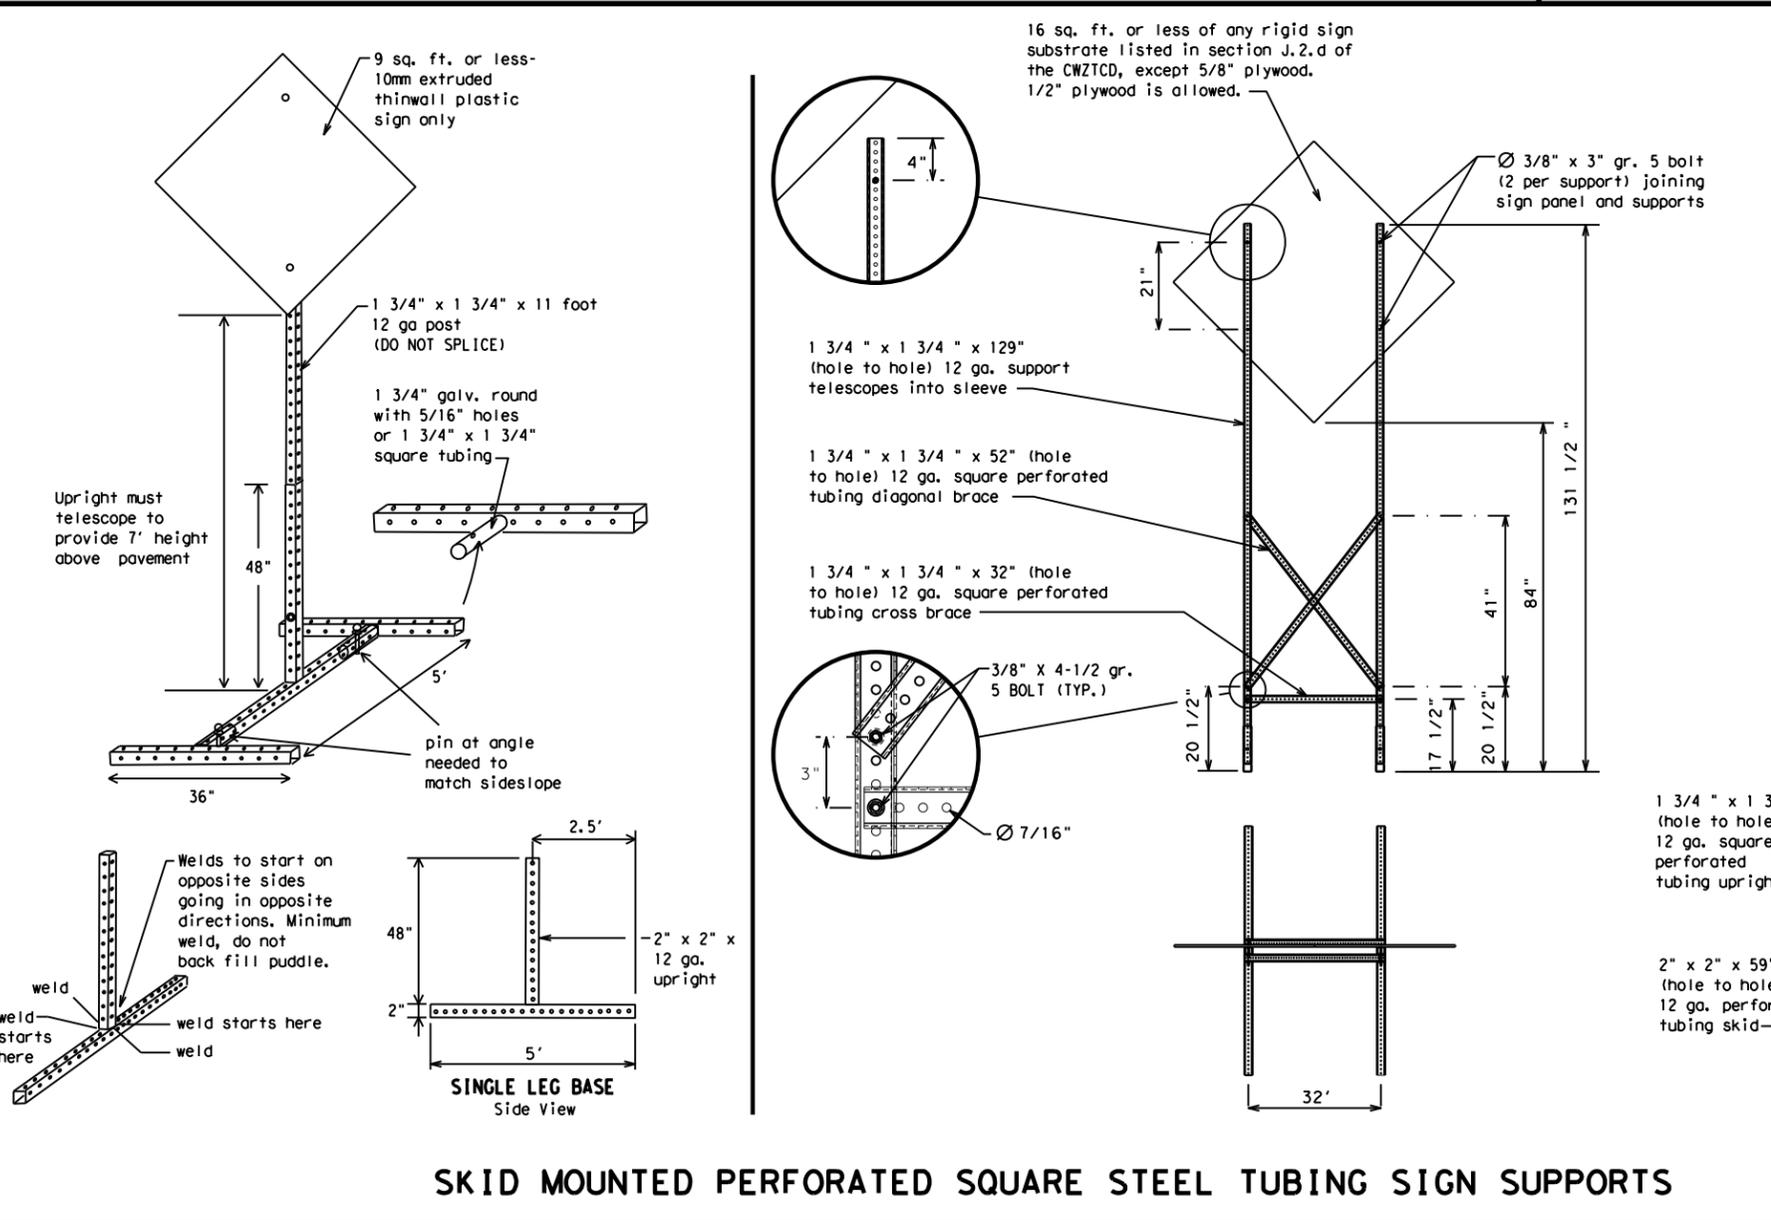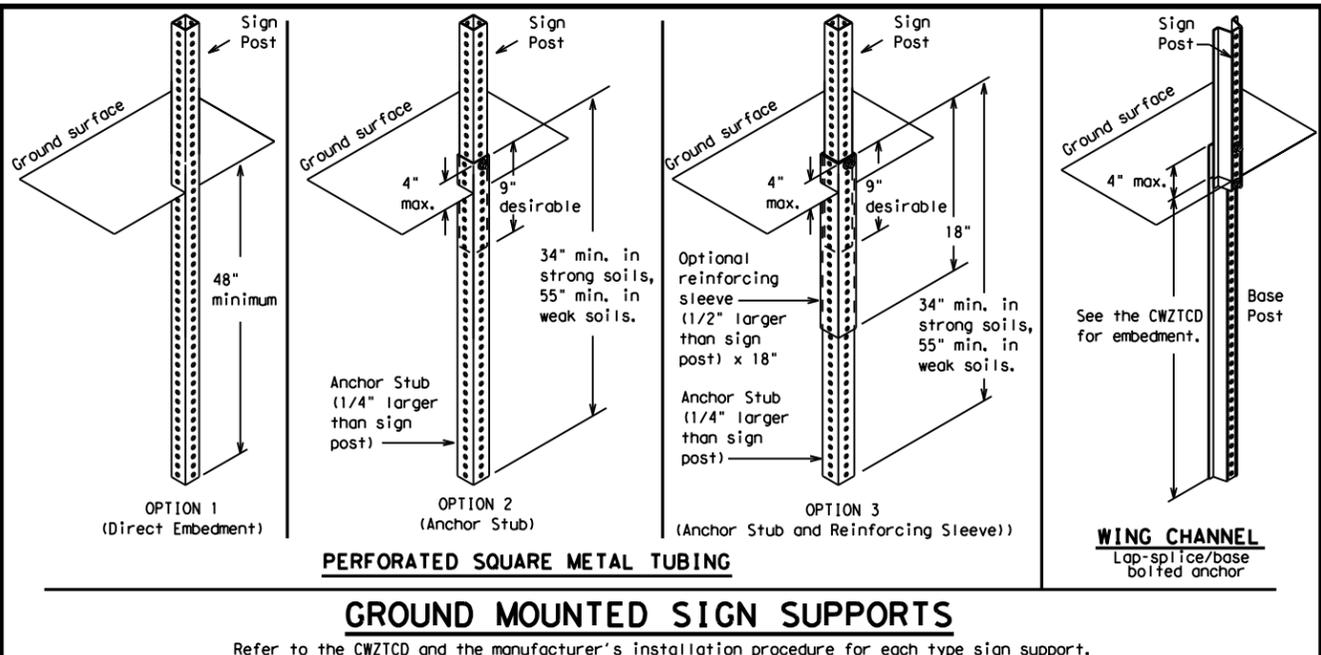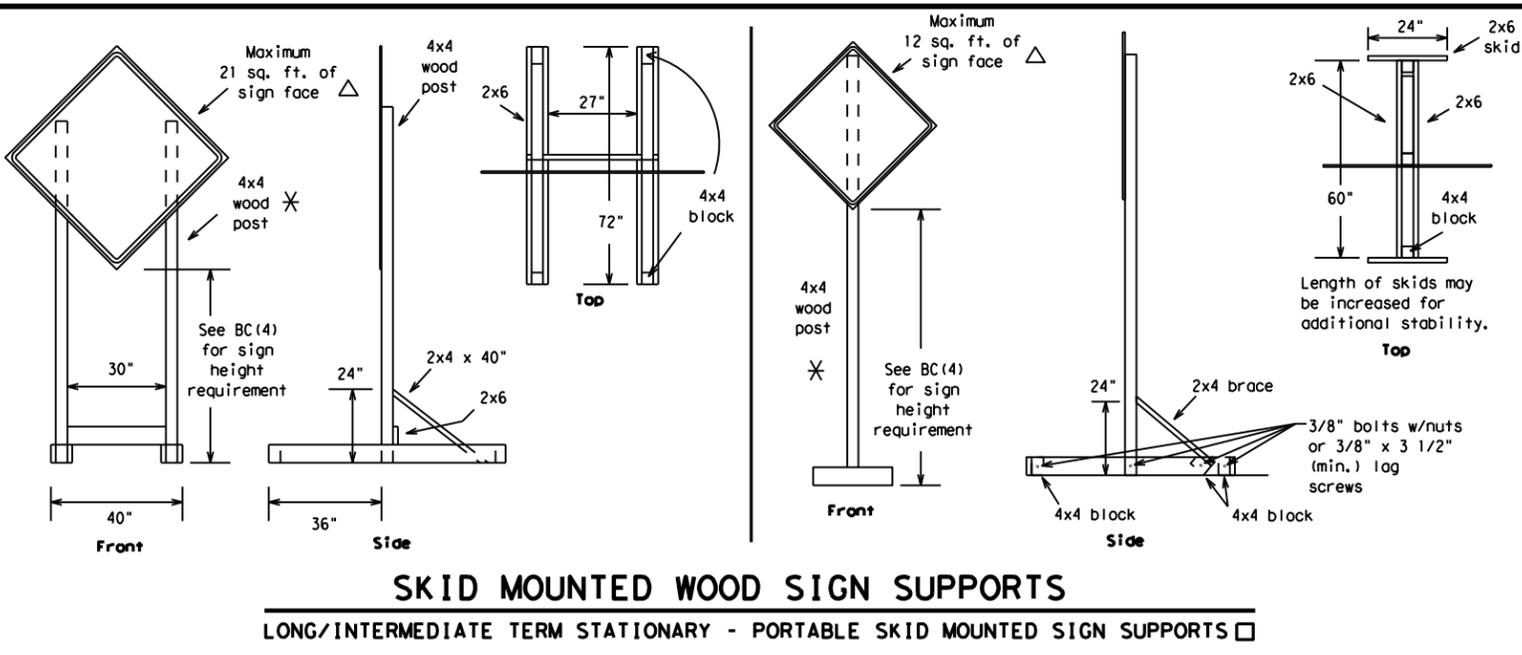

OTHER DESIGNS
 MORE DETAILS OF APPROVED LONG/INTERMEDIATE AND SHORT TERM SUPPORTS CAN BE FOUND ON THE CWZTCD LIST. SEE BC(1) FOR WEBSITE LOCATION.

- GENERAL NOTES**
- Nails may be used in the assembly of wooden sign supports, but 3/8" bolts with nuts or 3/8" x 3 1/2" lag screws must be used on every joint for final connection.
 - No more than 2 sign posts shall be placed within a 7 ft. circle, except for specific materials noted on the CWZTCD List.
 - When project is completed, all sign supports and foundations shall be removed from the project site. This will be considered subsidiary to Item 502.

See BC(4) for definition of "Work Duration."
 ✖ Wood sign posts MUST be one piece. Splicing will NOT be allowed. Posts shall be painted white.
 △ See the CWZTCD for the type of sign substrate that can be used for each approved sign support.

BARRICADE AND CONSTRUCTION TYPICAL SIGN SUPPORT

BC(5) - 14

FILE: bc-14.dgn	DN: TxDOT	CK: TxDOT	DW: TxDOT	CR: TxDOT
© TxDOT November 2002	CONT	SECT	JOB	HIGHWAY
REVISIONS	0169	07	053, ETC	US60
9-07 8-14	DIST	COUNTY	SHEET NO.	
7-13	AMA	GRAY	39	

WHEN NOT IN USE, REMOVE THE PCMS FROM THE RIGHT-OF-WAY OR PLACE THE PCMS BEHIND BARRIER OR GUARDRAIL WITH SIGN PANEL TURNED PARALLEL TO TRAFFIC

RECOMMENDED PHASES AND FORMATS FOR PCMS MESSAGES DURING ROADWORK ACTIVITIES

(The Engineer may approve other messages not specifically covered here.)

PORTABLE CHANGEABLE MESSAGE SIGNS

- The Engineer/Inspector shall approve all messages used on portable changeable message signs (PCMS).
- Messages on PCMS should contain no more than 8 words (about four to eight characters per word), not including simple words such as "TO," "FOR," "AT," etc.
- Messages should consist of a single phase, or two phases that alternate. Three-phase messages are not allowed. Each phase of the message should convey a single thought, and must be understood by itself.
- Use the word "EXIT" to refer to an exit ramp on a freeway; i.e., "EXIT CLOSED." Do not use the term "RAMP."
- Always use the route or interstate designation (IH, US, SH, FM) along with the number when referring to a roadway.
- When in use the bottom of a stationary PCMS message panel should be a minimum 7 feet above the roadway, where possible.
- The message term "WEEKEND" should be used only if the work is to start on Saturday morning and end by Sunday evening at midnight. Actual days and hours of work should be displayed on the PCMS if work is to begin on Friday evening and/or continue into Monday morning.
- The Engineer/Inspector may select one of two options which are available for displaying a two-phase message on a PCMS. Each phase may be displayed for either four seconds each or for three seconds each.
- Do not "flash" messages or words included in a message. The message should be steady burn or continuous while displayed.
- Do not present redundant information on a two-phase message; i.e., keeping two lines of the message the same and changing the third line.
- Do not use the word "Danger" in message.
- Do not display the message "LANES SHIFT LEFT" or "LANES SHIFT RIGHT" on a PCMS. Drivers do not understand the message.
- Do not display messages that scroll horizontally or vertically across the face of the sign.
- The following table lists abbreviated words and two-word phrases that are acceptable for use on a PCMS. Both words in a phrase must be displayed together. Words or phrases not on this list should not be abbreviated, unless shown in the TMUTCD.
- PCMS character height should be at least 18 inches for trailer mounted units. They should be visible from at least 1/2 (.5) mile and the text should be legible from at least 600 feet at night and 800 feet in daylight. Truck mounted units must have a character height of 10 inches and must be legible from at least 400 feet.
- Each line of text should be centered on the message board rather than left or right justified.
- If disabled, the PCMS should default to an illegible display that will not alarm motorists and will only be used to alert workers that the PCMS has malfunctioned. A pattern such as a series of horizontal solid bars is appropriate.

Phase 1: Condition Lists

Road/Lane/Ramp Closure List

FREEWAY CLOSED X MILE	FRONTAGE ROAD CLOSED
ROAD CLOSED AT SH XXX	SHOULDER CLOSED XXX FT
ROAD CLSD AT FM XXXX	RIGHT LN CLOSED XXX FT
RIGHT X LANES CLOSED	RIGHT X LANES OPEN
CENTER LANE CLOSED	DAYTIME LANE CLOSURES
NIGHT LANE CLOSURES	I-XX SOUTH EXIT CLOSED
VARIOUS LANES CLOSED	EXIT XXX CLOSED X MILE
EXIT CLOSED	RIGHT LN TO BE CLOSED
MALL DRIVEWAY CLOSED	X LANES CLOSED TUE - FRI
XXXXXXXX BLVD CLOSED	

Other Condition List

ROADWORK XXX FT	ROAD REPAIRS XXXX FT
FLAGGER XXXX FT	LANE NARROWS XXXX FT
RIGHT LN NARROWS XXXX FT	TWO-WAY TRAFFIC XX MILE
MERGING TRAFFIC XXXX FT	CONST TRAFFIC XXX FT
LOOSE GRAVEL XXXX FT	UNEVEN LANES XXXX FT
DETOUR X MILE	ROUGH ROAD XXXX FT
ROADWORK PAST SH XXXX	ROADWORK NEXT FRI-SUN
BUMP XXXX FT	US XXX EXIT X MILES
TRAFFIC SIGNAL XXXX FT	LANES SHIFT *

* LANES SHIFT in Phase 1 must be used with STAY IN LANE in Phase 2.

Phase 2: Possible Component Lists

Action to Take/Effect on Travel List

MERGE RIGHT	FORM X LINES RIGHT
DETOUR NEXT X EXITS	USE XXXXX RD EXIT
USE EXIT XXX	USE EXIT I-XX NORTH
STAY ON US XXX SOUTH	USE I-XX E TO I-XX N
TRUCKS USE US XXX N	WATCH FOR TRUCKS
WATCH FOR TRUCKS	EXPECT DELAYS
EXPECT DELAYS	PREPARE TO STOP
REDUCE SPEED XXX FT	END SHOULDER USE
USE OTHER ROUTES	WATCH FOR WORKERS
STAY IN LANE *	

Location List

AT FM XXXX
BEFORE RAILROAD CROSSING
NEXT X MILES
PAST US XXX EXIT
XXXXXXXX TO XXXXXXX
US XXX TO FM XXXX

Warning List

SPEED LIMIT XX MPH
MAXIMUM SPEED XX MPH
MINIMUM SPEED XX MPH
ADVISORY SPEED XX MPH
RIGHT LANE EXIT
USE CAUTION
DRIVE SAFELY
DRIVE WITH CARE

** Advance Notice List

TUE-FRI XX AM-X PM
APR XX-XX X PM-X AM
BEGINS MONDAY
BEGINS MAY XX
MAY X-X XX PM - XX AM
NEXT FRI-SUN
XX AM TO XX PM
NEXT TUE AUG XX
TONIGHT XX PM-XX AM

** See Application Guidelines Note 6.

APPLICATION GUIDELINES

- Only 1 or 2 phases are to be used on a PCMS.
- The 1st phase (or both) should be selected from the "Road/Lane/Ramp Closure List" and the "Other Condition List".
- A 2nd phase can be selected from the "Action to Take/Effect on Travel, Location, General Warning, or Advance Notice Phase Lists".
- A Location Phase is necessary only if a distance or location is not included in the first phase selected.
- If two PCMS are used in sequence, they must be separated by a minimum of 1000 ft. Each PCMS shall be limited to two phases, and should be understandable by themselves.
- For advance notice, when the current date is within seven days of the actual work date, calendar days should be replaced with days of the week. Advance notification should typically be for no more than one week prior to the work.

WORDING ALTERNATIVES

- The words RIGHT, LEFT and ALL can be interchanged as appropriate.
- Roadway designations IH, US, SH, FM and LP can be interchanged as appropriate.
- EAST, WEST, NORTH and SOUTH (or abbreviations E, W, N and S) can be interchanged as appropriate.
- Highway names and numbers replaced as appropriate.
- ROAD, HIGHWAY and FREEWAY can be interchanged as needed.
- AHEAD may be used instead of distances if necessary.
- FT and MI, MILE and MILES interchanged as appropriate.
- AT, BEFORE and PAST interchanged as needed.
- Distances or AHEAD can be eliminated from the message if a location phase is used.

PCMS SIGNS WITHIN THE R.O.W. SHALL BE BEHIND GUARDRAIL OR CONCRETE BARRIER OR SHALL HAVE A MINIMUM OF FOUR (4) PLASTIC DRUMS PLACED PERPENDICULAR TO TRAFFIC ON THE UPSTREAM SIDE OF THE PCMS, WHEN EXPOSED TO ONE DIRECTION OF TRAFFIC. WHEN EXPOSED TO TWO WAY TRAFFIC, THE FOUR DRUMS SHOULD BE PLACED WITH ONE DRUM AT EACH OF THE FOUR CORNERS OF THE UNIT.

FULL MATRIX PCMS SIGNS

- When Full Matrix PCMS signs are used, the character height and legibility/visibility requirements shall be maintained as listed in Note 15 under "PORTABLE CHANGEABLE MESSAGE SIGNS" above.
- When symbol signs, such as the "Flagger Symbol" (CW20-7) are represented graphically on the Full Matrix PCMS sign and, with the approval of the Engineer, it shall maintain the legibility/visibility requirement listed above.
- When symbol signs are represented graphically on the Full Matrix PCMS, they shall only supplement the use of the static sign represented, and shall not substitute for, or replace that sign.
- A full matrix PCMS may be used to simulate a flashing arrow board provided it meets the visibility, flash rate and dimming requirements on BC(7), for the same size arrow.

DISCLAIMER: The use of this standard is governed by the "Texas Engineering Practice Act". No warranty of any kind is made by TxDOT for any purpose whatsoever. TxDOT assumes no responsibility for the conversion of this standard to other formats or for incorrect results or damages resulting from its use.

WORD OR PHRASE	ABBREVIATION	WORD OR PHRASE	ABBREVIATION
Access Road	ACCS RD	Major	MAJ
Alternate	ALT	Miles	MI
Avenue	AVE	Miles Per Hour	MPH
Best Route	BEST RTE	Minor	MNR
Boulevard	BLVD	Monday	MON
Bridge	BRDG	Normal	NORM
Canal	CANT	North	N
Center	CTR	Northbound	(route) N
Construction Ahead	CONST AHD	Parking	PKING
CROSSING	XING	Road	RD
Detour Route	DETOUR RTE	Right Lane	RT LN
Do Not	DONT	Saturday	SAT
East	E	Service Road	SERV RD
Eastbound	(route) E	Shoulder	SHLDR
Emergency	EMER	Slippery	SLIP
Emergency Vehicle	EMER VEH	South	S
Entrance, Enter	ENT	Southbound	(route) S
Express Lane	EXP LN	Speed	SPD
Expressway	EXPWY	Street	ST
XXXX Feet	XXXX FT	Sunday	SUN
Fog Ahead	FOG AHD	Telephone	PHONE
Freeway	FRWY, FWY	Temporary	TEMP
Freeway Blocked	FWY BLKD	Thursday	THURS
Friday	FRI	To Downtown	TO DWNTN
Hazardous Driving	HAZ DRIVING	Traffic	TRAF
Hazardous Material	HAZMAT	Travelers	TRVLR
High-Occupancy Vehicle	HOV	Tuesday	TUES
Highway	Hwy	Time Minutes	TIME MIN
Hour(s)	HR, HRS	Upper Level	UPR LEVEL
Information	INFO	Vehicles (s)	VEH, VEHS
It Is	ITS	Warning	WARN
Junction	JCT	Wednesday	WED
Left	LFT	Weight Limit	WT LIMIT
Left Lane	LFT LN	West	W
Lane Closed	LN CLOSED	Westbound	(route) W
Lower Level	LWR LEVEL	Wet Pavement	WET PVMT
Maintenance	MAINT	Will Not	WONT

Roadway designation # IH-number, US-number, SH-number, FM-number



Traffic Operations Division Standard

BARRICADE AND CONSTRUCTION PORTABLE CHANGEABLE MESSAGE SIGN (PCMS)


BC (6) - 14

FILE:	bc-14.dgn	DN:	TxDOT	CK:	TxDOT	DW:	TxDOT	CR:	TxDOT
© TxDOT	November 2002	CONT:	SECT:	JOB:	HIGHWAY:				
REVISIONS		0169	07	053, ETC	US60				
9-07	8-14	DIST:	COUNTY:	SHEET NO.:					
7-13		AMA	GRAY	40					


DISCLAIMER: The use of this standard is governed by the "Texas Engineering Practice Act". No warranty of any kind is made by TxDOT for any purpose whatsoever. TxDOT assumes no responsibility for the conversion of this standard to other formats or for incorrect results or damages resulting from its use.

DATE: 4/7/2021 7:26:28 AM
 FILE: F:\Projects\2019\11004.TxDOT_5x5_P&E\03_US60_Amarillo\ENG\500-USTN\511.1-TCP\05-Standards\bc-14.dgn

- Barrier Reflectors shall be pre-qualified, and conform to the color and reflectivity requirements of DMS-8600. A list of prequalified Barrier Reflectors can be found at the Material Producer List web address shown on BC(1).
- Color of Barrier Reflectors shall be as specified in the TMUTCD. The cost of the reflectors shall be considered subsidiary to Item 512.

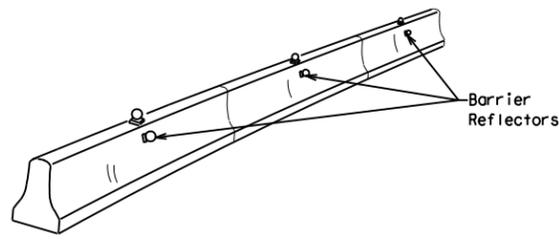


CONCRETE TRAFFIC BARRIER (CTB)

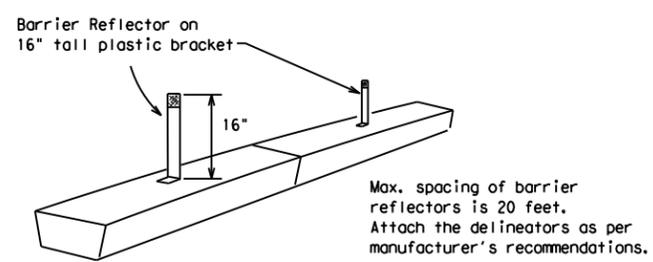

LOW PROFILE CONCRETE BARRIER (LPCB)

- Where traffic is on one side of the CTB, two (2) Barrier Reflectors shall be mounted in approximately the midsection of each section of CTB. An alternate mounting location is uniformly spaced at one end of each CTB. This will allow for attachment of a barrier grapple without damaging the reflector. The Barrier Reflector mounted on the side of the CTB shall be located directly below the reflector mounted on top of the barrier, as shown in the detail above.
- Where CTB separates two-way traffic, three barrier reflectors shall be mounted on each section of CTB. The reflector unit on top shall have two yellow reflective faces (Bi-Directional) while the reflectors on each side of the barrier shall have one yellow reflective face, as shown in the detail above.
- When CTB separates traffic traveling in the same direction, no barrier reflectors will be required on top of the CTB.
- Barrier Reflector units shall be yellow or white in color to match the edgeline being supplemented.
- Maximum spacing of Barrier Reflectors is forty (40) feet.
- Pavement markers or temporary flexible-reflective roadway marker tabs shall NOT be used as CTB delineation.
- Attachment of Barrier Reflectors to CTB shall be per manufacturer's recommendations.
- Missing or damaged Barrier Reflectors shall be replaced as directed by the Engineer.
- Single slope barriers shall be delineated as shown on the above detail.

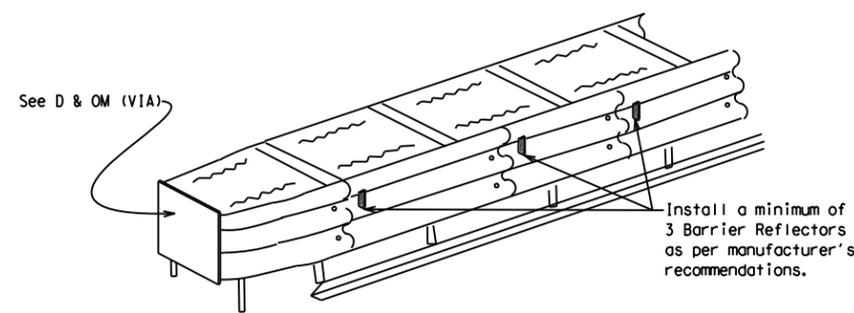

DELINEATION OF END TREATMENTS

END TREATMENTS FOR CTB'S USED IN WORK ZONES
 End treatments used on CTB's in work zones shall meet crashworthy standards as defined in the National Cooperative Highway Research Report 350. Refer to the CWZTCD List for approved end treatments and manufacturers.

BARRIER REFLECTORS FOR CONCRETE TRAFFIC BARRIER AND ATTENUATORS

WARNING LIGHTS


- Warning lights shall meet the requirements of the TMUTCD.
- Warning lights shall NOT be installed on barricades.
- Type A-Low Intensity Flashing Warning Lights are commonly used with drums. They are intended to warn of or mark a potentially hazardous area. Their use shall be as indicated on this sheet and/or other sheets of the plans by the designation "FL". The Type A Warning Lights shall not be used with signs manufactured with Type B_{FL} or C_{FL} Sheeting meeting the requirements of Departmental Material Specification DMS-8300.
- Type-C and Type D 360 degree Steady Burn Lights are intended to be used in a series for delineation to supplement other traffic control devices. Their use shall be as indicated on this sheet and/or other sheets of the plans by the designation "SB".
- The Engineer/Inspector or the plans shall specify the location and type of warning lights to be installed on the traffic control devices.
- When required by the Engineer, the Contractor shall furnish a copy of the warning lights certification. The warning light manufacturer will certify the warning lights meet the requirements of the latest ITE Purchase Specifications for Flashing and Steady-Burn Warning Lights.
- When used to delineate curves, Type-C and Type D Steady Burn Lights should only be placed on the outside of the curve, not the inside.
- The location of warning lights and warning reflectors on drums shall be as shown elsewhere in the plans.

WARNING LIGHTS MOUNTED ON PLASTIC DRUMS


- Type A flashing warning lights are intended to warn drivers that they are approaching or are in a potentially hazardous area.
- Type A random flashing warning lights are not intended for delineation and shall not be used in a series.
- A series of sequential flashing warning lights placed on channelizing devices to form a merging taper may be used for delineation. If used, the successive flashing of the sequential warning lights should occur from the beginning of the taper to the end of the merging taper in order to identify the desired vehicle path. The rate of flashing for each light shall be 65 flashes per minute, plus or minus 10 flashes.
- Type C and D steady-burn warning lights are intended to be used in a series to delineate the edge of the travel lane on detours, on lane changes, and on lane closures, and on other similar conditions.
- Type A, Type C and Type D warning lights shall be installed at locations as detailed on other sheets in the plans.
- Warning lights shall not be installed on a drum that has a sign, chevron or vertical panel.
- The maximum spacing for warning lights on drums should be identical to the channelizing device spacing.

WARNING REFLECTORS MOUNTED ON PLASTIC DRUMS AS A SUBSTITUTE FOR TYPE C (STEADY BURN) WARNING LIGHTS

- A warning reflector or approved substitute may be mounted on a plastic drum as a substitute for a Type C, steady burn warning light at the discretion of the Contractor unless otherwise noted in the plans.
- The warning reflector shall be yellow in color and shall be manufactured using a sign substrate approved for use with plastic drums listed on the CWZTCD.
- The warning reflector shall have a minimum retroreflective surface area (one-side) of 30 square inches.
- Round reflectors shall be fully reflectorized, including the area where attached to the drum.
- Square substrates must have a minimum of 30 square inches of reflectorized sheeting. They do not have to be reflectorized where it attaches to the drum.
- The side of the warning reflector facing approaching traffic shall have sheeting meeting the color and retroreflectivity requirements for DMS 8300-Type B or Type C.
- When used near two-way traffic, both sides of the warning reflector shall be reflectorized.
- The warning reflector should be mounted on the side of the handle nearest approaching traffic.
- The maximum spacing for warning reflectors should be identical to the channelizing device spacing requirements.

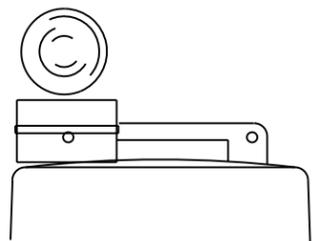


Type C Warning Light or approved substitute mounted on a drum adjacent to the travel way.

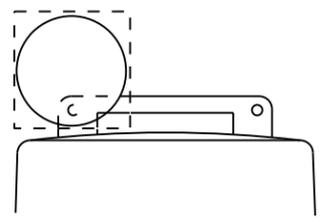

Warning reflector may be round or square. Must have a yellow reflective surface area of at least 30 square inches

Arrow Boards may be located behind channelizing devices in place for a shoulder taper or merging taper, otherwise they shall be delineated with four (4) channelizing devices placed perpendicular to traffic on the upstream side of traffic.

- The Flashing Arrow Board should be used for all lane closures on multi-lane roadways, or slow moving maintenance or construction activities on the travel lanes.
- Flashing Arrow Boards should not be used on two-lane, two-way roadways, detours, diversions or work on shoulders unless the "CAUTION" display (see detail below) is used.
- The Engineer/Inspector shall choose all appropriate signs, barricades and/or other traffic control devices that should be used in conjunction with the Flashing Arrow Board.
- The Flashing Arrow Board should be able to display the following symbols:

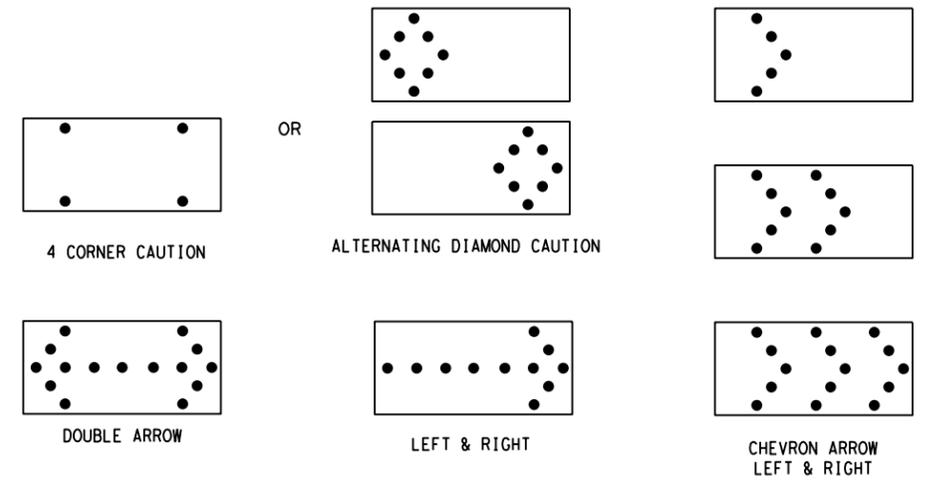

- The "CAUTION" display consists of four corner lamps flashing simultaneously, or the Alternating Diamond Caution mode as shown.
- The straight line caution display is NOT ALLOWED.
- The Flashing Arrow Board shall be capable of minimum 50 percent dimming from rated lamp voltage. The flashing rate of the lamps shall not be less than 25 nor more than 40 flashes per minute.
- Minimum lamp "on time" shall be approximately 50 percent for the flashing arrow and equal intervals of 25 percent for each sequential phase of the flashing chevron.
- The sequential arrow display is NOT ALLOWED.
- The flashing arrow display is the TxDOT standard; however, the sequential Chevron display may be used during daylight operations.
- The Flashing Arrow Board shall be mounted on a vehicle, trailer or other suitable support.
- A Flashing Arrow Board SHALL NOT BE USED to laterally shift traffic.
- A full matrix PCMS may be used to simulate a Flashing Arrow Board provided it meets visibility, flash rate and dimming requirements on this sheet for the same size arrow.
- Minimum mounting height of trailer mounted Arrow Boards should be 7 feet from roadway to bottom of panel.

REQUIREMENTS			
TYPE	MINIMUM SIZE	MINIMUM NUMBER OF PANEL LAMPS	MINIMUM VISIBILITY DISTANCE
B	30 x 60	13	3/4 mile
C	48 x 96	15	1 mile

ATTENTION
 Flashing Arrow Boards shall be equipped with automatic dimming devices.

WHEN NOT IN USE, REMOVE THE ARROW BOARD FROM THE RIGHT-OF-WAY OR PLACE THE ARROW BOARD BEHIND CONCRETE TRAFFIC BARRIER OR GUARDRAIL.

FLASHING ARROW BOARDS

SHEET 7 OF 12

TRUCK-MOUNTED ATTENUATORS

- Truck-mounted attenuators (TMA) used on TxDOT facilities must meet the requirements outlined in the National Cooperative Highway Research Report No. 350 (NCHRP 350) or the Manual for Assessing Safety Hardware (MASH).
- Refer to the CWZTCD for the requirements of Level 2 or Level 3 TMAs.
- Refer to the CWZTCD for a list of approved TMAs.
- TMAs are required on freeways unless otherwise noted in the plans.
- A TMA should be used anytime that it can be positioned 30 to 100 feet in advance of the area of crew exposure without adversely affecting the work performance.
- The only reason a TMA should not be required is when a work area is spread down the roadway and the work crew is an extended distance from the TMA.

Texas Department of Transportation
 Traffic Operations Division Standard

BARRICADE AND CONSTRUCTION ARROW PANEL, REFLECTORS, WARNING LIGHTS & ATTENUATOR

BC (7) - 14

FILE: bc-14.dgn	DN: TxDOT	CR: TxDOT	DW: TxDOT	CK: TxDOT
© TxDOT November 2002	CONT	SECT	JOB	HIGHWAY
REVISIONS	0169	07	053, ETC	US60
9-07 8-14	DIST	COUNTY	SHEET NO.	
7-13	AMA	GRAY	41	

DATE: 4/7/2021 7:26:29 AM
 FILE: F:\Projects\2019\11004.TxDOT_5x5_P&E\03_US60_Amarillo\ENGL\500-USTN\511.1-TCP\05-Standards\bc-14.dgn
 DISCLAIMER: The use of this standard is governed by the "Texas Engineering Practice Act". No warranty of any kind is made by TxDOT for any purpose whatsoever. TxDOT assumes no responsibility for the conversion of this standard to other formats or for incorrect results or damages resulting from its use.

GENERAL NOTES

- For long term stationary work zones on freeways, drums shall be used as the primary channelizing device.
- For intermediate term stationary work zones on freeways, drums should be used as the primary channelizing device but may be replaced in tangent sections by vertical panels, or 42" two-piece cones. In tangent sections one-piece cones may be used with the approval of the Engineer but only if personnel are present on the project at all times to maintain the cones in proper position and location.
- For short term stationary work zones on freeways, drums are the preferred channelizing device but may be replaced in tapers, transitions and tangent sections by vertical panels, two-piece cones or one-piece cones as approved by the Engineer.
- Drums and all related items shall comply with the requirements of the current version of the "Texas Manual on Uniform Traffic Control Devices" (TMUTCD) and the "Compliant Work Zone Traffic Control Devices List" (CWZTCD).
- Drums, bases, and related materials shall exhibit good workmanship and shall be free from objectionable marks or defects that would adversely affect their appearance or serviceability.
- The Contractor shall have a maximum of 24 hours to replace any plastic drums identified for replacement by the Engineer/Inspector. The replacement device must be an approved device.

GENERAL DESIGN REQUIREMENTS



- Pre-qualified plastic drums shall meet the following requirements:
- Plastic drums shall be a two-piece design; the "body" of the drum shall be the top portion and the "base" shall be the bottom.
 - The body and base shall lock together in such a manner that the body separates from the base when impacted by a vehicle traveling at a speed of 20 MPH or greater but prevents accidental separation due to normal handling and/or air turbulence created by passing vehicles.
 - Plastic drums shall be constructed of lightweight flexible, and deformable materials. The Contractor shall NOT use metal drums or single piece plastic drums as channelization devices or sign supports.
 - Drums shall present a profile that is a minimum of 18 inches in width at the 36 inch height when viewed from any direction. The height of drum unit (body installed on base) shall be a minimum of 36 inches and a maximum of 42 inches.
 - The top of the drum shall have a built-in handle for easy pickup and shall be designed to drain water and not collect debris. The handle shall have a minimum of two widely spaced 9/16 inch diameter holes to allow attachment of a warning light, warning reflector unit or approved compliant sign.
 - The exterior of the drum body shall have a minimum of four alternating orange and white retroreflective circumferential stripes not less than 4 inches nor greater than 8 inches in width. Any non-reflectORIZED space between any two adjacent stripes shall not exceed 2 inches in width.
 - Bases shall have a maximum width of 36 inches, a maximum height of 4 inches, and a minimum of two footholds of sufficient size to allow base to be held down while separating the drum body from the base.
 - Plastic drums shall be constructed of ultra-violet stabilized, orange, high-density polyethylene (HDPE) or other approved material.
 - Drum body shall have a maximum unballasted weight of 11 lbs.
 - Drum and base shall be marked with manufacturer's name and model number.

RETROREFLECTIVE SHEETING

- The stripes used on drums shall be constructed of sheeting meeting the color and retroreflectivity requirements of Departmental Materials Specification DMS-8300, "Sign Face Materials." Type A reflective sheeting shall be supplied unless otherwise specified in the plans.
- The sheeting shall be suitable for use on and shall adhere to the drum surface such that, upon vehicular impact, the sheeting shall remain adhered in-place and exhibit no delaminating, cracking, or loss of retroreflectivity other than that loss due to abrasion of the sheeting surface.

BALLAST


- Unballasted bases shall be large enough to hold up to 50 lbs. of sand. This base, when filled with the ballast material, should weigh between 35 lbs (minimum) and 50 lbs (maximum). The ballast may be sand in one to three sandbags separate from the base, sand in a sand-filled plastic base, or other ballasting devices as approved by the Engineer. Stacking of sandbags will be allowed, however height of sandbags above pavement surface may not exceed 12 inches.
- Bases with built-in ballast shall weigh between 40 lbs. and 50 lbs. Built-in ballast can be constructed of an integral crumb rubber base or a solid rubber base.
- Recycled truck tire sidewalls may be used for ballast on drums approved for this type of ballast on the CWZTCD list.
- The ballast shall not be heavy objects, water, or any material that would become hazardous to motorists, pedestrians, or workers when the drum is struck by a vehicle.
- When used in regions susceptible to freezing, drums shall have drainage holes in the bottoms so that water will not collect and freeze becoming a hazard when struck by a vehicle.
- Ballast shall not be placed on top of drums.
- Adhesives may be used to secure base of drums to pavement.

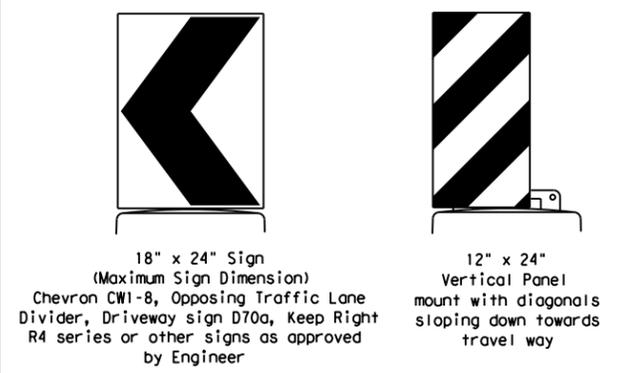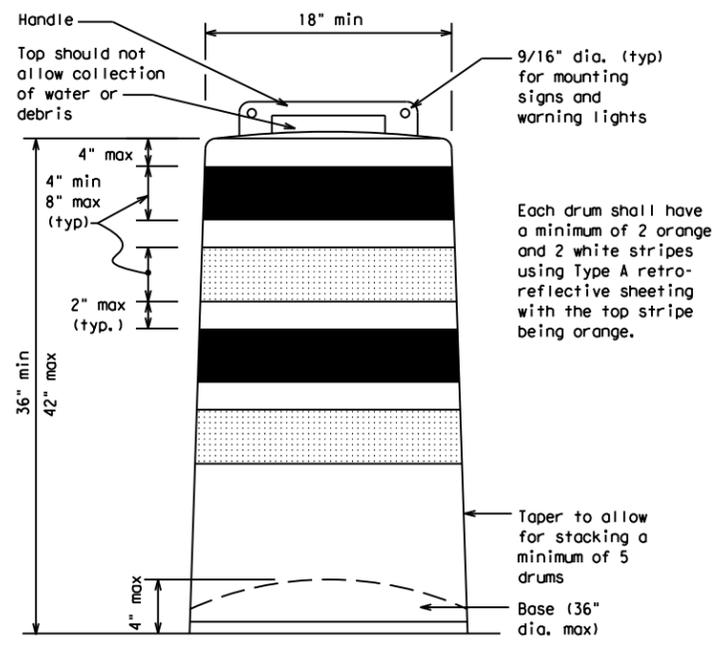

Plywood, Aluminum or Metal sign substrates shall NOT be used on plastic drums


SIGNS, CHEVRONS, AND VERTICAL PANELS MOUNTED ON PLASTIC DRUMS

- Signs used on plastic drums shall be manufactured using substrates listed on the CWZTCD.
- Chevrons and other work zone signs with an orange background shall be manufactured with Type B_{FL} or Type C_{FL} Orange sheeting meeting the color and retroreflectivity requirements of DMS-8300, "Sign Face Material," unless otherwise specified in the plans.
- Vertical Panels shall be manufactured with orange and white sheeting meeting the requirements of DMS-8300 Type A Diagonal stripes on Vertical Panels shall slope down toward the intended traveled lane.
- Other sign messages (text or symbolic) may be used as approved by the Engineer. Sign dimensions shall not exceed 18 inches in width or 24 inches in height, except for the R9 series signs discussed in note 8 below.
- Signs shall be installed using a 1/2 inch bolt (nominal) and nut, two washers, and one locking washer for each connection.
- Mounting bolts and nuts shall be fully engaged and adequately torqued. Bolts should not extend more than 1/2 inch beyond nuts.
- Chevrons may be placed on drums on the outside of curves, on merging tapers or on shifting tapers. When used in these locations they may be placed on every drum or spaced not more than on every third drum. A minimum of three (3) should be used at each location called for in the plans.
- R9-9, R9-10, R9-11 and R9-11a Sidewalk Closed signs which are 24 inches wide may be mounted on plastic drums, with approval of the Engineer.

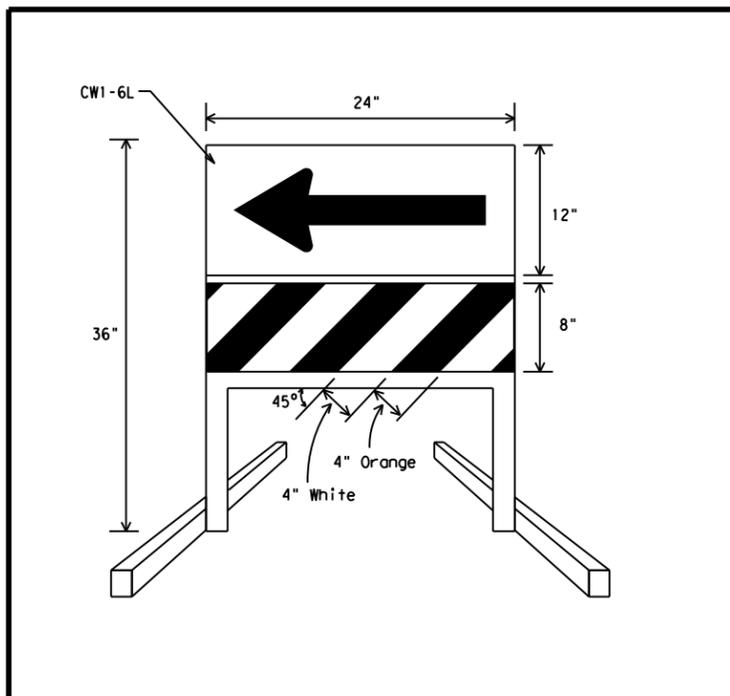

DIRECTION INDICATOR BARRICADE

- The Direction Indicator Barricade may be used in tapers, transitions, and other areas where specific directional guidance to drivers is necessary.
- If used, the Direction Indicator Barricade should be used in series to direct the driver through the transition and into the intended travel lane.
- The Direction Indicator Barricade shall consist of One-Direction Large Arrow (CWI-6) sign in the size shown with a black arrow on a background of Type B_{FL} or Type C_{FL} Orange retroreflective sheeting above a rail with Type A retroreflective sheeting in alternating 4" white and orange stripes sloping downward at an angle of 45 degrees in the direction road users are to pass. Sheetting types shall be as per DMS 8300.
- Double arrows on the Direction Indicator Barricade will not be allowed.
- Approved manufacturers are shown on the CWZTCD List. Ballast shall be as approved by the manufacturers instructions.

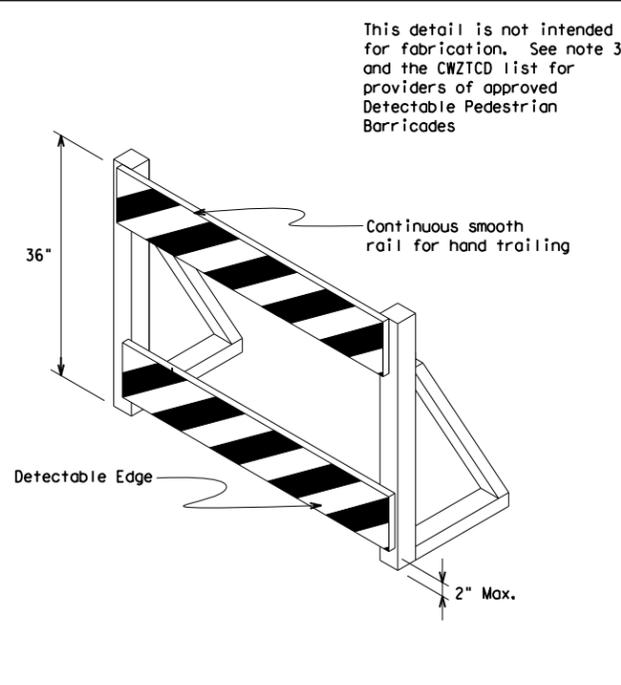

DETECTABLE PEDESTRIAN BARRICADES

- When existing pedestrian facilities are disrupted, closed, or relocated in a TTC zone, the temporary facilities shall be detectable and include accessibility features consistent with the features present in the existing pedestrian facility.
- Where pedestrians with visual disabilities normally use the closed sidewalk, a device that is detectable by a person with a visual disability traveling with the aid of a long cane shall be placed across the full width of the closed sidewalk.
- Detectable pedestrian barricades similar to the one pictured above, longitudinal channelizing devices, some concrete barriers, and wood or chain link fencing with a continuous detectable edging can satisfactorily delineate a pedestrian path.
- Tape, rope, or plastic chain strung between devices are not detectable, do not comply with the design standards in the "Americans with Disabilities Act Accessibility Guidelines for Buildings and Facilities (ADAAG)" and should not be used as a control for pedestrian movements.
- Warning lights shall not be attached to detectable pedestrian barricades.
- Detectable pedestrian barricades may use 8" nominal barricade rails as shown on BC(10) provided that the top rail provides a smooth continuous rail suitable for hand trailing with no splinters, burrs, or sharp edges.

SHEET 8 OF 12




BARRICADE AND CONSTRUCTION CHANNELIZING DEVICES

BC (8) - 14

FILE: bc-14.dgn	DN: TxDOT	CR: TxDOT	DW: TxDOT	CK: TxDOT
© TxDOT November 2002	CONT	SECT	JOB	HIGHWAY
REVISIONS	0169	07	053, ETC	US60
4-03 7-13	DIST	COUNTY	SHEET NO.	
9-07 8-14	AMA	GRAY	42	


DISCLAIMER: The use of this standard is governed by the "Texas Engineering Practice Act". No warranty of any kind is made by TxDOT for any purpose whatsoever. TxDOT assumes no responsibility for the conversion of this standard to other formats or for incorrect results or damages resulting from its use.

DATE: 4/7/2021 7:26:29 AM
 FILE: F:\Projects\2019\11004.TxDOT_5x5_P&E\03_US60_Amarillo\ENG\500-USTN\511.1-TCP\05-Standards\bc-14.dgn

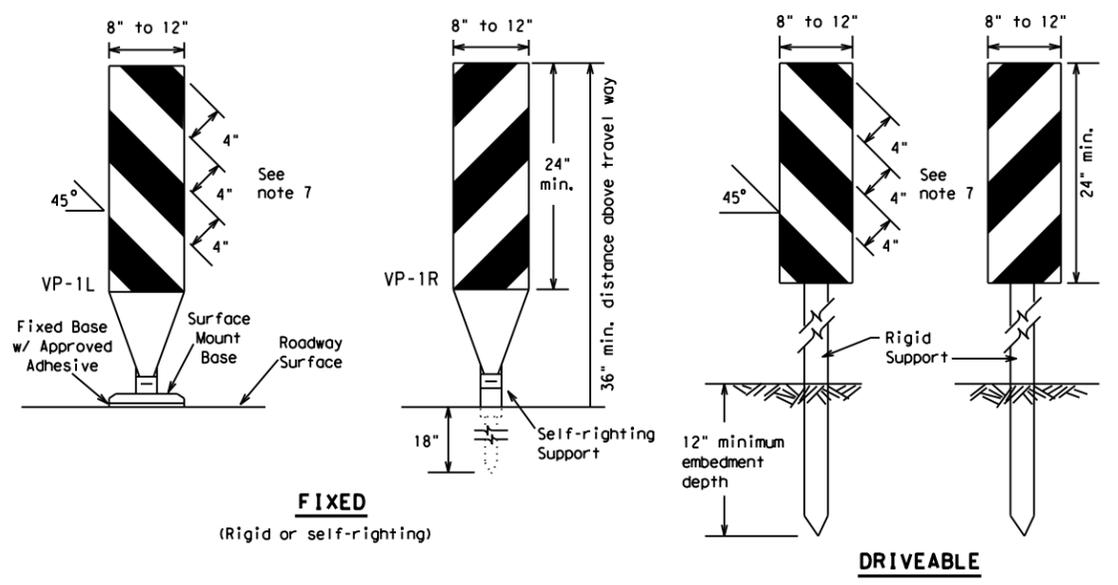

FIXED
(Rigid or self-righting)

DRIVEABLE

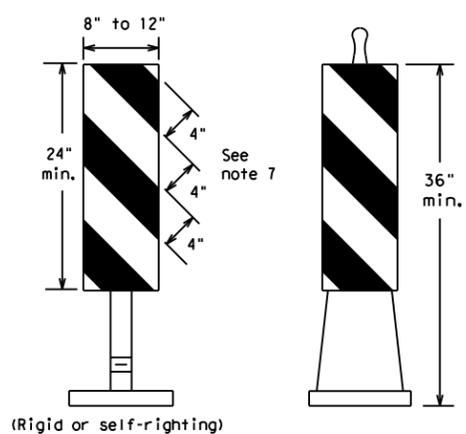


(Rigid or self-righting)

PORTABLE


VERTICAL PANELS (VPs)

- Vertical Panels (VP's) are normally used to channelize traffic or divide opposing lanes of traffic.
- VP's may be used in daytime or nighttime situations. They may be used at the edge of shoulder drop-offs and other areas such as lane transitions where positive daytime and nighttime delineation is required. The Engineer/Inspector shall refer to the Roadway Design Manual Appendix B "Treatment of Pavement Drop-offs in Work Zones" for additional guidelines on the use of VP's for drop-offs.
- VP's should be mounted back to back if used at the edge of cuts adjacent to two-way two lane roadways. Stripes are to be reflective orange and reflective white and should always slope downward toward the travel lane.
- VP's used on expressways and freeways or other high speed roadways, may have more than 270 square inches of retroreflective area facing traffic.
- Self-righting supports are available with portable base. See "Compliant Work Zone Traffic Control Devices List" (CWZTCD).
- Sheeting for the VP's shall be retroreflective Type A conforming to Departmental Material Specification DMS-8300, unless noted otherwise.
- Where the height of reflective material on the vertical panel is 36 inches or greater, a panel stripe of 6 inches shall be used.

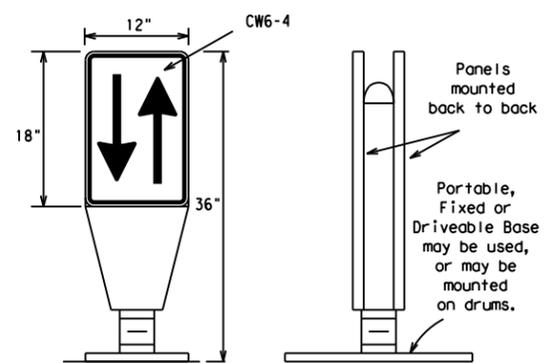

OPPOSING TRAFFIC LANE DIVIDERS (OTLD)


- Opposing Traffic Lane Dividers (OTLD) are delineation devices designed to convert a normal one-way roadway section to two-way operation. OTLD's are used on temporary centerlines. The upward and downward arrows on the sign's face indicate the direction of traffic on either side of the divider. The base is secured to the pavement with an adhesive or rubber weight to minimize movement caused by a vehicle impact or wind gust.
- The OTLD may be used in combination with 42" cones or VPs.
- Spacing between the OTLD shall not exceed 500 feet. 42" cones or VPs placed between the OTLD's should not exceed 100 foot spacing.
- The OTLD shall be orange with a black non-reflective legend. Sheeting for the OTLD shall be retroreflective Type B_{FL} or Type C_{FL} conforming to Departmental Material Specification DMS-8300, unless noted otherwise. The legend shall meet the requirements of DMS-8300.

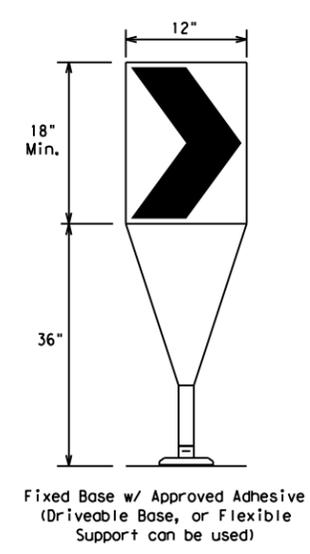

Fixed Base w/ Approved Adhesive (Driveable Base, or Flexible Support can be used)

- The chevron shall be a vertical rectangle with a minimum size of 12 by 18 inches.
- Chevrons are intended to give notice of a sharp change of alignment with the direction of travel and provide additional emphasis and guidance for vehicle operators with regard to changes in horizontal alignment of the roadway.
- Chevrons, when used, shall be erected on the outside of a sharp curve or turn, or on the far side of an intersection. They shall be in line with and at right angles to approaching traffic. Spacing should be such that the motorist always has three in view, until the change in alignment eliminates its need.
- To be effective, the chevron should be visible for at least 500 feet.
- Chevrons shall be orange with a black nonreflective legend. Sheeting for the chevron shall be retroreflective Type B_{FL} or Type C_{FL} conforming to Departmental Material Specification DMS-8300, unless noted otherwise. The legend shall meet the requirements of DMS-8300.
- For Long Term Stationary use on tapers or transitions on freeways and divided highways self-righting chevrons may be used to supplement plastic drums but not to replace plastic drums.

CHEVRONS

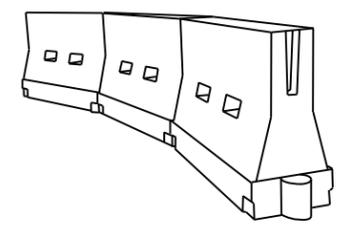

LONGITUDINAL CHANNELIZING DEVICES (LCD)

- LCDs are crashworthy, lightweight, deformable devices that are highly visible, have good target value and can be connected together. They are not designed to contain or redirect a vehicle on impact.
- LCDs may be used instead of a line of cones or drums.
- LCDs shall be placed in accordance to application and installation requirements specific to the device, and used only when shown on the CWZTCD list.
- LCDs should not be used to provide positive protection for obstacles, pedestrians or workers.
- LCDs shall be supplemented with retroreflective delineation as required for temporary barriers on BC(7) when placed roughly parallel to the travel lanes.
- LCDs used as barricades placed perpendicular to traffic should have at least one row of reflective sheeting meeting the requirements for barricade rails as shown on BC(10) placed near the top of the LCD along the full length of the device.

WATER BALLASTED SYSTEMS USED AS BARRIERS

- Water ballasted systems used as barriers shall not be used solely to channelize road users, but also to protect the work space per the appropriate NCHRP 350 crashworthiness requirements based on roadway speed and barrier application.
- Water ballasted systems used to channelize vehicular traffic shall be supplemented with retroreflective delineation or channelizing devices to improve daytime/nighttime visibility. They may also be supplemented with pavement markings.
- Water ballasted systems used as barriers shall be placed in accordance to application and installation requirements specific to the device, and used only when shown on the CWZTCD list.
- Water ballasted systems used as barriers should not be used for a merging taper except in low speed (less than 45 MPH) urban areas. When used on a taper in a low speed urban area, the taper shall be delineated and the taper length should be designed to optimize road user operations considering the available geometric conditions.
- When water ballasted systems used as barriers have blunt ends exposed to traffic, they should be attenuated as per manufacturer recommendations or flared to a point outside the clear zone.

If used to channelize pedestrians, longitudinal channelizing devices or water ballasted systems must have a continuous detectable bottom for users of long canes and the top of the unit shall not be less than 32 inches in height.

HOLLOW OR WATER BALLASTED SYSTEMS USED AS LONGITUDINAL CHANNELIZING DEVICES OR BARRIERS

GENERAL NOTES

- Work Zone channelizing devices illustrated on this sheet may be installed in close proximity to traffic and are suitable for use on high or low speed roadways. The Engineer/Inspector shall ensure that spacing and placement is uniform and in accordance with the "Texas Manual on Uniform Traffic Control Devices" (TMUTCD).
- Channelizing devices shown on this sheet may have a driveable, fixed or portable base. The requirement for self-righting channelizing devices must be specified in the General Notes or other plan sheets.
- Channelizing devices on self-righting supports should be used in work zone areas where channelizing devices are frequently impacted by errant vehicles or vehicle related wind gusts making alignment of the channelizing devices difficult to maintain. Locations of these devices shall be detailed elsewhere in the plans. These devices shall conform to the TMUTCD and the "Compliant Work Zone Traffic Control Devices List" (CWZTCD).
- The Contractor shall maintain devices in a clean condition and replace damaged, nonreflective, faded, or broken devices and bases as required by the Engineer/Inspector. The Contractor shall be required to maintain proper device spacing and alignment.
- Portable bases shall be fabricated from virgin and/or recycled rubber. The portable bases shall weigh a minimum of 30 lbs.
- Pavement surfaces shall be prepared in a manner that ensures proper bonding between the adhesives, the fixed mount bases and the pavement surface. Adhesives shall be prepared and applied according to the manufacturer's recommendations.
- The installation and removal of channelizing devices shall not cause detrimental effects to the final pavement surfaces, including pavement surface discoloration or surface integrity. Driveable bases shall not be permitted on final pavement surfaces. The Engineer/Inspector shall approve all application and removal procedures of fixed bases.

Posted Speed * S	Formula L = WS ² / 60	Minimum Desirable Taper Lengths **			Suggested Maximum Spacing of Channelizing Devices	
		10' Offset	11' Offset	12' Offset	On a Taper	On a Tangent
30	L = WS ² / 60	150'	165'	180'	30'	60'
35		205'	225'	245'	35'	70'
40	L = WS	265'	295'	320'	40'	80'
45		450'	495'	540'	45'	90'
50		500'	550'	600'	50'	100'
55		550'	605'	660'	55'	110'
60		600'	660'	720'	60'	120'
65		650'	715'	780'	65'	130'
70		700'	770'	840'	70'	140'
75		750'	825'	900'	75'	150'
80	800'	880'	960'	80'	160'	

**Taper lengths have been rounded off.
 L=Length of Taper (FT.) W=Width of Offset (FT.)
 S=Posted Speed (MPH)

SUGGESTED MAXIMUM SPACING OF CHANNELIZING DEVICES AND MINIMUM DESIRABLE TAPER LENGTHS

SHEET 9 OF 12



BARRICADE AND CONSTRUCTION CHANNELIZING DEVICES

BC (9) - 14


FILE: bc-14.dgn	DN: TxDOT	CK: TxDOT	DW: TxDOT	CR: TxDOT
© TxDOT November 2002	CONT	SECT	JOB	HIGHWAY
REVISIONS	0169	07	053, ETC	US60
9-07 8-14	DIST	COUNTY	SHEET NO.	
7-13	AMA	GRAY	43	

DISCLAIMER: The use of this standard is governed by the "Texas Engineering Practice Act". No warranty of any kind is made by TxDOT for any purpose whatsoever. TxDOT assumes no responsibility for the conversion of this standard to other formats or for incorrect results or damages resulting from its use.
 DATE: 4/7/2021 7:26:29 AM
 FILE: F:\Projects\2019\11004.TxDOT_5x5_PSE\03_US60_Amarillo\ENG\500-USTN\511.1-TCP\05-Standards\bc-14.dgn


TYPE 3 BARRICADES

1. Refer to the Compliant Work Zone Traffic Control Devices List (CWZTCD) for details of the Type 3 Barricades and a list of all materials used in the construction of Type 3 Barricades.
2. Type 3 Barricades shall be used at each end of construction projects closed to all traffic.
3. Barricades extending across a roadway should have stripes that slope downward in the direction toward which traffic must turn in detouring. When both right and left turns are provided, the chevron striping may slope downward in both directions from the center of the barricade. Where no turns are provided at a closed road striping should slope downward in both directions toward the center of roadway.
4. Striping of rails, for the right side of the roadway, should slope downward to the left. For the left side of the roadway, striping should slope downward to the right.
5. Identification markings may be shown only on the back of the barricade rails. The maximum height of letters and/or company logos used for identification shall be 1".
6. Barricades shall not be placed parallel to traffic unless an adequate clear zone is provided.
7. Warning lights shall NOT be installed on barricades.
8. Where barricades require the use of weights to keep from turning over, the use of sandbags with dry, cohesionless sand is recommended. The sandbags will be tied shut to keep the sand from spilling and to maintain a constant weight. Sand bags shall not be stacked in a manner that covers any portion of a barricade rails reflective sheeting. Rock, concrete, iron, steel or other solid objects will NOT be permitted. Sandbags should weigh a minimum of 35 lbs and a maximum of 50 lbs. Sandbags shall be made of a durable material that tears upon vehicular impact. Rubber (such as tire inner tubes) shall not be used for sandbags. Sandbags shall only be placed along or upon the base supports of the device and shall not be suspended above ground level or hung with rope, wire, chains or other fasteners.
9. Sheeting for barricades shall be retroreflective Type A conforming to Departmental Material Specification DMS-8300 unless otherwise noted.


Barricades shall NOT be used as a sign support.

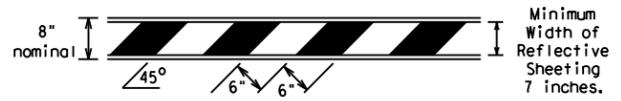

TYPICAL STRIPING DETAIL FOR BARRICADE RAIL

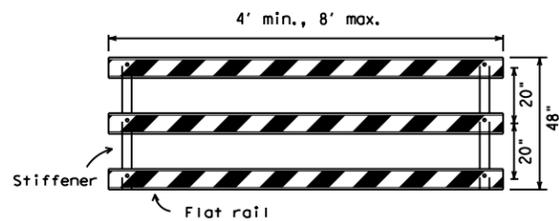


TYPICAL PANEL DETAIL FOR SKID OR POST TYPE BARRICADES

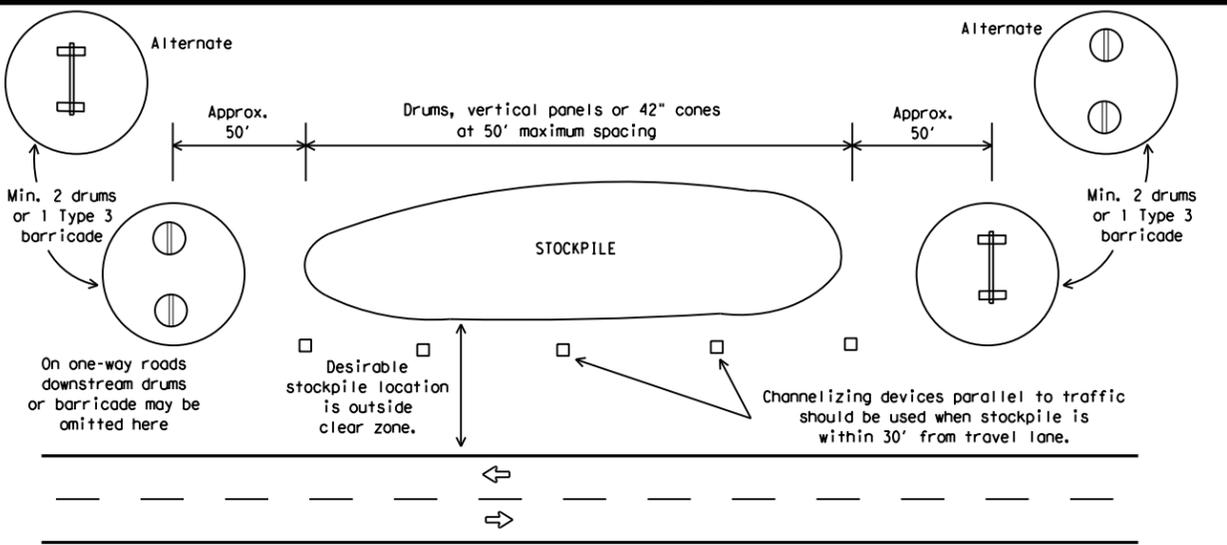


TRAFFIC CONTROL FOR MATERIAL STOCKPILES

Each roadway of a divided highway shall be barricaded in the same manner.

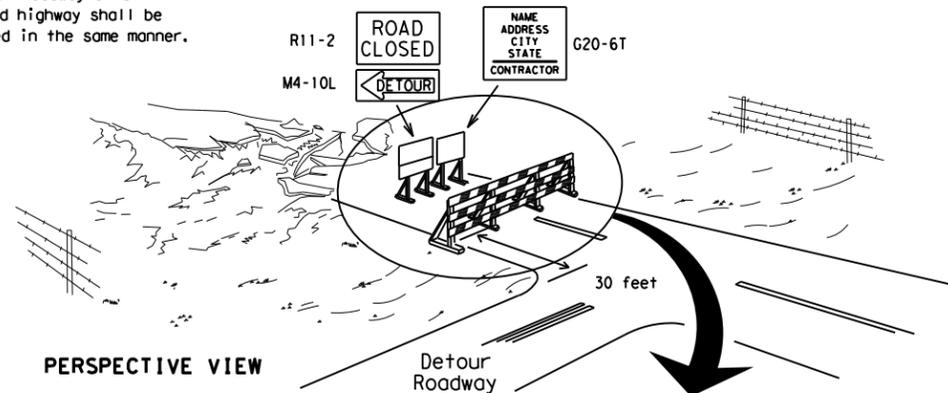

PERSPECTIVE VIEW


The three rails on Type 3 barricades shall be reflectorized orange and reflective white stripes on one side facing one-way traffic and both sides for two-way traffic. Barricade striping should slant downward in the direction of detour.

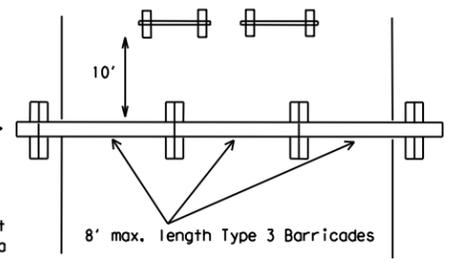


PLAN VIEW

1. Signs should be mounted on independent supports at a 7 foot mounting height in center of roadway. The signs should be a minimum of 10 feet behind Type 3 Barricades.
2. Advance signing shall be as specified elsewhere in the plans.

TYPE 3 BARRICADE (POST AND SKID) TYPICAL APPLICATION

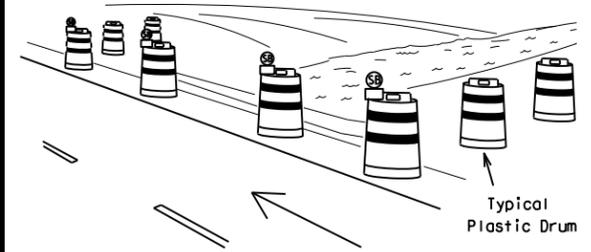


PERSPECTIVE VIEW

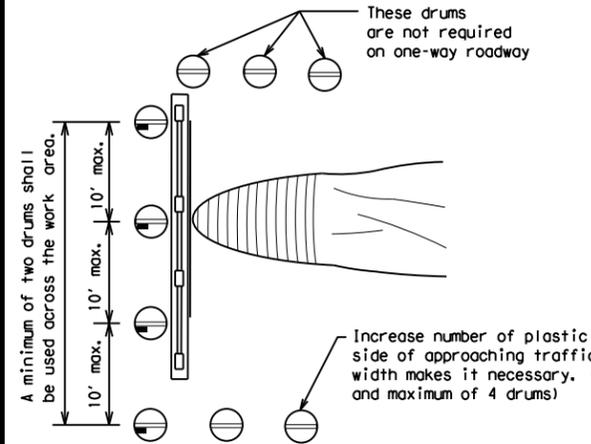

PLAN VIEW


CULVERT WIDENING OR OTHER ISOLATED WORK WITHIN THE PROJECT LIMITS

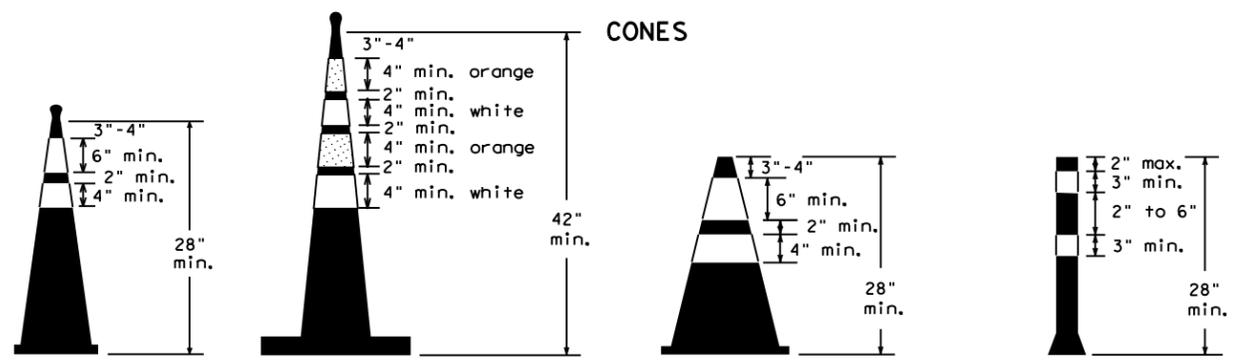

28" Cones shall have a minimum weight of 9 1/2 lbs.
 42" 2-piece cones shall have a minimum weight of 30 lbs. including base.

1. Traffic cones and tubular markers shall be predominantly orange, and meet the height and weight requirements shown above.
2. One-piece cones have the body and base of the cone molded in one consolidated unit. Two-piece cones have a cone shaped body and a separate rubber base, or ballast, that is added to keep the device upright and in place.
3. Two-piece cones may have a handle or loop extending up to 8" above the minimum height shown, in order to aid in retrieving the device.
4. Cones or tubular markers used at night shall have white or white and orange reflective bands as shown above. The reflective bands shall have a smooth, sealed outer surface and meet the requirements of Departmental Material Specification DMS-8300 Type A.
5. 28" cones and tubular markers are generally suitable for short duration and short-term stationary work as defined on BC(4). These should not be used for intermediate-term or long-term stationary work unless personnel is on-site to maintain them in their proper upright position.
6. 42" two-piece cones, vertical panels or drums are suitable for all work zone durations.
7. Cones or tubular markers used on each project should be of the same size and shape.

THIS DEVICE SHALL NOT BE USED ON PROJECTS LET AFTER MARCH 2014.

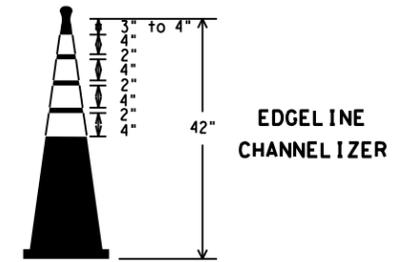

EDGE LINE CHANNELIZER

1. This device is intended only for use in place of a vertical panel to channelize traffic by indicating the edge of the travel lane. It is not intended to be used in transitions or tapers.
2. This device shall not be used to separate lanes of traffic (opposing or otherwise) or warn of objects.
3. This device is based on a 42 inch, two-piece cone with an alternate striping pattern: four 4 inch retroreflective bands, with an approximate 2 inch gap between bands. The color of the band should correspond to the color of the edgeline (yellow for left edgeline, white for right edgeline) for which the device is substituted or for which it supplements. The reflectorized bands shall be retroreflective Type A conforming to Departmental Material Specification DMS-8300, unless otherwise noted.
4. The base must weigh a minimum of 30 lbs.

SHEET 10 OF 12

Texas Department of Transportation Traffic Operations Division Standard

BARRICADE AND CONSTRUCTION CHANNELIZING DEVICES

BC (10) - 14

FILE: bc-14.dgn	DN: TxDOT	CK: TxDOT	DW: TxDOT	CR: TxDOT
© TxDOT November 2002	CONT	SECT	JOB	HIGHWAY
REVISIONS	0169	07	053, ETC	US60
9-07 8-14	DIST	COUNTY	SHEET NO.	
7-13	AMA	GRAY	44	

WORK ZONE PAVEMENT MARKINGS

GENERAL

- The Contractor shall be responsible for maintaining work zone and existing pavement markings, in accordance with the standard specifications and special provisions, on all roadways open to traffic within the CSJ limits unless otherwise stated in the plans.
- Color, patterns and dimensions shall be in conformance with the "Texas Manual on Uniform Traffic Control Devices" (TMUTCD).
- Additional supplemental pavement marking details may be found in the plans or specifications.
- Pavement markings shall be installed in accordance with the TMUTCD and as shown on the plans.
- When short term markings are required on the plans, short term markings shall conform with the TMUTCD, the plans and details as shown on the Standard Plan Sheet WZ(STPM).
- When standard pavement markings are not in place and the roadway is opened to traffic, DO NOT PASS signs shall be erected to mark the beginning of the sections where passing is prohibited and PASS WITH CARE signs at the beginning of sections where passing is permitted.
- All work zone pavement markings shall be installed in accordance with Item 662, "Work Zone Pavement Markings."

RAISED PAVEMENT MARKERS

- Raised pavement markers are to be placed according to the patterns on BC(12).
- All raised pavement markers used for work zone markings shall meet the requirements of Item 672, "RAISED PAVEMENT MARKERS" and Departmental Material Specification DMS-4200 or DMS-4300.

PREFABRICATED PAVEMENT MARKINGS

- Removable prefabricated pavement markings shall meet the requirements of DMS-8241.
- Non-removable prefabricated pavement markings (foil back) shall meet the requirements of DMS-8240.


MAINTAINING WORK ZONE PAVEMENT MARKINGS

- The Contractor will be responsible for maintaining work zone pavement markings within the work limits.
- Work zone pavement markings shall be inspected in accordance with the frequency and reporting requirements of work zone traffic control device inspections as required by Form 599.
- The markings should provide a visible reference for a minimum distance of 300 feet during normal daylight hours and 160 feet when illuminated by automobile low-beam headlights at night, unless sight distance is restricted by roadway geometrics.
- Markings failing to meet this criteria within the first 30 days after placement shall be replaced at the expense of the Contractor as per Specification Item 662.

REMOVAL OF PAVEMENT MARKINGS

- Pavement markings that are no longer applicable, could create confusion or direct a motorist toward or into the closed portion of the roadway shall be removed or obliterated before the roadway is opened to traffic.
- The above shall not apply to detours in place for less than three days, where flaggers and/or sufficient channelizing devices are used in lieu of markings to outline the detour route.
- Pavement markings shall be removed to the fullest extent possible, so as not to leave a discernable marking. This shall be by any method approved by TxDOT Specification Item 677 for "Eliminating Existing Pavement Markings and Markers".
- The removal of pavement markings may require resurfacing or seal coating portions of the roadway as described in Item 677.
- Subject to the approval of the Engineer, any method that proves to be successful on a particular type pavement may be used.
- Blast cleaning may be used but will not be required unless specifically shown in the plans.
- Over-painting of the markings SHALL NOT BE permitted.
- Removal of raised pavement markers shall be as directed by the Engineer.
- Removal of existing pavement markings and markers will be paid for directly in accordance with Item 677, "ELIMINATING EXISTING PAVEMENT MARKINGS AND MARKERS," unless otherwise stated in the plans.
- Black-out marking tape may be used to cover conflicting existing markings for periods less than two weeks when approved by the Engineer.

Temporary Flexible-Reflective Roadway Marker Tabs

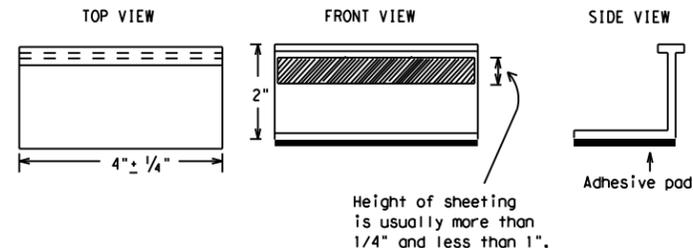

**STAPLES OR NAILS SHALL NOT BE USED TO SECURE
TEMPORARY FLEXIBLE-REFLECTIVE ROADWAY MARKER
TABS TO THE PAVEMENT SURFACE**

- Temporary flexible-reflective roadway marker tabs used as guidemarks shall meet the requirements of DMS-8242.
- Tabs detailed on this sheet are to be inspected and accepted by the Engineer or designated representative. Sampling and testing is not normally required, however at the option of the Engineer, either "A" or "B" below may be imposed to assure quality before placement on the roadway.
 - Select five (5) or more tabs at random from each lot or shipment and submit to the Construction Division, Materials and Pavement Section to determine specification compliance.
 - Select five (5) tabs and perform the following test. Affix five (5) tabs at 24 inch intervals on an asphaltic pavement in a straight line. Using a medium size passenger vehicle or pickup, run over the markers with the front and rear tires at a speed of 35 to 40 miles per hour, four (4) times in each direction. No more than one (1) out of the five (5) reflective surfaces shall be lost or displaced as a result of this test.
- Small design variances may be noted between tab manufacturers.
- See Standard Sheet WZ(STPM) for tab placement on new pavements. See Standard Sheet TCP(7-1) for tab placement on seal coat work.

RAISED PAVEMENT MARKERS USED AS GUIDEMARKS

- Raised pavement markers used as guidemarks shall be from the approved product list, and meet the requirements of DMS-4200.
- All temporary construction raised pavement markers provided on a project shall be of the same manufacturer.
- Adhesive for guidemarks shall be bituminous material hot applied or butyl rubber pad for all surfaces, or thermoplastic for concrete surfaces.

Guidemarks shall be designated as:
 YELLOW - (two amber reflective surfaces with yellow body).
 WHITE - (one silver reflective surface with white body).

DEPARTMENTAL MATERIAL SPECIFICATIONS	
PAVEMENT MARKERS (REFLECTORIZED)	DMS-4200
TRAFFIC BUTTONS	DMS-4300
EPOXY AND ADHESIVES	DMS-6100
BITUMINOUS ADHESIVE FOR PAVEMENT MARKERS	DMS-6130
PERMANENT PREFABRICATED PAVEMENT MARKINGS	DMS-8240
TEMPORARY REMOVABLE, PREFABRICATED PAVEMENT MARKINGS	DMS-8241
TEMPORARY FLEXIBLE, REFLECTIVE ROADWAY MARKER TABS	DMS-8242

A list of prequalified reflective raised pavement markers, non-reflective traffic buttons, roadway marker tabs and other pavement markings can be found at the Material Producer List web address shown on BC(1).

SHEET 11 OF 12



BARRICADE AND CONSTRUCTION PAVEMENT MARKINGS

BC(11) - 14


FILE: bc-14.dgn	DN: TxDOT	CK: TxDOT	DW: TxDOT	CR: TxDOT
© TxDOT February 1998	CONT	SECT	JOB	HIGHWAY
REVISIONS		0169	07	053, ETC
2-98	9-07			US60
1-02	7-13	DIST	COUNTY	SHEET NO.
11-02	8-14	AMA	GRAY	45

DISCLAIMER: The use of this standard is governed by the "Texas Engineering Practice Act". No warranty of any kind is made by TxDOT for any purpose whatsoever. TxDOT assumes no responsibility for the conversion of this standard to other formats or for incorrect results or damages resulting from its use.
 DATE: 4/7/2021 7:26:30 AM
 FILE: F:\Projects\2019\11004.TxDOT_5x5_P&E\03_US60_Amarillo\ENGL\500-USTN\511.1-1-TCP\05-Standards\bc-14.dgn

PAVEMENT MARKING PATTERNS




REFLECTORIZED PAVEMENT MARKINGS - PATTERN A

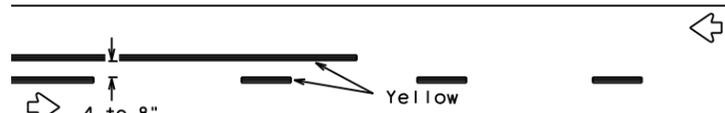


REFLECTORIZED PAVEMENT MARKINGS - PATTERN B

Pattern A is the TxDOT Standard, however Pattern B may be used if approved by the Engineer. Prefabricated markings may be substituted for reflectorized pavement markings.

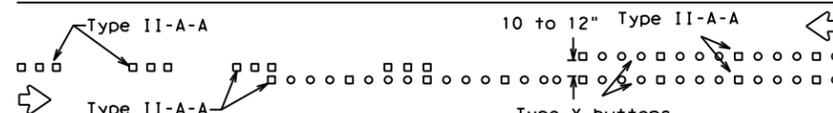


RAISED PAVEMENT MARKERS - PATTERN A

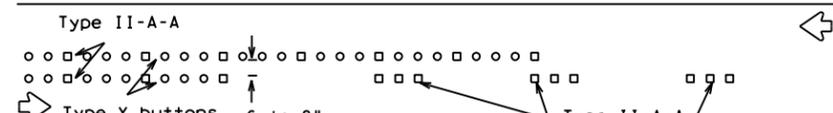


RAISED PAVEMENT MARKERS - PATTERN B

CENTER LINE & NO-PASSING ZONE BARRIER LINES FOR TWO-LANE, TWO-WAY HIGHWAYS

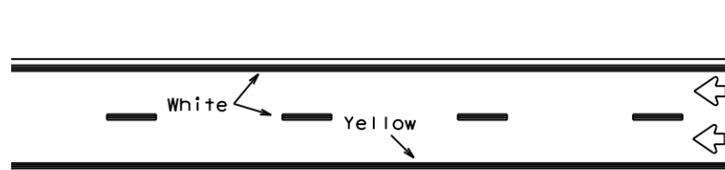

REFLECTORIZED PAVEMENT MARKINGS

Prefabricated markings may be substituted for reflectorized pavement markings.

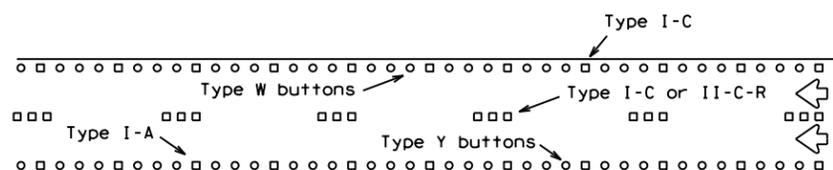


RAISED PAVEMENT MARKERS

EDGE & LANE LINES FOR DIVIDED HIGHWAY




REFLECTORIZED PAVEMENT MARKINGS

Prefabricated markings may be substituted for reflectorized pavement markings.

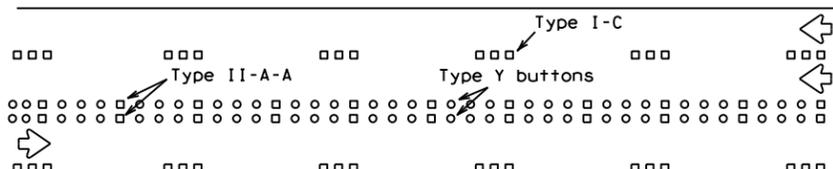


RAISED PAVEMENT MARKERS

LANE & CENTER LINES FOR MULTILANE UNDIVIDED HIGHWAYS

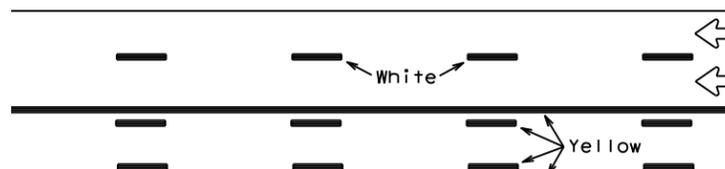

REFLECTORIZED PAVEMENT MARKINGS


Prefabricated markings may be substituted for reflectorized pavement markings.

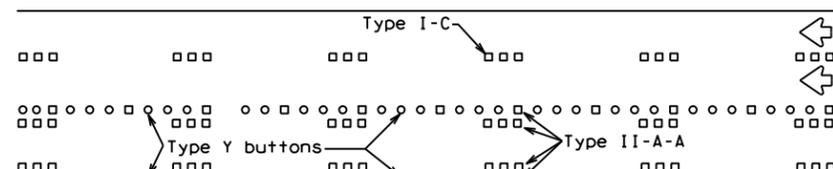




RAISED PAVEMENT MARKERS

TWO-WAY LEFT TURN LANE


STANDARD WORK ZONE PAVEMENT MARKINGS DETAILS

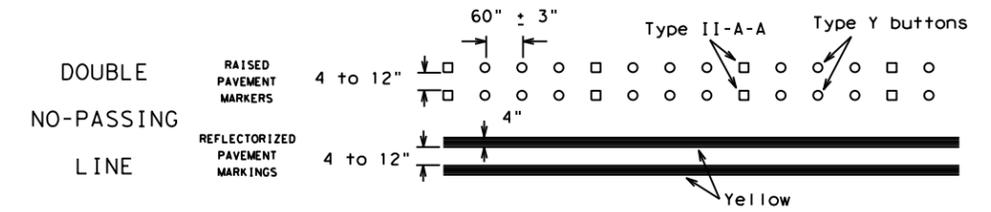

SOLID LINES

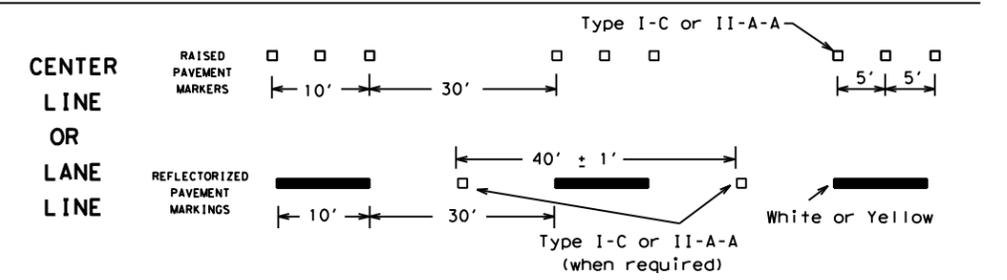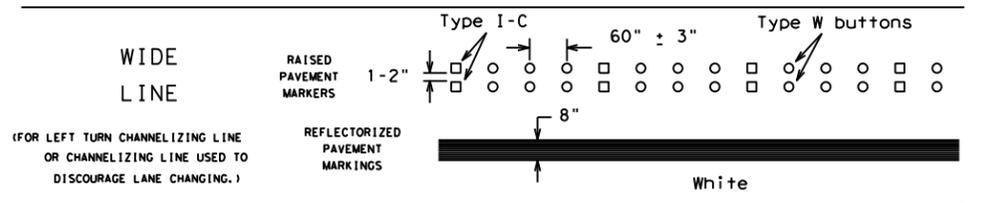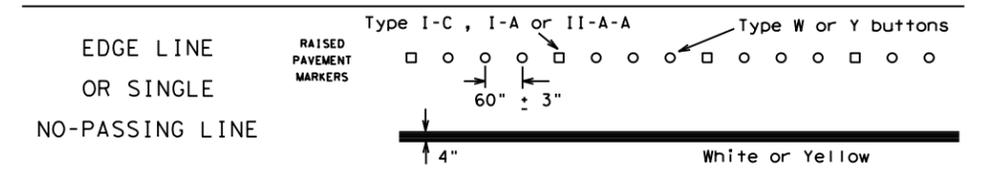


BROKEN LINES

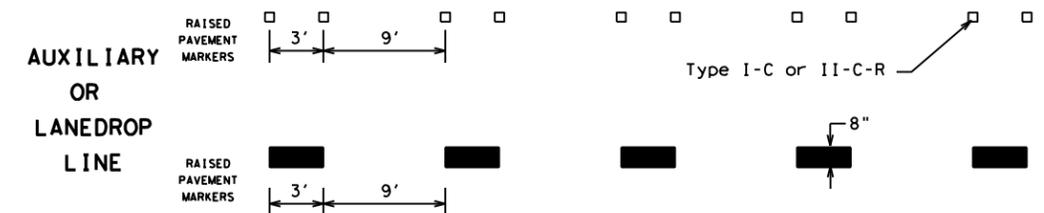

REMOVABLE MARKINGS WITH RAISED PAVEMENT MARKERS

If raised pavement markers are used to supplement REMOVABLE markings, the markers shall be applied to the top of the tape at the approximate mid length of tape used for broken lines or at 20 foot spacing for solid lines. This allows an easier removal of raised pavement markers and tape.

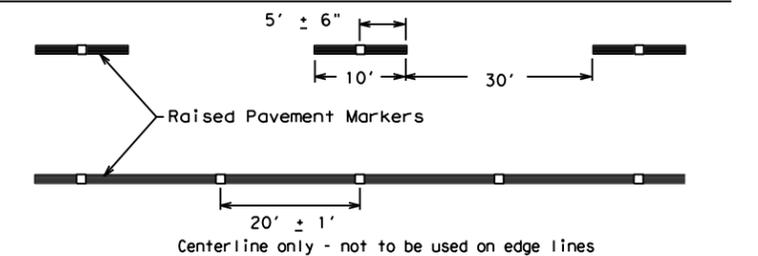

SHEET 12 OF 12



BARRICADE AND CONSTRUCTION PAVEMENT MARKING PATTERNS

BC(12)-14



FILE: bc-14.dgn	DN: TxDOT	CK: TxDOT	DW: TxDOT	CK: TxDOT
© TxDOT February 1998	CONT	SECT	JOB	HIGHWAY
REVISIONS	0169	07	053, ETC	US60
1-97 9-07	DIST	COUNTY	SHEET NO.	
2-98 7-13	AMA	GRAY	46	
11-02 8-14				

DISCLAIMER: The use of this standard is governed by the "Texas Engineering Practice Act". No warranty of any kind is made by TxDOT for any purpose whatsoever. TxDOT assumes no responsibility for the conversion of this standard to other formats or for incorrect results or damages resulting from its use.

DATE: 4/7/2021 7:26:30 AM
FILE: F:\Projects\2019\11004.TxDOT_5x5_PSE\03_US60_Amarillo\ENG\500-USTN\511.1-TCP\05-Standards\bc-14.dgn

DISCLAIMER: The use of this standard is governed by the "Texas Engineering Practice Act". No warranty of any kind is made by TxDOT for any purpose whatsoever. TxDOT assumes no responsibility for the conversion of units or for the use of this standard in any project. TxDOT is not responsible for incorrect results or damages resulting from its use.

DATE: 4/7/2021 7:26:31 AM
 FILE: F:\Projects\2019\11004.TxDOT_5x5_P&E\03_US60_Amarillo\ENG\500-USTN\501\T&E\2019\20190408\20190408.dgn

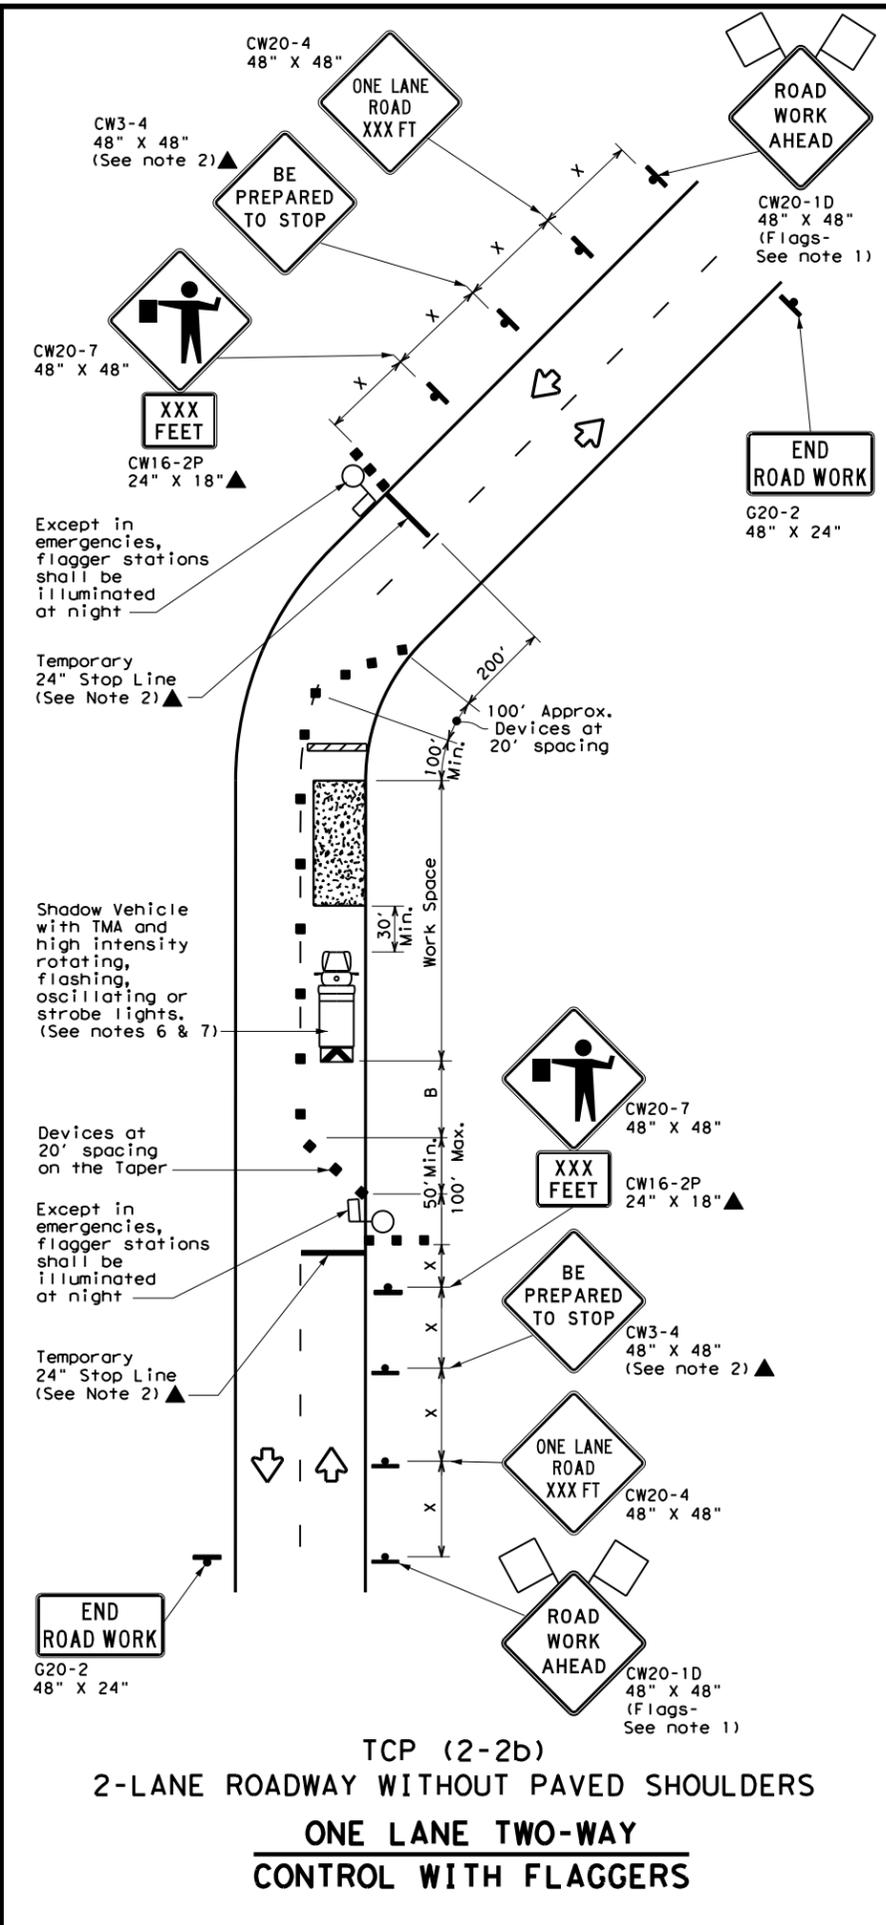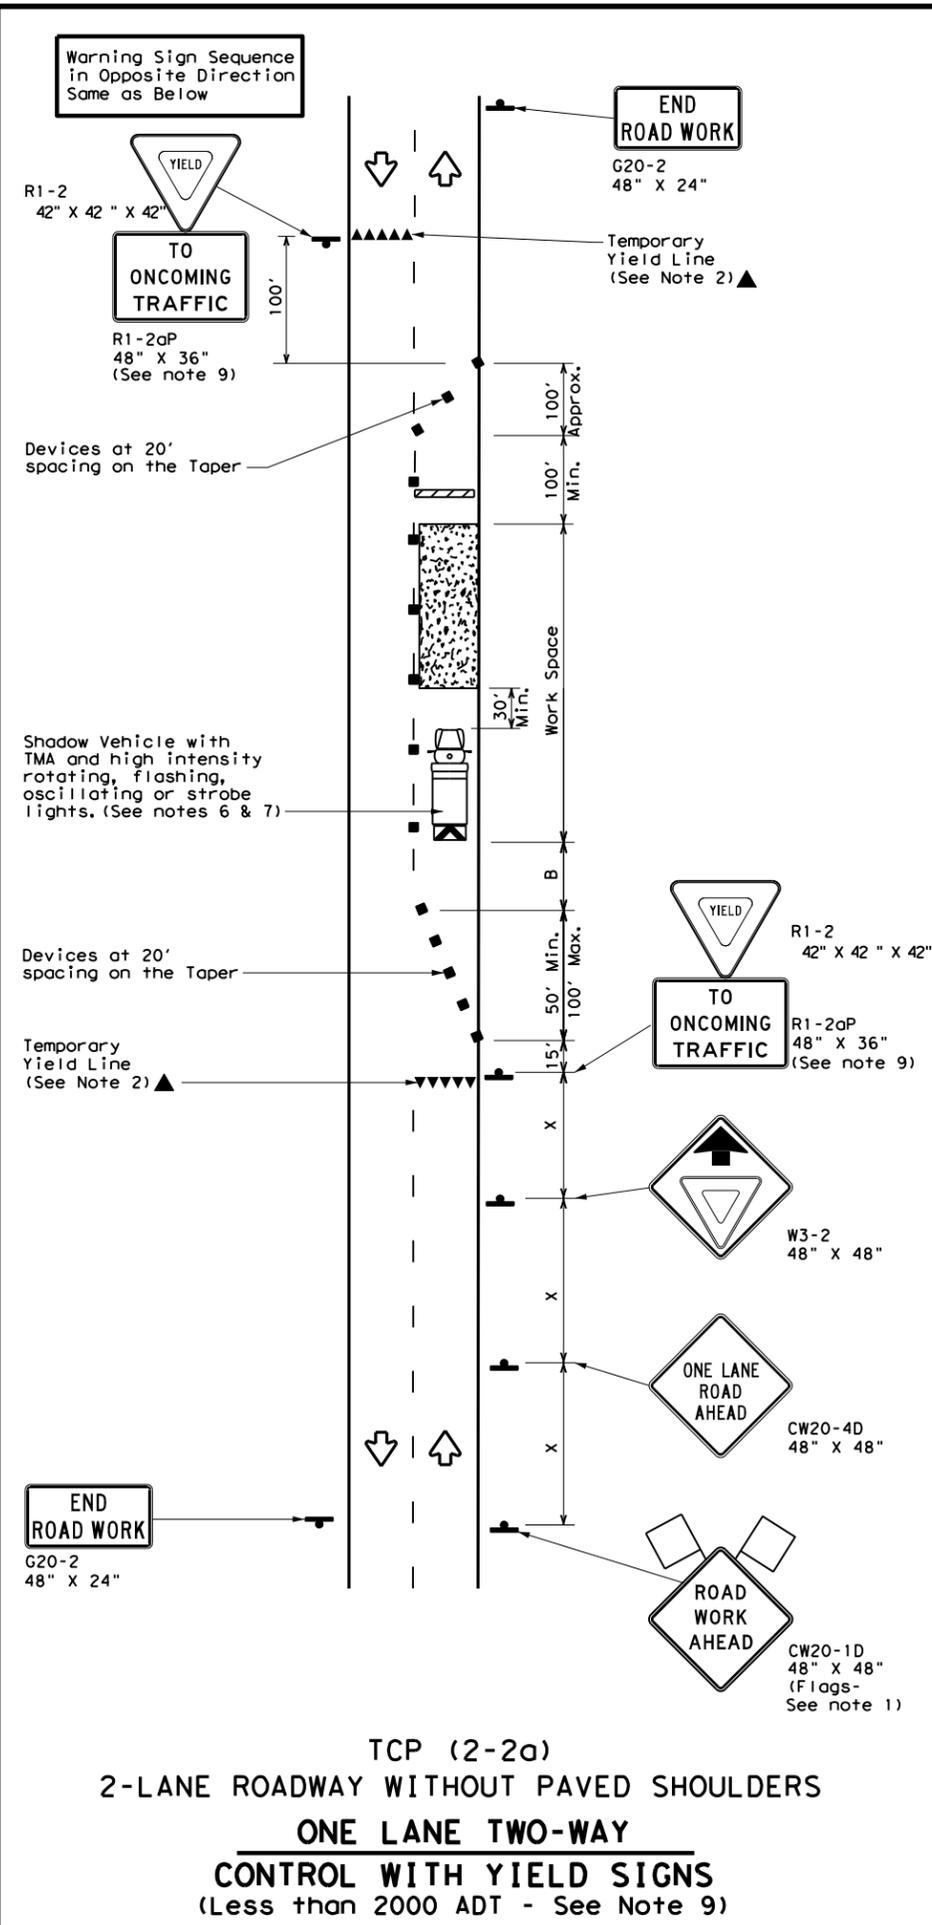

LEGEND

	Type 3 Barricade		Channelizing Devices
	Heavy Work Vehicle		Truck Mounted Attenuator (TMA)
	Trailer Mounted Flashing Arrow Board		Portable Changeable Message Sign (PCMS)
	Sign		Traffic Flow
	Flag		Flagger

Posted Speed *	Formula	Minimum Desirable Taper Lengths **			Suggested Maximum Spacing of Channelizing Devices		Minimum Sign Spacing "x" Distance	Suggested Longitudinal Buffer Space "B"	Stopping Sight Distance
		10' Offset	11' Offset	12' Offset	On a Taper	On a Tangent			
30	L = WS ² / 60	150'	165'	180'	30'	60'	120'	90'	200'
35		205'	225'	245'	35'	70'	160'	120'	250'
40		265'	295'	320'	40'	80'	240'	155'	305'
45	L = WS	450'	495'	540'	45'	90'	320'	195'	360'
50		500'	550'	600'	50'	100'	400'	240'	425'
55		550'	605'	660'	55'	110'	500'	295'	495'
60		600'	660'	720'	60'	120'	600'	350'	570'
65		650'	715'	780'	65'	130'	700'	410'	645'
70		700'	770'	840'	70'	140'	800'	475'	730'
75		750'	825'	900'	75'	150'	900'	540'	820'

* Conventional Roads Only
 ** Taper lengths have been rounded off.
 L=Length of Taper (FT) W=Width of Offset (FT) S=Posted Speed (MPH)

TYPICAL USAGE

	MOBILE	SHORT DURATION	SHORT TERM STATIONARY	INTERMEDIATE TERM STATIONARY	LONG TERM STATIONARY
		✓	✓	✓	

GENERAL NOTES

- Flags attached to signs where shown, are REQUIRED.
 - All traffic control devices illustrated are REQUIRED, except those denoted with the triangle symbol may be omitted when stated elsewhere in the plans, or for routine maintenance work, when approved by the Engineer.
 - The CW3-4 "BE PREPARED TO STOP" sign may be installed after the CW20-4 "ONE LANE ROAD XXX FT" sign, but proper sign spacing shall be maintained.
 - Flaggers should use two-way radios or other methods of communication to control traffic.
 - Length of work space should be based on the ability of flaggers to communicate.
 - A Shadow Vehicle with a TMA should be used anytime it can be positioned 30 to 100 feet in advance of the area of crew exposure without adversely affecting the performance or quality of the work. If workers are no longer present but road or work conditions require the traffic control to remain in place, Type 3 Barricades or other channelizing devices may be substituted for the Shadow Vehicle and TMA.
 - Additional Shadow Vehicles with TMAs may be positioned off the paved surface, next to those shown in order to protect a wider work space.
- TCP (2-2a)**
- The R1-2 "YIELD" sign traffic control may be used on projects with approaches that have adequate sight distance. For projects in urban areas, work space should be no longer than one half city block. In rural areas, roadways with less than 2000 ADT, work space should be no longer than 400 feet.
 - The R1-2aP "YIELD TO ONCOMING TRAFFIC" sign shall be placed on a support at a 7 foot minimum mounting height.
- TCP (2-2b)**
- Channelizing devices on the center line may be omitted when a pilot car is leading traffic and approved by the Engineer.
 - If the work space is located near a horizontal or vertical curve, the buffer distances should be increased in order to maintain stopping sight distance to the flagger and a queue of stopped vehicles. (See table above).
 - Flaggers should use 24" STOP/SLOW paddles to control traffic. Flags should be limited to emergency situations.

Texas Department of Transportation


TRAFFIC CONTROL PLAN
ONE-LANE TWO-WAY
TRAFFIC CONTROL

TCP (2-2) - 18


FILE:	tcp2-2-18.dgn	DN:		CK:		DW:		CK:	
© TxDOT	December 1985	CONT	SECT	JOB	HIGHWAY				
REVISIONS		0169	07	053, ETC	US60				
8-95	3-03			DIST	COUNTY	SHEET NO.			
1-97	2-12			AMA	GRAY	48			
4-98	2-18								

DISCLAIMER: The use of this standard is governed by the "Texas Engineering Practice Act". No warranty of any kind is made by TxDOT for any purpose whatsoever. TxDOT assumes no responsibility for the conversion of units or for the accuracy of the information provided. TxDOT is not responsible for any errors or omissions in this standard or for any damages resulting from its use.

DATE: 4/7/2021 7:26:32 AM
 FILE: F:\Projects\2019\11004.TxDOT_5x5_PS&E\03_US60_Amarillo\ENG\500-USTN\SP11\11004-11004.dgn

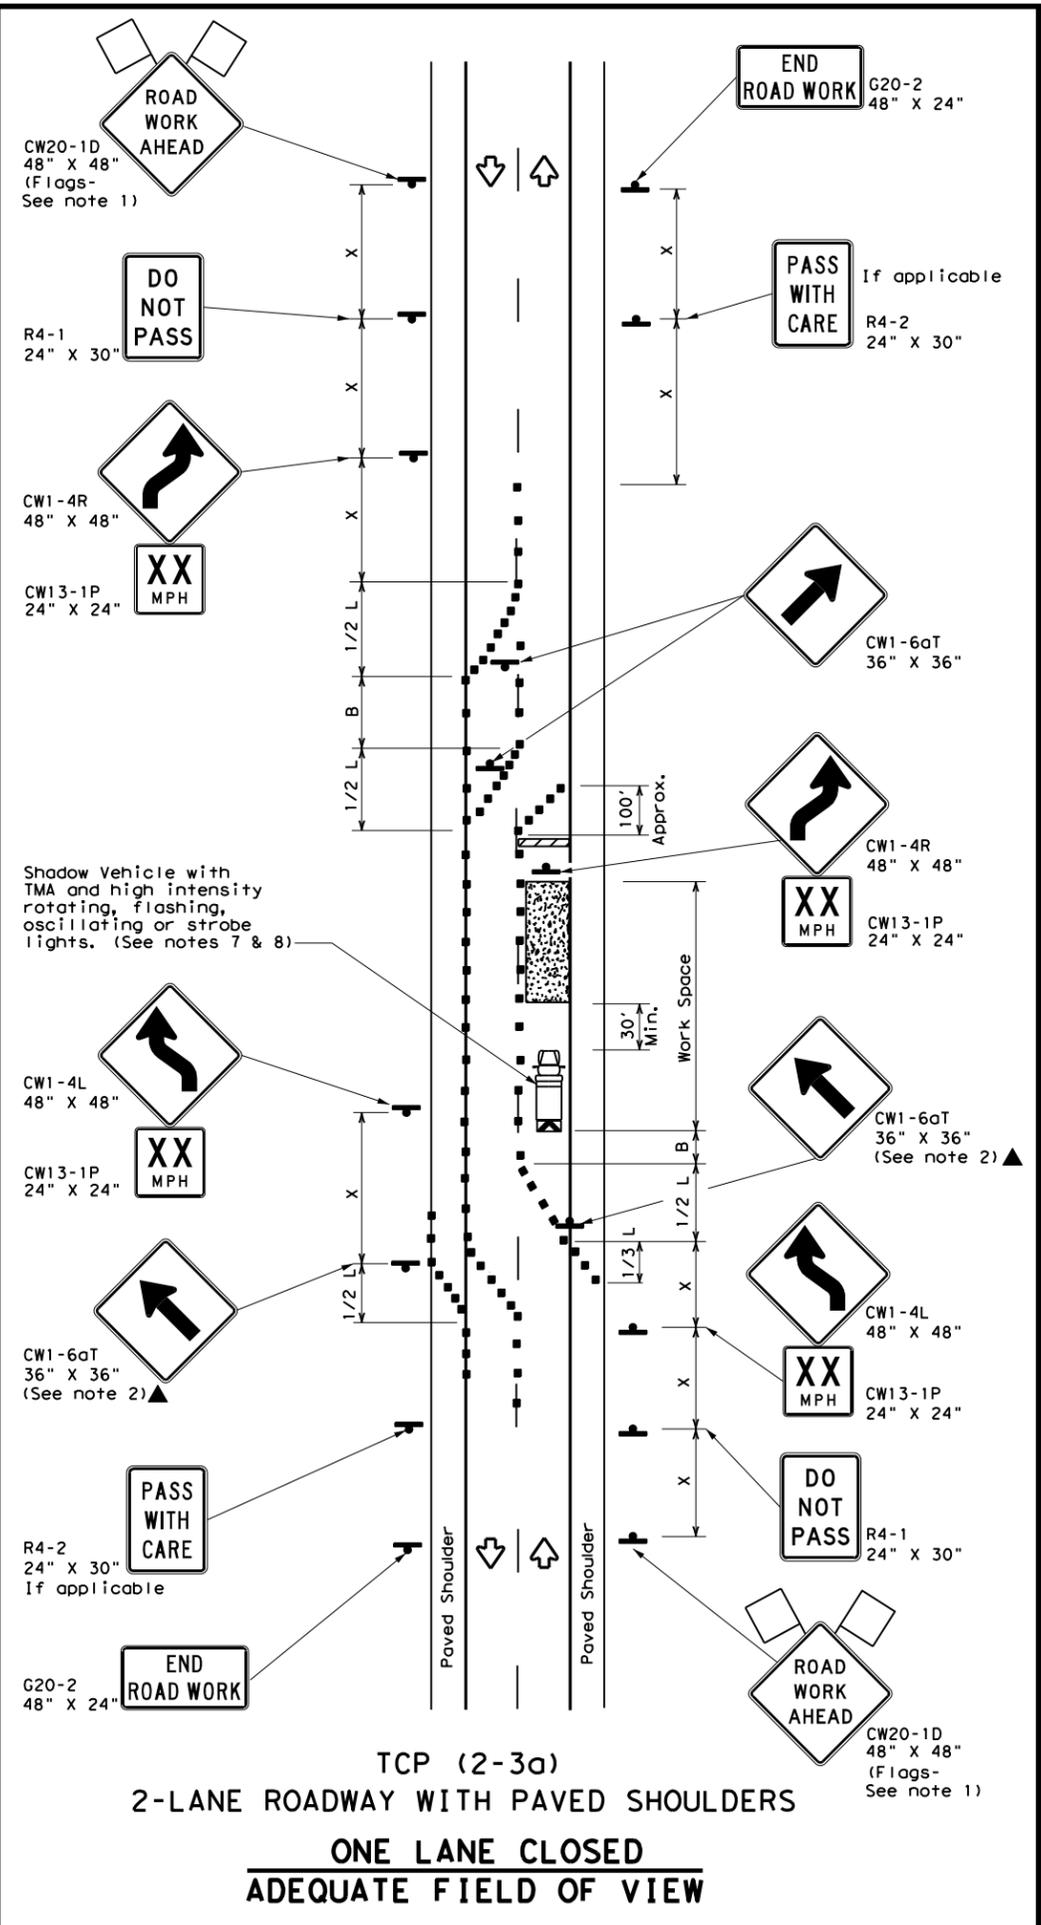

TCP (2-3a)
 2-LANE ROADWAY WITH PAVED SHOULDERS
 ONE LANE CLOSED
 ADEQUATE FIELD OF VIEW

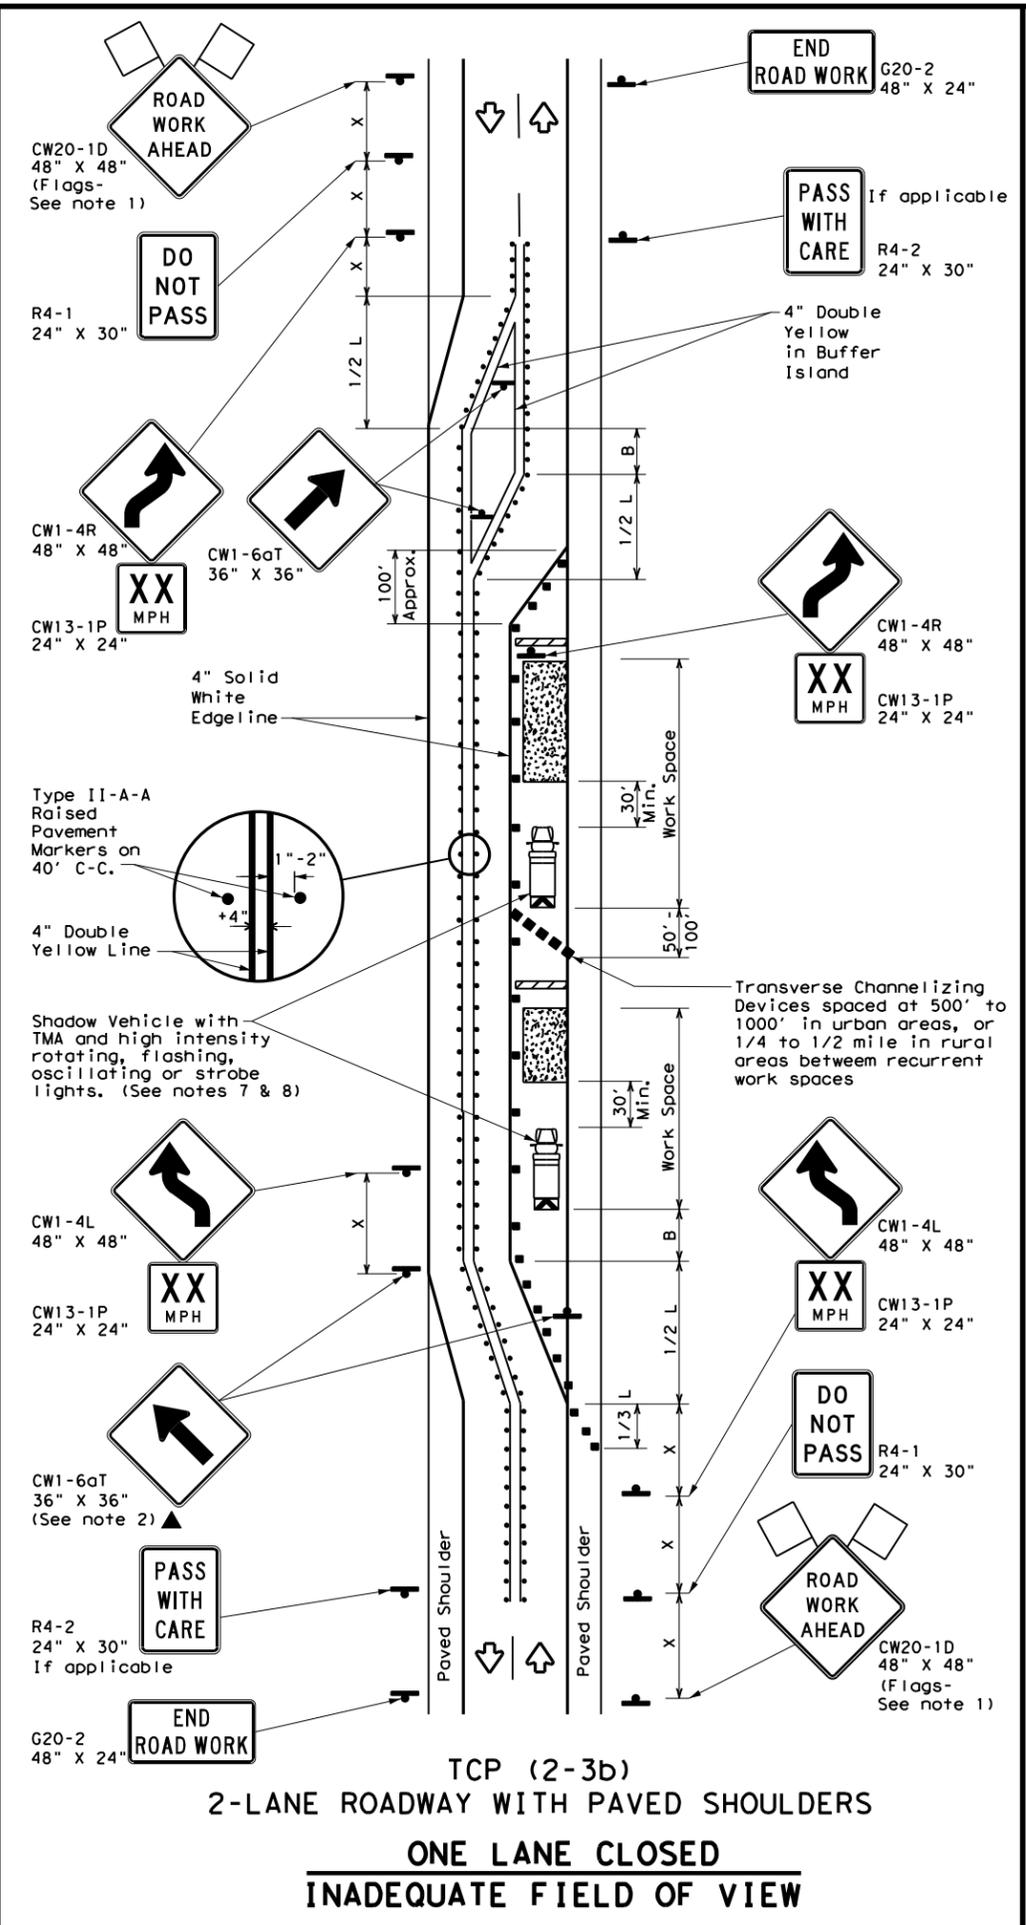

TCP (2-3b)
 2-LANE ROADWAY WITH PAVED SHOULDERS
 ONE LANE CLOSED
 INADEQUATE FIELD OF VIEW

LEGEND			
	Type 3 Barricade		Channelizing Devices
	Heavy Work Vehicle		Truck Mounted Attenuator (TMA)
	Trailer Mounted Flashing Arrow Board		Raised Pavement Markers Ty II-AA
	Sign		Traffic Flow
	Flag		Flagger

Posted Speed * X	Formula L = WS ² / 60	Minimum Desirable Taper Lengths **			Suggested Maximum Spacing of Channelizing Devices		Minimum Sign Spacing "x" Distance	Suggested Longitudinal Buffer Space "B"
		10' Offset	11' Offset	12' Offset	On a Taper	On a Tangent		
30	L = WS ² / 60	150'	165'	180'	30'	70'	120'	90'
35		205'	225'	245'	35'	80'	160'	120'
40		265'	295'	320'	40'	90'	240'	155'
45	L = WS	450'	495'	540'	45'	100'	320'	195'
50		500'	550'	600'	50'	110'	400'	240'
55		550'	605'	660'	55'	120'	500'	295'
60	L = WS	600'	660'	720'	60'	130'	600'	350'
65		650'	715'	780'	65'	140'	700'	410'
70		700'	770'	840'	70'	150'	800'	475'
75	L = WS	750'	825'	900'	75'	160'	900'	540'
75		750'	825'	900'	75'	150'	900'	540'

* Conventional Roads Only
 ** Taper lengths have been rounded off.
 L=Length of Taper (FT) W=Width of Offset (FT) S=Posted Speed (MPH)


TYPICAL USAGE				
MOBILE	SHORT DURATION	SHORT TERM STATIONARY	INTERMEDIATE TERM STATIONARY	LONG TERM STATIONARY
			✓	✓
				TCP (2-3b) ONLY

- GENERAL NOTES**
- Flags attached to signs where shown, are REQUIRED.
 - All traffic control devices illustrated are REQUIRED, except those denoted with the triangle symbol may be omitted when stated elsewhere in the plans, or for routine maintenance work, when approved by the Engineer.
 - When work space will be in place less than three days existing pavement markings may remain in place. Channelizing devices shall be used to separate traffic.
 - Flagger control should NOT be used unless roadway conditions or heavy traffic volume require additional emphasis to safely control traffic. Flagger should be positioned at end of traffic queue.
 - The R4-1 "DO NOT PASS," R4-2 "PASS WITH CARE" and construction regulatory speed zone signs may be installed within CW20-1D "ROAD WORK AHEAD" signs. Proper spacing of signs shall be maintained.
 - Conflicting pavement marking shall be removed for long term projects.
 - A Shadow Vehicle with a TMA should be used anytime it can be positioned 30 to 100 feet in advance of the area of crew exposure without adversely affecting the performance or quality of the work. If workers are no longer present but road or work conditions require the traffic control to remain in place, Type 3 Barricades or other channelizing devices may be substituted.
 - Additional Shadow Vehicles with TMAs may be positioned off the paved surface, next to those shown in order to protect a wider work space.
- TCP (2-3a)**
- Conflicting pavement markings shall be removed for long-term projects. For shorter durations where traffic is directed over a yellow centerline, channelizing devices which separate two-way traffic should be spaced on tapers at 20' or 15' if posted speeds are 35 mph or slower, and for tangent sections, at 1/2(S) where S is the speed in mph. This tighter device spacing is intended for the area of the conflicting markings, not the entire work zone.


		Traffic Operations Division Standard	
TRAFFIC CONTROL PLAN			
TRAFFIC SHIFTS ON			
TWO-LANE ROADS			
TCP (2-3) - 18			
FILE:	tcp(2-3)-18.dgn	DN:	CK:
© TxDOT	December 1985	CONT	SECT
REVISIONS		0169	07
8-95	3-03	JOB	
1-97	2-12	US60	
4-98	2-18	DIST	COUNTY
		AMA	GRAY
		SHEET NO.	
		49	

DISCLAIMER: The use of this standard is governed by the "Texas Engineering Practice Act". No warranty of any kind is made by TxDOT for any purpose whatsoever. TxDOT assumes no responsibility for the conversion of this standard to metric units or for any errors or omissions that may appear hereon.


DATE: 4/7/2021 7:26:32 AM
 FILE: F:\Projects\2019\11004.TxDOT_5x5_P&E\03_US60_Amarillo\ENG\500-USTN\SP1\T&E\CP\3-1.dgn

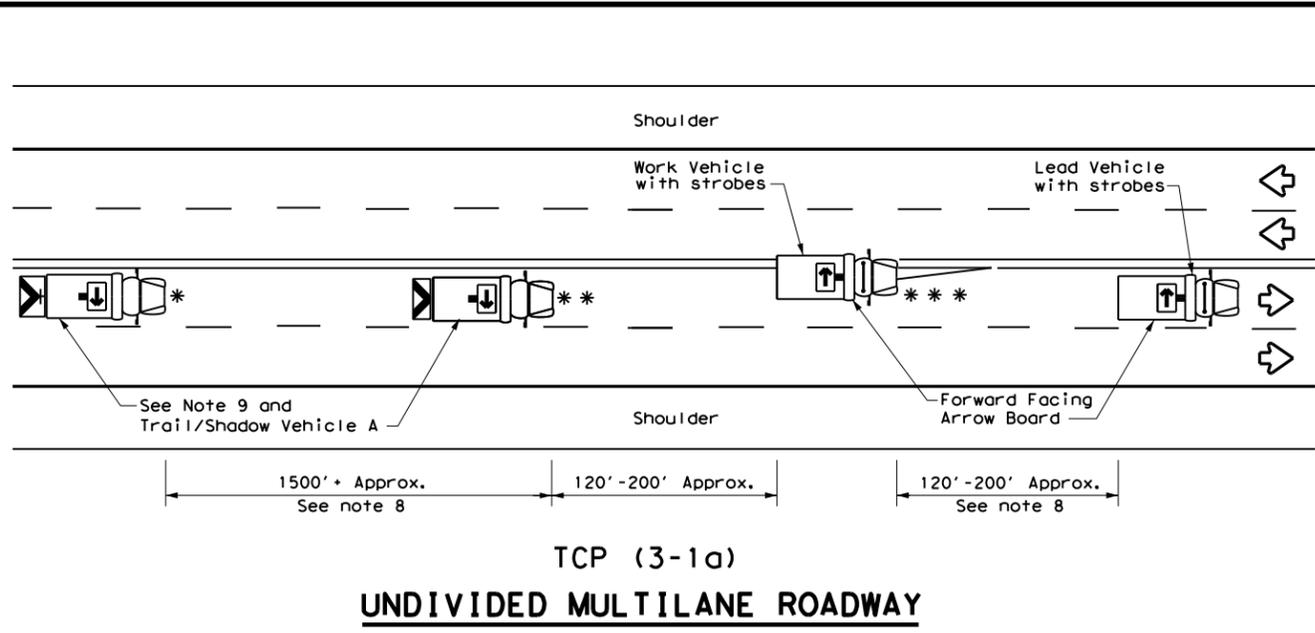


TCP (3-1a)
UNDIVIDED MULTILANE ROADWAY

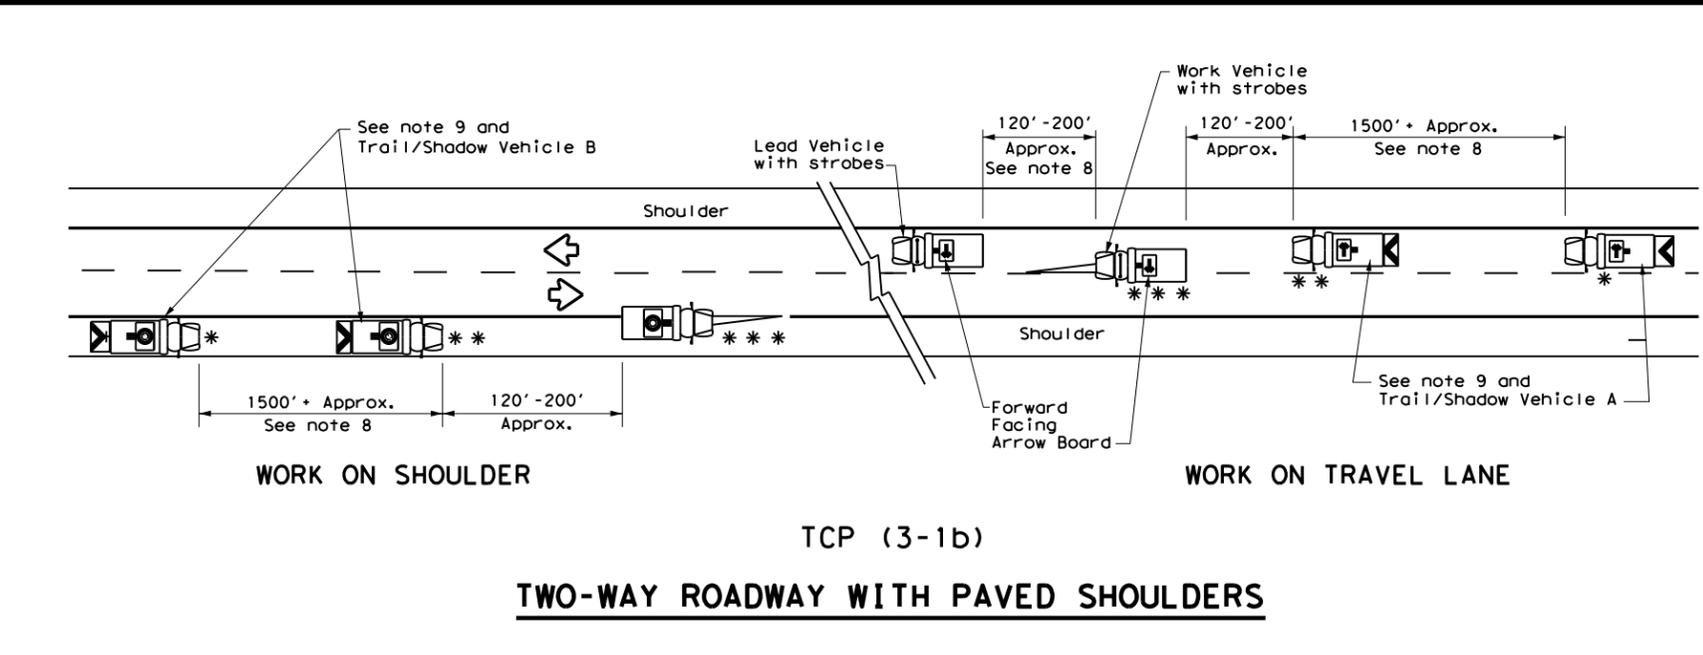


TCP (3-1b)
TWO-WAY ROADWAY WITH PAVED SHOULDERS

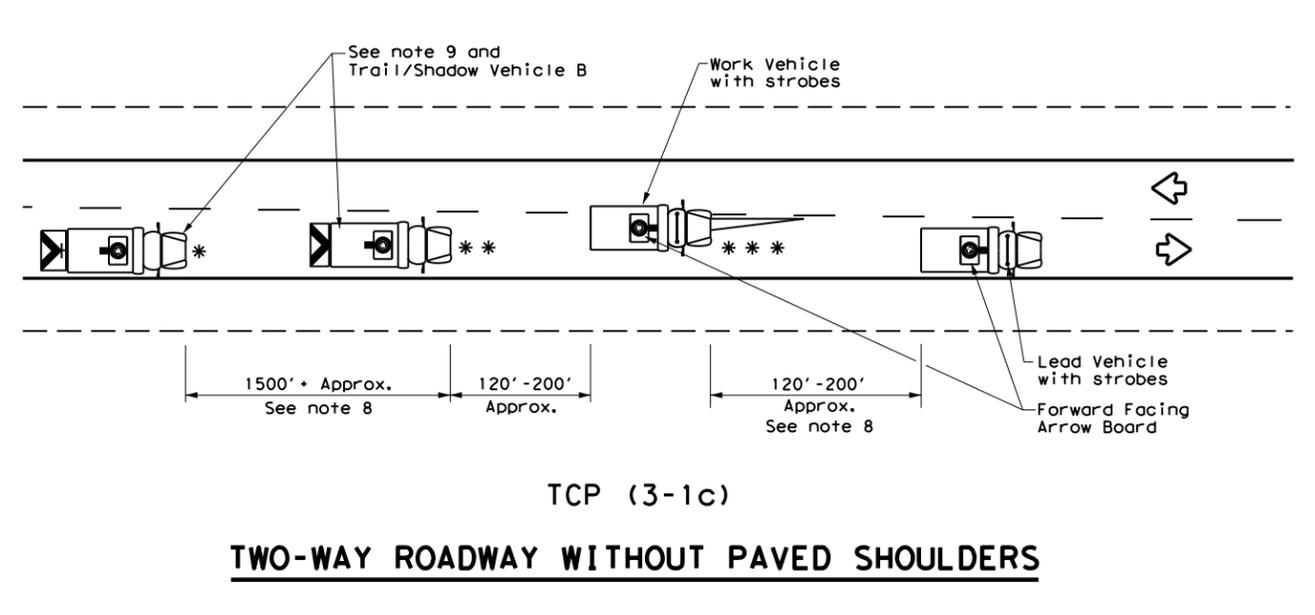

TCP (3-1c)
TWO-WAY ROADWAY WITHOUT PAVED SHOULDERS

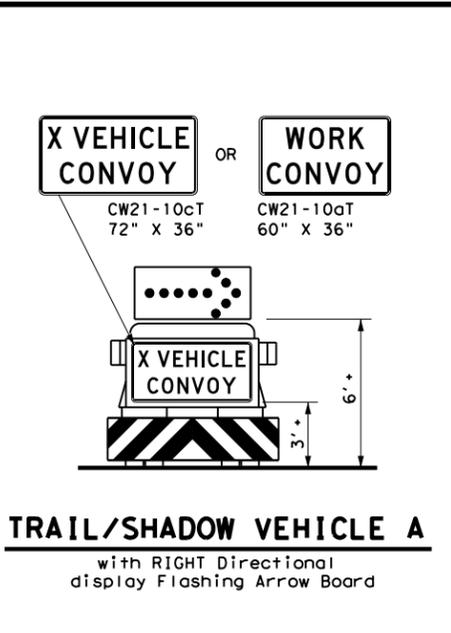

TRAIL/SHADOW VEHICLE A
 with RIGHT Directional display Flashing Arrow Board

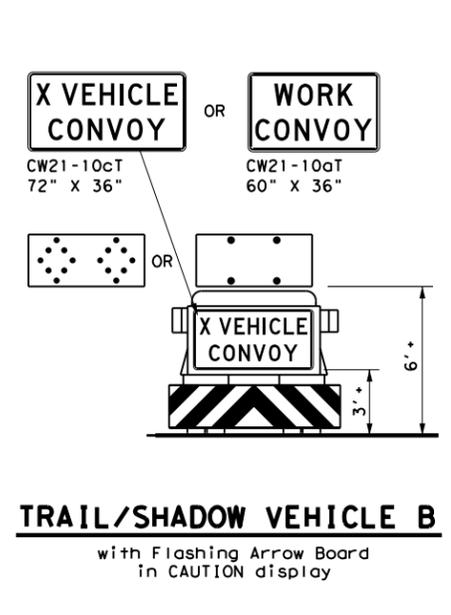


TRAIL/SHADOW VEHICLE B
 with Flashing Arrow Board in CAUTION display

LEGEND			
*	Trail Vehicle	ARROW BOARD DISPLAY	
**	Shadow Vehicle		
***	Work Vehicle		RIGHT Directional
	Heavy Work Vehicle		LEFT Directional
	Truck Mounted Attenuator (TMA)		Double Arrow
	Traffic Flow		CAUTION (Alternating Diamond or 4 Corner Flash)

TYPICAL USAGE				
MOBILE	SHORT DURATION	SHORT TERM STATIONARY	INTERMEDIATE TERM STATIONARY	LONG TERM STATIONARY
<input checked="" type="checkbox"/>	<input type="checkbox"/>	<input type="checkbox"/>	<input type="checkbox"/>	<input type="checkbox"/>

GENERAL NOTES

1. TRAIL, SHADOW, and LEAD vehicles shall be equipped with arrow boards as illustrated. When a LEAD vehicle is not used the WORK vehicle must be equipped with an arrow board. The Engineer will determine if the LEAD VEHICLE and/or TRAIL VEHICLE are required based on prevailing roadway conditions, traffic volume, and sight distance restrictions.
2. The use of amber high intensity rotating, flashing, oscillating, or strobe lights on vehicles are required. Blue high intensity rotating, flashing, oscillating or strobe lights when mounted on the driver's side of the vehicle may be operated simultaneously with the amber beacons or strobe lights.
3. The use of truck mounted attenuators (TMA) on the SHADOW VEHICLE and TRAIL VEHICLE are required.
4. Reflective sheeting on the rear of the TMA shall meet or exceed the reflectivity and color requirements of DEPARTMENTAL MATERIAL SPECIFICATION DMS 8300, Type A.
5. Flashing arrow boards shall be Type B or Type C as per the Barricade and Construction (BC) standards. The board shall be controlled from inside the vehicle.
6. Each vehicle shall have two-way radio communication capability.
7. When work convoys must change lanes, the TRAIL VEHICLE should change lanes first to shadow the other convoy vehicles.
8. Vehicle spacing between the TRAIL VEHICLE and the SHADOW VEHICLE will vary depending on sight distance restrictions. Motorists approaching the work convoy should be able to see the TRAIL VEHICLE in time to slow down and/or change lanes as they approach the TRAIL VEHICLE. Vehicle spacing between the WORK VEHICLE and SHADOW VEHICLE and vehicle spacing between WORK VEHICLE and LEAD VEHICLE may vary according to terrain, work activity and other factors.
9. "X VEHICLE CONVOY" (CW21-10cT) or "WORK CONVOY" (CW21-10aT) signs shall be used on TRAIL VEHICLES and SHADOW VEHICLES as shown. As an option 48" X 48" diamond shaped "WORK CONVOY" (CW21-10T) or "X VEHICLE CONVOY" (CW21-10bT) signs may be used where adequate mounting space exists. When used, the X VEHICLE CONVOY sign shall have the number of the convoy vehicles displayed on the sign in the number designation "X" location. The "X VEHICLE CONVOY" sign shall not be used on the SHADOW VEHICLE if a TRAIL VEHICLE is used.
10. On two-lane two-way roadways, the work and protection vehicles should pull over periodically to allow motor vehicle traffic to pass. If motorists are not allowed to pass the work convoy, a "DO NOT PASS" (R4-1) sign should be placed on the back of the rearmost protection vehicle.

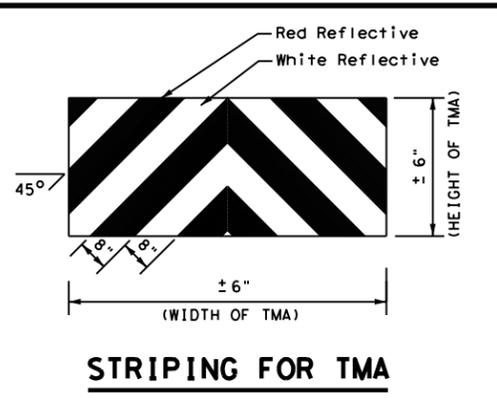

STRIPING FOR TMA


Texas Department of Transportation
 Traffic Operations Division Standard

**TRAFFIC CONTROL PLAN
 MOBILE OPERATIONS
 UNDIVIDED HIGHWAYS**


TCP (3-1) - 13

FILE:	tcp3-1.dgn	DN:	TxDOT	CK:	TxDOT	DW:	TxDOT	CK:	TxDOT
© TxDOT	December 1985	CONT:	SECT:	JOB:	HIGHWAY:				
REVISIONS		0169	07	053, ETC	US60				
2-94	4-98	DIST:	COUNTY:	SHEET NO.					
8-95	7-13	AMA	GRAY	50					
1-97									


DATE: 4/7/2021 7:26:33 AM
 FILE: F:\Projects\2019\11004.TxDOT_5x5_PS&E\03_US60_Amarillo\ENG\500-USTIN\SP1\TMS\CP\3-3.dgn
 The use of this standard is governed by the "Texas Engineering Practice Act". No warranty of any kind is made by TxDOT for any purpose whatsoever. TxDOT assumes no responsibility for the conversion of units or for the use of this standard for incorrect results or damages resulting from its use.

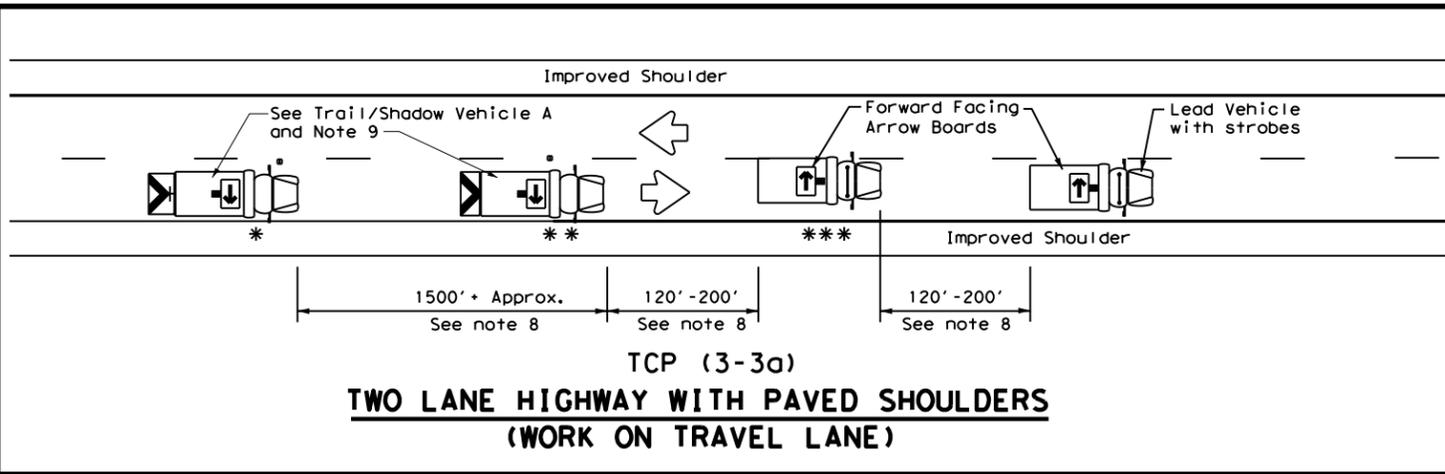


TCP (3-3a)
TWO LANE HIGHWAY WITH PAVED SHOULDERS
(WORK ON TRAVEL LANE)

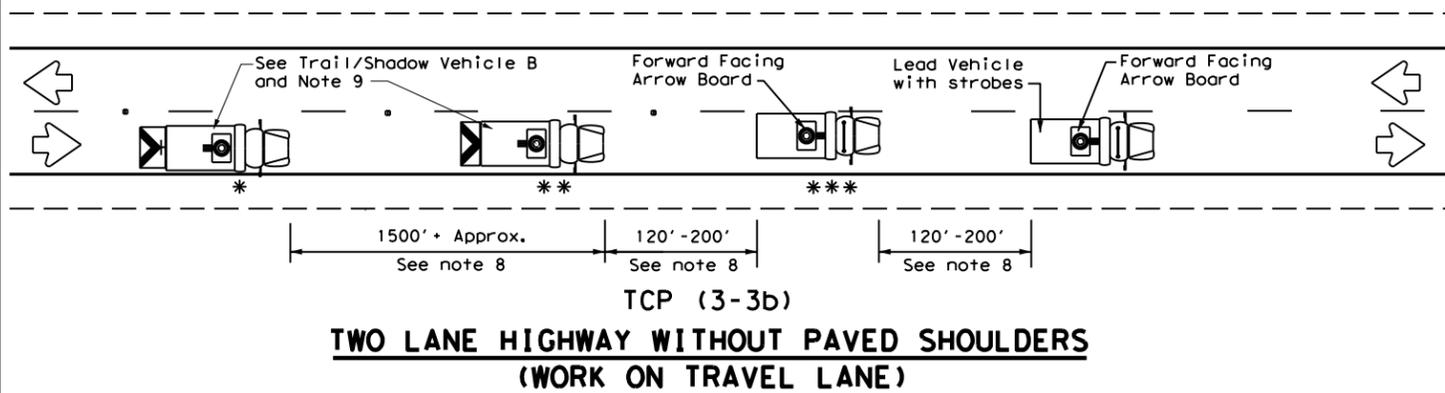


TCP (3-3b)
TWO LANE HIGHWAY WITHOUT PAVED SHOULDERS
(WORK ON TRAVEL LANE)

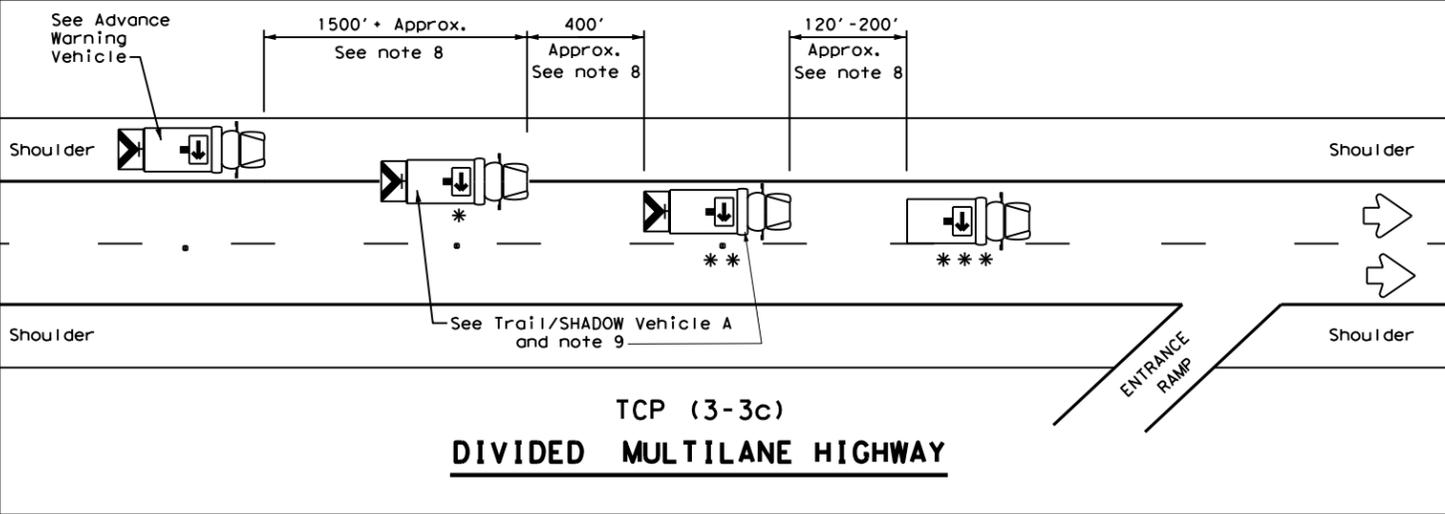


TCP (3-3c)
DIVIDED MULTILANE HIGHWAY

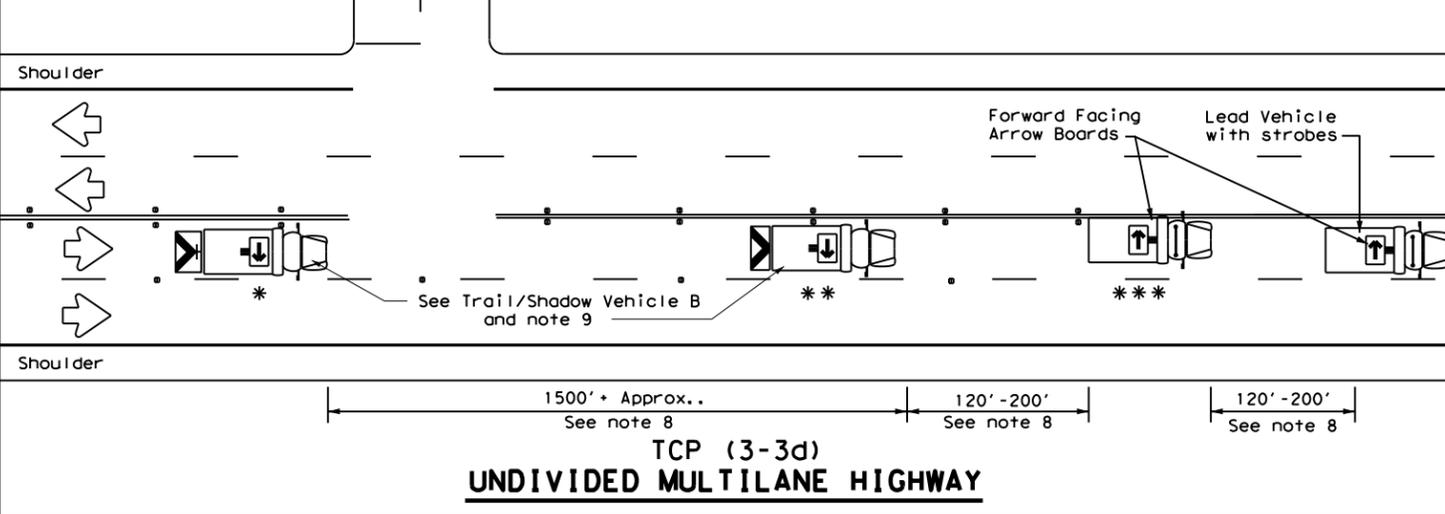


TCP (3-3d)
UNDIVIDED MULTILANE HIGHWAY

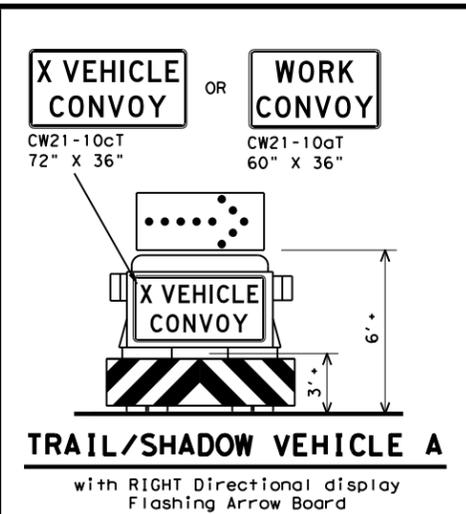


TRAIL/SHADOW VEHICLE A
 with RIGHT Directional display
 Flashing Arrow Board

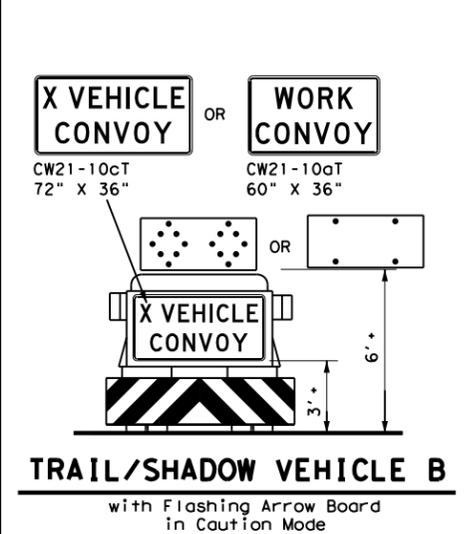

TRAIL/SHADOW VEHICLE B
 with Flashing Arrow Board
 in Caution Mode

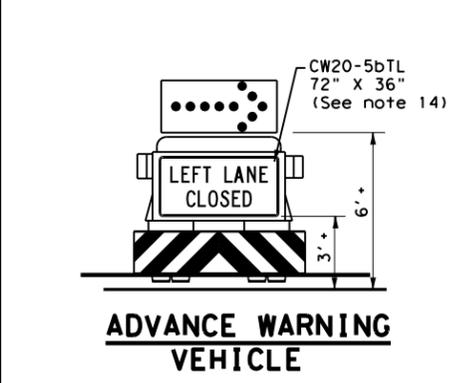

ADVANCE WARNING VEHICLE

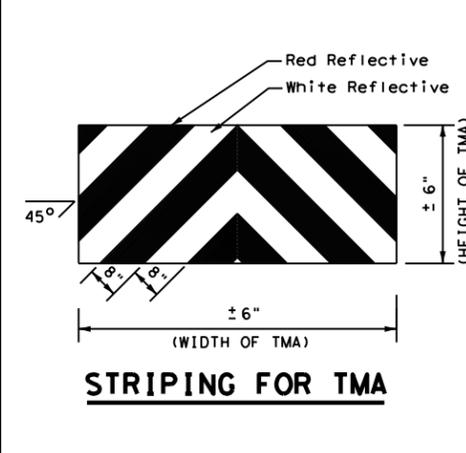

STRIPING FOR TMA

LEGEND		
* Trail Vehicle		ARROW BOARD DISPLAY
** Shadow Vehicle		
*** Work Vehicle		RIGHT Directional
Heavy Work Vehicle		LEFT Directional
Truck Mounted Attenuator (TMA)		Double Arrow
Traffic Flow		CAUTION (Alternating Diamond or 4 Corner Flash)

TYPICAL USAGE				
MOBILE	SHORT DURATION	SHORT TERM STATIONARY	INTERMEDIATE TERM STATIONARY	LONG TERM STATIONARY
<input checked="" type="checkbox"/>	<input type="checkbox"/>	<input type="checkbox"/>	<input type="checkbox"/>	<input type="checkbox"/>

GENERAL NOTES

1. TRAIL, SHADOW, and LEAD vehicles shall be equipped with arrow boards as illustrated. When a LEAD vehicle is not used on two way roads the WORK vehicle must have an arrow board. For divided roadways, the arrow board on the WORK vehicle is optional based on the type of work being performed. The Engineer will determine if the LEAD vehicle and/or TRAIL vehicle are required based on prevailing roadway conditions, traffic volume, and sight distance restrictions.
2. The use of amber high intensity rotating, flashing, oscillating, or strobe lights on vehicles are required. Blue high intensity rotating, flashing, oscillating, or strobe lights when mounted on the driver's side of the vehicle may be operated simultaneously with the amber beacons or strobe lights.
3. The use of truck mounted attenuators (TMA) on the SHADOW VEHICLE, ADVANCE WARNING and TRAIL VEHICLE are required.
4. Reflective sheeting on the rear of the TMA shall meet or exceed the reflectivity and color requirements of DEPARTMENTAL MATERIAL SPECIFICATION DMS 8300, Type A.
5. Flashing arrow boards shall be Type B or Type C as per the Barricade and Construction (BC) standards. The board shall be controlled from inside the vehicle.
6. Each vehicle shall have two-way radio communication capability.
7. When work convoys must change lanes, the TRAIL VEHICLE should change lanes first to shadow the other convoy vehicles.
8. Vehicle spacing between the TRAIL VEHICLE and the SHADOW VEHICLE will vary depending on sight distance restrictions. Motorists approaching the convoy should be able to see the TRAIL VEHICLE in time to slow down and/or change lanes as they approach the TRAIL VEHICLE. Vehicle spacing between the WORK VEHICLE and SHADOW VEHICLE and vehicle spacing between WORK VEHICLE and LEAD VEHICLE may vary according to terrain, work activity and other factors.
9. X VEHICLE CONVOY (CW21-10cT) or WORK CONVOY (CW21-10aT) signs shall be used on TRAIL VEHICLES and SHADOW VEHICLES as shown. As an option 48" x 48" diamond shaped WORK CONVOY (CW21-10T) or X VEHICLE CONVOY (CW21-10bT) signs may be used where adequate mounting space exists. When used, the X VEHICLE CONVOY sign shall have the number of the convoy vehicles displayed on the sign in the number designation "X" location. The X VEHICLE CONVOY sign shall not be used on the SHADOW VEHICLE if a TRAIL VEHICLE is used.
10. For divided highways with two or three lanes in one direction, the appropriate LEFT LANE CLOSED (CW20-5bTL), RIGHT LANE CLOSED (CW20-5bTR), or CENTER LANE CLOSED (CW20-5dT) sign should be used on the Advance Warning Vehicle. As an option, a portable changeable message sign (PCMS) or truck mounted changeable message sign (TMCMS) with a minimum character height of 12", and displaying the same legend may be substituted for these signs. An appropriate directional arrow display, simulating the size and legibility of the flashing arrow board may be used in the second phase of the PCMS/TMCMS message. When this is done, the arrow board will not be required on the Advance Warning Vehicle.
11. A double arrow shall not be displayed on the arrow board on the Advance Warning Vehicle.
12. For divided highways with three or four lanes in each direction, use TCP(3-2).
13. Standard diamond shape versions of the CW20-5 series signs may be used as an option if the rectangular signs shown are not available.
14. The Advance Warning Vehicle may straddle the edgeline when Shoulder width makes it necessary.
15. On two-lane two-way roadways, the work and protection vehicles should pull over periodically to allow motor vehicle traffic to pass. If motorists are not allowed to pass the work convoy, a DO NOT PASS (R4-1) sign should be placed on the back of the rearmost protection vehicle.

Texas Department of Transportation
 Traffic Operations Division Standard


TRAFFIC CONTROL PLAN
MOBILE OPERATIONS
RAISED PAVEMENT
MARKER INSTALLATION/
REMOVAL
TCP (3-3) - 14

FILE: tcp3-3.dgn	DN: TxDOT	CK: TxDOT	DW: TxDOT	CK: TxDOT
© TxDOT September 1987	CONT	SECT	JOB	HIGHWAY
REVISIONS	0169 07	053, ETC	US60	
2-94 4-98				
8-95 7-13	DIST	COUNTY	SHEET NO.	
1-97 7-14	AMA	GRAY	51	

DISCLAIMER: The use of this standard is governed by the "Texas Engineering Practice Act". No warranty of any kind is made by TxDOT for any purpose whatsoever. TxDOT assumes no responsibility for the conversion of units or for the accuracy of the information provided. TxDOT is not responsible for any errors or omissions or for any consequences arising from the use of this standard.

DATE: 4/7/2021 7:26:34 AM
 FILE: F:\Projects\2019\11004.TxDOT_5x5_PS&E_V03_US60_Amarillo.ENG.500-USTN.501.1111.ctb

WORK ZONE SHORT TERM PAVEMENT MARKINGS DETAILS

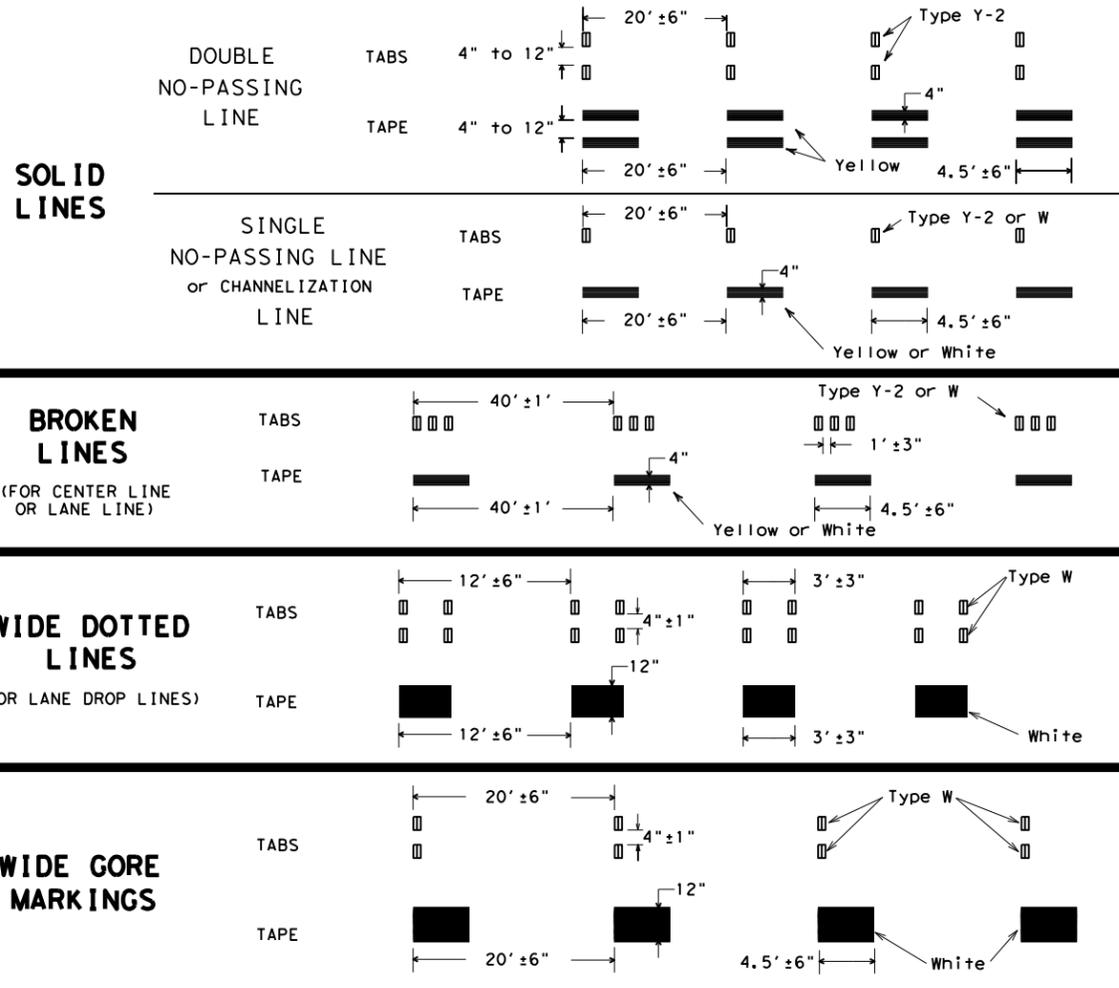



NOTES:

- Short term pavement markings may be prefabricated markings (stick down tape) or temporary flexible-reflective roadway marker tabs unless otherwise specified elsewhere in plans.
- Short term pavement markings shall NOT be used to simulate edge lines.
- Dimensions indicated on this sheet are typical and approximate. Variations in size and height may occur between markers or devices made by manufacturers, by as much as 1/4 inch, unless otherwise noted.
- Temporary flexible-reflective roadway marker tabs will require normal maintenance replacement when used on roadways with an ADT per lane of up to 7500 vehicles with no more than 10% truck mix. When roadways exceed these values, additional maintenance replacement of devices should be planned.
- No segment of roadway open to traffic shall remain without permanent pavement markings for a period greater than 14 calendar days. The Contractor will be responsible for maintaining short term pavement markings until permanent pavement markings are in place. When the Contractor is responsible for placement of permanent pavement markings, no segment of roadway shall remain without permanent pavement markings for a period greater than 14 calendar days unless weather conditions prohibit placement. Permanent pavement markings shall be placed as soon as weather permits.
- For two lane, two-way roadways, DO NOT PASS signs shall be erected to mark the beginning of sections where passing is prohibited and PASS WITH CARE signs shall be erected to mark the beginning of sections where passing is permitted. Signs shall be in accordance with the "Texas Manual on Uniform Traffic Control Devices" (TMUTCD) and may be used to indicate the limits of no-passing zones for up to 14 calendar days. Permanent pavement markings should then be placed.
- For low volume two lane, two-way roadways of 4000 ADT or less, no-passing lines may be omitted when approved by the Engineer. DO NOT PASS and PASS WITH CARE signs shall be erected (see note 6).
- For exit gores where a lane is being dropped place wide gore markings or retroreflective channelizing devices to guide motorist through the exit. If channelizing devices are to be used it should be noted elsewhere in the plans. One piece cones are not allowed for this purpose.

TEMPORARY FLEXIBLE, REFLECTIVE ROADWAY MARKER TABS (TABS)

- Temporary flexible-reflective roadway marker tabs detailed on this sheet will be designated Type Y-2 (two amber reflective surfaces with yellow body); Type Y (one amber reflective surface with yellow body); and Type W (one white or silver reflective surface with white body). Additional details may be found on BC(11).
- Tabs shall meet requirements of Departmental Material Specification DMS-8242.
- When dry, tabs shall be visible for a minimum distance of 200 feet during normal daylight hours and when illuminated by automobile low-beam head light at night, unless sight distance is restricted by roadway geometrics.
- No two consecutive tabs nor four tabs per 1000 feet of line shall be missing or fail to meet the visual performance requirements of Note 3.

WORK ZONE SHORT TERM PAVEMENT MARKINGS PATTERNS

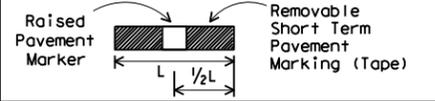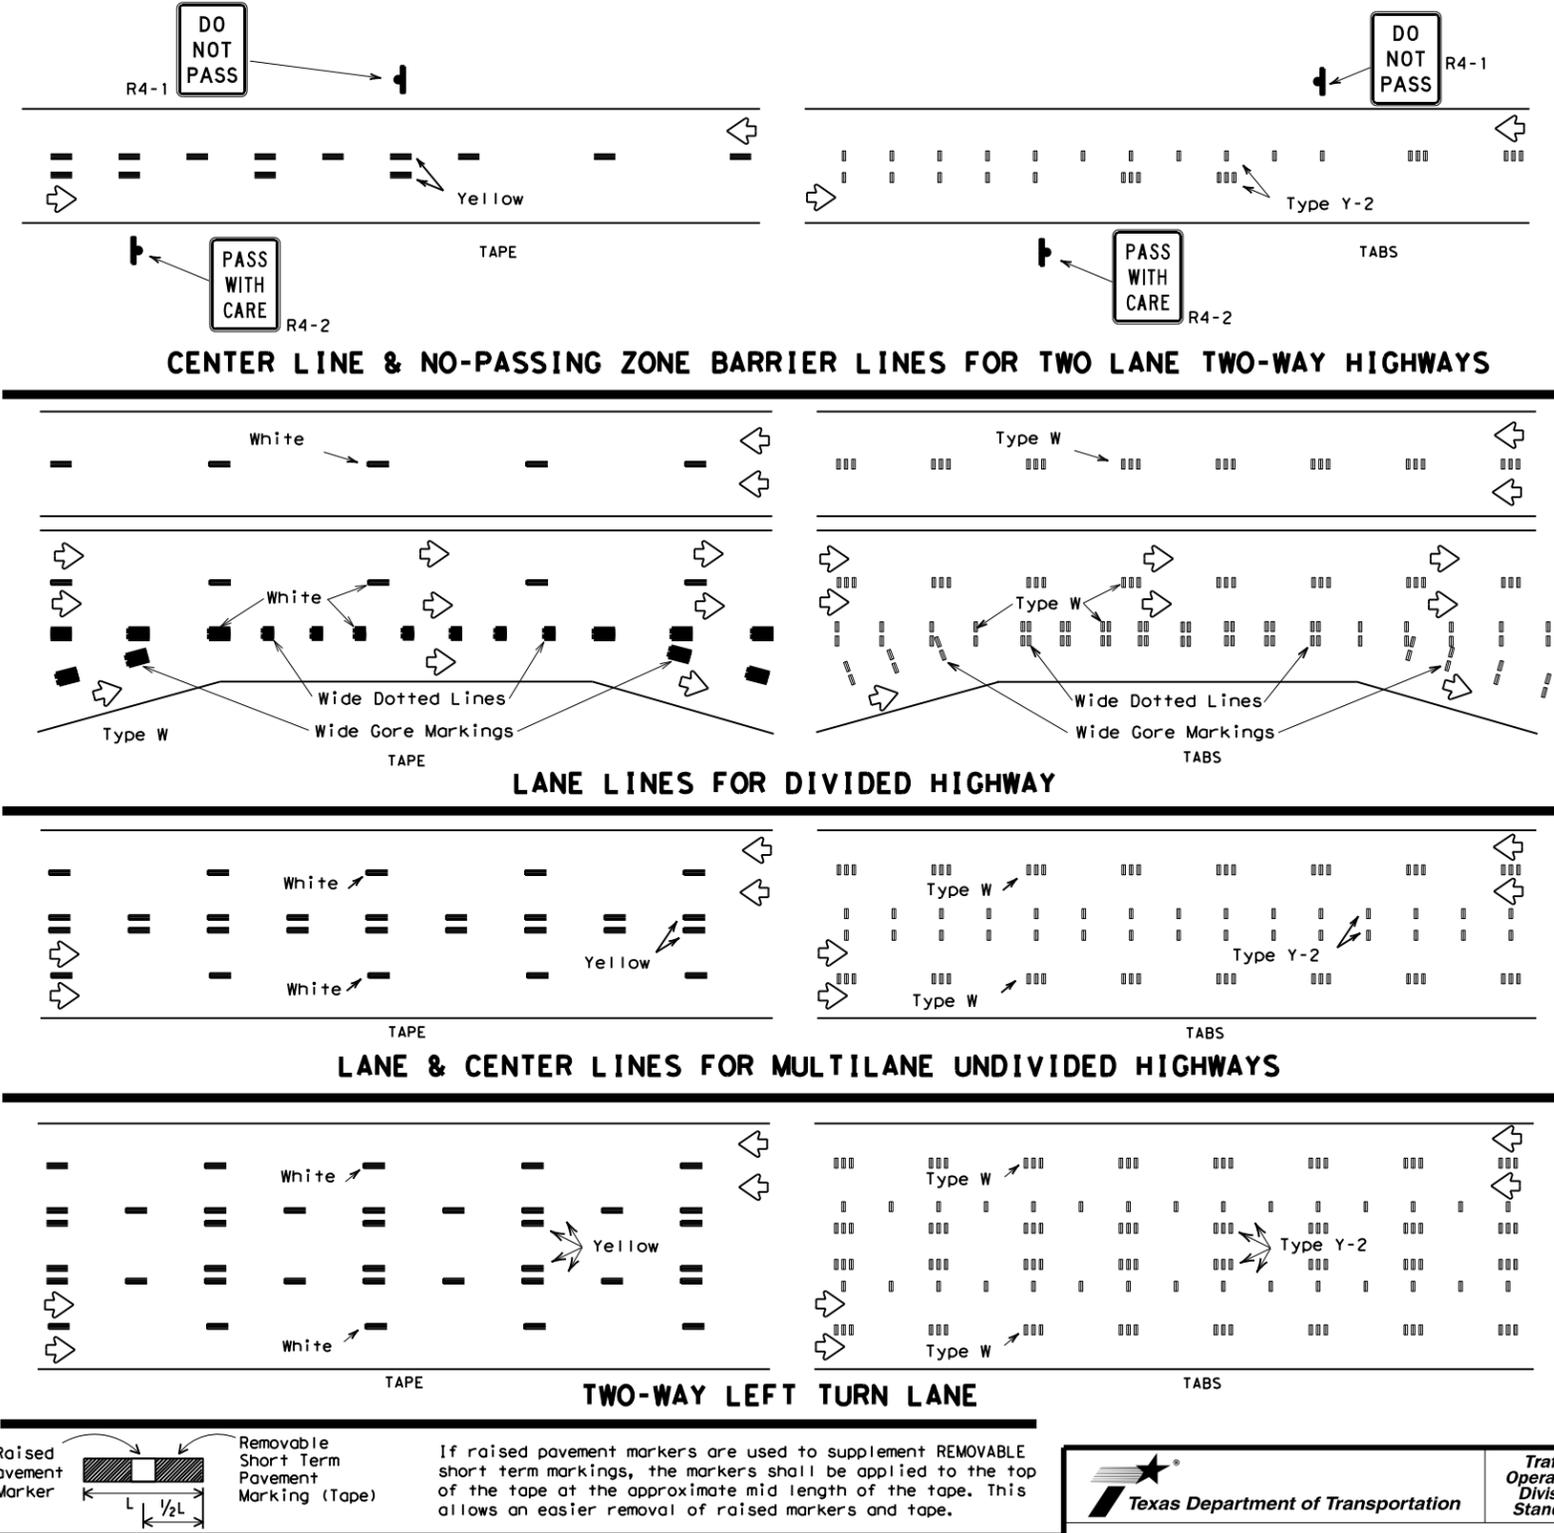

If raised pavement markers are used to supplement REMOVABLE short term markings, the markers shall be applied to the top of the tape at the approximate mid length of the tape. This allows an easier removal of raised markers and tape.

PREFABRICATED PAVEMENT MARKINGS

- Temporary Removable Prefabricated Pavement Markings shall meet the requirements of DMS-8241.
- Non-removable Prefabricated Pavement Markings shall meet the requirements of either DMS-8240 "Permanent Prefabricated Pavement Markings" or DMS-8243 "Temporary Construction-Grade Prefabricated Pavement Markings."

RAISED PAVEMENT MARKERS

- All raised pavement markers used for work zone markings shall meet the requirements of Item 672, "RAISED PAVEMENT MARKERS" and DMS-4200.

DEPARTMENTAL MATERIAL SPECIFICATIONS (DMS) & MATERIAL PRODUCER LISTS (MPL)

- DMSs referenced above can be found along with embedded links to their respective MPLs at the following website:
http://www.txdot.gov/business/contractors_consultants/material_specifications/default.htm



WORK ZONE SHORT TERM PAVEMENT MARKINGS

WZ (STPM) - 13


FILE:	wzstpm-13.dgn	DN:	TxDOT	CK:	TxDOT	OW:	TxDOT	CK:	TxDOT
© TxDOT	April 1992	CONT:	0169	SECT:	07	JOB:	053, ETC	HIGHWAY:	US60
REVISIONS:		DIST:		COUNTY:		SHEET NO.:			
1-97		AMA:		GRAY					53
3-03									
7-13									

DISCLAIMER: The use of this standard is governed by the "Texas Engineering Practice Act". No warranty of any kind is made by TxDOT for any purpose whatsoever. TxDOT assumes no responsibility for incorrect results or damages resulting from its use.


DATE: 4/7/2021 7:26:35 AM
 FILE: F:\Projects\2019\11004.TxDOT_5x5_PS&E\03_US60_Amarillo\ENG\500-USTN\501\11004.dgn

Warning sign and rumble strip sequence in opposite direction is same as below

Flagger to Flagger (Length of Work Area)	ADT	# of Rumble Strip Arrays
1/8 Mile	< 4,500	1
	≥ 4,500	2
1/4 Mile	< 3,500	1
	≥ 3,500	2
1/2 Mile	< 2,600	1
	≥ 2,600	2
1 Mile	< 1,600	1
	≥ 1,600	2
> 1 Mile	N/A	2

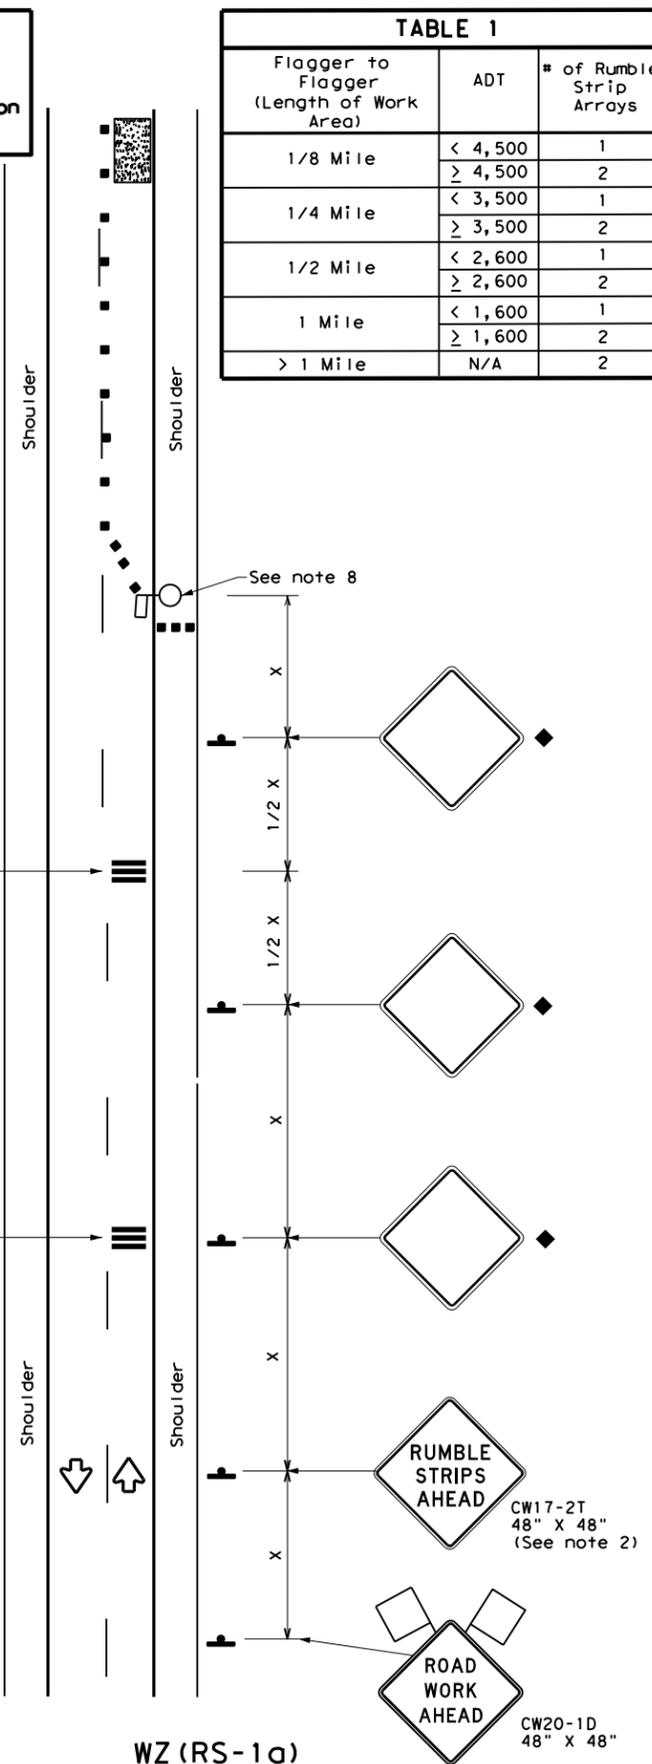

WZ (RS-1a)
75 mph or Less
RUMBLE STRIPS ON ONE-LANE TWO-WAY APPLICATION

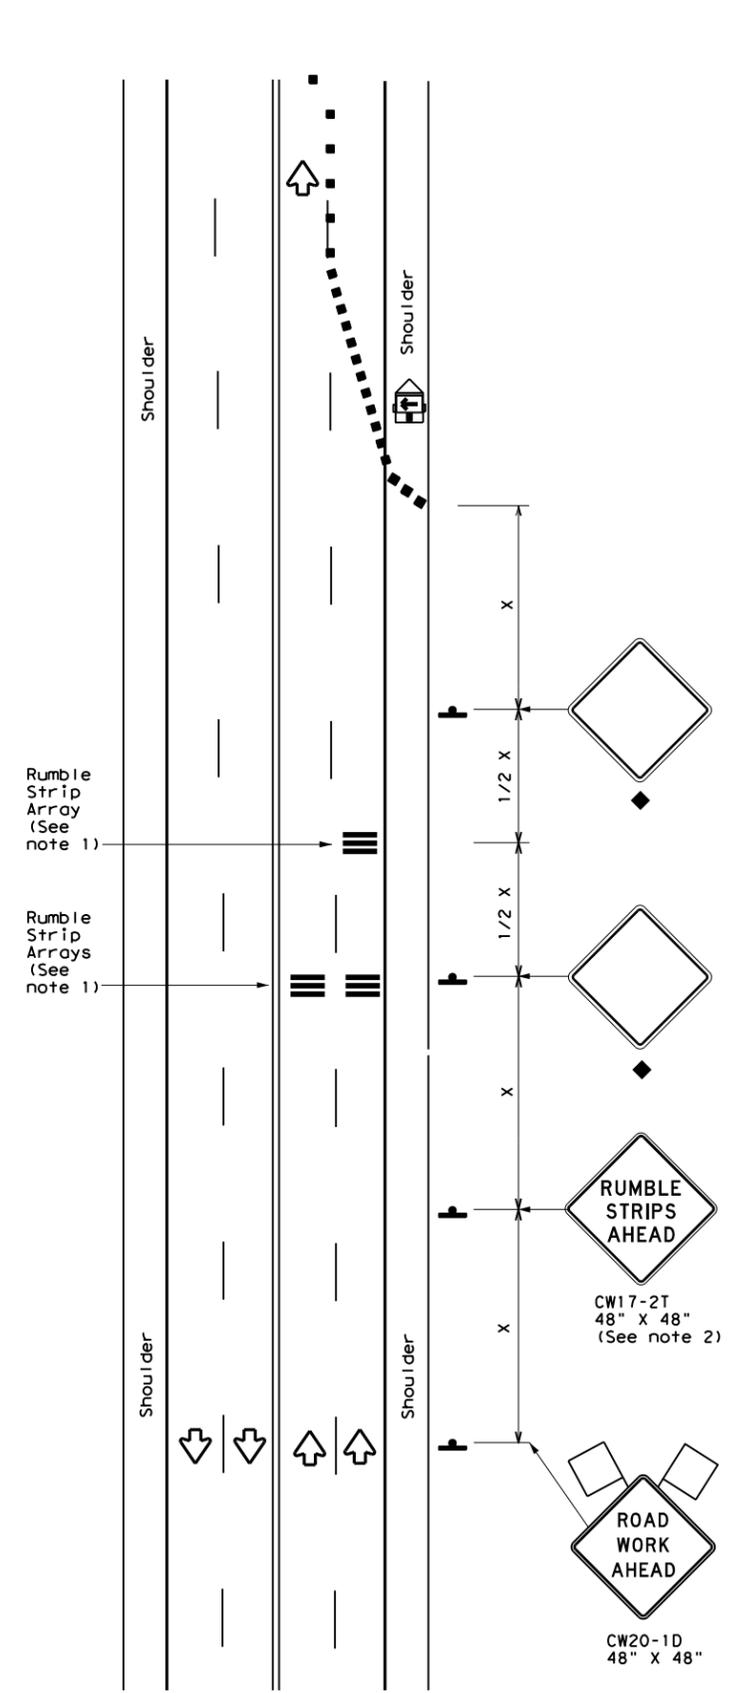

WZ (RS-1b)
75 mph or Less
RUMBLE STRIPS FOR LANE CLOSURE ON CONVENTIONAL ROADWAY

GENERAL NOTES

- Each Rumble Strip Array should consist of three rumble strips spaced center to center at the spacing shown in Table 2, placed transverse across the lane at locations shown.
- The CW17-2T "RUMBLE STRIPS AHEAD" sign should be located after the CW20-1D "ROAD WORK AHEAD" sign and spaced as shown. If traffic is observed to be queuing, or is expected to queue beyond the Rumble Strips, the CW17-2T sign and the first Rumble Strip Array may be located upstream of the CW20-1D sign as necessary to provide needed warning.
- Temporary Rumble Strips will be considered subsidiary to Item 502, and shall be a product listed on the Compliant Work Zone Traffic Control Devices.
- Removal of the Temporary Rumble Strips should be accomplished before removing the advance warning signs.
- Temporary Rumble Strips should not be used on horizontal curves, loose gravel, soft or bleeding asphalt, heavily rutted pavements or unpaved surfaces.
- Temporary Rumble Strips shall be installed and maintained as per manufacturer's recommendations.
- This standard sheet shall be used in conjunction with other appropriate TCP standard, TMUTCD typical application or project specific detail for the project.
- The one-lane two-way application may utilize a flagger, an AFAD or a portable traffic signal.
- Temporary Rumble Strips may be used on freeways or expressways based on engineering judgment.

Speed	Approximate distance between strips in an Array
≤ 40 MPH	10'
> 40 MPH & ≤ 55 MPH	15'
> 55 MPH	20'

	Type 3 Barricade		Channelizing Devices
	Heavy Work Vehicle		Truck Mounted Attenuator (TMA)
	Trailer Mounted Flashing Arrow Panel		Portable Changeable Message Sign (PCMS)
	Sign		Traffic Flow
	Flag		Flagger

Posted Speed *	Formula	Minimum Desirable Taper Lengths **			Suggested Maximum Spacing of Channelizing Devices		Minimum Sign Spacing "x" Distance	Suggested Longitudinal Buffer Space "B"
		10' Offset	11' Offset	12' Offset	On a Taper	On a Tangent		
30	L = WS ² / 60	150'	165'	180'	30'	60'	120'	90'
35		205'	225'	245'	35'	70'	160'	120'
40		265'	295'	320'	40'	80'	240'	155'
45	L = WS	450'	495'	540'	45'	90'	320'	195'
50		500'	550'	600'	50'	100'	400'	240'
55		550'	605'	660'	55'	110'	500'	295'
60		600'	660'	720'	60'	120'	600'	350'
65		650'	715'	780'	65'	130'	700'	410'
70	700'	770'	840'	70'	140'	800'	475'	
75	750'	825'	900'	75'	150'	900'	540'	

* Conventional Roads Only
 ** Taper lengths have been rounded off.
 L=Length of Taper (FT) W=Width of Offset (FT)
 S=Posted Speed (MPH)

MOBILE	SHORT DURATION	SHORT TERM STATIONARY	INTERMEDIATE TERM STATIONARY	LONG TERM STATIONARY
	✓	✓		

◆ Signs are for illustrative purposes only. Signs required may vary depending on the TCP, TMUTCD Typical Application, or project specific details for the project.

Texas Department of Transportation
 Traffic Operations Division Standard

TEMPORARY RUMBLE STRIPS

WZ (RS) - 16


FILE: wzrs16.dgn	DN: TxDOT	CK: TxDOT	DW: TxDOT	CK: TxDOT
© TxDOT November 2012	CONT	SECT	JOB	HIGHWAY
REVISIONS	0169	07	053, ETC	US60
2-14	DIST	COUNTY	SHEET NO.	
4-16	AMA	GRAY	55	



PRIMARY CONTROL POINTS (SURFACE)					
CP	NORTHING	EASTING	ELEVATION	STATION	OFFSET
8512300	3,840,214.82'	821,333.83'	3,222.59'	49+52.38	43.68' LT
8512700	3,840,315.04'	826,257.23'	3,219.18'	98+76.78	55.07' LT
8513400	3,840,427.63'	832,822.82'	3,214.49'	164+43.33	49.10' LT
8514100	3,840,621.48'	843,115.70'	3,196.48'	267+36.96	34.04' RT
8514200	3,843,217.80'	847,524.64'	3,196.59'	318+49.79	46.79' RT

BEGIN PROJECT
 STA. = 49+00
 OFFSET = 0.00' RT
 CSJ NO. 0169-07-054
 N = 3,840,170.12'
 E = 821,282.25'
 LAT = 35°32'00.6398" N
 LONG = 100°56'43.9637" W

BEGIN PROJECT
 STA. = 128+00
 OFFSET = 0.00' RT
 END CSJ NO. 0169-07-054
 BEGIN CSJ NO. 0169-07-053
 N = 3,840,312.76'
 E = 829,180.96'
 LAT = 35°32'01.6017" N
 LONG = 100°55'08.3982" W

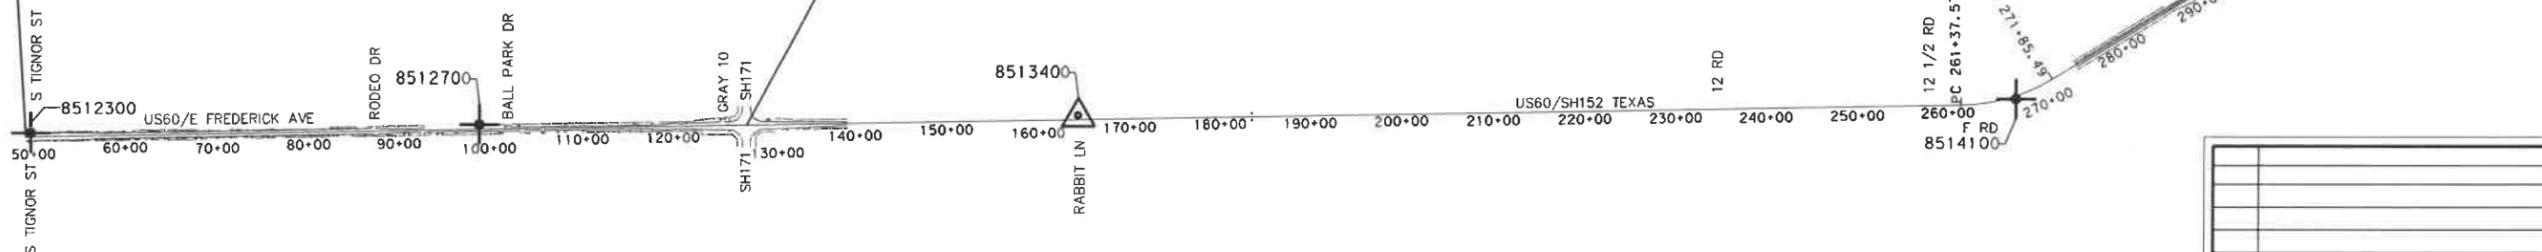

NO.	REVISION	BY	DATE

CONTROL POINT LEGEND

- DENOTES PRIMARY CONTROL POINT (5/8" IRON ROD SET IN CONCRETE WITH A 2" ALUMINUM CAP STAMPED "TEXAS DEPT OF TRANS CONTROL"), UNLESS OTHERWISE NOTED
- DENOTES PRIMARY CONTROL POINT (2" ALUMINUM CAP STAMPED "TEXAS DEPT OF TRANS CONTROL" SET IN A CONCRETE STRUCTURE), UNLESS OTHERWISE NOTED

LAMB-STAR ENGINEERING, L.P.
 5700 W. PLANO PARKWAY, SUITE 1000
 PLANO, TX 75093
 P 214-440-3800
 F 214-440-3801
 TBPLS # 10048300

CobbFendley 13430 Northwest Freeway, Ste. 1100
 Houston, Texas 77040
 TBPE Firm Registration No. 274 713.462.3242
 TBPLS Firm Registration No. 100467 www.cobbfendley.com

Texas Department of Transportation

US60
SURVEY CONTROL INDEX MAP


NOTE:
 TEXAS COORDINATE SYSTEM NAD83 (1993)
 ZONE: NORTH ZONE (4201)
 BEARING BASIS: GRID NORTH
 ELEVATION BASIS: NAVD88
 UNITS: U.S. SURVEY FEET
 SURFACE ADJUSTMENT FACTOR: 1.00019
 COORDINATES ARE SURFACE

DATE: JUNE 10-22, 2020




SHEET 1 OF 3


FED. RD. DIST. NO.	STATE	PROJECT NO.	HIGHWAY NO.		
6	TEXAS		US60		
STATE DISTRICT	COUNTY	CONTROL NO.	SECTION NO.	JOB NO.	SHEET NO.
AMA	GRAY	0169	07	053,054	56

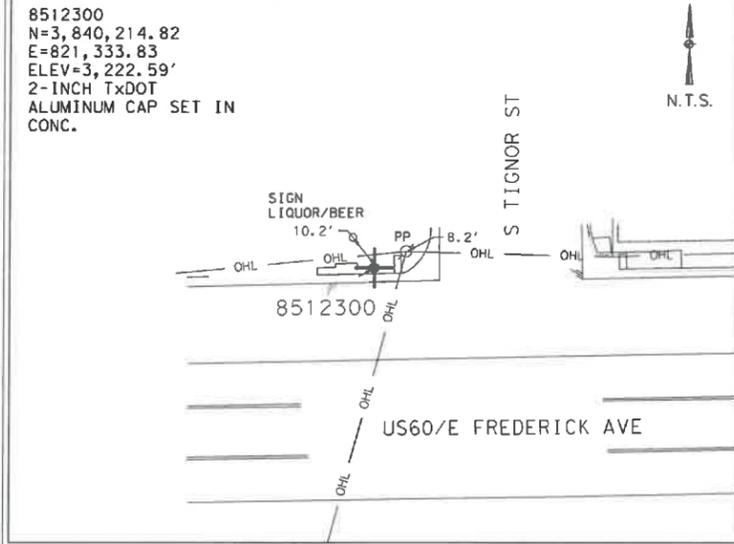


STATION IS LOCATED ON THE NORTH SIDE OF US 60 AT THE NORTHWEST CORNER OF THE INTERSECTION OF US 60 AND S TIGNOR ST. BEING LOCATED 10.2' SOUTHEAST FROM A LIQUOR BEER SIGN, 8.2' SOUTHWEST OF A POWER POLE AND 7.6' EAST OF A STORM MANHOLE/CURB INLET.

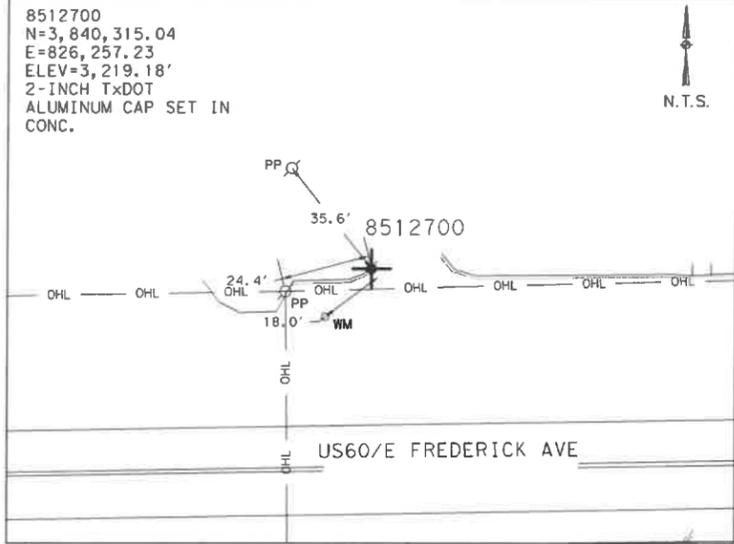


STATION IS LOCATED ON THE NORTH SIDE OF US 60 BEING APPROXIMATELY 300' WEST OF BALL PARK DR., 35.6' SOUTHWEST OF A POWER POLE, 24.4' EAST OF A POWER POLE ON THE NORTH ROW OF US 60 AND 18.0' EAST OF A WATER METER.

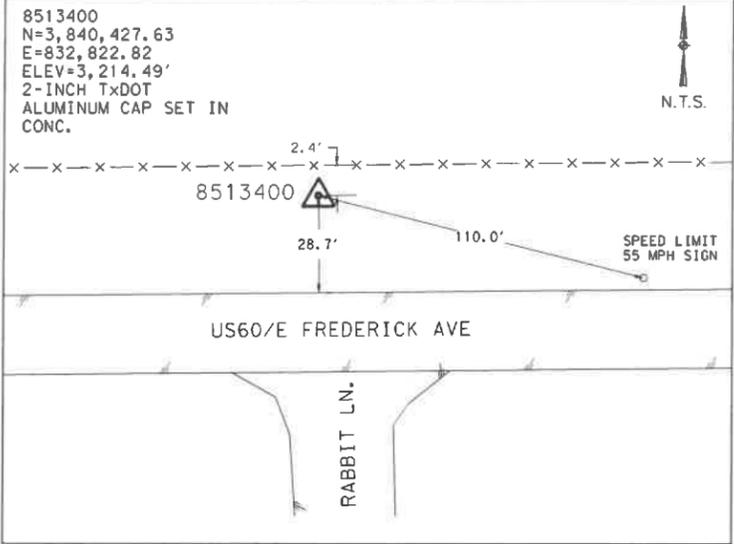


STATION IS LOCATED ON THE NORTH SIDE OF US 60 ACROSS THE HIGHWAY OF RABBIT LN., BEING APPROXIMATELY 2.4' SOUTH OF A BARBED WIRE FENCE, 28.7' NORTH OF THE NORTHERLY EDGE OF PAVEMENT OF US 60 AND 110.0' WEST OF A SPEED LIMIT SIGN (55 MPH).

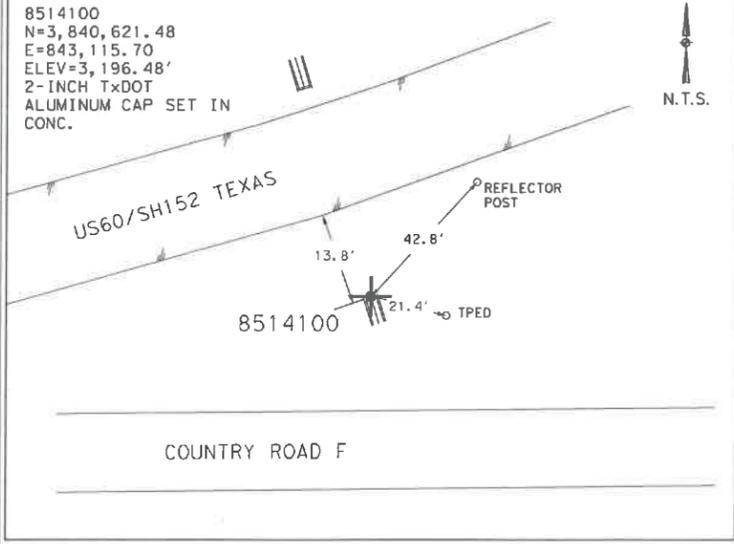


STATION IS LOCATED ON THE SOUTH SIDE OF US 60 IN BETWEEN US 60 AND COUNTRY ROAD F. APPROXIMATELY 13.8' SOUTHEAST OF THE SOUTHERLY EDGE OF PAVEMENT OF US 60, 42.8' SOUTHWEST OF A REFLECTOR POST AND 21.4' WEST OF A TELEPHONE PESTAL.

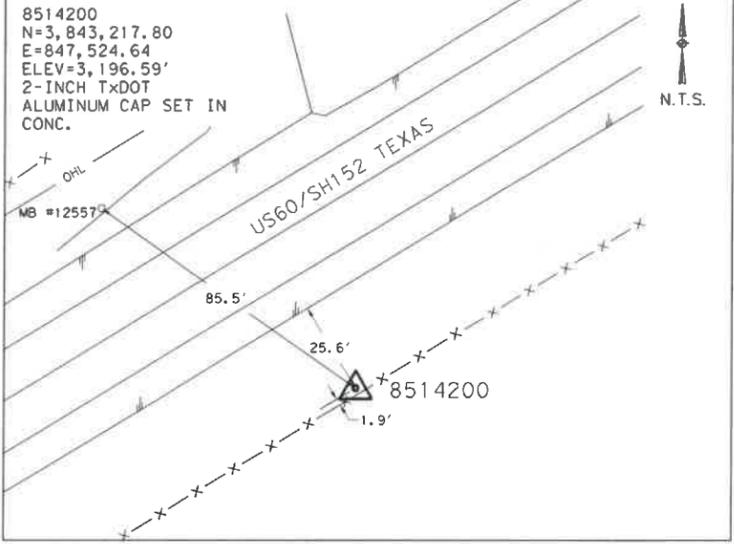


STATION IS LOCATED ON THE SOUTHEAST SIDE OF US 60 APPROXIMATELY 1.9' NORTHWEST OF A BARBED WIRE FENCE, 25.6' SOUTHEAST OF THE SOUTHERLY EDGE OF PAVEMENT AND 85.5 FEET SOUTHEAST OF A MAILBOX #12557 LOCATED ON THE NORTH SIDE OF US 60.

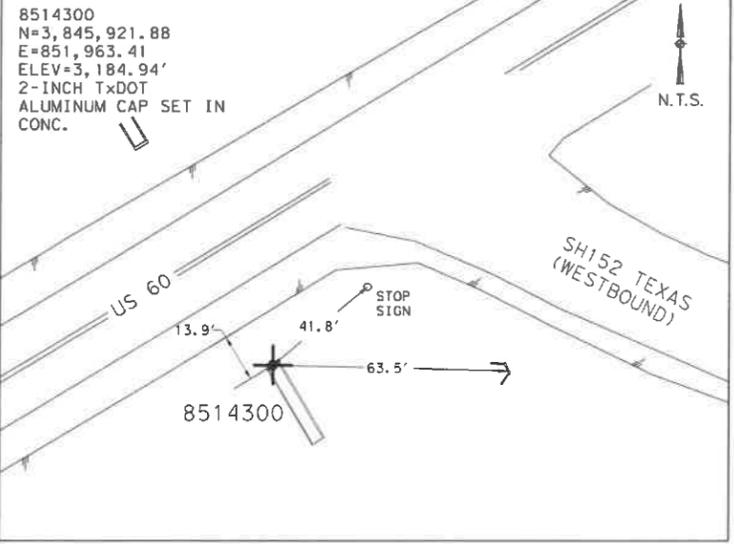


STATION IS LOCATED ON THE SOUTHEAST SIDE OF US 60 WEST OF THE EXIT TO SH 152, APPROXIMATELY 13.9' SOUTHEAST OF THE SOUTHERLY EDGE OF PAVEMENT OF US 60, 41.8' SOUTHWEST OF A STOP SIGN AND 63.5' NORTHWEST OF A 24" RCP.

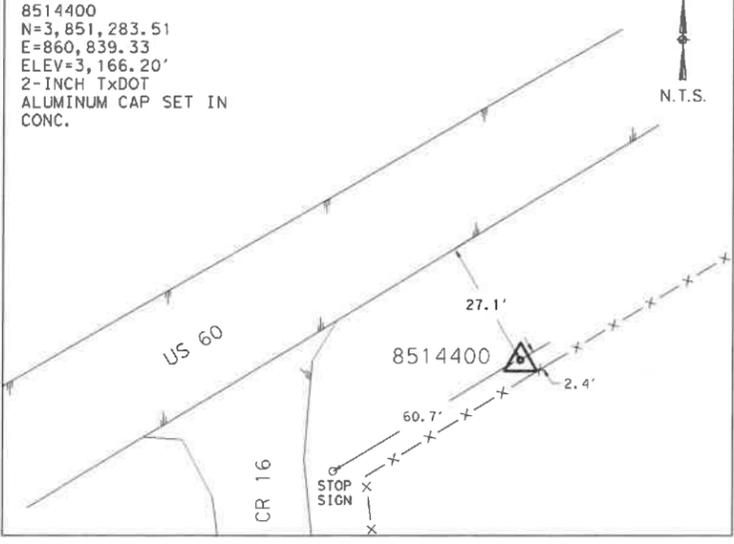

STATION IS LOCATED ON THE SOUTHEAST SIDE OF US 60 APPROXIMATELY 450' SOUTHWEST OF COUNTY ROAD NO. 16, BEING 27.1' SOUTH OF THE SOUTHERLY EDGE OF PAVEMENT OF US 60, 60.7' NORTHEAST OF A STOP SIGN, 2.4' NORTHWEST OF A BARB WIRE FENCE.

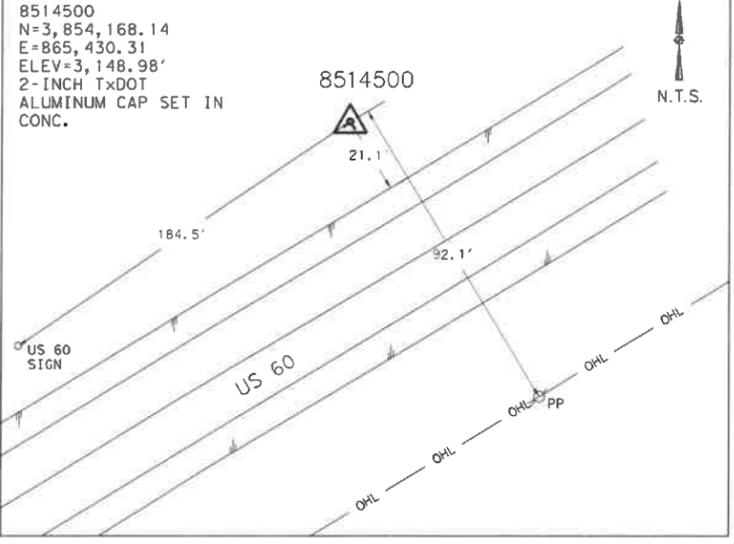


STATION IS LOCATED ON THE NORTHWEST SIDE OF US 60 APPROXIMATELY 4,400' SOUTHWEST OF COUNTY ROAD C, BEING 21.1' NORTH OF THE NORTHERLY EDGE OF PAVEMENT OF US 60, 184.5' NORTHEAST OF US 60 (W) SIGN, AND 92.1' NORTHWEST OF A POWER POLE.

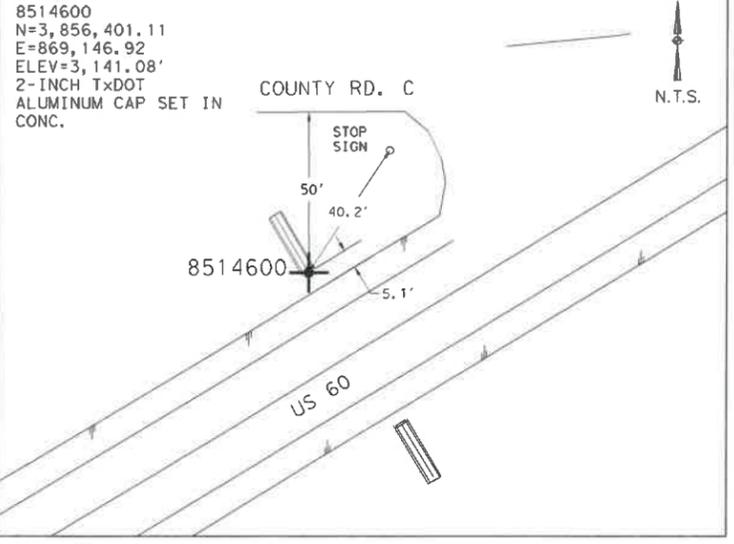

STATION IS LOCATED ON THE NORTHWEST SIDE OF US 60 APPROXIMATELY 50' SOUTHWEST OF COUNTY ROAD C, BEING 5.1' NORTH OF THE NORTHERLY EDGE OF PAVEMENT OF US 60, 40.2' SOUTHWEST OF A STOP SIGN.

I HEREBY CERTIFY THAT THE HORIZONTAL AND VERTICAL DATA SHOWN HEREON WAS DETERMINED BY A FIELD SURVEY ON JUNE 10-22, 2020 AND IS CORRECTLY SHOWN HEREON

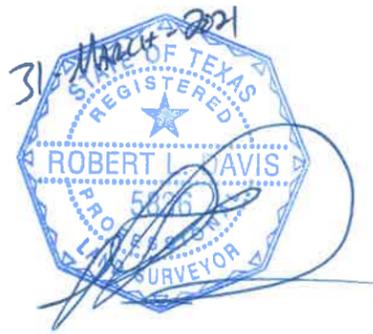

Robert Davis
Registered Professional Land Surveyor
No. 5836

LAMB-STAR ENGINEERING, L.P.
5700 W. PLANO PARKWAY,
SUITE 1000
PLANO, TX. 75093
TBPLS # 10048300

NO.	REVISION	BY	DATE

CONTROL POINT LEGEND

DENOTES PRIMARY CONTROL POINT (5/8" IRON ROD SET IN CONCRETE WITH A 2" ALUMINUM CAP STAMPED "TEXAS DEPT OF TRANS CONTROL"), UNLESS OTHERWISE NOTED

DENOTES PRIMARY CONTROL POINT (2" ALUMINUM CAP STAMPED "TEXAS DEPT OF TRANS CONTROL" SET IN A CONCRETE STRUCTURE), UNLESS OTHERWISE NOTED

LAMB-STAR ENGINEERING, L.P.
5700 W. PLANO PARKWAY, SUITE 1000
PLANO, TX 75093
P 214-440-3600
F 214-440-3601
TBPLS # 10048300

CobbFendley 13430 Northwest Freeway, Ste. 1100
Houston, Texas 77040
713.462.3242
TBPE Firm Registration No. 274
TBPLS Firm Registration No. 100467
www.cobbfendley.com


Texas Department of Transportation
© 2020

US60
CONTROL SHEET


SHEET 1 OF 2

FED. PROJ. NO.	STATE	PROJECT NO.	SHEET NO.
6	TEXAS	0169 07	59

STATE DISTRICT	COUNTY	CONTROL NO.	SECTION NO.	JOB NO.	SHEET NO.
AMA	GRAY	0169	07	053,054	59

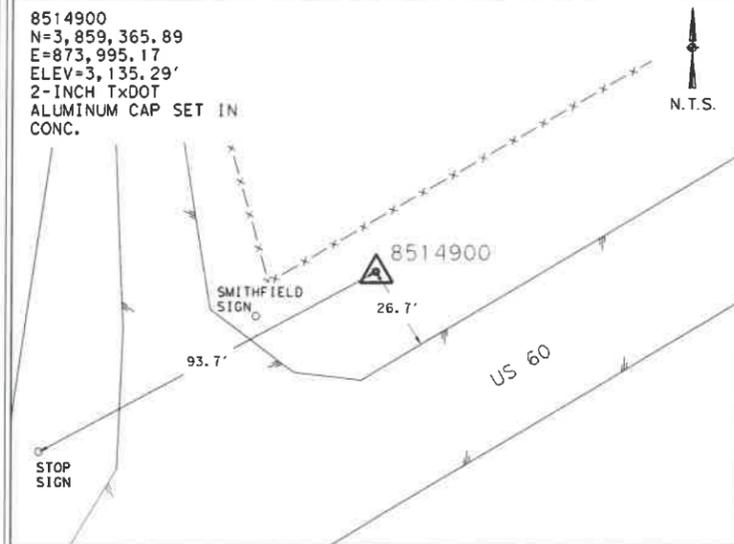


STATION IS LOCATED ON THE NORTHWEST SIDE OF US 60 APPROXIMATELY 3,380' SOUTHWEST OF COUNTY ROAD 19, BEING 26.7' NORTH OF THE NORTHERLY EDGE OF PAVEMENT OF US 60, 93.7' NORTHWEST OF A STOP SIGN.

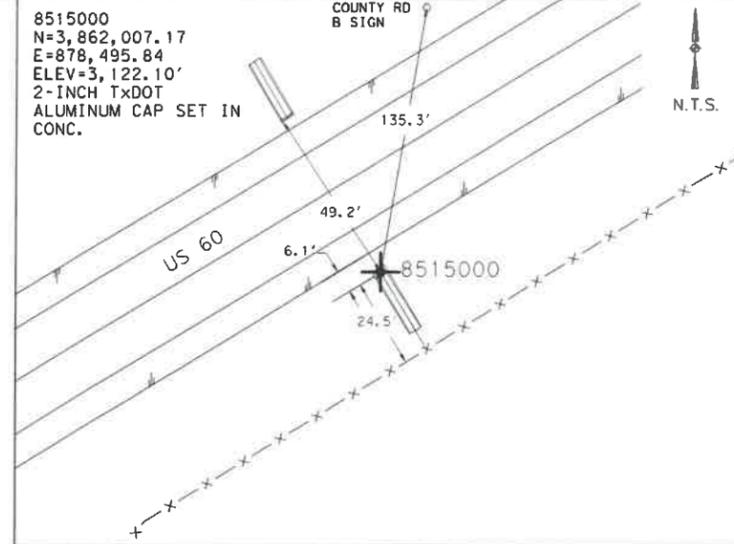


STATION IS LOCATED ON THE SOUTHEAST SIDE OF US 60 APPROXIMATELY 1840' NORTHEAST OF COUNTY ROAD 19, BEING 6.1' SOUTH OF THE SOUTHERLY EDGE OF PAVEMENT OF US 60, 135.3' SOUTHWEST OF A COUNTY ROAD B SIGN AND 24.5' NORTHWEST OF A BARB WIRE FENCE.



STATION IS LOCATED ON THE NORTHWEST SIDE OF US 60 APPROXIMATELY 6,950' SOUTHWEST OF COUNTY ROAD 21, BEING 19.7' NORTHWEST OF THE NORTHWESTERLY EDGE OF PAVEMENT OF US 60, 59.9' NORTHWEST OF THE SOUTHEASTERLY EDGE OF PAVEMENT OF US 60.

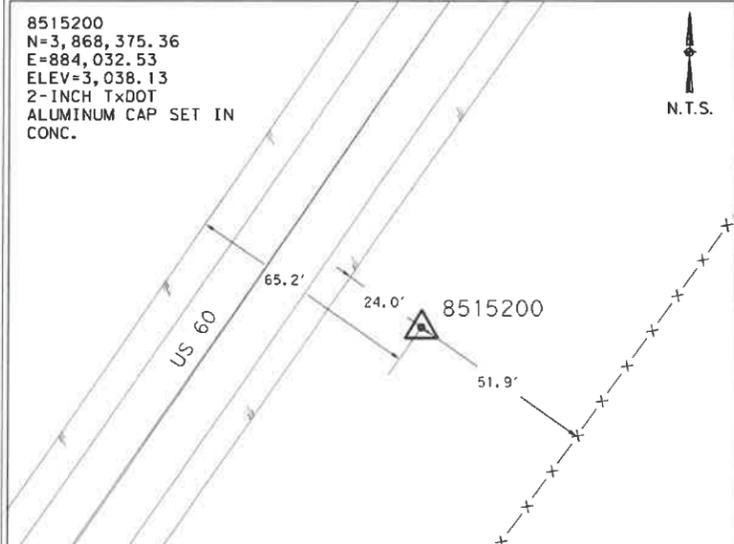

STATION IS LOCATED ON THE SOUTHEAST SIDE OF US 60 APPROXIMATELY 3150' SOUTHWEST OF COUNTY ROAD 21, BEING 24' EAST OF THE EASTERLY EDGE OF PAVEMENT OF US 60, 51.9' WEST OF A BARBED WIRE FENCE.

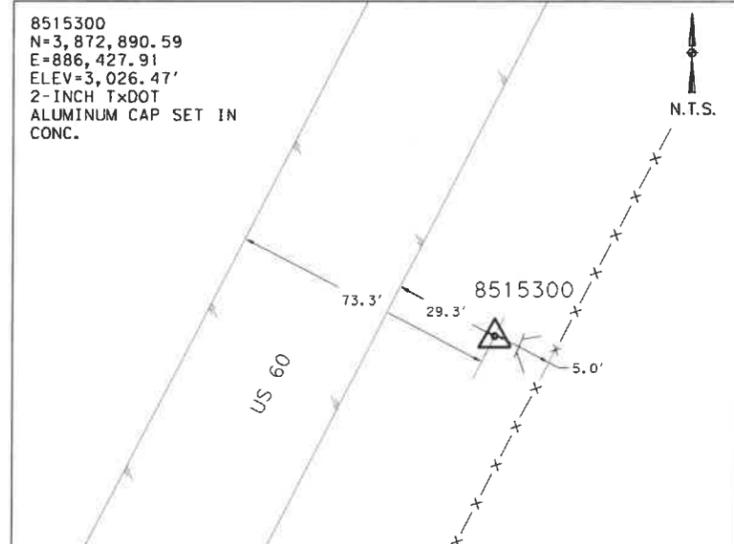

STATION IS LOCATED ON THE SOUTHEAST SIDE OF US 60 APPROXIMATELY 1960' NORTHEAST OF COUNTY ROAD 21, BEING 29.3' EAST OF THE EASTERLY EDGE OF PAVEMENT OF US 60, 5.0' WEST OF A BARBED WIRE FENCE.

I HEREBY CERTIFY THAT THE HORIZONTAL AND VERTICAL DATA SHOWN HEREON WAS DETERMINED BY A FIELD SURVEY ON JUNE 10-22, 2020 AND IS CORRECTLY SHOWN HEREON



Robert Davis
Registered Professional Land Surveyor
No. 5836

LAMB-STAR ENGINEERING, L.P.
5700 W. PLANO PARKWAY,
SUITE 1000
PLANO, TX. 75093
TBPLS # 10048300

NO.	REVISION	BY	DATE

CONTROL POINT LEGEND

DENOTES PRIMARY CONTROL POINT (5/8" IRON ROD SET IN CONCRETE WITH A 2" ALUMINUM CAP STAMPED "TEXAS DEPT OF TRANS CONTROL"), UNLESS OTHERWISE NOTED

DENOTES PRIMARY CONTROL POINT (2" ALUMINUM CAP STAMPED "TEXAS DEPT OF TRANS CONTROL" SET IN A CONCRETE STRUCTURE), UNLESS OTHERWISE NOTED

LAMB-STAR ENGINEERING, L.P.
5700 W. PLANO PARKWAY, SUITE 1000
PLANO, TX. 75093
P 214-440-3600
F 214-440-3601
TBPLS # 10048300

CobbFendley 13430 Northwest Freeway, Ste. 1100
Houston, Texas 77040
713.462.3242
TBPE Firm Registration No. 274
713.462.3242
www.cobbfendley.com
TBPLS Firm Registration No. 100467

Texas Department of Transportation

US60
CONTROL SHEET

SHEET 2 OF 2

FED. RD. DIST. NO.	STATE	PROJECT NO.	HIGHWAY NO.		
6	TEXAS		US60		
STATE DISTRICT	COUNTY	CONTROL NO.	SECTION NO.	JOB NO.	SHEET NO.
AMA	GRAY	0169	07	053,054	60

Beginning chain US60 description

Point 1 X 821,282.25 Y 3,840,170.12 Sta 49+00.00

Course from 1 to PC US601 N 88° 57' 55.63" E Dist 21,237.57

Curve Data

 Curve US601 (Chord Definition)
 P.I. Station = 266+74.04 X 843,052.74 Y 3,840,563.26
 Delta = 30° 10' 28.32" (LT)
 Degree = 2° 52' 46.16"
 Tangent = 536.47
 Length = 1,047.91
 Radius = 1,990.00
 External = 71.04
 Long Chord = 1,035.95
 Mid. Ord. = 68.59
 P.C. Station = 261+37.57 X 842,516.36 Y 3,840,553.57
 P.T. Station = 271+85.49 X 843,511.57 Y 3,840,841.23
 C.C. = X 842,480.43 Y 3,842,543.24
 Back = N 88° 57' 55.63" E
 Ahead = N 58° 47' 27.31" E
 Chord Bear = N 73° 52' 41.47" E

Course from PT US601 to PC US602 N 58° 47' 27.31" E Dist 42,464.75

Curve Data

 Curve US602 (Chord Definition)
 P.I. Station = 702+71.13 X 880,361.95 Y 3,863,166.60
 Delta = 24° 00' 31.15" (LT)
 Degree = 1° 57' 44.21"
 Tangent = 620.90
 Length = 1,223.51
 Radius = 2,920.00
 External = 65.28
 Long Chord = 1,214.64
 Mid. Ord. = 63.85
 P.C. Station = 696+50.23 X 879,830.91 Y 3,862,844.87
 P.T. Station = 708+73.74 X 880,716.15 Y 3,863,676.56
 C.C. = X 878,317.88 Y 3,865,342.30
 Back = N 58° 47' 27.31" E
 Ahead = N 34° 46' 56.15" E
 Chord Bear = N 46° 47' 11.73" E

Course from PT US602 to PC US603 N 34° 46' 56.15" E Dist 6,054.94

Curve Data

 Curve US603 (Chord Definition)
 P.I. Station = 772+70.30 X 884,365.13 Y 3,868,930.22
 Delta = 7° 49' 58.29" (LT)
 Degree = 1° 08' 53.63"
 Tangent = 341.62
 Length = 682.17
 Radius = 4,990.00
 External = 11.68
 Long Chord = 681.65
 Mid. Ord. = 11.65
 P.C. Station = 769+28.68 X 884,170.25 Y 3,868,649.64
 P.T. Station = 776+10.85 X 884,519.95 Y 3,869,234.74
 C.C. = X 880,071.83 Y 3,871,496.23
 Back = N 34° 46' 56.15" E
 Ahead = N 26° 56' 57.86" E
 Chord Bear = N 30° 51' 57.01" E

Course from PT US603 to 2 N 26° 56' 57.86" E Dist 3,047.94

Point 2 X 885,901.29 Y 3,871,951.70 Sta 806+58.79

Ending chain US60 description

04/07/2021



Bo L. Ratto

REV. NO.	DATE	DESCRIPTION	BY

CobbFendley 13430 Northwest Freeway, Ste. 1100
 Houston, Texas 77040
 TBPE Firm Registration No. 274 713.462.3242
 TBPLS Firm Registration No. 100467 www.cobbfendley.com

 **Texas Department of Transportation**

HORIZONTAL ALIGNMENT DATA SHEET

SHEET 1 OF 1

FED. RD. DIV. NO.	STATE	PROJECT NO.	HIGHWAY NO.
6	TEXAS	(SEE TITLE SHEET)	US60
STATE DISTRICT	COUNTY	CONTROL NO.	SECTION NO.
AMA	GRAY	0169	07
			JOB NO.
			053, ETC
			SHEET NO.
			61



4/7/2021 7:26:36 AM F:\P\j\c\2019\1004_Tx\DOT_5x5_P5&E\03_US60_Amar\1161\ENG\500-UST\N\511_2-Roadway\02-Sheets\US60_Road-ALIGN-01.dgn

US60-ROAD-ALIGN-01.dgn



- LEGEND**
- PROPOSED PAVEMENT
 - PROPOSED DRIVEWAY
 - PROPOSED RIPRAP
 - PAVEMENT REMOVAL
 - EXIST TRAFFIC FLOW
 - PROP TRAFFIC FLOW
 - APPROX ROW
 - DRIVEWAY NUMBER
 - PROP DITCH

NOTE:
1. REFER TO MISCELLANEOUS DRIVEWAY DETAILS FOR ADDITIONAL INFORMATION.

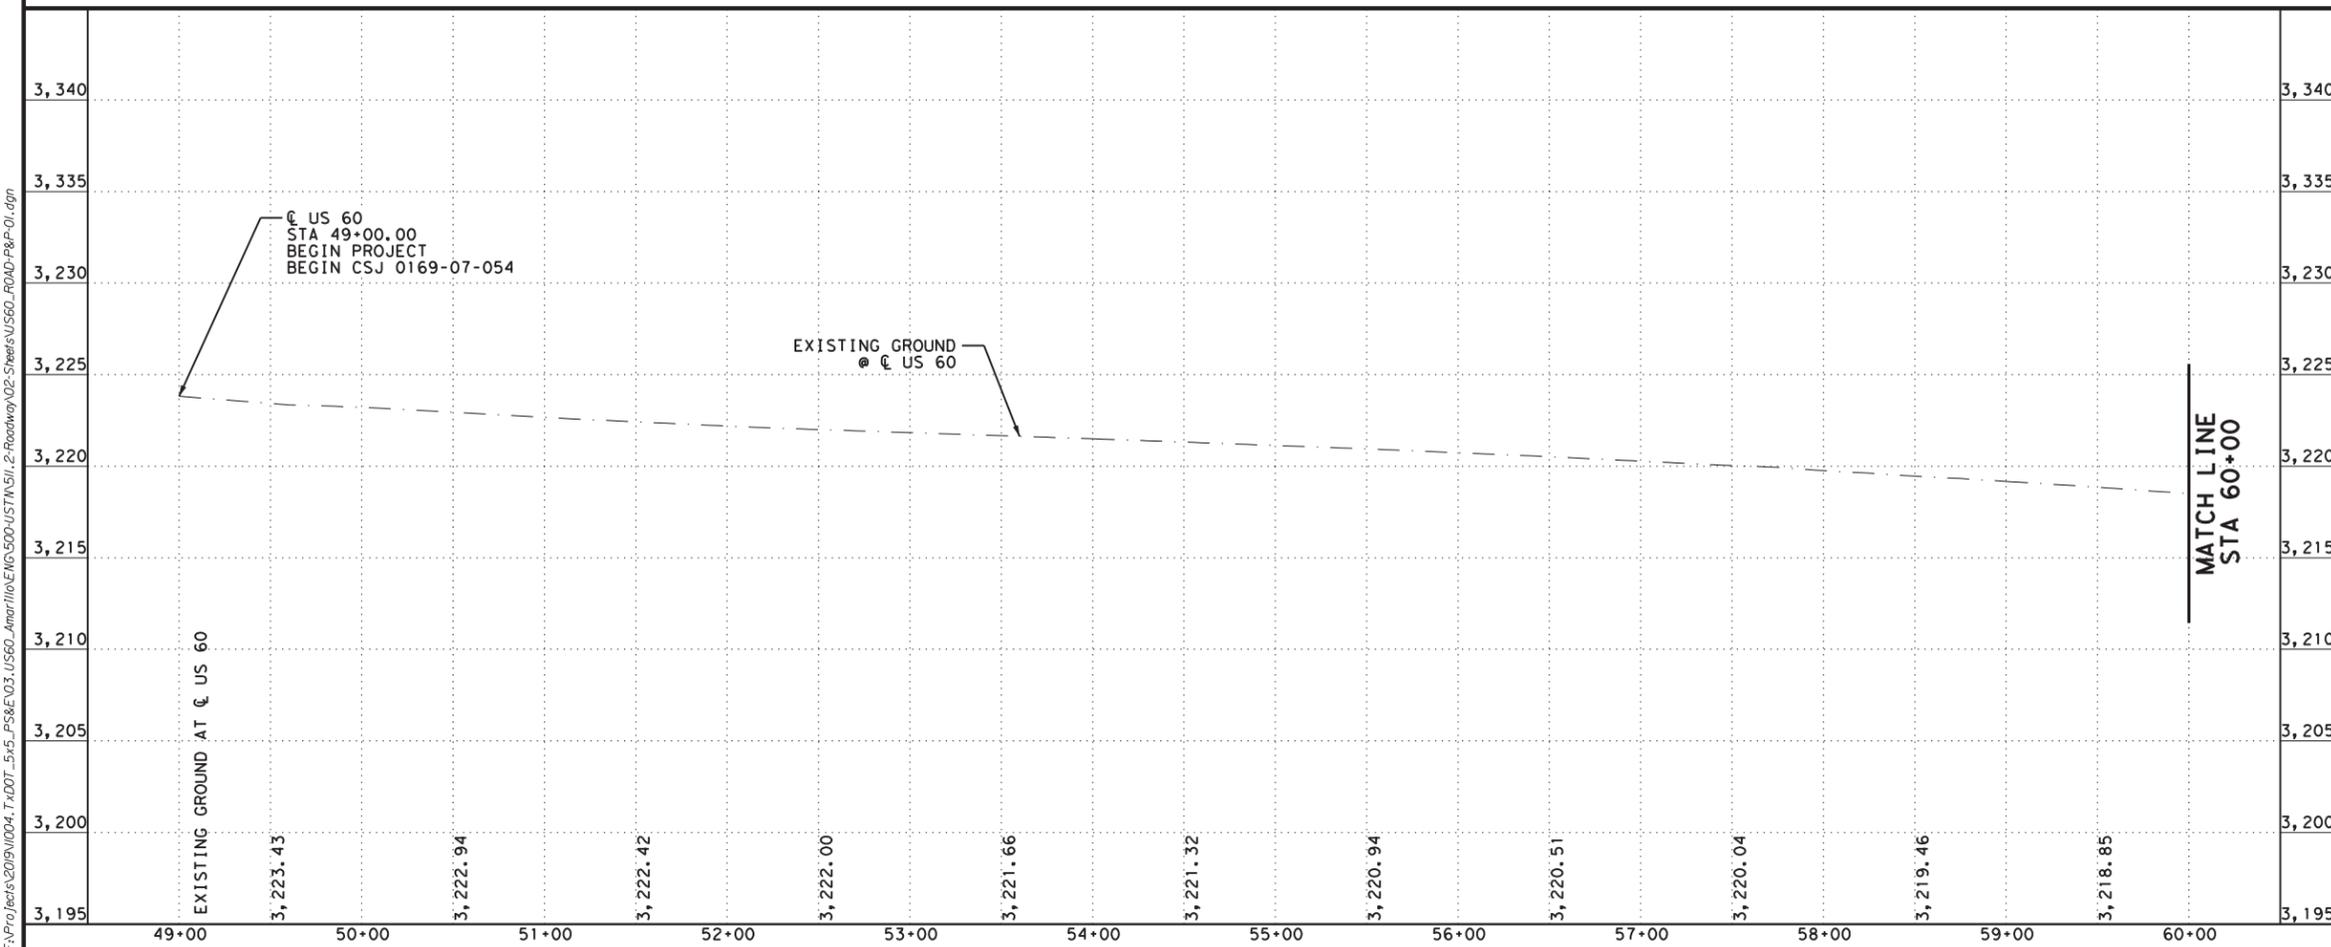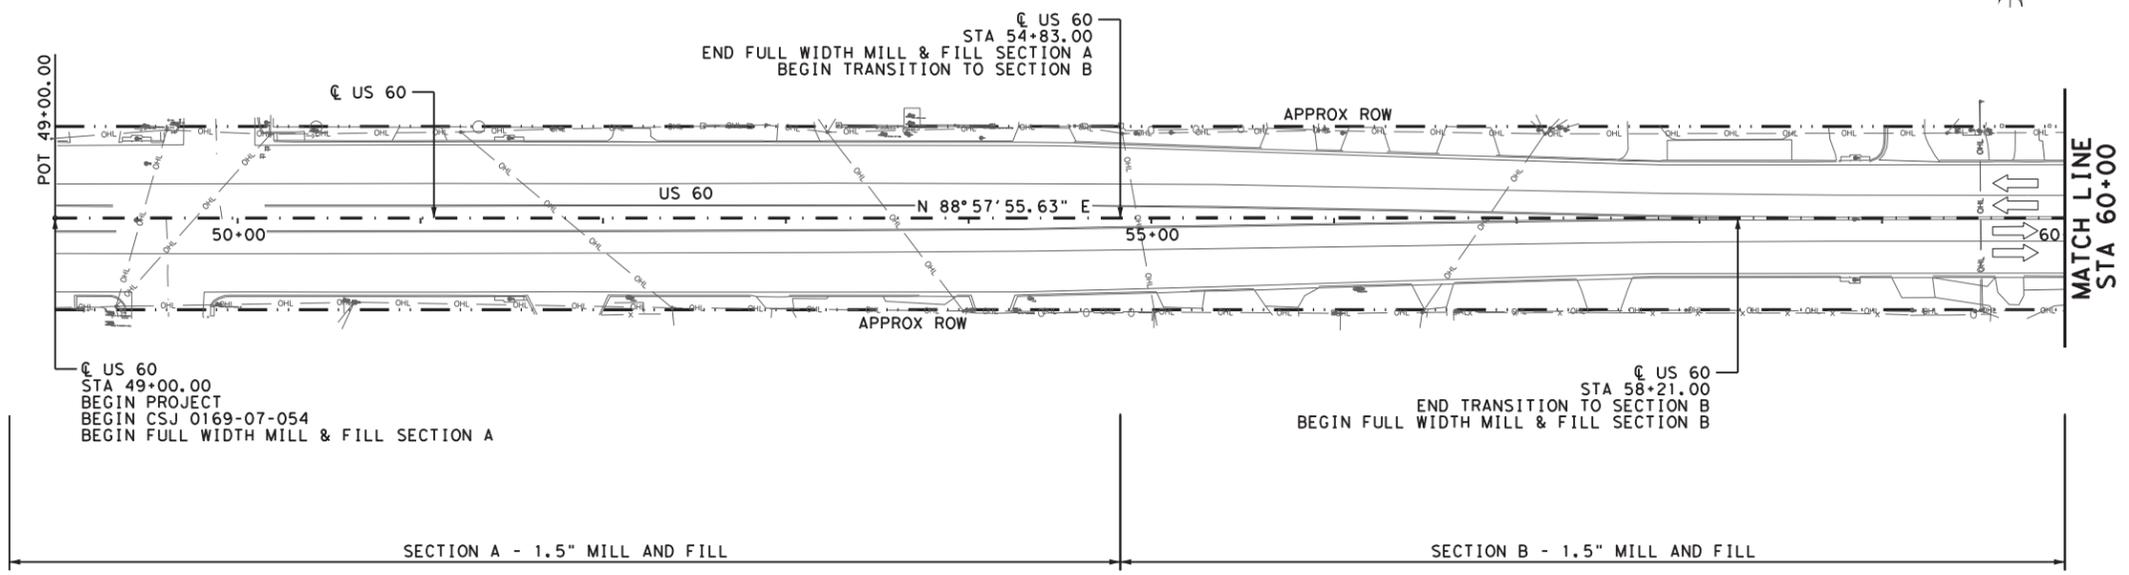

04/07/2021

Bo L. Ratto

0 25 50 100 (H)
0 5 10 (V)

REV. NO.	DATE	DESCRIPTION	BY

CobbFendley 13430 Northwest Freeway, Ste. 1100
Houston, Texas 77040
713.462.3242
www.cobbfendley.com

Texas Department of Transportation

**US 60
ROADWAY PLAN & PROFILE
STA 49+00 TO STA 60+00**

SHEET 1 OF 38

FED. RD. DIV. NO.	STATE	PROJECT NO.	HIGHWAY NO.
6	TEXAS	(SEE TITLE SHEET)	US60
STATE DISTRICT	COUNTY	CONTROL NO.	SECTION NO.
AMA	GRAY	0169	07
			JOB NO.
			053, ETC
			SHEET NO.
			62



4/7/2021 7:56:37 AM F:\P\0169\07\004_TxDOT_5x5_P5&E\03_US60_Amarillo\EN\500-UST\IN\511_2-Roadway\02-Sheets\US60_ROAD-PLAN.dgn

LEGEND

-  PROPOSED PAVEMENT
-  PROPOSED DRIVEWAY
-  PROPOSED RIPRAP
-  PAVEMENT REMOVAL
-  EXIST TRAFFIC FLOW
-  PROP TRAFFIC FLOW
-  APPROX ROW
-  DRIVEWAY NUMBER
-  PROP DITCH E

NOTE:

1. REFER TO MISCELLANEOUS DRIVEWAY DETAILS FOR ADDITIONAL INFORMATION.

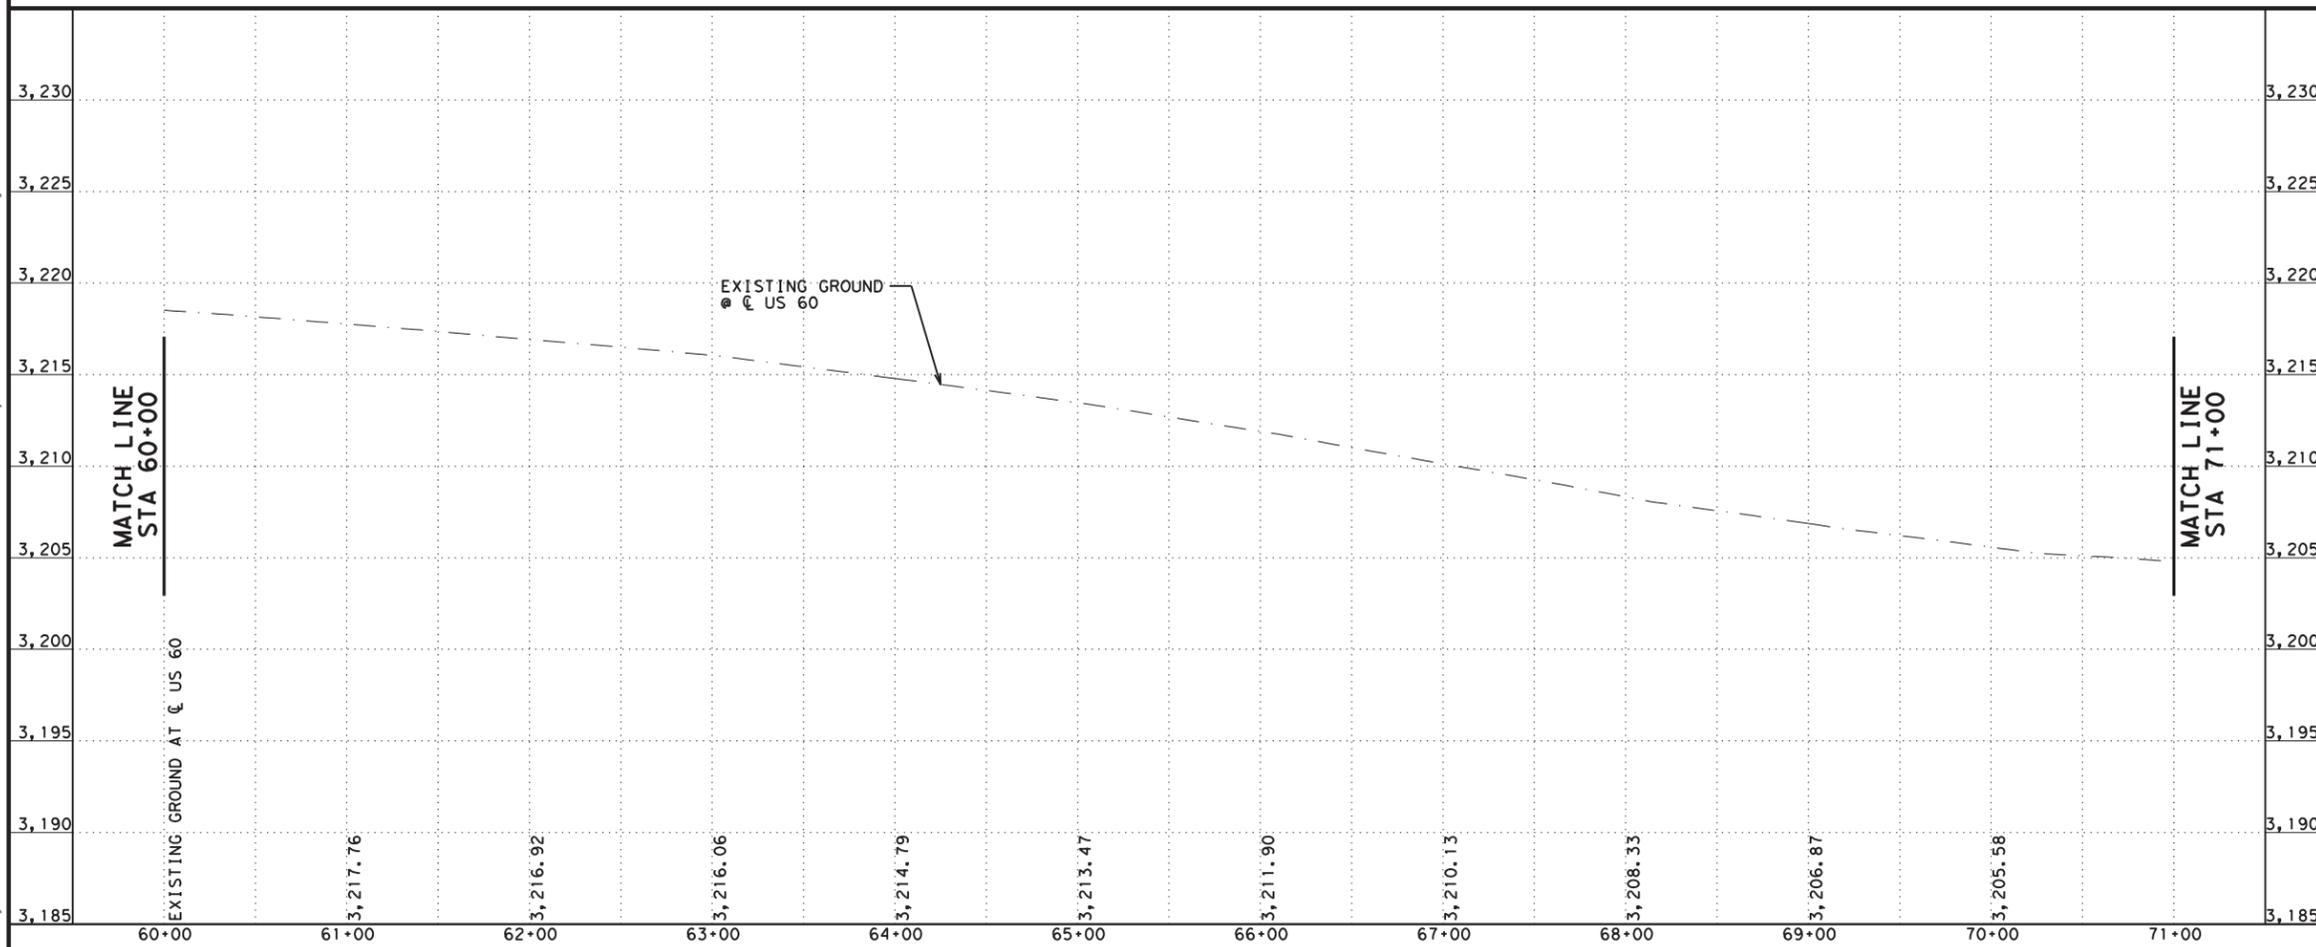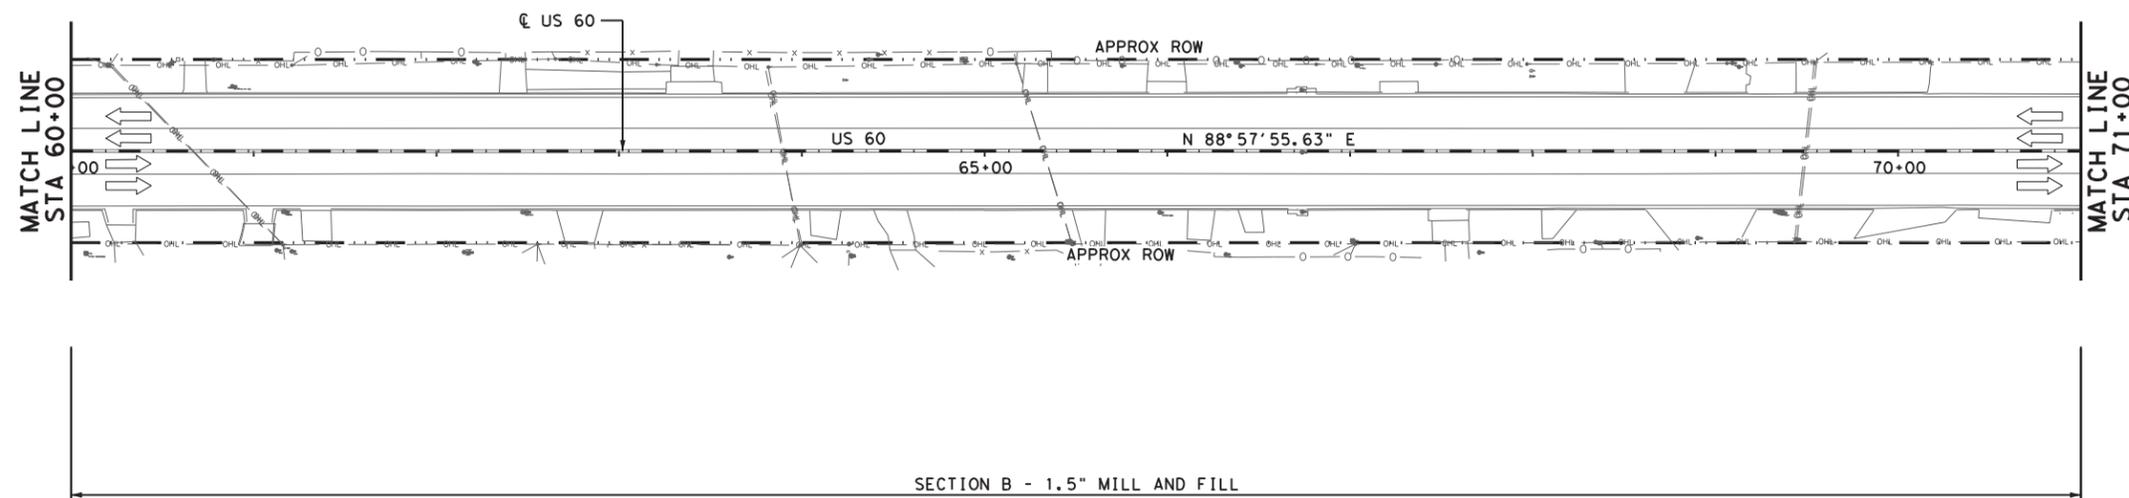

04/07/2021



Bo L. Ratto

0 25 50 100 (H)
0 5 10 (V)

REV. NO.	DATE	DESCRIPTION	BY

CobbFendley 13430 Northwest Freeway, Ste. 1100
Houston, Texas 77040
713.462.3242
www.cobbfendley.com

 Texas Department of Transportation


**US 60
ROADWAY PLAN & PROFILE**
STA 60+00 TO STA 71+00

SHEET 2 OF 38

FED. RD. DIV. NO.	STATE	PROJECT NO.	HIGHWAY NO.
6	TEXAS	(SEE TITLE SHEET)	US60
STATE DISTRICT	COUNTY	CONTROL NO.	SECTION NO.
AMA	GRAY	0169	07
		JOB NO.	SHEET NO.
		053, ETC	63

4/7/2021 7:56:38 AM F:\P\J\162019\1004_Tx\DOT_Dx5_P5&E\03_US60_Amarillo\1616\1616\500\UST\N\511_2-Roadway\02-Sheets\US60_ROAD-P&P-02.dgn

US60-ROAD-P&P-02.dgn


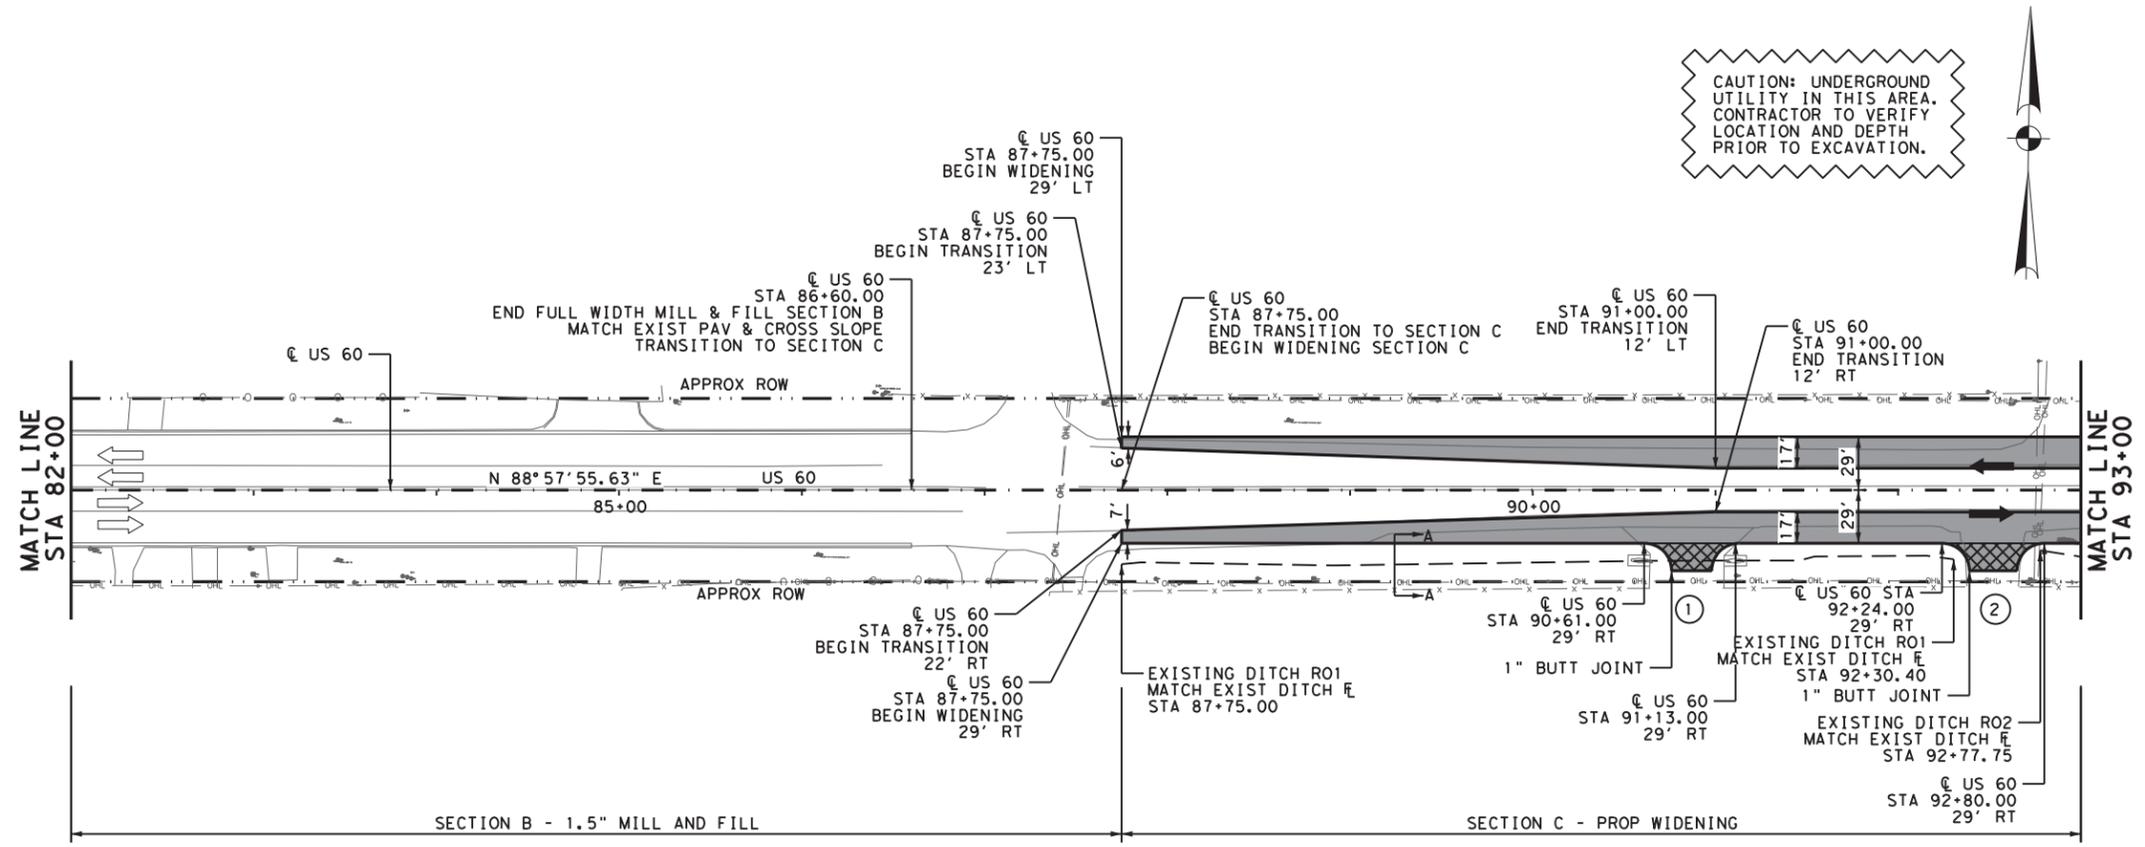


CAUTION: UNDERGROUND UTILITY IN THIS AREA. CONTRACTOR TO VERIFY LOCATION AND DEPTH PRIOR TO EXCAVATION.

- LEGEND**
- PROPOSED PAVEMENT
 - PROPOSED DRIVEWAY
 - PROPOSED RIPRAP
 - PAVEMENT REMOVAL
 - EXIST TRAFFIC FLOW
 - PROP TRAFFIC FLOW
 - APPROX ROW
 - DRIVEWAY NUMBER
 - PROP DITCH E
 - DITCH CENTERLINE RT
 - DITCH CENTERLINE LT

NOTE:

1. REFER TO MISCELLANEOUS DRIVEWAY DETAILS FOR ADDITIONAL INFORMATION.

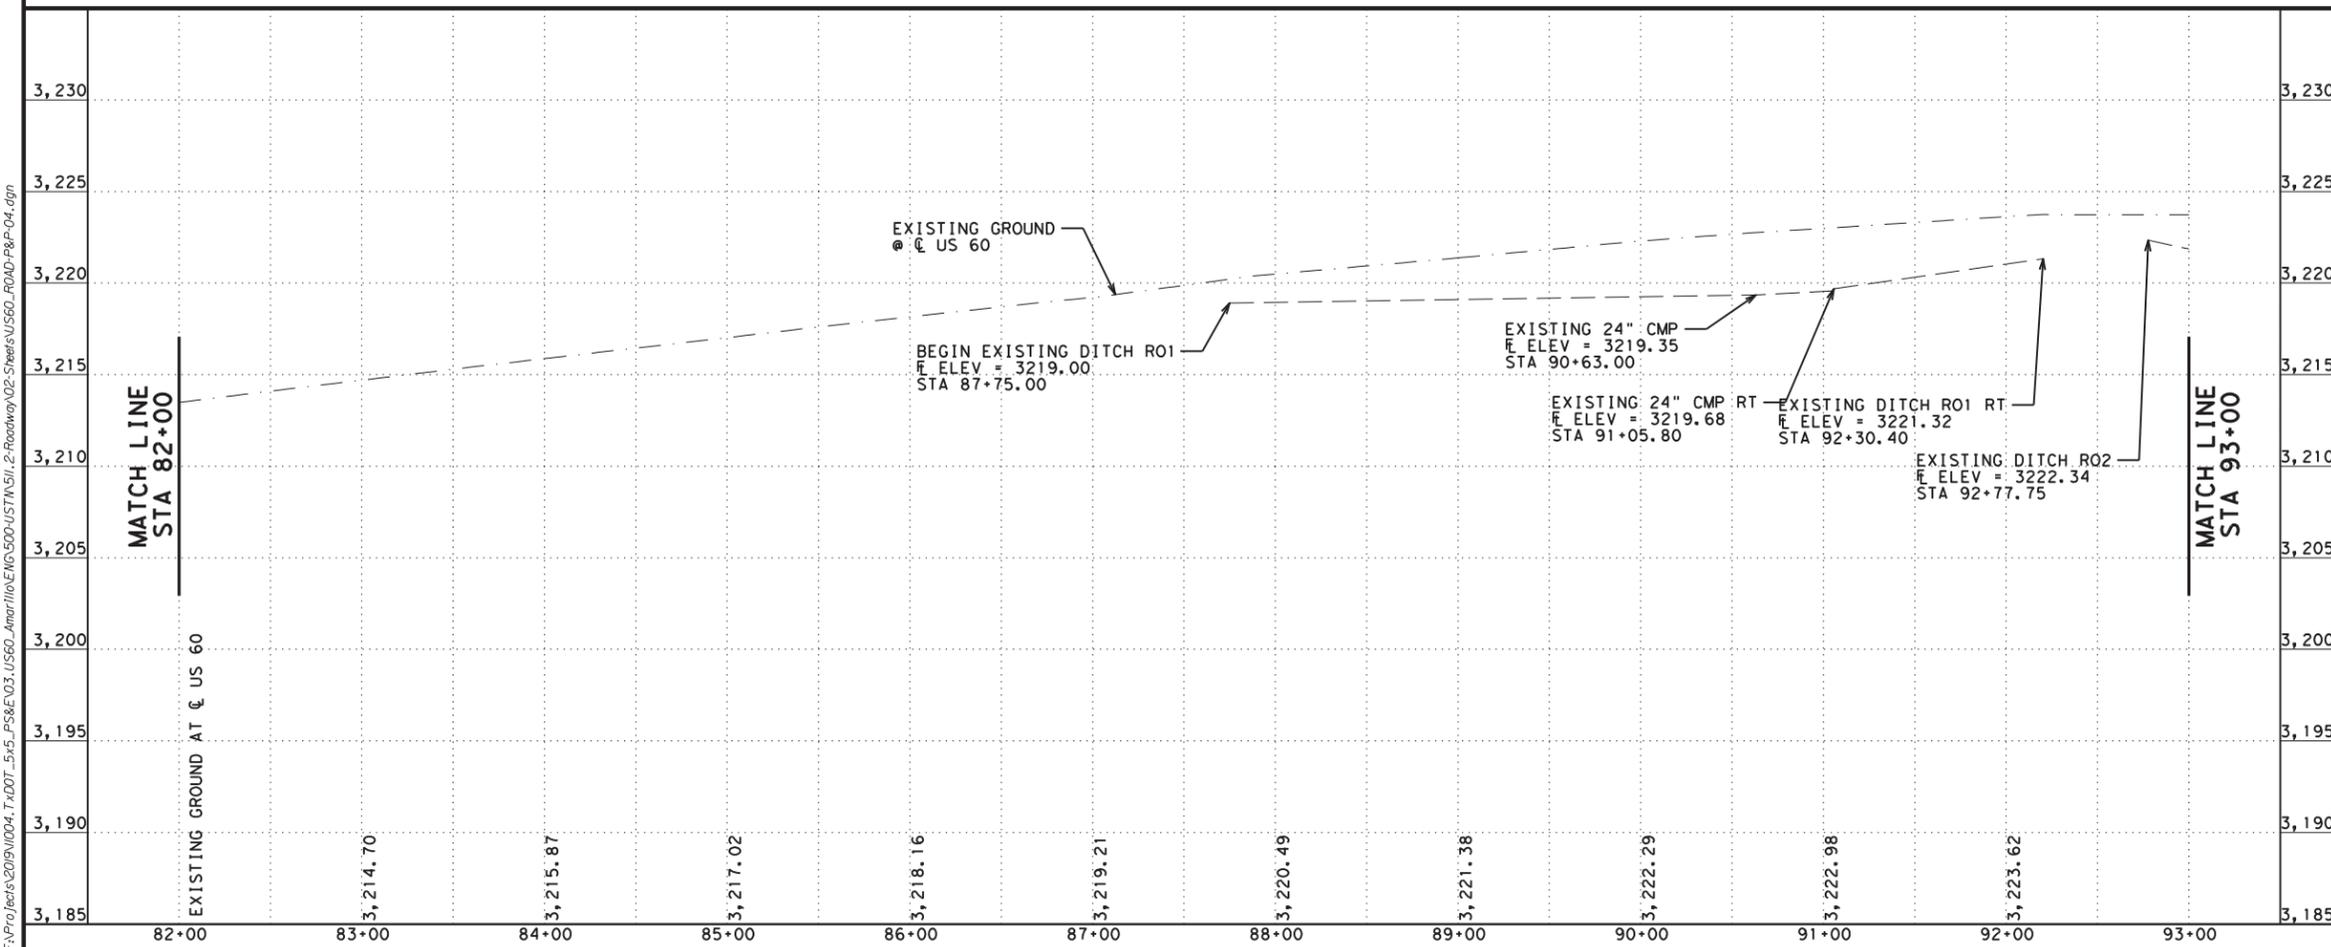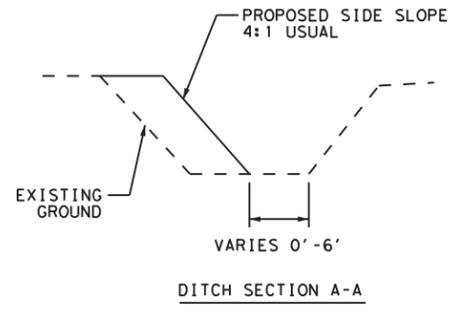

04/07/2021

Bo L. Ratto

0 25 50 100 (H)
0 5 10 (V)

REV. NO.	DATE	DESCRIPTION	BY

CobbFendley 13430 Northwest Freeway, Ste. 1100
Houston, Texas 77040
713.462.3242
www.cobbhendley.com

Texas Department of Transportation

**US 60
ROADWAY PLAN & PROFILE
STA 82+00 TO STA 93+00**


SHEET **4** OF **38**

FED. RD. DIV. NO.	STATE	PROJECT NO.	HIGHWAY NO.
6	TEXAS	(SEE TITLE SHEET)	US60
STATE DISTRICT	COUNTY	CONTROL NO.	SECTION NO.
AMA	GRAY	0169	07
		JOB NO.	SHEET NO.
		053, ETC	65

4/7/2021 7:56:39 AM F:\P\J\1621\2019\1004_TxDOT_5x5_P&S\03_US60_Amarillo\ENGIN\500-UST\1\511_2-Roadway\02-Sheets\US60_ROAD-P&P-04.dgn



US60-ROAD-P&P-04.dgn

CAUTION: UNDERGROUND UTILITY IN THIS AREA. CONTRACTOR TO VERIFY LOCATION AND DEPTH PRIOR TO EXCAVATION.

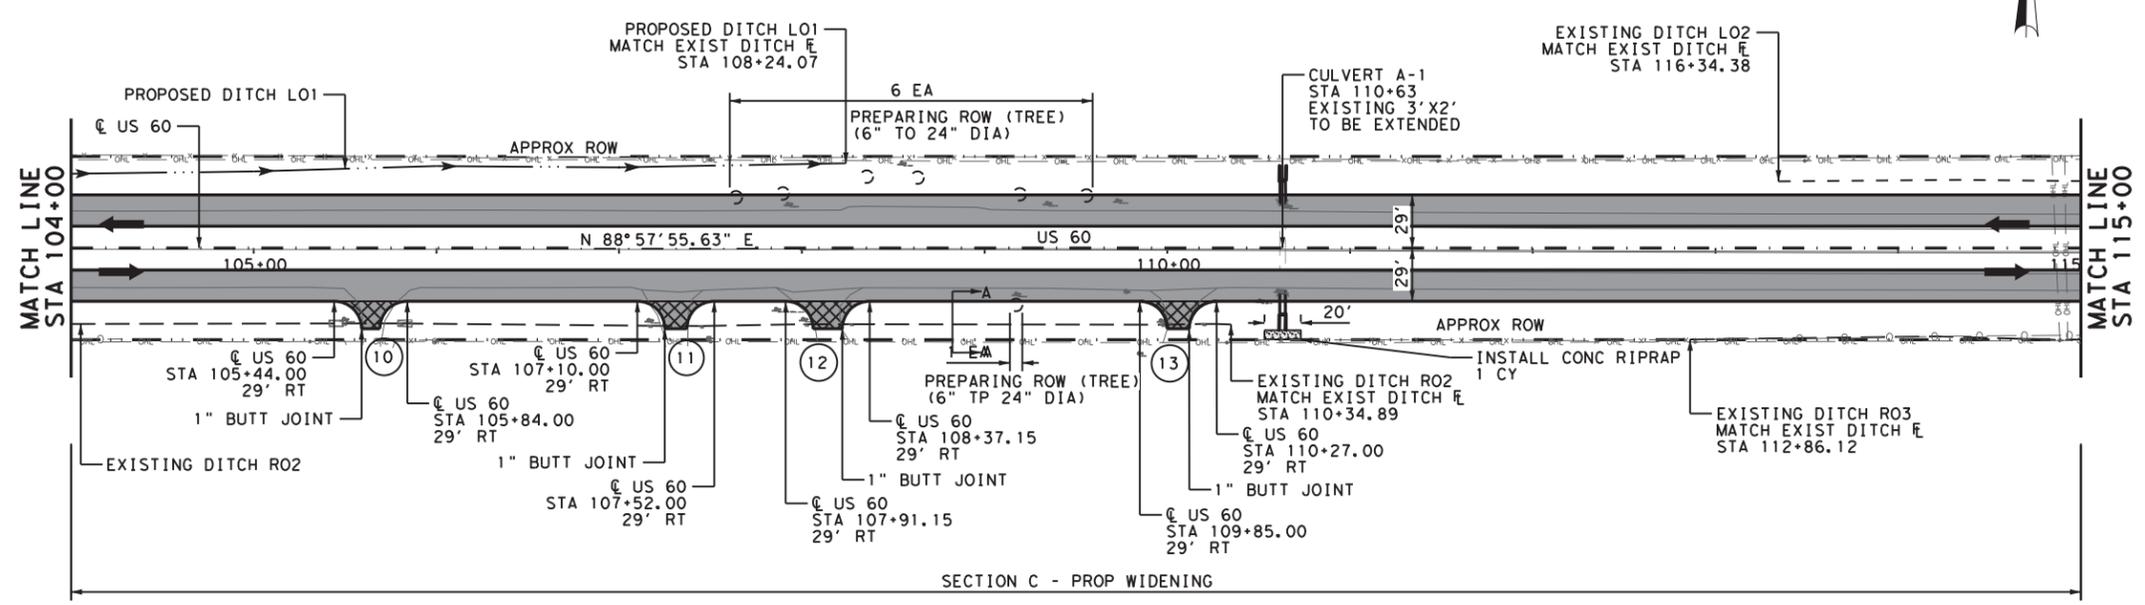

- LEGEND**
- PROPOSED PAVEMENT
 - PROPOSED DRIVEWAY
 - PROPOSED RIPRAP
 - PAVEMENT REMOVAL
 - EXIST TRAFFIC FLOW
 - PROP TRAFFIC FLOW
 - APPROX ROW
 - DRIVEWAY NUMBER
 - PROP DITCH CL
 - DITCH CENTERLINE RT
 - DITCH CENTERLINE LT

NOTE:
1. REFER TO MISCELLANEOUS DRIVEWAY DETAILS FOR ADDITIONAL INFORMATION.

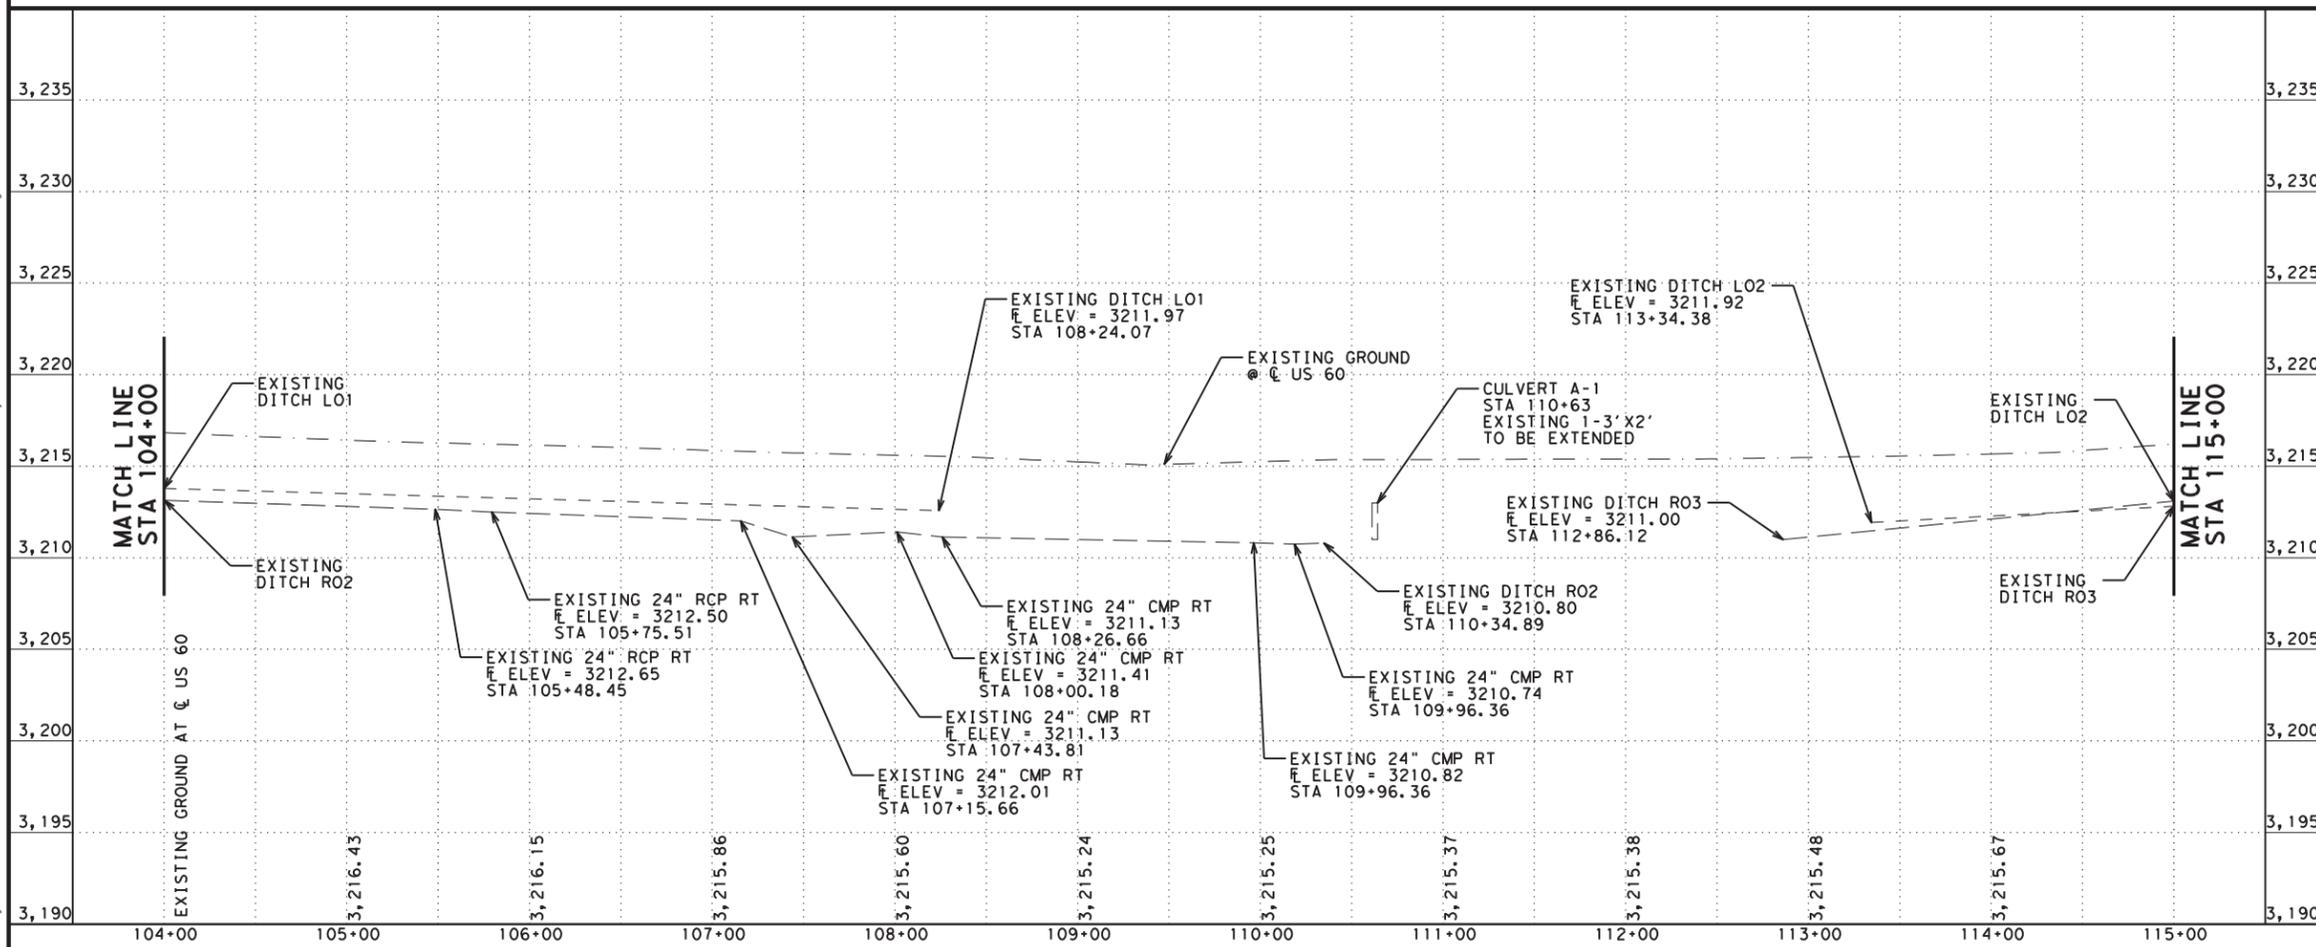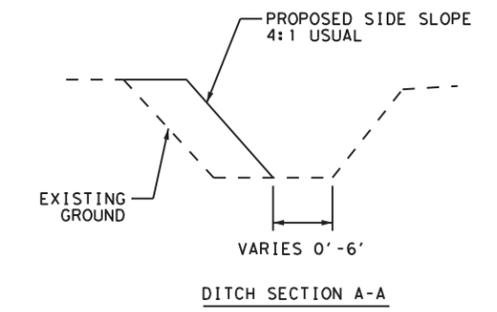

04/07/2021

Bo L. Ratto

REV. NO.	DATE	DESCRIPTION	BY

CobbFendley 13430 Northwest Freeway, Ste. 1100
Houston, Texas 77040
713.462.3242
www.cobbfendley.com




**US 60
ROADWAY PLAN & PROFILE
STA 104+00 TO STA 115+00**

FED. RD. DIV. NO.	STATE	PROJECT NO.	HIGHWAY NO.
6	TEXAS	(SEE TITLE SHEET)	US60
STATE DISTRICT	COUNTY	CONTROL NO.	SECTION NO.
AMA	GRAY	0169	07
		JOB NO.	SHEET NO.
		053, ETC	67



4/7/2021 7:26:41 AM F:\P\01\1625\2019\1004_TxDOT_3x5_PSS&E\03_US60_Amari\1616\ENG\500\UST\N\S\1_2_Roadway\02_Sheets\US60_ROAD_P&P-06.dgn

US60-ROAD-P&P-06.dgn

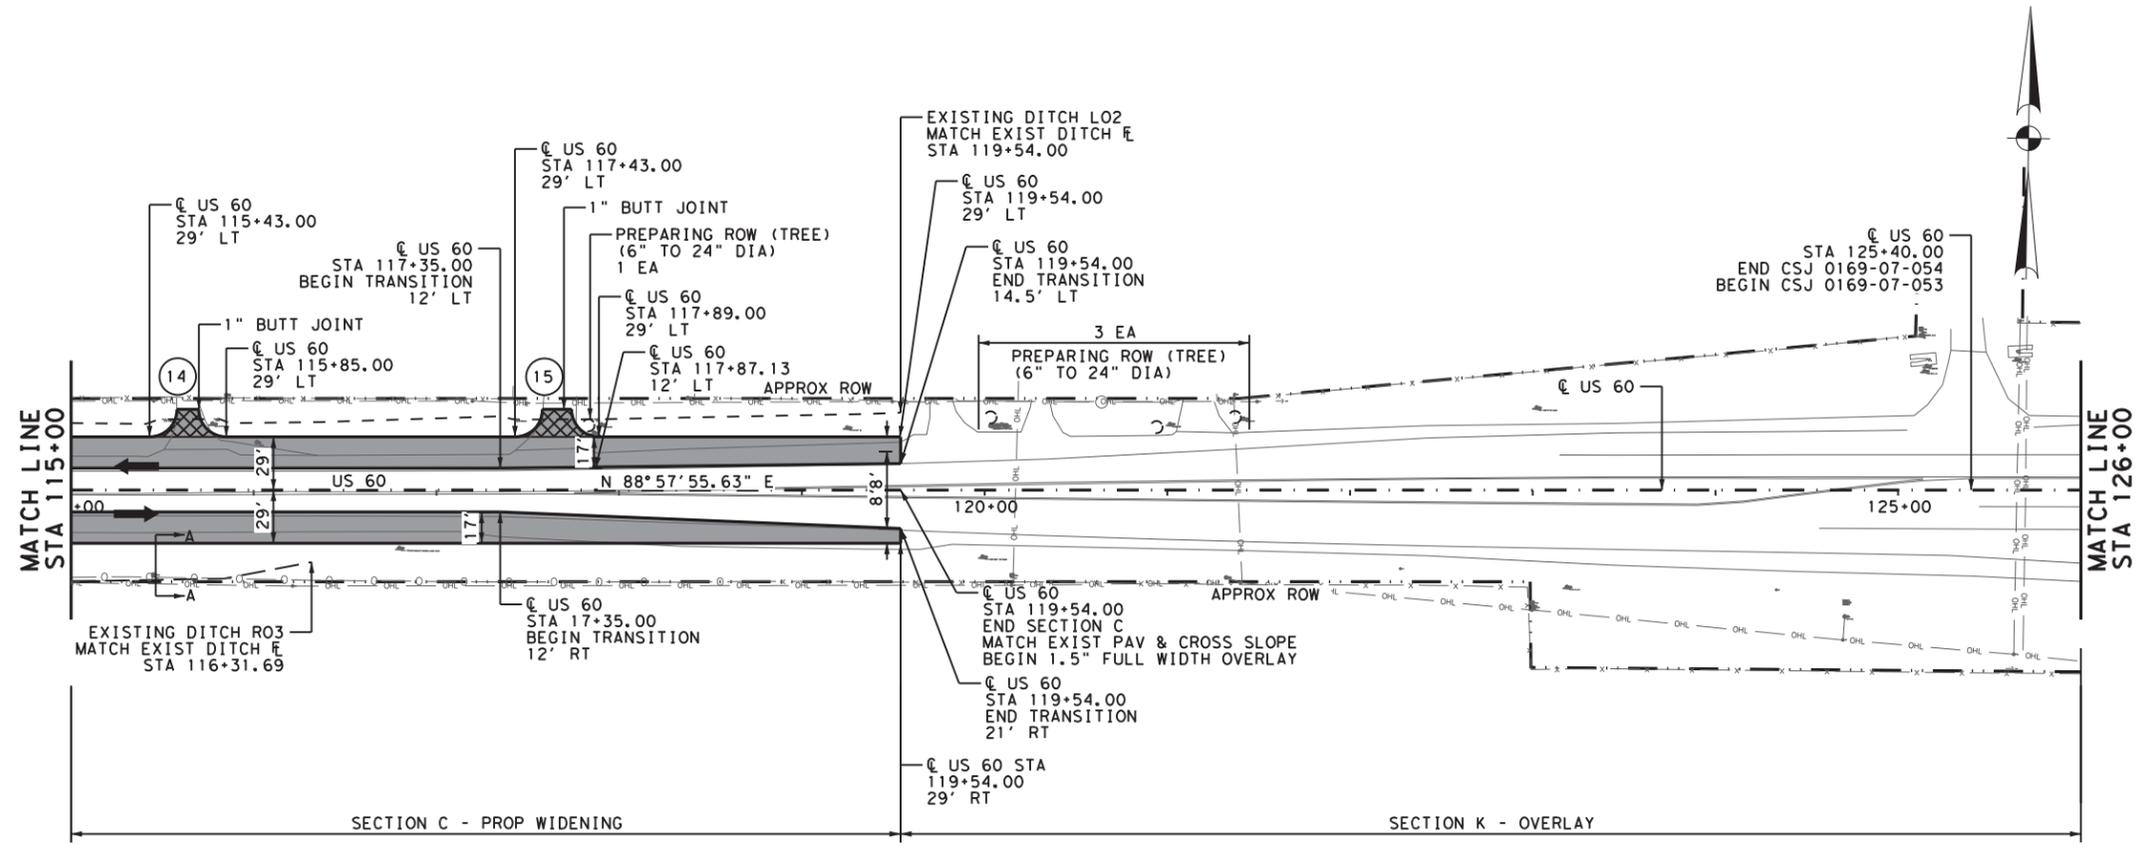

- LEGEND**
- PROPOSED PAVEMENT
 - PROPOSED DRIVEWAY
 - PROPOSED RIPRAP
 - PAVEMENT REMOVAL
 - EXIST TRAFFIC FLOW
 - PROP TRAFFIC FLOW
 - APPROX ROW
 - DRIVEWAY NUMBER
 - PROP DITCH E
 - DITCH CENTERLINE RT
 - DITCH CENTERLINE LT

NOTE:
1. REFER TO MISCELLANEOUS DRIVEWAY DETAILS FOR ADDITIONAL INFORMATION.

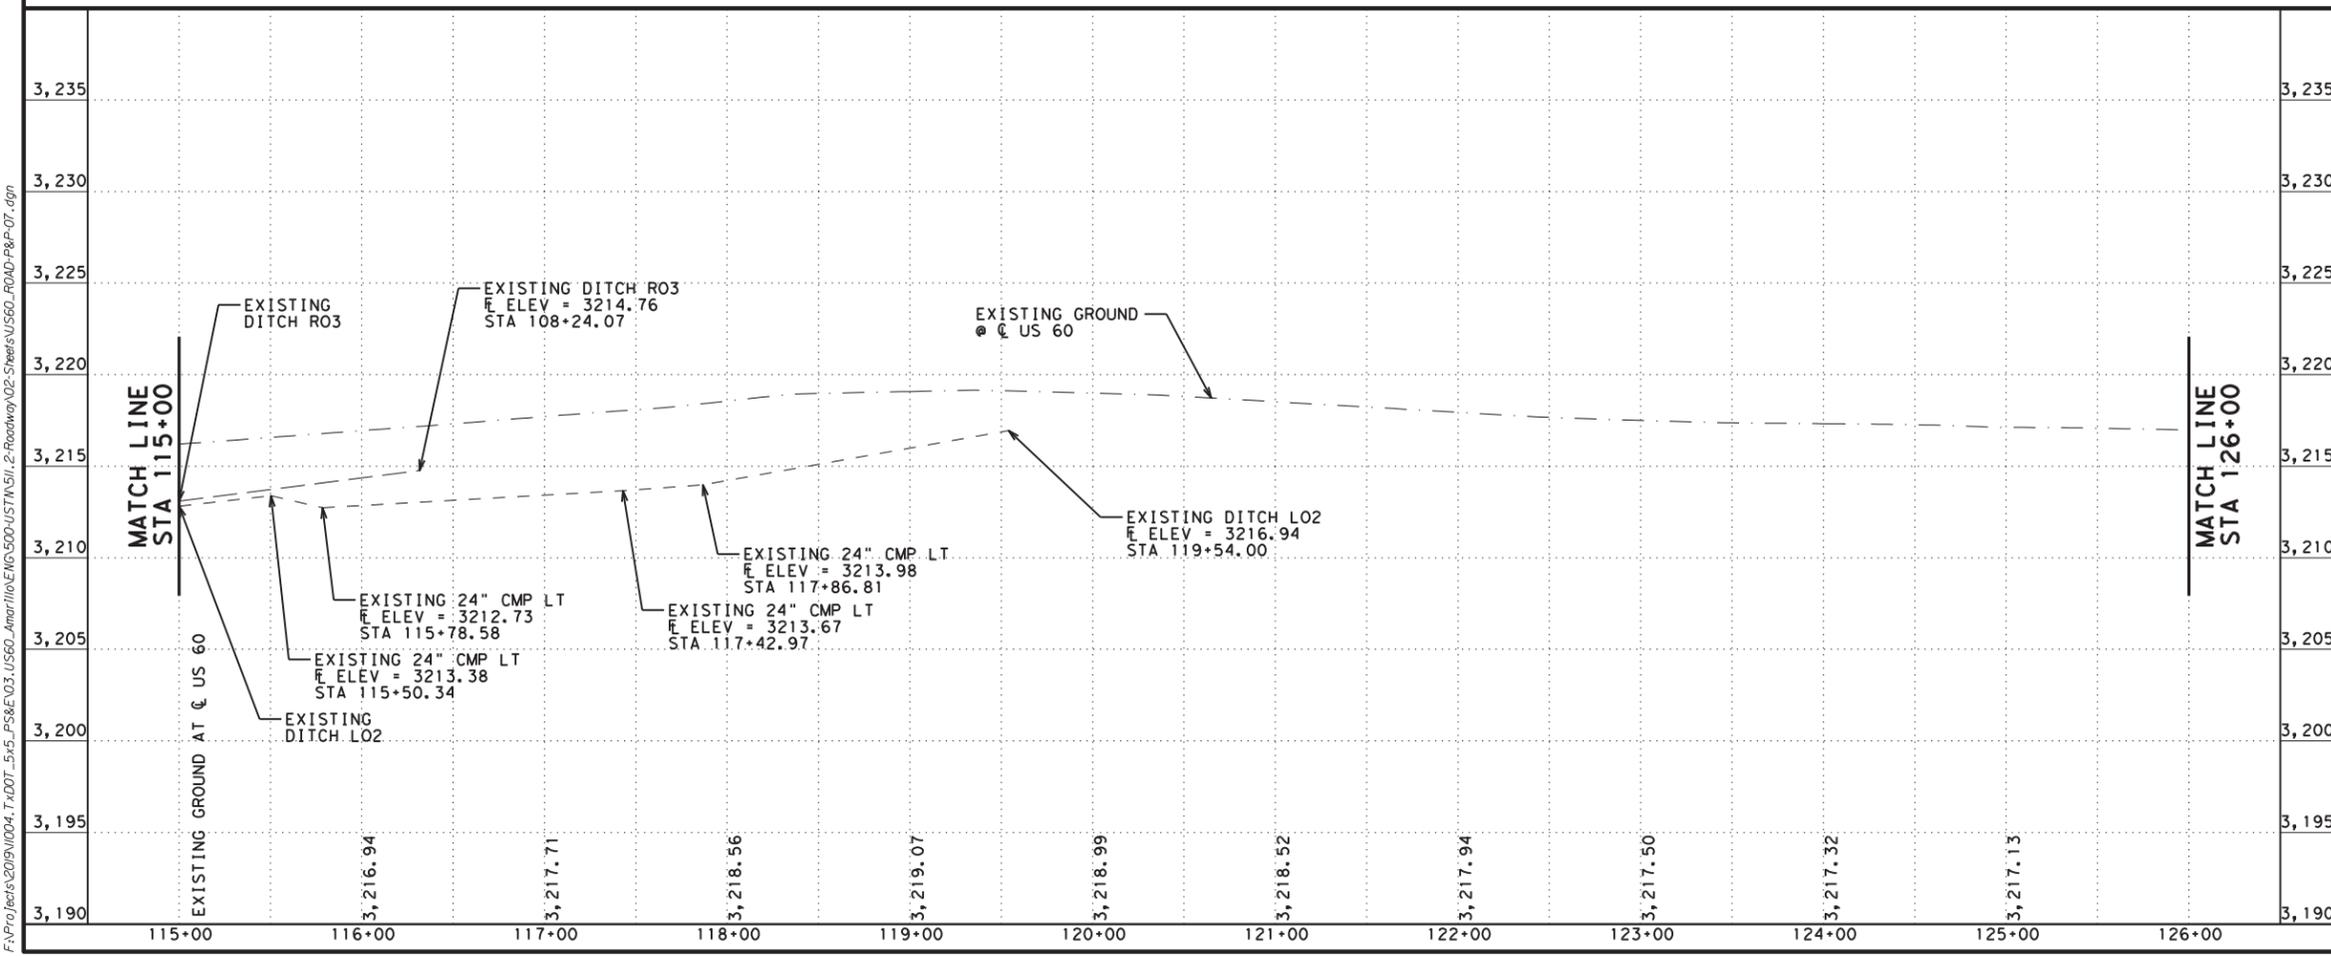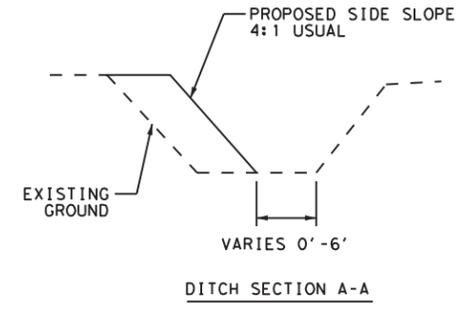

04/07/2021

Bo L. Ratto

0 25 50 100 (H)
0 5 10 (V)

REV. NO.	DATE	DESCRIPTION	BY

CobbFendley 13430 Northwest Freeway, Ste. 1100
Houston, Texas 77040
713.462.3242
www.cobbhendley.com




**US 60
ROADWAY PLAN & PROFILE
STA 115+00 TO STA 126+00**

FED. RD. DIV. NO.	STATE	PROJECT NO.	HIGHWAY NO.
6	TEXAS	(SEE TITLE SHEET)	US60
STATE DISTRICT	COUNTY	CONTROL NO.	SECTION NO.
AMA	GRAY	0169	07
		JOB NO.	SHEET NO.
		053, ETC	68


4/7/2021 7:26:42 AM F:\P\01\1620\1004_T\DOT_35\PS&E\03_US60_Amrt\1616\NG500\UST\N\11_2_Roadway\02_Sheets\US60_ROAD_P&P-07.dgn

US60-ROAD-P&P-07.dgn

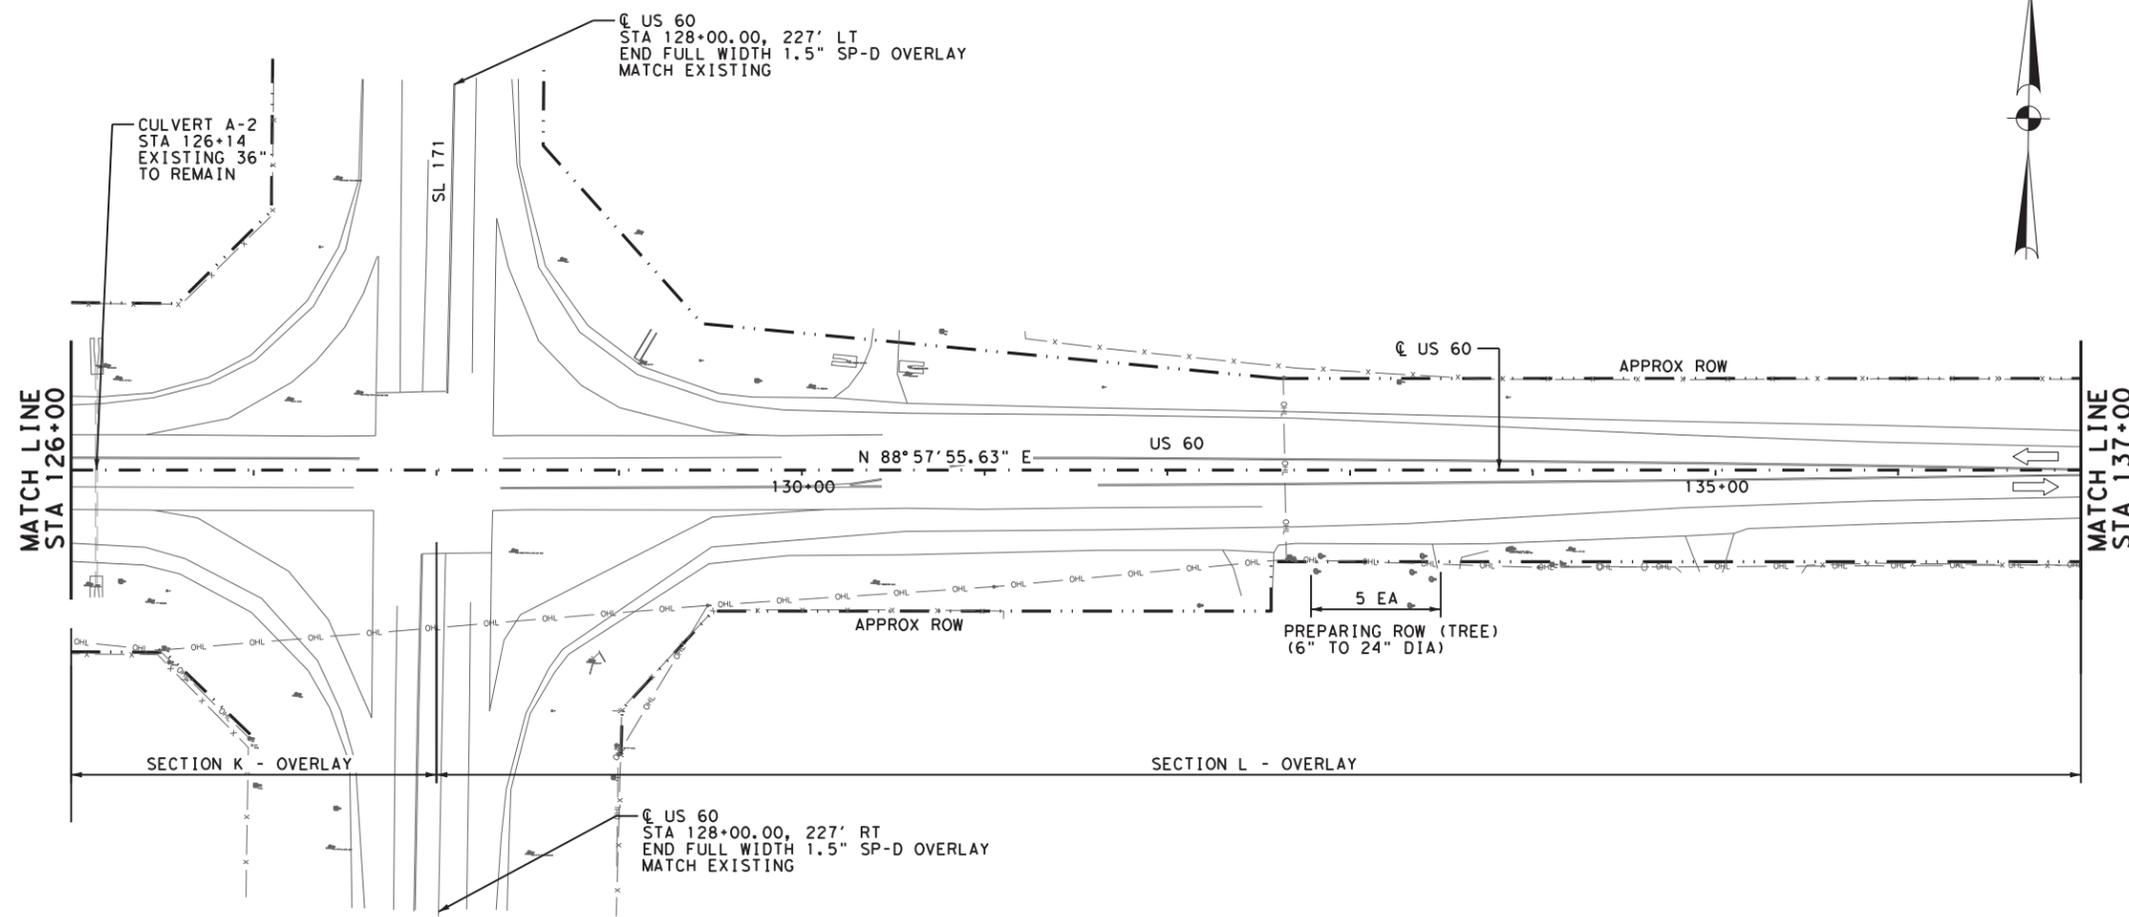

- LEGEND**
- PROPOSED PAVEMENT
 - PROPOSED DRIVEWAY
 - PROPOSED RIPRAP
 - PAVEMENT REMOVAL
 - EXIST TRAFFIC FLOW
 - PROP TRAFFIC FLOW
 - APPROX ROW
 - DRIVEWAY NUMBER
 - PROP DITCH

NOTE:
1. REFER TO MISCELLANEOUS DRIVEWAY DETAILS FOR ADDITIONAL INFORMATION.

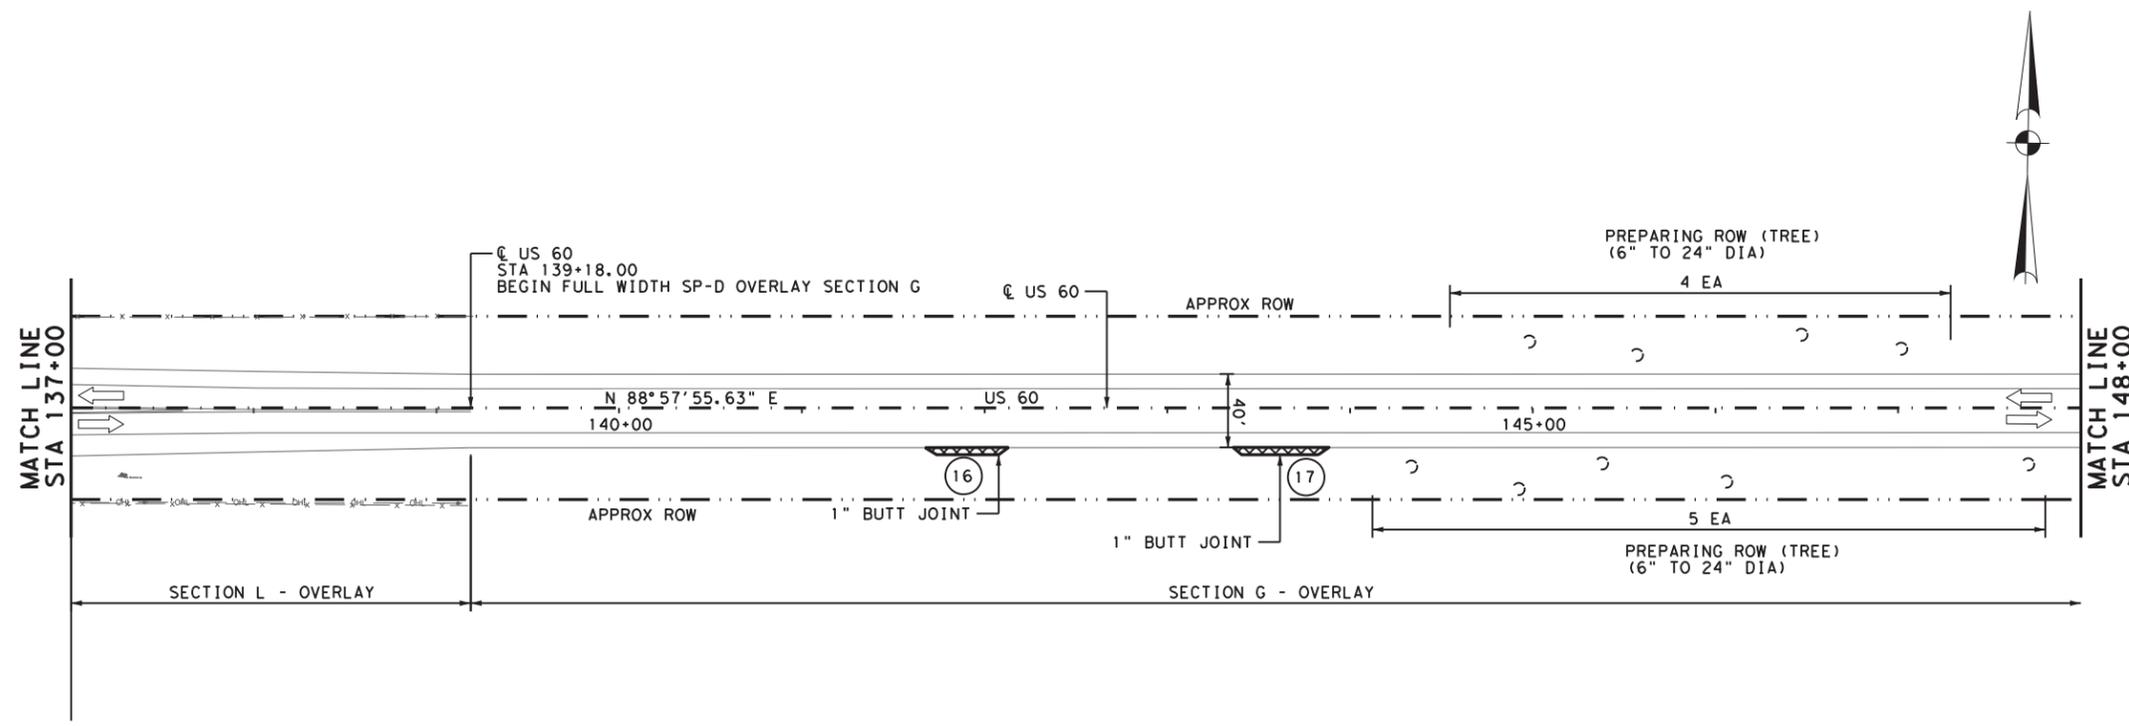

04/07/2021

Bo L. Ratto

0 25 50 100
1" = 100'

REV. NO.	DATE	DESCRIPTION	BY

CobbFendley 13430 Northwest Freeway, Ste. 1100
Houston, Texas 77040
713.462.3242
www.cobbhendley.com





**US 60
ROADWAY PLAN
STA 126+00 TO STA 148+00**

FED. RD. DIV. NO.	STATE	PROJECT NO.	HIGHWAY NO.
6	TEXAS	(SEE TITLE SHEET)	US60
STATE DISTRICT	COUNTY	CONTROL NO.	SECTION NO.
AMA	GRAY	0169	07
JOB NO.			SHEET NO.
053, ETC			69

4/7/2021 7:26:43 AM F:\P\J\1616\1616\US60-Roadway\02-Street\US60-Road\F&P-08.dgn

US60-ROAD-F&P-08.dgn

4/7/2021 7:26:44 AM F:\P\proj\2019\1004_Tx\DOT_5x5_P5&E\03_US60_Amarillo\ENGIN\500-UST\N\S\1_2-Roadway\02-Sheets\US60_ROAD-P&P-10.dgn

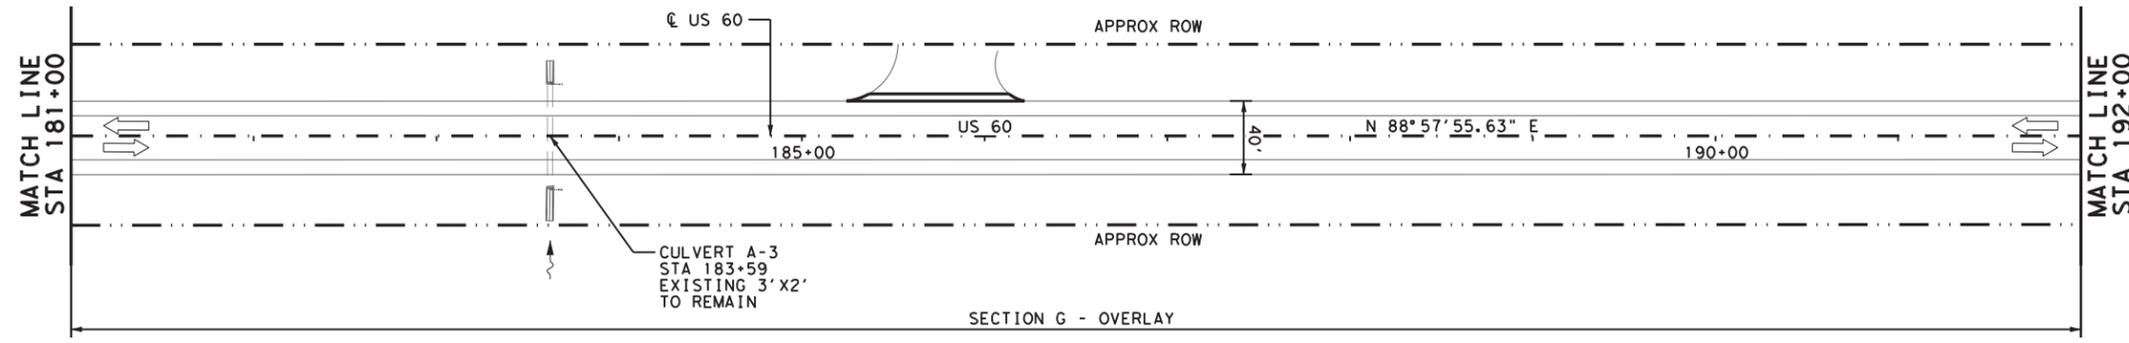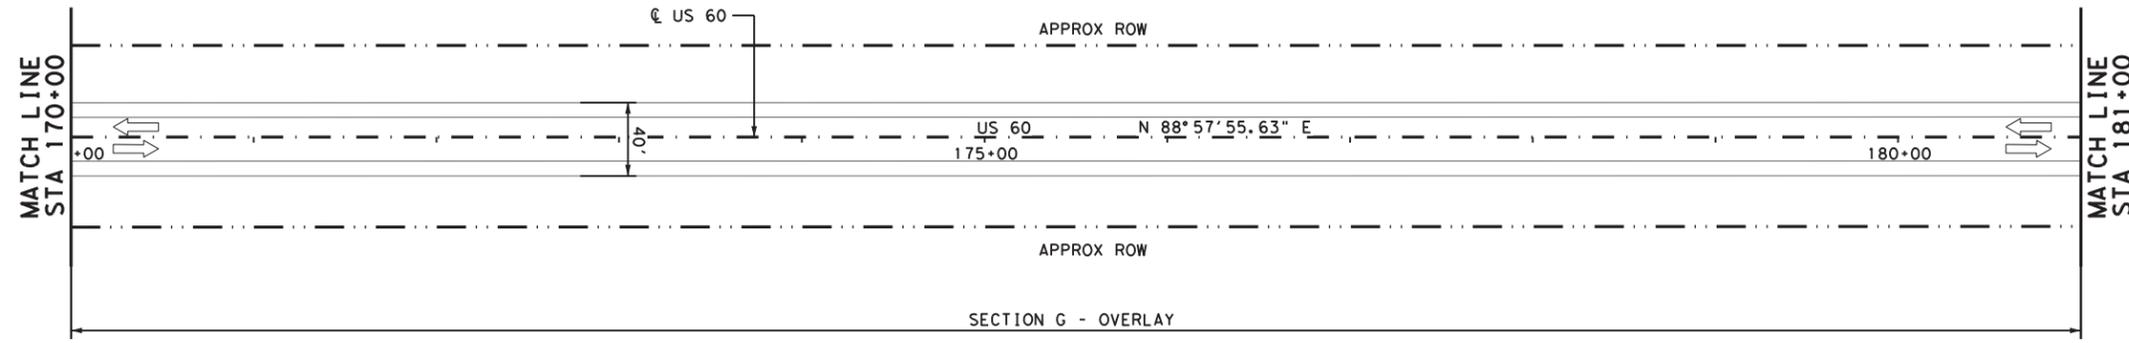

- LEGEND**
- PROPOSED PAVEMENT
 - PROPOSED DRIVEWAY
 - PROPOSED RIPRAP
 - PAVEMENT REMOVAL
 - EXIST TRAFFIC FLOW
 - PROP TRAFFIC FLOW
 - APPROX ROW
 - DRIVEWAY NUMBER
 - PROP DITCH

NOTE:
1. REFER TO MISCELLANEOUS DRIVEWAY DETAILS FOR ADDITIONAL INFORMATION.

04/07/2021

Bo L. Ratto

REV. NO.	DATE	DESCRIPTION	BY

CobbFendley 13430 Northwest Freeway, Ste. 1100
Houston, Texas 77040
713.462.3242
www.cobbhendley.com

Texas Department of Transportation


**US 60
ROADWAY PLAN
STA 170+00 TO STA 192+00**

SHEET 10 OF 38

FED. RD. DIV. NO.	STATE	PROJECT NO.	HIGHWAY NO.
6	TEXAS	(SEE TITLE SHEET)	US60
STATE DISTRICT	COUNTY	CONTROL NO.	SECTION NO.
AMA	GRAY	0169	07
		JOB NO.	SHEET NO.
		053, ETC	71

US60-ROAD-P&P-10.dgn

4/7/2021 7:26:46 AM F:\P\Projects\2019\1004_TxDOT_5x5_P5&E\03_US60_Amarillo\ENGIN\500-UST\N\S\1_2-Roadway\02-Sheets\US60_ROAD-F&P-12.dgn

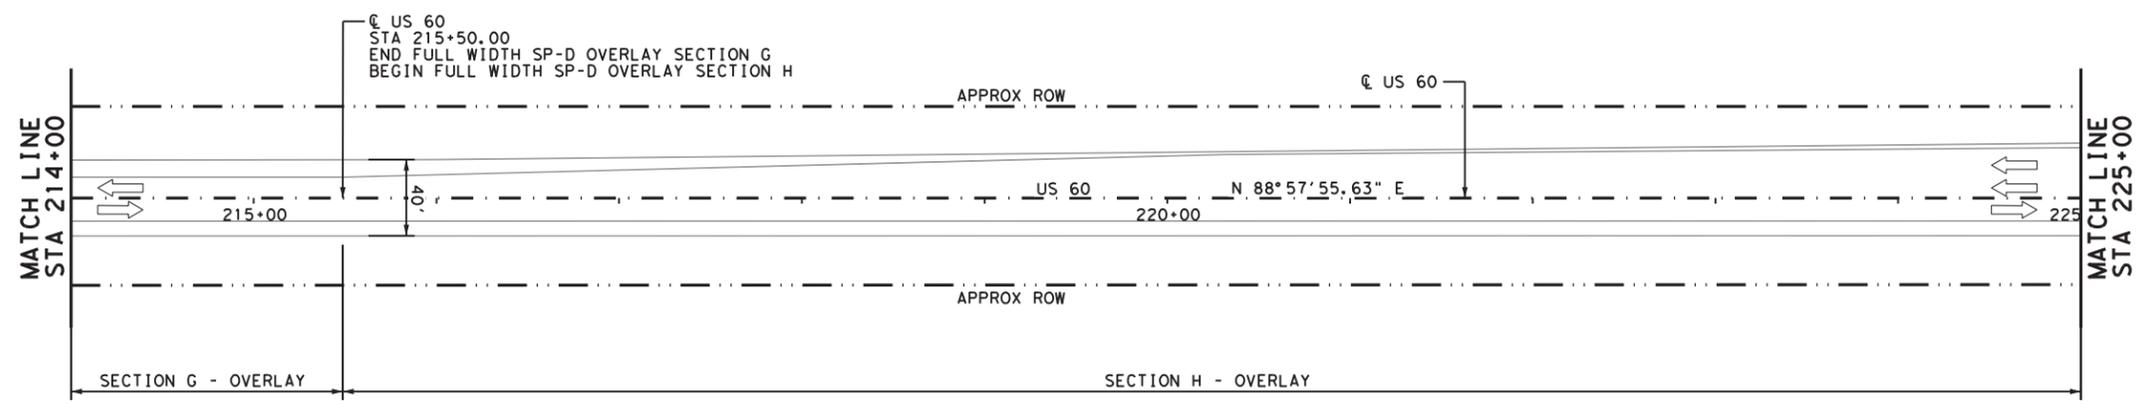


LEGEND

- PROPOSED PAVEMENT
- PROPOSED DRIVEWAY
- PROPOSED RIPRAP
- PAVEMENT REMOVAL
- EXIST TRAFFIC FLOW
- PROP TRAFFIC FLOW
- APPROX ROW
- DRIVEWAY NUMBER
- PROP DITCH

NOTE:

1. REFER TO MISCELLANEOUS DRIVEWAY DETAILS FOR ADDITIONAL INFORMATION.

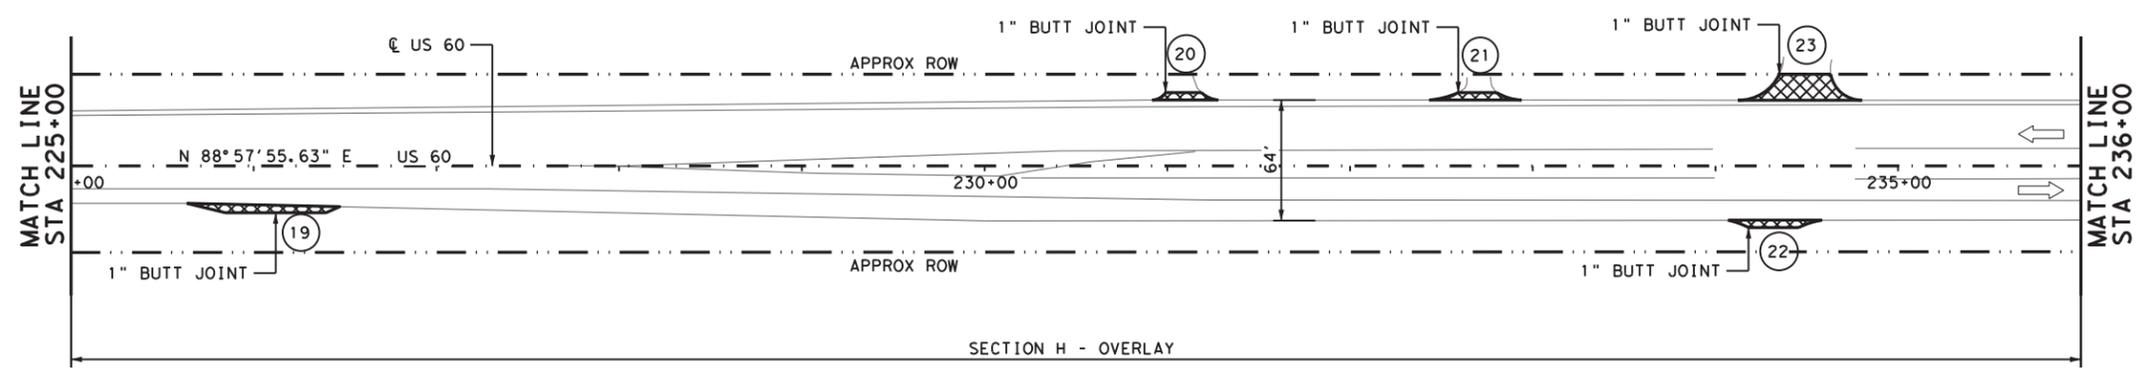

04/07/2021

Bo L. Ratto

0 25 50 100
1" = 100'

REV. NO.	DATE	DESCRIPTION	BY

CobbFendley 13430 Northwest Freeway, Ste. 1100
Houston, Texas 77040
713.462.3242
www.cobbhendley.com



Texas Department of Transportation

**US 60
ROADWAY PLAN
STA 214+00 TO STA 236+00**

FED. RD. DIV. NO.	STATE	PROJECT NO.	HIGHWAY NO.		
6	TEXAS	(SEE TITLE SHEET)	US60		
STATE DISTRICT	COUNTY	CONTROL NO.	SECTION NO.	JOB NO.	SHEET NO.
AMA	GRAY	0169	07	053, ETC	73

US60-ROAD-F&P-12.dgn

4/7/2021 7:26:47 AM F:\P\J\2019\1004_Tx\DOT_5x5_P5&E\03_US60_Amar\1161616\500-UST\N\511_2-Roadway\02-Sheets\US60_ROAD-F&P-13.dgn

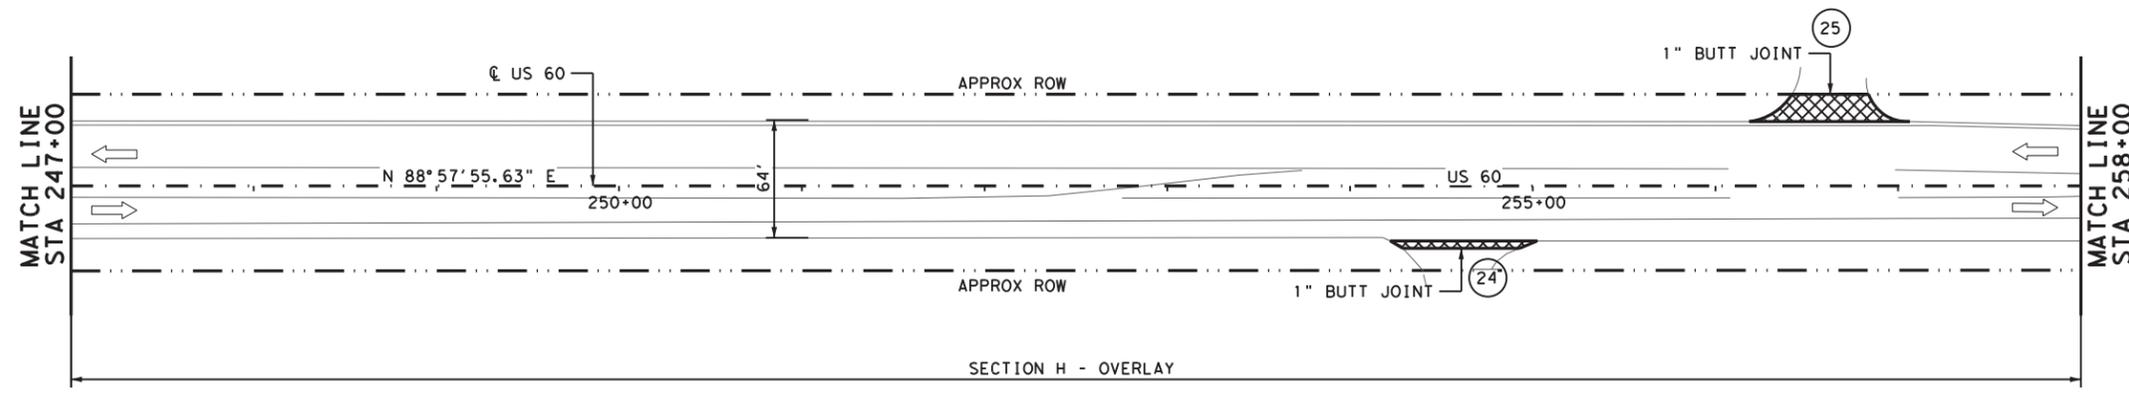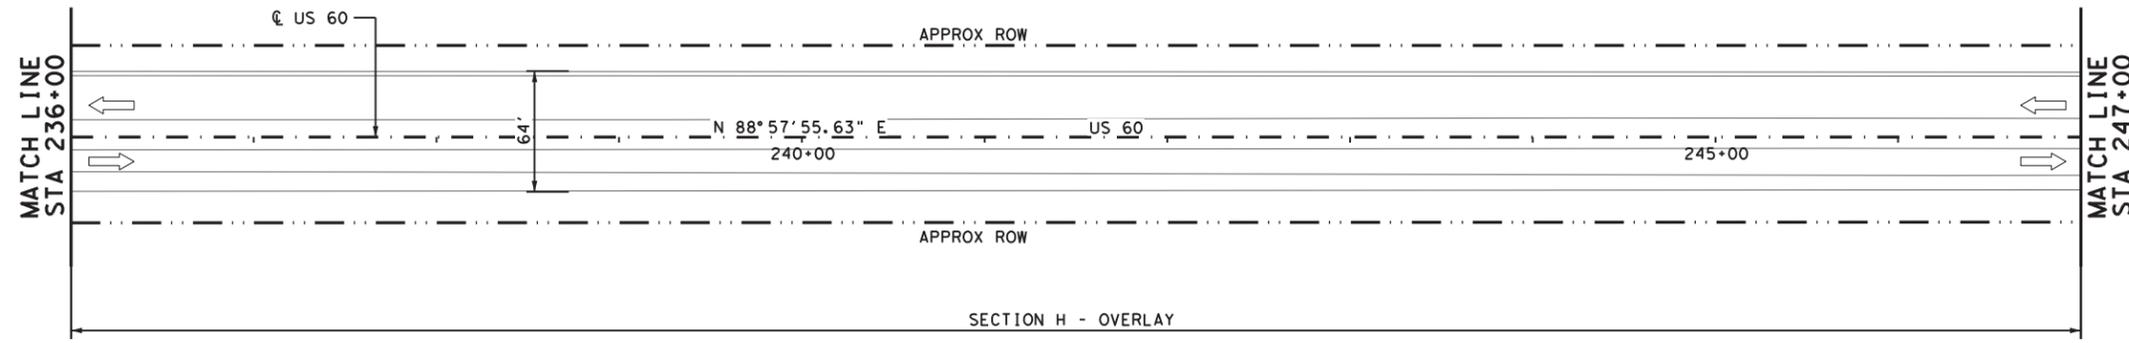

- LEGEND**
- PROPOSED PAVEMENT
 - PROPOSED DRIVEWAY
 - PROPOSED RIPRAP
 - PAVEMENT REMOVAL
 - EXIST TRAFFIC FLOW
 - PROP TRAFFIC FLOW
 - APPROX ROW
 - DRIVEWAY NUMBER
 - PROP DITCH

NOTE:
1. REFER TO MISCELLANEOUS DRIVEWAY DETAILS FOR ADDITIONAL INFORMATION.

04/07/2021

Bo L. Ratto

REV. NO.	DATE	DESCRIPTION	BY

CobbFendley 13430 Northwest Freeway, Ste. 1100
Houston, Texas 77040
713.462.3242
www.cobbfendley.com

Texas Department of Transportation

**US 60
ROADWAY PLAN
STA 236+00 TO STA 258+00**



FED. RD. DIV. NO.	STATE	PROJECT NO.	HIGHWAY NO.		
6	TEXAS	(SEE TITLE SHEET)	US60		
STATE DISTRICT	COUNTY	CONTROL NO.	SECTION NO.	JOB NO.	SHEET NO.
AMA	GRAY	0169	07	053, ETC	74

US60-ROAD-F&P-13.dgn

LEGEND

-  PROPOSED PAVEMENT
-  PROPOSED DRIVEWAY
-  PROPOSED RIPRAP
-  PAVEMENT REMOVAL
-  EXIST TRAFFIC FLOW
-  PROP TRAFFIC FLOW
-  APPROX ROW
-  DRIVEWAY NUMBER
-  PROP DITCH

NOTE:
1. REFER TO MISCELLANEOUS DRIVEWAY DETAILS FOR ADDITIONAL INFORMATION.

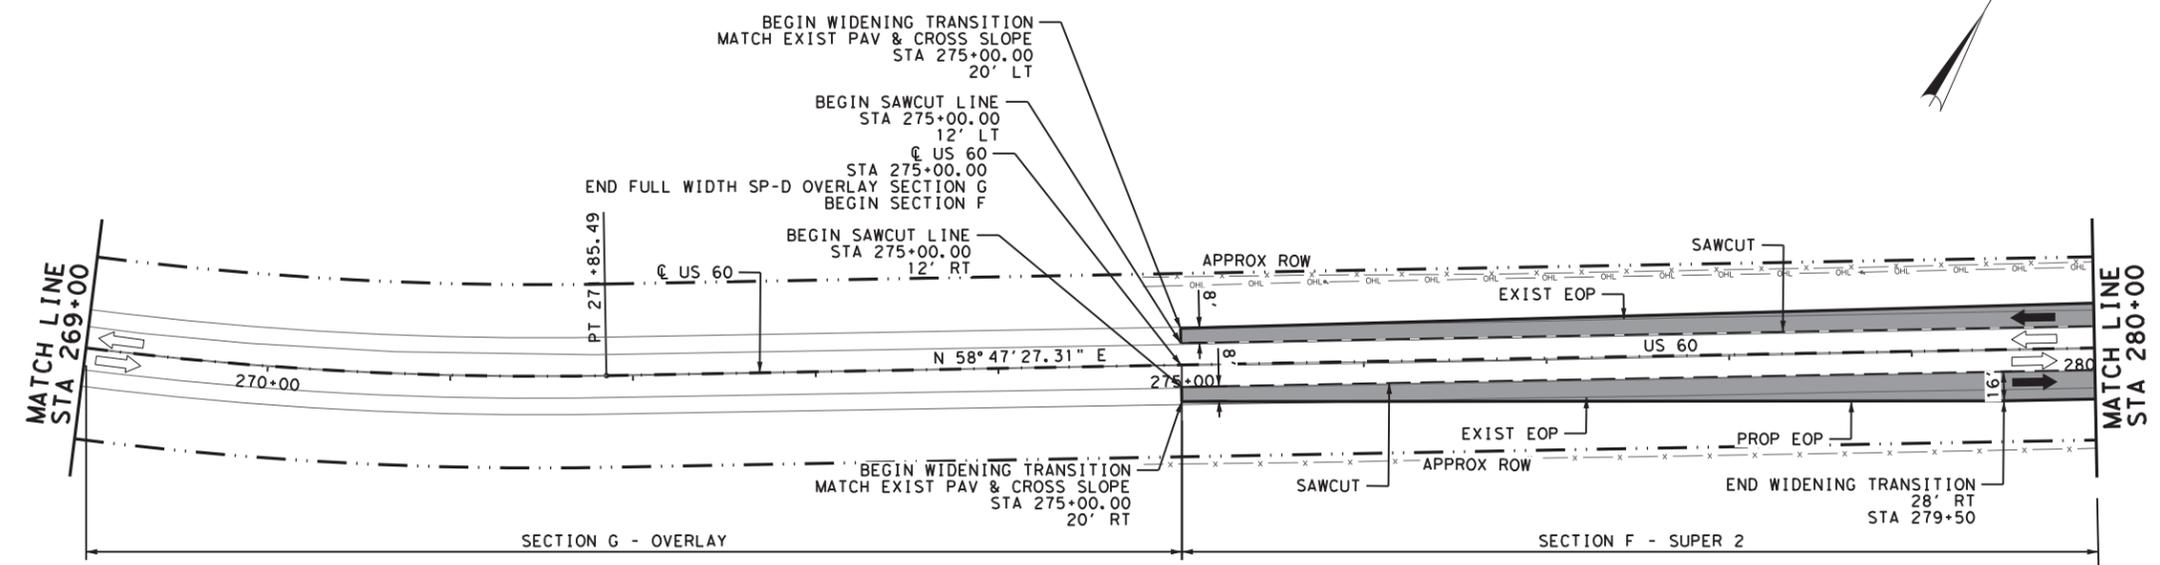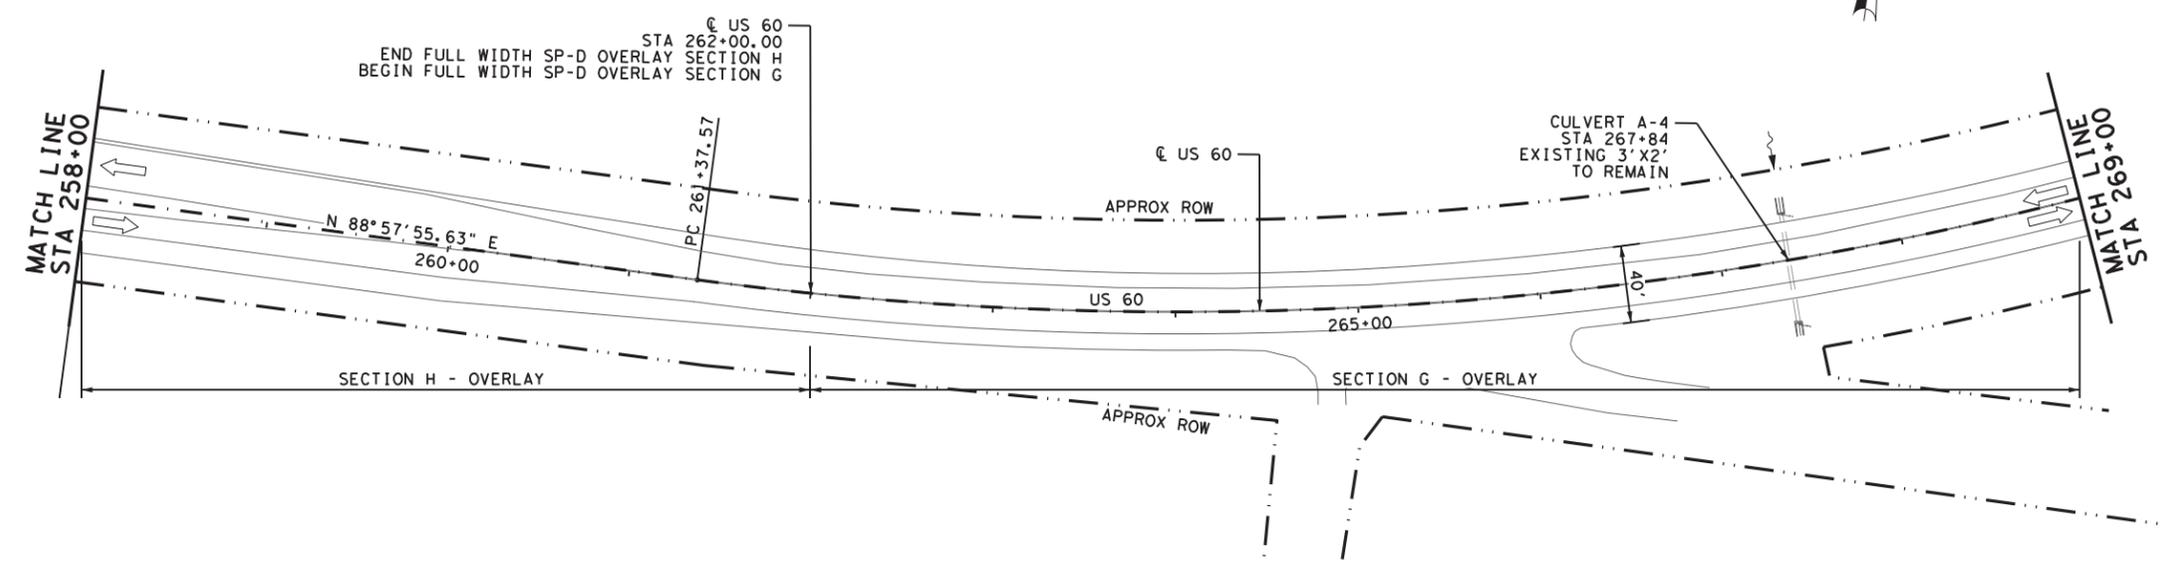

04/07/2021



Bo L. Ratto

0 25 50 100
1" = 100'

REV. NO.	DATE	DESCRIPTION	BY

CobbFendley 13430 Northwest Freeway, Ste. 1100
Houston, Texas 77040
713.462.3242
www.cobbhendley.com




**US 60
ROADWAY PLAN
STA 258+00 TO STA 280+00**

SHEET 14 OF 38

FED. RD. DIV. NO.	STATE	PROJECT NO.	HIGHWAY NO.
6	TEXAS	(SEE TITLE SHEET)	US60
STATE DISTRICT	COUNTY	CONTROL NO.	SECTION NO.
AMA	GRAY	0169	07
		JOB NO.	SHEET NO.
		053, ETC	75

4/7/2021 7:26:48 AM F:\P\proj\162019\1004_TxDOT_155_P5&E\03_US60_Amar\11616\162019\1004_TxDOT_155_P5&E\03_US60_Roadway\02_Sheets\US60_Road_P8-P14.dgn


CAUTION: UNDERGROUND AND OVERHEAD UTILITIES IN THIS AREA. CONTRACTOR TO VERIFY LOCATION AND DEPTH PRIOR TO EXCAVATION. CONTRACTOR TO AVOID /PROTECT OVERHEAD LINES AND POLES DURING CONSTRUCTION AS NECESSARY.

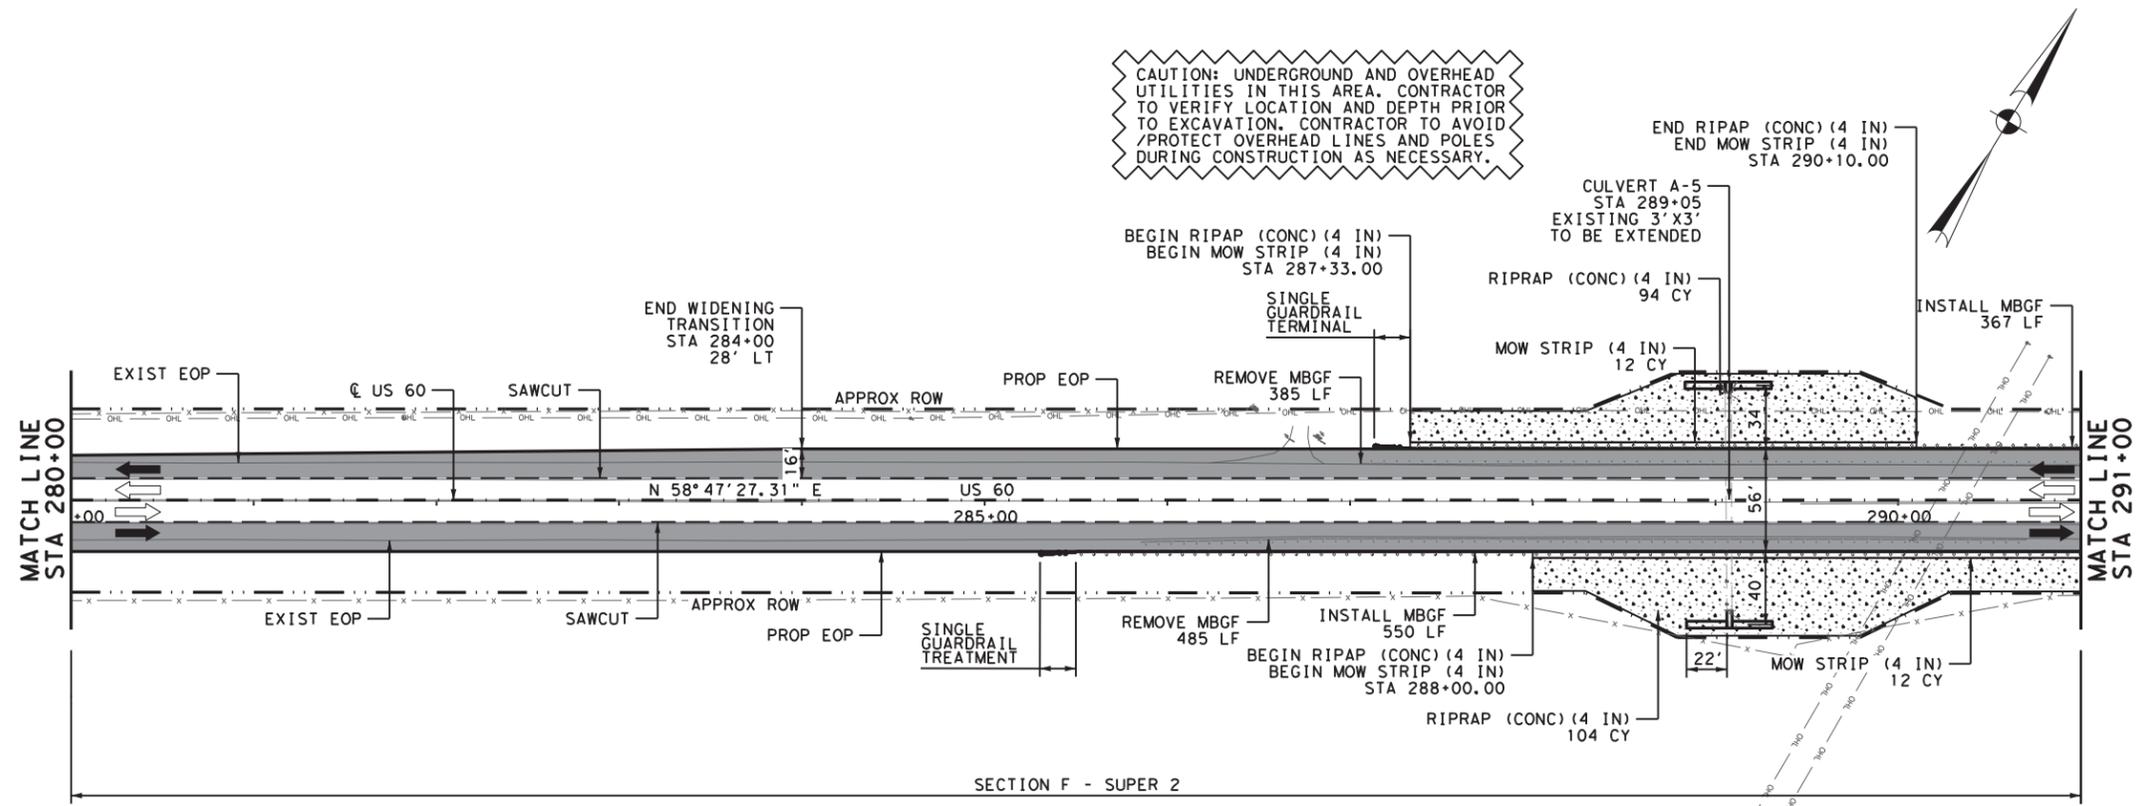

SECTION F - SUPER 2

- LEGEND**
- PROPOSED PAVEMENT
 - PROPOSED DRIVEWAY
 - PROPOSED RIPRAP
 - PAVEMENT REMOVAL
 - EXIST TRAFFIC FLOW
 - PROP TRAFFIC FLOW
 - APPROX ROW
 - DRIVEWAY NUMBER
 - PROP DITCH

NOTE:
1. REFER TO MISCELLANEOUS DRIVEWAY DETAILS FOR ADDITIONAL INFORMATION.

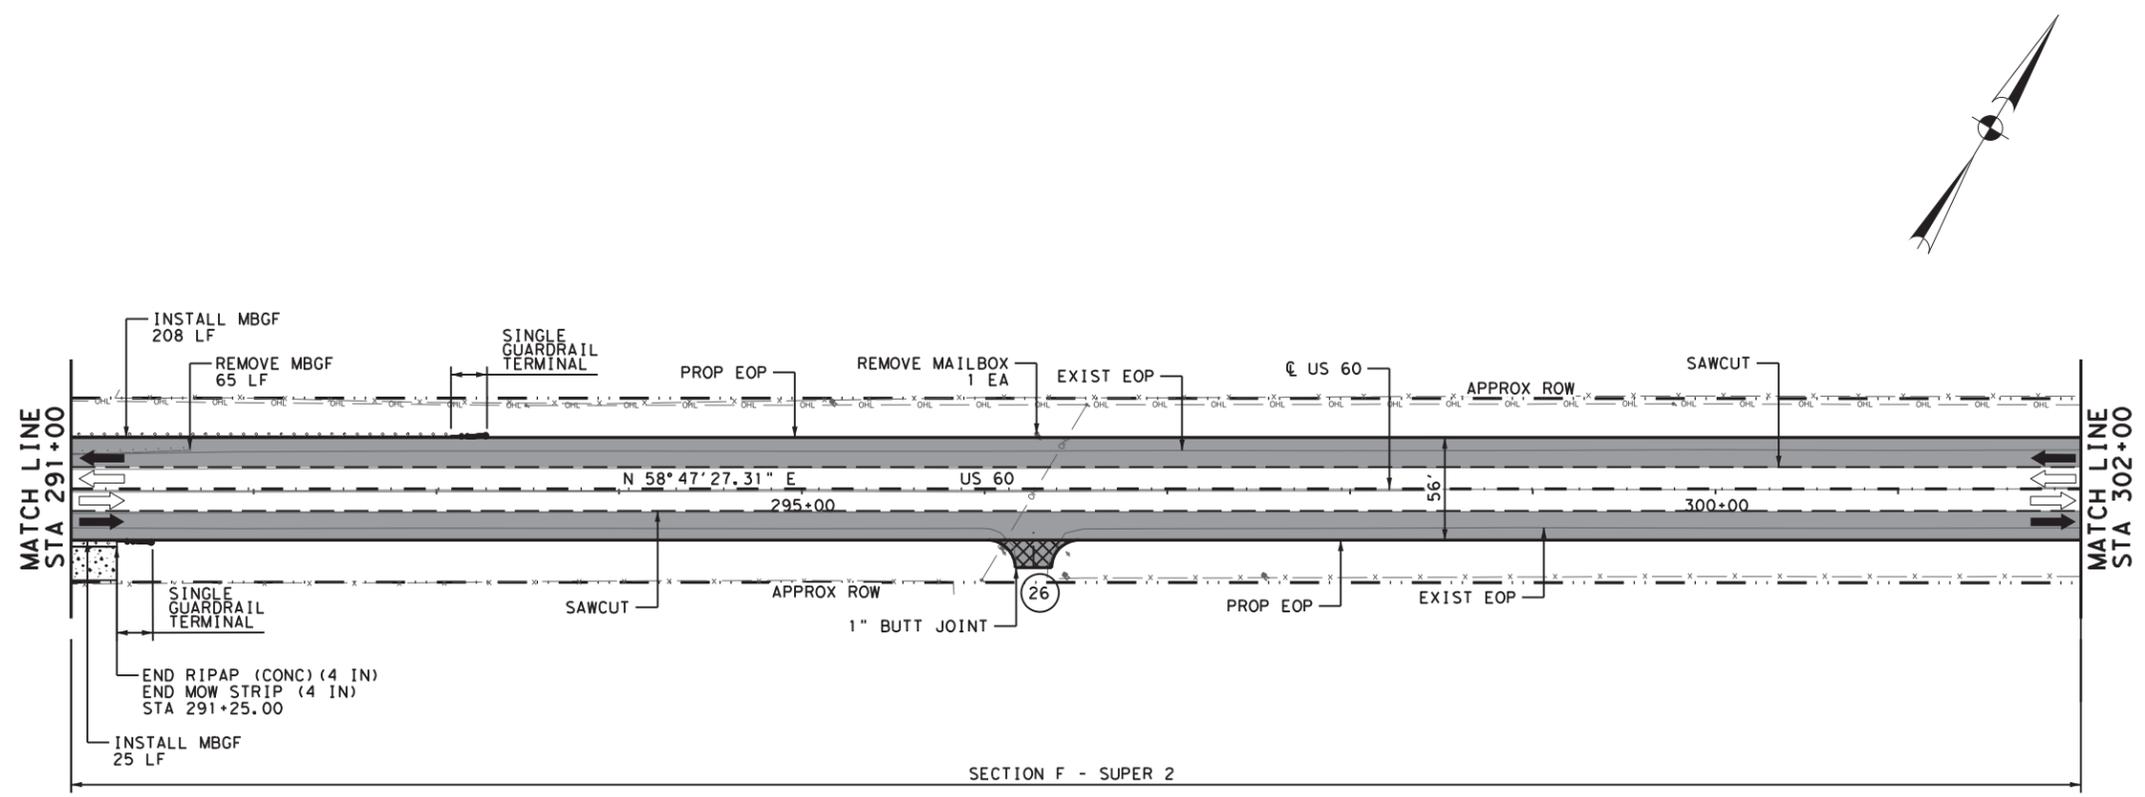

SECTION F - SUPER 2

04/07/2021

Bo L. Ratto

REV. NO.	DATE	DESCRIPTION	BY

CobbFendley 13430 Northwest Freeway, Ste. 1100
Houston, Texas 77040
713.462.3242
www.cobbhendley.com





**US 60
ROADWAY PLAN
STA 280+00 TO STA 302+00**

SHEET 15 OF 38

FED. RD. DIV. NO.	STATE	PROJECT NO.	HIGHWAY NO.		
6	TEXAS	(SEE TITLE SHEET)	US60		
STATE DISTRICT	COUNTY	CONTROL NO.	SECTION NO.	JOB NO.	SHEET NO.
AMA	GRAY	0169	07	053, ETC	76

4/7/2021 F:\P\0\16216\2019\1004_Tx\DOT_3x5_P5&E\03_US60_Amari\161616\US60-UST\161616_2-Roadway\02-Sheets\US60_ROAD-F&P-15.dgn 7:26:48 AM

4/7/2021 7:26:49 AM F:\P\0\02\2019\1004_TxDOT_353_P5&E\03_US60_Amari\16\16\500\UST\N\11_2-Roadway\02-Street\US60_ROAD-F&P-16.dgn

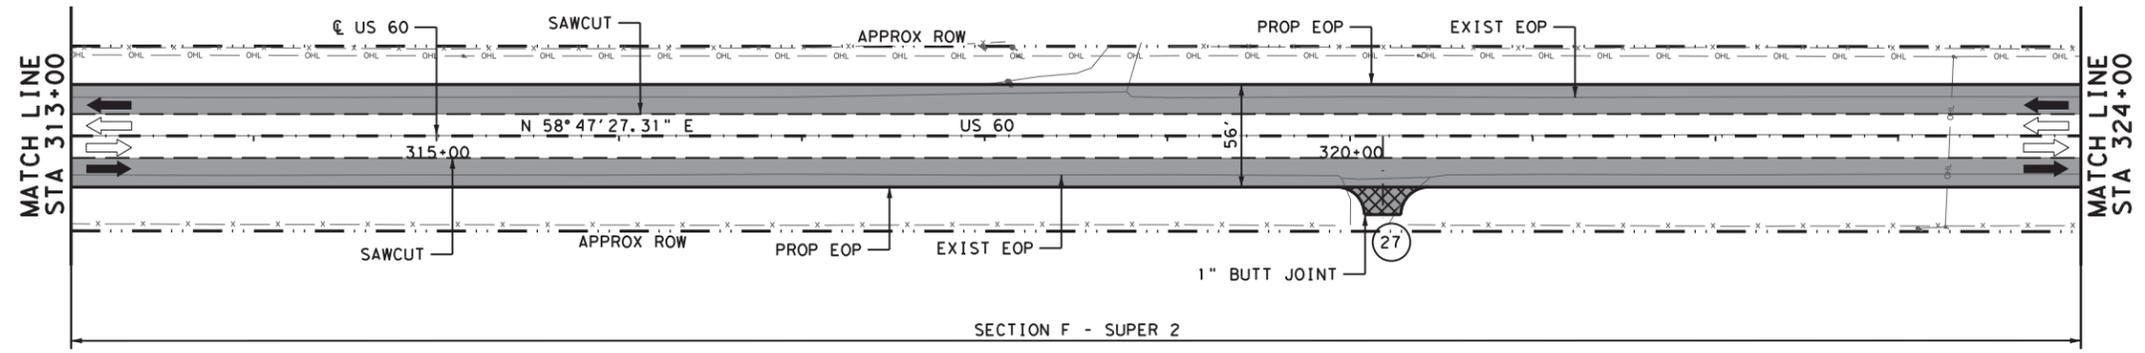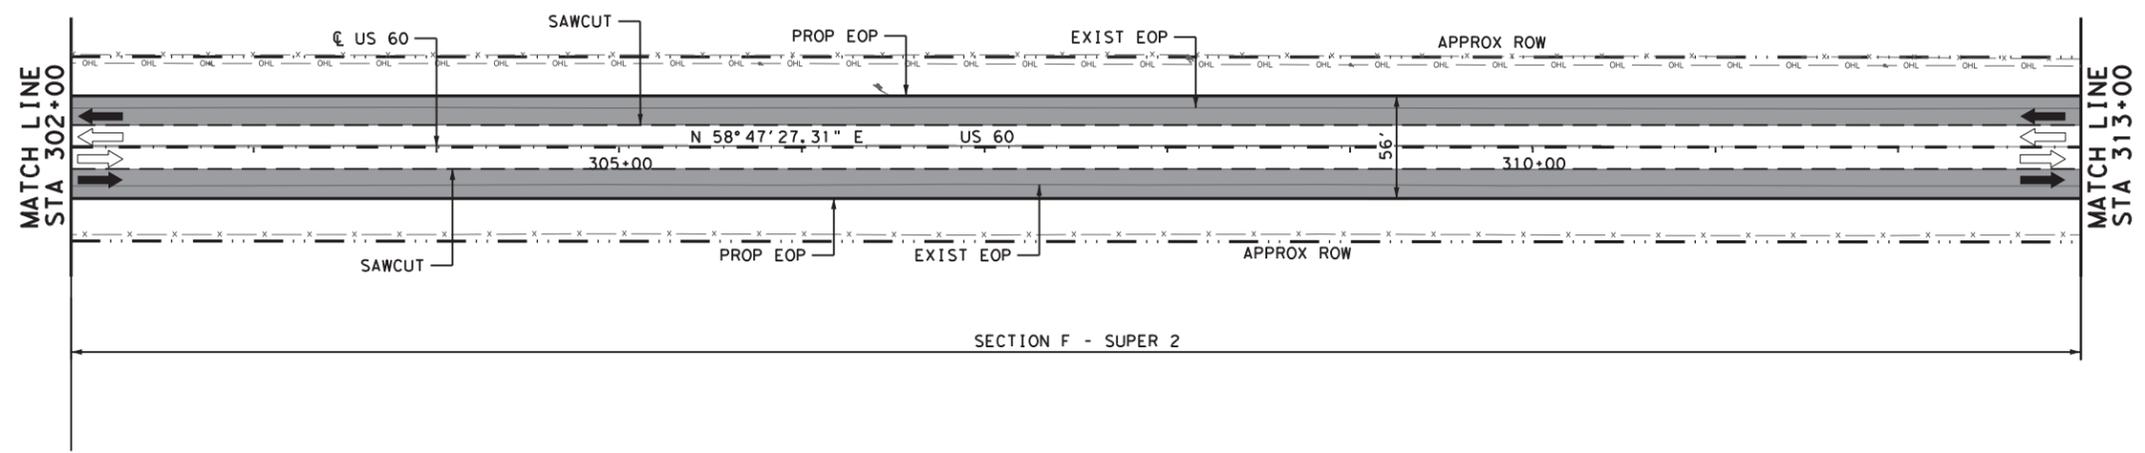

LEGEND

- PROPOSED PAVEMENT
- PROPOSED DRIVEWAY
- PROPOSED RIPRAP
- PAVEMENT REMOVAL
- EXIST TRAFFIC FLOW
- PROP TRAFFIC FLOW
- APPROX ROW
- DRIVEWAY NUMBER
- PROP DITCH

NOTE:

1. REFER TO MISCELLANEOUS DRIVEWAY DETAILS FOR ADDITIONAL INFORMATION.

04/07/2021

Bo L. Ratto

1" = 100'

REV. NO.	DATE	DESCRIPTION	BY

CobbFendley 13430 Northwest Freeway, Ste. 1100
 Houston, Texas 77040
 TBPE Firm Registration No. 274 713.462.3242
 TBPLS Firm Registration No. 100467 www.cobbhendley.com



US 60
ROADWAY PLAN
 STA 302+00 TO STA 324+00
 SHEET 16 OF 38

FED. RD. DIV. NO.	STATE	PROJECT NO.	HIGHWAY NO.
6	TEXAS	(SEE TITLE SHEET)	US60
STATE DISTRICT	COUNTY	CONTROL NO.	SECTION NO.
AMA	GRAY	0169	07
		JOB NO.	SHEET NO.
		053, ETC	77



US60-ROAD-F&P-16.dgn

LEGEND

- PROPOSED PAVEMENT
- PROPOSED DRIVEWAY
- PROPOSED RIPRAP
- PAVEMENT REMOVAL
- EXIST TRAFFIC FLOW
- PROP TRAFFIC FLOW
- APPROX ROW
- DRIVEWAY NUMBER
- PROP DITCH

NOTE:

1. REFER TO MISCELLANEOUS DRIVEWAY DETAILS FOR ADDITIONAL INFORMATION.

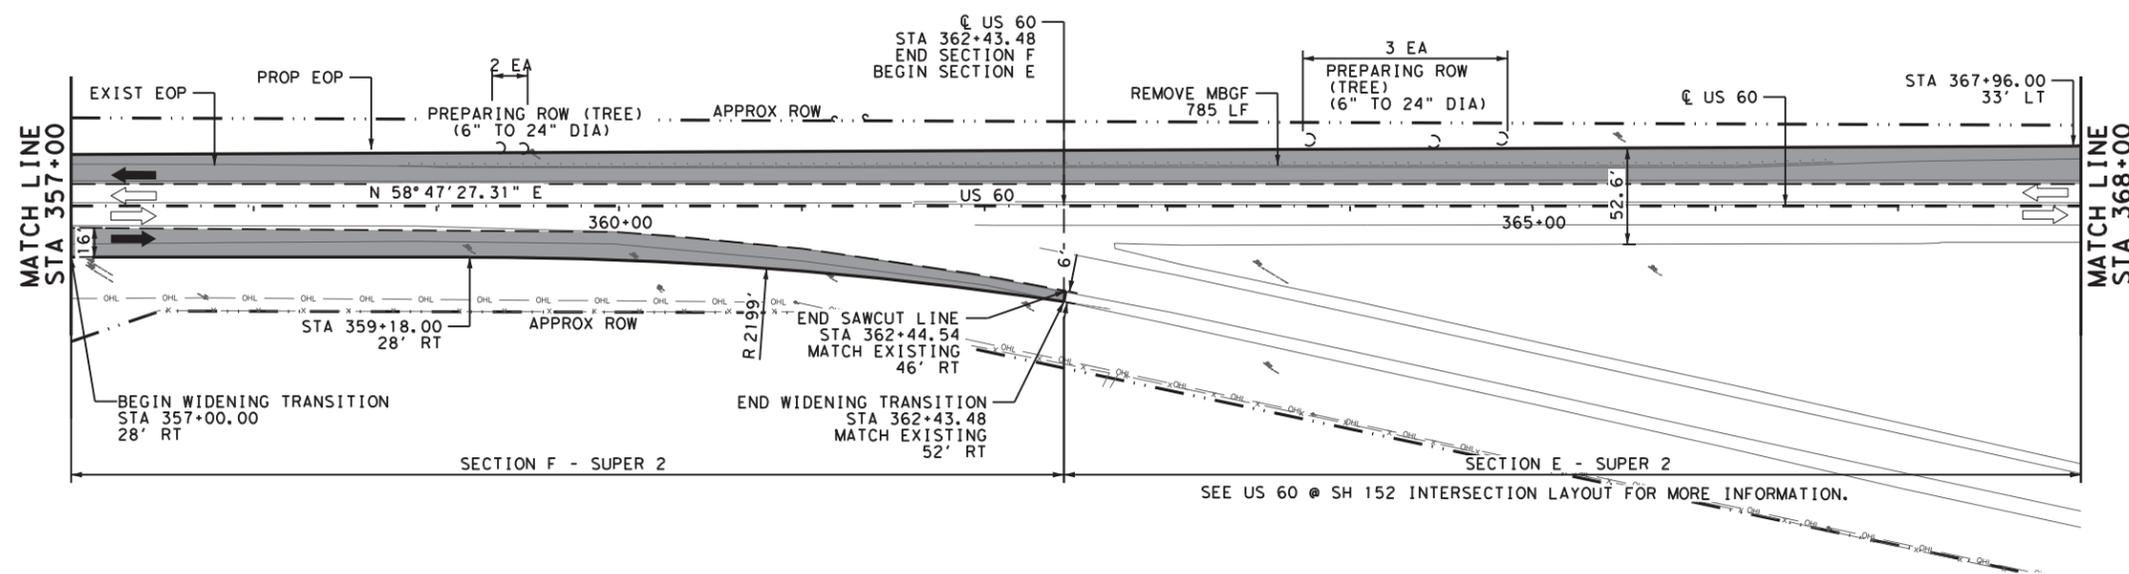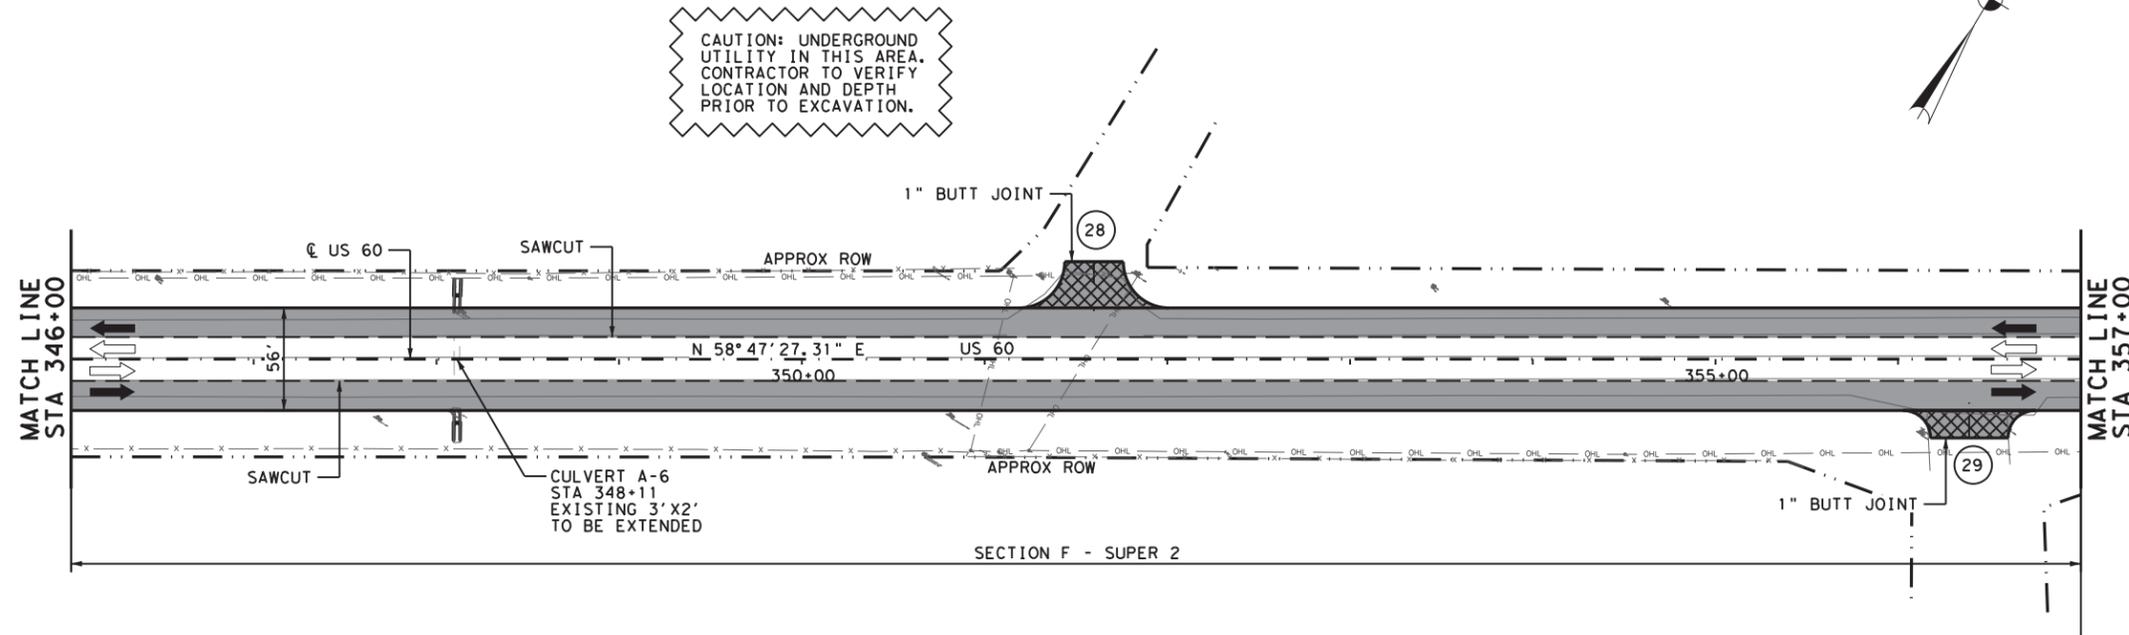

04/07/2021

Bo L. Ratto

0 25 50 100
1" = 100'

REV. NO.	DATE	DESCRIPTION	BY

CobbFendley 13430 Northwest Freeway, Ste. 1100
Houston, Texas 77040
713.462.3242
www.cobbfendley.com

Texas Department of Transportation

US 60 ROADWAY PLAN
STA 346+00 TO STA 368+00

FED. RD. DIV. NO.	STATE	PROJECT NO.	HIGHWAY NO.
6	TEXAS	(SEE TITLE SHEET)	US60
STATE DISTRICT	COUNTY	CONTROL NO.	SECTION NO.
AMA	GRAY	0169	07
		JOB NO.	SHEET NO.
		053, ETC	79

4/7/2021 7:26:51 AM F:\P\Projects\2019\1004_TxDOT_5x5_PSS\03_US60_Amari\1616\1616\500\UST\N\S\1_2_Roadway\02_Sheets\US60_ROAD_P&P-18.dgn



US60-ROAD-P&P-18.dgn

LEGEND

-  PROPOSED PAVEMENT
-  PROPOSED DRIVEWAY
-  PROPOSED RIPRAP
-  PAVEMENT REMOVAL
-  EXIST TRAFFIC FLOW
-  PROP TRAFFIC FLOW
-  APPROX ROW
-  DRIVEWAY NUMBER
-  PROP DITCH

NOTE:

1. REFER TO MISCELLANEOUS DRIVEWAY DETAILS FOR ADDITIONAL INFORMATION.

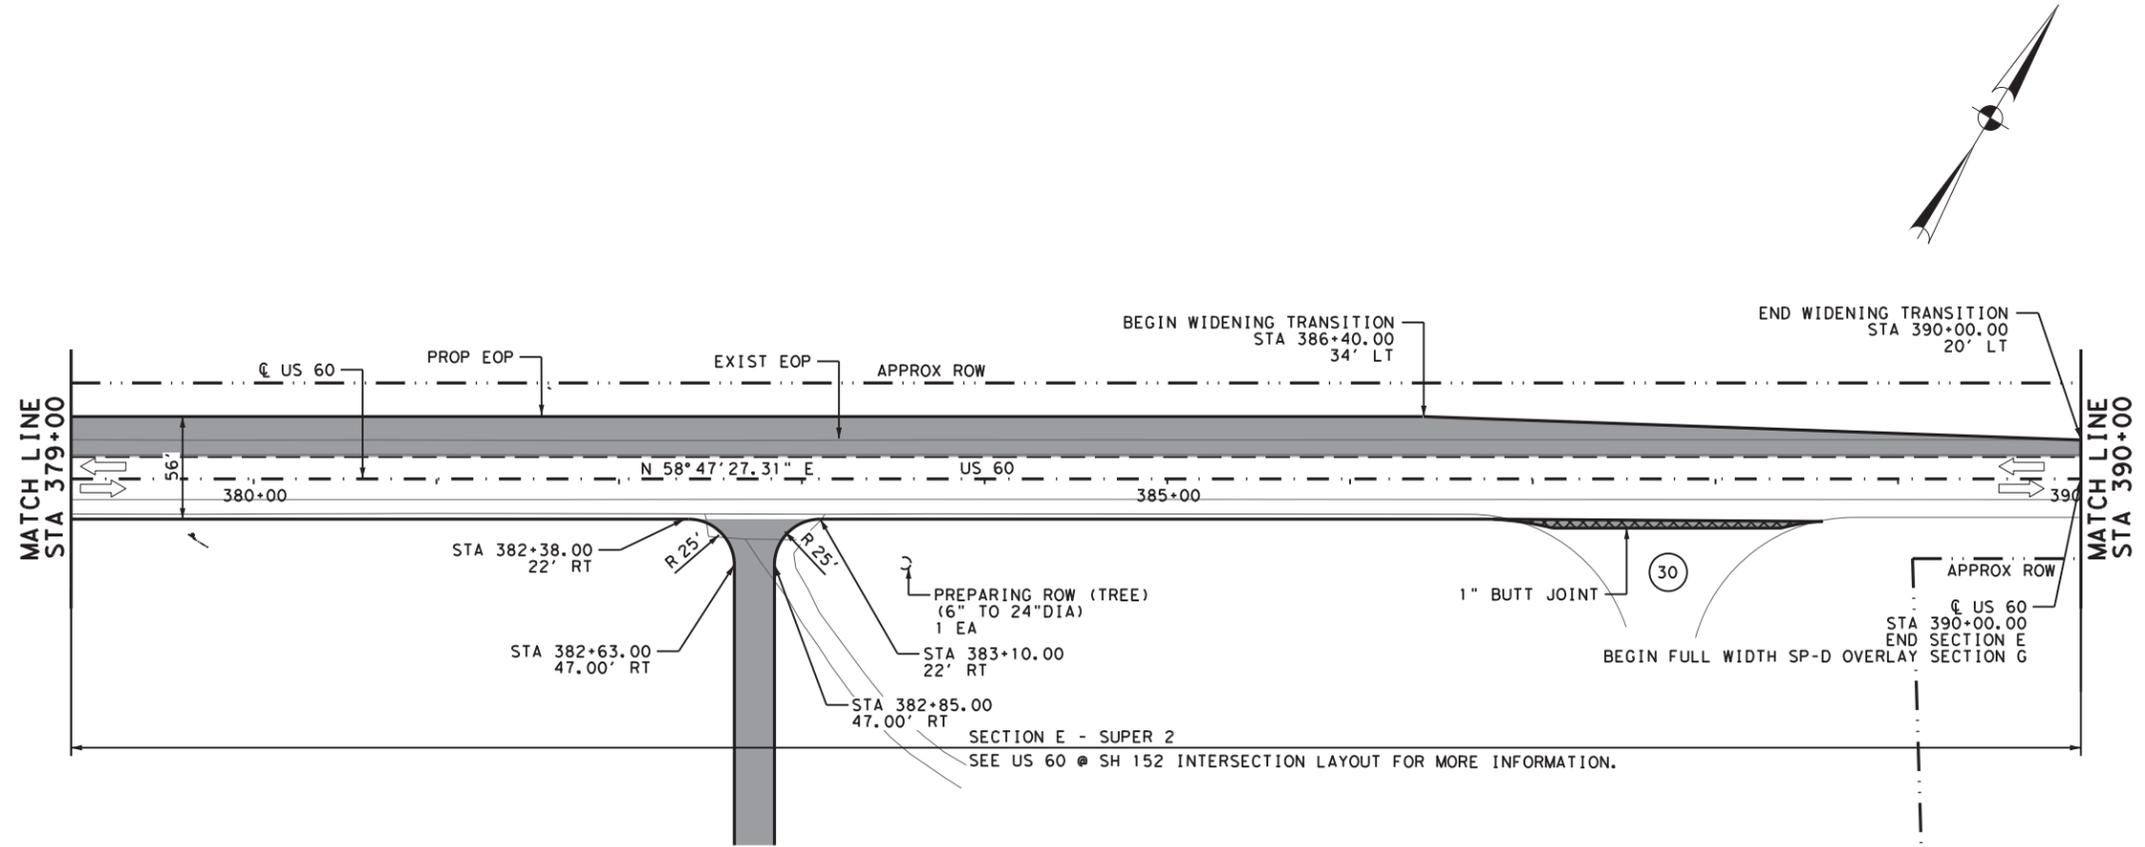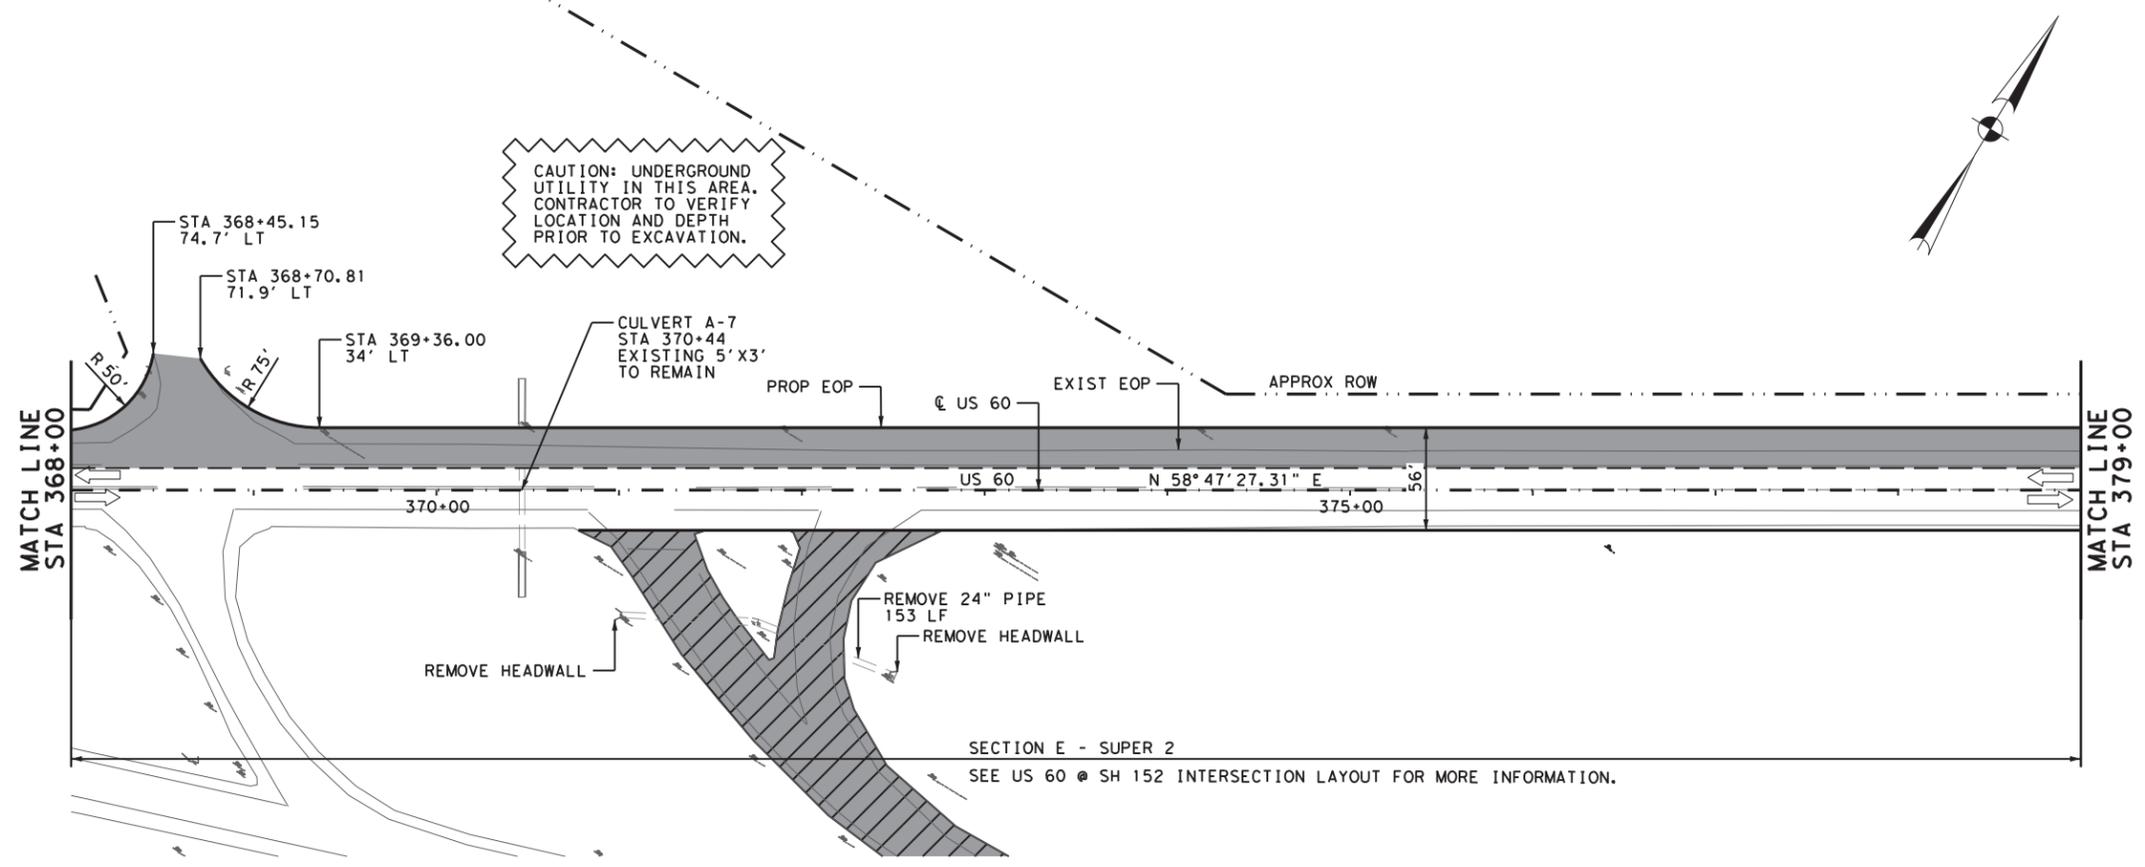

04/07/2021

Bo L. Ratto

0 25 50 100
 1" = 100'

REV. NO.	DATE	DESCRIPTION	BY

CobbFendley 13430 Northwest Freeway, Ste. 1100
 Houston, Texas 77040
 713.462.3242
 www.cobbfendley.com




**US 60
 ROADWAY PLAN
 STA 368+00 TO STA 390+00**

FED. RD. DIV. NO.	STATE	PROJECT NO.	HIGHWAY NO.		
6	TEXAS	(SEE TITLE SHEET)	US60		
STATE DISTRICT	COUNTY	CONTROL NO.	SECTION NO.	JOB NO.	SHEET NO.
AMA	GRAY	0169	07	053, ETC	80


4/7/2021 7:26:52 AM F:\P\Projects\2019\1004_Tx\DOT_355_P58E\03_US60_Amarillo\ENGIN\500\UST\N\11_2_Roadway\02_Sheets\US60_ROAD_P&P-19.dgn

US60-ROAD-P&P-19.dgn

4/7/2021 7:26:53 AM F:\P\Projects\2019\1004_TxDOT_Div5_P5&E\03_US60_Amarillo\ENGIN\500-UST\N\511_2-Roadway\02-Sheets\US60_ROAD-F&P-20.dgn

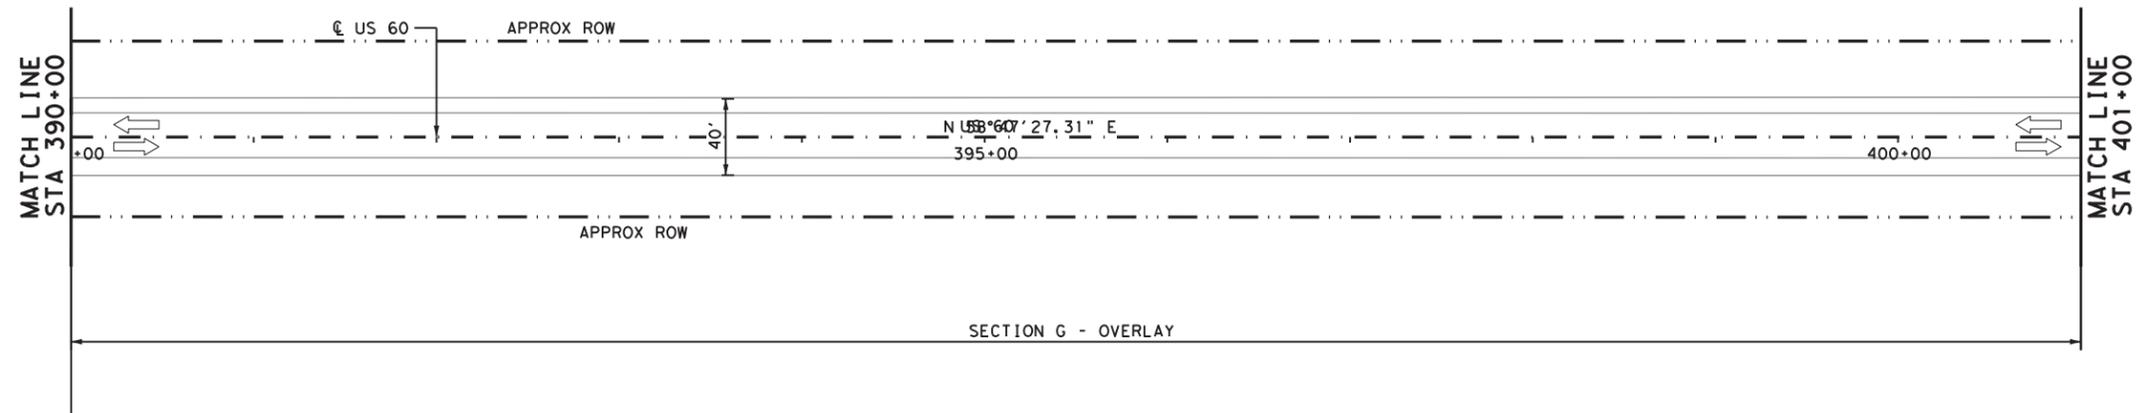

SECTION G - OVERLAY

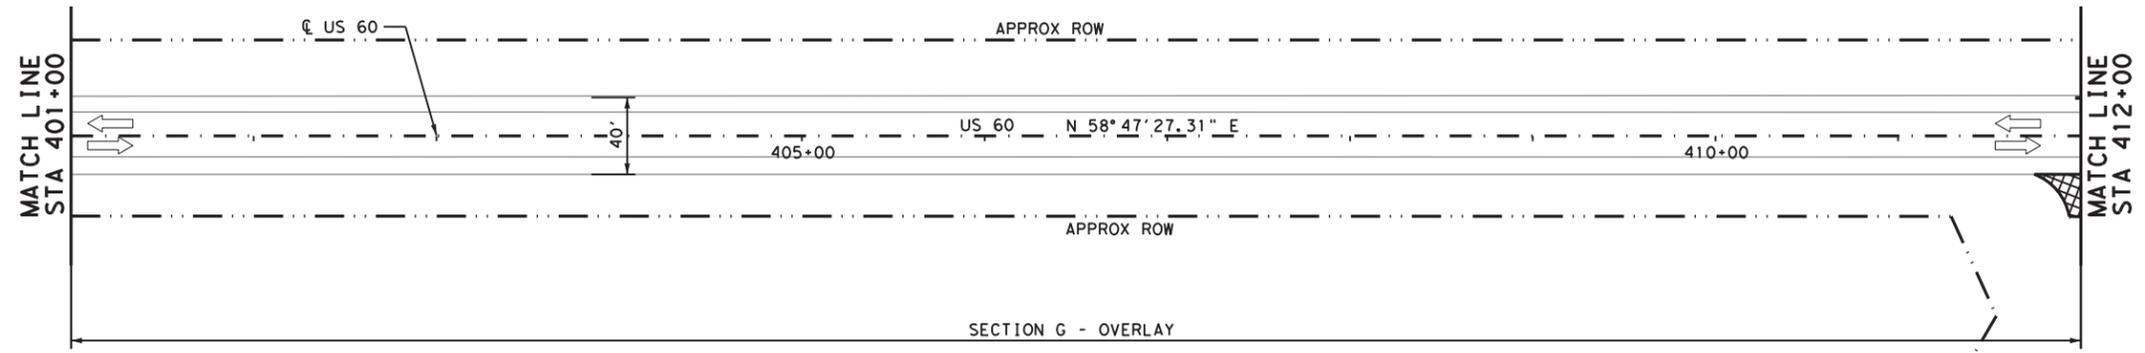

SECTION G - OVERLAY

- LEGEND**
- PROPOSED PAVEMENT
 - PROPOSED DRIVEWAY
 - PROPOSED RIPRAP
 - PAVEMENT REMOVAL
 - EXIST TRAFFIC FLOW
 - PROP TRAFFIC FLOW
 - APPROX ROW
 - DRIVEWAY NUMBER
 - PROP DITCH

NOTE:
1. REFER TO MISCELLANEOUS DRIVEWAY DETAILS FOR ADDITIONAL INFORMATION.

04/07/2021

Bo L. Ratto

1" = 100'

REV. NO.	DATE	DESCRIPTION	BY

13430 Northwest Freeway, Ste. 1100
Houston, Texas 77040
713.462.3242
www.cobbhendley.com

Texas Department of Transportation



**US 60
ROADWAY PLAN
STA 390+00 TO STA 412+00**

SHEET 20 OF 38

FED. RD. DIV. NO.	STATE	PROJECT NO.	HIGHWAY NO.
6	TEXAS	(SEE TITLE SHEET)	US60
STATE DISTRICT	COUNTY	CONTROL NO.	SECTION NO.
AMA	GRAY	0169	07
			JOB NO.
			053, ETC
			SHEET NO.
			81

US60-ROAD-F&P-20.dgn

4/7/2021 7:26:54 AM F:\P\J\2019\1004_Tx\DOT_5x5_P5&E\03_US60_Amar\1161616\NG500-UST\N\511_2-Roadway\02-Sheets\US60_ROAD-F&P-21.dgn

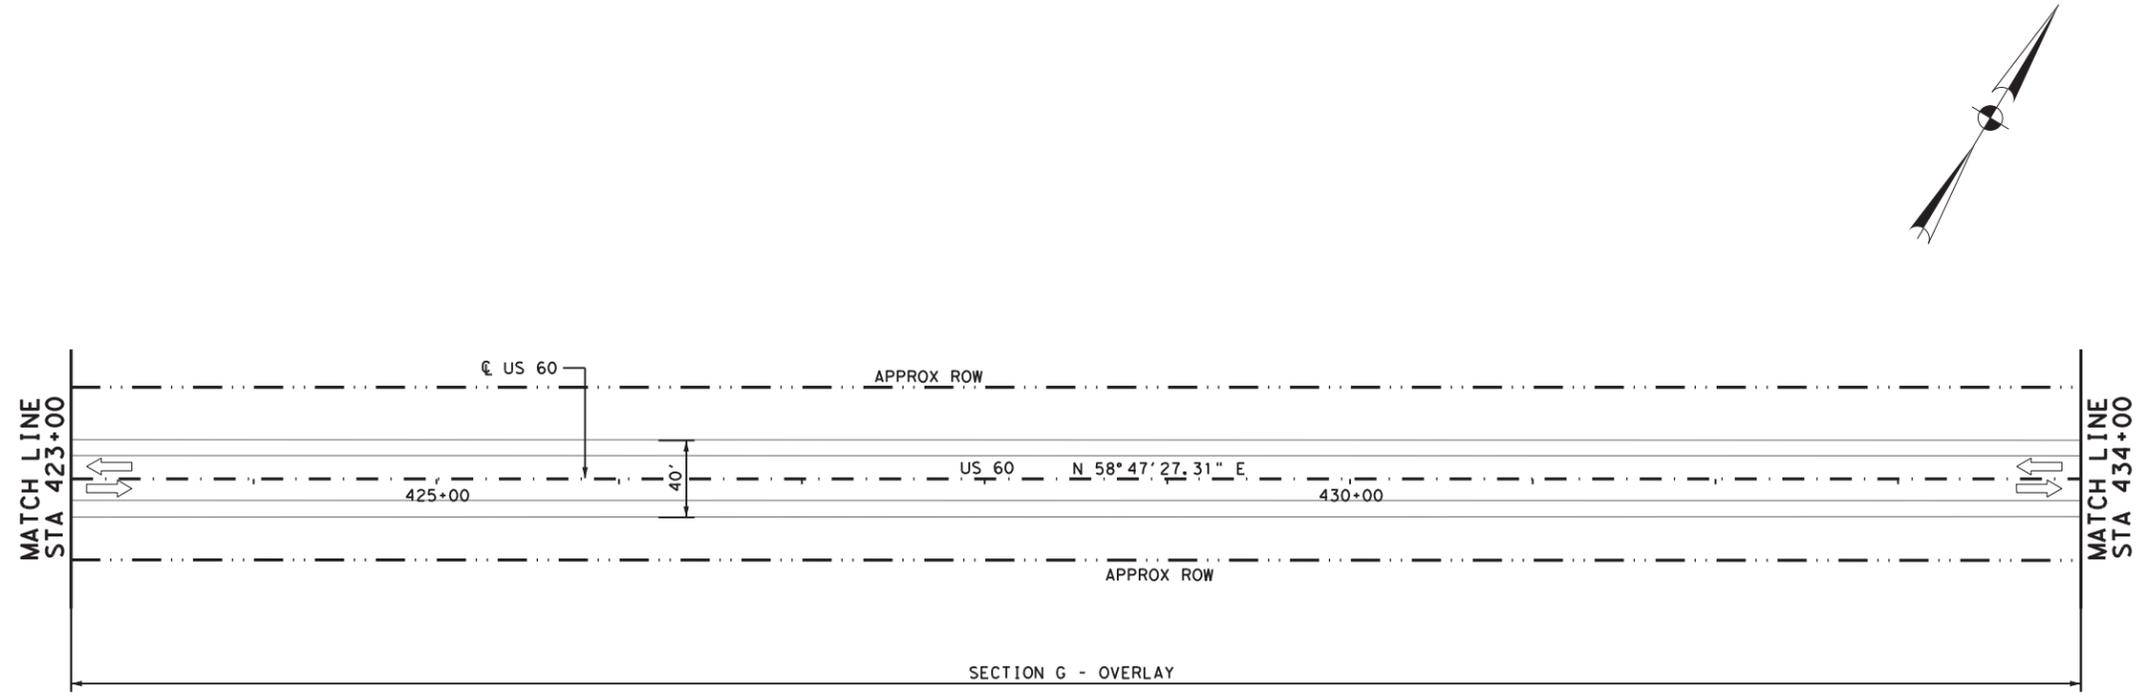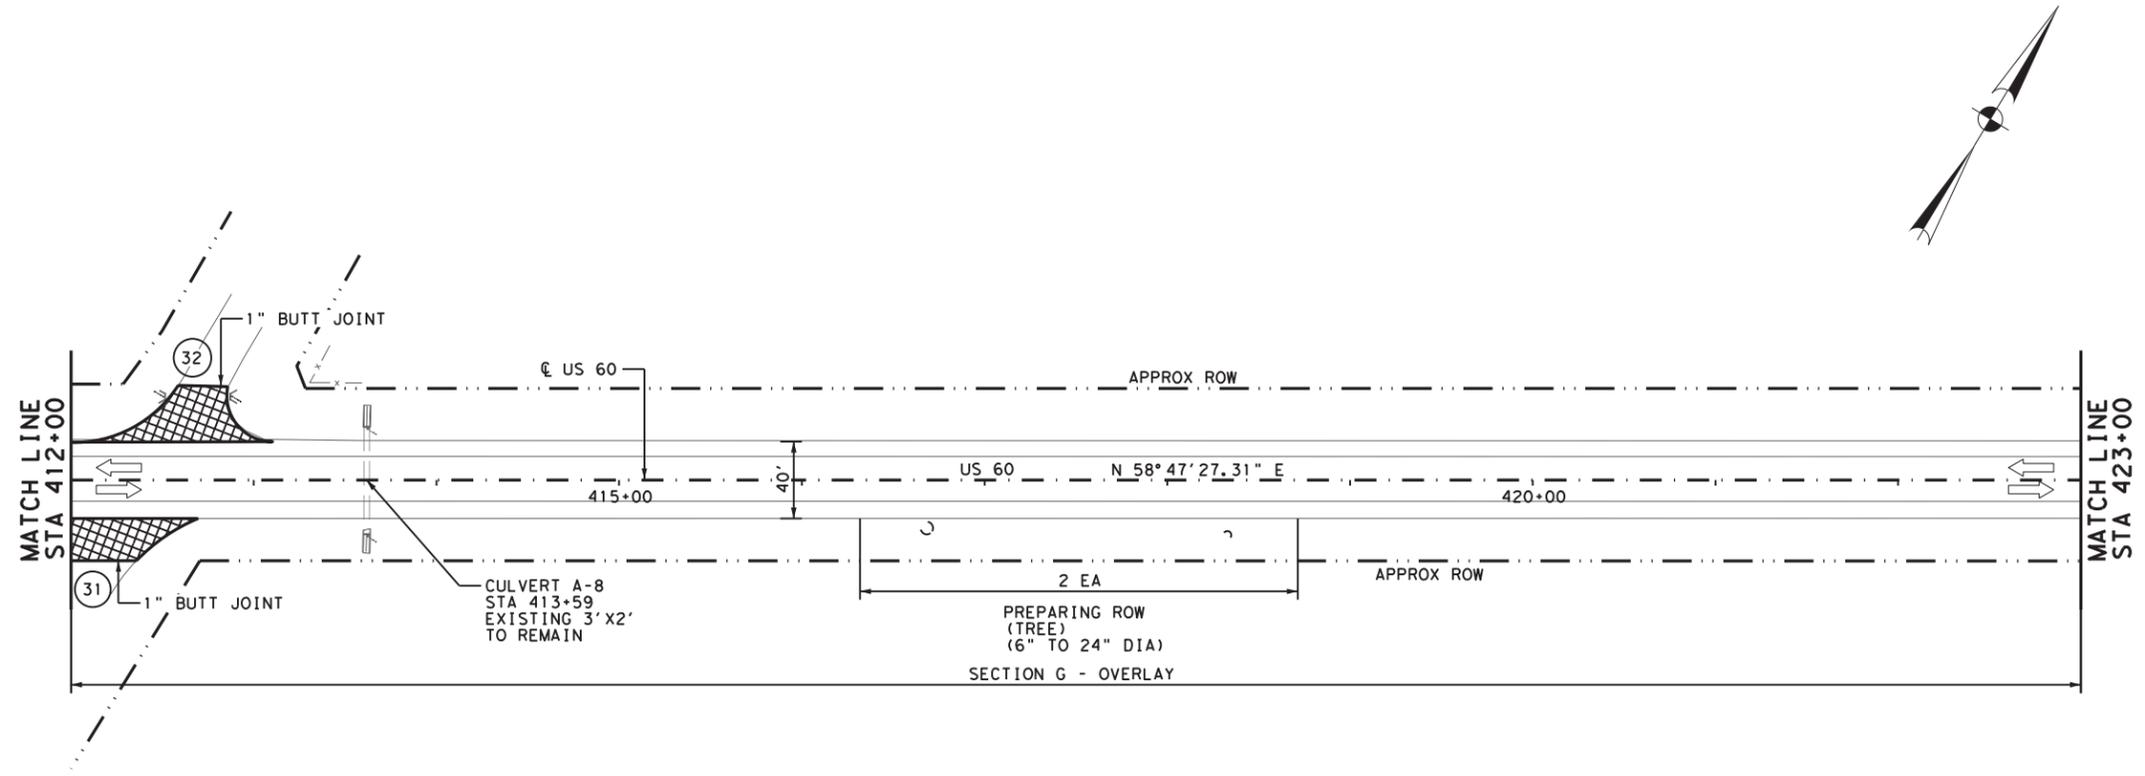

- LEGEND**
- PROPOSED PAVEMENT
 - PROPOSED DRIVEWAY
 - PROPOSED RIPRAP
 - PAVEMENT REMOVAL
 - EXIST TRAFFIC FLOW
 - PROP TRAFFIC FLOW
 - APPROX ROW
 - DRIVEWAY NUMBER
 - PROP DITCH

NOTE:
1. REFER TO MISCELLANEOUS DRIVEWAY DETAILS FOR ADDITIONAL INFORMATION.

04/07/2021

Bo L. Ratto

1" = 100'

REV. NO.	DATE	DESCRIPTION	BY

CobbFendley 13430 Northwest Freeway, Ste. 1100
Houston, Texas 77040
713.462.3242
www.cobbhendley.com

Texas Department of Transportation


**US 60
ROADWAY PLAN
STA 412+00 TO STA 434+00**

SHEET 21 OF 38

FED. RD. DIV. NO.	STATE	PROJECT NO.	HIGHWAY NO.
6	TEXAS	(SEE TITLE SHEET)	US60
STATE DISTRICT	COUNTY	CONTROL NO.	SECTION NO.
AMA	GRAY	0169	07
		JOB NO.	SHEET NO.
		053, ETC	82

US60-ROAD-F&P-21.dgn


4/7/2021 7:26:54 AM F:\P\Projects\2019\1004_TxDOT_5x5_P&E\03_US60_Amarillo\ENGIN\500-USTIN\511_2-Roadway\02-Sheets\US60_ROAD-F&E-22.dgn

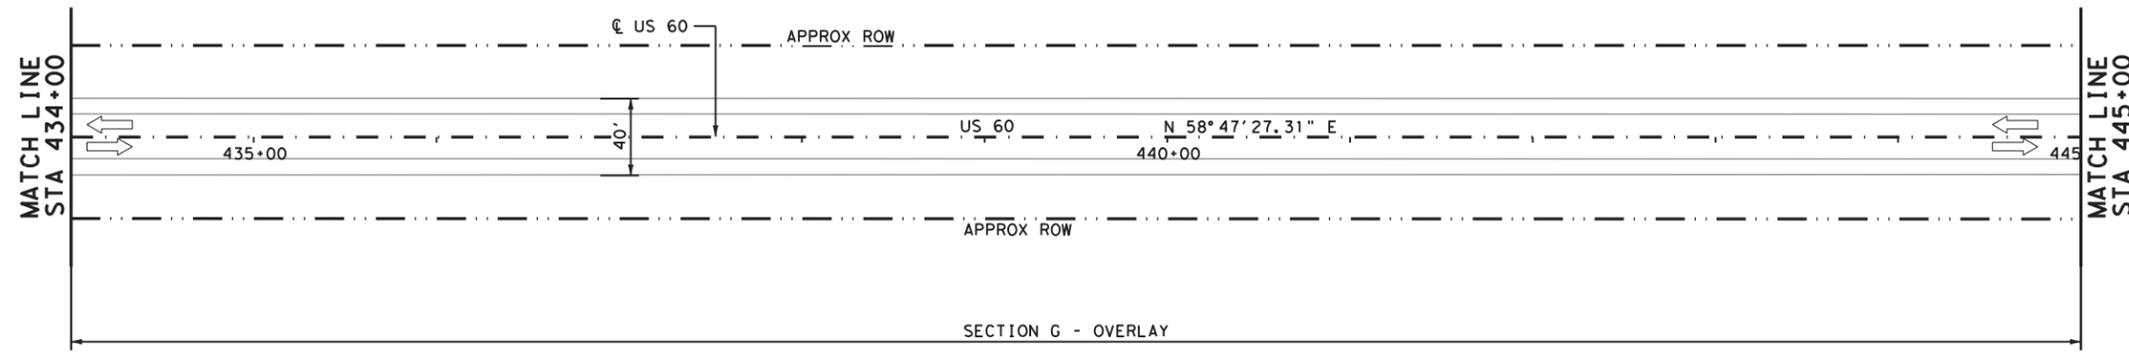

LEGEND

- PROPOSED PAVEMENT
- PROPOSED DRIVEWAY
- PROPOSED RIPRAP
- PAVEMENT REMOVAL
- EXIST TRAFFIC FLOW
- PROP TRAFFIC FLOW
- APPROX ROW
- DRIVEWAY NUMBER
- PROP DITCH

NOTE:
1. REFER TO MISCELLANEOUS DRIVEWAY DETAILS FOR ADDITIONAL INFORMATION.

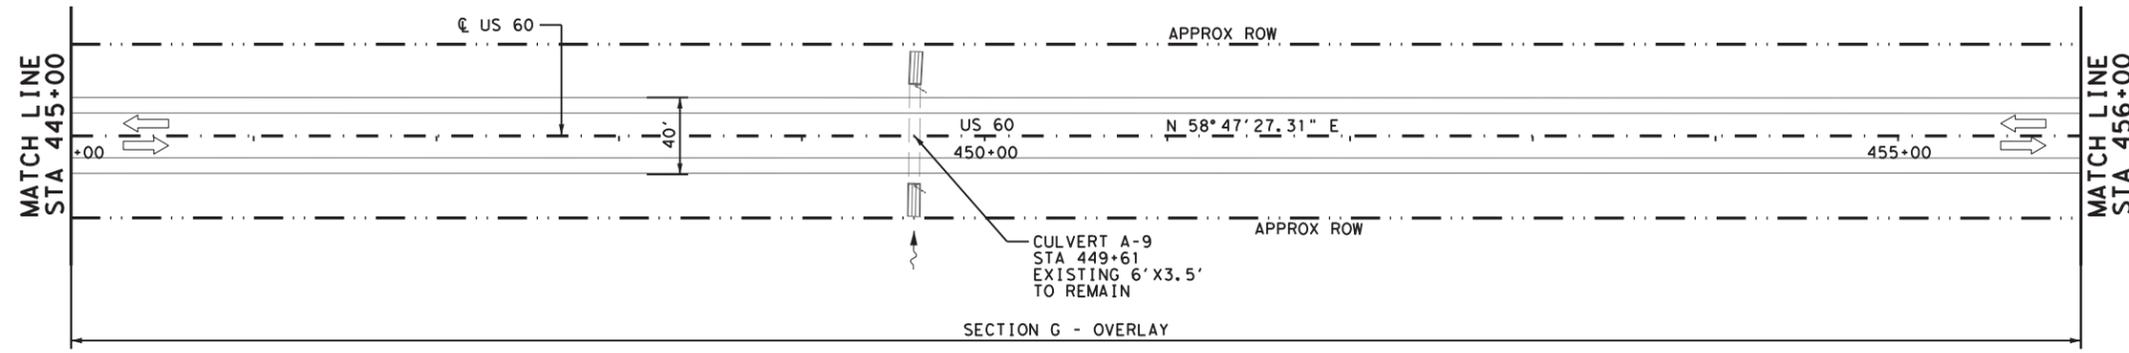

04/07/2021

Bo L. Ratto

0 25 50 100
1" = 100'

REV. NO.	DATE	DESCRIPTION	BY

CobbFendley 13430 Northwest Freeway, Ste. 1100
Houston, Texas 77040
713.462.3242
www.cobbfendley.com



Texas Department of Transportation

**US 60
ROADWAY PLAN
STA 434+00 TO STA 456+00**

FED. RD. DIV. NO.	STATE	PROJECT NO.	HIGHWAY NO.
6	TEXAS	(SEE TITLE SHEET)	US60
STATE DISTRICT	COUNTY	CONTROL NO.	SECTION NO.
AMA	GRAY	0169	07
		JOB NO.	SHEET NO.
		053, ETC	83

US60-ROAD-F&E-22.dgn

4/7/2021 7:26:55 AM F:\P\Projects\2019\1004_Tx\DOT_5x5_P5&E\03_US60_Amar\1161616\NG500-UST\N\511_2-Roadway\02-Sheets\US60_ROAD-F&P-23.dgn

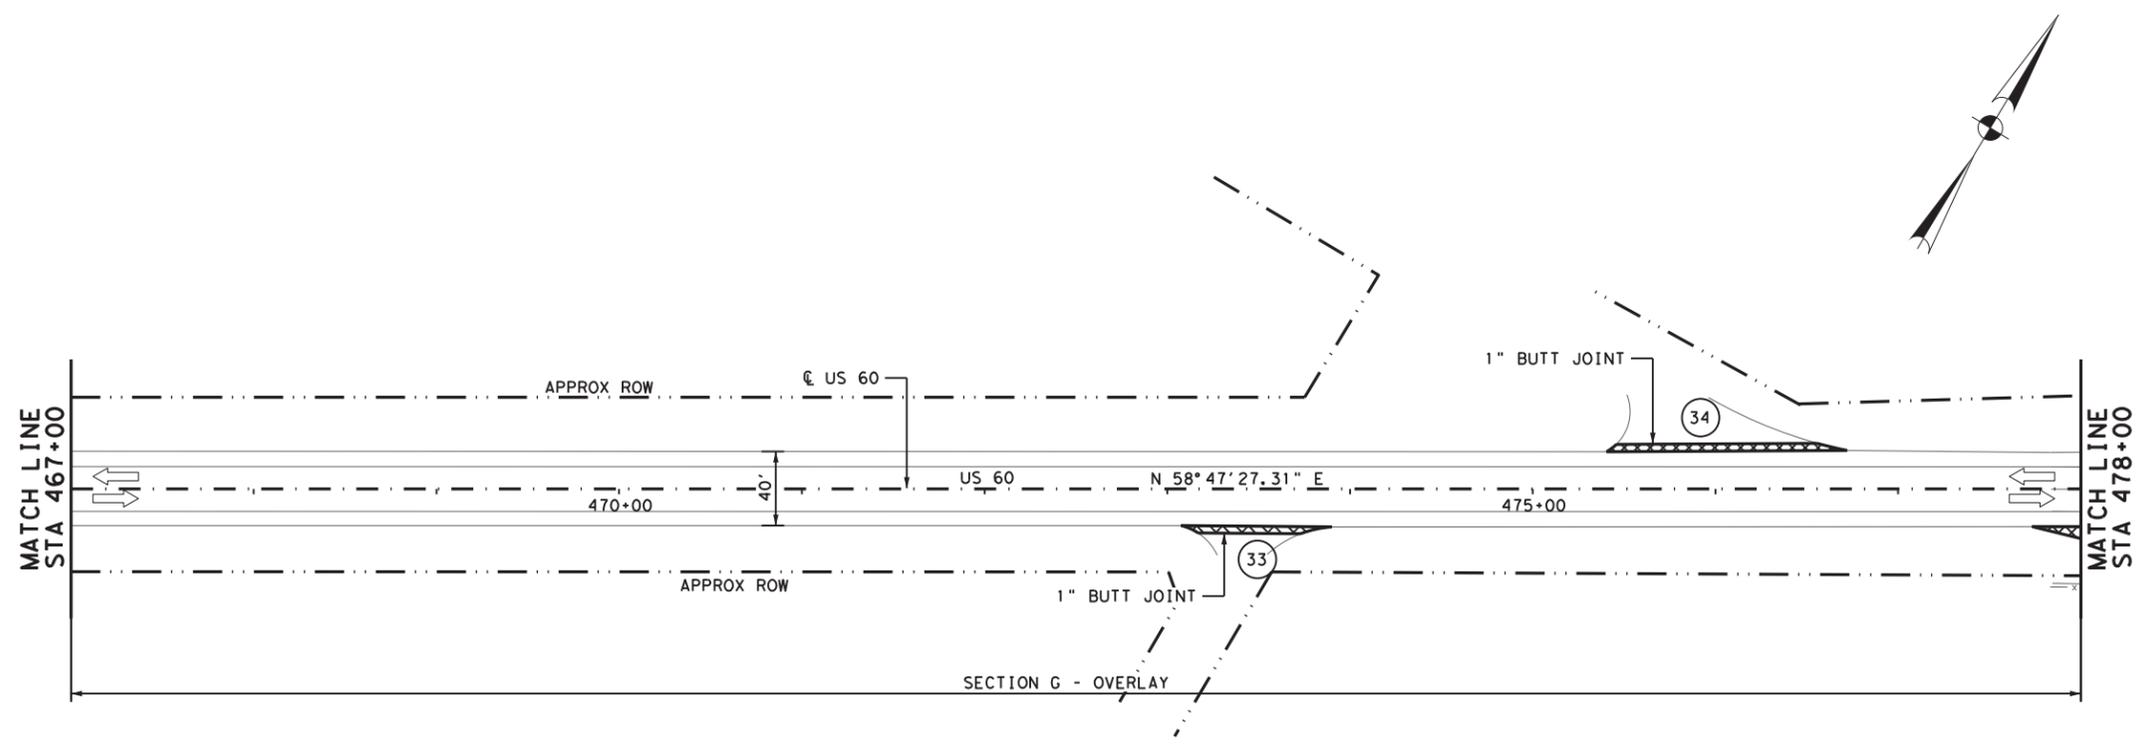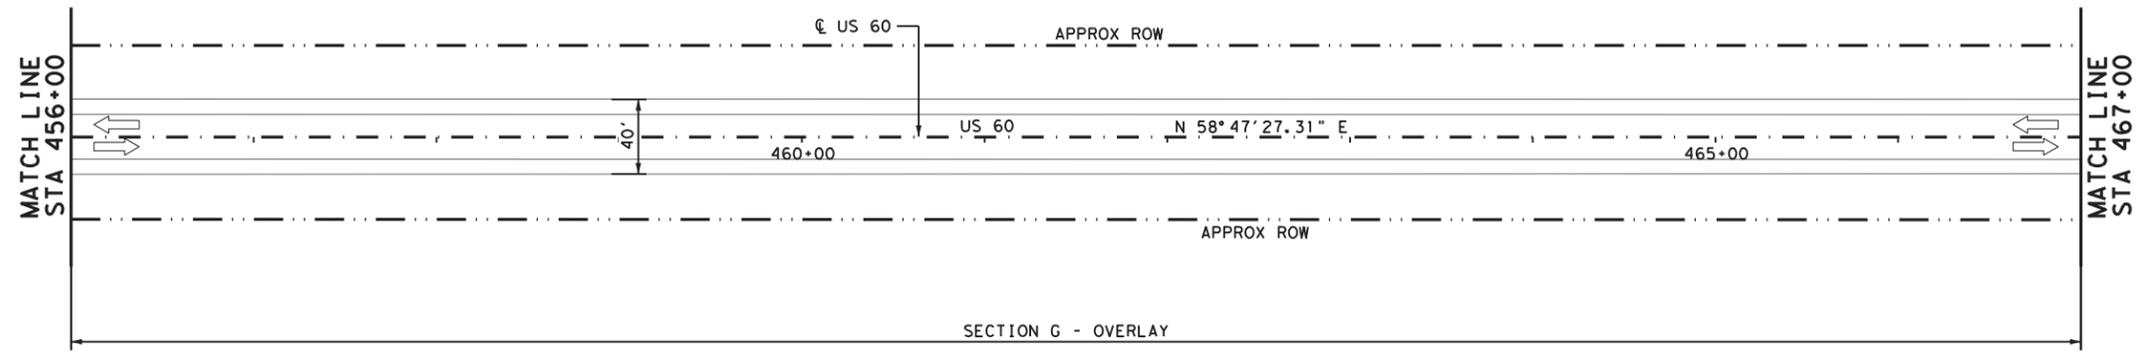

- LEGEND**
- PROPOSED PAVEMENT
 - PROPOSED DRIVEWAY
 - PROPOSED RIPRAP
 - PAVEMENT REMOVAL
 - EXIST TRAFFIC FLOW
 - PROP TRAFFIC FLOW
 - APPROX ROW
 - DRIVEWAY NUMBER
 - PROP DITCH

NOTE:
1. REFER TO MISCELLANEOUS DRIVEWAY DETAILS FOR ADDITIONAL INFORMATION.

04/07/2021

Bo L. Ratto

REV. NO.	DATE	DESCRIPTION	BY

CobbFendley 13430 Northwest Freeway, Ste. 1100
Houston, Texas 77040
713.462.3242
www.cobbfendley.com





**US 60
ROADWAY PLAN
STA 456+00 TO STA 478+00**

SHEET **23** OF **38**

FED. RD. DIV. NO.	STATE	PROJECT NO.	HIGHWAY NO.
6	TEXAS	(SEE TITLE SHEET)	US60
STATE DISTRICT	COUNTY	CONTROL NO.	SECTION NO.
AMA	GRAY	0169	07
		JOB NO.	SHEET NO.
		053, ETC	84

US60-ROAD-F&P-23.dgn

4/7/2021 7:26:56 AM F:\P\proj\2019\1004_TxDOT_DxL_P5&E\03_US60_Amrt\16\16\US60-DIST\1\2-Roadway\02-Sheets\US60_ROAD-P&P-24.dgn

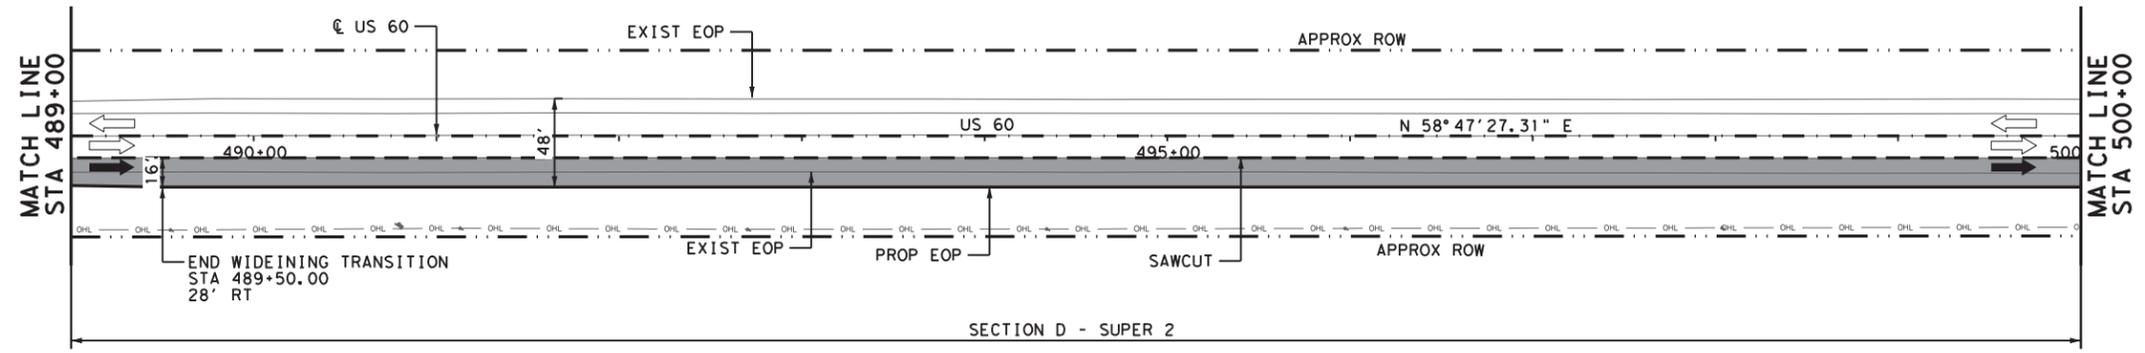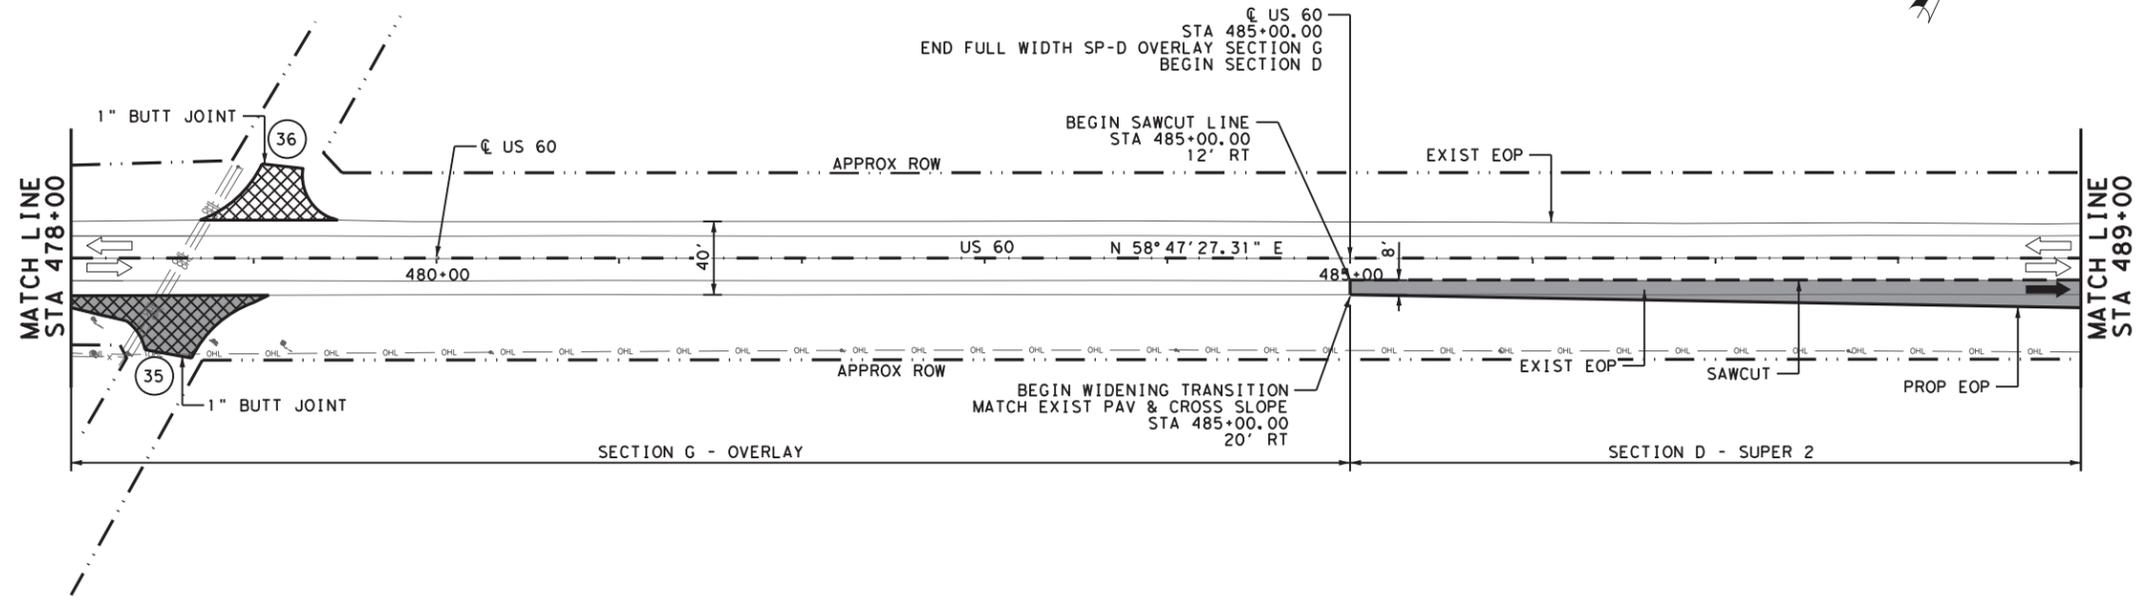

- LEGEND**
- PROPOSED PAVEMENT
 - PROPOSED DRIVEWAY
 - PROPOSED RIPRAP
 - PAVEMENT REMOVAL
 - EXIST TRAFFIC FLOW
 - PROP TRAFFIC FLOW
 - APPROX ROW
 - DRIVEWAY NUMBER
 - PROP DITCH

NOTE:
1. REFER TO MISCELLANEOUS DRIVEWAY DETAILS FOR ADDITIONAL INFORMATION.

04/07/2021

Bo L. Ratto

0 25 50 100
1" = 100'

REV. NO.	DATE	DESCRIPTION	BY

CobbFendley 13430 Northwest Freeway, Ste. 1100
Houston, Texas 77040
713.462.3242
www.cobbhendley.com





**US 60
ROADWAY PLAN
STA 478+00 TO STA 500+00**

FED. RD. DIV. NO.	STATE	PROJECT NO.	HIGHWAY NO.
6	TEXAS	(SEE TITLE SHEET)	US60
STATE DISTRICT	COUNTY	CONTROL NO.	SECTION NO.
AMA	GRAY	0169	07
		JOB NO.	SHEET NO.
		053, ETC	85

US60-ROAD-P&P-24.dgn

4/7/2021 7:26:57 AM F:\P\0\j\2019\1004_Tx\DOT_5x5_P5&E\03_US60_Amarillo\EN\6500-UST\N\511_2-Roadway\02-Sheets\US60_ROAD-P&P-25.dgn

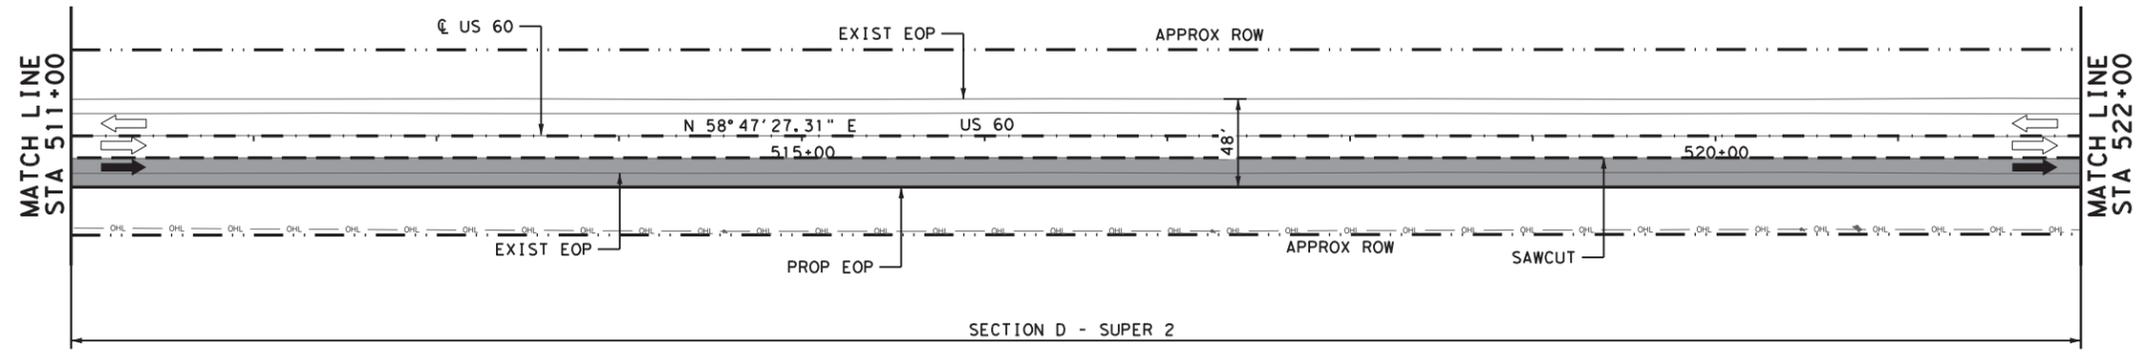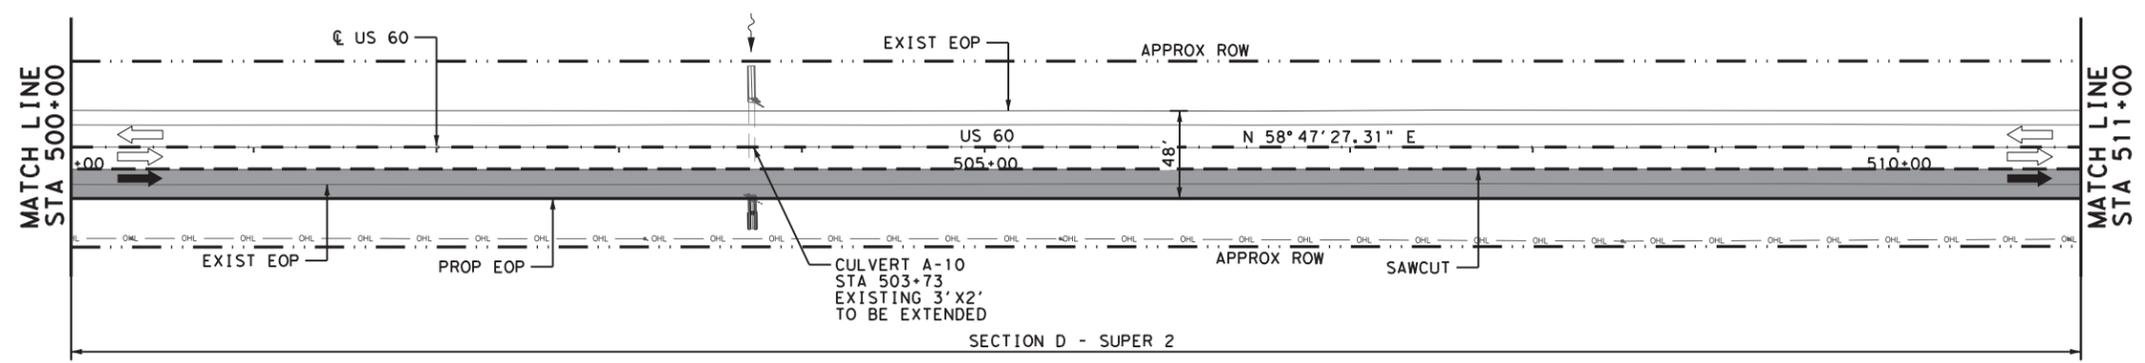

LEGEND

- PROPOSED PAVEMENT
- PROPOSED DRIVEWAY
- PROPOSED RIPRAP
- PAVEMENT REMOVAL
- EXIST TRAFFIC FLOW
- PROP TRAFFIC FLOW
- APPROX ROW
- DRIVEWAY NUMBER
- PROP DITCH

NOTE:
1. REFER TO MISCELLANEOUS DRIVEWAY DETAILS FOR ADDITIONAL INFORMATION.

04/07/2021

Bo L. Ratto

0 25 50 100
1" = 100'

REV. NO.	DATE	DESCRIPTION	BY

13430 Northwest Freeway, Ste. 1100
Houston, Texas 77040
713.462.3242
www.cobbhendley.com

Texas Department of Transportation


**US 60
ROADWAY PLAN
STA 500+00 TO STA 522+00**

SHEET 25 OF 38

FED. RD. DIV. NO.	STATE	PROJECT NO.		HIGHWAY NO.	
6	TEXAS	(SEE TITLE SHEET)		US60	
STATE DISTRICT	COUNTY	CONTROL NO.	SECTION NO.	JOB NO.	SHEET NO.
AMA	GRAY	0169	07	053, ETC	86


US60-ROAD-P&P-25.dgn

4/7/2021 7:26:58 AM F:\P\proj\162019\1004_TxDOT_3x5_P5&E\03_US60_Amrt\1616\1616\US60-UST\1616_2-Roadway\02-Sheets\US60_ROAD-P&P-26.dgn

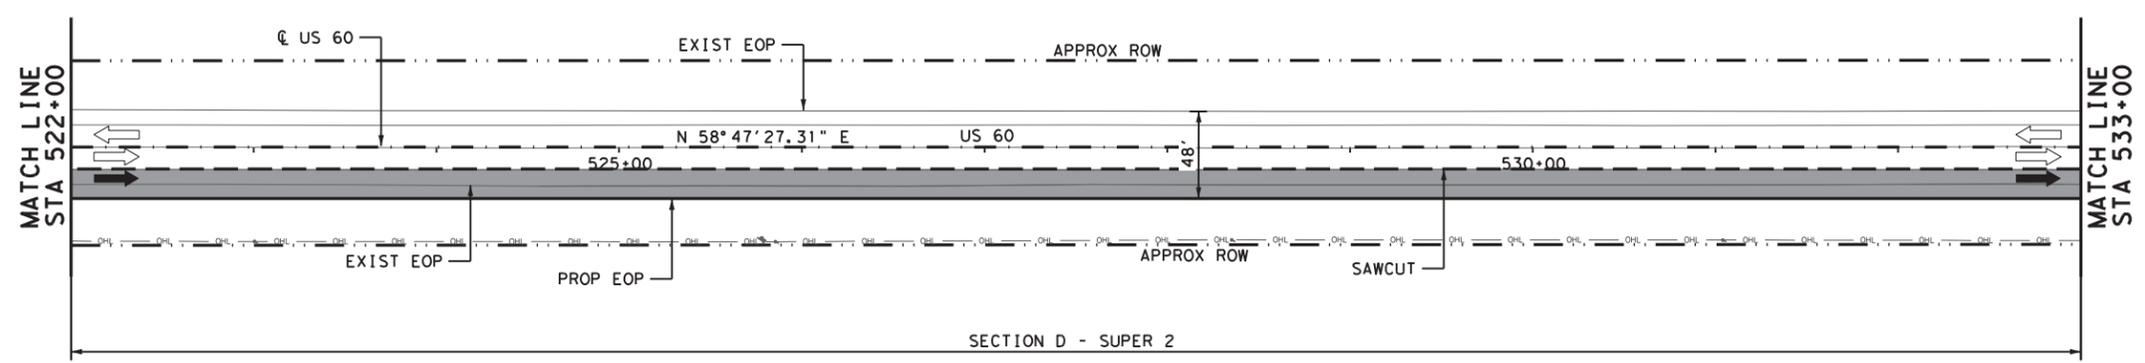

- LEGEND**
- PROPOSED PAVEMENT
 - PROPOSED DRIVEWAY
 - PROPOSED RIPRAP
 - PAVEMENT REMOVAL
 - EXIST TRAFFIC FLOW
 - PROP TRAFFIC FLOW
 - APPROX ROW
 - DRIVEWAY NUMBER
 - PROP DITCH E

NOTE:
1. REFER TO MISCELLANEOUS DRIVEWAY DETAILS FOR ADDITIONAL INFORMATION.

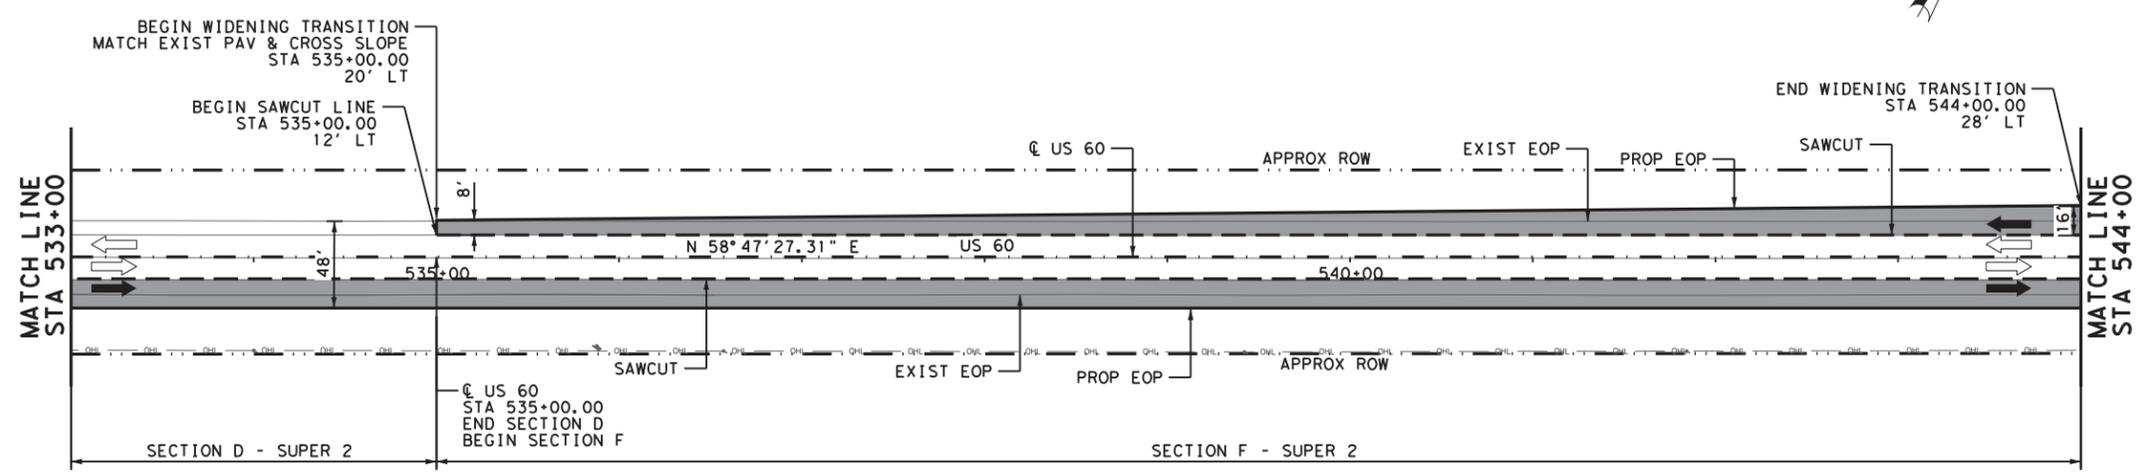

04/07/2021

Bo L. Ratto

0 25 50 100
1" = 100'

REV. NO.	DATE	DESCRIPTION	BY

CobbFendley 13430 Northwest Freeway, Ste. 1100
Houston, Texas 77040
713.462.3242
www.cobbhendley.com





**US 60
ROADWAY PLAN
STA 522+00 TO STA 544+00**

FED. RD. DIV. NO.	STATE	PROJECT NO.	ROADWAY NO.
6	TEXAS	(SEE TITLE SHEET)	US60
STATE DISTRICT	COUNTY	CONTROL NO.	SECTION NO.
AMA	GRAY	0169	07
			JOB NO.
			053, ETC
			SHEET NO.
			87

US60-ROAD-P&P-26.dgn

4/7/2021 7:26:59 AM F:\P\Projects\2019\1004_TxDOT_Dx5_PSS&E\03_US60_Amzn\16\EN\6500\UST\N\511_2-Roadway\02-Sheets\US60_ROAD-F&P-27.dgn

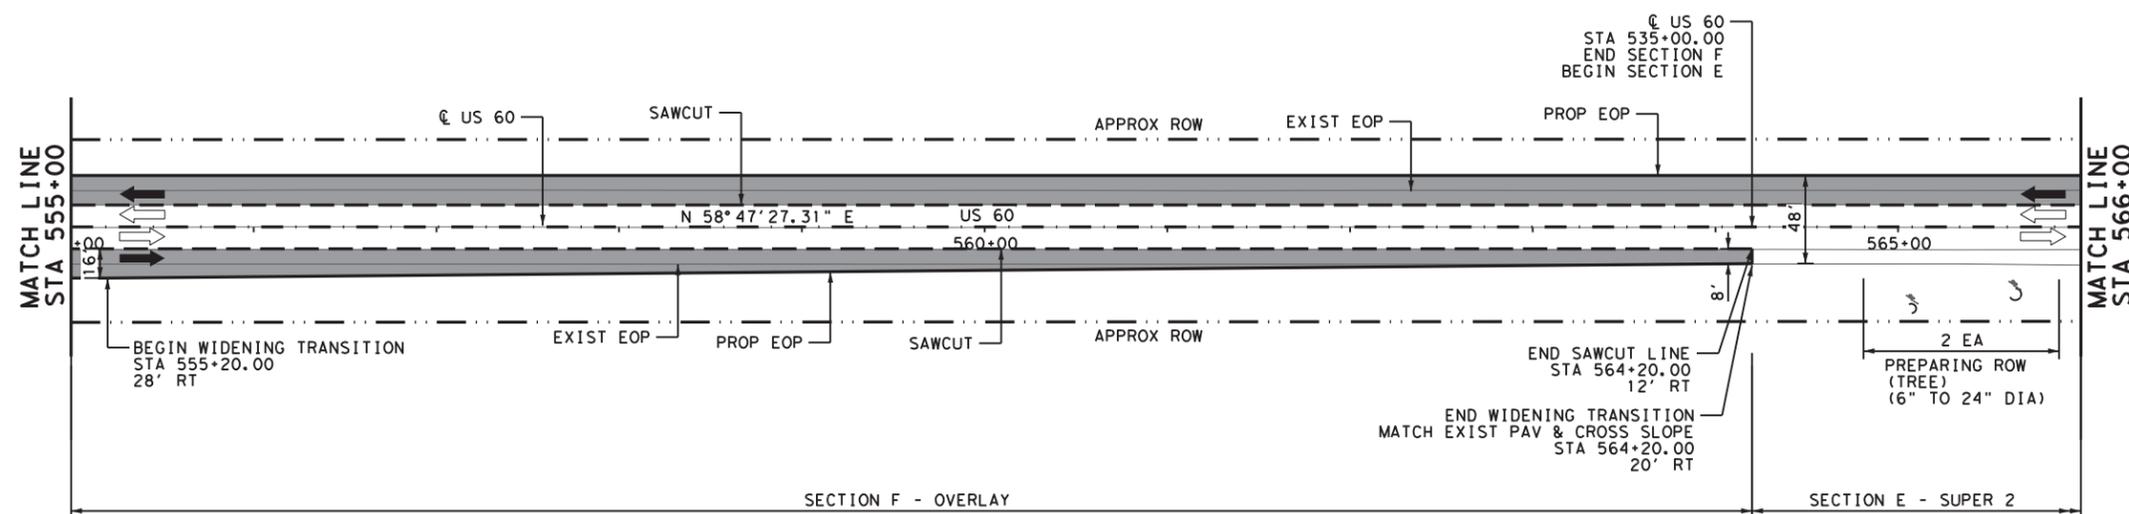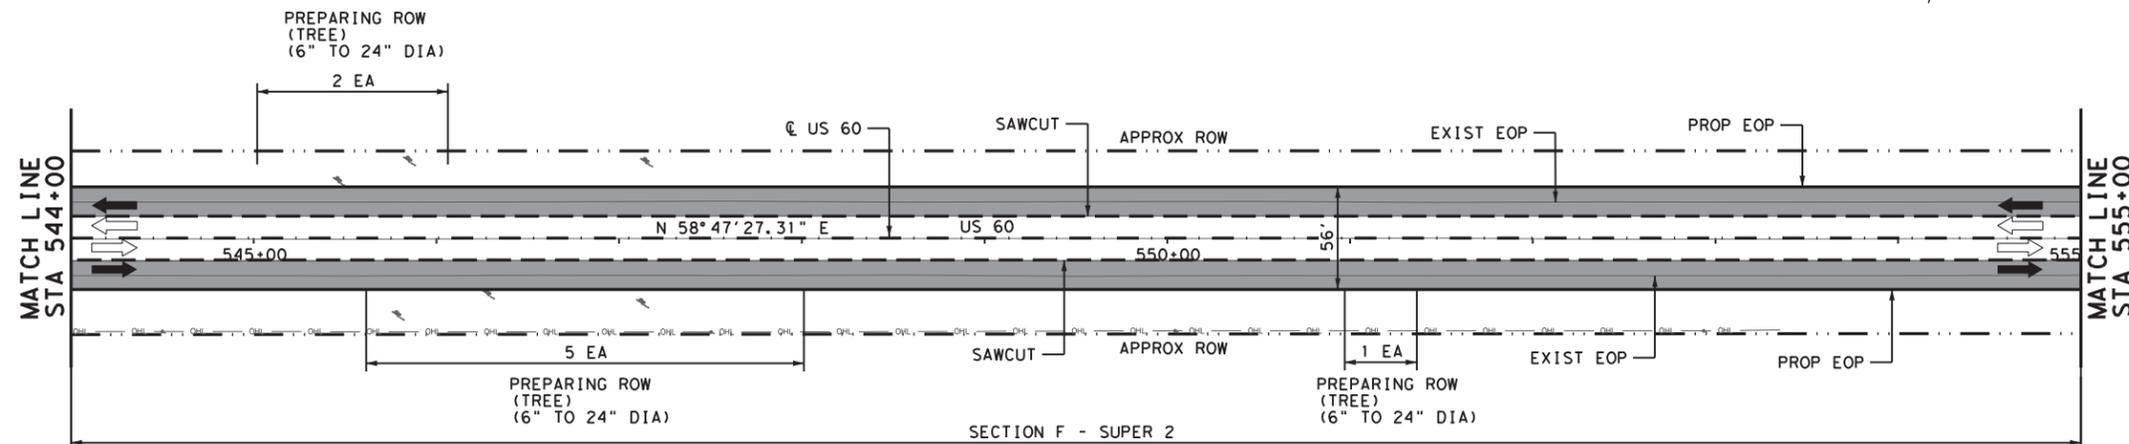

LEGEND

- PROPOSED PAVEMENT
- PROPOSED DRIVEWAY
- PROPOSED RIPRAP
- PAVEMENT REMOVAL
- EXIST TRAFFIC FLOW
- PROP TRAFFIC FLOW
- APPROX ROW
- DRIVEWAY NUMBER
- PROP DITCH

NOTE:

- REFER TO MISCELLANEOUS DRIVEWAY DETAILS FOR ADDITIONAL INFORMATION.

04/07/2021

Bo L. Ratto

0 25 50 100
1" = 100'

REV. NO.	DATE	DESCRIPTION	BY

CobbFendley 13430 Northwest Freeway, Ste. 1100
Houston, Texas 77040
713.462.3242
www.cobbfendley.com


Texas Department of Transportation

US 60
ROADWAY PLAN
STA 544+00 TO STA 566+00
SHEET 27 OF 38

FED. RD. DIV. NO.	STATE	PROJECT NO.	HIGHWAY NO.		
6	TEXAS	(SEE TITLE SHEET)	US60		
STATE DISTRICT	COUNTY	CONTROL NO.	SECTION NO.	JOB NO.	SHEET NO.
AMA	GRAY	0169	07	053, ETC	88

US60-ROAD-F&P-27.dgn


4/7/2021 7:26:59 AM F:\P\Projects\2019\1004_TxDOT_5x5_P5&E\03_US60_Amarillo\ENGIN\500\UST\N\511_2-Roadway\02-Sheets\US60_ROAD-P&P-2B.dgn

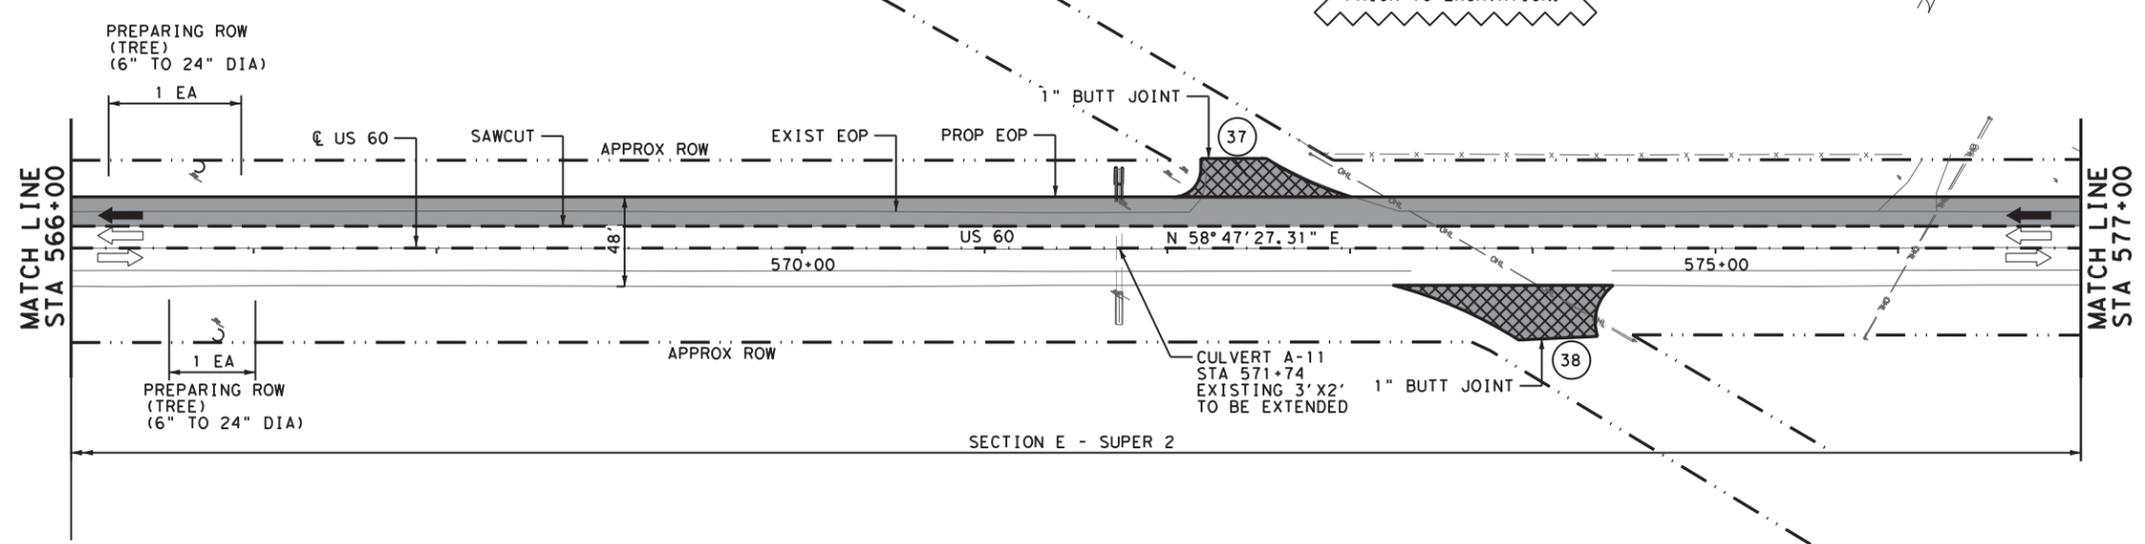

CAUTION: UNDERGROUND UTILITY IN THIS AREA. CONTRACTOR TO VERIFY LOCATION AND DEPTH PRIOR TO EXCAVATION.

- LEGEND**
- PROPOSED PAVEMENT
 - PROPOSED DRIVEWAY
 - PROPOSED RIPRAP
 - PAVEMENT REMOVAL
 - EXIST TRAFFIC FLOW
 - PROP TRAFFIC FLOW
 - APPROX ROW
 - DRIVEWAY NUMBER
 - PROP DITCH

NOTE:
1. REFER TO MISCELLANEOUS DRIVEWAY DETAILS FOR ADDITIONAL INFORMATION.

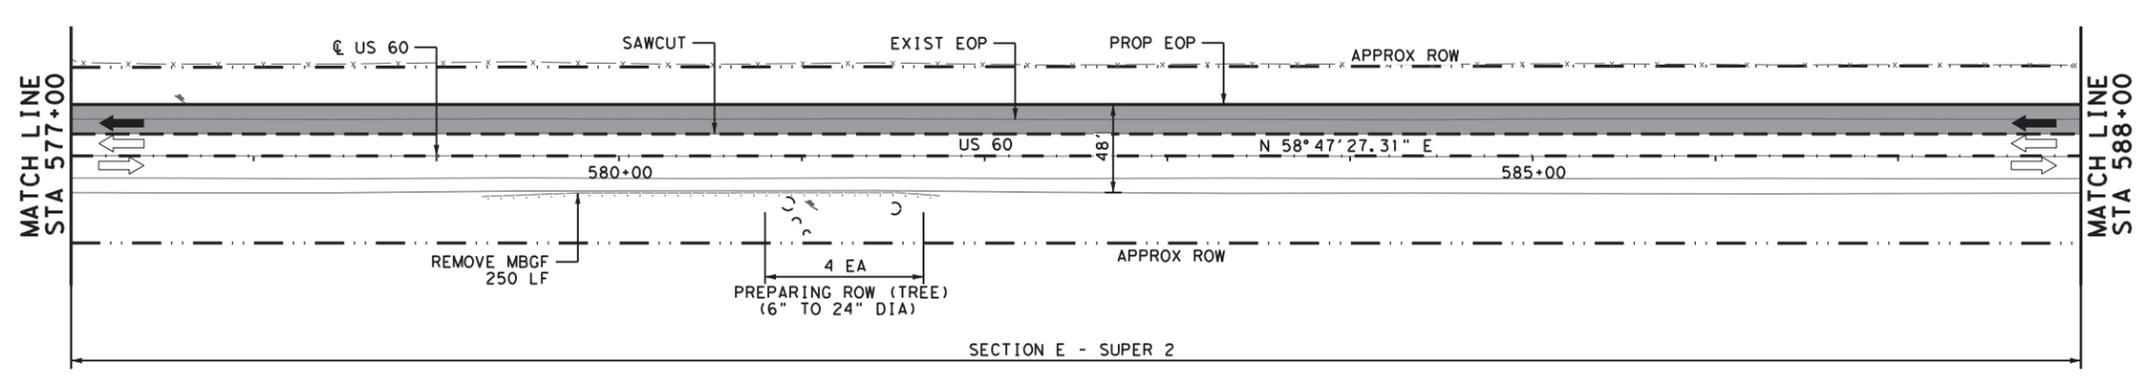

04/07/2021

Bo L. Ratto

REV. NO.	DATE	DESCRIPTION	BY

CobbFendley 13430 Northwest Freeway, Ste. 1100
Houston, Texas 77040
713.462.3242
www.cobbhendley.com




**US 60
ROADWAY PLAN
STA 566+00 TO STA 588+00**

FED. RD. DIV. NO.	STATE	PROJECT NO.	HIGHWAY NO.
6	TEXAS	(SEE TITLE SHEET)	US60
STATE DISTRICT	COUNTY	CONTROL NO.	SECTION NO.
AMA	GRAY	0169	07
			JOB NO.
			053, ETC
			SHEET NO.
			89

US60-ROAD-P&P-2B.dgn


4/7/2021
 F:\P\Projects\2019\1004_TxDOT_5x5_P5&E\03_US60_Amarillo\616\600-UST\N\S\1_2-Roadway\02-Sheets\US60_ROAD-P&P-29.dgn

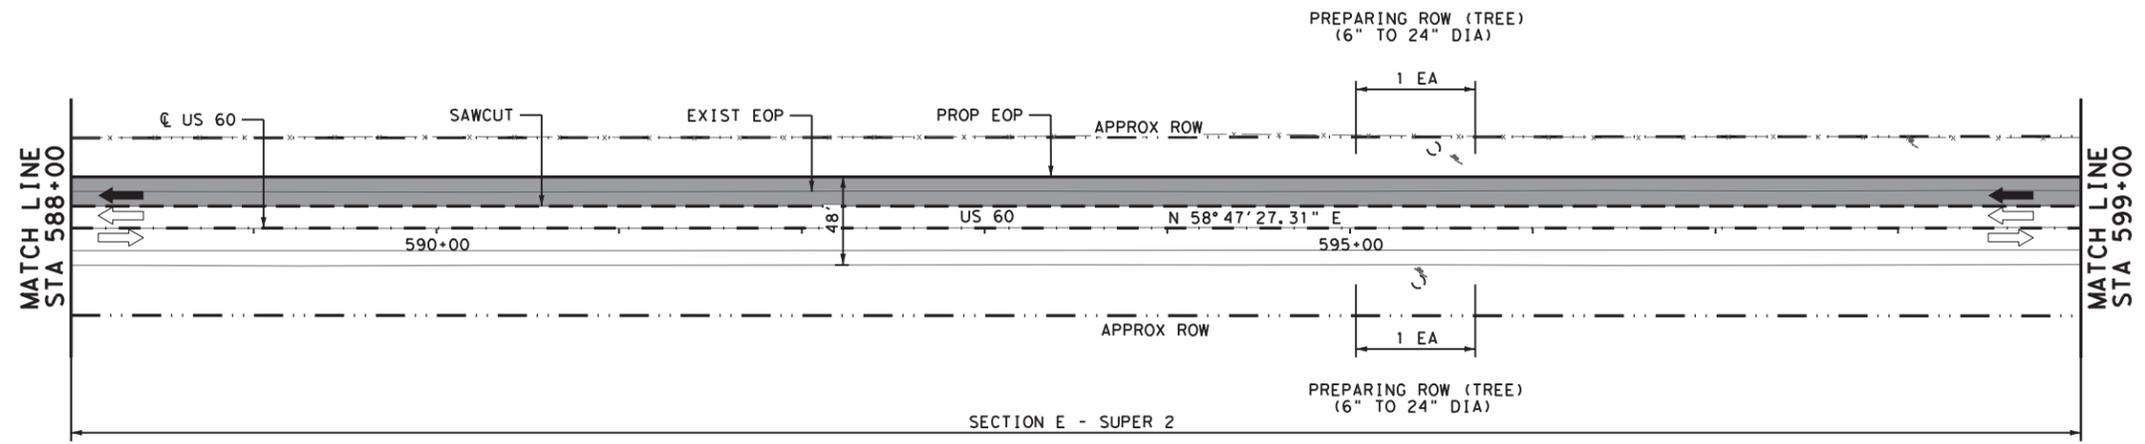

- LEGEND**
- PROPOSED PAVEMENT
 - PROPOSED DRIVEWAY
 - PROPOSED RIPRAP
 - PAVEMENT REMOVAL
 - EXIST TRAFFIC FLOW
 - PROP TRAFFIC FLOW
 - APPROX ROW
 - DRIVEWAY NUMBER
 - PROP DITCH

NOTE:

- REFER TO MISCELLANEOUS DRIVEWAY DETAILS FOR ADDITIONAL INFORMATION.

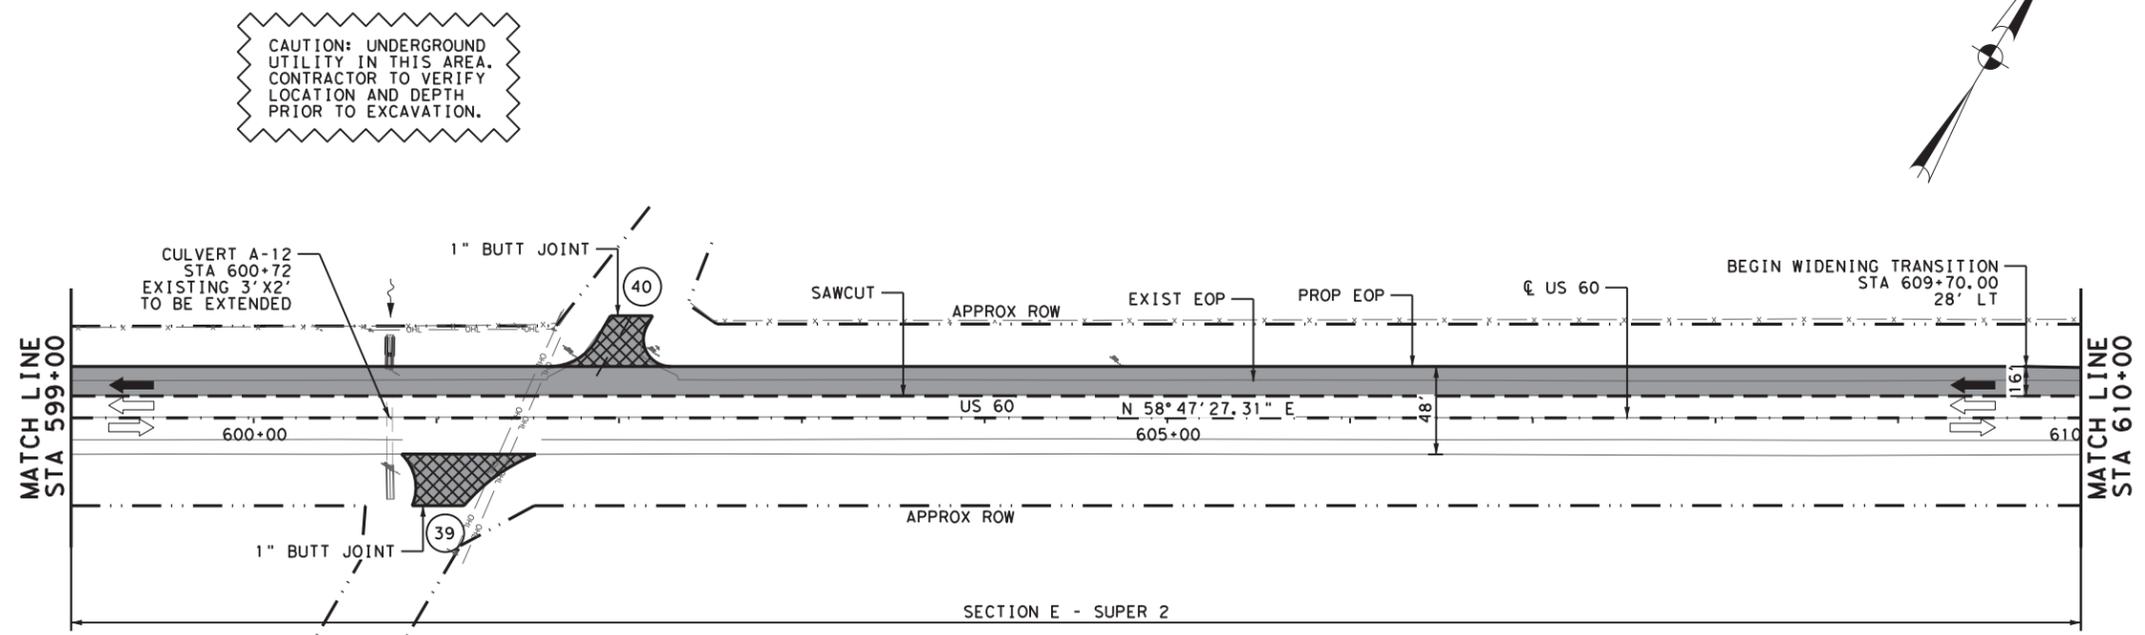

CAUTION: UNDERGROUND UTILITY IN THIS AREA. CONTRACTOR TO VERIFY LOCATION AND DEPTH PRIOR TO EXCAVATION.

04/07/2021

Bo L. Ratto

0 25 50 100
1" = 100'

REV. NO.	DATE	DESCRIPTION	BY

CobbFendley
 13430 Northwest Freeway, Ste. 1100
 Houston, Texas 77040
 TBPE Firm Registration No. 274 713.462.3242
 TBPLS Firm Registration No. 100467 www.cobbhendley.com




US 60
ROADWAY PLAN
STA 588+00 TO STA 610+00
SHEET 29 OF 38

FED. RD. DIV. NO.	STATE	PROJECT NO.	HIGHWAY NO.
6	TEXAS	(SEE TITLE SHEET)	US60
STATE DISTRICT	COUNTY	CONTROL NO.	SECTION NO.
AMA	GRAY	0169	07
			JOB NO.
			053, ETC
			SHEET NO.
			90

US60-ROAD-P&P-29.dgn


4/7/2021 7:27:01 AM F:\P\0\004\2019\1004_Tx\DOT_5x5_PSS&E\03_US60_Amar\11616\NG500\UST\N\11_2-Roadway\02-Sheets\US60_ROAD-F&P-30.dgn

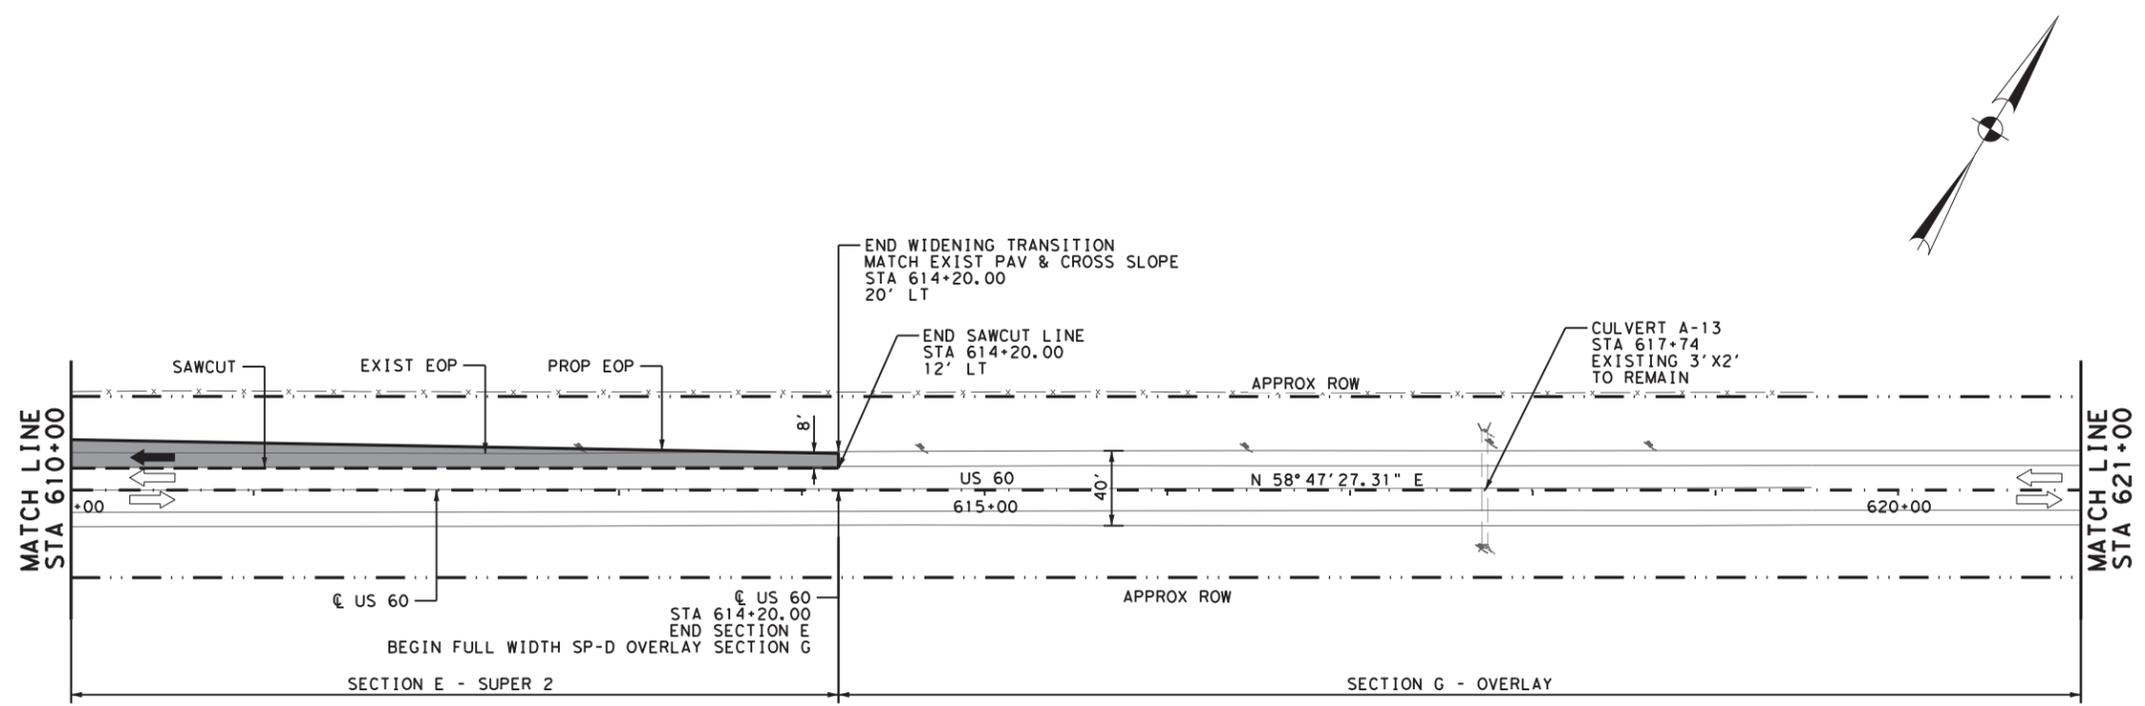

LEGEND

- PROPOSED PAVEMENT
- PROPOSED DRIVEWAY
- PROPOSED RIPRAP
- PAVEMENT REMOVAL
- EXIST TRAFFIC FLOW
- PROP TRAFFIC FLOW
- APPROX ROW
- DRIVEWAY NUMBER
- PROP DITCH

NOTE:
1. REFER TO MISCELLANEOUS DRIVEWAY DETAILS FOR ADDITIONAL INFORMATION.

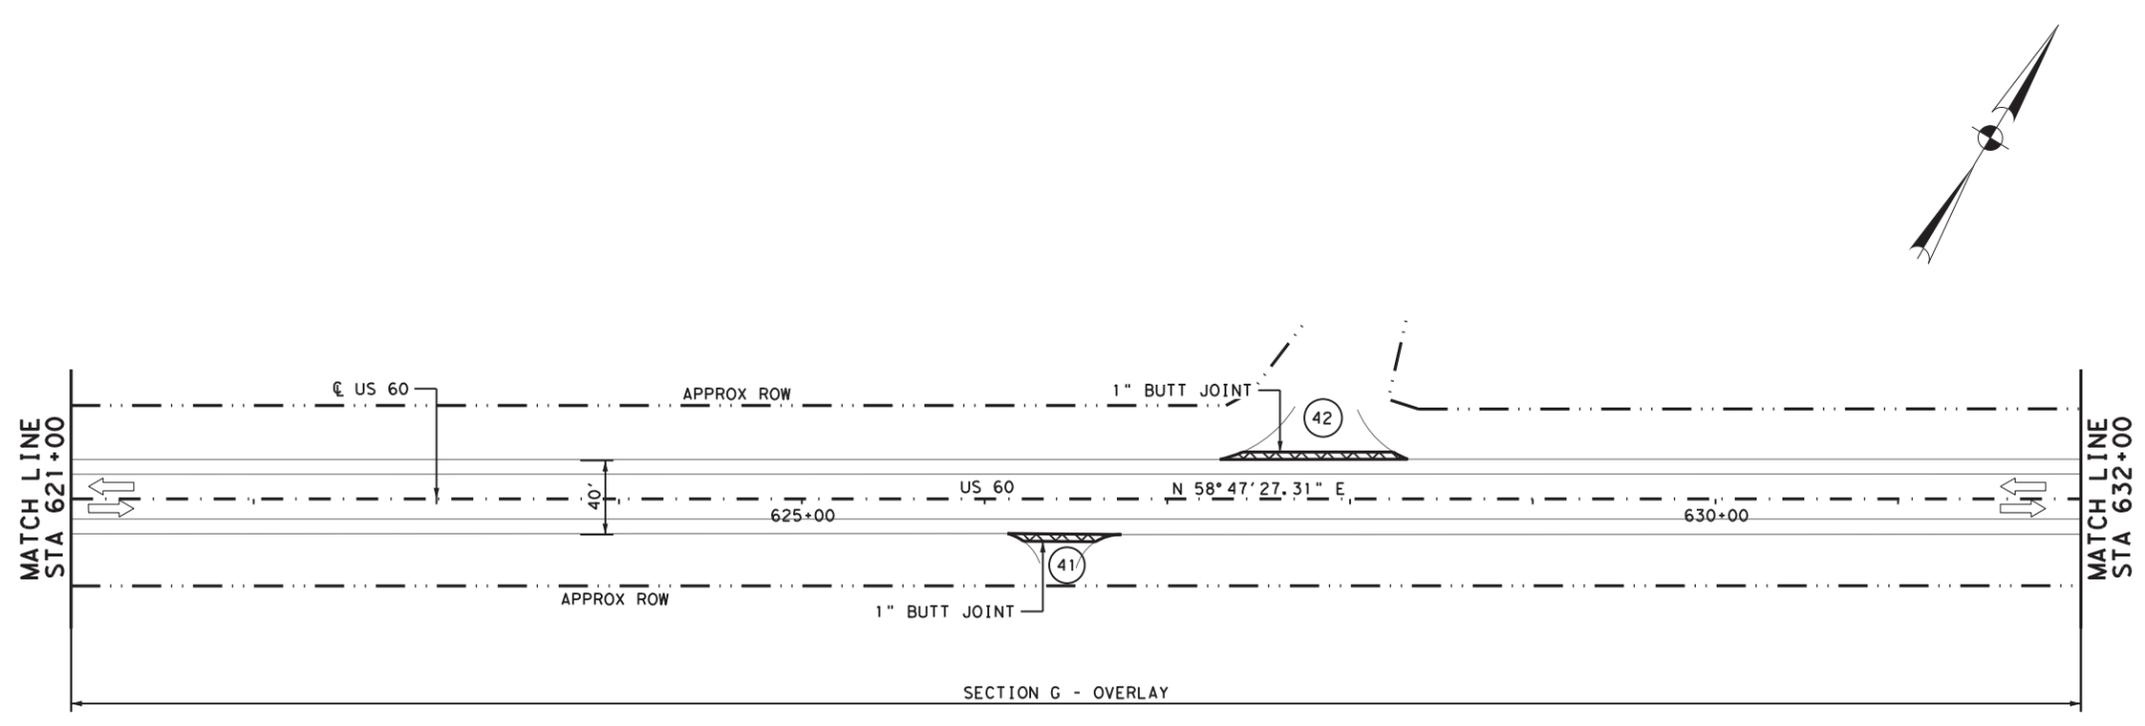

04/07/2021

Bo L. Ratto

0 25 50 100
1" = 100'

REV. NO.	DATE	DESCRIPTION	BY

CobbFendley 13430 Northwest Freeway, Ste. 1100
Houston, Texas 77040
713.462.3242
www.cobbhendley.com





**US 60
ROADWAY PLAN
STA 610+00 TO STA 632+00**

SHEET **30** OF **38**

FED. RD. DIV. NO.	STATE	PROJECT NO.	HIGHWAY NO.		
6	TEXAS	(SEE TITLE SHEET)	US60		
STATE DISTRICT	COUNTY	CONTROL NO.	SECTION NO.	JOB NO.	SHEET NO.
AMA	GRAY	0169	07	053, ETC	91

US60-ROAD-F&P-30.dgn

4/7/2021 7:27:02 AM F:\P\J\2019\1004_Tx\DOT_5x5_P5&E\03_US60_Amar\1161616\US60-USTIN\11.2-Roadway\02-Sheets\US60_ROAD-P&P-31.dgn

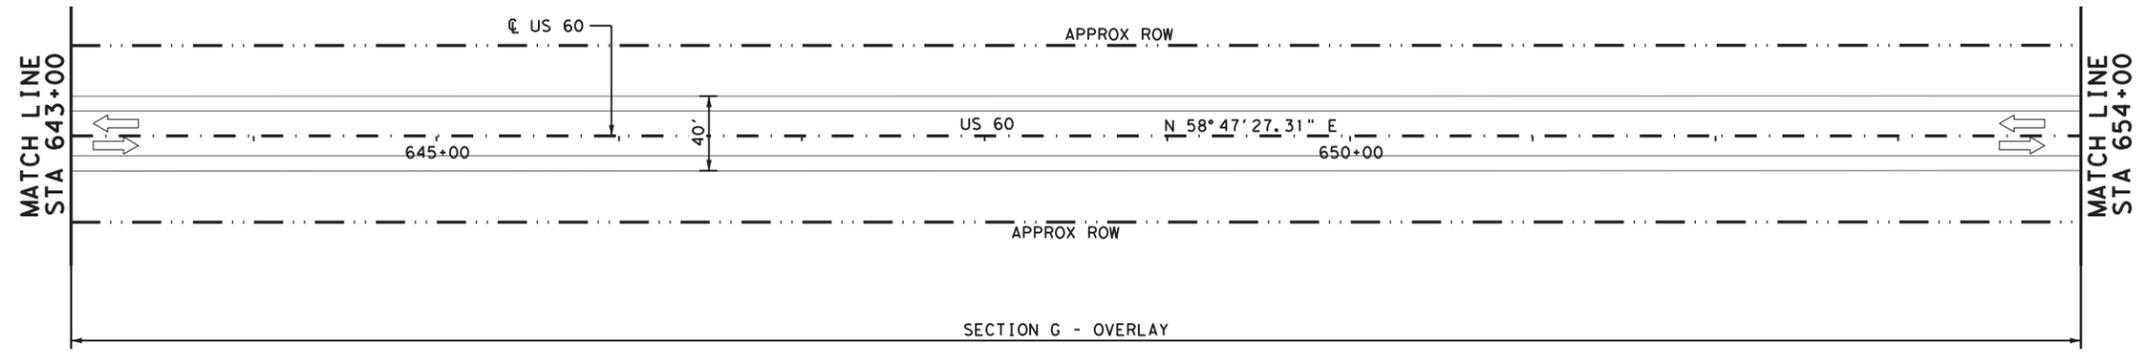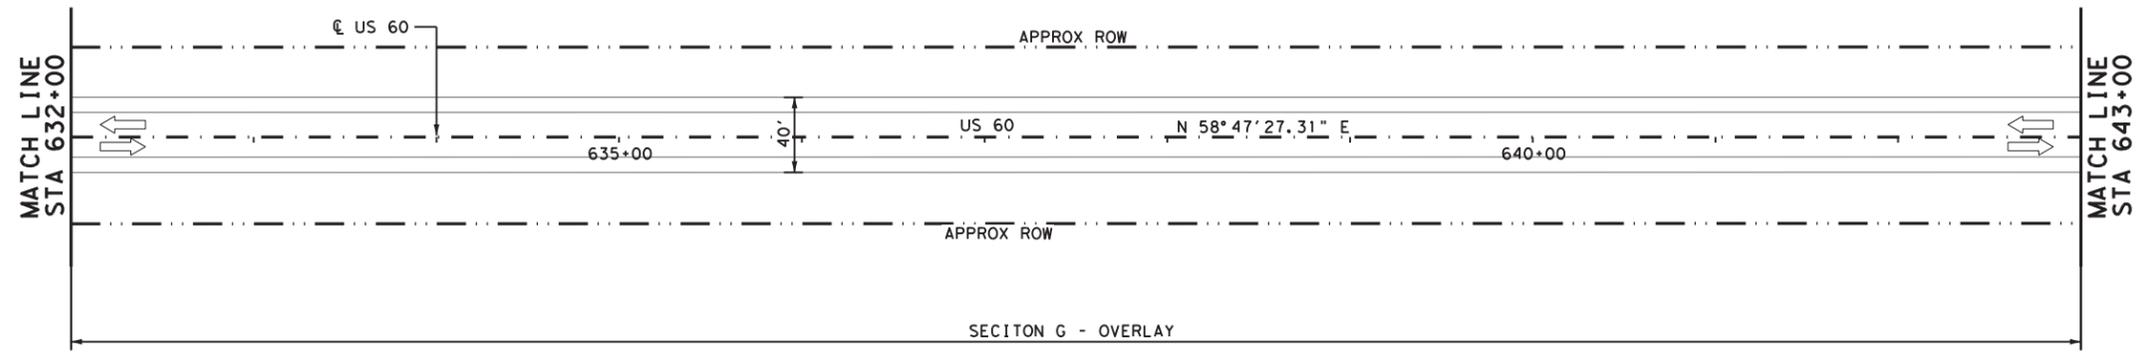

- LEGEND**
- PROPOSED PAVEMENT
 - PROPOSED DRIVEWAY
 - PROPOSED RIPRAP
 - PAVEMENT REMOVAL
 - EXIST TRAFFIC FLOW
 - PROP TRAFFIC FLOW
 - APPROX ROW
 - DRIVEWAY NUMBER
 - PROP DITCH

NOTE:
1. REFER TO MISCELLANEOUS DRIVEWAY DETAILS FOR ADDITIONAL INFORMATION.

04/07/2021

Bo L. Ratto

REV. NO.	DATE	DESCRIPTION	BY

CobbFendley 13430 Northwest Freeway, Ste. 1100
Houston, Texas 77040
713.462.3242
www.cobbfendley.com



Texas Department of Transportation

**US 60
ROADWAY PLAN
STA 632+00 TO STA 654+00**

FED. RD. DIV. NO.	STATE	PROJECT NO.	HIGHWAY NO.
6	TEXAS	(SEE TITLE SHEET)	US60
STATE DISTRICT	COUNTY	CONTROL NO.	SECTION NO.
AMA	GRAY	0169	07
			JOB NO.
			053, ETC
			SHEET NO.
			92

US60-ROAD-P&P-31.dgn

4/7/2021 7:27:03 AM F:\P\proj\2019\1004_Tx\DOT_5x5_P5&E\03_US60_Amari\16\EN\6500-UST\N\511_2-Roadway\02-Sheets\US60_ROAD-P&P-32.dgn

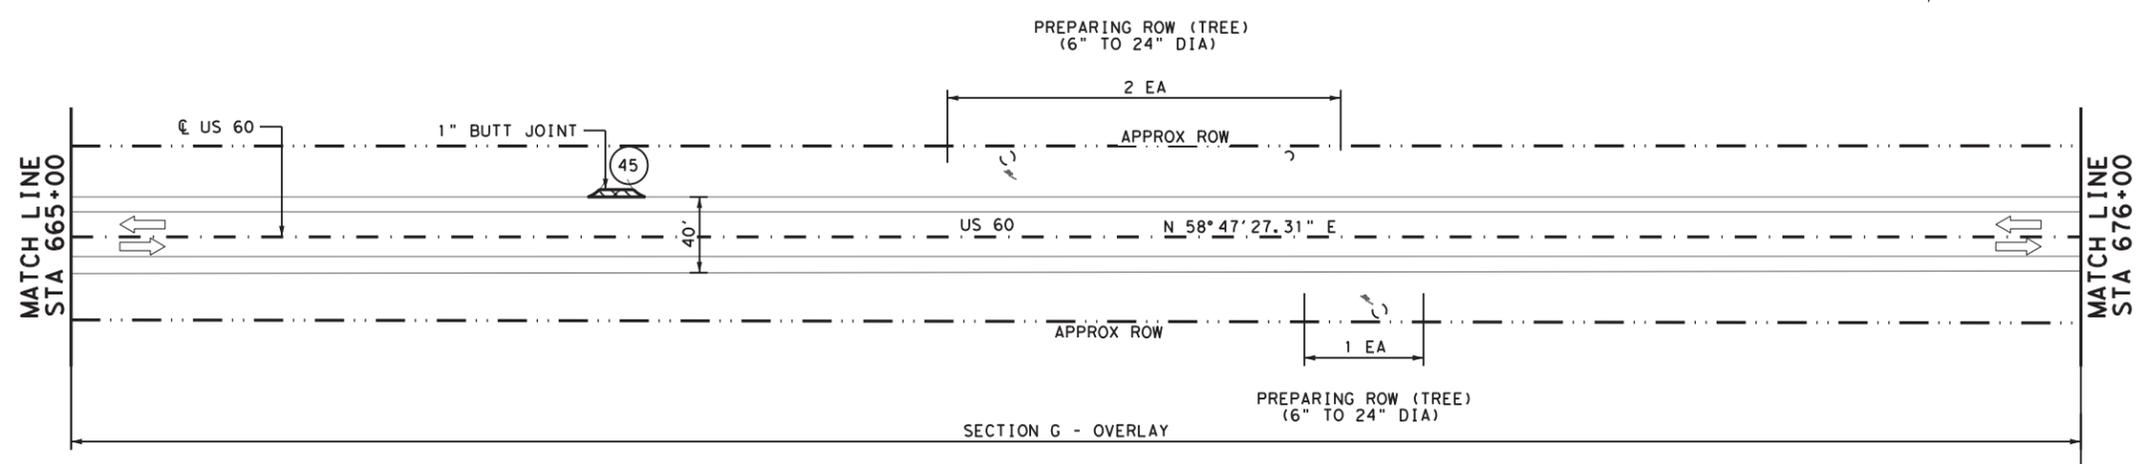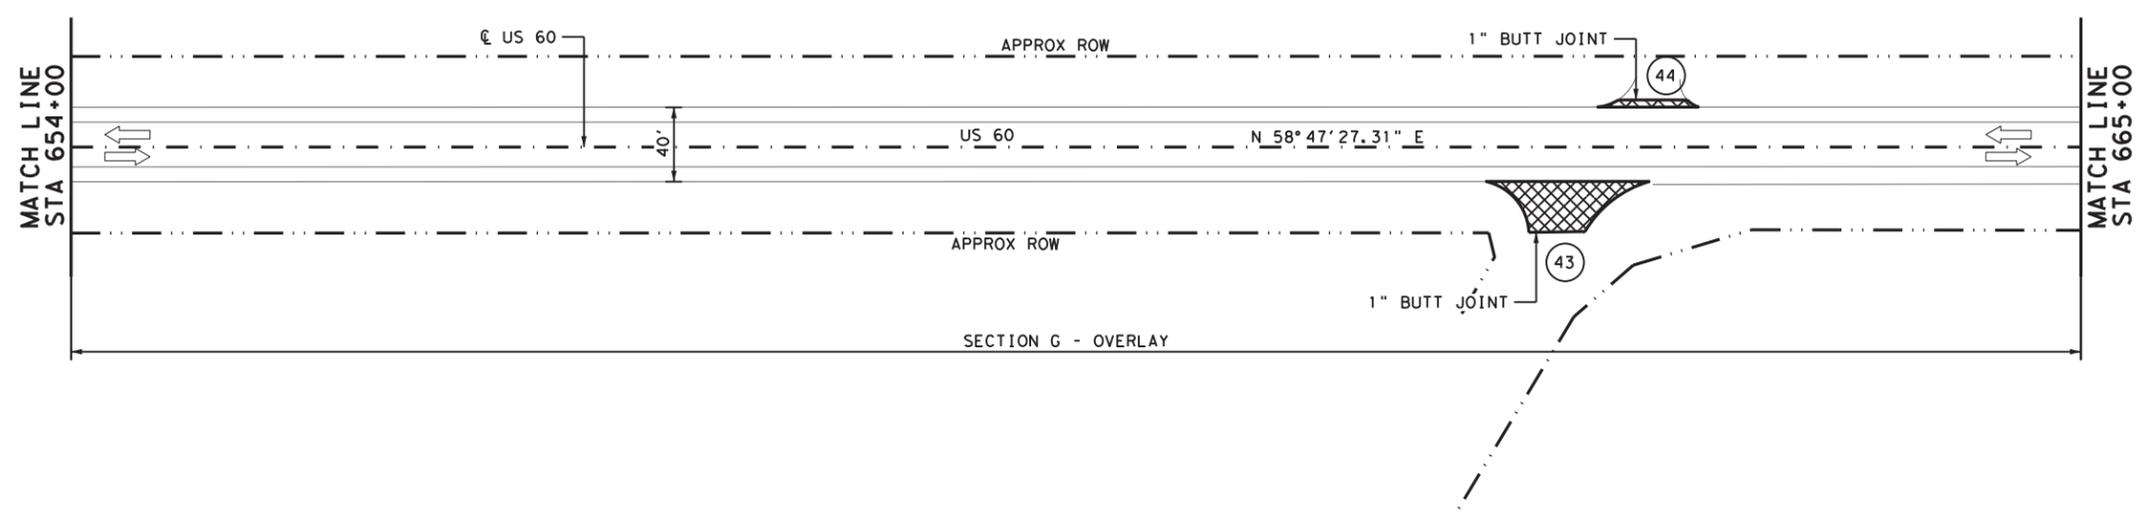

- LEGEND**
- PROPOSED PAVEMENT
 - PROPOSED DRIVEWAY
 - PROPOSED RIPRAP
 - PAVEMENT REMOVAL
 - EXIST TRAFFIC FLOW
 - PROP TRAFFIC FLOW
 - APPROX ROW
 - DRIVEWAY NUMBER
 - PROP DITCH

NOTE:
1. REFER TO MISCELLANEOUS DRIVEWAY DETAILS FOR ADDITIONAL INFORMATION.

04/07/2021

Bo L. Ratto

1" = 100'

REV. NO.	DATE	DESCRIPTION	BY

CobbFendley 13430 Northwest Freeway, Ste. 1100
Houston, Texas 77040
713.462.3242
www.cobbhendley.com

Texas Department of Transportation


**US 60
ROADWAY PLAN
STA 654+00 TO STA 676+00**

SHEET 32 OF 38

FED. RD. DIV. NO.	STATE	PROJECT NO.	HIGHWAY NO.
6	TEXAS	(SEE TITLE SHEET)	US60
STATE DISTRICT	COUNTY	CONTROL NO.	SECTION NO.
AMA	GRAY	0169	07
		JOB NO.	SHEET NO.
		053, ETC	93


US60-ROAD-P&P-32.dgn

4/7/2021 7:27:04 AM F:\P\Projects\2019\1004_Tx\DOT_5x5_P5&E\03_US60_Amari\16\16\500-UST\N\S\11_2-Roadway\02-Sheets\US60_ROAD-F&P-33.dgn

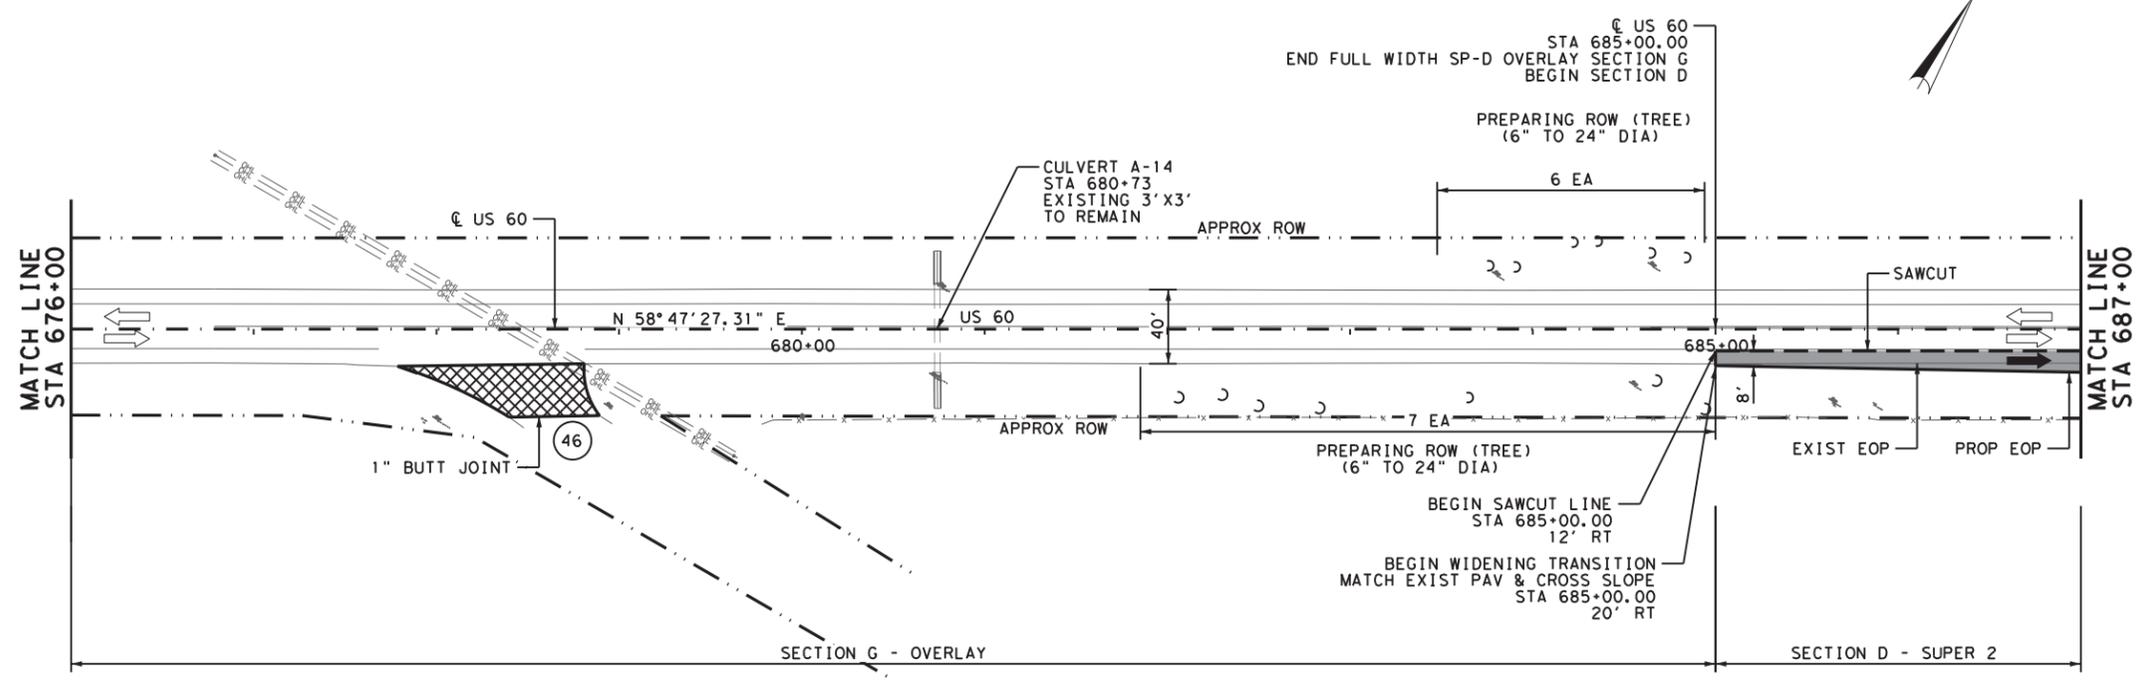

- LEGEND**
- PROPOSED PAVEMENT
 - PROPOSED DRIVEWAY
 - PROPOSED RIPRAP
 - PAVEMENT REMOVAL
 - EXIST TRAFFIC FLOW
 - PROP TRAFFIC FLOW
 - APPROX ROW
 - DRIVEWAY NUMBER
 - PROP DITCH

NOTE:
1. REFER TO MISCELLANEOUS DRIVEWAY DETAILS FOR ADDITIONAL INFORMATION.

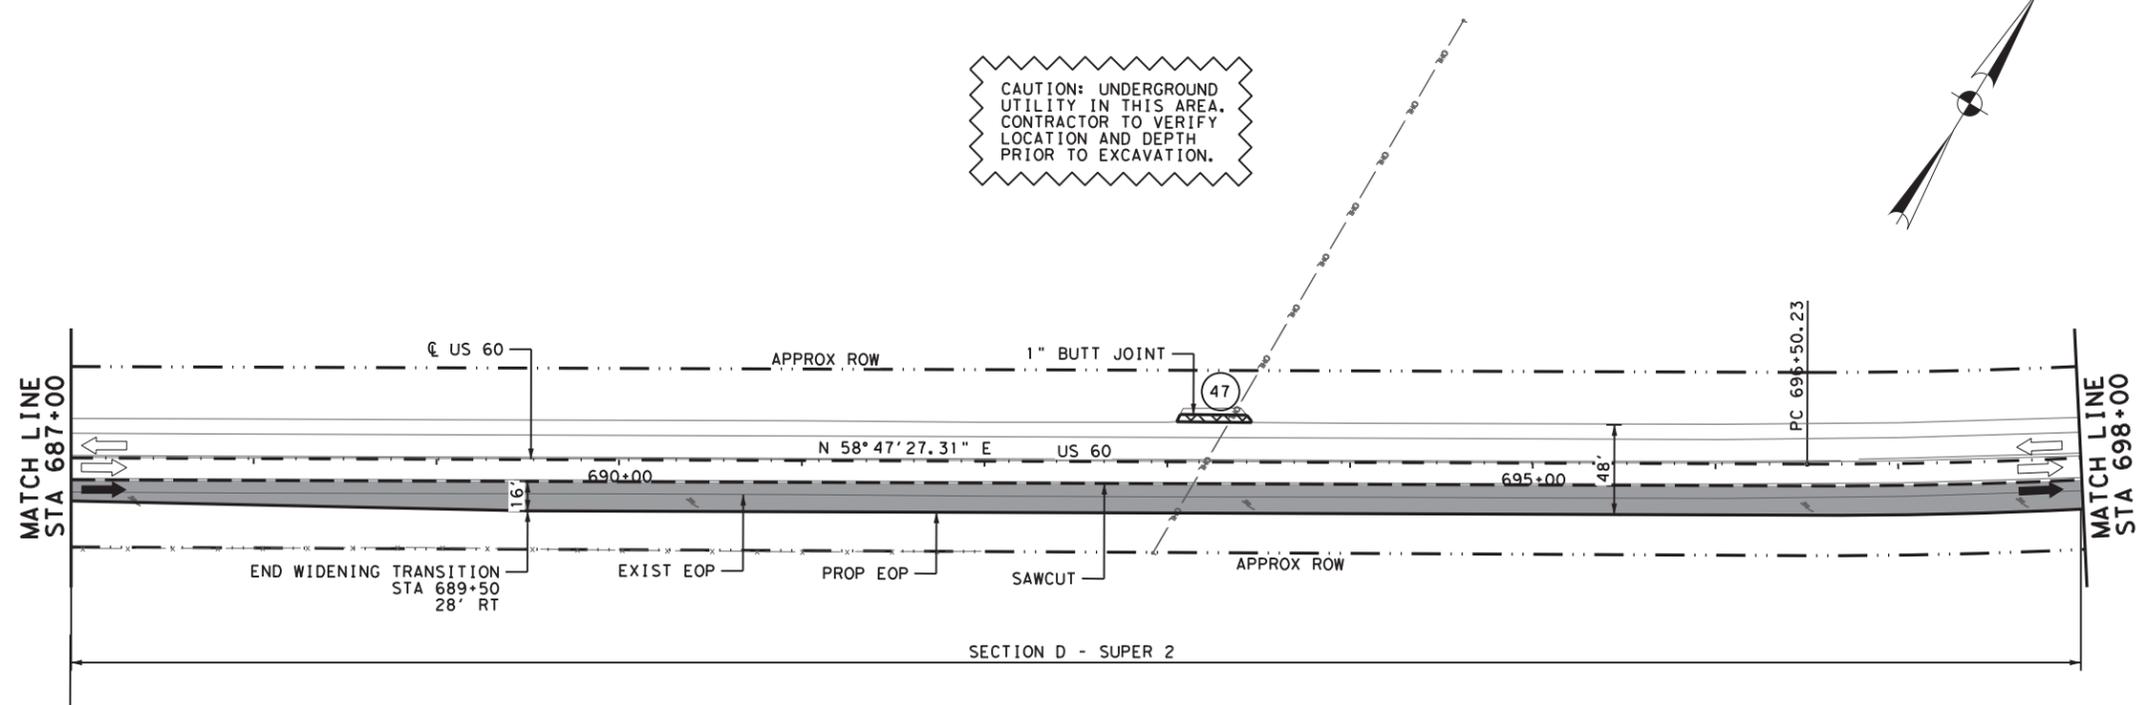

CAUTION: UNDERGROUND UTILITY IN THIS AREA. CONTRACTOR TO VERIFY LOCATION AND DEPTH PRIOR TO EXCAVATION.

04/07/2021

Bo L. Ratto

0 25 50 100
1" = 100'

REV. NO.	DATE	DESCRIPTION	BY

13430 Northwest Freeway, Ste. 1100
Houston, Texas 77040
713.462.3242
www.cobbhendley.com

Texas Department of Transportation


**US 60
ROADWAY PLAN
STA 676+00 TO STA 698+00**

SHEET 33 OF 38

FED. RD. DIV. NO.	STATE	PROJECT NO.	HIGHWAY NO.		
6	TEXAS	(SEE TITLE SHEET)	US60		
STATE DISTRICT	COUNTY	CONTROL NO.	SECTION NO.	JOB NO.	SHEET NO.
AMA	GRAY	0169	07	053, ETC	94

US60-ROAD-F&P-33.dgn


4/7/2021 7:27:05 AM F:\P\Projects\2019\1004_TxDOT_5x5_P&E\03_US60_Amari\16\EN\600-UST\N\511_2-Roadway\02-Sheets\US60_ROAD-P&E-35.dgn

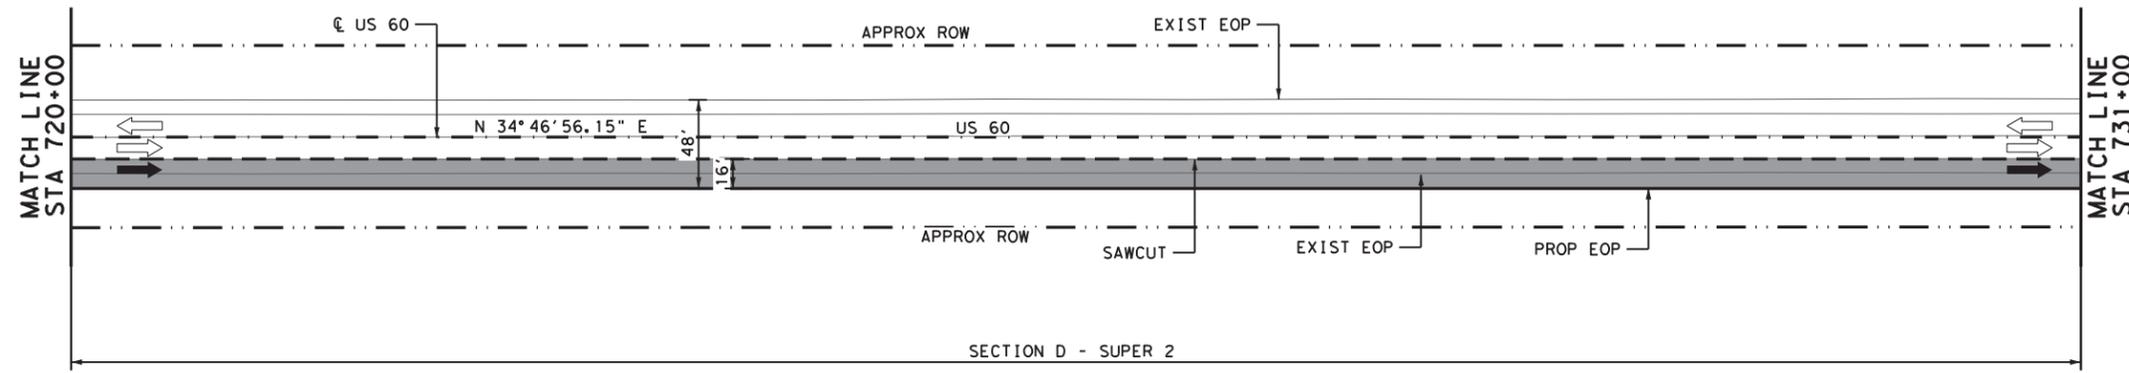

LEGEND

- PROPOSED PAVEMENT
- PROPOSED DRIVEWAY
- PROPOSED RIPRAP
- PAVEMENT REMOVAL
- EXIST TRAFFIC FLOW
- PROP TRAFFIC FLOW
- APPROX ROW
- DRIVEWAY NUMBER
- PROP DITCH

NOTE:
1. REFER TO MISCELLANEOUS DRIVEWAY DETAILS FOR ADDITIONAL INFORMATION.

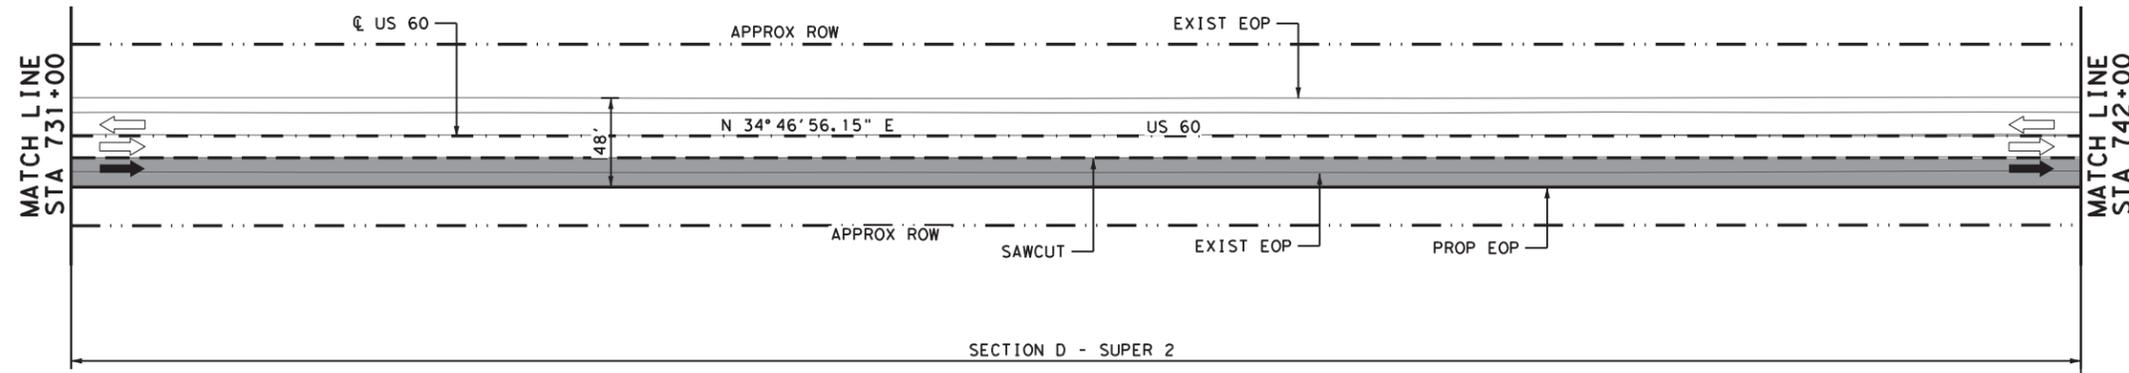

04/07/2021

Bo L. Ratto

0 25 50 100
1" = 100'

REV. NO.	DATE	DESCRIPTION	BY

13430 Northwest Freeway, Ste. 1100
Houston, Texas 77040
713.462.3242
www.cobbhendley.com


**US 60
ROADWAY PLAN
STA 720+00 TO STA 742+00**

SHEET 35 OF 38

FED. RD. DIV. NO.	STATE	PROJECT NO.	HIGHWAY NO.
6	TEXAS	(SEE TITLE SHEET)	US60
STATE DISTRICT	COUNTY	CONTROL NO.	SECTION NO.
AMA	GRAY	0169	07
			JOB NO.
			053, ETC
			SHEET NO.
			96

US60-ROAD-P&E-35.dgn

4/7/2021 7:27:06 AM F:\P\Projects\2019\1004_TxDOT_5x5_P5&E\03_US60_Amrt\16\EN\6500\UST\N\11_2-Roadway\02-Sheets\US60_ROAD-P&P-36.dgn

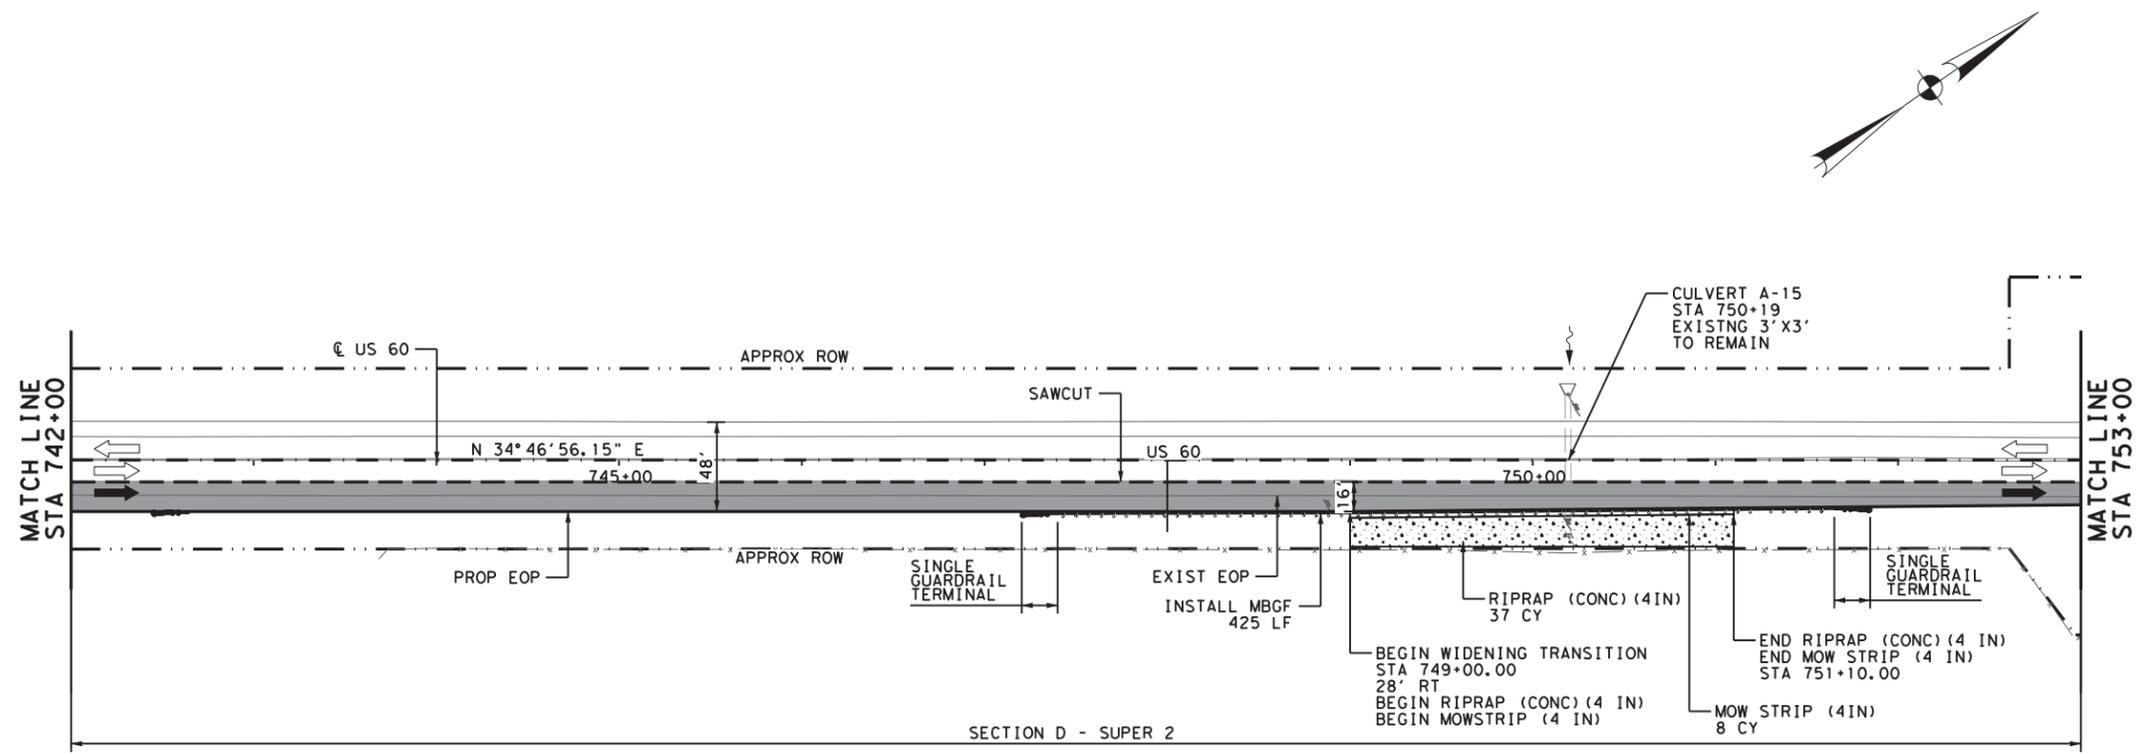


LEGEND

- PROPOSED PAVEMENT
- PROPOSED DRIVEWAY
- PROPOSED RIPRAP
- PAVEMENT REMOVAL
- EXIST TRAFFIC FLOW
- PROP TRAFFIC FLOW
- APPROX ROW
- DRIVEWAY NUMBER
- PROP DITCH

NOTE:

1. REFER TO MISCELLANEOUS DRIVEWAY DETAILS FOR ADDITIONAL INFORMATION.

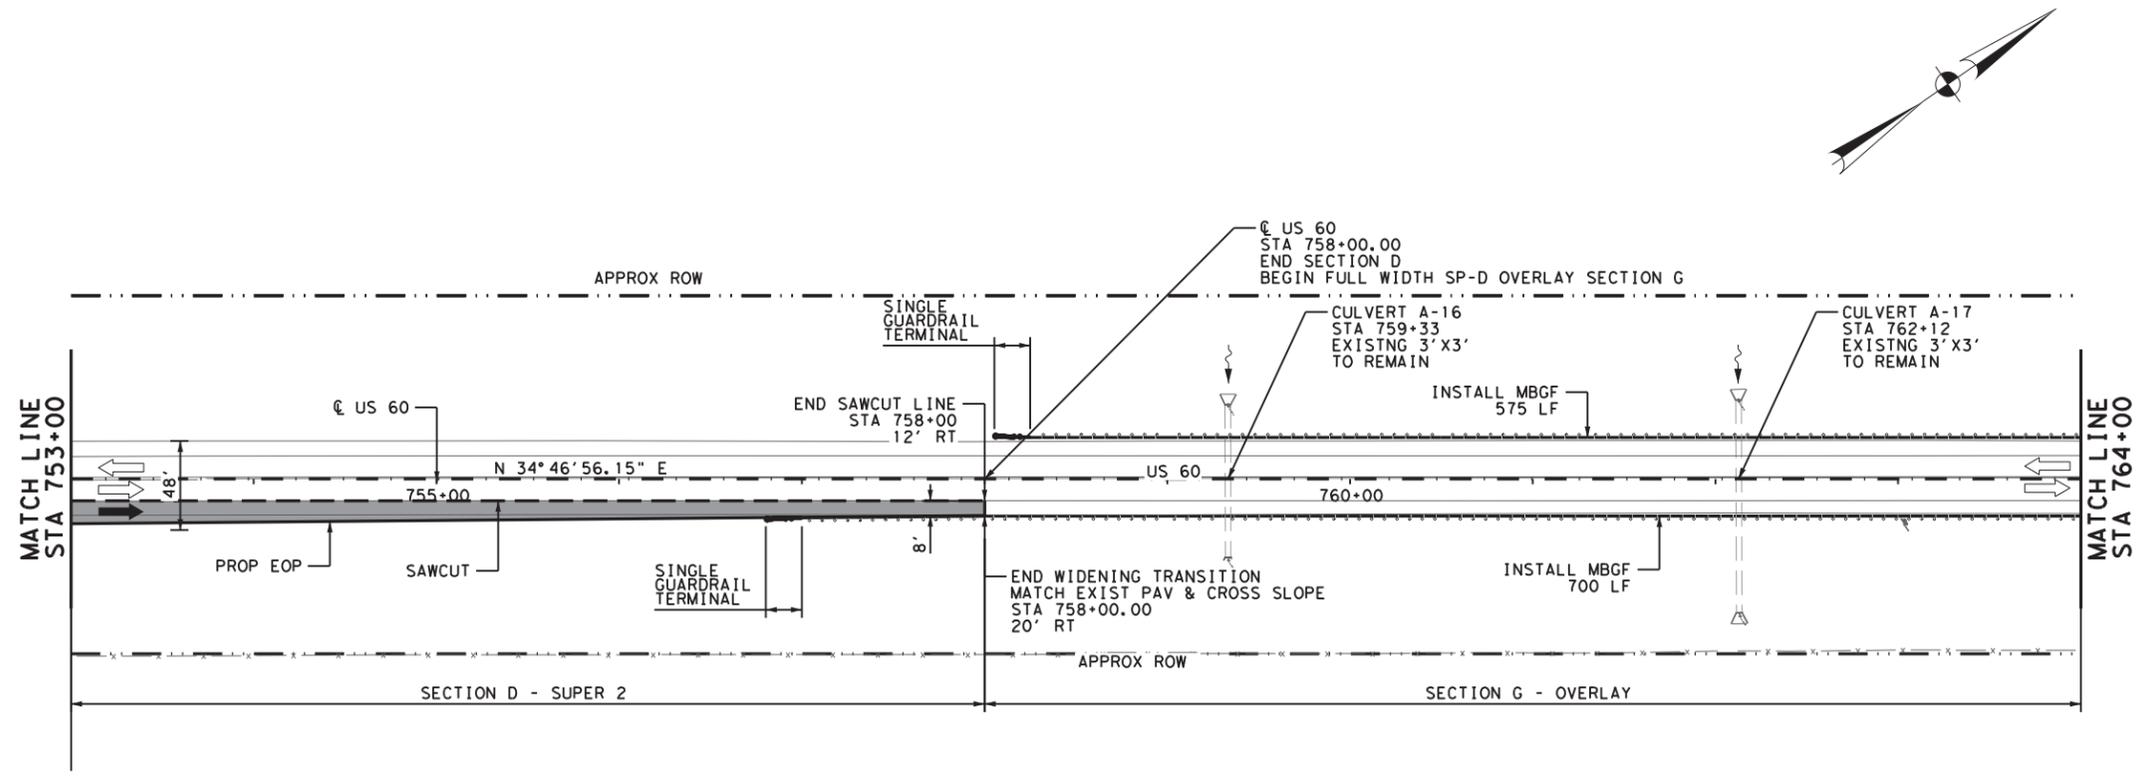

04/07/2021

Bo L. Ratto

REV. NO.	DATE	DESCRIPTION	BY


CobbFendley 13430 Northwest Freeway, Ste. 1100
 Houston, Texas 77040
 713.462.3242
 www.cobbhendley.com

Texas Department of Transportation

US 60
ROADWAY PLAN
STA 742+00 TO STA 764+00
SHEET 36 OF 38

FED. RD. DIV. NO.	STATE	PROJECT NO.	HIGHWAY NO.
6	TEXAS	(SEE TITLE SHEET)	US60
STATE DISTRICT	COUNTY	CONTROL NO.	SECTION NO.
AMA	GRAY	0169	07
			JOB NO.
			053, ETC
			SHEET NO.
			97

US60-ROAD-P&P-36.dgn

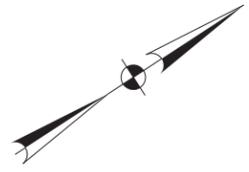


LEGEND



- PROPOSED PAVEMENT
- PROPOSED DRIVEWAY
- PROPOSED RIPRAP
- PAVEMENT REMOVAL
- EXIST TRAFFIC FLOW
- PROP TRAFFIC FLOW
- APPROX ROW
- DRIVEWAY NUMBER
- PROP DITCH

NOTE:

1. REFER TO MISCELLANEOUS DRIVEWAY DETAILS FOR ADDITIONAL INFORMATION.

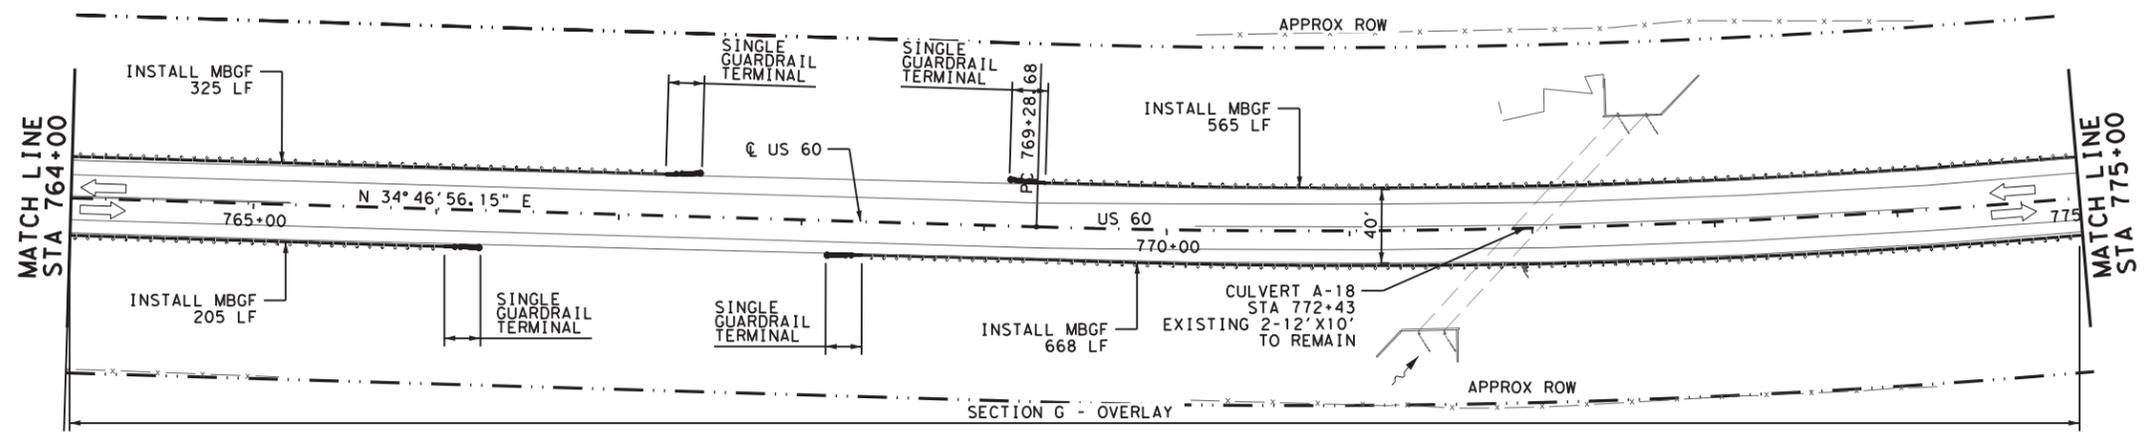

SECTION G - OVERLAY

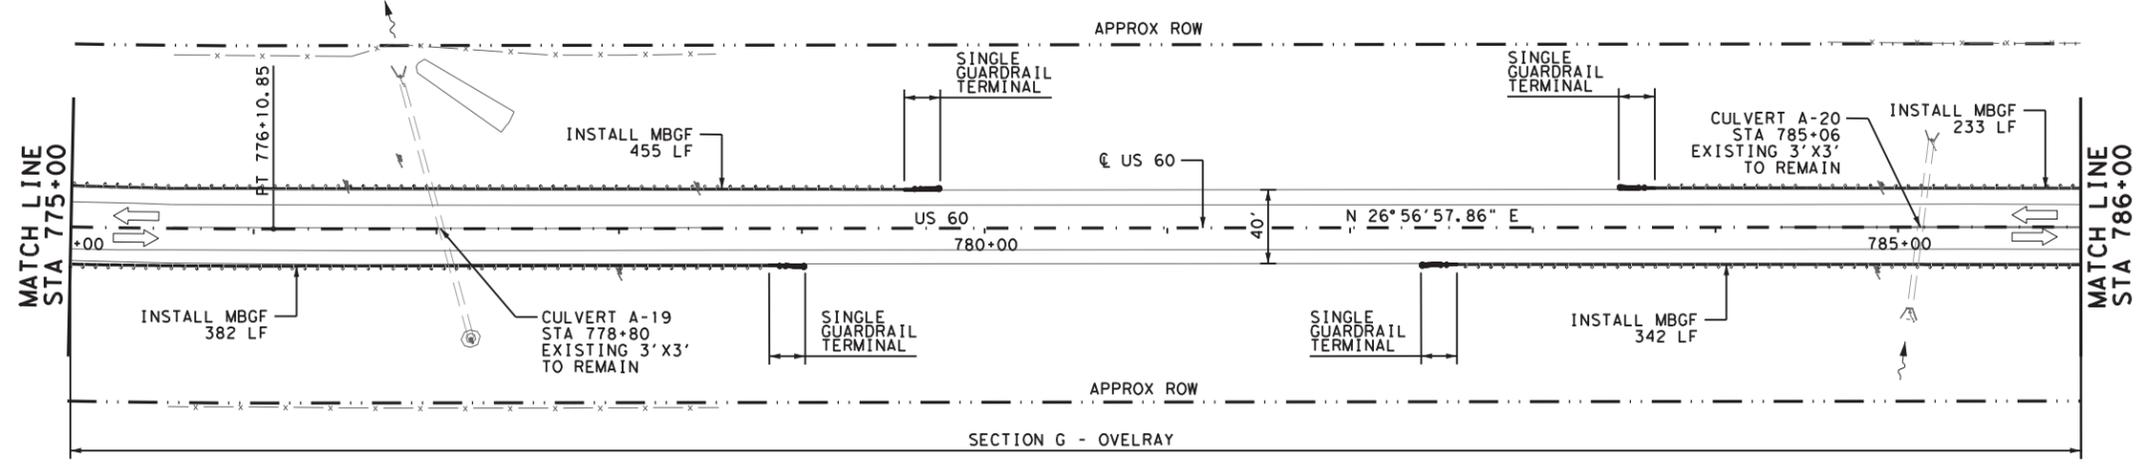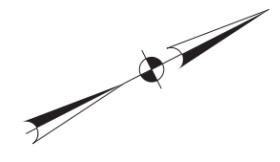


SECTION G - OVERLAY

04/07/2021



Bo L. Ratto

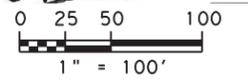

REV. NO.	DATE	DESCRIPTION	BY

CobbFendley 13430 Northwest Freeway, Ste. 1100
Houston, Texas 77040
713.462.3242
www.cobbfendley.com



**US 60
ROADWAY PLAN
STA 764+00 TO STA 786+00**

SHEET 37 OF 38

FED. RD. DIV. NO.	STATE	PROJECT NO.	HIGHWAY NO.
6	TEXAS	(SEE TITLE SHEET)	US60
STATE DISTRICT	COUNTY	CONTROL NO.	SECTION NO.
AMA	GRAY	0169	07
		JOB NO.	SHEET NO.
		053, ETC	98

4/7/2021 7:27:07 AM F:\P\proj\162019\1004_Tx\DOT_15x5_PSS&E\03_US60_Amarillo\162019\DOT_15x5_PSS&E\03_US60_ROADWAY\02-Sheets\US60_ROADWAY-P&P-37.dgn


US60-ROADWAY-P&P-37.dgn

① CURVE DATA - P-WB-SH152

P. I. STATION	=	14+97.15
DELTA	=	59° 50' 52.40" (RT)
DEGREE	=	8° 18' 13.45"
TANGENT	=	397.1514
LENGTH	=	720.7345
RADIUS	=	690.0000
P. C. STATION	=	11+00.00
P. T. STATION	=	18+20.73



SUPER ELEVATION RATES

STATION LIMITS	SUPERELEVATION RATE
10+00.00 TO 10+10.00	NORMAL CROWN
10+10.00 TO 11+15.00	TRANSITION
11+15.00 TO 18+00.73	-5.60%
18+00.73 TO 19+50.73	TRANSITION
19+50.73 TO 20+80.32	-0.50%

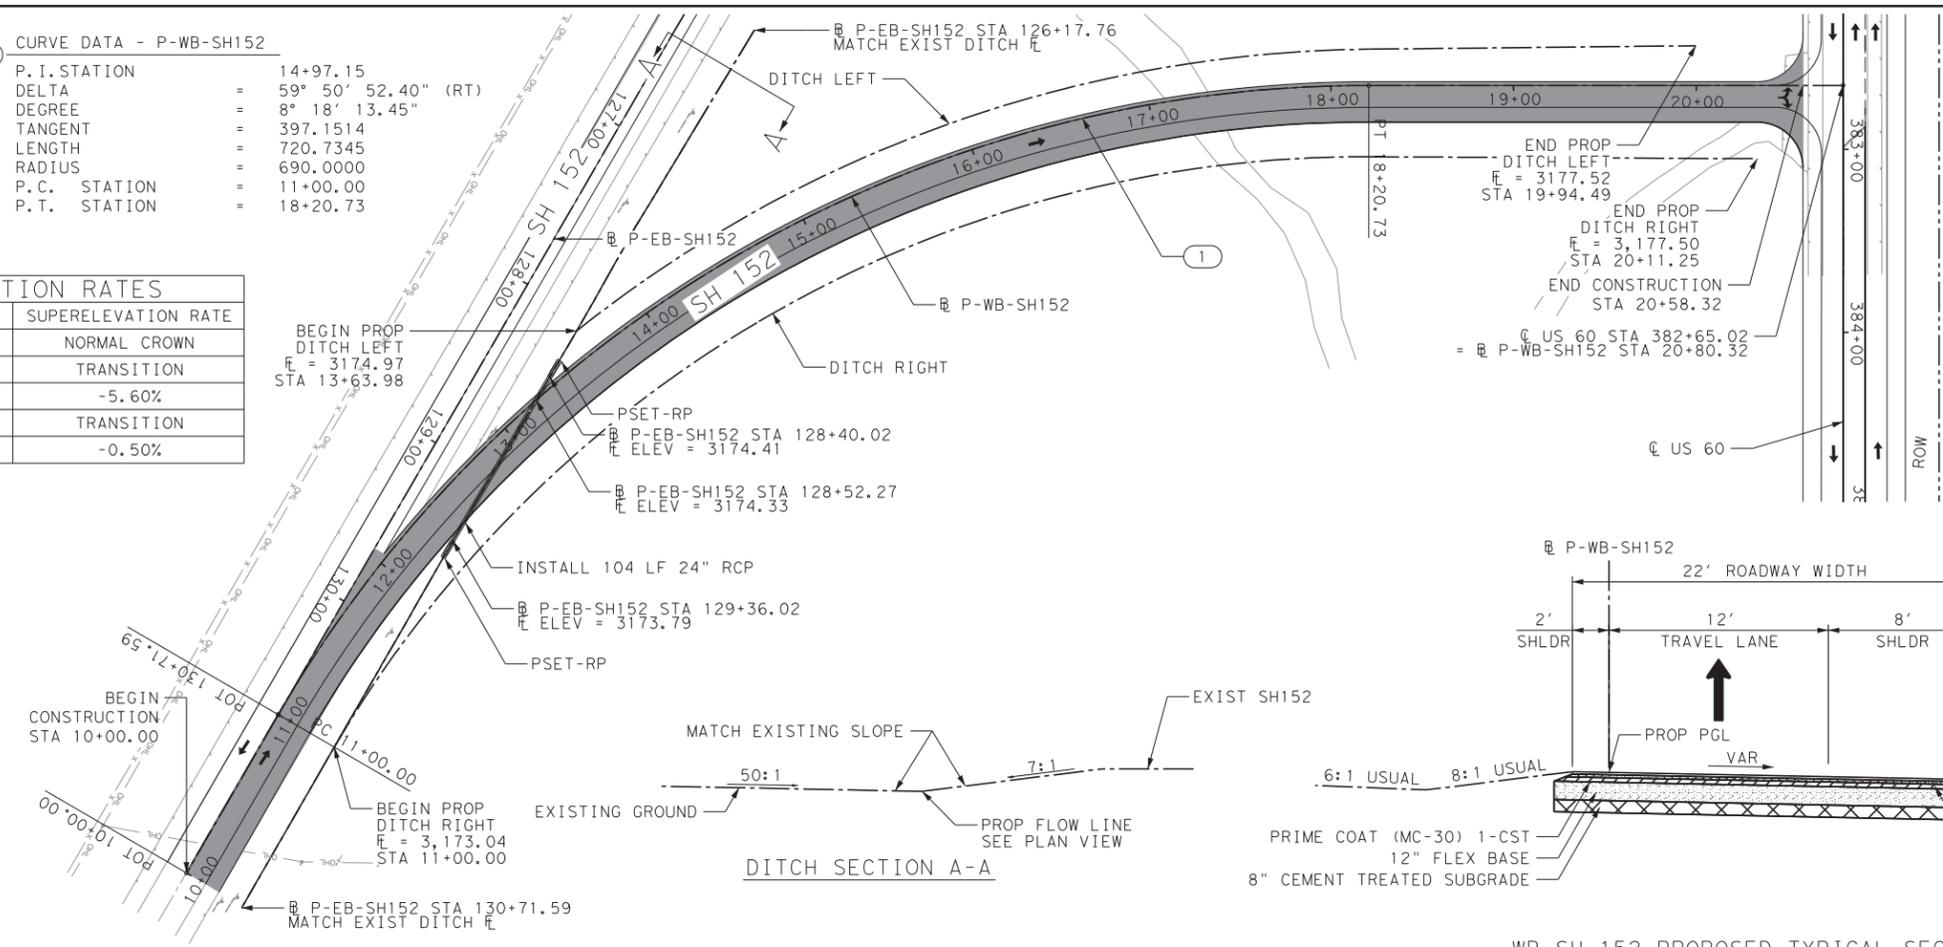

- LEGEND:
- TRAFFIC FLOW ARROW
 - PROPOSED PAVEMENT
 - - - PROPOSED DITCH

- NOTES:
- SAWCUT AT EXISTING SH 152 LANE LINE. REMOVE 1 FT. OF EXISTING SURFACE COURSE. WORK WILL BE CONSIDERED SUBSIDIARY TO ITEM 251.

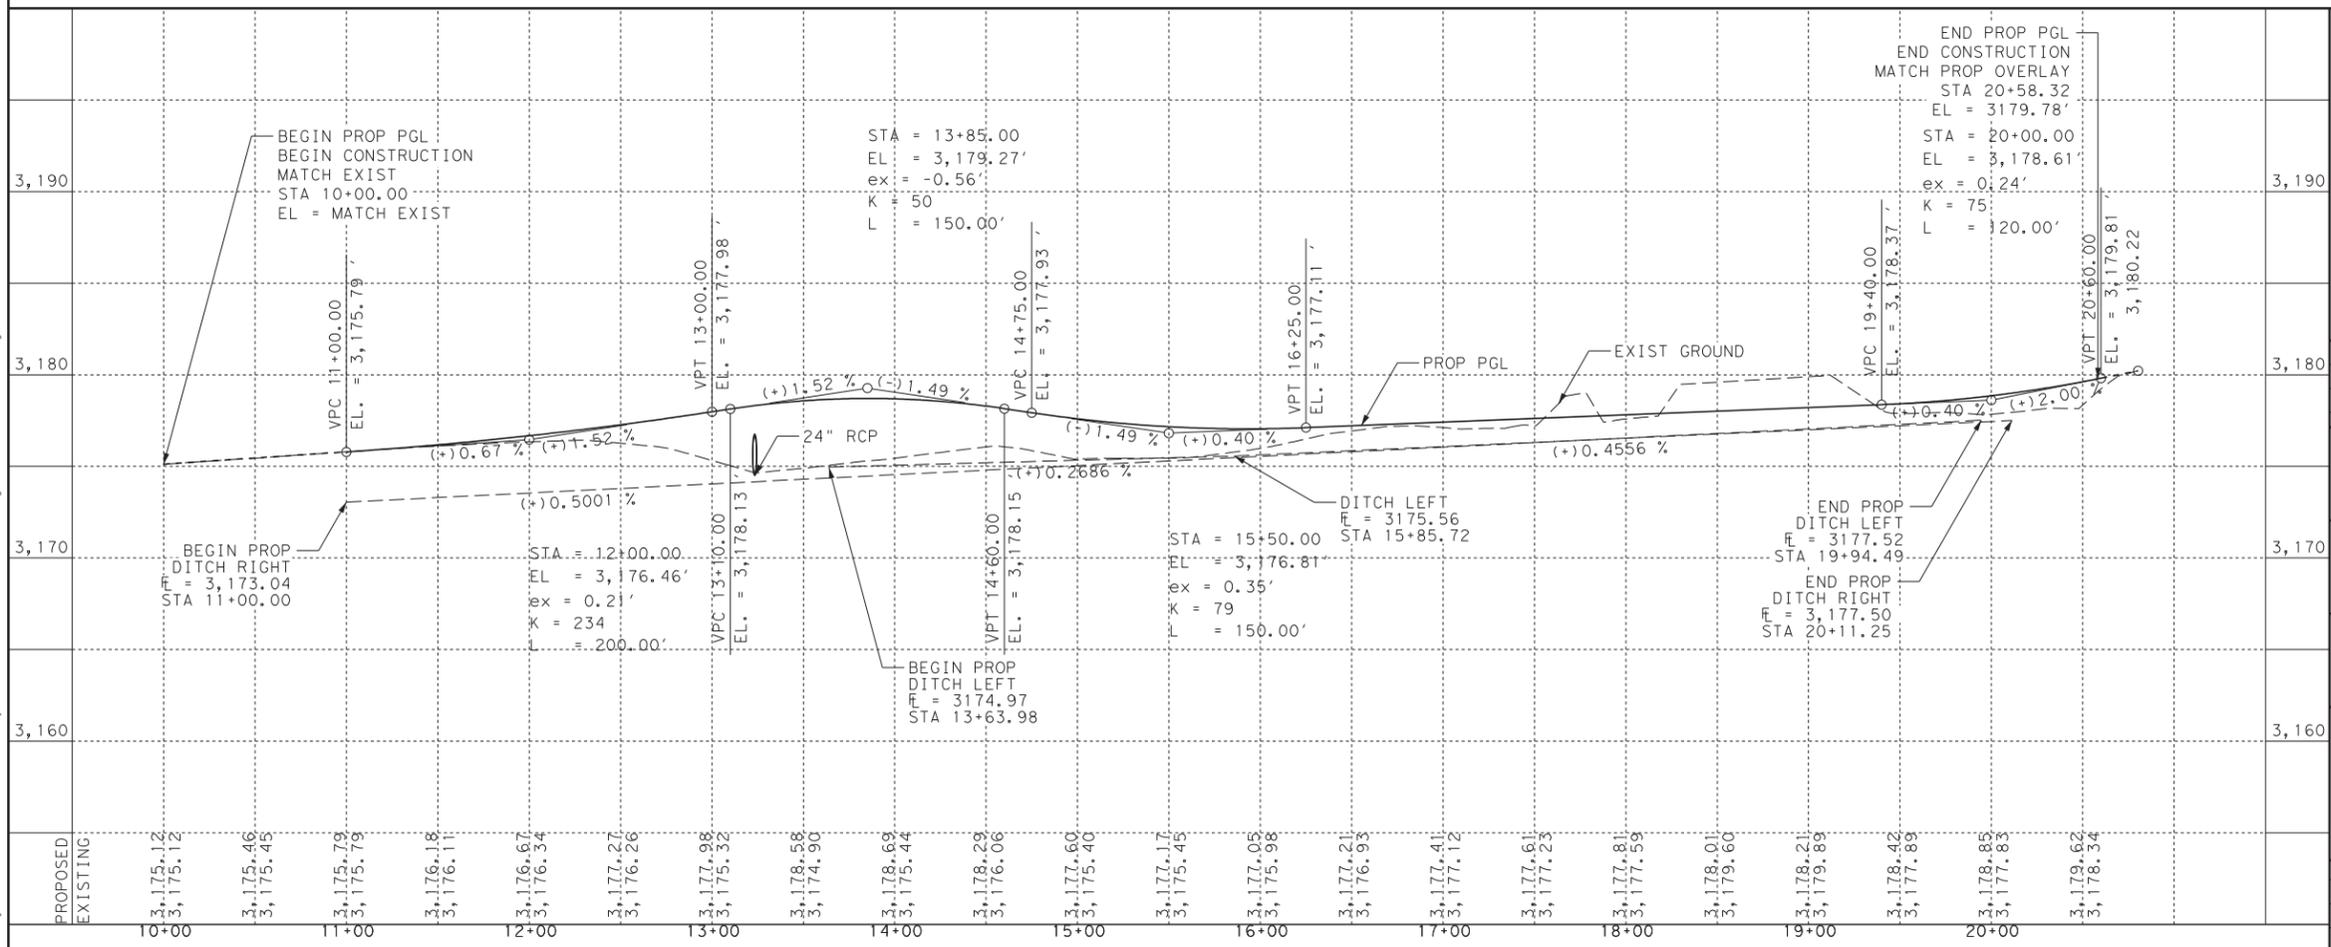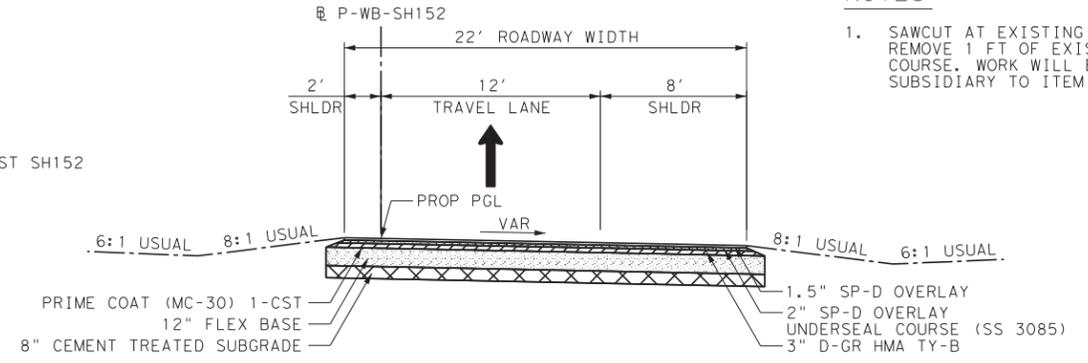

STATE OF TEXAS
COURTNEY KINTNER
129701
LICENSED PROFESSIONAL ENGINEER
3/31/2021
1" = 100'

REV. NO.	DATE	DESCRIPTION	BY

LAMB-STAR ENGINEERING, L.L.C.
5700 W. PLANO PARKWAY, SUITE 1000
PLANO, TEXAS 75093 (214) 440-3600
TEXAS REGISTERED ENGINEERING FIRM F-9073




SH 152
PLAN AND PROFILE


SHEET 1 OF 1

FED. RD. DIV. NO.	STATE	PROJECT NO.	HIGHWAY NO.
6	TEXAS	SEE TITLE SHEET	US 60
STATE DISTRICT	COUNTY	CONTROL NO.	SECTION NO.
AMA	GRAY	0169	07
		JOB NO.	SHEET NO.
		053, ETC	100

3/31/2021 3:56:32 PM L:\Projects\B200495.03 - Cobb, Fenley - Amarillo District - US 60CAD(Eng)\Sheets\SH152_PP_001.dgn

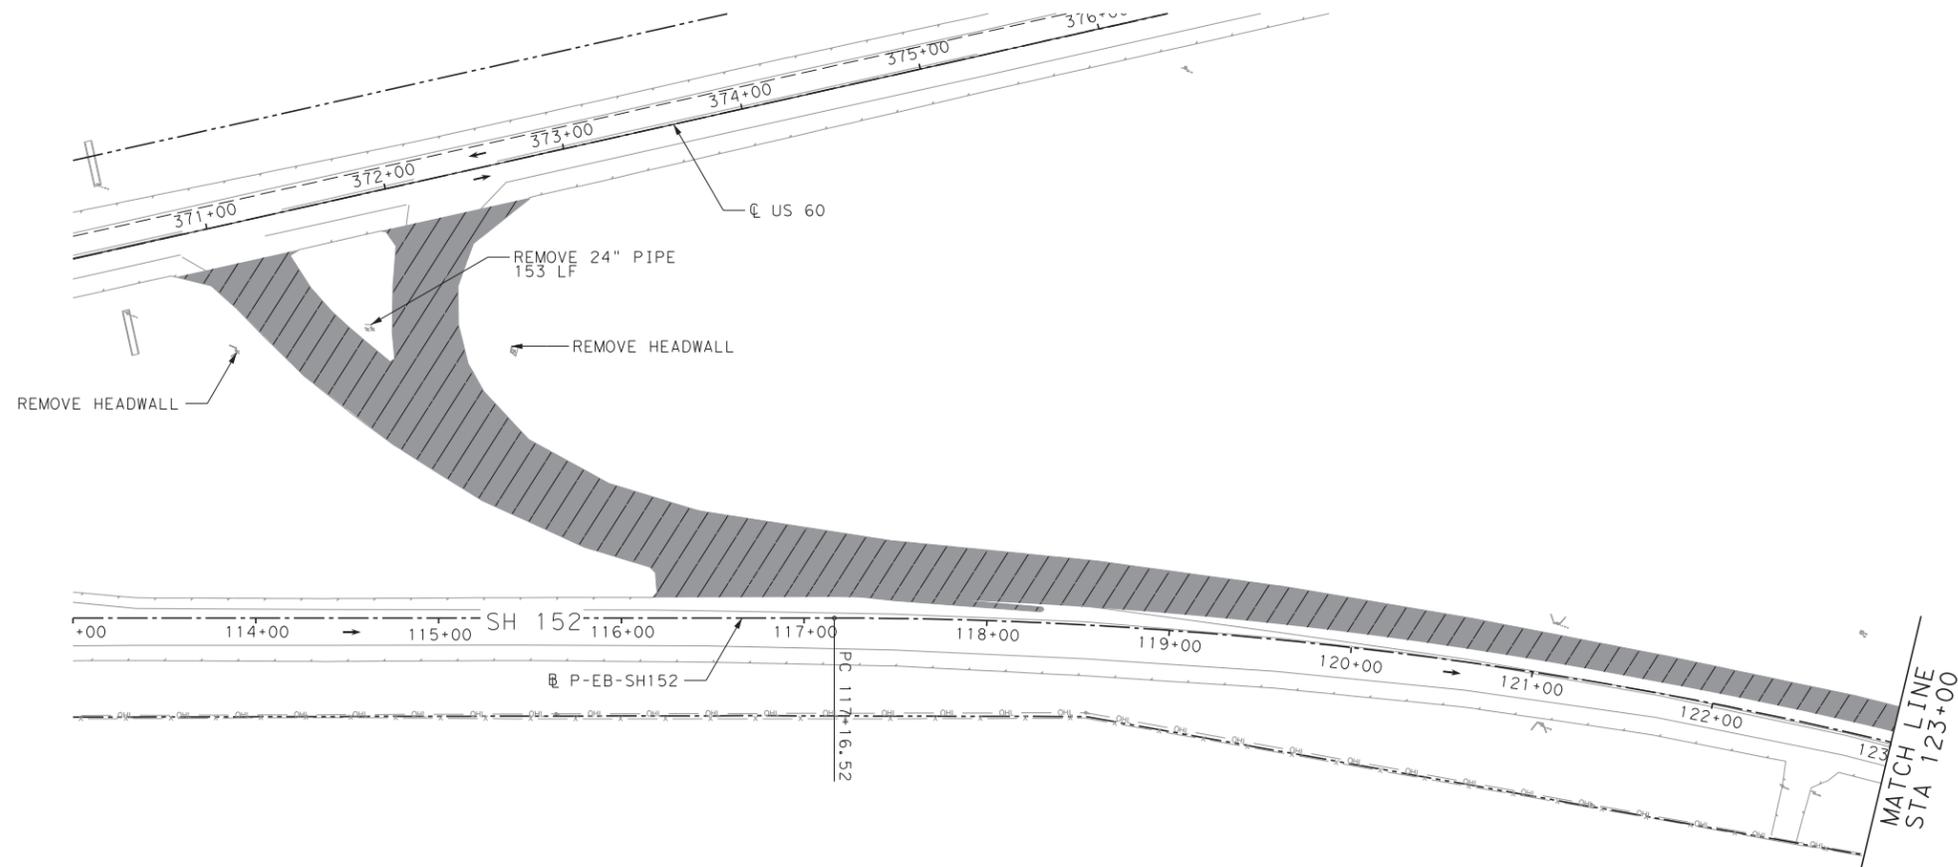

LEGEND:
 → TRAFFIC FLOW ARROW
 [Hatched Box] PAVEMENT REMOVAL

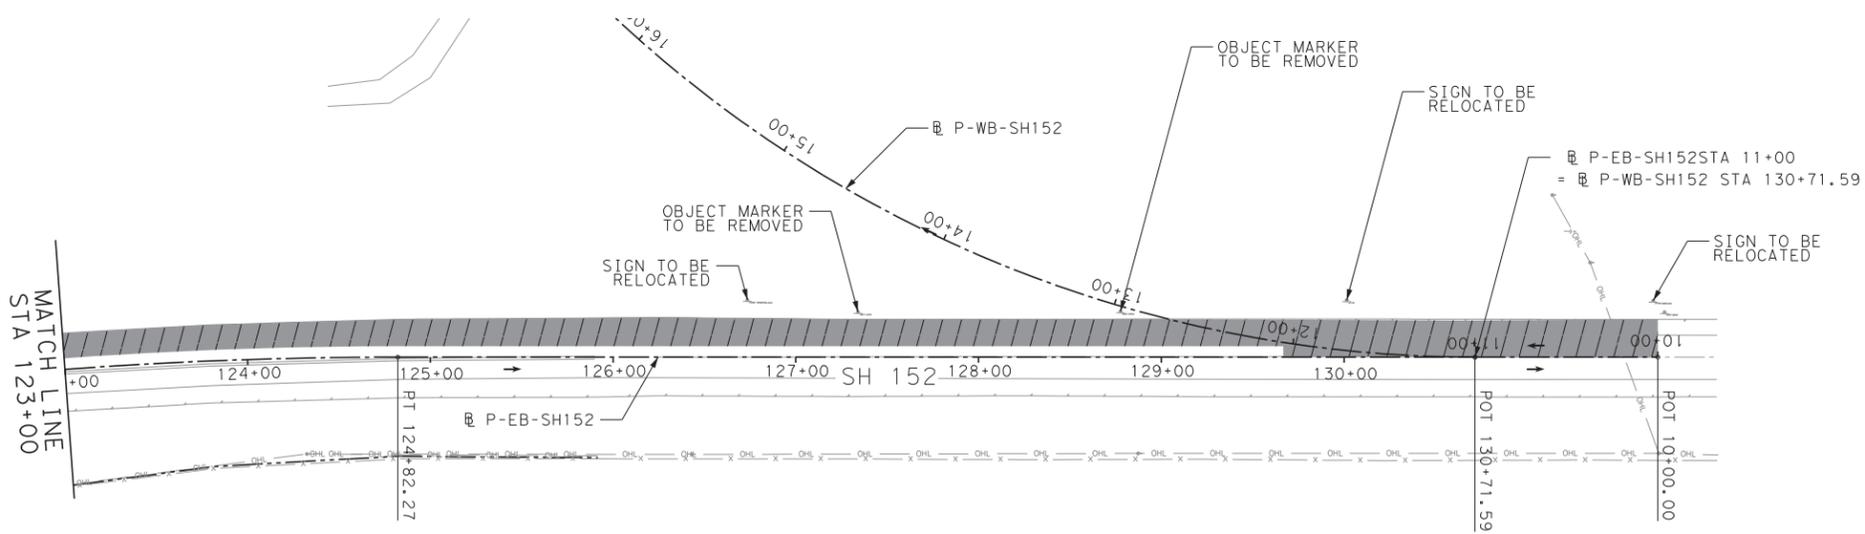

Courtney Kintner
 LICENSED PROFESSIONAL ENGINEER
 129701
 3/31/2021

REV. NO.	DATE	DESCRIPTION	BY

LAMB-STAR ENGINEERING, L.L.C.
 5700 W. PLANO PARKWAY, SUITE 1000
 PLANO, TEXAS 75093 (214) 440-3600
 TEXAS REGISTERED ENGINEERING FIRM F-9073



SH 152
 REMOVALS

SHEET 1 OF 1


FED. RD. DIV. NO.	STATE	PROJECT NO.	HIGHWAY NO.		
6	TEXAS	SEE TITLE SHEET	US 60		
STATE DISTRICT	COUNTY	CONTROL NO.	SECTION NO.	JOB NO.	SHEET NO.
AMA	GRAY	0169	07	053, ETC	101

3/31/2021
 L:\Projects\B200495_03 - Cobb, Fendley - Amarillo District - US 60\CADD\Eng\Sheets\SH152_REM_001.dgn
 3:56:38 PM

SH152_REM_001.dgn


DISCLAIMER: The use of this standard is governed by the "Texas Engineering Practice Act". No warranty of any kind is made by TxDOT for any purpose whatsoever. TxDOT assumes no responsibility for the conversion of units or for the accuracy of the drawings or for the results obtained from their use.

DATE: 4/7/2021 7:27:09 AM
 FILE: F:\Projects\2019\11004.TxDOT_5x5_PS&E_V03_US60_Amarillo\ENGR\500-USTN\511\20190407\CONCRETE RIPRAP AND SHOULDER DRAINS AT BRIDGE ENDS.dwg

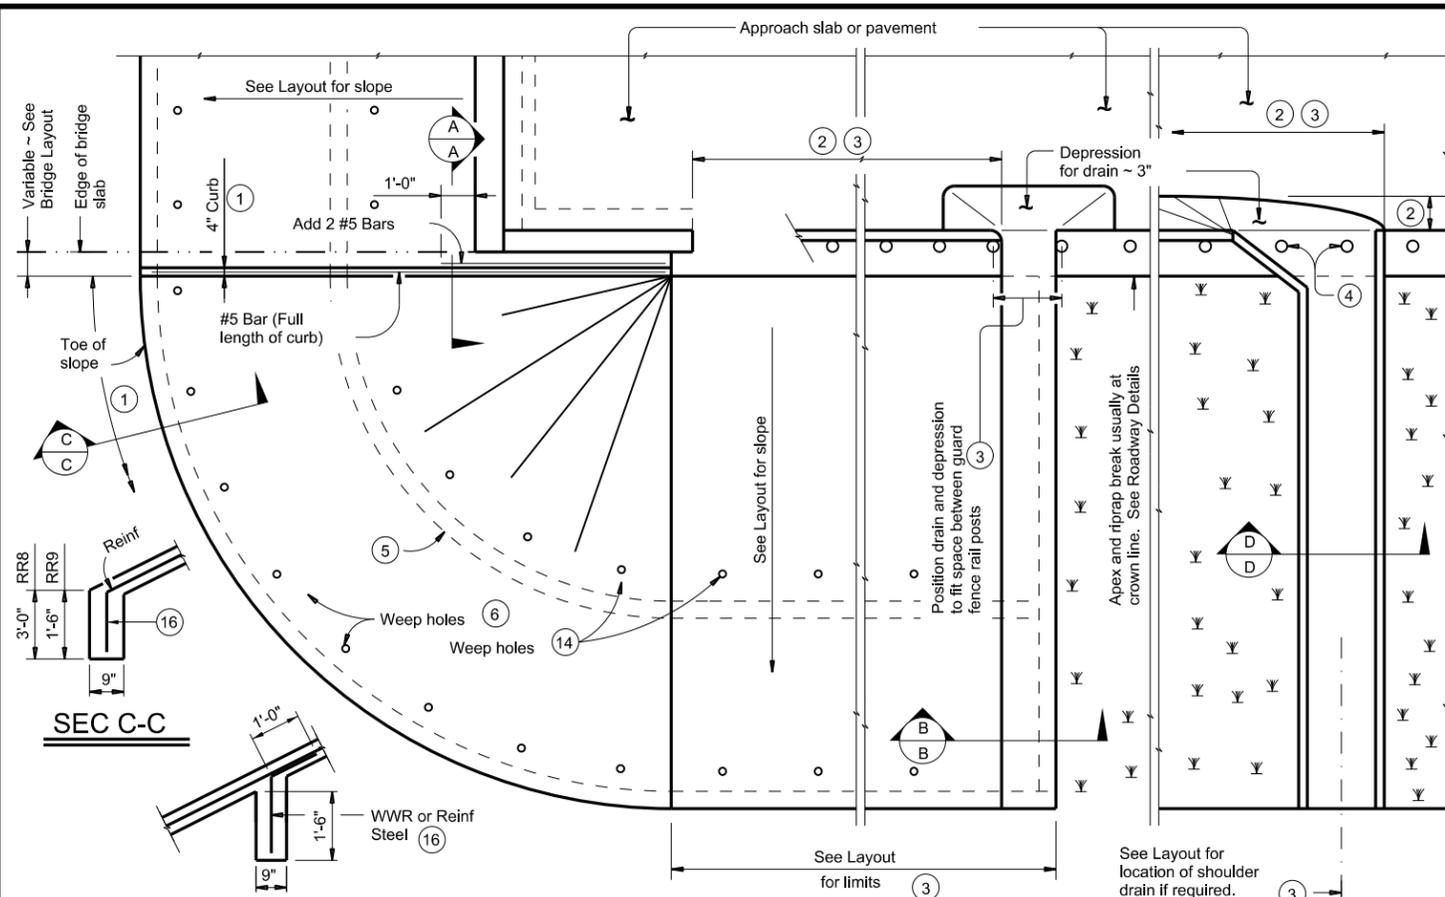


INTERMEDIATE TOEWALL (5)


PLAN (3)

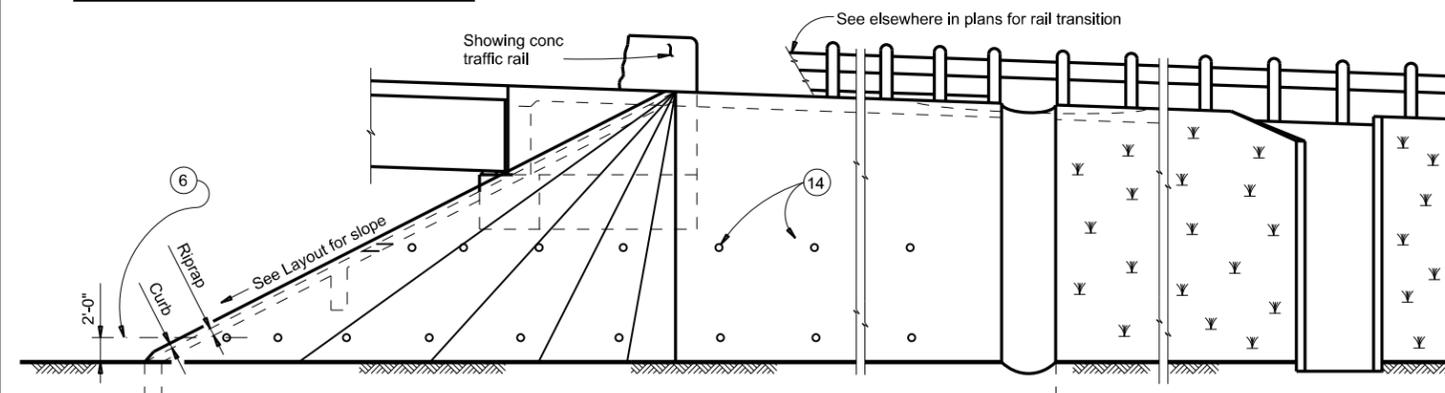


ELEVATION

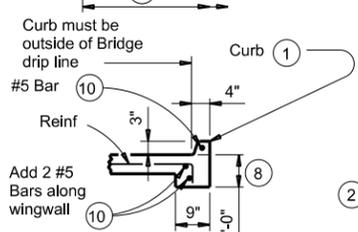


SEC A-A

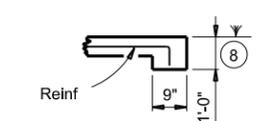


SEC B-B
(No drain)

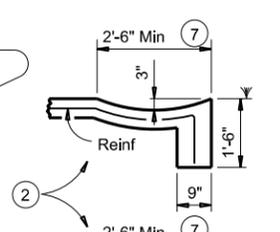

SEC B-B
(Shoulder drain integral with riprap)

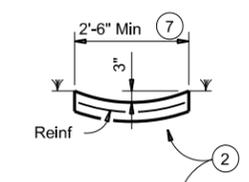


SEC D-D
(Shoulder drain)

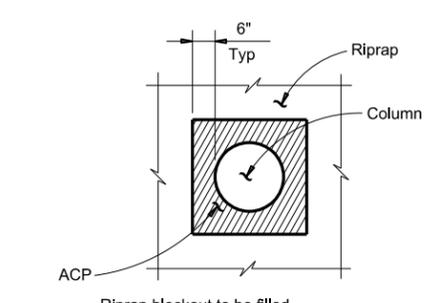


RIPRAP DETAIL AT COLUMNS
(As directed by the Engineer)


- 1 When riprap is shown extended around header on layout, extend slab and toewall as shown and eliminate 4" curb.
- 2 Limits and configuration of drains and depressions are as shown elsewhere in plans or as directed by the Engineer.
- 3 Location of shoulder drain must consider limitations imposed by rail transition. Do not locate shoulder drains at expansion joints between approach slab and concrete pavement.
- 4 See details elsewhere in plans for installation of guard fence posts through concrete riprap.
- 5 Provide intermediate toewall only when designated elsewhere in the plans or included in the specifications.
- 6 Provide lower level of 2" Dia weep holes at 10' c-c backed by 1 CF packet of gravel and galvanized hardware cloth at all locations unless directed by the Engineer to eliminate.
- 7 Use wider or other drain configurations if shown elsewhere in plans or if directed by the Engineer.
- 8 Wall extension may be reduced or modified if approved by the Engineer. Increase wall extension to 1'-6" whenever the optional intermediate toewall is called for in the plans.
- 9 Top of cap to top of riprap dimension varies as directed by the Engineer. Should be 9" Min for beam/slab type bridges and 1'-6" for slab span, box beam, or slab beam bridges.
- 10 #5 bars shown are required even when synthetic fiber reinforcing option is selected.
- 11 Provide sealing option for joint between the face of cap and riprap as designated by the Engineer or as shown elsewhere on plans.
- 12 Flashing (shown in Cap Option A) may be used at wingwall in addition to Exp Jt Mat'l if shown on plans or directed by the Engineer.
- 13 Provide #3 reinforcing bars at 18" Spa c-c. Provide Welded Wire Reinforcement (WWR) as 6x6-D2.9xD2.9 or D3xD3. Combinations of WWR and reinforcing bars may be used if both are permitted. Use lap splices of a minimum 6 inches, measured from the transverse wire of WWR, and the ends of reinforcing bars.
- 14 If granular material is specified, provide upper level of 2" Dia weep holes at 10' c-c backed by galvanized hardware cloth.
- 15 8" x 18 Gage Galv Sheet Metal
- 16 Provide WWR or #3 bars, with 1'-0" extension into slope.
- 17 WWR or reinforcing steel is continuous through riprap construction joints. Provide WWR or reinforcing steel that extends 1'-1" minimum into adjacent riprap on each side of construction joint even if synthetic reinforcing fiber is utilized.

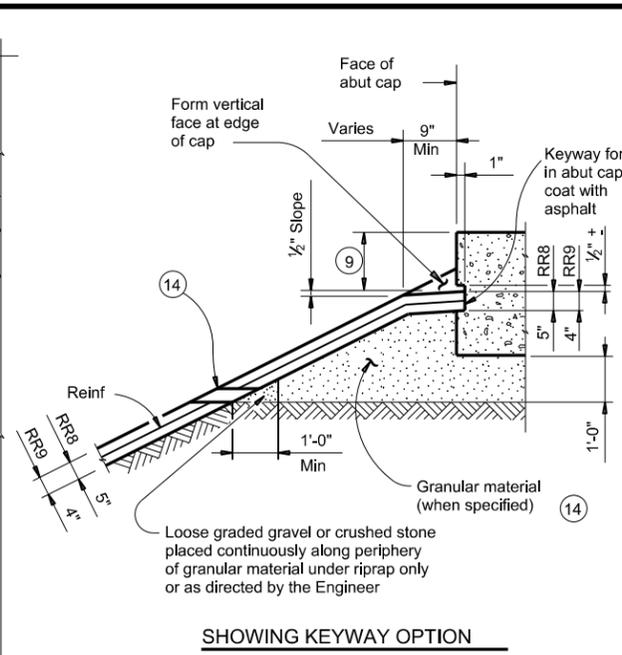

SHOWING KEYWAY OPTION

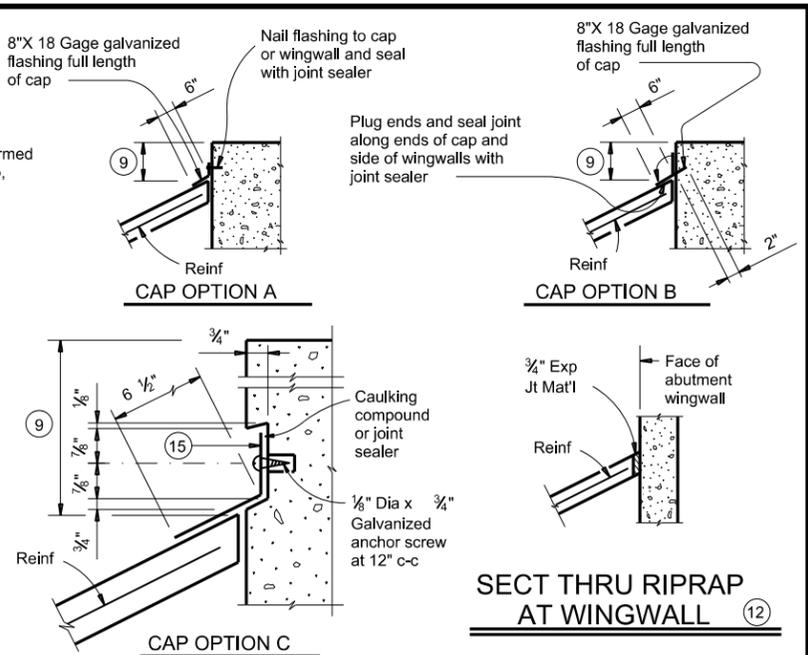

SECTIONS THRU RIPRAP AT CAP (11)

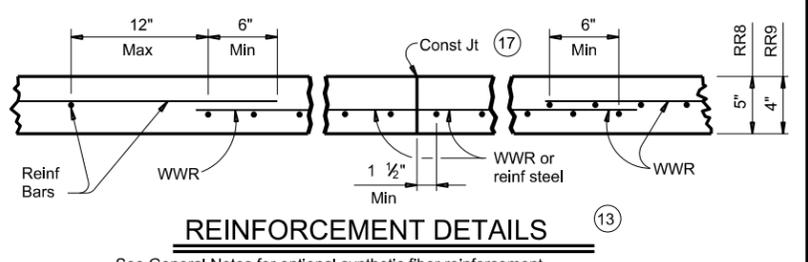

REINFORCEMENT DETAILS (13)


See General Notes for optional synthetic fiber reinforcement.

GENERAL NOTES:
 Provide Class "B" concrete (f_c = 2,000 psi) unless noted elsewhere in plans.
 Provide Grade 60 reinforcing steel.
 Provide deformed welded wire reinforcement (WWR) meeting ASTM A1064, unless otherwise shown.
 Provide reinforcing bars, deformed WWR, or any suitable combination of both types for riprap reinforcing, unless specified elsewhere in the plans.
 Optionally synthetic fibers may be used if approved by the Engineer. Provide synthetic fibers listed on the "Fibers for Concrete" Material Producer List (MPL) in lieu of steel reinforcing in riprap concrete. Install construction joints or grooved joints extending the full slant slope height at intervals of approximately 20 feet unless otherwise directed by the Engineer.
 Hardware cloth, loose grade stone behind weep holes, flashing, or other sealing material are subsidiary to the bid item "Riprap". See Layout for limits of riprap.
 RR8 is to be used on stream crossings.
 RR9 is to be used on other embankments.


FOR CONTRACTOR'S INFORMATION ONLY:
 5" of RR8 = 0.015 CY/SF
 4" of RR9 = 0.012 CY/SF
 #3 Reinf at 18" c-c = 0.501 Lbs/SF
 6x6-D3xD3 = 0.408 Lbs/SF

		Bridge Division Standard	
CONCRETE RIPRAP AND SHOULDER DRAINS EMBANKMENTS AT BRIDGE ENDS (TYPES RR8 & RR9)			
CRR			
FILE: crstdet1-19.dgn	DN: TxDOT	CK: TxDOT	DW: TxDOT
©TxDOT April 2019	CONT: 0169	SECT: 07	JOB: 053, ETC
REVISIONS	0169	07	US60
DIST: AMA	COUNTY: GRAY	SHEET NO. 103	


DISCLAIMER: THE USE OF THIS STANDARD IS COVERED BY THE "TEXAS ENGINEERING PRACTICE ACT". NO WARRANTY OF ANY KIND IS MADE BY TXDOT FOR ANY PURPOSE WHATSOEVER. TXDOT ASSUMES NO RESPONSIBILITY FOR THE CONVERSION OF THIS STANDARD TO OTHER FORMATS OR FOR INCORRECT RESULTS OR DAMAGES RESULTING FROM ITS USE.
 DATE: 4/7/2021
 FILE: F:\Projects\2019\11004.TxDOT_5x5_P&E\03_US60_Amarillo\ENG\500-USTN\511.2-Roadway\05-Standard\gf3119.dgn

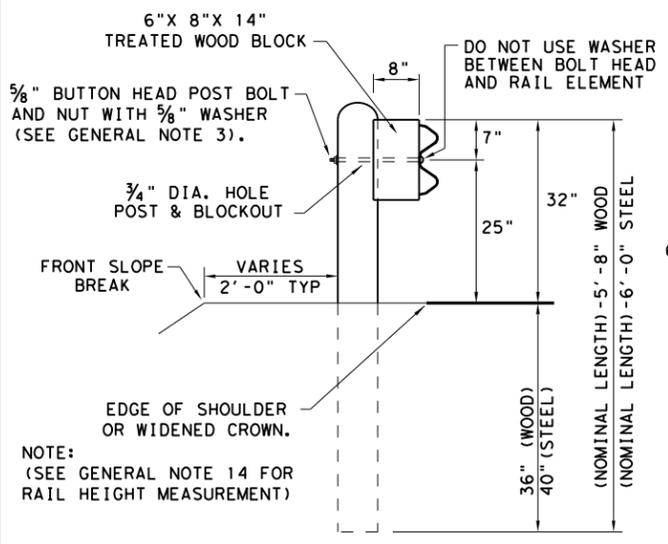


TYPICAL POST PLACEMENT

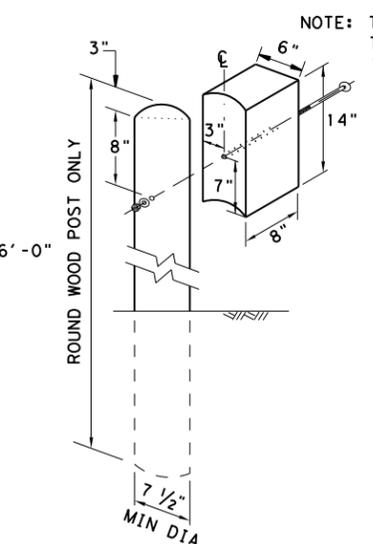

WOOD BLOCK TO ROUND WOOD POST

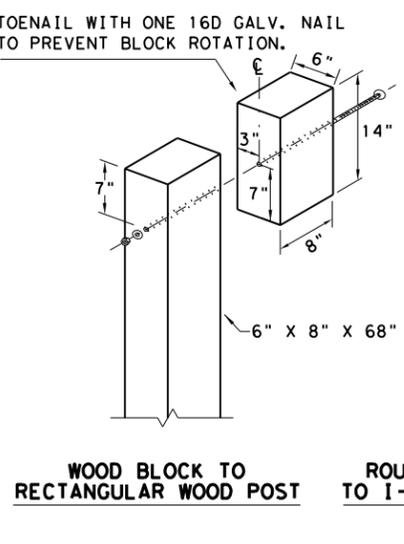


WOOD BLOCK TO RECTANGULAR WOOD POST

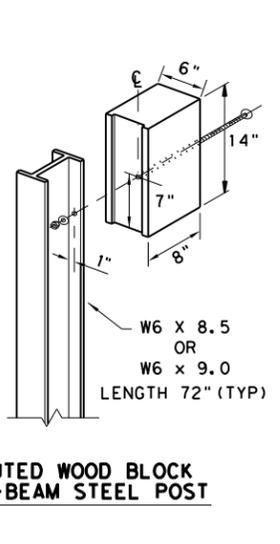

ROUTED WOOD BLOCK TO I-BEAM STEEL POST


GENERAL NOTES

1. THE TYPE OF POST (ROUND WOOD POST, RECTANGULAR WOOD POST, OR STEEL POST) WILL BE AS SHOWN IN THE PLANS. THE EXACT POSITION OF MBGF SHALL BE SHOWN IN THE PLANS OR AS DIRECTED BY THE ENGINEER. STEEL POSTS TO BE GALVANIZED IN ACCORDANCE WITH ITEM 445, "GALVANIZING."
2. RAIL ELEMENTS SHALL MEET THE REQUIREMENTS OF ITEM 540, "METAL BEAM GUARD FENCE" EXCEPT AS MODIFIED IN THE PLANS. THE CONTRACTOR MAY FURNISH RAIL ELEMENTS OF 25'-0", OR 12'-6" (NOM.) LENGTHS. RAIL ELEMENTS MAY HAVE SLOTTED HOLES AT 3'-1 1/2" C-C OR 6'-3" C-C. A SPECIAL LENGTH OF RAIL MAY BE MANUFACTURED TO ACCOMMODATE THE DOWNSTREAM ANCHOR TERMINAL (DAT) AND THE TRANSITION SECTIONS OF GUARDRAIL.
3. BUTTON HEAD "POST BOLTS & NUTS" SHALL MEET THE REQUIREMENTS OF (ASTM A307), AND SHALL BE OF SUFFICIENT LENGTH TO EXTEND THROUGH THE FULL THICKNESS OF THE NUT AND 3/8" WASHER (FWC16G) AND NOT MORE THAN 1" BEYOND IT. TRIM REMAINING BOLT LENGTH TO MEET REQUIRED LENGTH.
4. FITTINGS (BOLTS, NUTS, AND WASHERS) SHALL BE GALVANIZED IN ACCORDANCE WITH ITEM 445, "GALVANIZING." FITTINGS SHALL BE SUBSIDIARY TO THE BID ITEM.
5. CROWN SHALL BE WIDENED TO ACCOMMODATE THE METAL BEAM GUARD FENCE.
6. THE LATERAL APPROACH TO THE GUARD FENCE, SHALL HAVE A MAXIMUM SLOPE OF 1V:10H.
7. IF SHOWN ELSEWHERE IN THE PLANS OR AS DIRECTED BY THE ENGINEER, THE GUARD FENCE MAY BE FLARED AT A RATE OF 25:1 OR FLATTER.
8. UNLESS OTHERWISE SHOWN IN THE PLANS, GUARD FENCE PLACED IN THE VICINITY OF CURBS SHALL BE POSITIONED SO THAT THE FACE OF CURB IS LOCATED DIRECTLY BELOW OR BEHIND THE FACE OF THE RAIL. RAIL PLACED OVER CURBS SHALL BE INSTALLED SO THAT THE POST BOLT IS LOCATED APPROXIMATELY 25 INCHES ABOVE THE GUTTER PAN OR EDGE OF SHOULDER.
9. APPLICATIONS IN SOLID ROCK ARE ONLY ALLOWED WITH STEEL POSTS. IF SOLID ROCK IS ENCOUNTERED WITHIN 0 TO 18" OF THE FINISHED GRADE, DRILL A 24" DIA. HOLE, 24" INTO THE ROCK. IF SOLID ROCK IS ENCOUNTERED BELOW 18", DRILL A 12" DIA. HOLE, 12" INTO THE ROCK OR TO THE STANDARD EMBEDMENT DEPTH, WHICHEVER MAYBE LESS. ANY EXCESS POST LENGTH, AFTER MEETING THESE DEPTHS, MAY BE FIELD CUT TO ENSURE PROPER GUARDRAIL MOUNTING HEIGHT. BACKFILL WITH COARSE AGGREGATE MATERIAL.
10. POSTS SHALL NOT BE SET IN CONCRETE, OF ANY DEPTH.
11. SPECIAL FABRICATION WILL BE REQUIRED AT INSTALLATION LOCATIONS HAVING A CURVATURE OF LESS THAN 150 FT. RADIUS.
12. UNLESS OTHERWISE SHOWN IN THE PLANS, A COMPOSITE MATERIAL BLOCK THAT MEETS THE REQUIREMENTS OF DMS-7210, "COMPOSITE MATERIAL POSTS AND BLOCKS FOR METAL BEAM GUARD FENCE" MAY BE SUBSTITUTED FOR BLOCKS OF SIMILAR DIMENSIONS. THE CONSTRUCTION DIVISION, TXDOT MAINTAINS A MATERIAL PRODUCER LIST (MPL) FOR PRODUCERS OF MATERIALS CONFORMING TO DMS-7210 ONLY PRODUCERS ON THE MPL MAY FURNISH COMPOSITE MATERIAL BLOCKS.
13. FOR THE LOW FILL CULVERT OPTION, POSTS LOCATED PARTIALLY OR WHOLLY BETWEEN PRECAST BOX CULVERT UNITS, THE USE OF A CAST-IN-PLACE CONCRETE CLOSURE BETWEEN BOXES IS REQUIRED. THE LENGTH OF THE CAST-IN-PLACE CONCRETE CLOSURE SHALL ACCOMMODATE THE PLACEMENT OF THE LOW FILL CULVERT OPTION. SEE CONCRETE CLOSURE DETAILS ON BRIDGE STANDARD SCP-MD.
14. GUARDRAIL HEIGHT MEASUREMENT: WHEN THE GUARDRAIL IS LOCATED ABOVE PAVEMENT, MEASURE THE HEIGHT FROM THE PAVEMENT TO THE TOP OF THE W-BEAM RAIL. WHEN THE GUARDRAIL IS LOCATED UP TO 2 FT. OFF OF THE EDGE OF PAVEMENT OR FOR A PAVEMENT OVERLAY, USE A 10-FOOT STRAIGHTEDGE TO EXTEND THE PAVEMENT/SHOULDER SLOPE TO THE BACK OF RAIL, MEASURE FROM THE BOTTOM OF STRAIGHTEDGE TO THE TOP OF RAIL. FOR GUARDRAIL LOCATED DOWN A 10:1 SLOPE, MEASURE FROM THE NOMINAL TERRAIN.

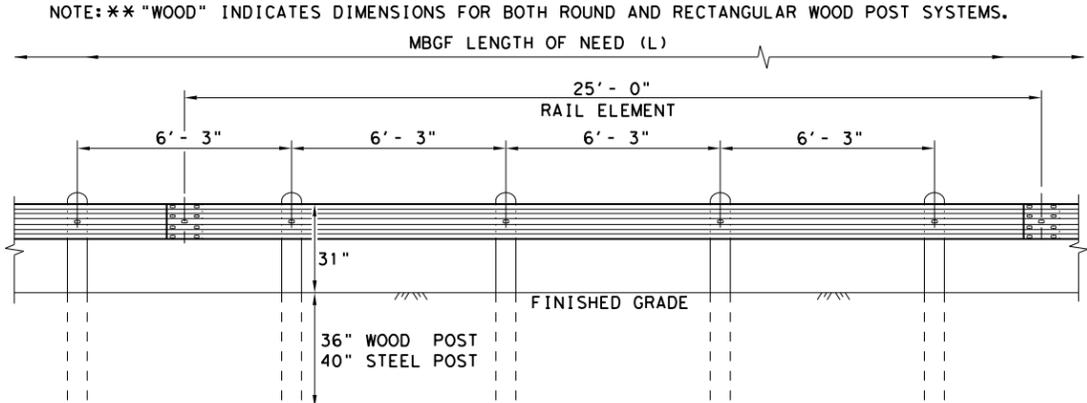


ELEVATION MID-SPAN RAIL SPLICE

SHOWING A 25'-0" SECTION OF W-BEAM RAIL. (SEE GENERAL NOTE 2)

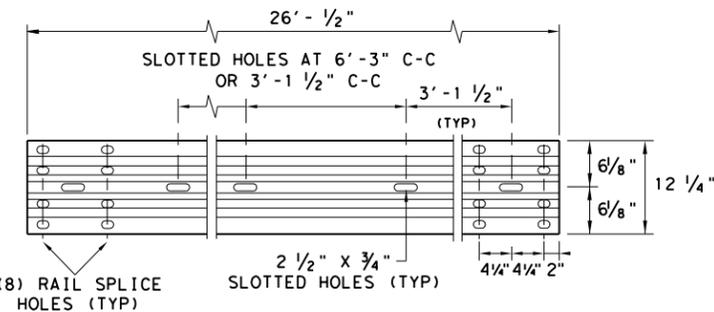


ELEVATION 25'-0" (NOM.) W-BEAM SECTION

NOTES: SEE GENERAL NOTE 2 FOR ALLOWABLE RAIL TYPES. SEE RAIL SPLICE DETAIL FOR REQUIRED HARDWARE.

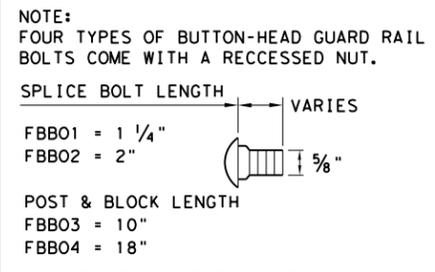

BUTTON HEAD BOLT


NOTE: SEE GENERAL NOTE 3 FOR SPLICE & POST BOLT DETAILS.

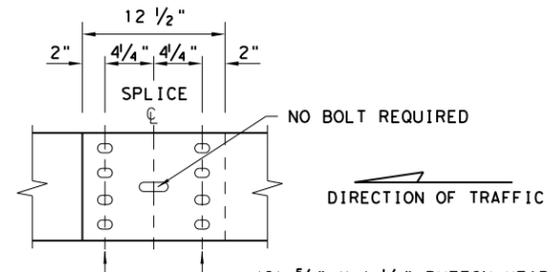

MID-SPAN RAIL SPLICE DETAIL

NOTE: GF(31), MID-SPAN RAIL SPLICES ARE REQUIRED WITH 6'-3" POST SPACINGS.

* POST(S) MAY REQUIRE FIELD MODIFICATION TO ENSURE PROPER GUARDRAIL HEIGHT.

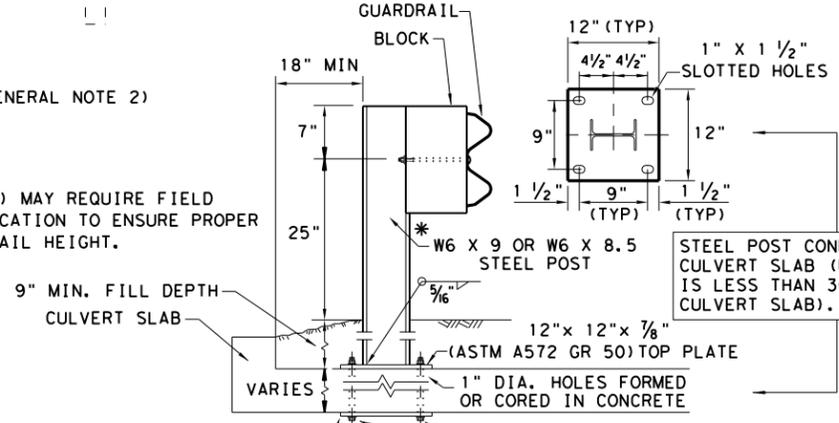

LOW FILL CULVERT POST

12" x 12" x 1/4" (ASTM A36) STEEL BOTTOM PLATE WITH 1" DIA. HOLES REQUIRED WITH BOLT-THROUGH INSTALLATION.


NOTE: TWO INSTALLATION OPTIONS.

1. **BOLT-THROUGH OPTION:** REQUIRES A 6" MIN. SLAB THICKNESS. 7/8" DIA (ASTM A449) HEAVY HEX BOLTS WITH TWO HARDENED WASHER EACH AND HEAVY HEX NUTS. NOTE: BOLT LENGTH = SLAB PLUS 2 1/4" MIN.
2. **EPOXY ANCHOR OPTION:** THIS OPTION MAY ONLY BE USED IF THE CULVERT SLAB IS 9" MIN. THICK. THREADED ANCHOR RODS MUST BE 7/8" DIA. ASTM A449 OR A193 GRADE B7 WITH HEAVY HEX NUT, AND ONE HARDENED WASHER EACH. EMBED ANCHOR RODS 6" WITH HILTI HIT RE 500 EPOXY ADHESIVE. OTHER TYPE III CLASS C EPOXY ADHESIVES MEETING THE REQUIREMENTS OF DMS-6100, "EPOXIES AND ADHESIVES", MAY BE USED IF IT CAN BE DEMONSTRATED THAT THEY MEET OR EXCEED THE STRENGTH OF HILTI HIT RE 500 WITH THE SAME EMBEDMENT DEPTH AND THREADED ROD DIA. FOLLOW THE MANUFACTURER'S REQUIREMENTS FOR INSTALLING EPOXIED THREADED RODS. EXTEND RODS 1/4" MIN. BEYOND NUT.

NOTE: CULVERTS OF 25 FT. OR LESS, SEE GF(31)LS STANDARD FOR "LONG SPAN" OPTION.


				Design Division Standard
METAL BEAM GUARD FENCE TL-3 MASH COMPLIANT GF(31)-19				
FILE: gf3119.dgn	DN: TxDOT	CK: KM	DW: VP	CK: CGL/AG
© TXDOT: NOVEMBER 2019	CONT	SECT	JOB	HIGHWAY
REVISIONS	0169	07	053, ETC	US60
	DIST	COUNTY		SHEET NO.
	AMA	GRAY		104

DISCLAIMER: THE USE OF THIS STANDARD IS COVERED BY THE "TEXAS ENGINEERING PRACTICE ACT". NO WARRANTY OF ANY KIND IS MADE BY TXDOT FOR ANY PURPOSE WHATSOEVER. TXDOT ASSUMES NO RESPONSIBILITY FOR THE CONVERSION OF THIS STANDARD TO OTHER FORMATS OR FOR INCORRECT RESULTS OR DAMAGES RESULTING FROM ITS USE.
 DATE: 4/7/2021
 FILE: F:\Projects\2019\11004.TxDOT_5x5_Ps&E\03_US60_Amarillo\ENG\500-USTN\511.2-Roadway\05-Standards\gf31ms19.dgn

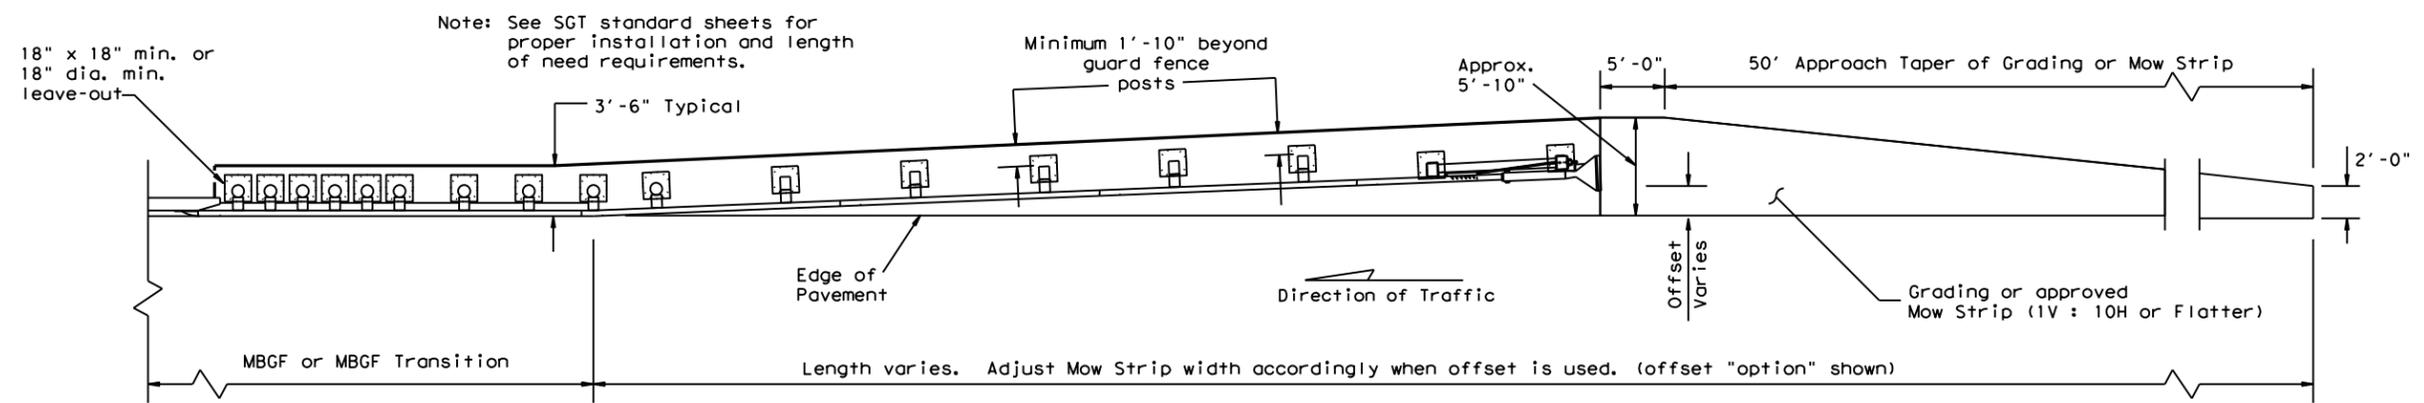


GRADING AND MOW STRIP AT GUARDRAIL END TREATMENTS

Note: Site Condition(s)
 Site conditions may exist where grading is required for the proper installation of metal guard fence and end treatments.
 Approach grading or mow strip may be decreased or eliminated, as directed by the Engineer.

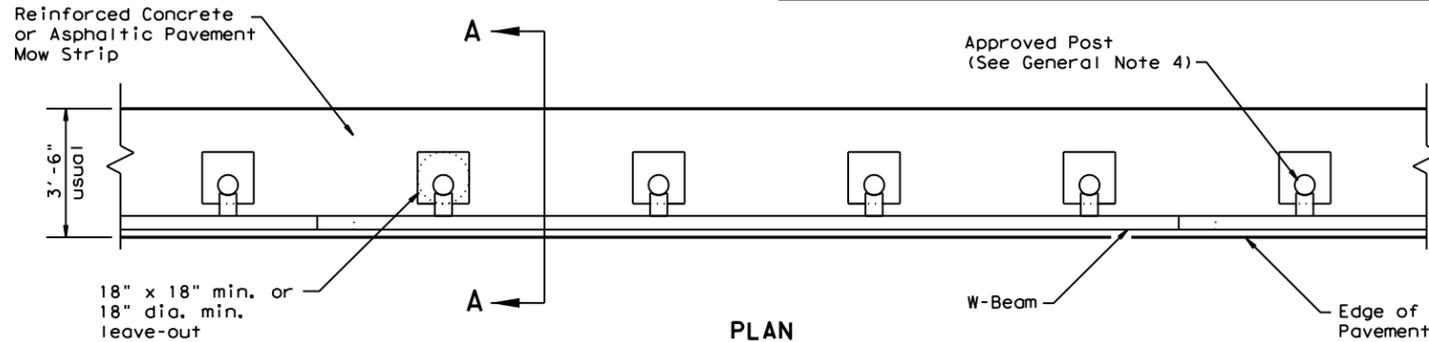


PLAN

GF(31) shown with Mow Strip
 (See GF(31) standard sheet for proper installation)

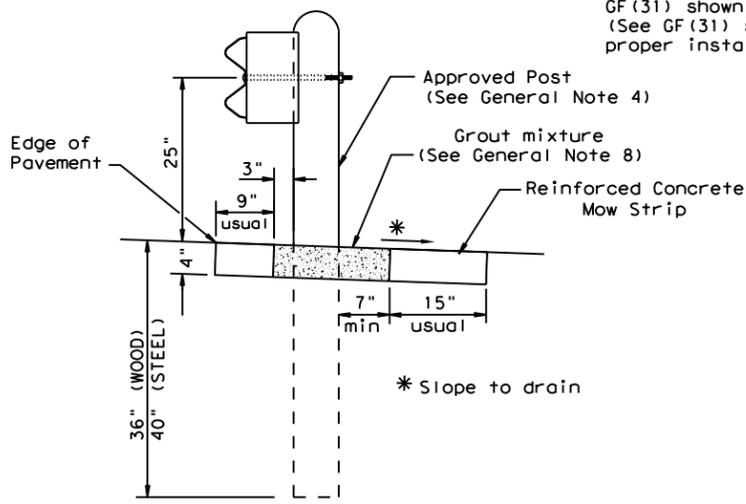

SECTION A-A


Typical

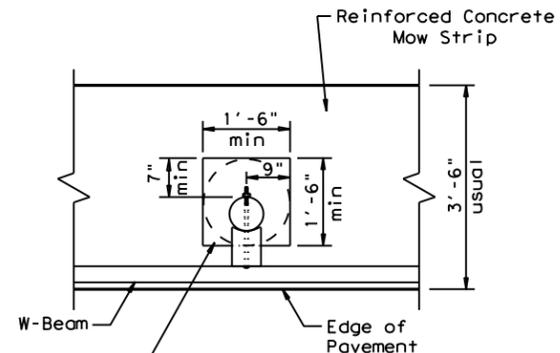

MOW STRIP DETAIL


Reinforced Concrete Mow Strip with 18" x 18" Square or 18" Dia. minimum leave-out.

- GENERAL NOTES**
1. This mow strip design is for use with metal beam guard fence, guard fence transitions, and guard fence end treatments. See applicable GF(31) MBGF or GF(31) Transition Standard sheet for additional information.
 2. Mow strips shall be reinforced concrete with (wire mesh or synthetic fiber), as shown on the plans and will be paid for under the pertinent bid item. Reinforced concrete shall be placed in accordance with Item 432, "Riprap." The use of the synthetic fiber in lieu of steel reinforcing is acceptable, provided the fiber producer is on the Department Material Producer List (MPL), maintained by TxDOT, Construction Division.
 3. The leave-out behind the post shall be a minimum of 7".
 4. Only steel (W6 x 8.5 or W6 x 9.0), or 7 1/2" Dia. round wood posts are acceptable for use in the mow strip. See GF(31) Standard for additional details.
 5. Other curb placement options may be used. Curbs are not considered part of the mow strip and will be paid for under other pertinent bid item.
 6. Thickness of the mow strip will be 4".
 7. The limits of payment for reinforced concrete will include leave-outs for the posts.
 8. The leave-outs shall be filled with a Grout mixture consisting of: 2719 pounds sand, 188 pounds Type I or II cement, and 550 pounds of water per cubic yard, with a 28-day compressive strength of approximately 230 psi or less. Provide grout with a consistency that will flow into and completely fill all voids. Due to auger size, larger leave-out dimensions are acceptable from both an impact performance and maintenance repair standpoint (Suggested Maximum leave-out of 20"). Payment for furnishing and placing the grout mixture will be subsidiary to the pay item of riprap mow strip.

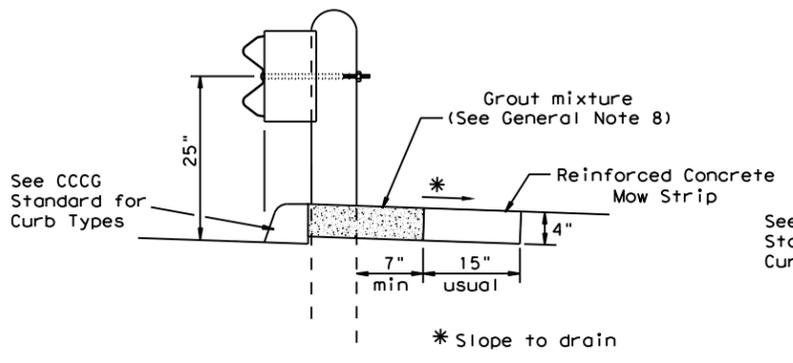


CURB OPTION (1)

This option will increase the post embedment throughout the system.

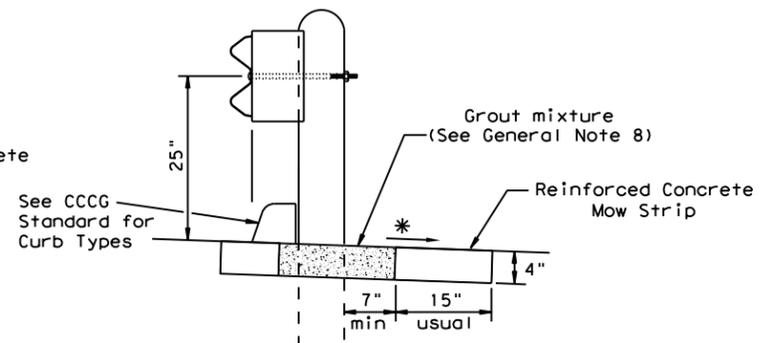

CURB OPTION (2)


Curb shown on top of mow strip

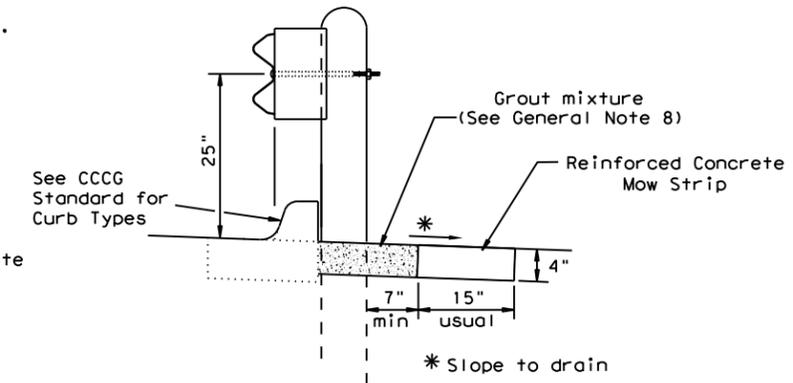

CURB OPTION (3)



		Design Division Standard	
METAL BEAM GUARD FENCE (MOW STRIP) TL-3 MASH COMPLIANT GF(31)MS-19			
FILE: gf31ms19.dgn	DN: TxDOT	CK: KM	DW: VP
© TxDOT: NOVEMBER 2019	CONT	SECT	JOB
REVISIONS	0169	07	053, ETC
	DIST	COUNTY	SHEET NO.
	AMA	GRAY	105

DISCLAIMER: THIS STANDARD IS GOVERNED BY THE "TEXAS ENGINEERING PRACTICE ACT". NO WARRANTY OF ANY KIND IS MADE BY TXDOT FOR ANY PURPOSE WHATSOEVER. TXDOT ASSUMES NO RESPONSIBILITY FOR THE CONVERSION OF THIS STANDARD TO OTHER FORMATS OR FOR INCORRECT RESULTS OR DAMAGES RESULTING FROM ITS USE.
 DATE: 4/7/2021
 FILE: F:\Projects\2019\11004.Txdot_5x5_Ps&E\03_US60_Amarillo\ENG\500-USTN\511.2-Roadway\05-Standard\sgt12s3118.dgn

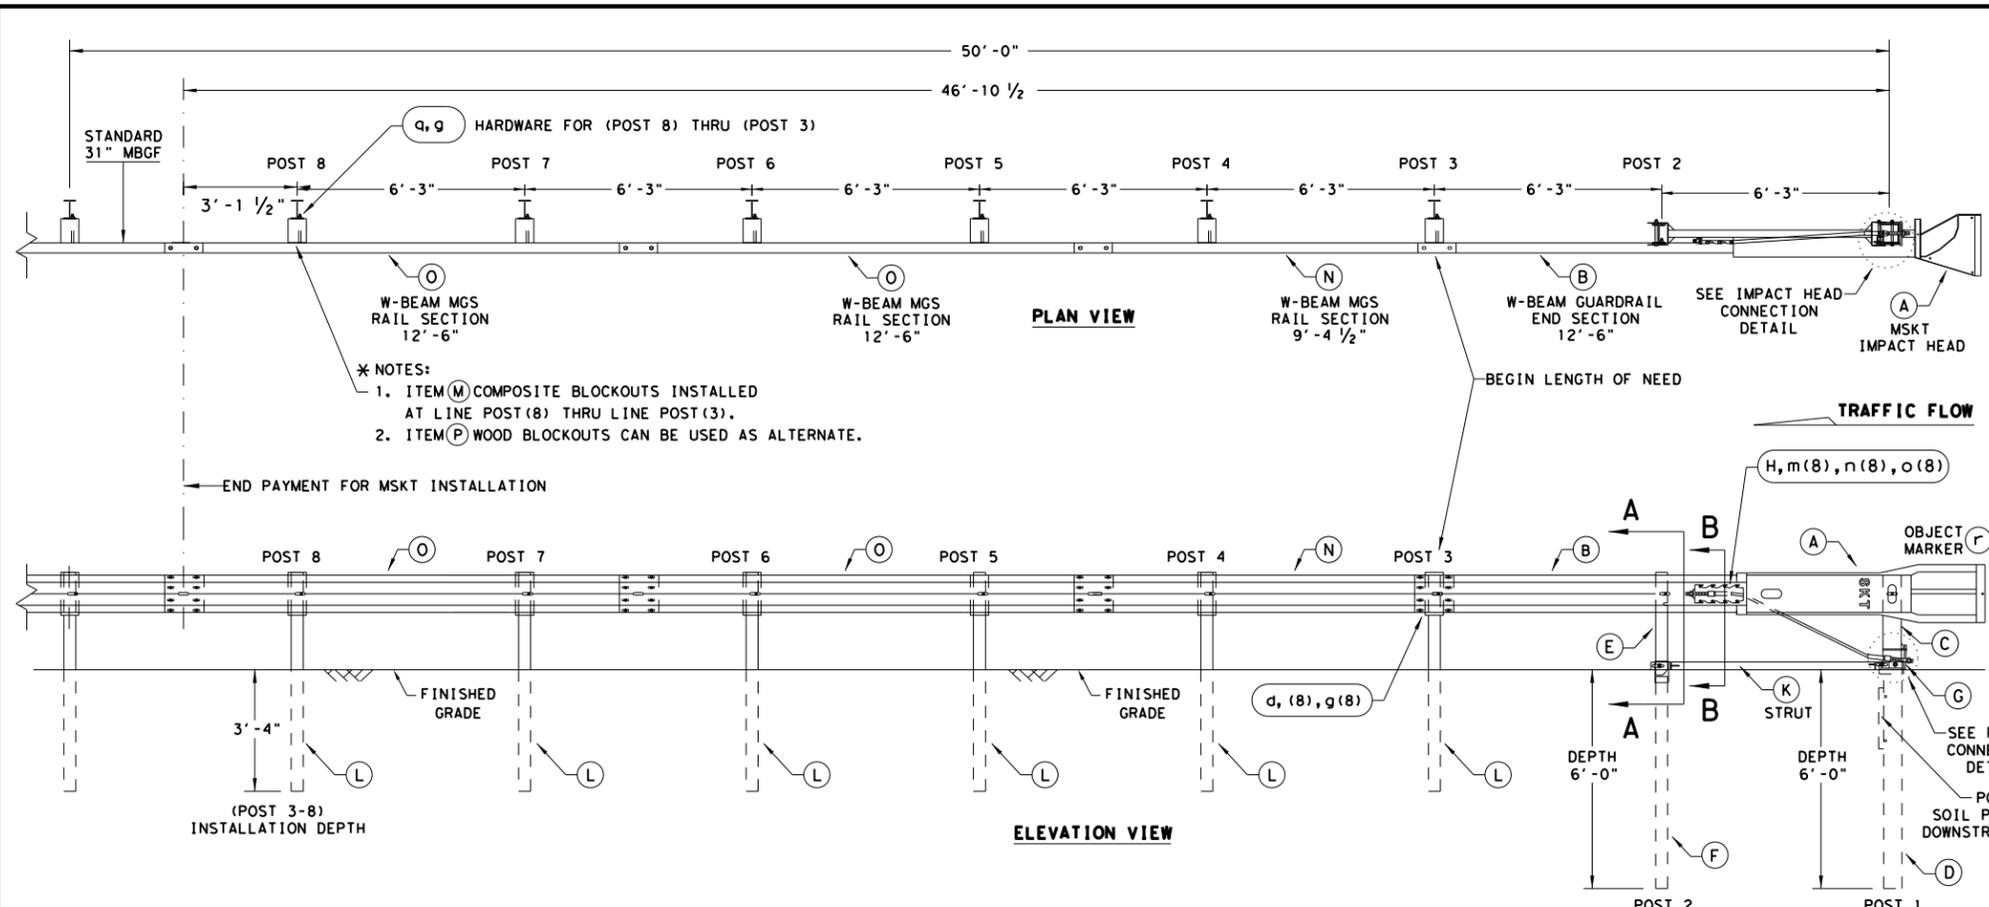



- GENERAL NOTES**
- FOR SPECIFIC INFORMATION REGARDING INSTALLATION AND TECHNICAL GUIDANCE OF THE SYSTEM, CONTACT: ROAD SYSTEMS, INC. (432)263-2435. 3616 OLD HOWARD COUNTY AIRPORT, BIG SPRING, TX 79720
 - FOR INSTALLATION, REPAIR AND MAINTENANCE REFER TO THE: MSKT END TERMINAL, PRODUCT DESCRIPTION ASSEMBLY MANUAL (PUBLICATION-062717).
 - APPLY HIGH INTENSITY REFLECTIVE SHEETING, "OBJECT MARKER" ON THE FRONT FACE OF THE DEVICE PER MANUFACTURER'S RECOMMENDATIONS. OBJECT MARKER SHALL CONFORM TO THE STANDARDS REQUIRED IN TEXAS MUTCD.
 - FOR POST (LEAVE-OUT) INSTALLATION AND GUIDANCE SEE TXDOT'S LATEST ROADWAY MOW STRIP STANDARD.
 - HARDWARE (BOLTS, NUTS, & WASHERS) SHALL BE GALVANIZED IN ACCORDANCE WITH ITEM 445, "GALVANIZING". FITTINGS SHALL BE SUBSIDIARY TO THE BID ITEM.
 - SYSTEM SHOWN USING STEEL WIDE FLANGE POSTS WITH COMPOSITE BLOCKOUTS.
 - A COMPOSITE MATERIAL BLOCKOUTS THAT MEETS THE REQUIREMENTS OF DMS-7210, MAY BE SUBSTITUTED FOR BLOCKOUTS OF SIMILAR DIMENSIONS. SEE CONSTRUCTION DIVISION MATERIAL PRODUCER LIST (MPL) FOR CERTIFIED PRODUCERS.
 - IF SOLID ROCK IS ENCOUNTERED IN THE AREA OF (POST 1) AND / OR (POST 2) CONTACT THE MANUFACTURER, & REFER TO THE LATEST ROADWAY MBSF STANDARD FOR INSTALLATION GUIDANCE.
 - POSTS SHALL NOT BE SET IN CONCRETE.
 - SYSTEM MUST BE ATTACHED TO STANDARD 31" MBSF.
 - UNDER NO CIRCUMSTANCES SHALL THE GUARDRAIL WITHIN THE MSKT SYSTEM BE CURVED.
 - A FLARE RATE OF UP TO 25:1 MAY BE USED TO PREVENT THE TERMINAL HEAD FROM ENCRoACHING ON THE SHOULDER. THE FLARE MAY BE DECREASED OR ELIMINATED FOR SPECIFIC INSTALLATIONS, IF DIRECTED BY THE ENGINEER.
 - THE SYSTEM IS SHOWN WITH TWO 12'-6" MBSF PANELS, ONE 25'-0" MBSF PANEL IS ALSO ALLOWED IN ITS PLACE.
 - A DRIVING CAP WITH A TIMBER OR PLASTIC INSERT SHALL BE USED WHEN DRIVING POSTS 3-8 TO PREVENT DAMAGE TO THE GALVANIZING ON TOP OF THE POST. SPECIAL DRIVING CAP TO BE USED ON LOWER POSTS 1 & 2 TO PREVENT DAMAGE TO THE WELDED PLATES.

ITEM	QTY	MAIN SYSTEM COMPONENTS	ITEM NUMBERS
A	1	MSKT IMPACT HEAD	MS3000
B	1	W-BEAM GUARDRAIL END SECTION, 12 Go.	SF1303
C	1	POST 1 - TOP (6" X 6" X 1/8" TUBE)	MTPHP1A
D	1	POST 1 - BOTTOM (6' W6X15)	MTPHP1B
E	1	POST 2 - ASSEMBLY TOP	UHP2A
F	1	POST 2 - ASSEMBLY BOTTOM (6' W6X9)	HP2B
G	1	BEARING PLATE	E750
H	1	CABLE ANCHOR BOX	S760
J	1	BCT CABLE ANCHOR ASSEMBLY	E770
K	1	GROUND STRUT	MS785
L	6	W6X9 OR W6X8.5 STEEL POST	P621
M	6	COMPOSITE BLOCKOUTS	CBSP-14
N	1	W-BEAM MGS RAIL SECTION (9'-4 1/2")	G12025
O	2	W-BEAM MGS RAIL SECTION (12'-6")	G1203A
P	6	WOOD BLOCKOUT 6" X 8" X 14"	P675
Q	1	W-BEAM MGS RAIL SECTION (25'-0")	G1209
SMALL HARDWARE			
o	2	5/8" x 1" HEX BOLT (GRD 5)	B5160104A
b	4	5/8" WASHER	W0516
c	2	5/8" HEX NUT	N0516
d	25	5/8" Dia. x 1 1/4" SPLICE BOLT (POST 2)	B580122
e	2	5/8" Dia. x 9" HEX BOLT (GRD A449)	B580904A
f	3	5/8" WASHER	W050
g	33	5/8" Dia. H.G.R NUT	N050
h	1	3/4" Dia. x 8 1/2" HEX BOLT (GRD A449)	B340854A
j	1	3/4" Dia. HEX NUT	N030
k	2	1 ANCHOR CABLE HEX NUT	N100
l	2	1 ANCHOR CABLE WASHER	W100
m	8	1/2" x 1 1/4" A325 BOLT WITH CAPTIVE WASHER	SB12A
n	8	1/2" STRUCTURAL NUTS	N012A
o	8	1 1/8" O.D. x 3/8" I.D. STRUCTURAL WASHERS	W012A
p	1	BEARING PLATE RETAINER TIE	CT-100ST
q	6	5/8" x 10" H.G.R. BOLT	B581002
r	1	OBJECT MARKER 18" X 18"	E3151

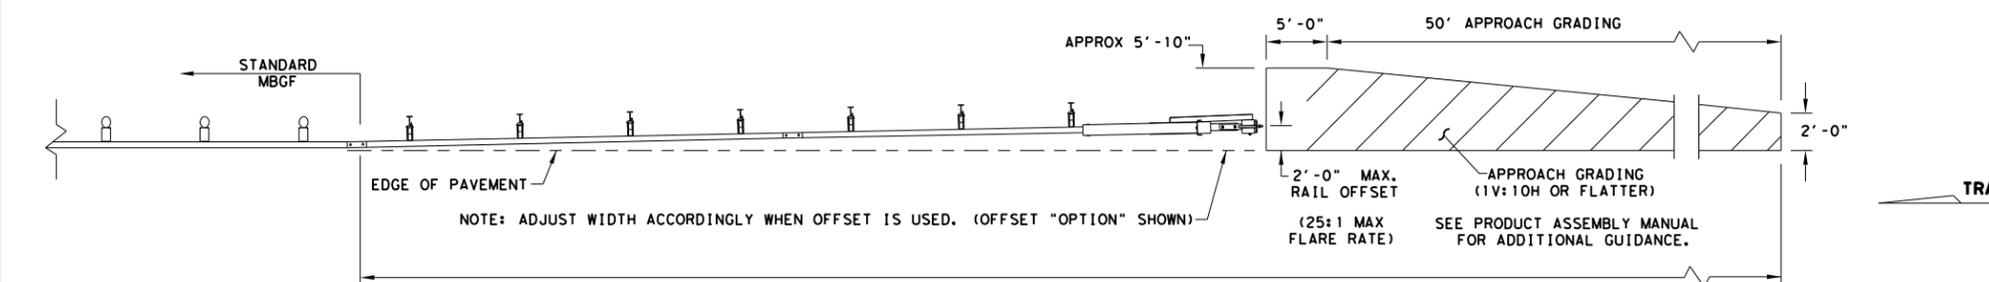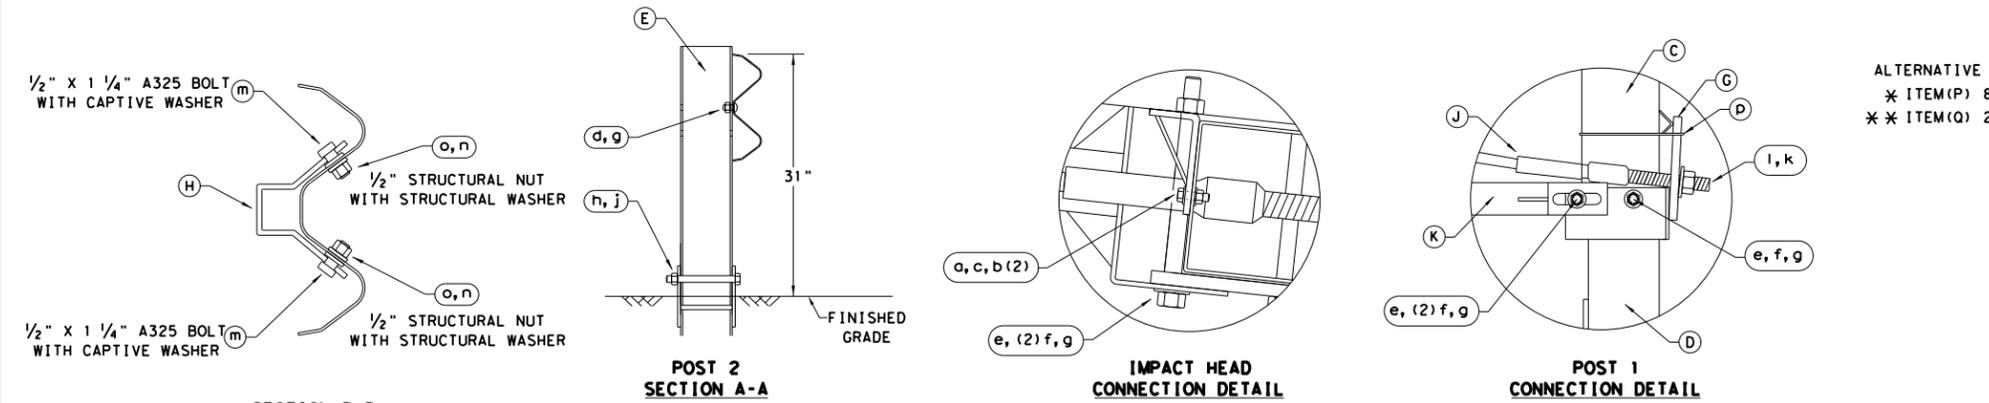

DISCLAIMER: The use of this standard is governed by the "Texas Engineering Practice Act". No warranty of any kind is made by TxDOT for any purpose whatsoever. TxDOT assumes no responsibility for the conversion of units or for the use of this standard in any way that may result in incorrect results or damages resulting from its use.

4/7/2021 7:27:12 AM
 F:\Projects\2019\11004.TxDOT_5x5_PS&E\03_US60_Amarillo\ENG\500-USTN\SPR1121\030503\030503.dwg

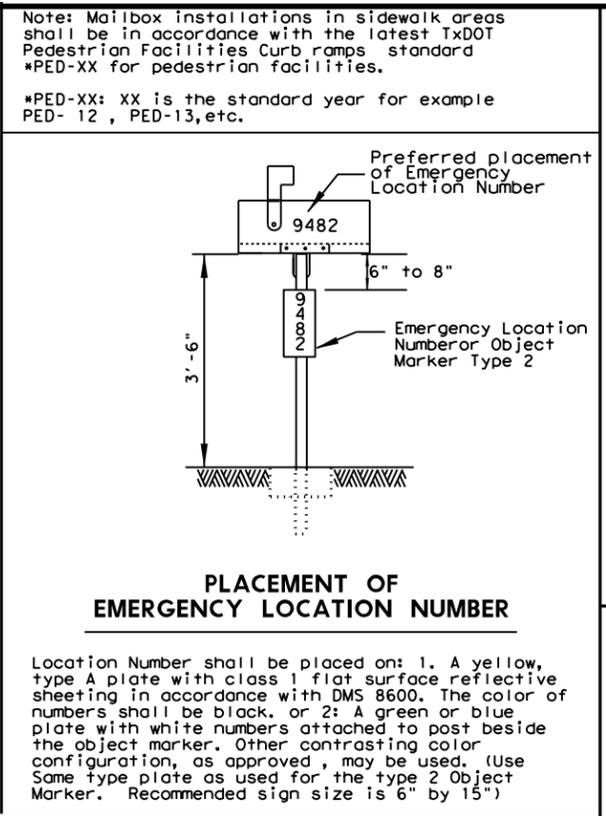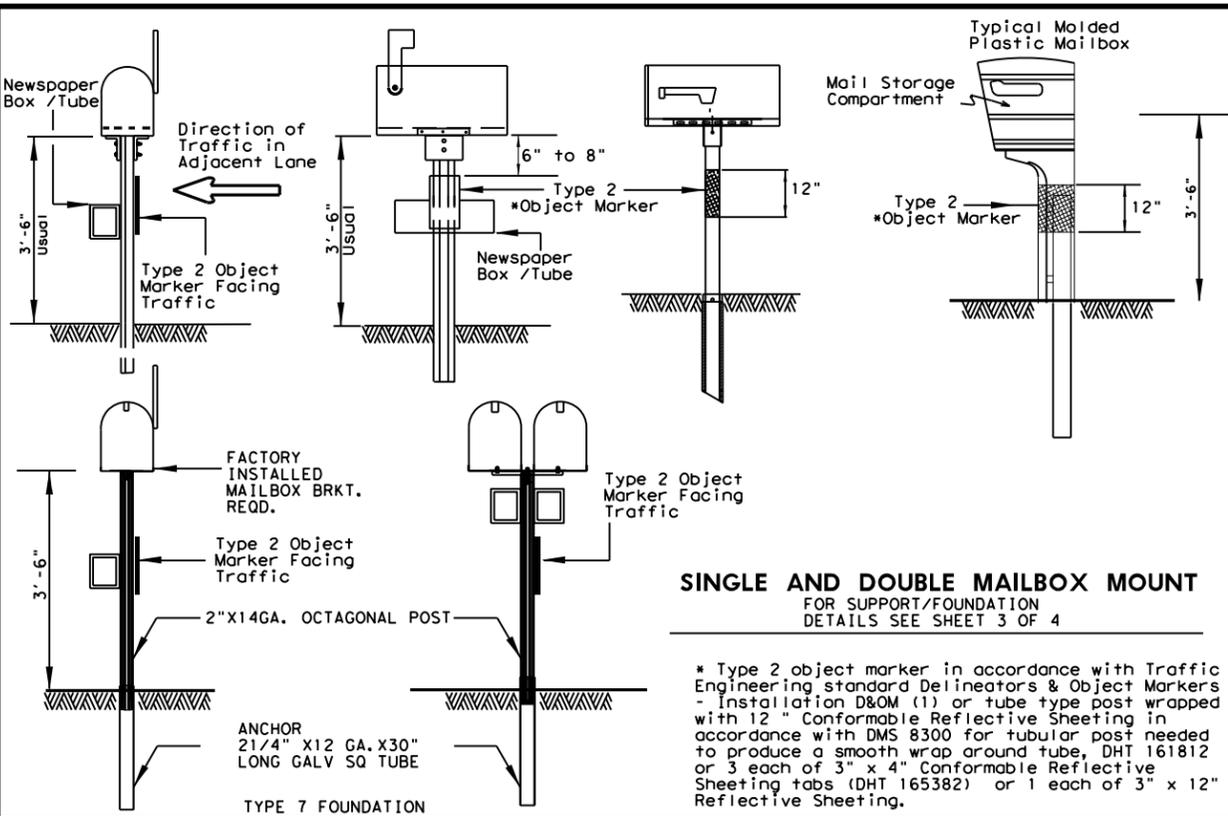

TYPICAL MAILBOX SIZE

SIZE	INCHES			POUNDS	
	LENGTH	WIDTH	HEIGHT	MAXIMUM WEIGHT	
SMALL	19 1/2	6	7	5	5
MEDIUM	22 1/2	8	11 1/2	7	7
LARGE	23 1/2*	11 1/2*	13 1/2*	10	10




* Maximum allowed dimensions for mailbox
 ** Excluding Molded Plastic on 4 X 4 Post

LOCKABLE ARCHITECTURAL MAILBOX SIZE (INCHES)

VIEW	TOP	BOTTOM	FRONT SIDE	BACK SIDE	WEIGHT (POUNDS)
SIDE	18	15	18.3	15	
BACK	11 1/2	11 1/2		15	22.4

Mailboxes shall be made of light weight sheet metal or light weight plastic. Lockable architectural mailboxes shall meet the requirements of the above table.
 Heavy steel, cast iron or decorative mailboxes shall not be used on the state highway system.

SEE TOP RIGHT CORNER OF SHEET 2 OF 4

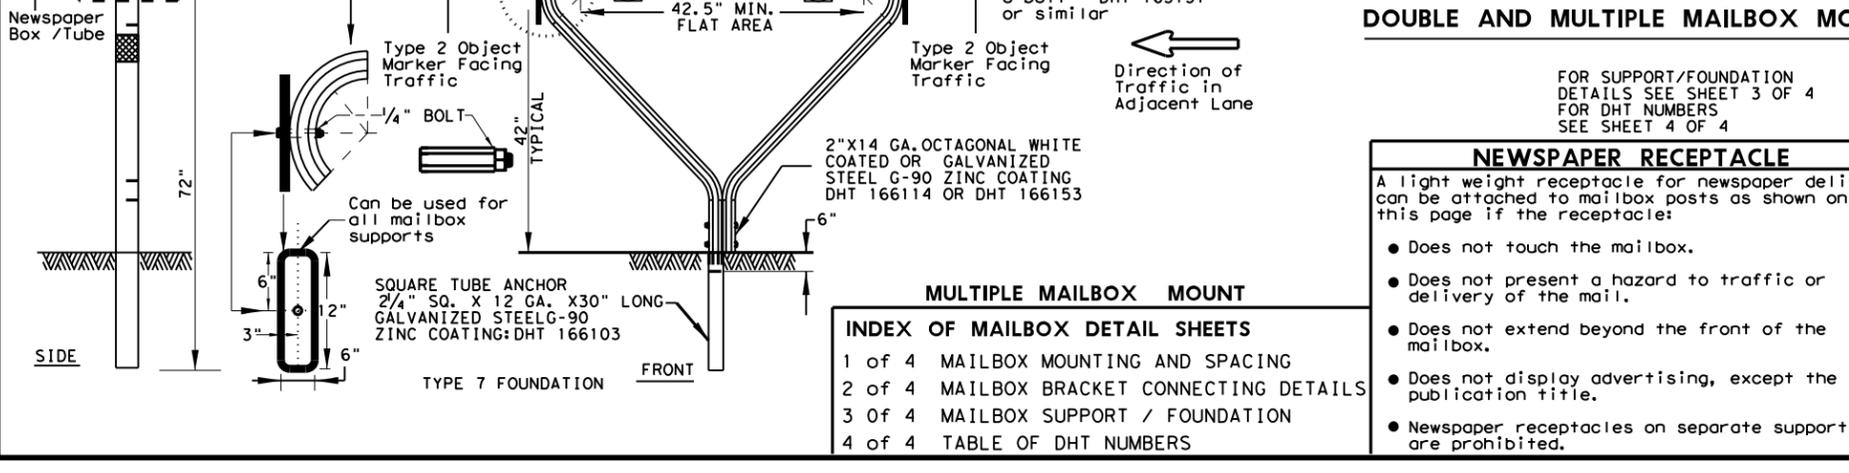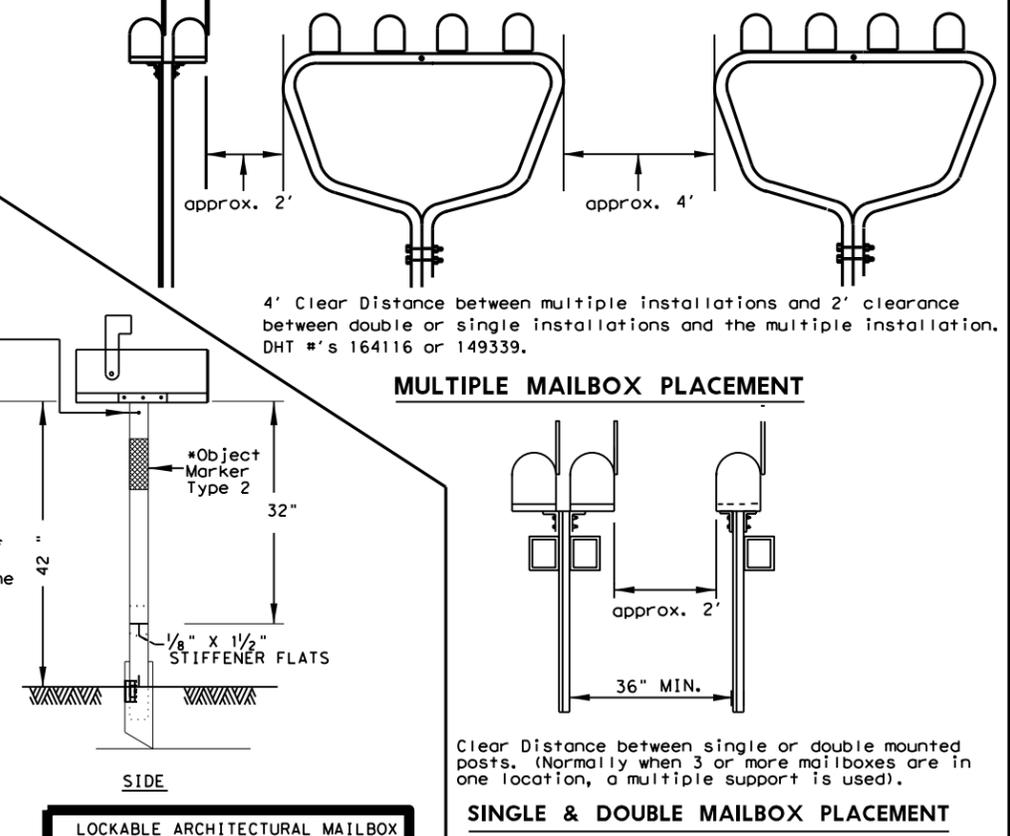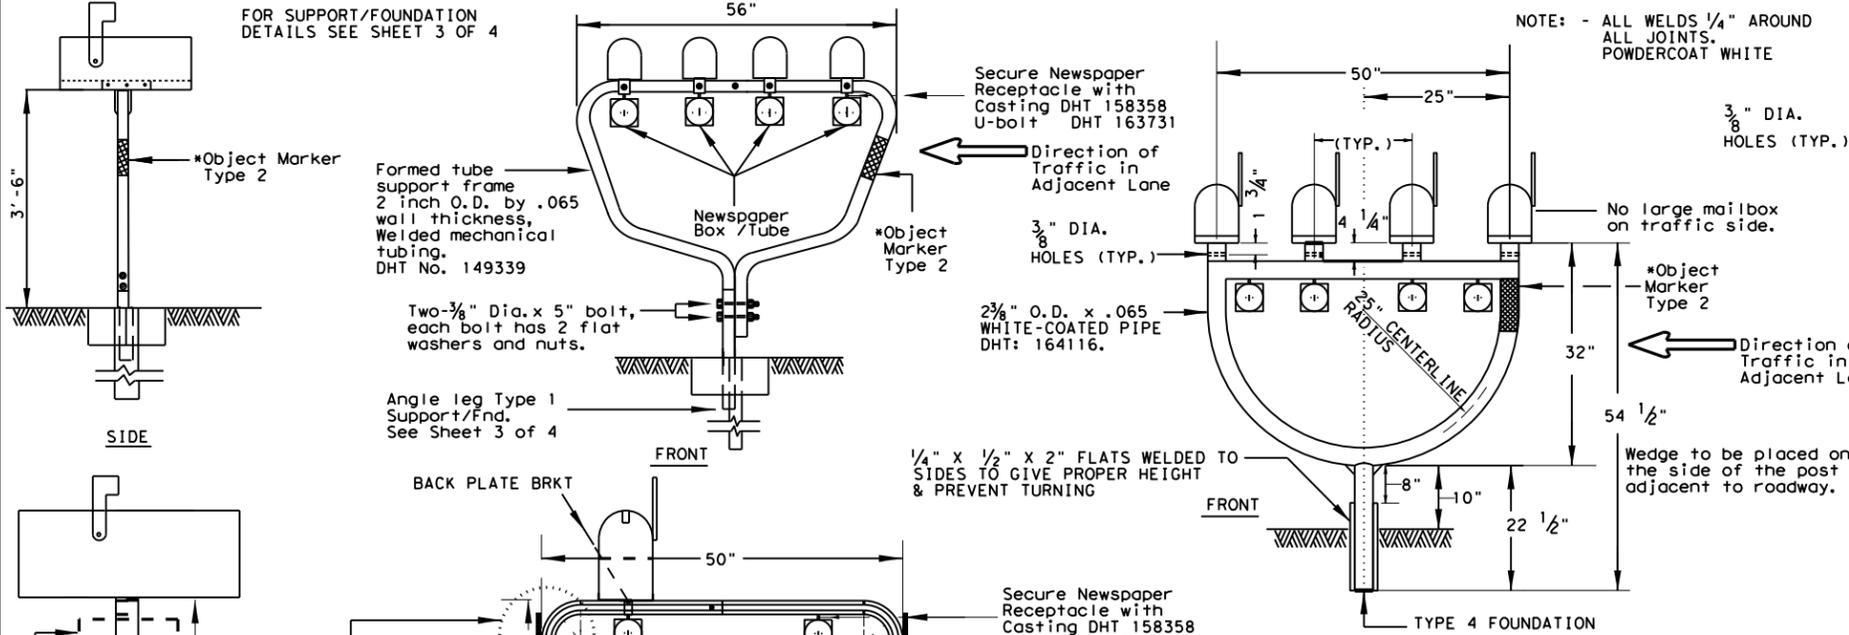

LOCKABLE ARCHITECTURAL MAILBOX

SEE SHEET 4 OF 4 FOR DETAILS

PLAN VIEW

IMPACT

ELEVATION VIEW

42"

17"

30"

12"

1

2

Type 2 Object Marker Facing Traffic

Traffic side

Ground Line

8"

17"

30"

12"

ELEVATION VIEW

SHEET 1 OF 4

Texas Department of Transportation Maintenance Division Standard

MAILBOX MOUNTING AND SPACING MB-15(1)

FILE: MB14(1).DGN	DN: JEO	CK: JEO	DW:	CK:
© TxDOT APRIL 2015	CONT	SECT	JOB	HIGHWAY
REVISIONS:	0169	07	053, ETC	US60
Added additional newspaper receptacle for double mailbox support	DIST	COUNTY	SHEET NO.	
	AMA	GRAY	108	

LOCKABLE ARCHITECTURAL MAILBOX

SINGLE-MOUNT INSTALLATION PARTS			
#	PART NAME	PART/DHT #	QTY
1	SOCKET, TYPE 4 FOUNDATION	160891	1
2	WEDGE FOR TYPE 4 FOUNDATION	160892	1
3	THIN-WALL WHITE STEEL TUBE 2.375 OD	162911	1
4	BRACKET FOR ATTACHING MAILBOX	161443	1
5	ARCHITECTURAL MAILBOX	SEE NOTE	1
6	NUT, 5/16" HEX	NUT, 5/16" HEX	1
7	BOLT, 5/16 X 3 HEX	GRADE 5	1
8	PLATE WASHER FOR ARCHITECTURAL MAILBOX	SEE SEE SHEET 2	2
9	WASHER, 3/8 FLAT		8
10	WASHER, 3/8 LOCK		4
11	NUT, 3/8 HEX		4
12	BOLT, 3/8 X 1-1/4 HEX	GRADE 5	4
13	CONCRETE, CLASS B (2000 PSI)		1

LOCKABLE ARCHITECTURAL MAILBOX DETAILS

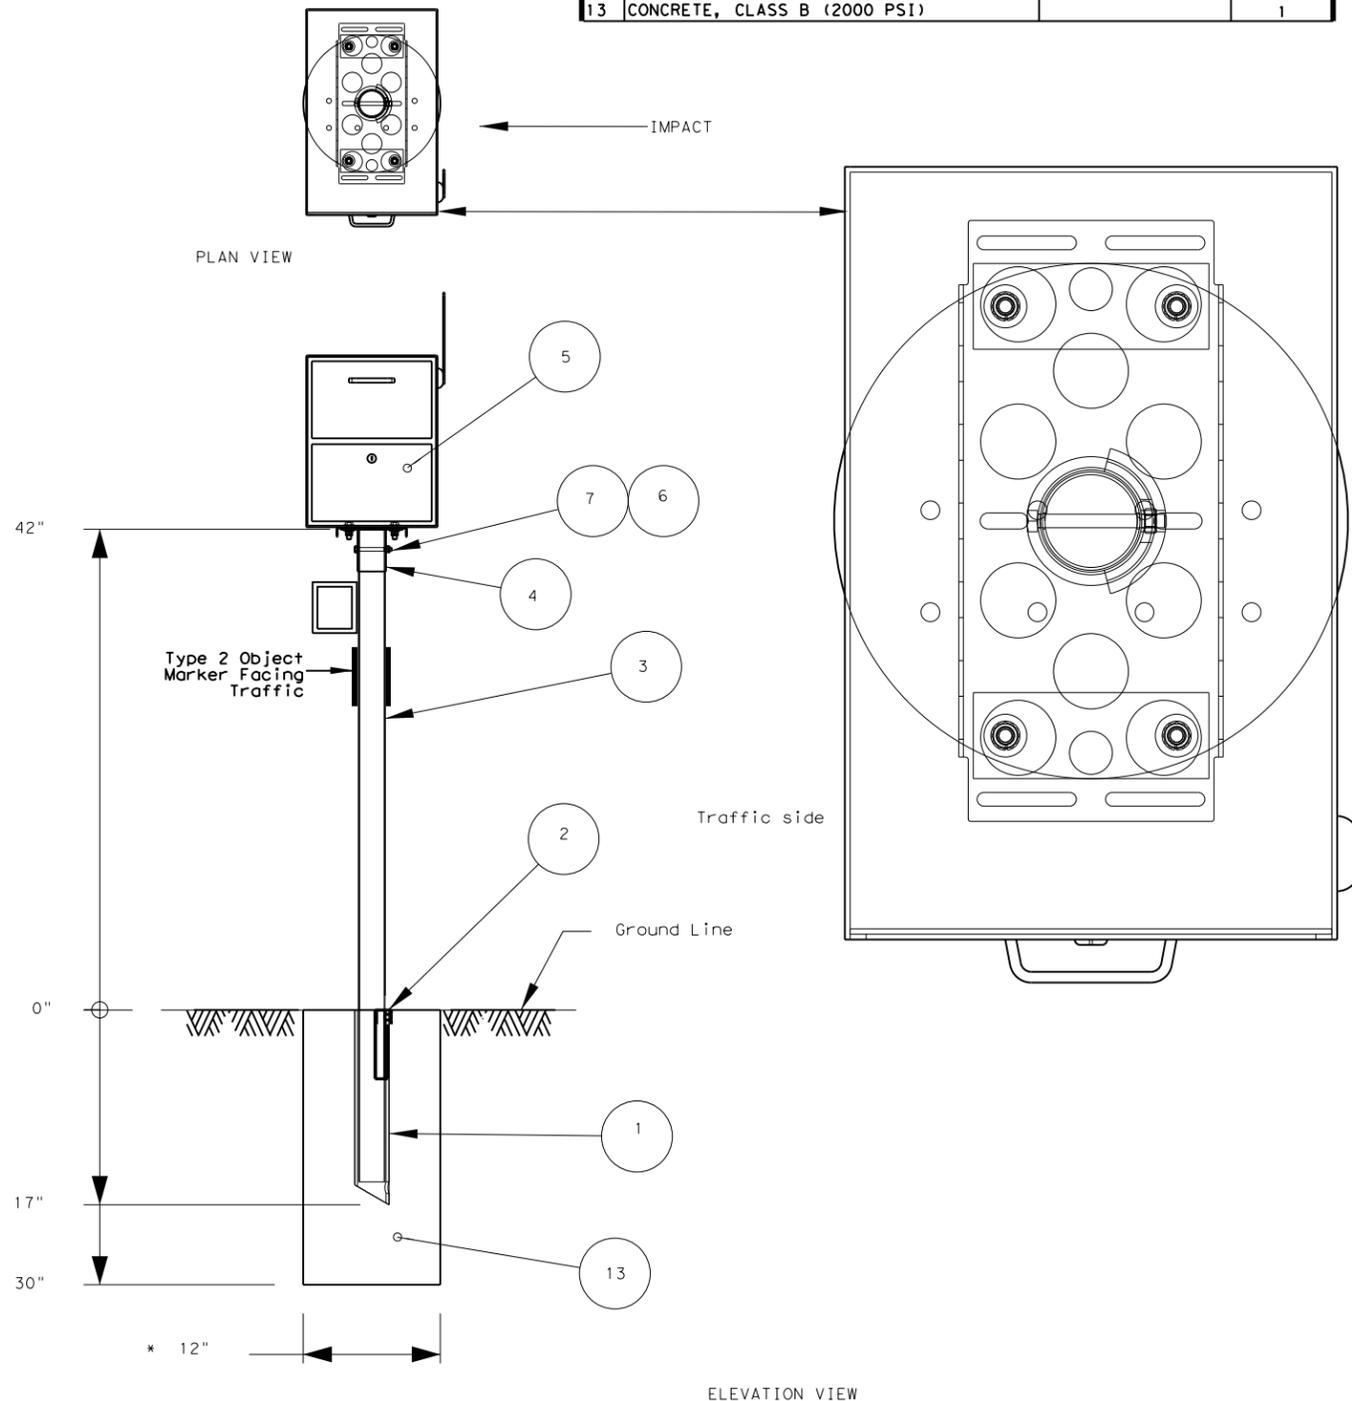


TABLE OF APPLICABLE DHT NUMBERS	
DHT NUMBER	DESCRIPTION
FOUNDATIONS	
46625	WEDGE FOR V-WING SOCKET FOR TYPE 1 FOUNDATION
149340	V-WING SOCKET FOR TYPE 1 FOUNDATION
143433	WEDGE FOR TYPE 2 FOUNDATION
143434	ANCHOR FOR TYPE 2 FOUNDATION
166103	ANCHOR FOR TYPE 7 FOUNDATION
160891	SOCKET FOR TYPE 4 FOUNDATION
160892	WEDGE FOR TYPE 4 FOUNDATION
166104	WEDGE FOR TYPE 7 FOUNDATION
POSTS	
4289	WINGED CHANNEL MAILBOX POST
149339	MULTIPLE MAILBOX POST (GALVANIZED TUBING)
164116	MULTIPLE MAILBOX POST (WHITE COATED)
166114	MULTIPLE MAILBOX POST (WHITE COATED OCTAGONAL)
166153	MULTIPLE MAILBOX POST (GALVANIZED OCTAGONAL)
161442	RECYCLED RUBBER POST. FOR SMALL MAILBOX ONLY
143426	THIN-WALL GALVANIZED STEEL TUBE 2.375" OUTER DIAMETER
162911	THINWALL WHITE STEEL TUBE 2.375" OUTER DIAMETER
	SINGLE OR DOUBLE THIN-WALL MAILBOX POST GALVANIZED
166152	2" OCTAGONAL
	SINGLE OR DOUBLE THIN-WALL MAILBOX POST WHITECOATED
166112	2" OCTAGONAL
REFLECTIVE SHEETING	
161812	REFLECTIVE SHEETING FOR EMERGENCY LOCATION NUMBER PANEL
CONNECTING HARDWARE	
2917	ANGLE BRACKET USED FOR TEMPORARY MAILBOX SUPPORT
166105	BRACKET FOR SINGLE MOUNTING OF MAILBOXES (MOUNTING KIT)
3789	PLATE FOR DOUBLE MOUNTING OF MAILBOXES
166108	BRACKET FOR DOUBLE MOUNTING OF MAILBOXES (MOUNTING KIT)
166111	BRACKET FOR MULTIPLE MOUNTING OF MAILBOXES (MOUNTING KIT)
148939	BRACKET FOR ATTACHING SMALL OR MEDIUM SIZE MAIL BOX
148938	EXTENDER TO BRACKET FOR ATTACHING LARGE MAILBOX
159489	ANGLE BRACKET PART A
159490	ANGLE BRACKET PART B
	BRACKET FOR DOUBLE MOUNTING OF MAILBOXES ON THINWALL
162323	STEEL POST, GALVANIZED OR POWDERCOATED.
	BRACKET FOR ATTACHING MAILBOX TO RECYCLED RUBBER POST
161443	AND TO MULTIPLE WHITE MAILBOX POST
158358	CASTING (NEWSPAPER RECEPTACLE BRACKET)
163731	U-BOLT (NEWSPAPER RECEPTACLE BRACKET)
160698	BOLT;HEX HEAD, GALV;3/8"DIA X 3/4"L HD, W/2-FLAT WASHERS
163750	BOLT;HEX HEAD, GALV;3/8" X 1-1/2, 16 NC, W/WASHERS
160701	BOLT;HEX HEAD, GALV;3/8"DIA X 2-1/2"L, HD, W/2-FLAT WASHERS
163730	BOLT;HEX HEAD, GALV;3/8" X 3-1/2", NC, W/NUT, 2 FLAT WASHERS
160699	BOLT;HEX HEAD, GALV;3/8"DIA X 3-3/4"L HD, W/2-FLAT WASHERS
160700	BOLT;HEX HEAD, GALV;3/8"DIA X 4"L HD, W/2-FLAT WASHERS

DISCLAIMER: The use of this standard is governed by the "Texas Engineering Practice Act". No warranty of any kind is made by TxDOT for any purpose whatsoever. TxDOT assumes no responsibility for the conversion of units or for the accuracy of the information contained herein. TxDOT is not responsible for incorrect results or damages resulting from its use.

4/7/2021 7:27:18 AM
 F:\Projects\2019\11004.TxDOT_5x5_P&E\03_US60_Amarillo\ENG\500-USTN\501\12\LockableArchMailBox.dwg




DHT NUMBERS TABLE
MB-15(1)


FILE:MB14(1).DGN	DN:	CK:	DW:	CK:
© TxDOT APRIL 2015	CONT	SECT	JOB	HIGHWAY
REVISIONS	0169	07	053, ETC	US60
	DIST	COUNTY	SHEET NO.	
	AMA	GRAY	111	

DISCLAIMER: The use of this standard is governed by the "Texas Engineering Practice Act". No warranty of any kind is made by TxDOT for any purpose whatsoever. TxDOT assumes no responsibility for the conversion of units or for the accuracy of the information provided. TxDOT is not responsible for any errors or omissions or for any consequences arising from the use of this standard.


DATE: 4/7/2021 7:27:18 AM
 FILE: F:\Projects\2019\11004_TxDOT_5x5_PS&E\03_US60_Amarillo\ENG\500-USTN\SP112\03\MB14(2).dgn

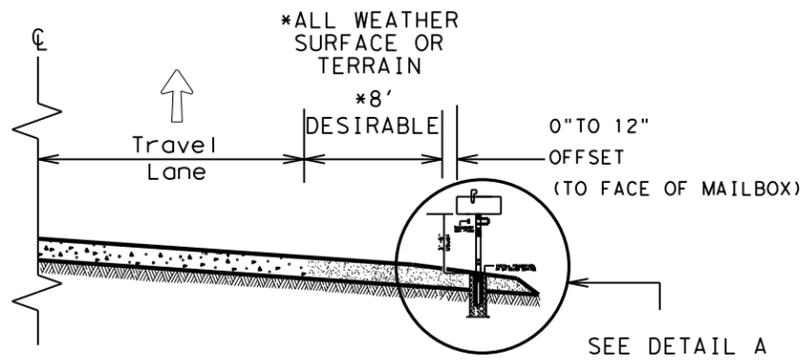


CASE 1. OFF TRAVEL WAY DELIVERY

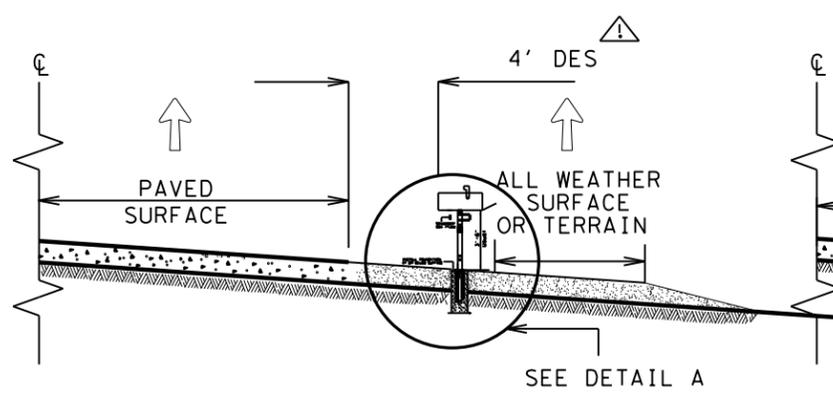

CASE 2. BACK SIDE DELIVERY

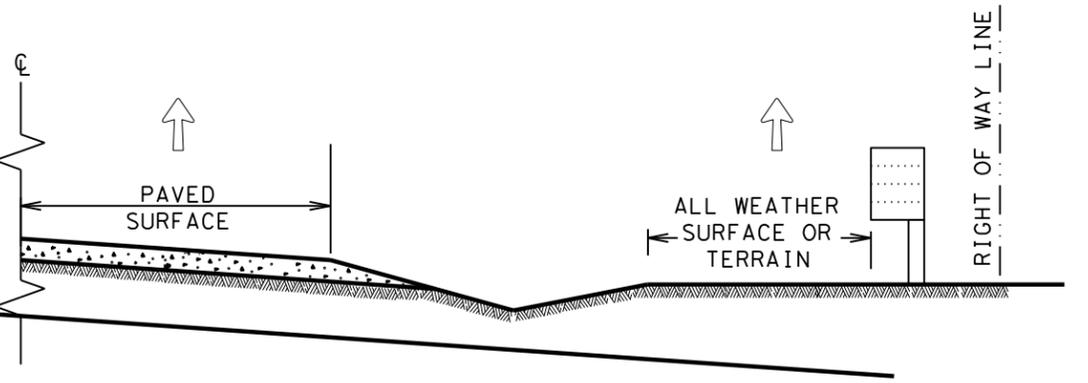


CASE 3. DELIVERY NEAR RIGHT OF WAY LINE

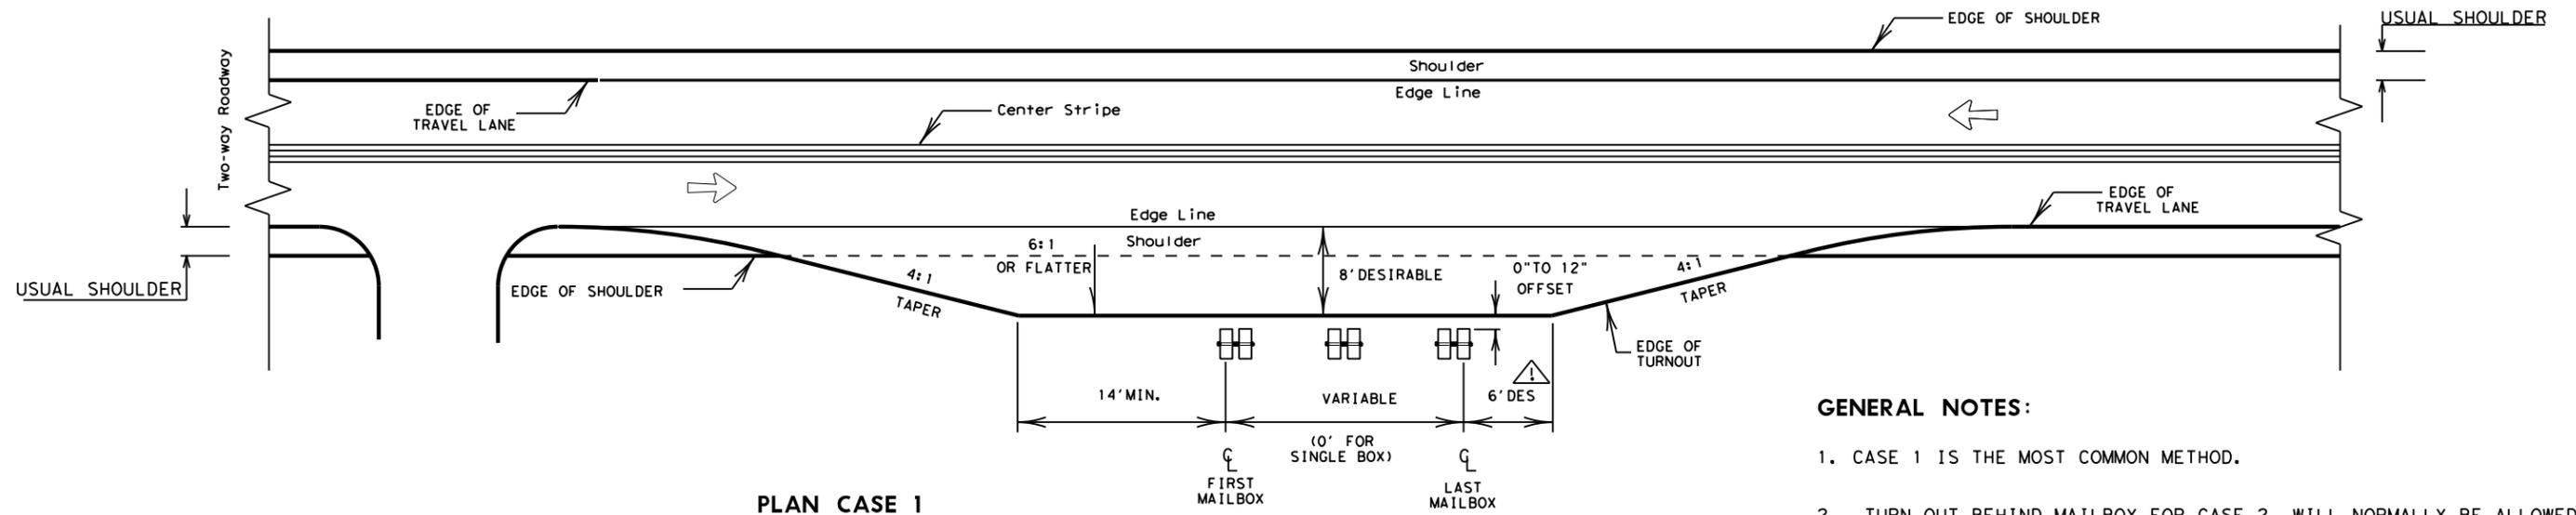


PLAN CASE 1

GENERAL NOTES:

1. CASE 1 IS THE MOST COMMON METHOD.
2. TURN OUT BEHIND MAILBOX FOR CASE 2 WILL NORMALLY BE ALLOWED FOR NATURAL TERRAIN THAT WILL SERVE AS AN ALL WEATHER SURFACE.
3. ALL WEATHER DRIVEWAYS FOR CASE 3 MAILBOXES LOCATED AT THE RIGHT OF WAY LINE SHOULD NORMALLY BE PLACED IN CONJUNCTION WITH COUNTY ROADS OR OTHER CONNECTING COMMUNITY ROADS OR STREETS. IF THE NUMBER OF MAILBOXES EXCEEDS FOUR, A COMMUNITY MAIL BOX SHOULD BE ENCOURAGED AT THESE LOCATIONS.

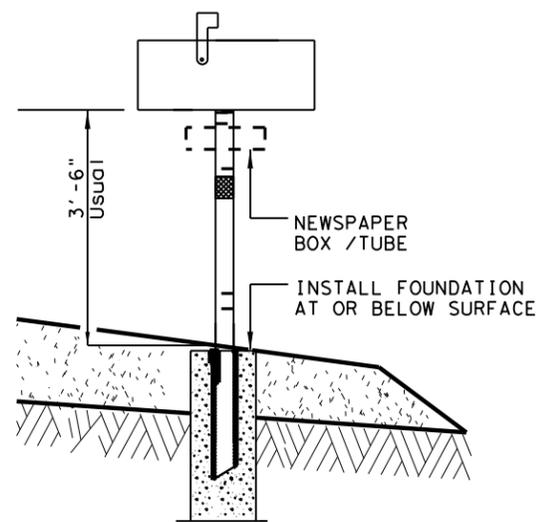

DETAIL A

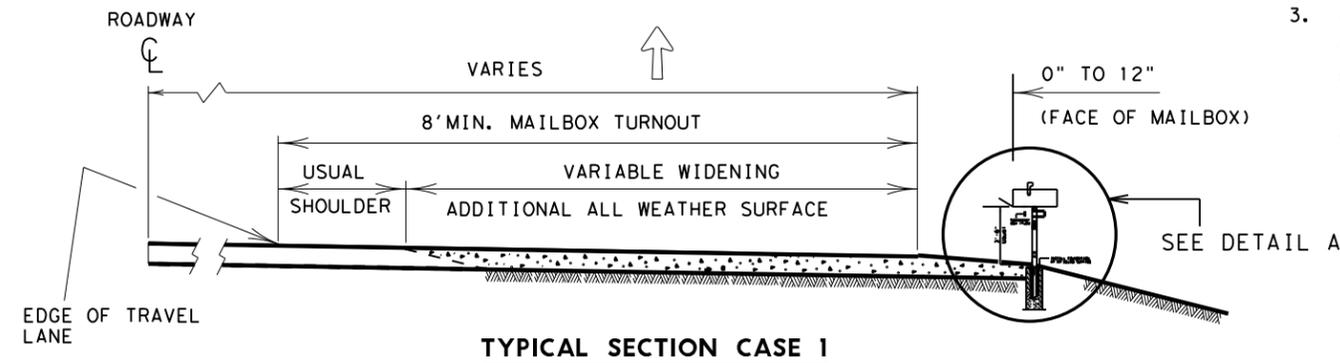


TYPICAL SECTION CASE 1

↑ MAIL DELIVERY VEHICLE TRAVEL DIRECTION


SHEET 1 OF 3

		Maintenance Division Standard	
<i>Guideline</i> MAILBOX SIDE ROAD PLACEMENT AND TURNOUTS MB-14(2)			
FILE: MB14(2).DGN	DN: JEO	CK:	DW: JEO
© TxDOT MAY 2014	CONT	SECT	JOB
REVISIONS	0169	07	053, ETC
DECEMBER 2012-NEW TxDOT TITLE BLOCK	DIST	COUNTY	SHEET NO.
	AMA	GRAY	112


DATE: 4/7/2021 7:27:19 AM
 FILE: E:\Projects\2016\11000_TxDOT_545_PSS\03_ISSUE_Amplified\500-INSTALL\113_PlanView\14.dwg
 The use of this standard is governed by the "Texas Engineering Practice Act". No warranty of any kind is made by TxDOT for any purpose whatsoever. TxDOT assumes no responsibility for the conversion of this standard to other formats, or for incorrect results or damages resulting from its use.

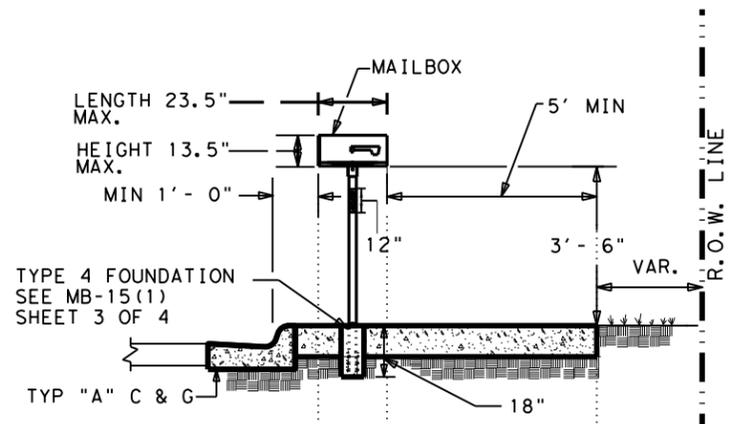


MAILBOX SIDEWALK INSTALLATION RELATIVE TO ANY OTHER OBSTRUCTION SUCH AS A SIGN (MINIMUM BORDER DISTANCE)

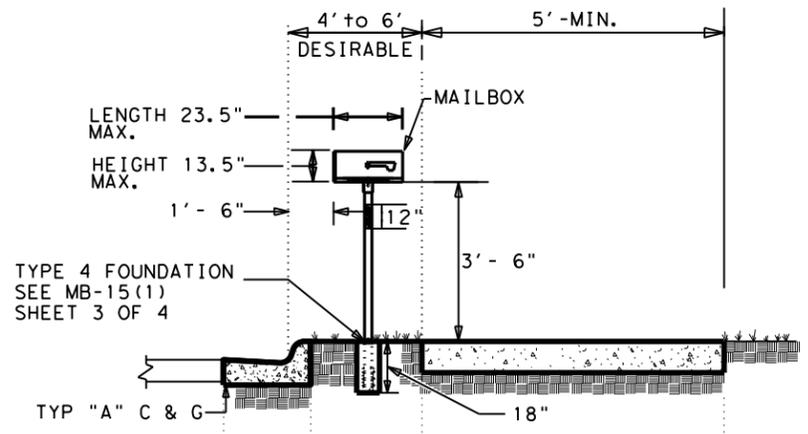


MAILBOX SIDEWALK INSTALLATION (DESIRABLE BORDER DISTANCE)

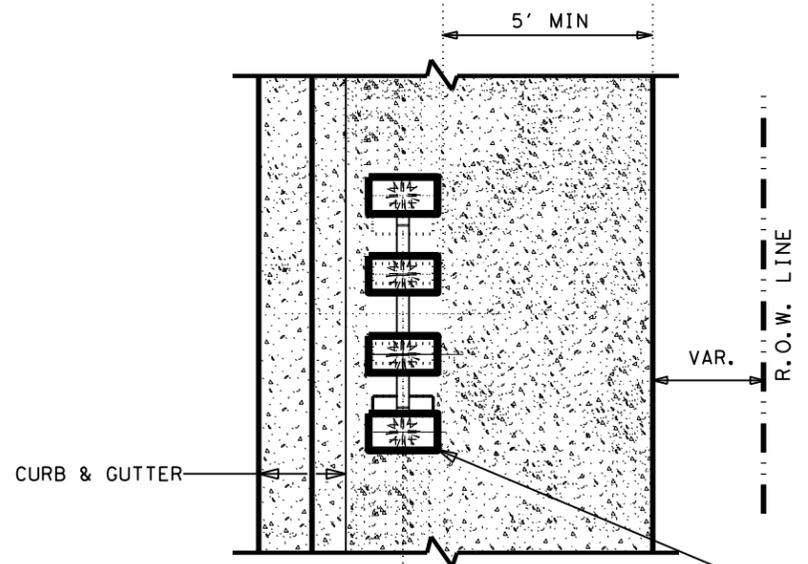

PLAN VIEW

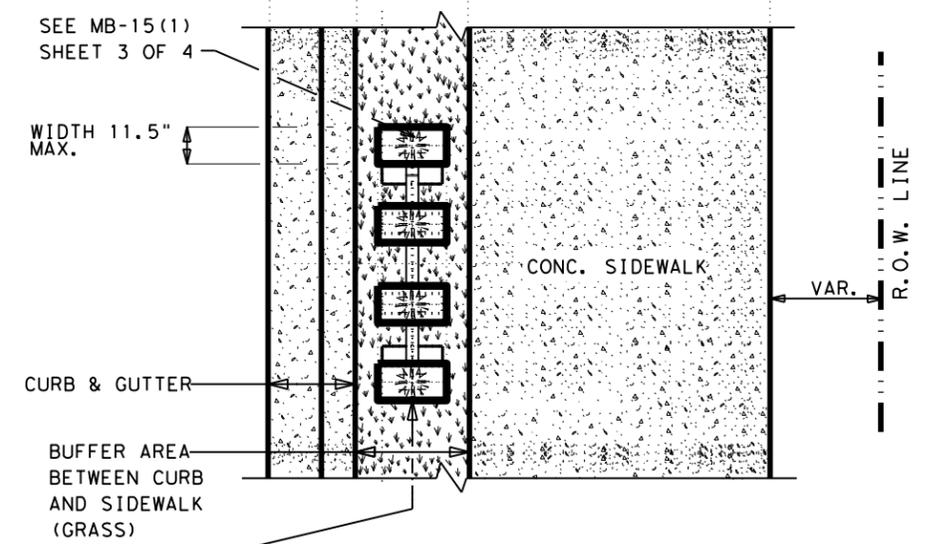

PLAN VIEW

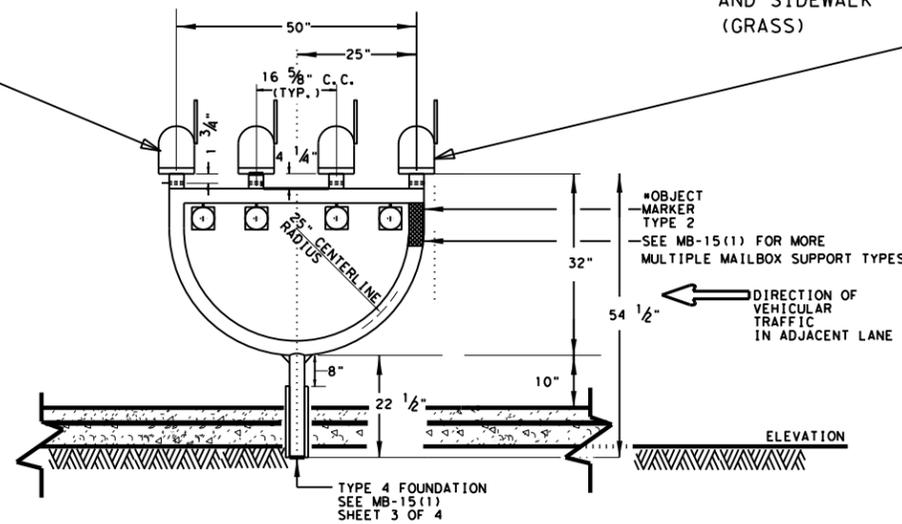

SHEET 3 OF 3




MULTIPLE MAILBOX PLACEMENT BEHIND CURBS WITH OR WITHOUT SIDEWALKS

MB-14(2B)

FILE: MB-14(2A)	DN:	CK:	DW:	CK:
© TxDOT MAY 2014	CONT	SECT	JOB	HIGHWAY
REVISIONS	0169	07	053, ETC	US60
	DIST	COUNTY	SHEET NO.	
	AMA	GRAY	114	


DISCLAIMER: The use of this standard is governed by the "Texas Engineering Practice Act". No warranty of any kind is made by TxDOT for any purpose whatsoever. TxDOT assumes no responsibility for the conversion of this standard to other formats or for incorrect results or damages resulting from its use.

DATE: 4/7/2021
 FILE: F:\Projects\2019\11004.TxDOT_5x5_P&E\03_US60_Amarillo\ENG\500-USTN\511.2-Roadway\05-Standard\tehmac11.dgn

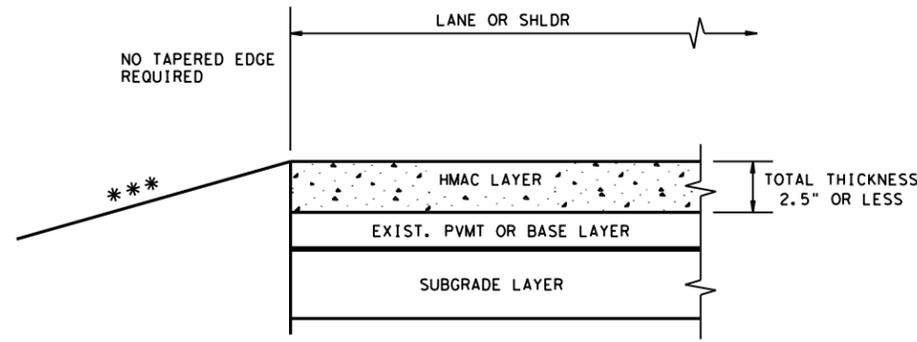

*** SEE TYPICAL SECTION FOR ROADSIDE DETAILS


CONDITION - 1
 THIN HMAC SURFACES OR HMAC OVERLAY
 WITH THICKNESS OF 2.5" OR LESS

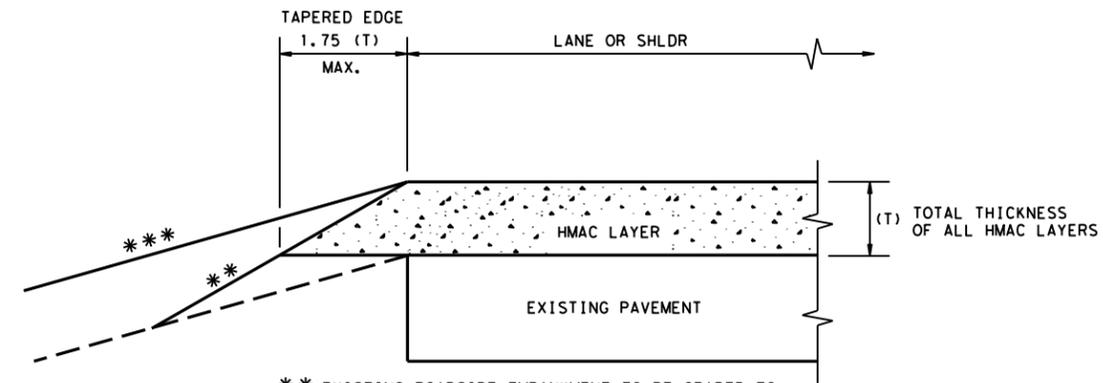

** EXISTING ROADSIDE EMBANKMENT TO BE GRADED TO PRODUCE A SMOOTH LEVEL SURFACE FOR PLACEMENT OF TAPERED EDGE. THIS WORK IS SUBSIDIARY TO THE VARIOUS BID ITEMS.


*** SEE TYPICAL SECTION FOR ROADSIDE DETAILS

CONDITION - 2
 OVERLAY OF EXISTING PAVEMENT
 HMAC THICKNESS 2.5" TO 5"

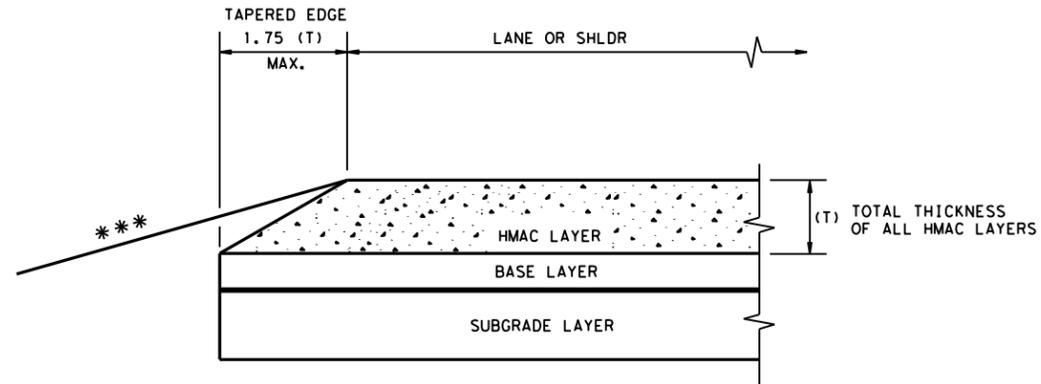

*** SEE TYPICAL SECTION FOR ROADSIDE DETAILS

CONDITION - 3
 NEW OR RECONSTRUCTED PAVEMENT
 HMAC THICKNESS 2.5" TO 5"

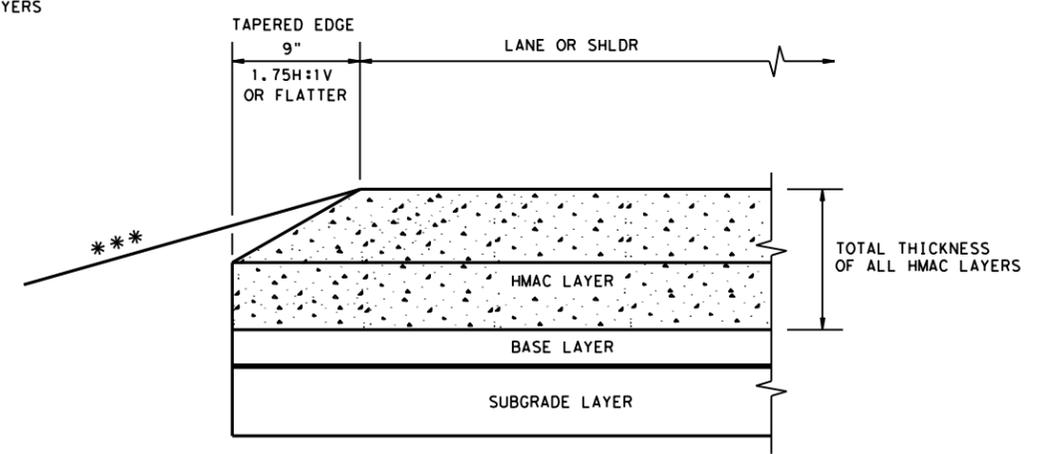

*** SEE TYPICAL SECTION FOR ROADSIDE DETAILS

CONDITION - 4
 NEW OR RECONSTRUCTED PAVEMENT
 HMAC THICKNESS 5" OR GREATER


GENERAL NOTES

- UNLESS OTHERWISE SHOWN IN THE PLANS, A VERTICAL EDGE IS PERMISSIBLE FOR HMAC PLACED GREATER THAN 5" BELOW THE EDGE OF PAVEMENT AND FOR THICKNESS OF HMAC LESS THAN 2.5".
- FOR FURTHER INFORMATION REGARDING THE ROADSIDE AND PAVEMENT DETAILS, SEE TYPICAL SECTIONS.
- PAYMENT FOR TAPERED EDGE WILL BE IN ACCORDANCE WITH APPLICABLE ITEMS IN THE CONTRACT.
- THE SLOPE OF THE TAPERED EDGE SHALL BE 1.75H:1V OR FLATTER.
- THE TAPERED EDGE SHALL BE PRODUCED BY USE OF A SCREED ATTACHMENT CAPABLE OF PRODUCING A SMOOTH COMPACTED SURFACE. ADDITIONAL COMPACTING EFFORT BEHIND THE SCREED IS NOT REQUIRED.

(NOT TO SCALE)

				Design Division Standard	
TAPERED EDGE DETAILS HMAC PAVEMENT					
TE (HMAC) - 11					
FILE: tehmac11.dgn	DN: TxDOT	CK: RL	DW: KB	CK:	
© TxDOT January 2011	CONT	SECT	JOB	HIGHWAY	
REVISIONS		0169	07	053, ETC	US60
DIST	COUNTY			SHEET NO.	
AMA	GRAY			115	

4/7/2021
 F:\P\proj\2019\1004_Tx00T_5x5_PSS&E\03_US60_Amarillo\ENGIN\500\USTN\511_3_Drainage\02_Sheets\US60_OVERALL_DRAIN_MAP.dgn

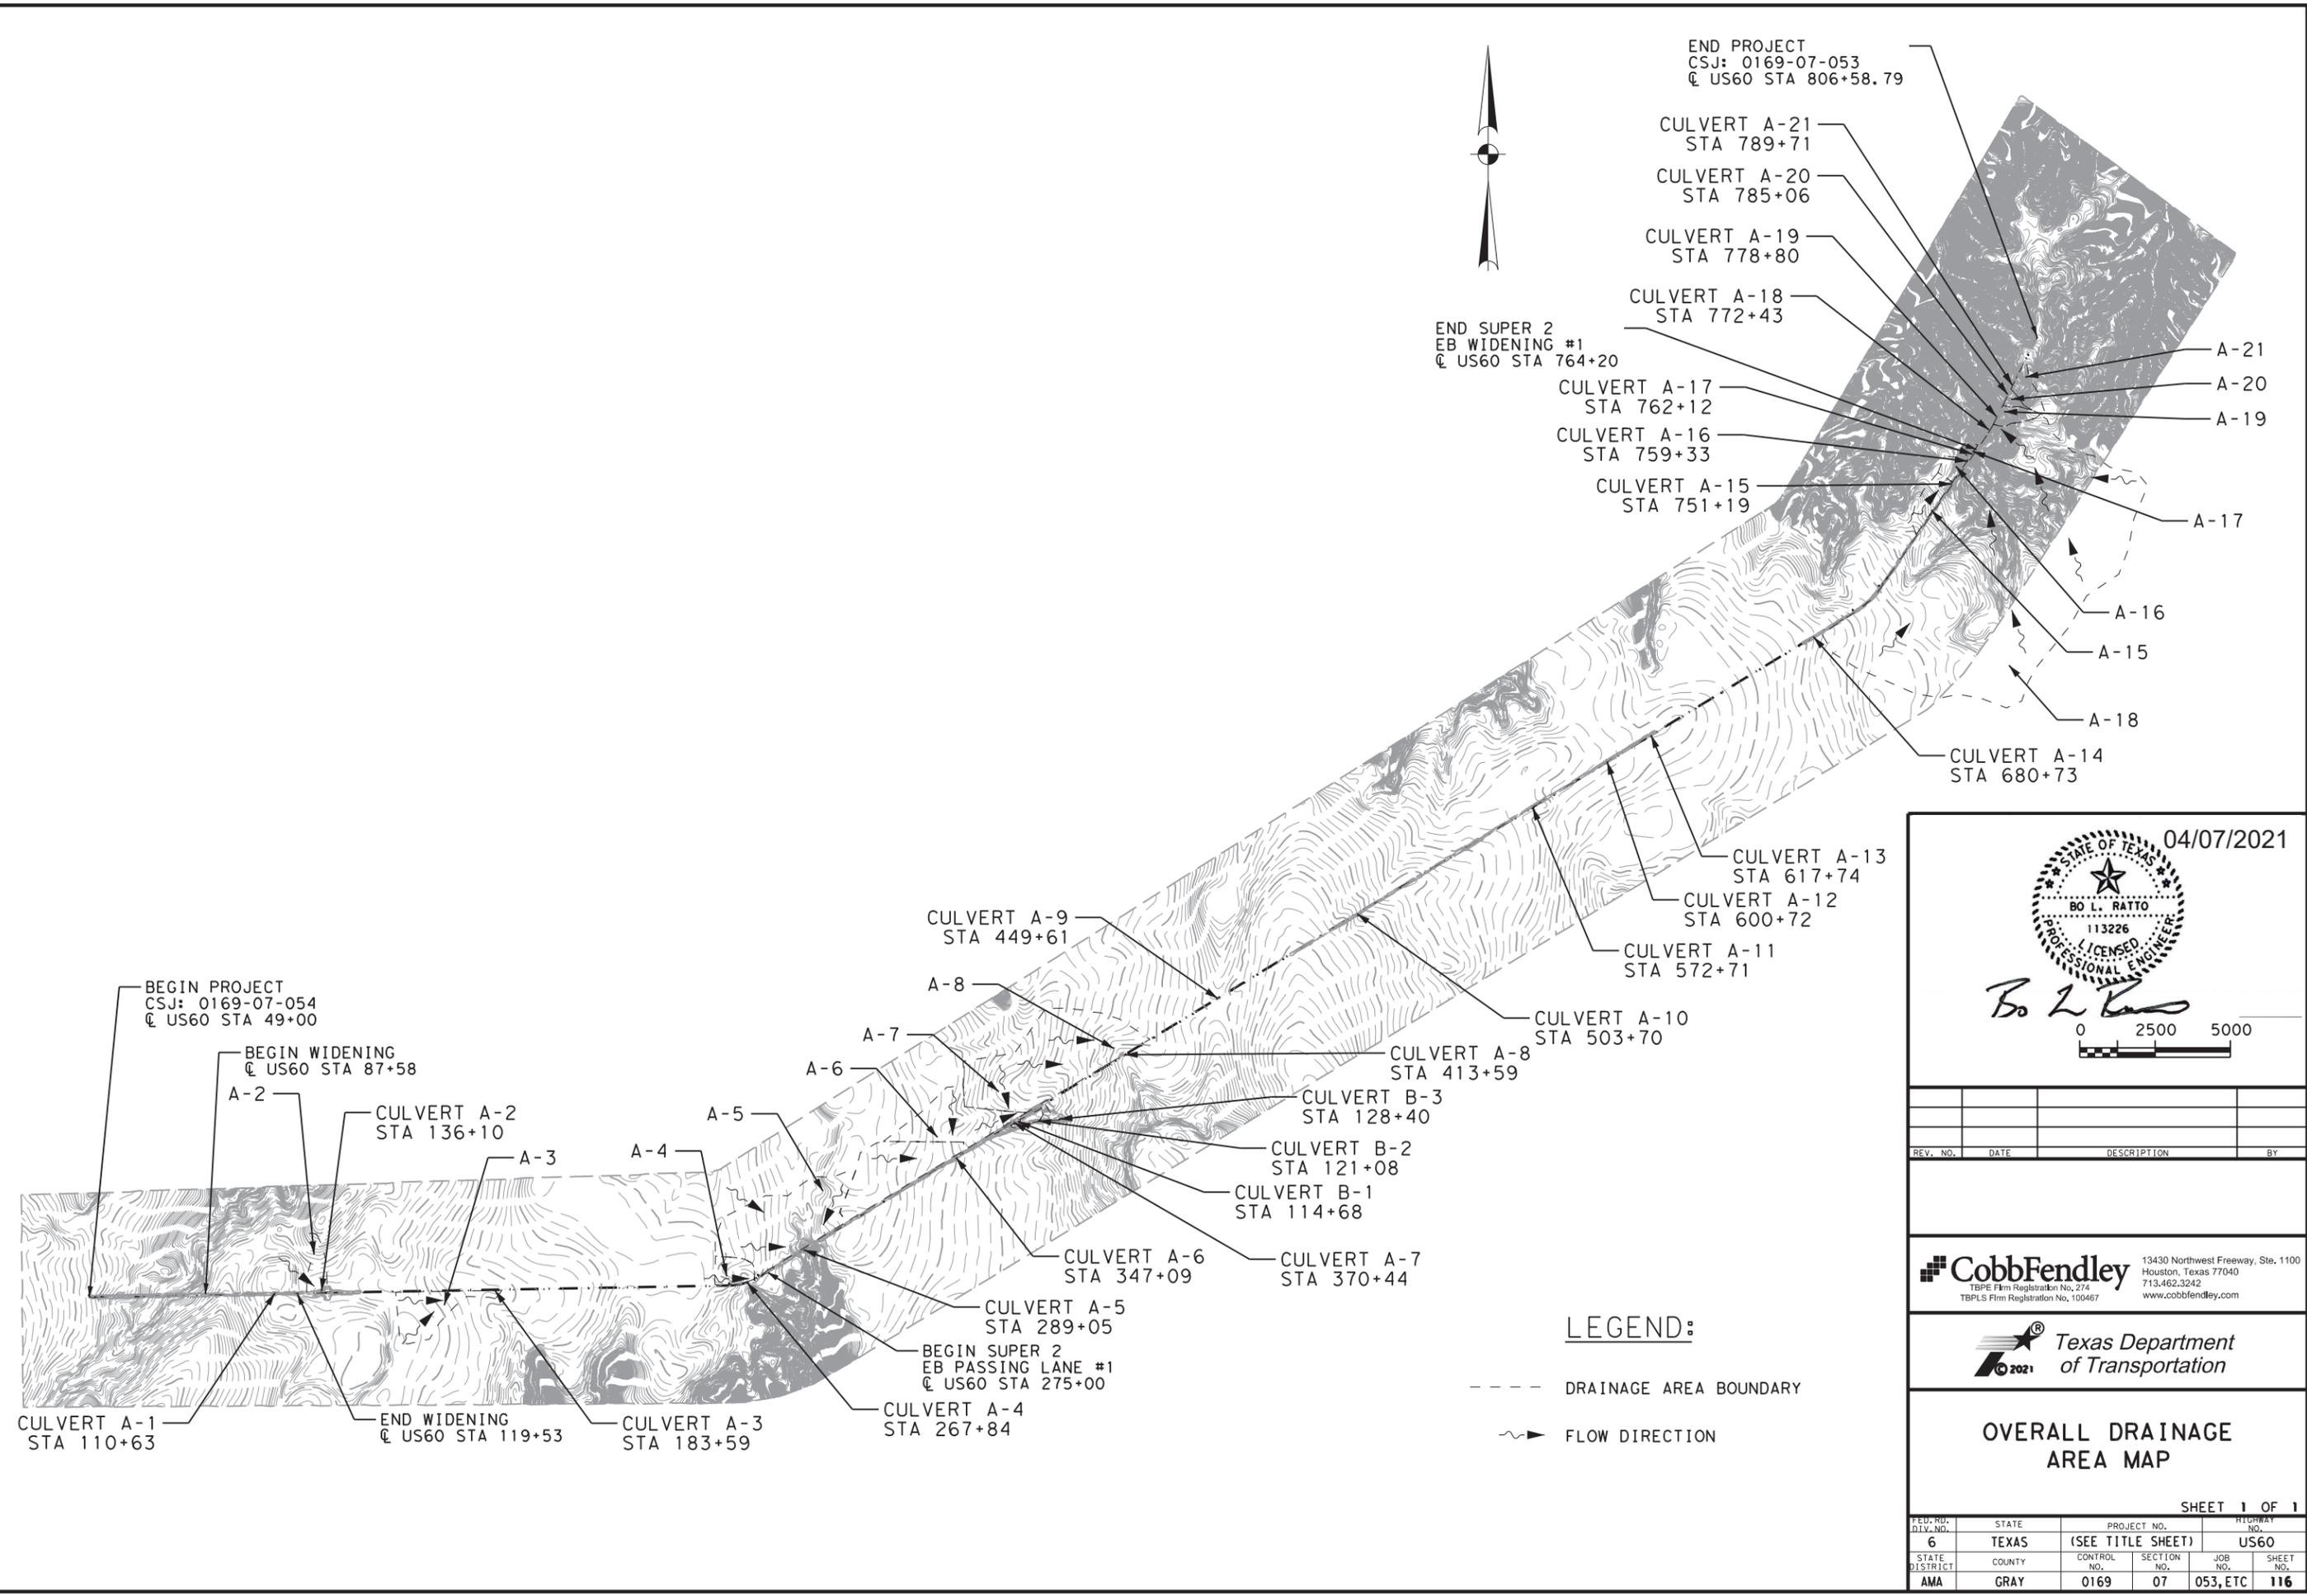

04/07/2021

Bo L. Ratto

0 2500 5000

REV. NO.	DATE	DESCRIPTION	BY

13430 Northwest Freeway, Ste. 1100
 Houston, Texas 77040
 713.462.3242
 www.cobbhendley.com

Texas Department of Transportation


OVERALL DRAINAGE AREA MAP

SHEET 1 OF 1

FED. RD. DIV. NO.	STATE	PROJECT NO.		HIGHWAY NO.	
6	TEXAS	(SEE TITLE SHEET)		US60	
STATE DISTRICT	COUNTY	CONTROL NO.	SECTION NO.	JOB NO.	SHEET NO.
AMA	GRAY	0169	07	053, ETC	116



Bo L Ratto

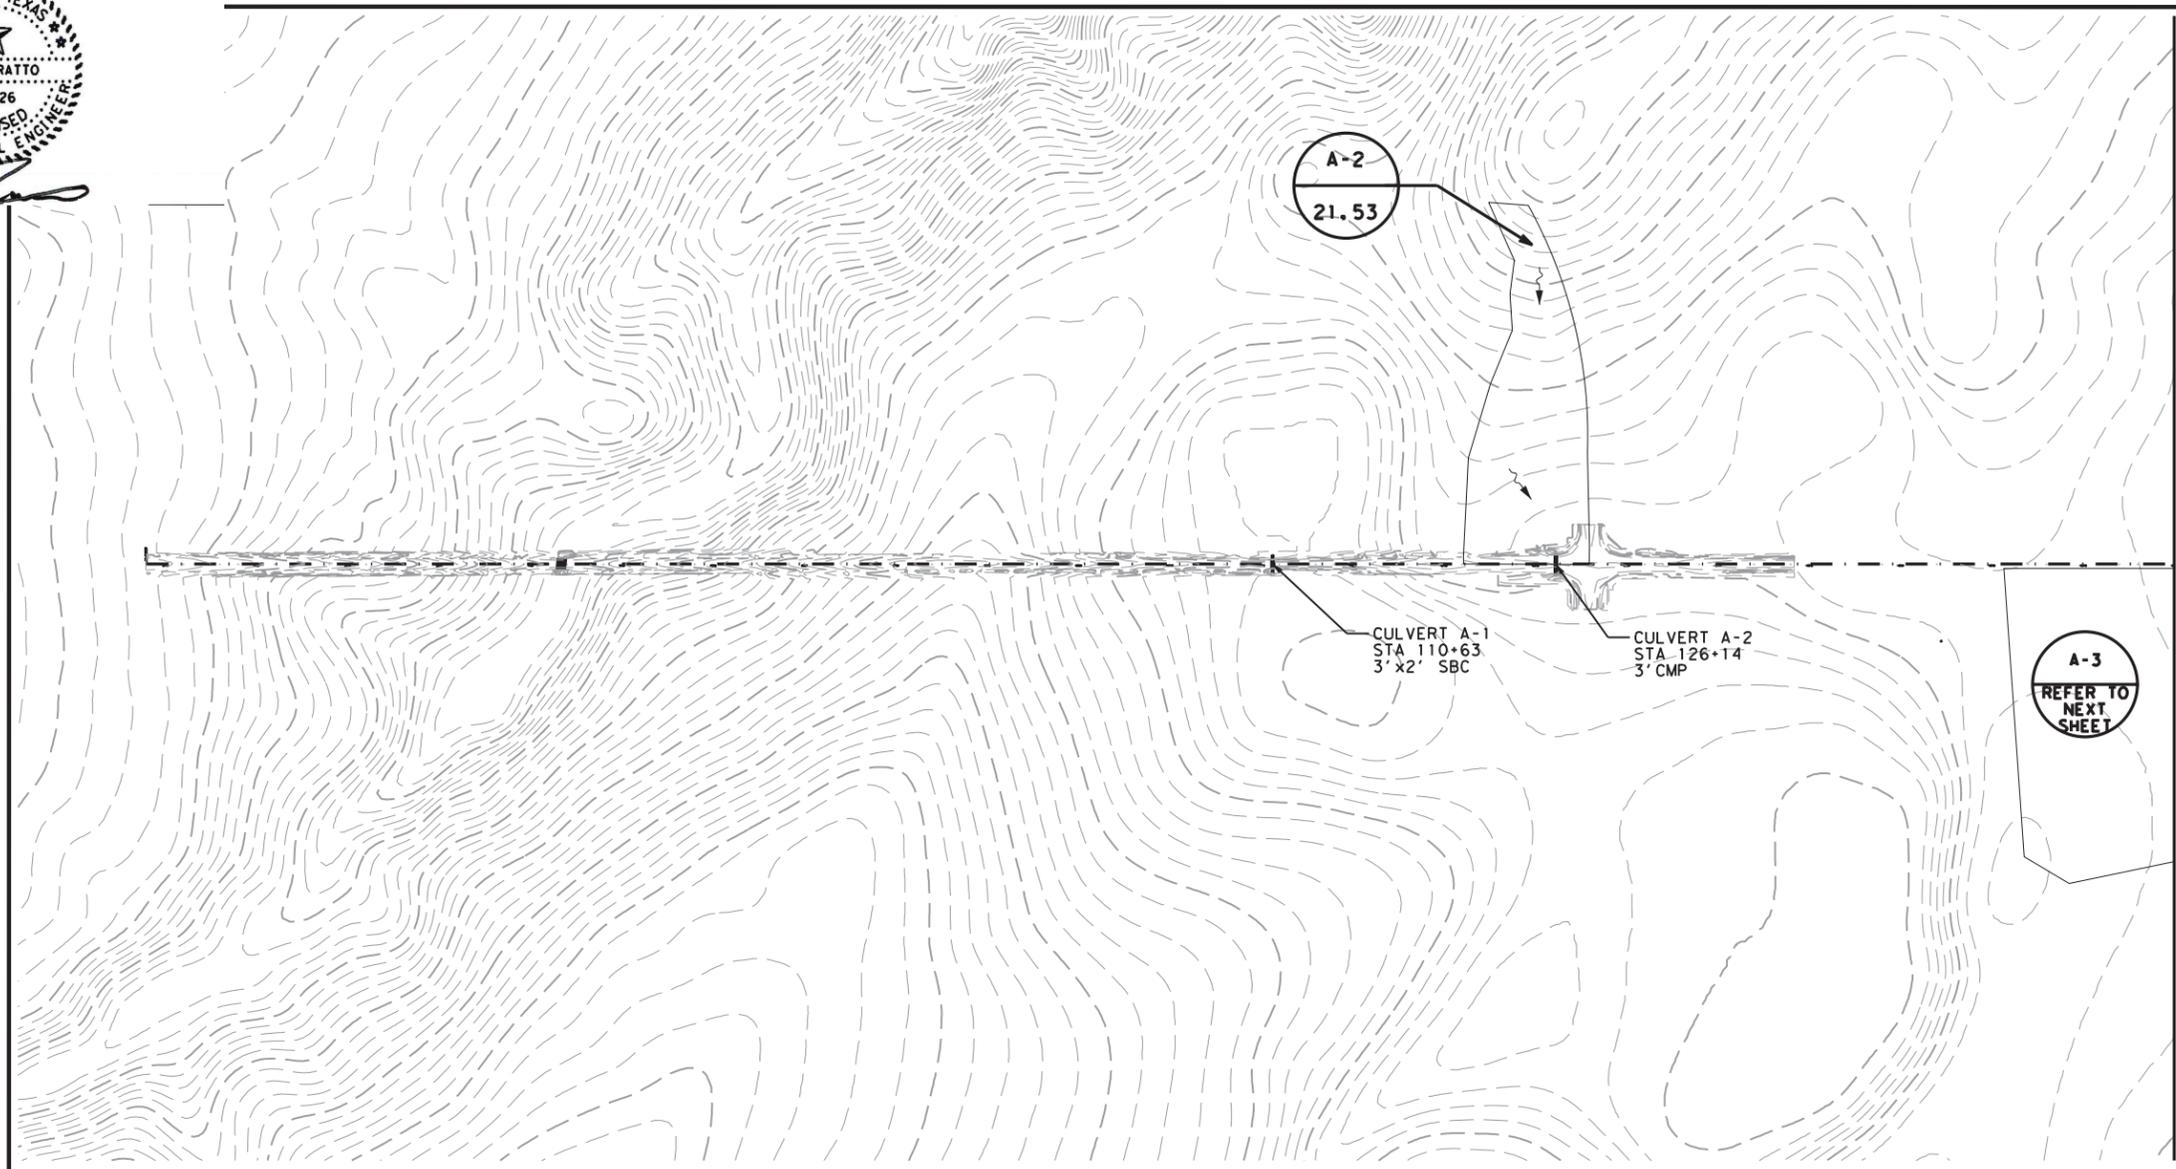

LEGEND:

- A-XX AREA ID
- XXX.XX AREA (ACRES)
- DRAINAGE AREA BOUNDARY
- FLOW DIRECTION

NOTES:

1. CONTOURS DISPLAYED REFLECT 2018 USGS PANHANDLE LIDAR DEM.
2. CALCULATIONS ARE BASED ON TxDOT HYDRAULIC DESIGN MANUAL (SEPTEMBER 2019) PROCEDURES FOR THE RATIONAL METHOD FOR DRAINAGE AREAS UP TO 200 ACRES AND THE NRCS METHOD FOR DRAINAGE AREAS GREATER THAN 200 ACRES.
3. STRUCTURES WITH NO DEFINED DRAINAGE AREA BOUNDARY ARE EQUALIZERS CULVERTS.
4. TC IS DETERMINED BY THE NRCS METHOD

24-HR RAINFALL DEPTH					
2-YR	5-YR	10-YR	25-YR	50-YR	100-YR
2.9	2.9	4.7	5.5	6.2	6.7

DOCUMENT IS FOR INTERIM REVIEW AND NOT INTENDED FOR CONSTRUCTION BIDDING, OR PERMIT PURPOSES
 BO L. RATTO, PE
 113226
 TEXAS SERIAL NO.
 4/7/2021
 DATE



DA ID	DA AREA (acres)	RATIONAL METHOD																		
		C				WEIGHTED "C"	Tc CALC (min)	Tc (min)	2 YR		5 YR		10 YR		25 YR		50 Yr		100 YR	
		PVMT 0.90	COMM 0.65	RESID 0.45	GROUND 0.25				INTENSITY (in/hr)	Q (cfs)										
A-2	21.53	-	-	-	21.53	0.25	24.87	25	2.6	14.1	3.5	18.9	4.2	22.4	4.9	26.2	5.6	30.3	6.1	32.6

CobbFendley 13430 Northwest Freeway, Ste. 1100
 Houston, Texas 77040
 TBPE Firm Registration No. 274 713.462.3242
 TBPLS Firm Registration No. 100467 www.cobbfendley.com




DRAINAGE AREA MAP

SHEET 1 OF 7

FED. RD. DIV. NO.	STATE	PROJECT NO.		HIGHWAY NO.	
6	TEXAS	(SEE TITLE SHEET)		US60	
STATE DISTRICT	COUNTY	CONTROL NO.	SECTION NO.	JOB NO.	SHEET NO.
AMA	GRAY	0169	07	053, ETC	117

4/7/2021
 F:\Projects\2019\1004_Tx007_5x5_PSS&E\03_US60_Amar\1161616\US60-UST\N\511_3-DRAINAGE\02-Sheets\US60_DRAIN-MAP-01.dgn
 7:27:25 AM

US60-DRAIN-MAP-01.dgn

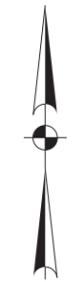


LEGEND:

- A-XX AREA ID
- XXX.XX AREA (ACRES)
- DRAINAGE AREA BOUNDARY
- FLOW DIRECTION

NOTES:

1. CONTOURS DISPLAYED REFLECT 2018 USGS PANHANDLE LIDAR DEM.
2. CALCULATIONS ARE BASED ON TxDOT HYDRAULIC DESIGN MANUAL (SEPTEMBER 2019) PROCEDURES FOR THE RATIONAL METHOD FOR DRAINAGE AREAS UP TO 200 ACRES AND THE NRCS METHOD FOR DRAINAGE AREAS GREATER THAN 200 ACRES.
3. STRUCTURES WITH NO DEFINED DRAINAGE AREA BOUNDARY ARE EQUALIZERS/CULVERTS.
4. TC IS DETERMINED BY THE NRCS METHOD

24-HR RAINFALL DEPTH					
2-YR	5-YR	10-YR	25-YR	50-YR	100-YR
2.9	2.9	4.7	5.5	6.2	6.7

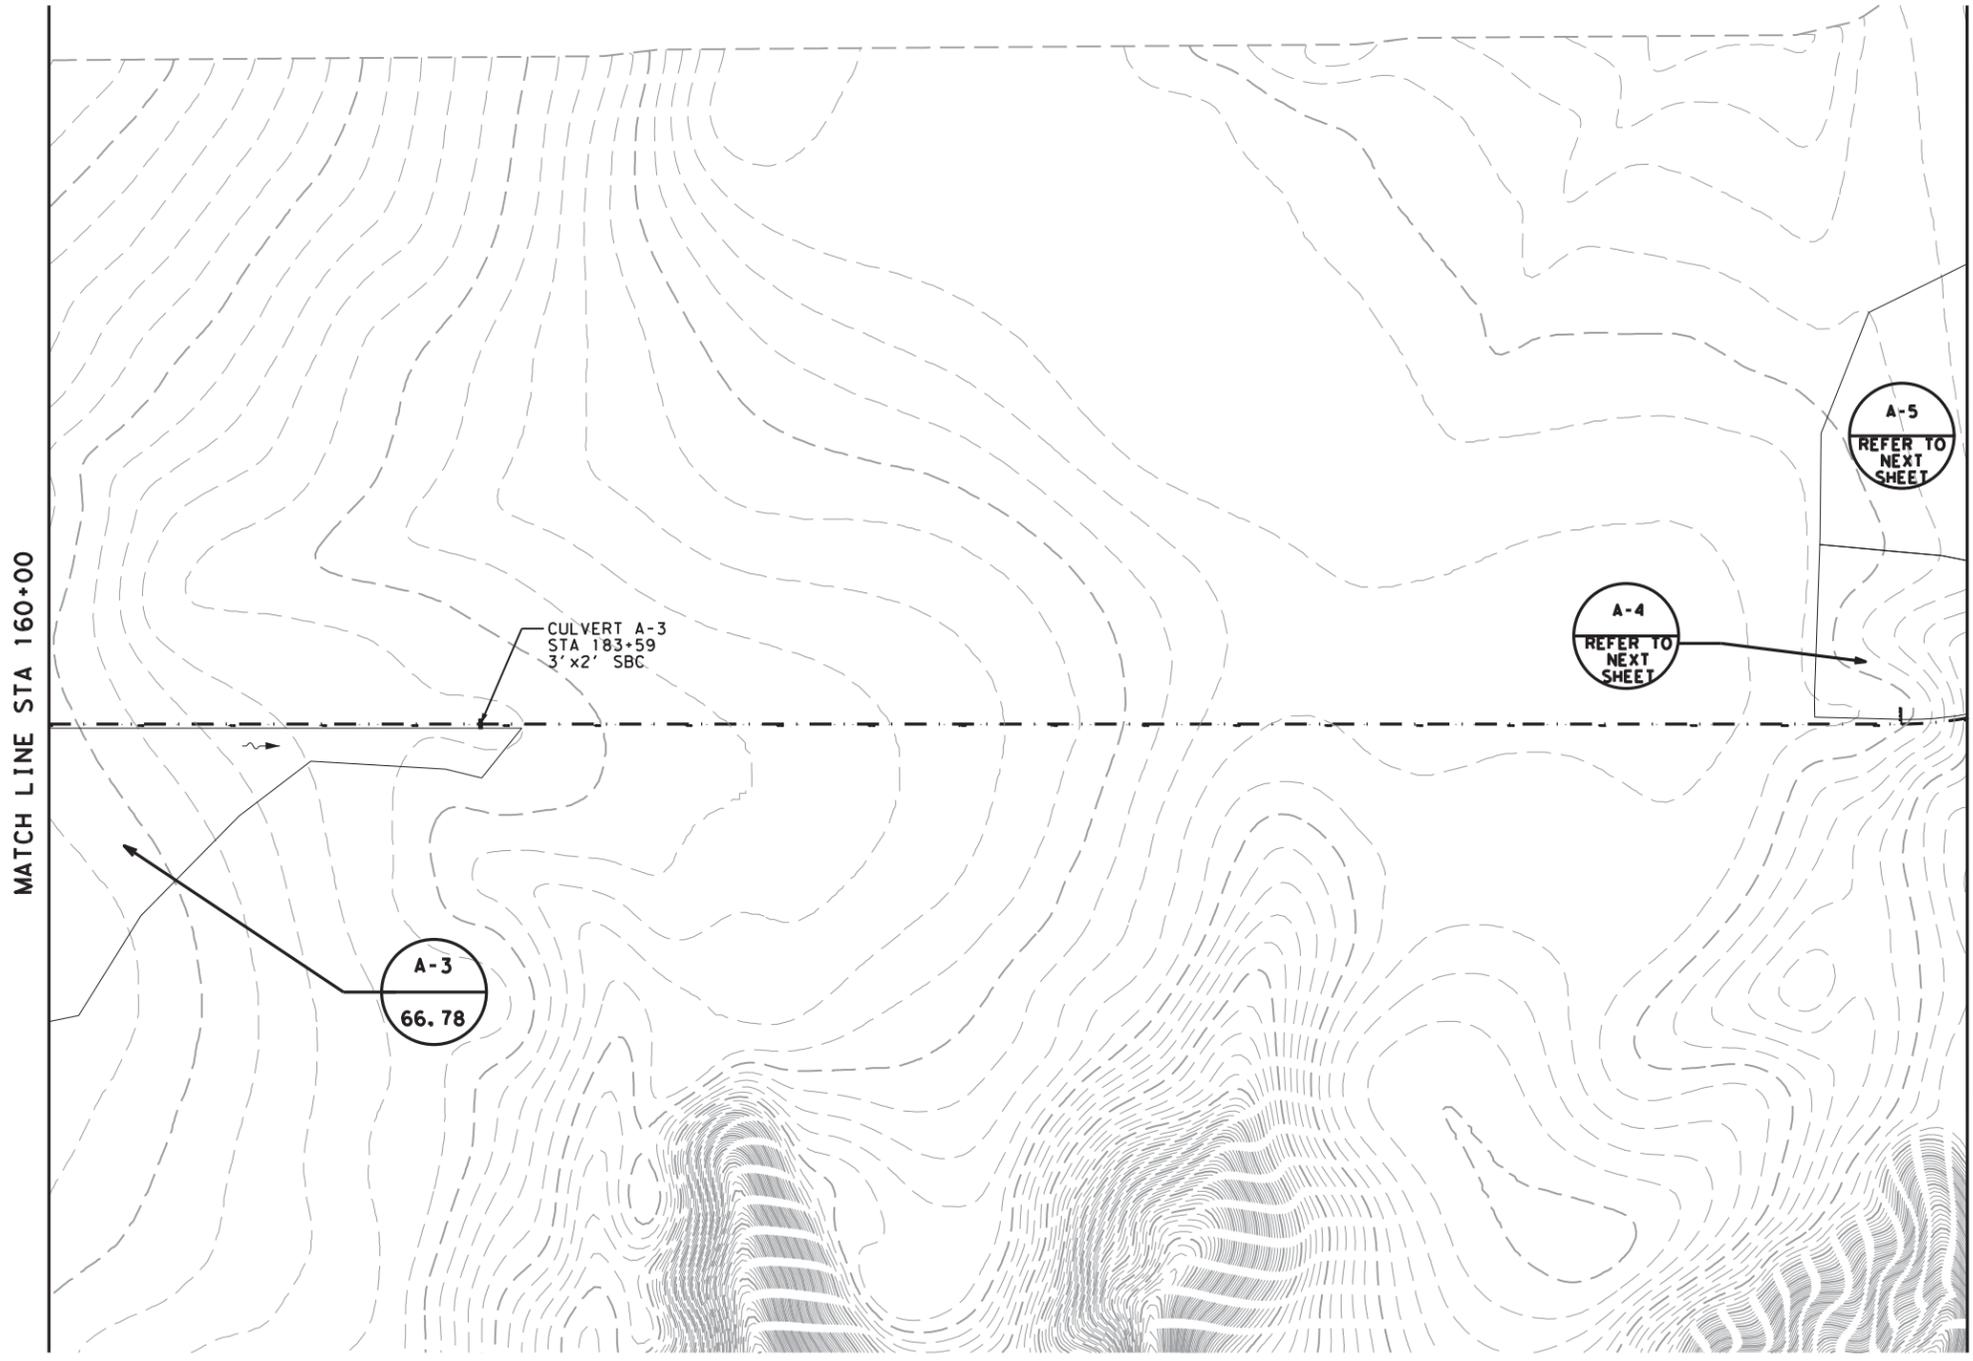

DA ID	DA AREA (ACRES)	C				WEIGHTED "C"	Tc CALC (MIN)	Tc (MIN)	2 YR		5 YR		10 YR		25 YR		50 Yr		100 YR	
		PVMT 0.90	COMM 0.65	RESID 0.45	GROUND 0.25				INTENSITY (IN/HR)	Q (CFS)										
A-3	66.78	-	-	9.08	57.70	0.22	97.47	97	1.0	14.9	1.4	20.1	1.7	23.9	1.9	27.8	2.2	32.1	2.4	34.4

04/07/2021

Bo L. Ratto

REV. NO.	DATE	DESCRIPTION	BY

CobbFendley 13430 Northwest Freeway, Ste. 1100
Houston, Texas 77040
713.462.3242
www.cobbendley.com

Texas Department of Transportation

DRAINAGE AREA MAP

SHEET 2 OF 7

FED. RD. DIV. NO.	STATE	PROJECT NO.	HIGHWAY NO.
6	TEXAS	(SEE TITLE SHEET)	US60
STATE DISTRICT	COUNTY	CONTROL NO.	SECTION NO.
AMA	GRAY	0169	07
		JOB NO.	SHEET NO.
		053, ETC	118

4/7/2021 7:57:05 AM F:\P\J\drain\2019\1004_TxDOT_5x5_P5&E\03_US60_Amarillo\ENGIN\500\UST\N\511_3_Drainage\02-Sheets\US60_DRAIN-MAP-02.dgn

US60-DRAIN-MAP-02.dgn




LEGEND:

- A-XX AREA ID
- XXX.XX AREA (ACRES)
- DRAINAGE AREA BOUNDARY
- FLOW DIRECTION

NOTES:

1. CONTOURS DISPLAYED REFLECT 2018 USGS PANHANDLE LIDAR DEM.
2. CALCULATIONS ARE BASED ON TxDOT HYDRAULIC DESIGN MANUAL (SEPTEMBER 2019) PROCEDURES FOR THE RATIONAL METHOD FOR DRAINAGE AREAS UP TO 200 ACRES AND THE NRCS METHOD FOR DRAINAGE AREAS GREATER THAN 200 ACRES.
3. STRUCTURES WITH NO DEFINED DRAINAGE AREA BOUNDARY ARE EQUALIZERS CULVERTS.
4. TC IS DETERMINED BY THE NRCS METHOD

24-HR RAINFALL DEPTH					
2-YR	5-YR	10-YR	25-YR	50-YR	100-YR
2.9	2.9	4.7	5.5	6.2	6.7

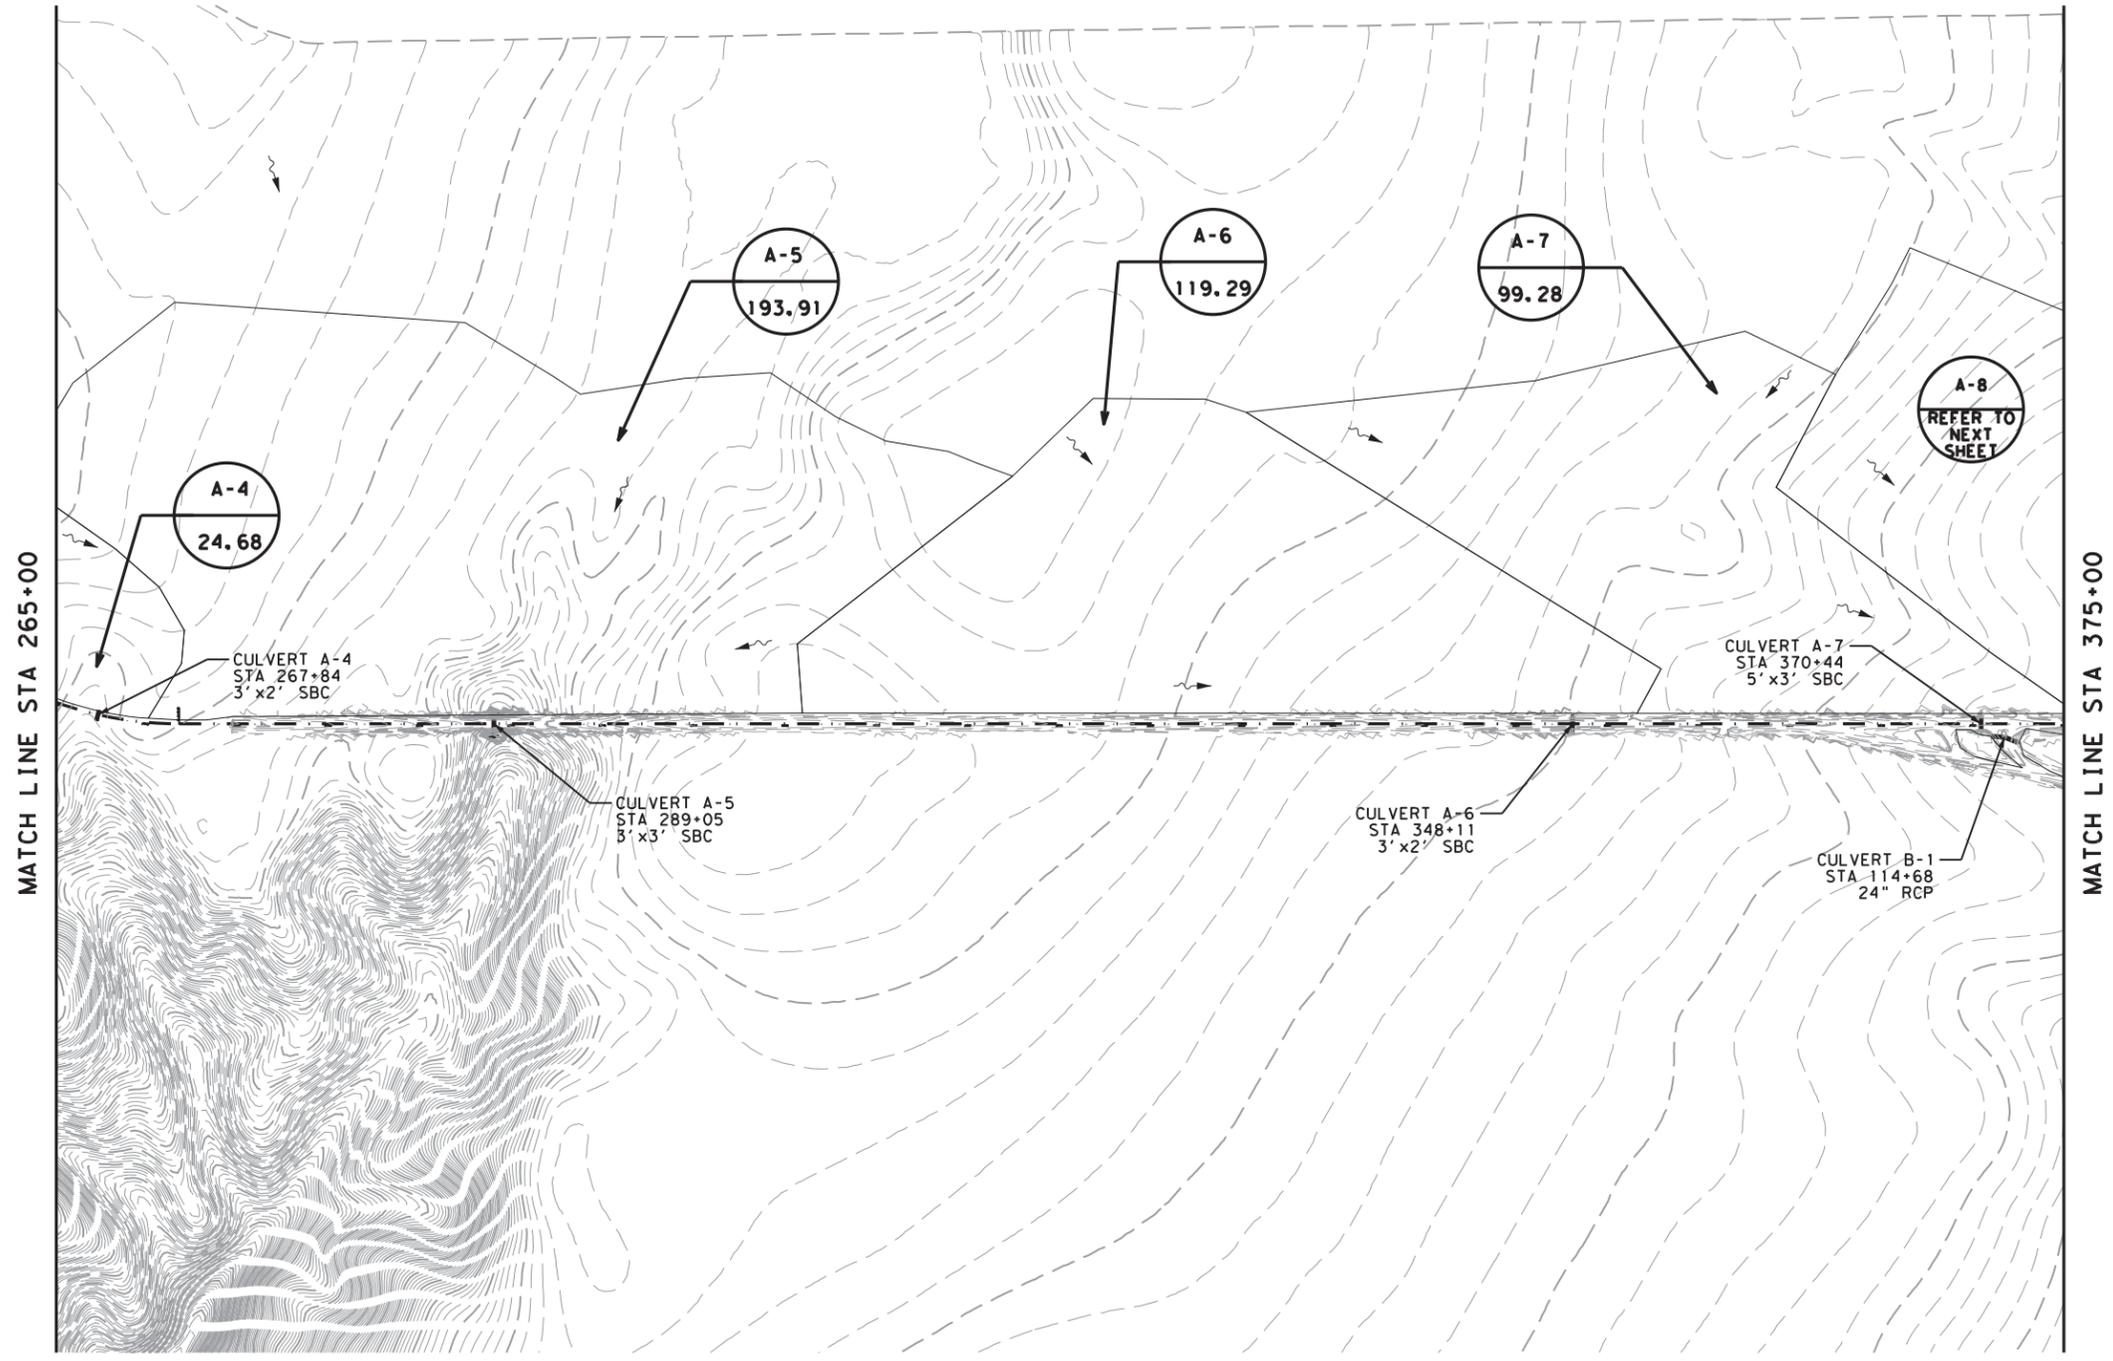

DA ID	DA AREA (ACRES)	C				WEIGHTED "C" (NONE)	Tc CALC (MIN)	Tc (MIN)	2 YR		5 YR		10 YR		25 YR		50 Yr		100 YR	
		PVMT 0.90	COMM 0.65	RESID 0.45	GROUND 0.25				INTENSITY (IN/HR)	Q (CFS)										
A-4	24.68	-	9.38	-	15.30	0.40	57.89	58	1.5	15.0	2.0	20.1	2.4	24.0	2.8	27.9	3.2	32.2	3.5	34.6
A-5	193.91	-	-	-	193.91	0.25	57.89	58	1.5	73.3	2.0	98.3	2.4	117.1	2.8	136.1	3.2	157.4	3.5	169.0
A-6	119.29	-	-	-	119.29	0.25	134.06	134.00	0.81	24.0	1.1	32.4	1.3	38.7	1.5	44.8	1.7	51.8	1.9	55.4
A-7	99.28	-	-	-	99.28	0.25	66.27	66.00	1.38	34.2	1.8	45.9	2.2	54.7	2.6	63.5	3.0	73.5	3.2	78.8

04/07/2021

Bo L. Ratto

REV. NO.	DATE	DESCRIPTION	BY

CobbFendley 13430 Northwest Freeway, Ste. 1100
Houston, Texas 77040
713.462.3242
www.cobbfendley.com

Texas Department of Transportation

DRAINAGE AREA MAP

SHEET 3 OF 7

FED. RD. DIV. NO.	STATE	PROJECT NO.		HIGHWAY NO.	
6	TEXAS	(SEE TITLE SHEET)		US60	
STATE DISTRICT	COUNTY	CONTROL NO.	SECTION NO.	JOB NO.	SHEET NO.
AMA	GRAY	0169	07	053, ETC	119

4/7/2021 7:27:27 AM F:\Proj\drain\2019\1004_TxDOT_15x5_PSS&E\03_US60_Amarr\116\116\500\UST\N\11_S11_3_Drainage\02_Sheets\US60_DRAIN_MAP-03.dgn

US60_DRAIN_MAP-03.dgn




LEGEND:

- A-XX AREA ID
- XXX.XX AREA (ACRES)
- DRAINAGE AREA BOUNDARY
- FLOW DIRECTION

NOTES:

1. CONTOURS DISPLAYED REFLECT 2018 USGS PANHANDLE LIDAR DEM.
2. CALCULATIONS ARE BASED ON TxDOT HYDRAULIC DESIGN MANUAL (SEPTEMBER 2019) PROCEDURES FOR THE RATIONAL METHOD FOR DRAINAGE AREAS UP TO 200 ACRES AND THE NRCS METHOD FOR DRAINAGE AREAS GREATER THAN 200 ACRES.
3. STRUCTURES WITH NO DEFINED DRAINAGE AREA BOUNDARY ARE EQUALIZERS CULVERTS.
4. TC IS DETERMINED BY THE NRCS METHOD

24-HR RAINFALL DEPTH					
2-YR	5-YR	10-YR	25-YR	50-YR	100-YR
2.9	2.9	4.7	5.5	6.2	6.7

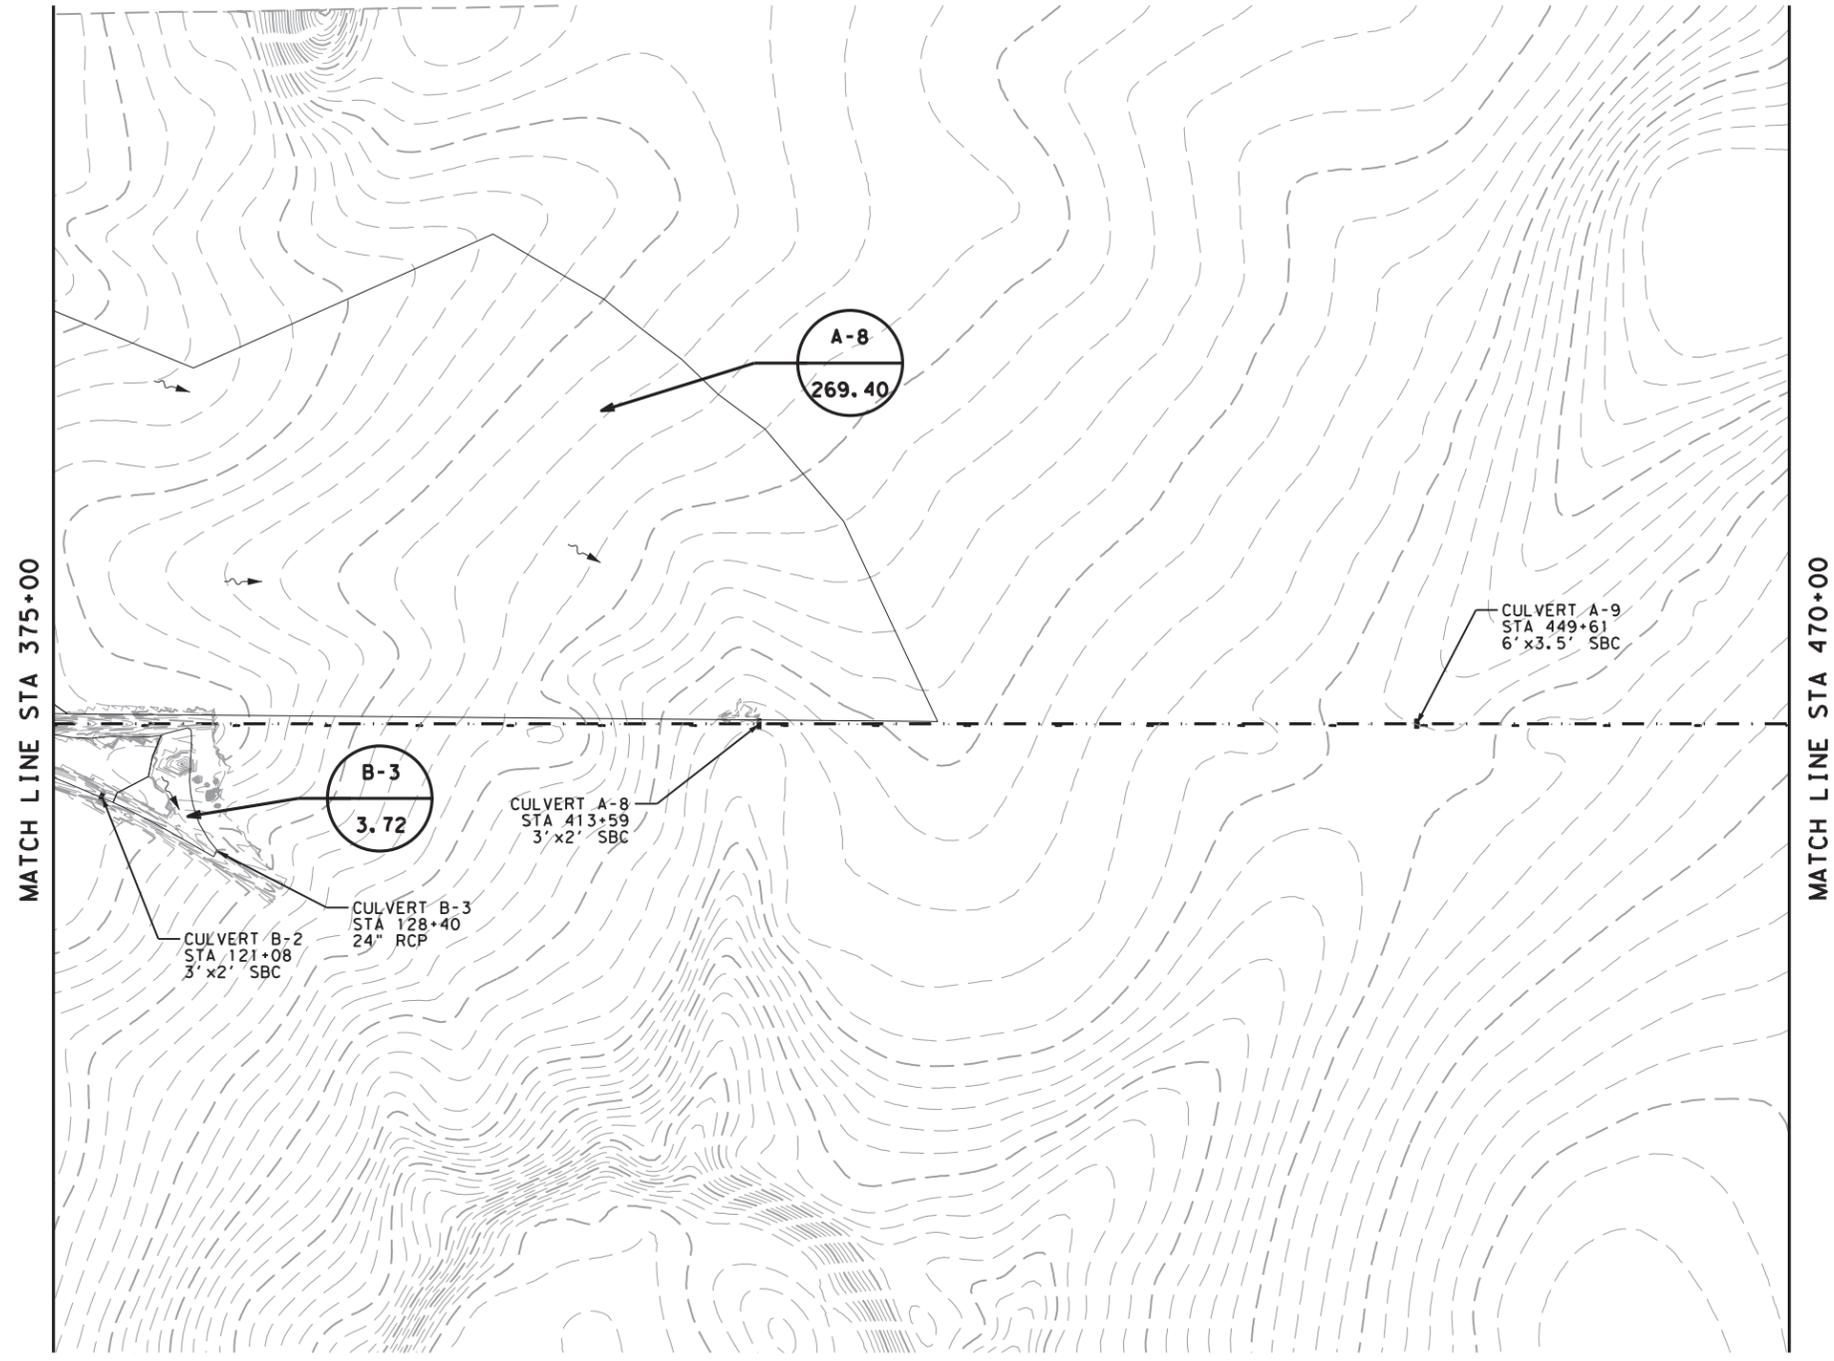

RATIONAL METHOD																				
DA ID	DA AREA (acres)	C				WEIGHTED "C"	Tc CALC (min)	Tc (min)	2 YR		5 YR		10 YR		25 YR		50 Yr		100 YR	
		PVMT 0.90	COMM 0.65	RESID 0.45	GROUND 0.25				INTENSITY (in/hr)	Q (cfs)										
B-3	3.72	-	-	-	3.72	0.25	38.66	39	2.0	1.8	2.7	2.5	3.2	2.9	3.7	3.4	4.3	4.0	4.6	4.3

NRCS RUNOFF CURVE NUMBER HYDROLOGY												
DA ID	HYDROLOGY METHOD	DESIGN FREQUENCY	DRAINAGE AREA			Weighted CN	PEAK DISCHARGE					
			AC	SQ MI	MIN		2 YR CFS	5 YR CFS	10 YR CFS	25 YR CFS	50 YR CFS	100 YR CFS
A-8	SCS UNIT HYDROGRAPH	25 YR	269.40	0.42	121.5	75	71.25	134.60	190.84	250.09	303.62	342.64

04/07/2021

Bo L. Ratto

REV. NO.	DATE	DESCRIPTION	BY

CobbFendley 13430 Northwest Freeway, Ste. 1100
Houston, Texas 77040
713.462.3242
www.cobbfendley.com

Texas Department of Transportation

DRAINAGE AREA MAP

SHEET 4 OF 7

FED. RD. DIV. NO.	STATE	PROJECT NO.	HIGHWAY NO.		
6	TEXAS	(SEE TITLE SHEET)	US60		
STATE DISTRICT	COUNTY	CONTROL NO.	SECTION NO.	JOB NO.	SHEET NO.
AMA	GRAY	0169	07	053, ETC	120

4/7/2021 7:57:29 AM F:\Proj\drain\2019\1004_TxDOT_5x5_PSS\US60_Amarillo\ENGIN\500\UST\N\3_Drainage\02_Sheets\US60_DRAIN_MAP-04.dgn



LEGEND:

-  AREA ID
-  AREA (ACRES)
-  DRAINAGE AREA BOUNDARY
-  FLOW DIRECTION

NOTES:

1. CONTOURS DISPLAYED REFLECT 2018 USGS PANHANDLE LIDAR DEM.
2. CALCULATIONS ARE BASED ON TxDOT HYDRAULIC DESIGN MANUAL (SEPTEMBER 2019) PROCEDURES FOR THE RATIONAL METHOD FOR DRAINAGE AREAS UP TO 200 ACRES AND THE NRCS METHOD FOR DRAINAGE AREAS GREATER THAN 200 ACRES.
3. STRUCTURES WITH NO DEFINED DRAINAGE AREA BOUNDARY ARE EQUALIZERS/CULVERTS.
4. TC IS DETERMINED BY THE NRCS METHOD

24-HR RAINFALL DEPTH					
2-YR	5-YR	10-YR	25-YR	50-YR	100-YR
2.9	2.9	4.7	5.5	6.2	6.7

04/07/2021



Bo L. Ratto



REV. NO.	DATE	DESCRIPTION	BY


CobbFendley 13430 Northwest Freeway, Ste. 1100
Houston, Texas 77040
713.462.3242
www.cobbfendley.com

 **Texas Department of Transportation**

DRAINAGE AREA MAP

SHEET **5** OF **7**

FED. RD. DIV. NO.	STATE	PROJECT NO.	HIGHWAY NO.
6	TEXAS	(SEE TITLE SHEET)	US60
STATE DISTRICT	COUNTY	CONTROL NO.	SECTION NO.
AMA	GRAY	0169	07
		JOB NO.	SHEET NO.
		053, ETC	121

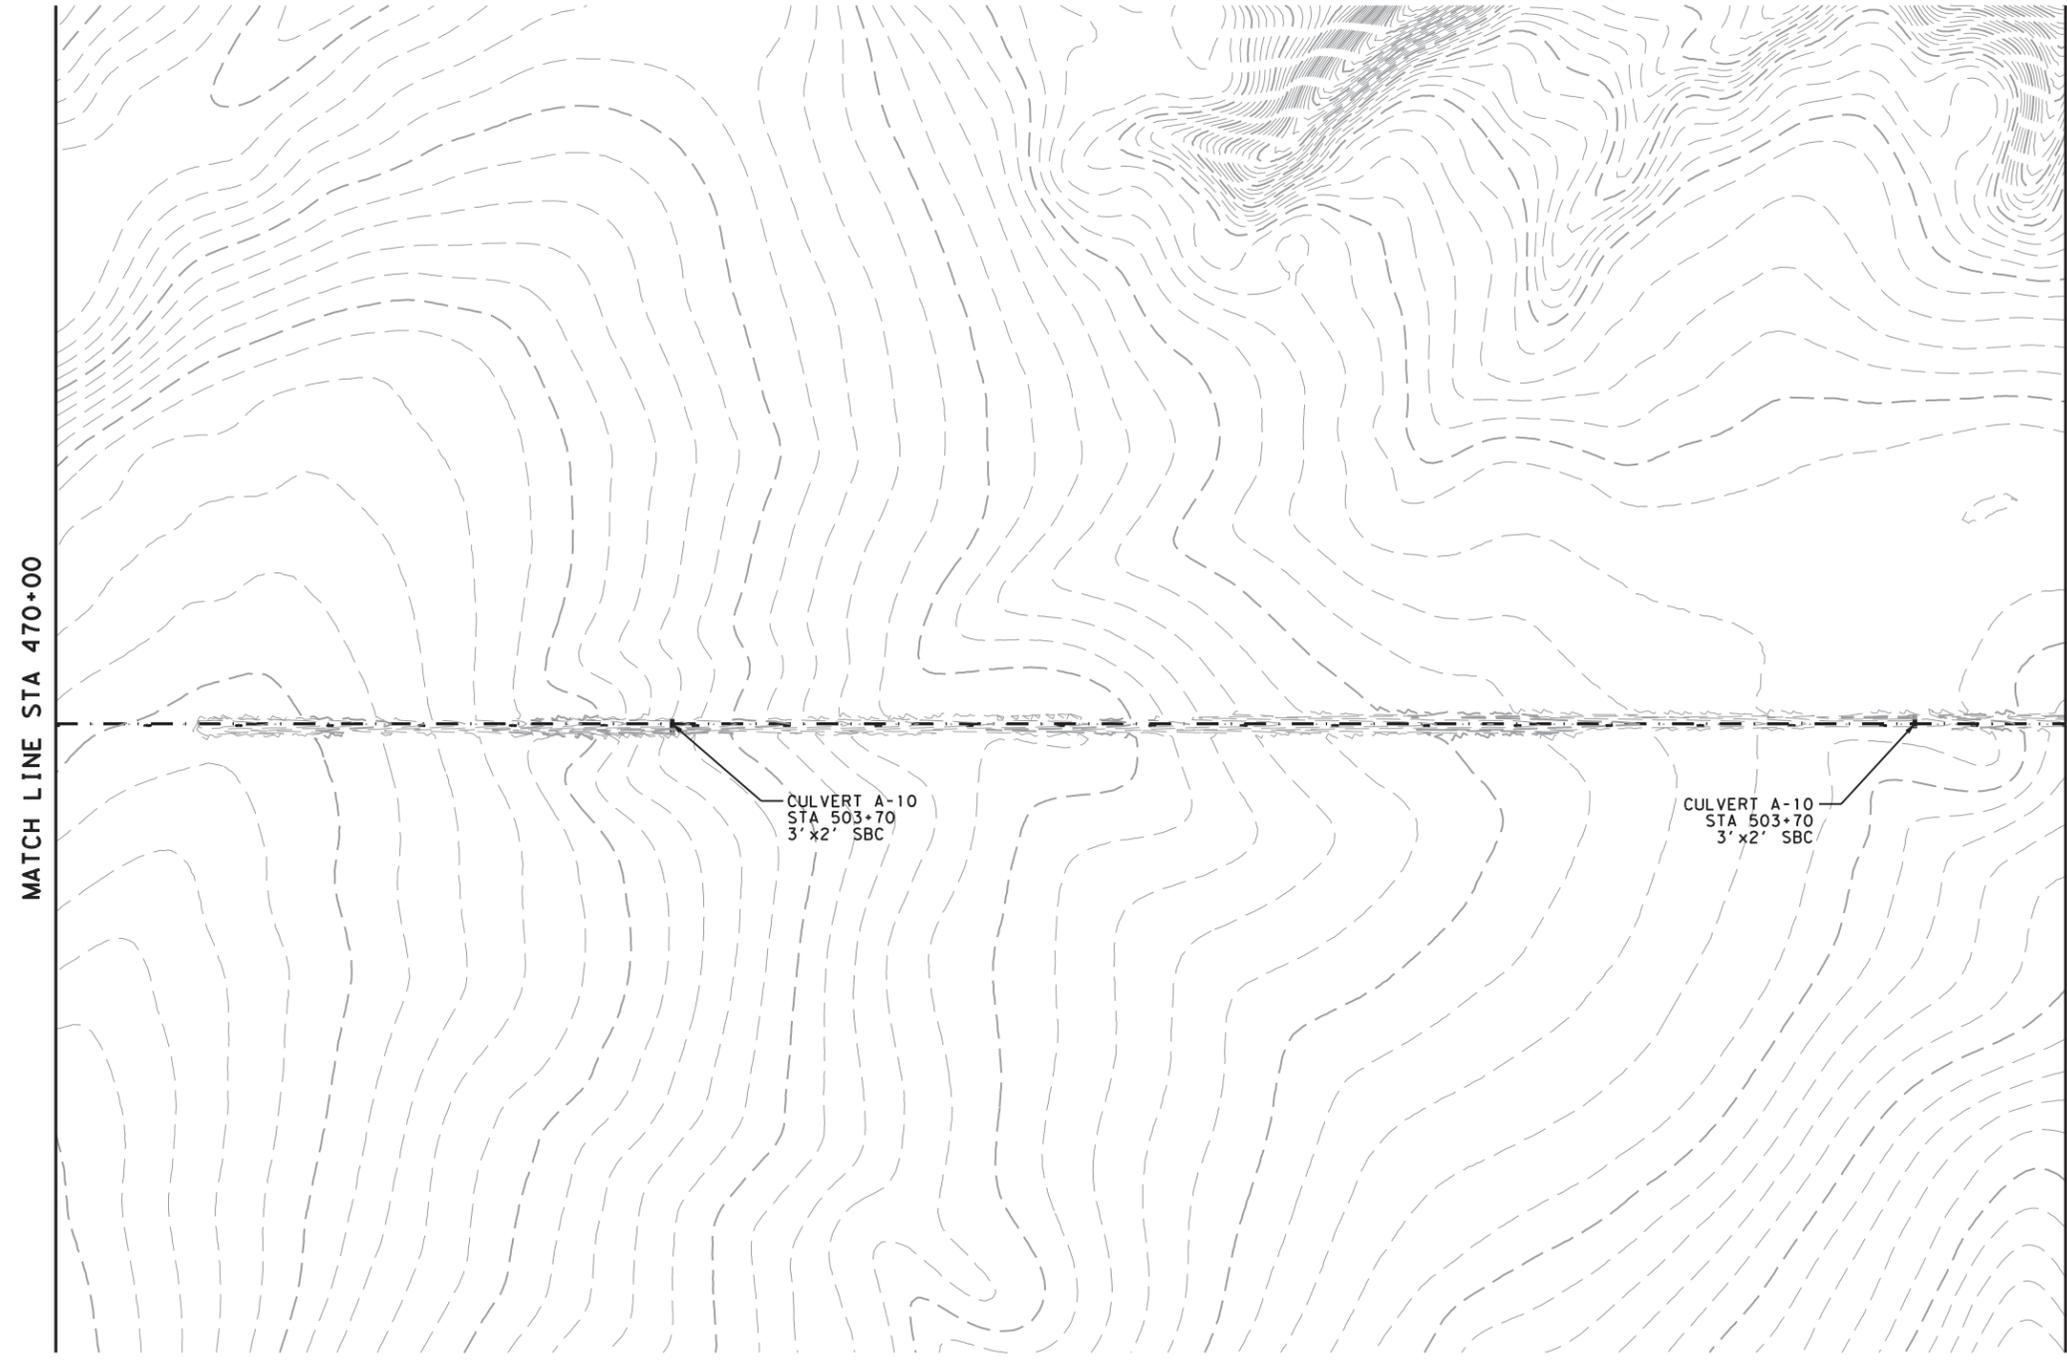

4/7/2021 7:27:30 AM F:\Proj\drain\2019\1004_TxDOT_5x5_P5&E\03_US60_Amar\1161616\US60-USTIN\511_3-Drainage\02-Sheets\US60_DRAIN-MAP-05.dgn

US60-DRAIN-MAP-05.dgn




LEGEND:

- A-XX AREA ID
- XXX.XX AREA (ACRES)
- DRAINAGE AREA BOUNDARY
- FLOW DIRECTION

NOTES:

1. CONTOURS DISPLAYED REFLECT 2018 USGS PANHANDLE LIDAR DEM.
2. CALCULATIONS ARE BASED ON TxDOT HYDRAULIC DESIGN MANUAL (SEPTEMBER 2019) PROCEDURES FOR THE RATIONAL METHOD FOR DRAINAGE AREAS UP TO 200 ACRES AND THE NRCS METHOD FOR DRAINAGE AREAS GREATER THAN 200 ACRES.
3. STRUCTURES WITH NO DEFINED DRAINAGE AREA BOUNDARY ARE EQUALIZERS CULVERTS.
4. TC IS DETERMINED BY THE NRCS METHOD

24-HR RAINFALL DEPTH					
2-YR	5-YR	10-YR	25-YR	50-YR	100-YR
2.9	2.9	4.7	5.5	6.2	6.7

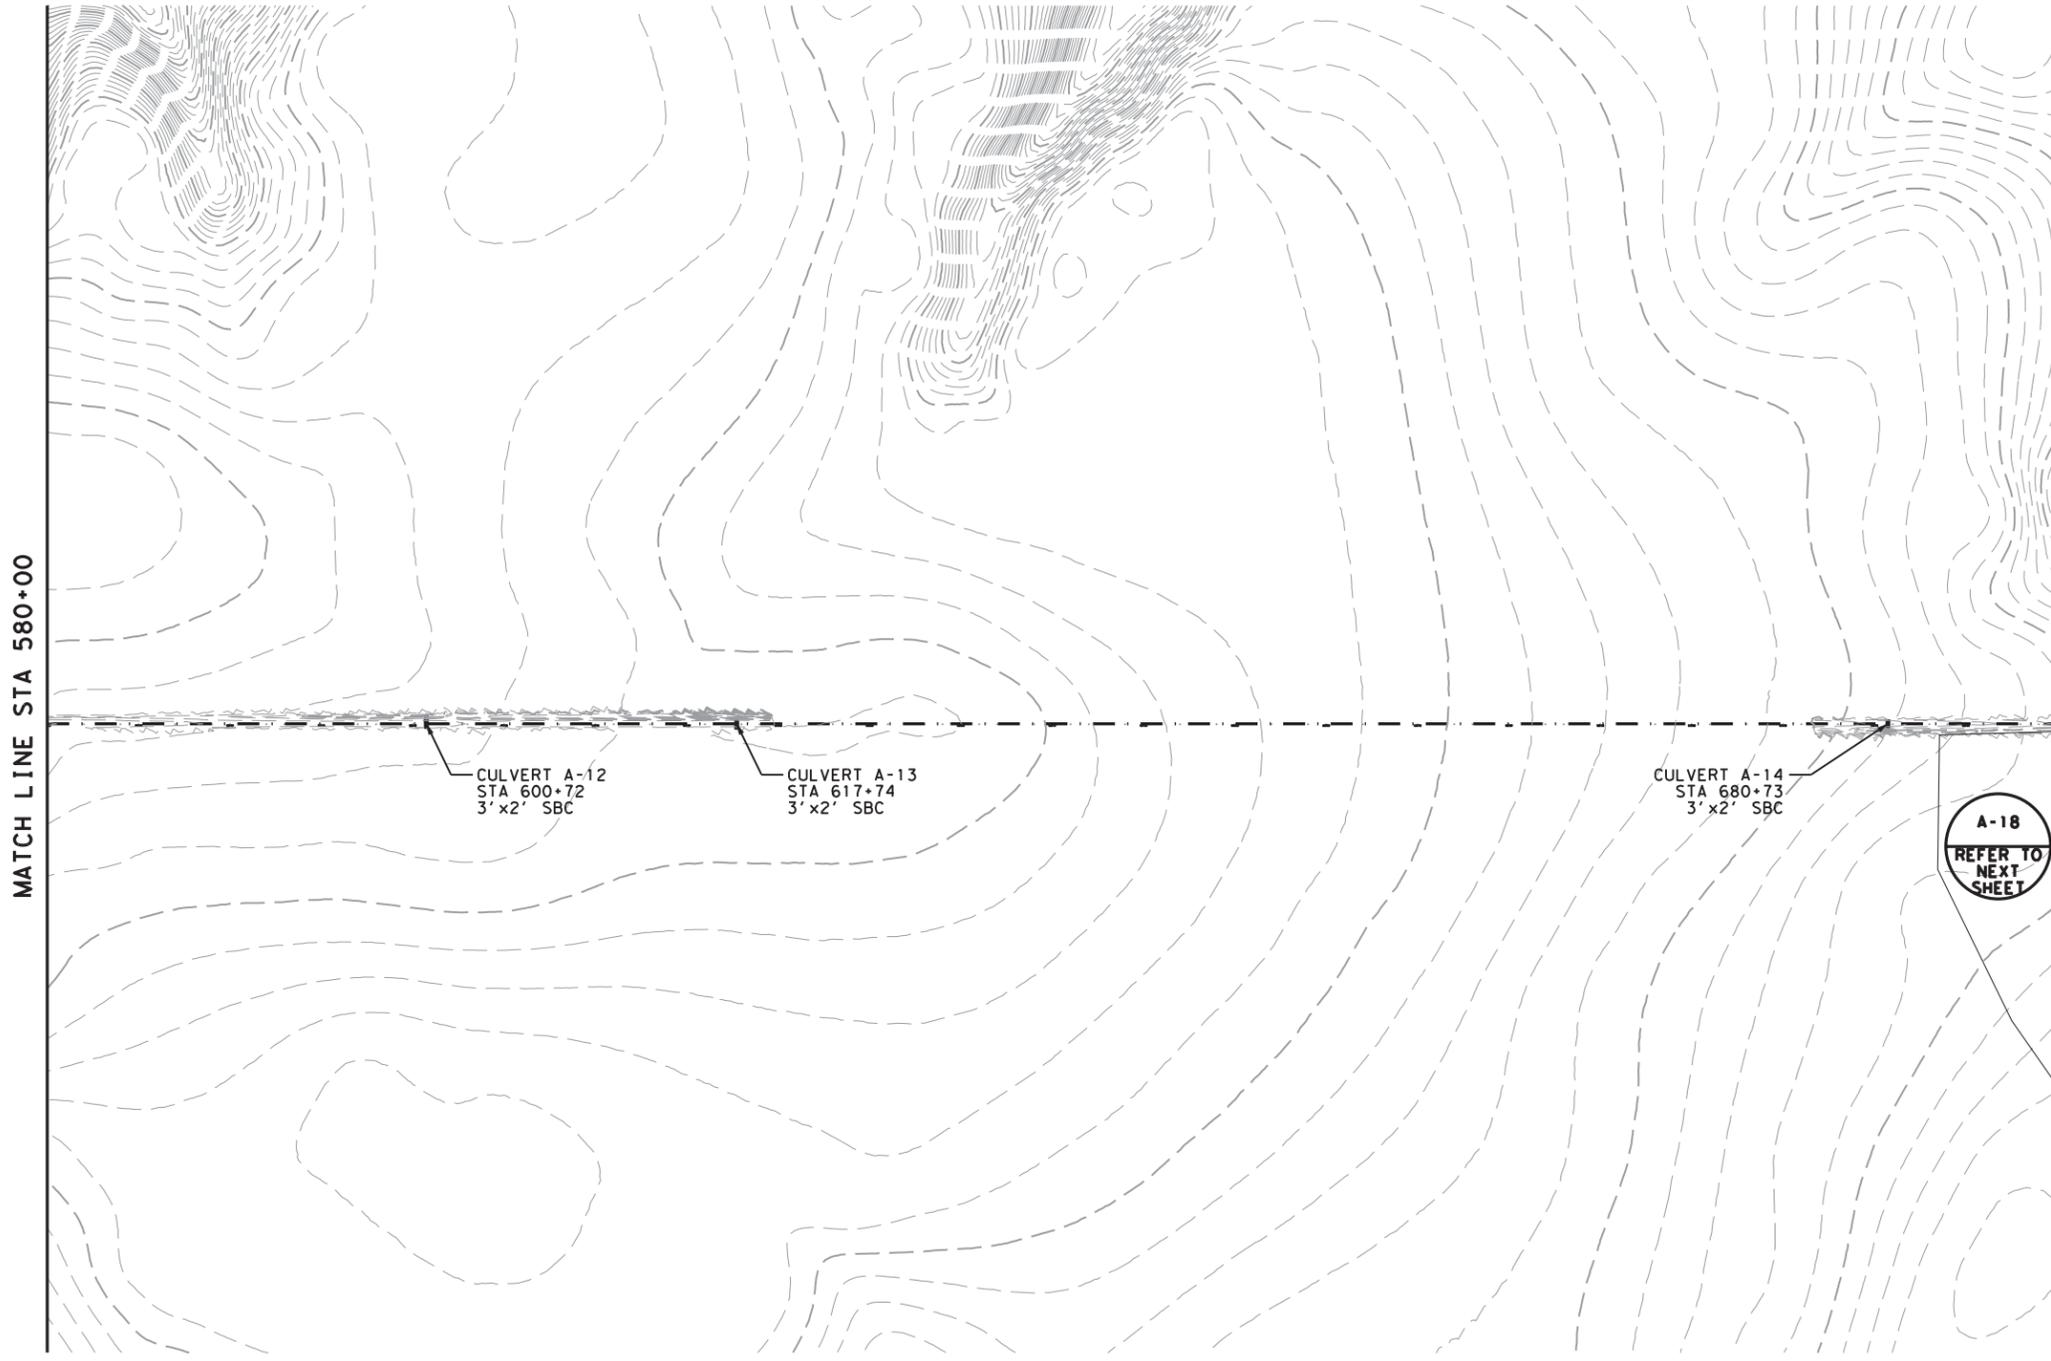

MATCH LINE STA 580+00

MATCH LINE STA 690+00

CULVERT A-12
STA 600+72
3'x2' SBC

CULVERT A-13
STA 617+74
3'x2' SBC

CULVERT A-14
STA 680+73
3'x2' SBC

A-18
REFER TO
NEXT
SHEET

04/07/2021



Bo L. Ratto



REV. NO.	DATE	DESCRIPTION	BY

CobbFendley 13430 Northwest Freeway, Ste. 1100
Houston, Texas 77040
713.462.3242
www.cobbendley.com




DRAINAGE AREA MAP

SHEET **6** OF **7**

FED. RD. DIV. NO.	STATE	PROJECT NO.		HIGHWAY NO.	
6	TEXAS	(SEE TITLE SHEET)		US60	
STATE DISTRICT	COUNTY	CONTROL NO.	SECTION NO.	JOB NO.	SHEET NO.
AMA	GRAY	0169	07	053, ETC	122

MATCH LINE STA 690+00

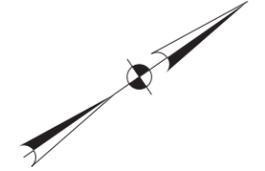

LEGEND:

- A-XX AREA ID
- XXX.XX AREA (ACRES)
- DRAINAGE AREA BOUNDARY
- FLOW DIRECTION

NOTES:

1. CONTOURS DISPLAYED REFLECT 2018 USGS PANHANDLE LIDAR DEM.
2. CALCULATIONS ARE BASED ON TxDOT HYDRAULIC DESIGN MANUAL (SEPTEMBER 2019) PROCEDURES FOR THE RATIONAL METHOD FOR DRAINAGE AREAS UP TO 200 ACRES AND THE NRCS METHOD FOR DRAINAGE AREAS GREATER THAN 200 ACRES.
3. STRUCTURES WITH NO DEFINED DRAINAGE AREA BOUNDARY ARE EQUALIZERS CULVERTS.
4. TC IS DETERMINED BY THE NRCS METHOD

24-HR RAINFALL DEPTH					
2-YR	5-YR	10-YR	25-YR	50-YR	100-YR
2.9	2.9	4.7	5.5	6.2	6.7

04/07/2021

Bo L. Ratto

0 250 500 1000

DA ID	DA AREA (acres)	C				WEIGHTED "C"	Tc CALC (min)	Tc (min)	2 YR		5 YR		10 YR		25 YR		50 YR		100 YR	
		PVMT 0.90	COMM 0.65	RESID 0.45	GROUND 0.25				INTENSITY (in/hr)	Q (cfs)										
		(none)	(min)	(min)	(in/hr)				(cfs)	(in/hr)	(cfs)									
A-15	25.23	-	-	-	25.23	0.25	60.69	61	1.5	9.2	2.0	12.3	2.3	14.7	2.7	17.1	3.1	19.8	3.4	21.2
A-16	11.45	-	-	-	11.45	0.25	20.69	21	2.9	8.3	3.9	11.1	4.6	13.2	5.4	15.4	6.2	17.8	6.7	19.2
A-17	3.78	-	-	-	3.78	0.25	11.21	11	4.0	3.8	5.3	5.0	6.3	6.0	7.4	7.0	8.5	8.1	9.2	8.7
A-19	14.93	-	-	-	14.93	0.25	22.79	23	2.8	10.3	3.7	13.7	4.4	16.3	5.1	19.1	5.9	22.0	6.4	23.7
A-20	5.54	-	-	-	5.54	0.25	53.65	54	1.6	2.2	2.1	3.0	2.5	3.5	3.0	4.1	3.4	4.7	3.7	5.1
A-21	22.99	-	-	-	22.99	0.25	131.78	132	0.8	4.7	1.1	6.3	1.3	7.5	1.5	8.7	1.8	10.1	1.9	10.8

DA ID	HYDROLOGY METHOD	DESIGN FREQUENCY	DRAINAGE AREA		TC MIN	Weighted CN	PEAK DISCHARGE					
			AC	SQ MI			2 YR	5 YR	10 YR	25 YR	50 YR	100 YR
			CFS	CFS			CFS	CFS	CFS	CFS		
A-18	SCS UNIT HYDROGRAPH	25 YR	1286.40	2.01	92.52	79	551.84	962.41	1317.55	1682.95	2010.69	2245.15

REV. NO.	DATE	DESCRIPTION	BY

CobbFendley 13430 Northwest Freeway, Ste. 1100
Houston, Texas 77040
713.462.3242
www.cobbendley.com



DRAINAGE AREA MAP

SHEET 7 OF 7

FED. RD. DIV. NO.	STATE	PROJECT NO.	HIGHWAY NO.
6	TEXAS	(SEE TITLE SHEET)	US60
STATE DISTRICT	COUNTY	CONTROL NO.	SECTION NO.
AMA	GRAY	0169	07
		JOB NO.	SHEET NO.
		053, ETC	123

4/7/2021 7:27:33 AM F:\Proj\drain\2019\1004_TxDOT_5x5_PSS&E\03_US60_Amari\16\EN\6500\UST\N\511_3_Drainage\02_Sheets\US60_DRAIN_MAP-07.dgn

CULVERT HYDRAULIC DATA (HY-8, v7.60)											COMMENTS
25 YR (DESIGN)											
US 60 STA	DESCRIPTION	DRAINAGE AREA ID	ALLOW HW FT	FLOW "Q" CFS	HW ELEV FT	HW DEPTH FT	TW ELEV FT	TW DEPTH FT	TW VEL FT/S	BYPASS RUNOFF CFS	
110+63	(EXIST) 3' x 2' x 46.73' SBC	A-1	-	-	-	-	-	-	-	-	EQUALIZER CULVERT
	(PROP) 3' x 2' x 75.40' SBC		-	-	-	-	-	-	-		
126+14	(EXIST) 3' x 119.58' CMP	A-2	3215.95	44.41	3214.55	2.81	3211.93	1.40	2.17	-	
183+59	(EXIST) 3' x 2' x 57.79' SBC	A-3	3211.20	27.78	3210.95	2.40	3209.68	1.71	1.65	-	
267+84	(EXIST) 3' x 2' x 60.77' SBC	A-4	3198.00	20.85	3196.58	2.50	3195.56	1.84	1.47	-	
289+05	(EXIST) 3' x 3' x 119.83' SBC	A-5	3187.25	136.12	3178.66	11.92	3166.10	1.94	5.12	-	
	(PROP) 3' x 3' x 135.68' SBC				3178.66	11.92	3166.10	1.94	5.12	-	
348+11	(EXIST) 3' x 2' x 53.66' SBC	A-6	3189.59	44.75	3187.96	1.33	3187.44	1.36	3.90	-	
	(PROP) 3' x 2' x 70.40' SBC				3188.00	1.28	3187.37	1.36	3.90	-	
370+44	(EXIST) 3' x 3' x 71.82' SBC	A-7	3186.58	66.20	3185.56	4.32	3183.00	2.41	2.24	-	
	(PROP) 3' x 3' x 79.31' SBC				3185.57	4.33	3182.90	2.31	2.24	-	
413+59	(EXIST) 3' x 2' x 58.67' SBC	A-8	3163.50	250.09	3163.52	3.79	3162.58	3.67	3.85	238.79	EQUALIZER CULVERT
449+61	(EXIST) 6' x 3.5' x 54.70' SBC	A-9	-	-	-	-	-	-	-	-	EQUALIZER CULVERT
503+73	(EXIST) 3' x 2' x 53.38' SBC	A-10	-	-	-	-	-	-	-	-	EQUALIZER CULVERT
	(PROP) 3' x 2' x 64.00' SBC				-	-	-	-	-	-	
571+74	(EXIST) 3' x 2' x 49.46' SBC	A-11	-	-	-	-	-	-	-	-	EQUALIZER CULVERT
	(PROP) 3' x 2' x 60.10' SBC				-	-	-	-	-	-	
600+72	(EXIST) 3' x 2' x 54.08' SBC	A-12	-	-	-	-	-	-	-	-	EQUALIZER CULVERT
	(PROP) 3' x 2' x 62.80' SBC				-	-	-	-	-	-	
617+74	(EXIST) 3' x 2' x 65.58' SBC	A-13	-	-	-	-	-	-	-	-	EQUALIZER CULVERT
680+73	(EXIST) 3' x 3' x 50.34' SBC	A-14	-	-	-	-	-	-	-	-	EQUALIZER CULVERT
750+19	(EXIST) 3' x 3' x 77.35' SBC	A-15	3082.10	17.09	3076.70	1.65	3072.45	0.98	2.52	-	
759+33	(EXIST) 3' x 3' x 84.15' SBC	A-16	3055.32	15.39	3046.21	2.05	3041.49	0.61	4.62	-	
762+12	(EXIST) 3' x 3' x 117.30' SBC	A-17	3047.56	7.40	3035.05	0.87	3020.43	0.41	3.91	-	
772+43	(EXIST) 2-12' x 10' x 162.25' MBC	A-18	3033.00	1682.95	3014.03	11.11	3008.90	6.17	6.10	-	
778+80	(EXIST) 3' x 3' x 149.52' SBC	A-19	3041.04	19.07	3026.82	22.48	3005.71	1.55	1.33	-	
785+06	(EXIST) 3' x 3' x 94.28' SBC	A-20	3055.66	4.09	3041.39	16.26	3007.48	0.35	2.67	-	
788+55	(EXIST) 3' x 3' x 132.30' SBC	A-21	3061.92	8.83	3041.79	1.05	3039.15	0.56	3.00	-	

NOTES:

- EDGE OF TRAVEL LANE ELEVATION OR DITCH HIGH POINT OR DITCH BLOCK ELEVATION IS USED AS ALLOWABLE HW ELEVATION.
- HY-8 VERSION 7.60 IS USED FOR HYDRAULIC ANALYSIS OF CULVERTS.

04/07/2021



Bo L. Ratto

REV. NO.	DATE	DESCRIPTION	BY

CobbFendley 13430 Northwest Freeway, Ste. 1100
Houston, Texas 77040
713.462.3242
www.cobbendley.com

 **Texas Department of Transportation**

CULVERT HYDRAULIC DATA SHEET

SHEET 1 OF 1



FED. RD. DIV. NO.	STATE	PROJECT NO.	HIGHWAY NO.
6	TEXAS	(SEE TITLE SHEET)	US60
STATE DISTRICT	COUNTY	CONTROL NO.	SECTION NO.
AMA	GRAY	0169	07
		JOB NO.	SHEET NO.
		053, ETC	124

4/7/2021 7:27:34 AM F:\Projects\2019\1004_TxDOT_5x5_PSS&E\03_US60_Amrt\16\ENG\500\UST\N\511_3-Drainage\02-Sheets\US60_CULV-DATA.dgn

US60_CULV-DATA.dgn

ITEM	DESCRIPTION	UNIT	QTY
432	RIPRAP (CONC) (4 IN)	CY	1
462	CONC BOX CULB (3FT x 2FT) (EXTEND)	LF	28
467	SET (TY 1) (S=3FT) (HW=2FT) (4:1) C	EA	2
496	REMOVE STR	EA	2


ITEM	DESCRIPTION	UNIT	QTY
432	RIPRAP (CONC) (4 IN)	CY	36
462	CONC BOX CULB (3FT x 3FT) (EXTEND)	LF	16
466	WINGWALL (PW-1) (HW=5FT)	EA	4
496	REMOVE STR	EA	2

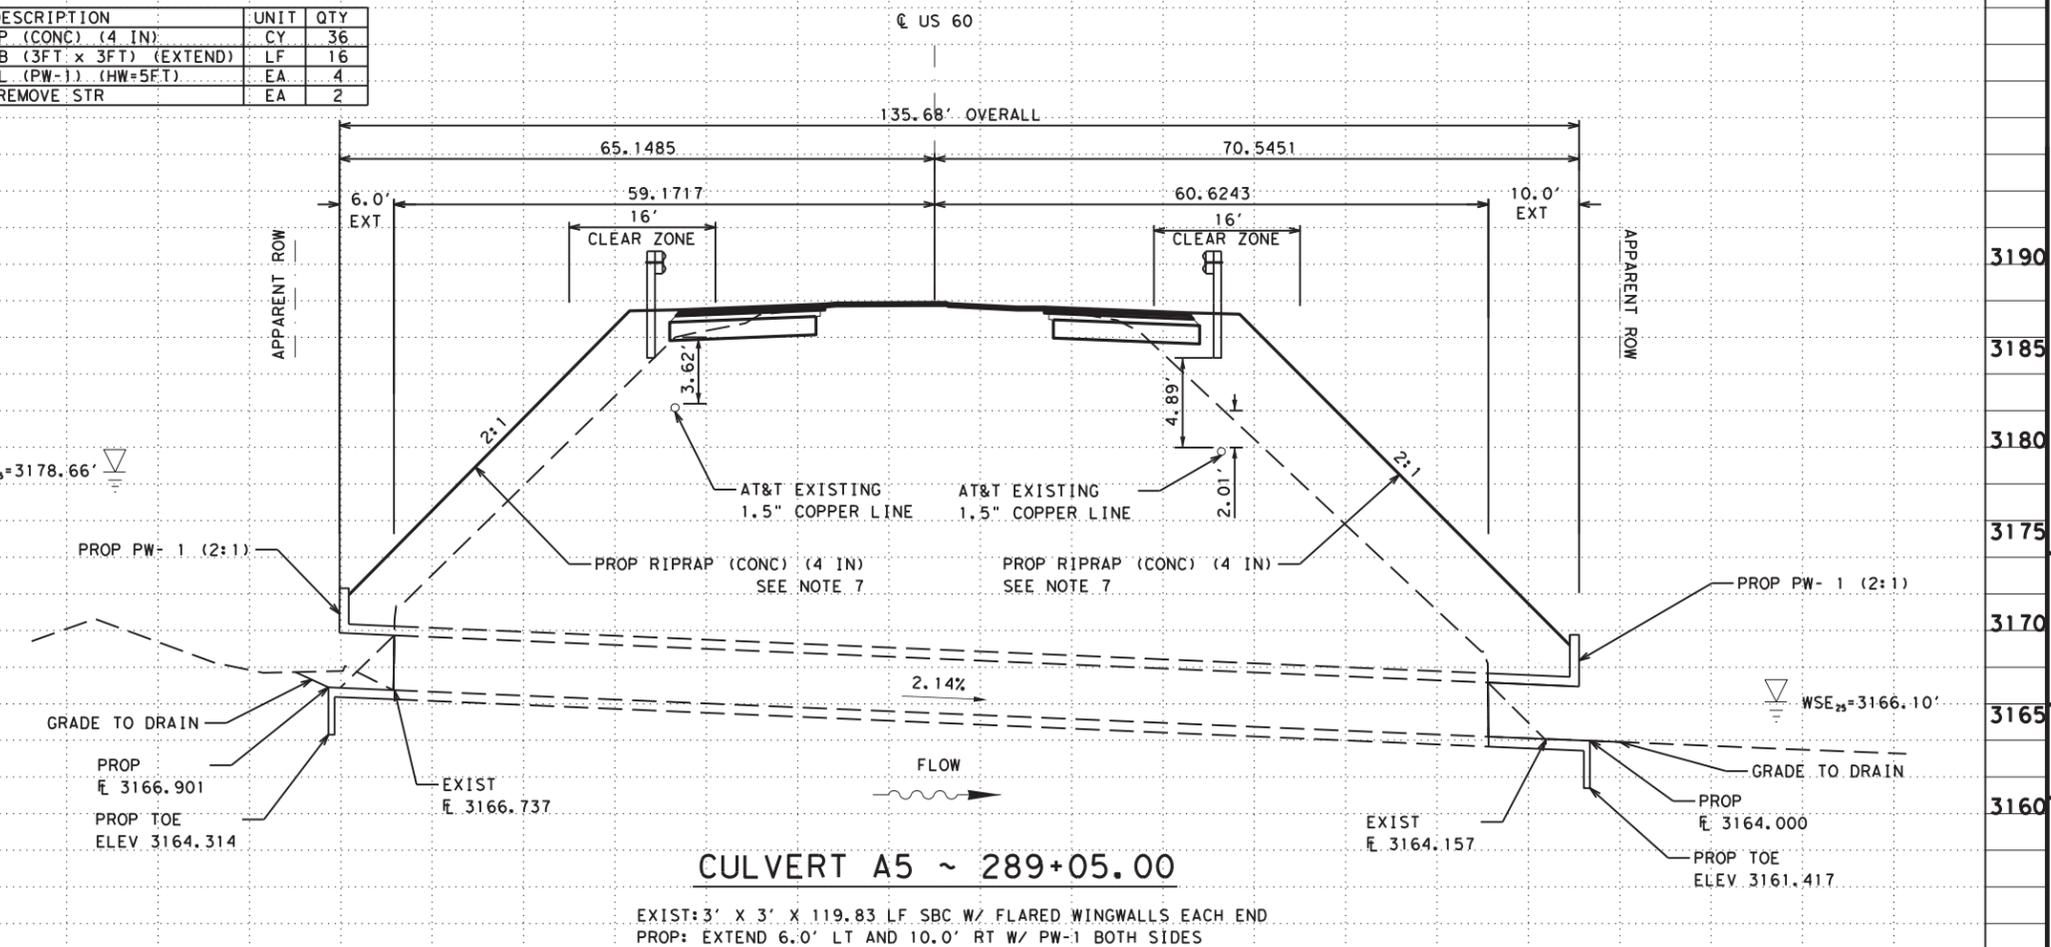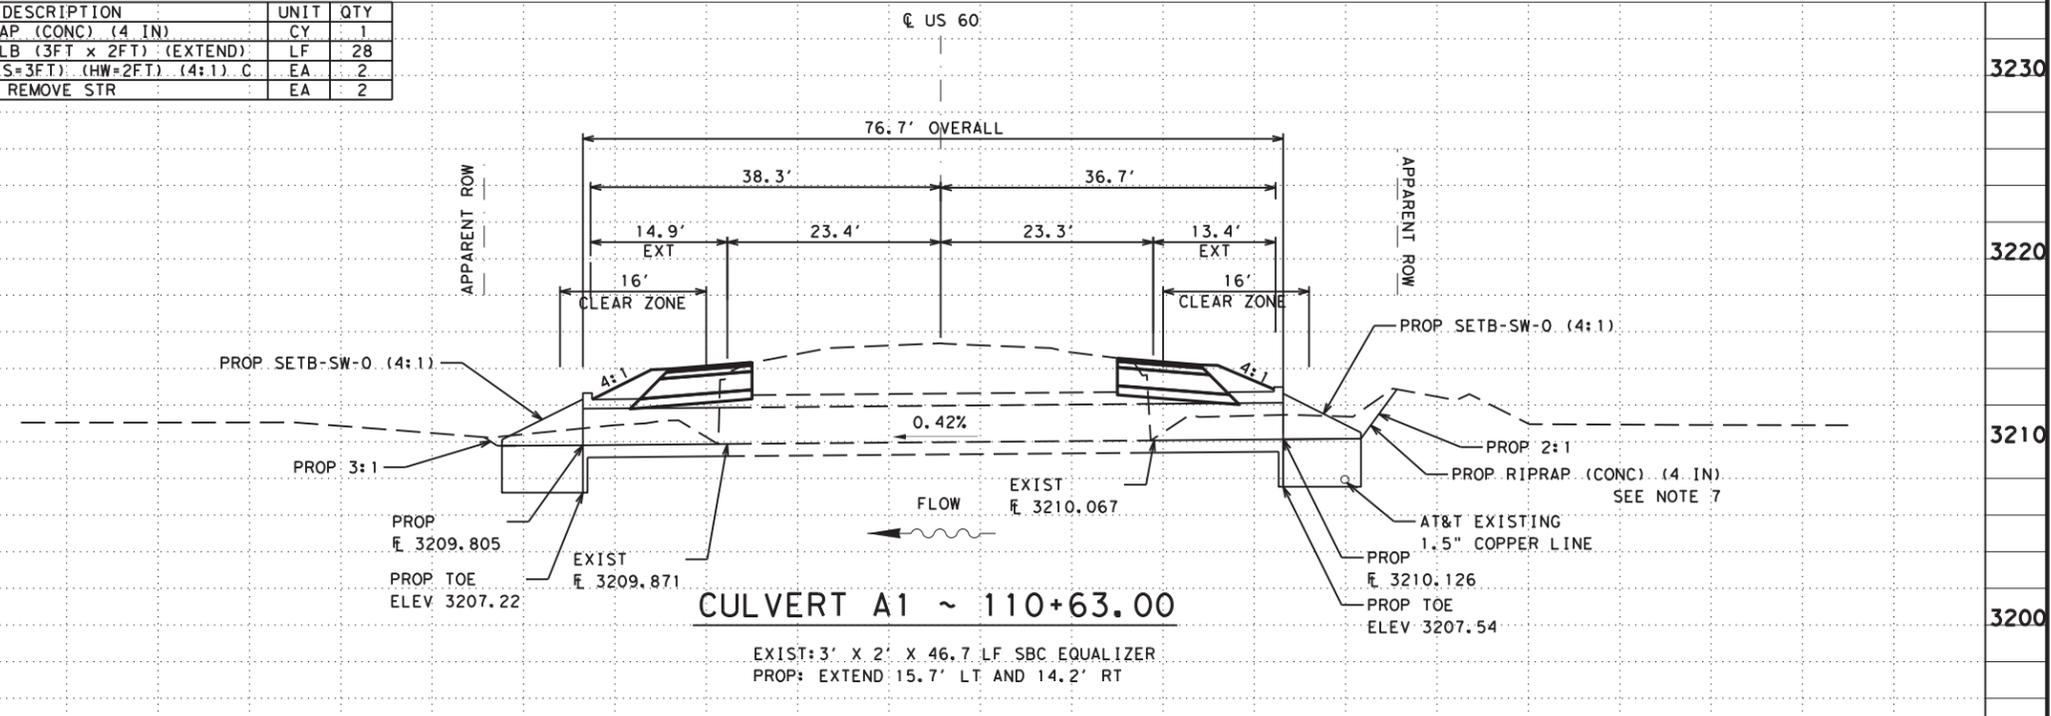

- NOTES:
- DEWATERING MAY BE REQUIRED FOR CULVERT EXTENSIONS.
 - REGRADE PARALLEL DITCHES TO FLOW TO PROPOSED CULVERT END ELEVATIONS AS NECESSARY.
 - REGRADE DITCHLINE TO ENSURE PROPER DRAINAGE.
 - CULVERT EXTENSION SHOULD MATCH THE EXISTING CULVERT FLOWLINES AND SLOPES UNLESS OTHERWISE NOTED.
 - SEE DRAINAGE AREA MAP FOR HYDROLOGIC DATA.
 - SEE CULVERT HYDRAULIC SHEET FOR HYDRAULIC DATA.
 - SEE ROADWAY P&P SHEETS FOR CONCRETE RIPRAP DIMENSIONS.

04/07/2021

Bo L Ratto

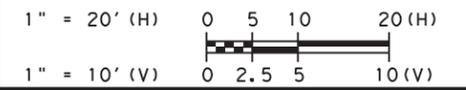

CobbFendley
 TBPE Firm Registration No. 274
 TBPLS Firm Registration No. 100467
 13430 Northwest Freeway, Suite 1100
 Houston, Texas 77040
 713.462.3242 | fax 713.462.3262
 www.cobbfendley.com




CULVERT EXTENSION LAYOUTS

FED. RD. DIV. NO.		STATE		PROJECT NO.		HIGHWAY NO.	
6		TEXAS		(SEE TITLE SHEET)		US60	
STATE DISTRICT	COUNTY	CONTROL NO.	SECTION NO.	JOB NO.	SHEET NO.		
AMA	GRAY	0169	07	053, ETC	125		

4/7/2021 F:\Projects\2019\1004_TxDOT_5x5_P&E\03_US60_Amarillo\ENGIN\500-UST\1\11_S11_3-DRAINAGE\02-Sheets\US60_DRAW-CULVERTS-SHEETS.dgn 7:27:34 AM

US60-DRAW-CULVERTS-SHEETS.dgn

ITEM	DESCRIPTION	UNIT	QTY
462	CONC BOX CULB (3FT x 2FT) (EXTEND)	LF	11
467	SET (TY 1) (S=3FT) (HW=2FT) (4:1) C	EA	1
496	REMOVE STR	EA	1

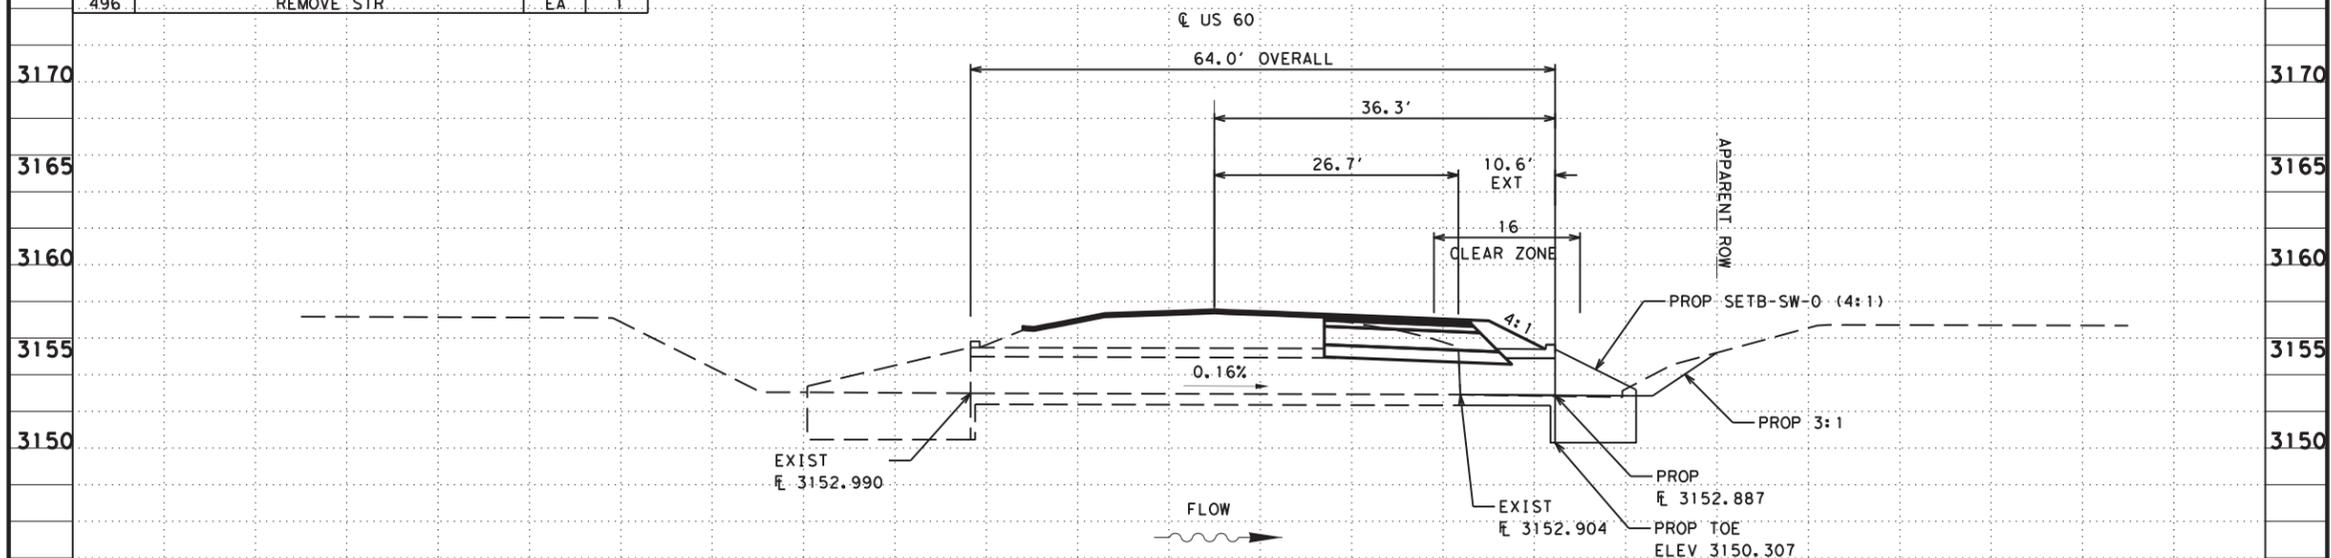


CULVERT A10 ~ 503+73.00

EXIST: 3' X 2' X 53.4 LF SBC
 PROP: EXTEND 10.6' RT

- NOTES:
1. DEWATERING MAY BE REQUIRED FOR CULVERT EXTENSIONS.
 2. REGRADE PARALLEL DITCHES TO FLOW TO PROPOSED CULVERT END ELEVATIONS AS NECESSARY.
 3. REGRADE DITCHLINE TO ENSURE PROPER DRAINAGE.
 4. CULVERT EXTENSION SHOULD MATCH THE EXISTING CULVERT FLOWLINES AND SLOPES UNLESS OTHERWISE NOTED.
 5. SEE DRAINAGE AREA MAP FOR HYDROLOGIC DATA.
 6. SEE CULVERT HYDRAULIC SHEET FOR HYDRAULIC DATA.
 7. SEE ROADWAY P&P SHEETS FOR CONCRETE RIPRAP DIMENSIONS.

ITEM	DESCRIPTION	UNIT	QTY
462	CONC BOX CULB (3FT x 2FT) (EXTEND)	LF	11
467	SET (TY 1) (S=3FT) (HW=2FT) (4:1) C	EA	1
496	REMOVE STR	EA	1

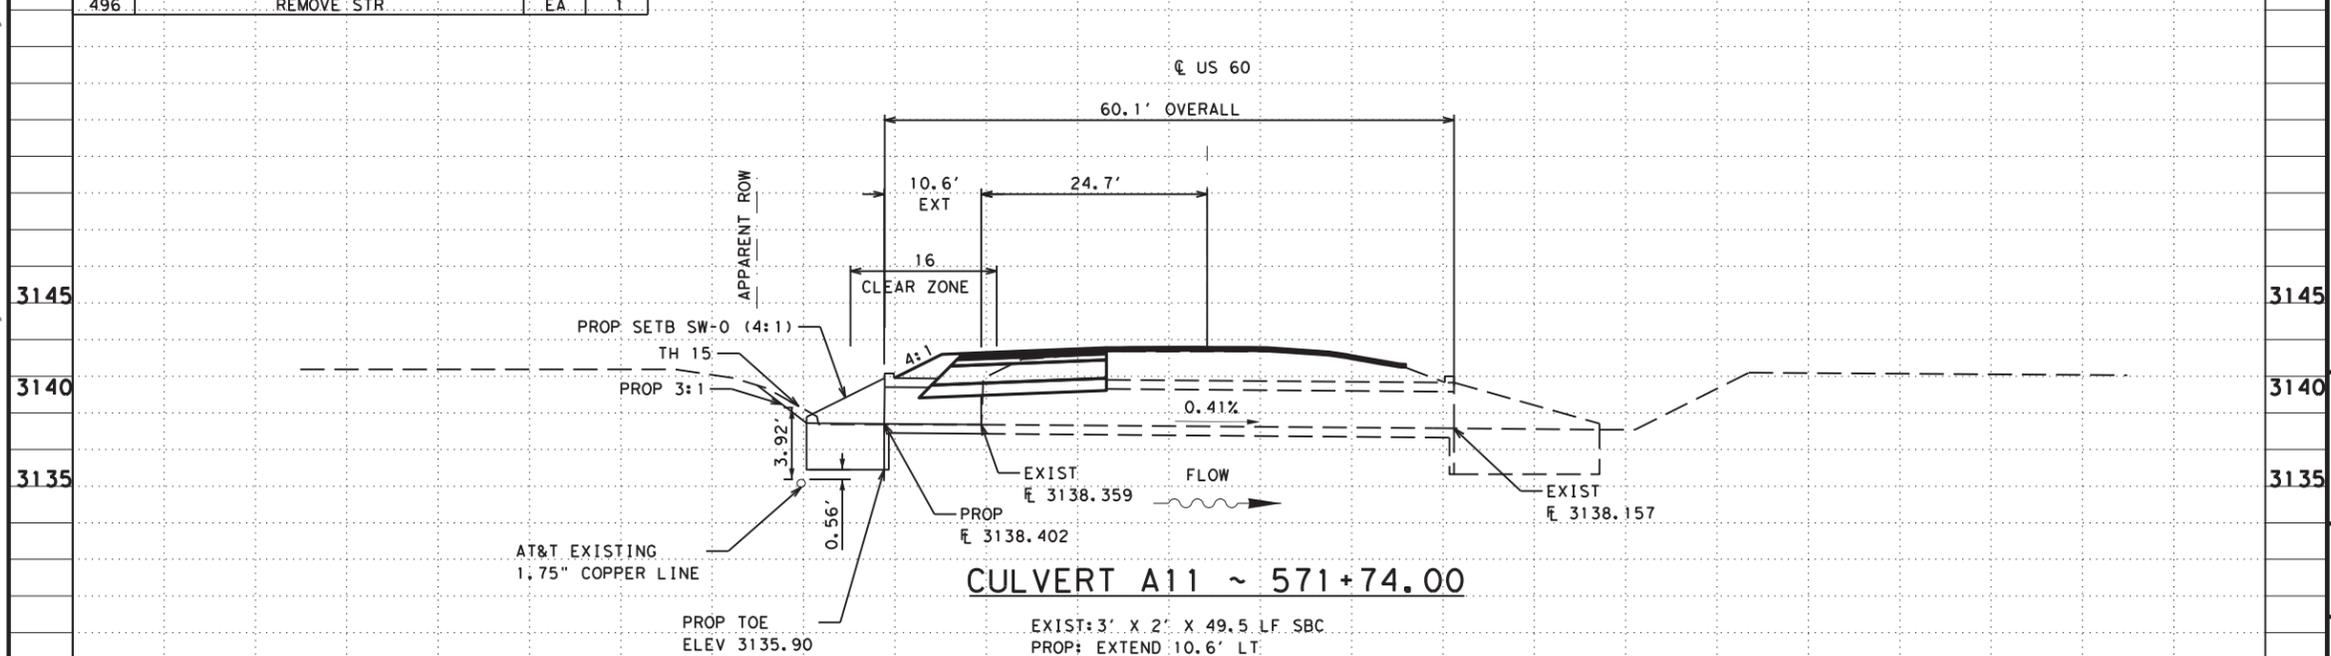


CULVERT A11 ~ 571+74.00

EXIST: 3' X 2' X 49.5 LF SBC
 PROP: EXTEND 10.6' LT

04/07/2021

Bo L. Ratto

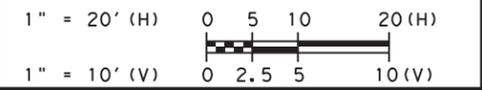

CobbFendley
 TBPE Firm Registration No. 274
 TBPLS Firm Registration No. 100467
 13430 Northwest Freeway, Suite 1100
 Houston, Texas 77040
 713.462.3242 | fax 713.462.3262
 www.cobbhendley.com

Texas Department of Transportation

CULVERT EXTENSION LAYOUTS

SHEET 3 OF 4

FED. RD. DIV. NO.	STATE	PROJECT NO.	HIGHWAY NO.
6	TEXAS	(SEE TITLE SHEET)	US60
STATE DISTRICT	COUNTY	CONTROL NO.	SECTION NO.
AMA	GRAY	0169	07
		JOB NO.	SHEET NO.
		053, ETC	127


4/7/2021 7:27:35 AM F:\Projects\2019\1004_TxDOT_5x5_P&P\03_US60_Amarillo\ENGIN\500\UST\N\Sil_3_Drainage\02_Sheets\US60_DRAIN_CULVERTS-SHEETS.dgn

ITEM	DESCRIPTION	UNIT	QTY
462	CONC BOX CULB (3FT x 2FT) (EXTEND)	LF	9
467	SET (TY 1) (S=3FT) (HW=2FT) (4:1) C	EA	1
496	REMOVE STR	EA	1

NOTES:

1. DEWATERING MAY BE REQUIRED FOR CULVERT EXTENSIONS.
2. REGRADE PARALLEL DITCHES TO FLOW TO PROPOSED CULVERT END ELEVATIONS AS NECESSARY.
3. REGRADE DITCHLINE TO ENSURE PROPER DRAINAGE.
4. CULVERT EXTENSION SHOULD MATCH THE EXISTING CULVERT FLOWLINES AND SLOPES UNLESS OTHERWISE NOTED.
5. SEE DRAINAGE AREA MAP FOR HYDROLOGIC DATA.
6. SEE CULVERT HYDRAULIC SHEET FOR HYDRAULIC DATA.
7. SEE ROADWAY P&P SHEETS FOR CONCRETE RIPRAP DIMENSIONS.

4/7/2021 F:\Projects\2019\1004_TxDOT_5x5_PSS&E\03_US60_Amarillo\EN\6500-UST\1\1\1_S11_3_Drainage\02_Sheets\US60_DRAIN_CULVERTS-SHEETS.dgn 7:27:35 AM

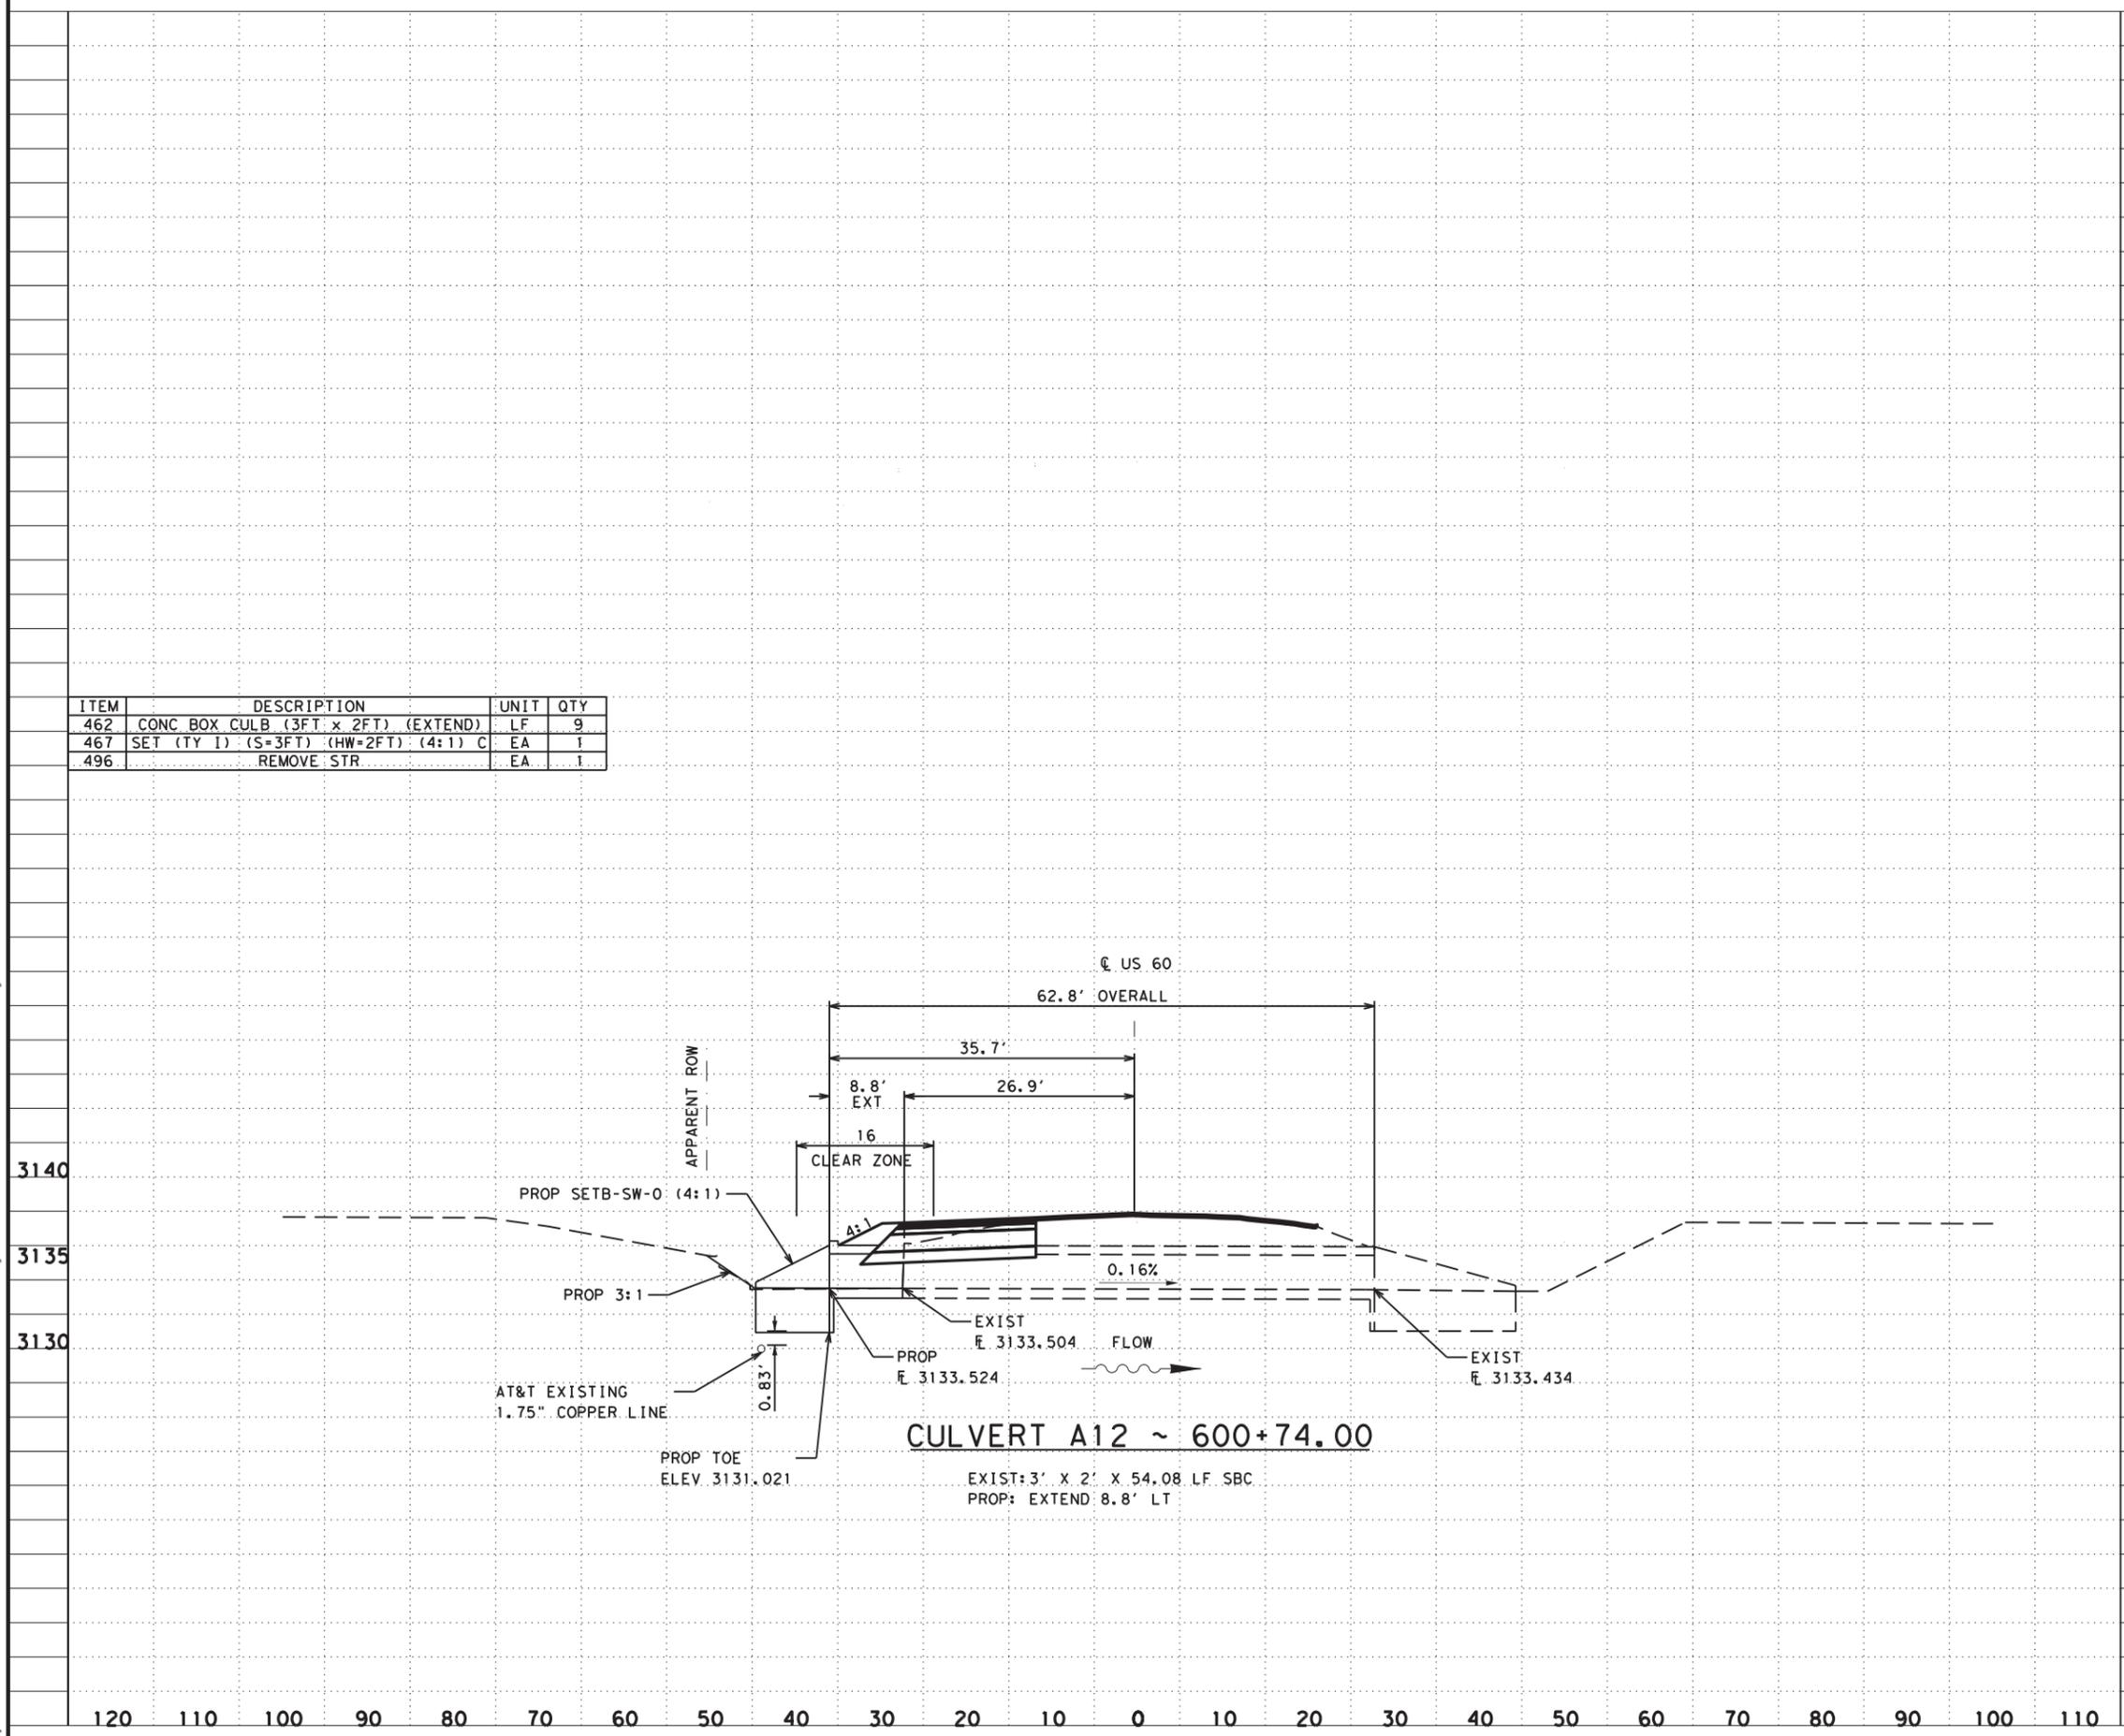

04/07/2021
 STATE OF TEXAS
 BO L. RATTO
 113226
 LICENSED PROFESSIONAL ENGINEER
Bo L Ratto



CobbFendley
 TBPE Firm Registration No. 274
 TBPLS Firm Registration No. 100467
 13430 Northwest Freeway, Suite 1100
 Houston, Texas 77040
 713.462.3242 | fax 713.462.3262
 www.cobbfendley.com

Texas Department of Transportation

CULVERT EXTENSION LAYOUTS

SHEET 4 OF 4

FED. RD. DIV. NO.	STATE	PROJECT NO.	HIGHWAY NO.
6	TEXAS	(SEE TITLE SHEET)	US60
STATE DISTRICT	COUNTY	CONTROL NO.	SECTION NO.
AMA	GRAY	0169	07
		JOB NO.	SHEET NO.
		053, ETC	128

US60-DRAIN-CULVERTS-SHEETS.dgn

DISCLAIMER: The use of this standard is governed by the "Texas Engineering Practice Act". No warranty of any kind is made by TxDOT for any purpose whatsoever. TxDOT assumes no responsibility for the conversion of units or for errors or omissions in this standard or for any consequences resulting therefrom.

DATE: 4/7/2021 7:27:36 AM
 FILE: F:\Projects\2019\11004.TxDOT_5x5_PS&E_V03_US60_Amar_11104.LENG.500-USTN.5111004.dgn

Culvert Station and/or Creek Name followed by applicable end (Lt, Rt or Both)	Description of Box Culvert No. Spans ~ Span X Height	Max Fill Height (Ft)	Applicable Box Culvert Standard (4)	Applicable Wingwall or End Treatment Standard	Skew Angle (0°, 15°, 30° or 45°)	Side Slope or Channel Slope Ratio (SL:1)	T Culvert Top Slab Thickness (In)	U Culvert Wall Thickness (In)	C Estimated Curb Height (Ft)	Hw Height of Wingwall (Ft) (1)	A Curb to End of Wingwall (Ft)	B Offset of End of Wingwall (Ft)	Lw Length of Longest Wingwall (Ft)	Ltw Culvert Toewall Length (Ft)	Atw Anchor Toewall Length (Ft)	Riprap Apron (CY)	Class "C" Conc (Curb) (CY) (2)	Class "C" Conc (Wingwall) (CY) (3)	Total Wingwall Area (SF)
STA: 110+63 (CULV - A1) (Both)	1 ~ 3'x2'	2.7'	SCC-3&4	SETB-SW0	0°	4:1	8"	7"	0.250'	2.667'	N/A	N/A	9.333'	4.167'	3.000'	0.0	0.0	5.4	N/A
STA: 289+05 (CULV - A5) (Both)	1 ~ 3'x3'	19'	SCC-3&4	PW-1	0°	2:1	8"	7"	2.250'	5.197'	N/A	N/A	11.833'	4.167'	N/A	0.0	0.6	18.0	280
STA: 348+11 (CULV - A6) (Both)	1 ~ 3'x2'	2.8'	SCC-3&4	SETB-SW0	0°	4:1	8"	7"	0.250'	2.667'	N/A	N/A	9.333'	4.167'	3.000'	0.0	0.0	5.4	N/A
STA: 370+44 (CULV - A7) (Lt)	1 ~ 5'x3'	3.1'	SCC-5&6	SETB-SW0	0°	4:1	8"	7"	0.250'	3.667'	N/A	N/A	13.333'	6.167'	5.000'	0.0	0.1	4.3	N/A
STA: 503+73 (CULV - A10) (Rt)	1 ~ 3'x2'	1.8'	SCC-3&4	SETB-SW0	0°	4:1	8"	7"	0.250'	2.667'	N/A	N/A	9.333'	4.167'	3.000'	0.0	0.0	2.7	N/A
STA: 571+74 (CULV - A11) (Lt)	1 ~ 3'x2'	1.9'	SCC-3&4	SETB-SW0	0°	4:1	8"	7"	0.250'	2.667'	N/A	N/A	9.333'	4.167'	3.000'	0.0	0.0	2.7	N/A
STA: 600+74 (CULV - A12) (Lt)	1 ~ 3'x2'	1.6'	SCC-3&4	SETB-SW0	0°	4:1	8"	7"	0.250'	2.667'	N/A	N/A	9.333'	4.167'	3.000'	0.0	0.0	2.7	N/A

NOTES:

Skew = 0° on SW-0, FW-0, SETB-CD, SETB-SW-0, and SETB-FW-0 standard sheets; 30° maximum for safety end treatment

SL:1 = Horizontal : 1 Vertical

- Side slope at culvert for flared or straight wingwalls.
- Channel slope for parallel wingwalls.
- Slope must be 3:1 or flatter for safety end treatments.

T = Box culvert top slab thickness. Dimension can be found on the applicable box culvert standard sheet.

U = Box culvert wall thickness. Dimension can be found on the applicable box culvert standard sheet.

C = Curb height

See applicable wing or end treatment standard sheets for calculations of Hw, A, B, Lw, Ltw, Atw, and Total Wingwall Area.

Hw = Height of wingwall

A = Distance from face of curb to end of wingwall (not applicable to parallel or straight wingwalls)

B = Offset of end of wingwall (not applicable to parallel or straight wingwalls)

Lw = Length of longest wingwall.

Ltw = Length of culvert toewall (not applicable when using riprap apron)

Atw = Length of anchor toewall (applicable to safety end treatment only)

Total Wingwall Area = Wingwall area in sq. ft. for two wingwalls (one structure end) if Lt or Rt. Area for four wingwalls (two structure ends) if Both.

- Round the wall heights shown to the nearest foot for bidding purposes.
- Concrete volume shown is for box culvert curb only. For curbs using the Box Culvert Rail Mounting Details (RAC) standard sheet quantities shown must be increased by a factor of 2.25. If Class S concrete is required for the top slab of the culvert, also provide Class S concrete for the curb. Curb concrete is considered part of the Box Culvert for payment.
- Concrete volume shown is total of wings, footings, culvert toewall (if any), anchor toewalls (if any) and wingwall toewalls. Riprap aprons, culverts, and curb quantities are not included.
- Regardless of the type of culvert shown on this sheet, the Contractor has the option of furnishing cast-in-place or precast culverts unless otherwise shown elsewhere on the plans. If the Contractor elects to provide culverts of a different type than those shown on this sheet, it is the Contractor's responsibility to make the necessary adjustments to the dimensions and quantities shown.

SPECIAL NOTE:

This sheet is a supplement to the box culvert standards. It is to be filled out by the culvert specifier and provides dimensions for the construction of the box culvert wingwalls and safety end treatments.

An Excel 2010 spreadsheet to assist in completing this table can be downloaded from the Bridge Standards (English) web page on the TxDOT web site. The completed sheet must be signed, sealed, and dated by a licensed Professional Engineer.

04/07/2021

 Bo L. Ratto

				Bridge Division Standard	
BOX CULVERT SUPPLEMENT WINGS AND END TREATMENTS					
BCS					
FILE:	bcsstd1-20.dgn	DN:	TxDOT	CK:	TxDOT
REVISIONS	0169	07	053, ETC	US60	
DIST:	AMA	COUNTY:	GRAY	SHEET NO.:	129

DATE: 4/7/2021 7:27:36 AM
 FILE: F:\Projects\2019\11004.TxDOT_5x5_PS&E\03_US60_Amarillo\ENGL\500-USTN\51 this is the same as the previous one but with the correct title block
 DISCLAIMER: The use of this standard is governed by the "Texas Engineering Practice Act". No warranty of any kind is made by TxDOT for any purpose whatsoever. TxDOT assumes no responsibility for the conversion of units or for the accuracy of the information provided herein.

TABLE OF DIMENSIONS AND REINFORCING STEEL
(Wings for one structure end)




Maximum Wingwall Height Hw	Dimensions				Variable Reinforcing				Estimated Quantities per ft of wing (2-wings)		Estimated Quantities per ft of Toewall (1-toewall)	
	W	X	Y	Z	Bars J1		Bars J2		Reinf (Lb/Ft)	Conc (CY/Ft)	Reinf (Lb/Ft)	Conc (CY/Ft)
					Size	Spa	Size	Spa				
2'-6"	2'-10"	10"	1'-0"	7"	#4	1'-0"	#4	1'-0"	48.64	0.406	6.85	0.071
2'-9"	2'-10"	10"	1'-0"	7"	#4	1'-0"	#4	1'-0"	49.31	0.424	6.85	0.071
3'-0"	2'-10"	10"	1'-0"	7"	#4	1'-0"	#4	1'-0"	49.98	0.444	6.85	0.071
3'-3"	2'-10"	10"	1'-0"	7"	#4	1'-0"	#4	1'-0"	53.32	0.462	6.85	0.071
3'-6"	2'-10"	10"	1'-0"	7"	#4	1'-0"	#4	1'-0"	53.98	0.480	6.85	0.071
4'-0"	3'-2"	1'-2"	1'-0"	7"	#4	1'-0"	#4	1'-0"	55.77	0.532	6.85	0.071
4'-6"	3'-2"	1'-2"	1'-0"	7"	#4	1'-0"	#4	1'-0"	59.77	0.568	6.85	0.071
5'-0"	3'-9"	1'-7"	1'-2"	7"	#4	1'-0"	#4	1'-0"	63.45	0.632	6.96	0.075
5'-6"	3'-9"	1'-7"	1'-2"	7"	#4	1'-0"	#4	1'-0"	67.46	0.668	6.96	0.075
6'-0"	4'-4"	2'-0"	1'-4"	7"	#5	1'-0"	#5	1'-0"	80.67	0.730	7.07	0.078
6'-6"	4'-4"	2'-0"	1'-4"	7"	#5	1'-0"	#5	1'-0"	85.05	0.768	7.07	0.078
7'-0"	5'-0"	2'-3"	1'-9"	8"	#5	1'-0"	#5	1'-0"	92.15	0.864	8.07	0.093
7'-6"	5'-0"	2'-3"	1'-9"	8"	#5	1'-0"	#5	1'-0"	96.54	0.902	8.07	0.093
8'-0"	5'-6"	2'-8"	1'-10"	8"	#5	6"	#5	6"	139.04	0.962	8.13	0.095
8'-6"	5'-6"	2'-8"	1'-10"	8"	#5	6"	#5	6"	144.47	1.000	8.13	0.095
9'-6"	6'-0"	2'-10"	2'-2"	9"	#5	6"	#5	6"	156.93	1.136	8.41	0.110
10'-6"	6'-5"	3'-0"	2'-5"	9"	#6	6"	#5	6"	196.27	1.234	8.57	0.117
11'-6"	7'-2"	3'-6"	2'-8"	11"	#6	6"	#6	6"	230.13	1.438	9.52	0.140
12'-6"	7'-8"	3'-9"	2'-11"	1'-0"	#7	6"	#6	6"	283.41	1.592	9.74	0.157
13'-6"	8'-2"	4'-0"	3'-2"	1'-2"	#8	6"	#6	6"	348.72	1.804	10.02	0.186
14'-6"	8'-10"	4'-5"	3'-5"	1'-4"	#9	6"	#6	6"	432.94	2.046	10.30	0.218
15'-6"	9'-6"	4'-10"	3'-8"	1'-6"	#9	6"	#7	6"	489.52	2.302	11.24	0.253
16'-0"	9'-11"	5'-0"	3'-11"	1'-7"	#9	6"	#7	6"	505.72	2.448	11.47	0.279

TABLE OF WINGWALL REINFORCING
(2-wings)

Bar	Size	No.	Spa
D1	#6	~	1'-0"
D2	#6	~	1'-0"
E1	#4	~	1'-0"
F	#4	~	1'-0"
G	#6	~	8"
M1	#4	4	~
P	#4	~	1'-0"
V	#4	~	1'-0"

TABLE OF TOEWALL REINFORCING

Bar	Size	No.	Spa
J3	#4	~	1'-0"
M2	#4	2	~
E2	#4	~	1'-0"

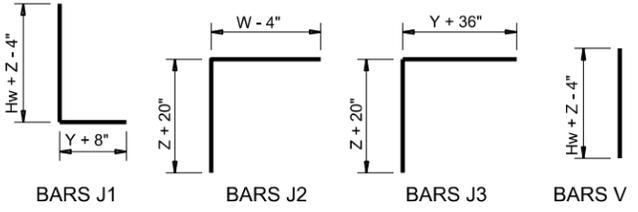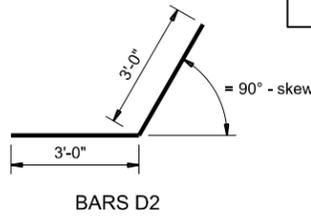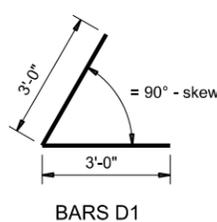

WING DIMENSION FORMULAS:
(All values are in feet.)

Hw = H + T + C
 Lw = (Hw) (SL) + cosine (θ) for Type PW-1
 = (Hw - 1') (SL) + cosine (θ) for Type PW-2 and Hw 4'
 = (Hw - 0.5') (SL) + cosine (θ) for Type PW-2 and Hw 4'








For cast-in-place culverts:
 Ltw = [(N) (S) + (N + 1) (U)] + cosine (θ)

For precast culverts:
 Ltw = [(N) (2U + S) + (N - 1) (0.5')] + cosine (θ)
 Total Wingwall Area (two wings ~ SF)
 = (2)(Hw)(Lw) for Type PW-1
 = (2)(Hw)(Lw) - 6 SF for Type PW-2 and Hw 4'
 = (2)(Hw)(Lw) - 1.5 SF for Type PW-2 and Hw 4'

Hw = Height of wingwall
 Lw = Length of wingwall
 Ltw = Culvert toewall length
 N = Number of culvert spans
 SL:1 = Channel slope ratio. (horizontal: 1 vertical, usual value is 2:1)
 θ = Culvert skew

See applicable box culvert standard sheet for S, H, T, and U values.

- Skew = 0°
- At discharge end, chamfer may be 3/4" minimum.
- For 15° skew ~ 1"
For 30° skew ~ 2"
For 45° skew ~ 3"
- Quantities shown are for two Type PW-1 wings. Adjust concrete volume for Type PW-2 wings. To determine estimated quantities for two wings, multiply the tabulated values by Lw. Quantities shown do not include weight of Bars D.
- Provide weepholes for Hw = 5'-0" and greater. Fill around weepholes with coarse gravel.
- Extend Bars E2 1'-6" minimum into the wingwall footing.
- Lap Bars M1 1'-6" minimum with Bars M2.
- Place Bars G as shown, equally spaced at 8" maximum. Provide at least two pairs of Bars G per wing.
- 0" Min to 5'-0" Max. Estimated curb heights are shown elsewhere in the plans. For structures with pedestrian rail or curbs taller than 1'-0, refer to the Extended Curb Details (ECD) standard sheet. For structures with T631 or T631LS bridge rail, refer to the Mounting Details for T631 & T631LS Rails (T631-CM) standard sheet. Refer to the Box Culvert Rail Mounting Details (RAC) standard sheet for structures with bridge rail other than T631 or T631LS.
- For vehicle safety, the following requirements must be met:
 - For structures without bridge rail, construct curbs no more than 3" above finished grade.
 - For structures with bridge rail, construct curbs flush with finished grade.
 Reduce curb heights, if necessary, to meet the above requirements. No changes will be made in quantities and no additional compensation will be allowed for this work.
- 1'-0" typical. 2'-3" when the Box Culvert Rail Mounting Details (RAC) standard sheet is referred to elsewhere in the plans.
- 3'-0" for Hw < 4'.
- 6" for Hw < 4'.

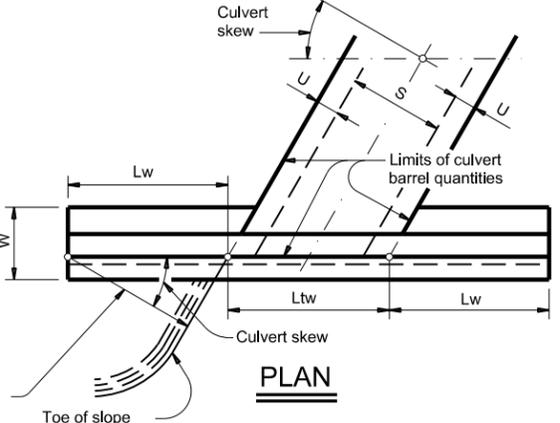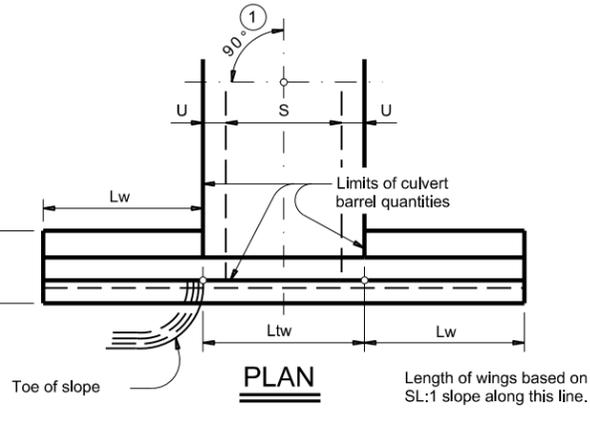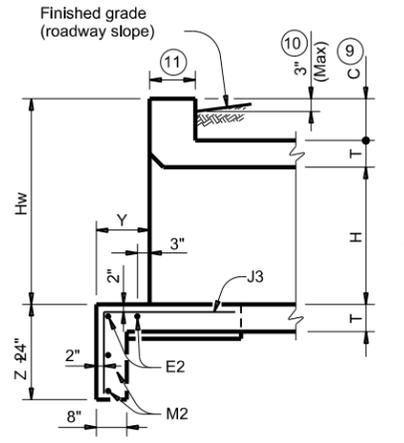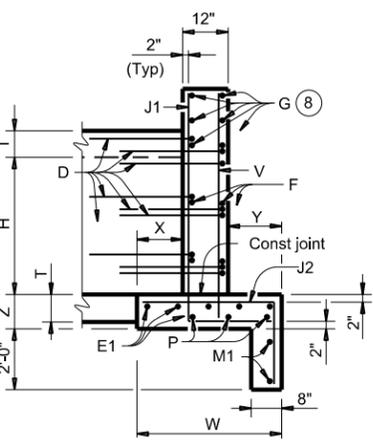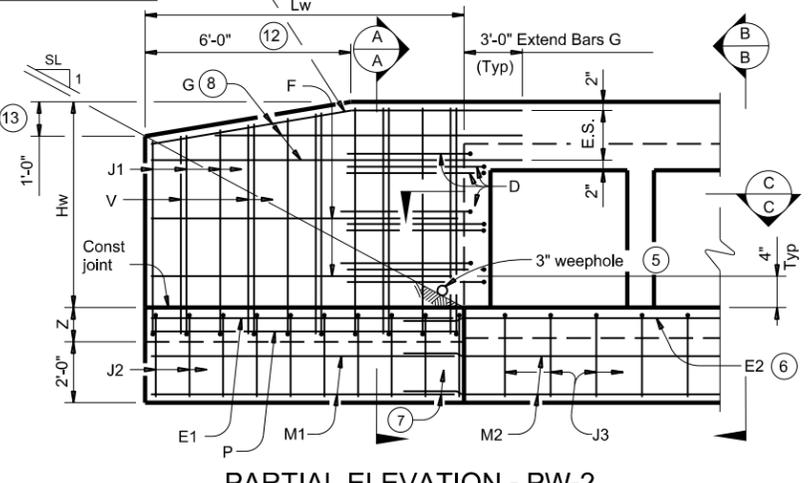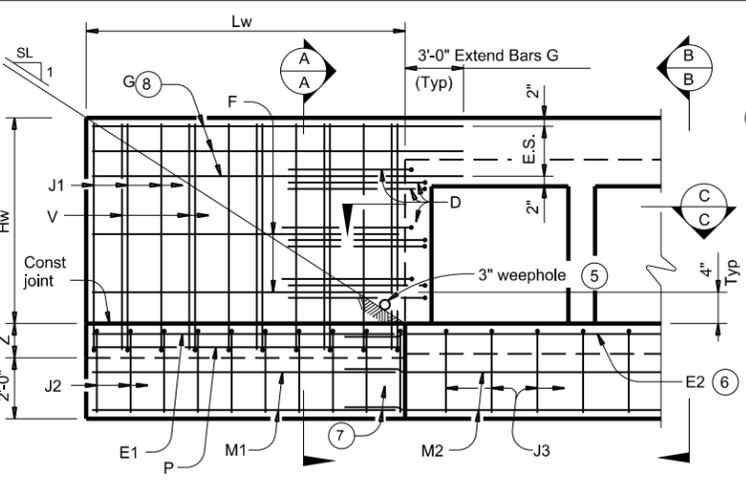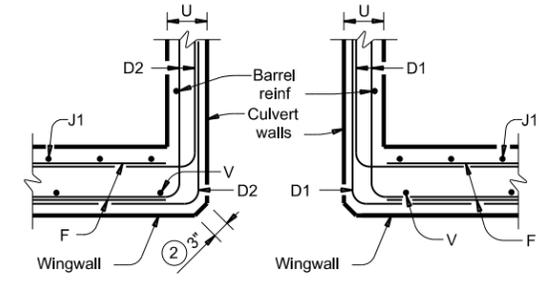

DESIGNER NOTES:
 Type PW-1 can be used for all applications and must be used if railing is to be mounted to the wingwall. Type PW-2 can only be used for applications without a railing mounted to the wingwall.

MATERIAL NOTES:
 Provide Class C concrete (f'c=3,600 psi).
 Provide Grade 60 reinforcing steel.
 Provide galvanized reinforcing steel if required elsewhere in the plans.

GENERAL NOTES:
 Designed in accordance with AASHTO LRFD Bridge Design Specifications.
 Depth of toewalls for wingwalls and culverts may be reduced or eliminated when founded on solid rock, when directed by the Engineer.
 See Box Culvert Supplement (BCS) standard sheet for wingwall type and additional dimensions and information. Quantities for concrete and reinforcing steel resulting from the formulas given on this sheet are for the Contractor's information only.

Cover dimensions are clear dimensions, unless noted otherwise.
 Reinforcing dimensions are out-to-out of bars.

				Bridge Division Standard	
CONCRETE WINGWALLS WITH PARALLEL WINGS FOR BOX CULVERTS TYPES PW-1 AND PW-2					
PW					
FILE:	pwstde01-20.dgn	DN:	GAF	CK:	CAT
©TxDOT	February 2020	CON:	0169 07	SECT:	053, ETC
REVISIONS		JOB:	US60	HSY:	HIGHWAY
		DIST:	AMA	COUNTY:	GRAY
				SHEET NO.:	130

DATE: 4/7/2021 7:27:39 AM
 FILE: F:\Projects\2019\11004.TxDOT_5x5_PS&E\03_US60_Amar.I.II\ENGL\500-USTN.51\Drawings\Bridges\SETB-SW-01.dwg
 DISCLAIMER: This standard is governed by the "Texas Engineering Practice Act". No warranty of any kind is made by TxDOT for any purpose whatsoever. TxDOT assumes no responsibility for the conversion of units or for the accuracy of the information presented herein.

TABLE OF DIMENSIONS AND REINFORCING STEEL
(Wings for One Structure End)

Maximum Wingwall Height Hw (9)	Dimensions				Variable Reinforcing				Estimated Quantities per ft of wing length (Two-Wings) (3)	
	W	X	Y	Z	Bars J1		Bars J2		Reinf (Lb/Ft)	Conc (CY/Ft)
2'-6"	2'-5"	1'-0"	9"	7"	#4	1'-0"	#4	1'-0"	33.73	0.248
3'-0"	2'-5"	1'-0"	9"	7"	#4	1'-0"	#4	1'-0"	37.07	0.261
3'-6"	2'-5"	1'-0"	9"	7"	#4	1'-0"	#4	1'-0"	37.74	0.273
4'-0"	2'-5"	1'-0"	9"	7"	#4	1'-0"	#4	1'-0"	38.41	0.285
4'-6"	3'-2"	1'-6"	1'-0"	7"	#4	1'-0"	#4	1'-0"	41.75	0.330
5'-0"	3'-2"	1'-6"	1'-0"	7"	#4	1'-0"	#4	1'-0"	45.09	0.343
5'-6"	3'-2"	1'-6"	1'-0"	7"	#4	1'-0"	#4	1'-0"	45.75	0.355
6'-0"	3'-2"	1'-6"	1'-0"	7"	#4	1'-0"	#4	1'-0"	46.42	0.367
7'-0"	3'-8"	1'-9"	1'-3"	7"	#4	1'-0"	#4	1'-0"	52.77	0.414
8'-0"	4'-2"	2'-0"	1'-6"	8"	#5	1'-0"	#4	1'-0"	60.19	0.486
9'-0"	4'-8"	2'-3"	1'-9"	8"	#4	6"	#4	6"	81.49	0.535
10'-0"	5'-2"	2'-6"	2'-0"	8"	#5	6"	#4	6"	97.25	0.584
11'-0"	5'-8"	2'-9"	2'-3"	8"	#6	6"	#4	6"	133.65	0.634
12'-0"	6'-2"	3'-0"	2'-6"	9"	#7	6"	#5	6"	162.29	0.721

TABLE OF WINGWALL REINFORCING
(Two-Wings)

Bar	Size	No.	Spa
D	#5	~	1'-0"
E	#4	~	1'-0"
F	#4	~	1'-0"
G	#6	4	~
M	#4	4	~
P	#4	~	1'-0"
R	#5	6	~
V	#4	~	1'-0"

TABLE OF ESTIMATED CULVERT TOEWALL QUANTITIES

Bar	Size	No.	Spa
L	#4	~	1'-6"
Q	#4	1	~
Reinf (Lb/Ft)	2.45		
Conc (CY/Ft)	0.037		

TABLE OF ESTIMATED ANCHOR TOEWALL QUANTITIES

Bar	Size	No.	Spa
K	#4	~	1'-0"
N	#5	6	~
OL	#4	6	~
Reinf (Lb/Ft)	9.82		
Conc (CY/Ft)	0.074		

- Extend Bars P 3'-0" Min into bottom slab of box culvert.
- Adjust to fit as necessary to maintain 1 #2" clear cover and 4" Min between bars.
- Quantities shown are based on an average wing height for two wings (one structure end). To determine total quantities for two wings multiply the tabulated values by Lw.
- Recommended values of slope are: 3:1, 4:1, and 6:1. Provide 3:1 or flatter slope.
- When shown elsewhere on the plans, construct 5" deep concrete riprap. Payment for riprap is as required by Item 432, "Riprap". Unless otherwise shown on the plans or directed by the Engineer, extend construction joints or grooved joints, oriented in the direction of flow, across the full distance of the riprap, at intervals of approximately 20'. When such riprap is provided, the culvert toewall shown in SECTION B-B is not required.
- At Contractor's option, end the culvert toewall flush with wingwall toewall. Adjust reinforcing as needed.
- 3" Min to 5'-0" Max. Estimated curb heights are shown elsewhere in the plans. For structures without railing and curbs taller than 1'-0", refer to Extended Curb Details (ECD) standard sheet.
- For vehicle safety, reduce curbs height, if necessary, to provide a maximum 3" projection above finished grade. No changes will be made in quantities and no additional compensation will be allowed for this work.
- See Table of Maximum Wing Heights for various slopes. Height is limited based on a 33'-6" maximum safety pipe runner length.

TABLE OF MAXIMUM WING HEIGHTS (9)

Side Slope	Hw Max
3:1	11'-5"
4:1	8'-10"
6:1	6'-1"

WING DIMENSION CALCULATIONS:






$Hw = H + T + C - 0.250'$ (9)
 $Lw = (Hw - 0.333') (SL)$

For cast-in-place culverts:
 $Ltw = (N) (S) + (N + 1) (U)$
 For precast culverts:
 $Ltw = (N) (2U + S) + (N - 1) (0.500')$


$Lc = (Ltw) - (2U)$
 $Atw = Lc$
 Total Wingwall Area (two wings ~ SF)
 $= (Hw + 0.333') (Lw)$

Hw = Height of wingwall (feet)
 SL:1 = Side slope ratio (horizontal : 1 vertical)
 Lw = Length of wingwall (feet)
 Ltw = Culvert toewall length (feet)
 Lc = Culvert curb between wings (feet)
 Atw = Anchor toewall length (feet)
 N = Number of culvert spans


See applicable box culvert standard for H, S, T, and U values. See Table of Maximum Wall Heights for limits on Hw.

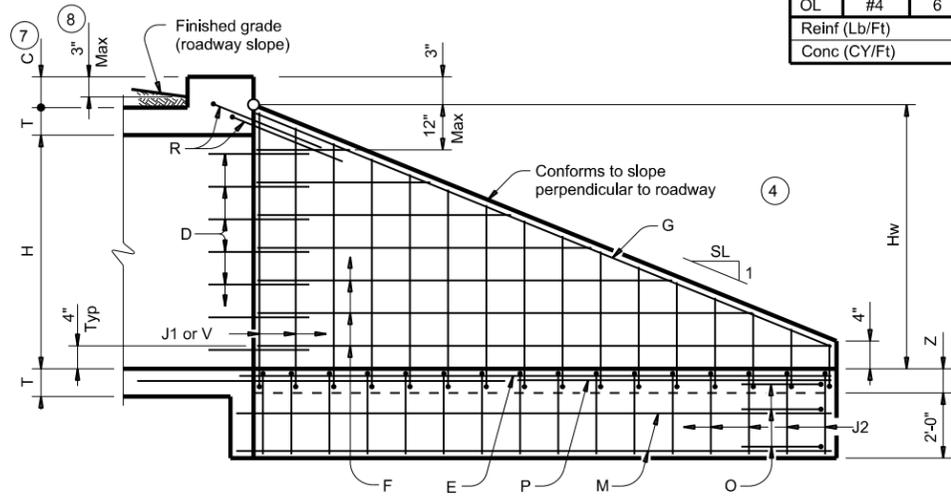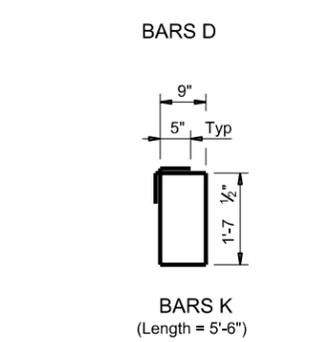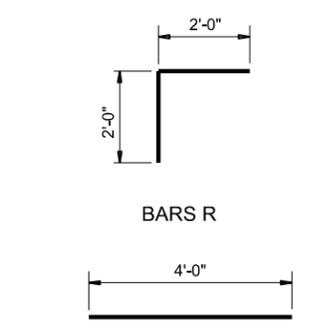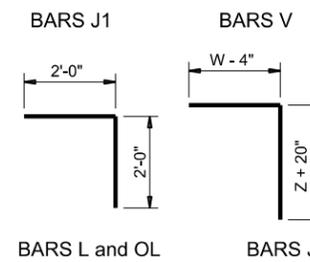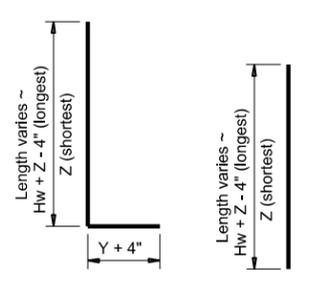


INSIDE ELEVATION OF WINGWALL
(Showing reinforcing. Culvert and culvert toewall reinforcing not shown for clarity.)

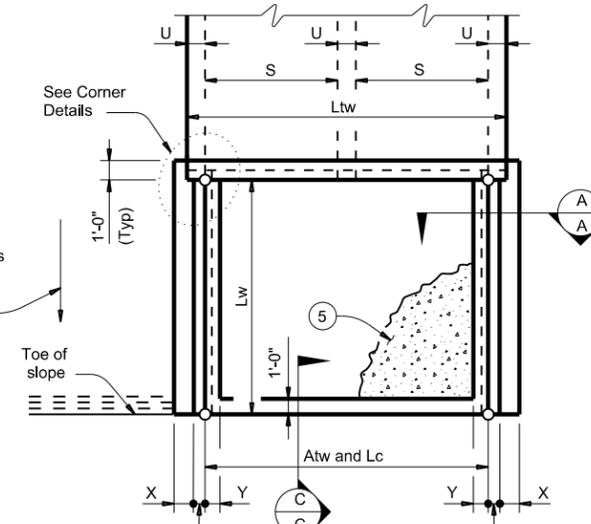


PLAN
(Showing dimensions.)

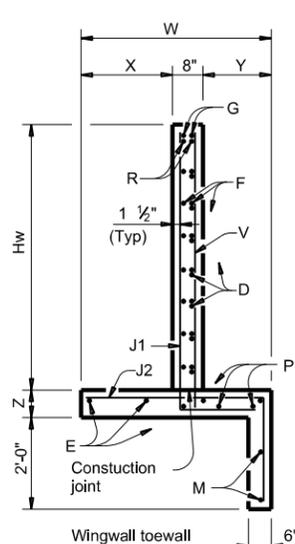


SECTION A-A

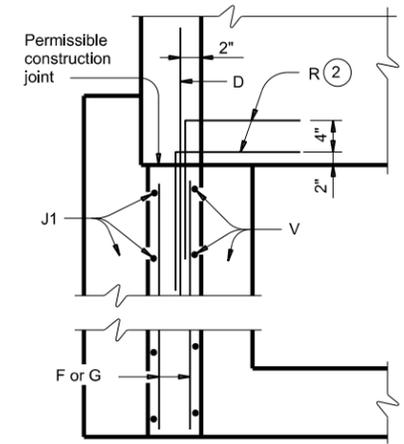


WINGWALL

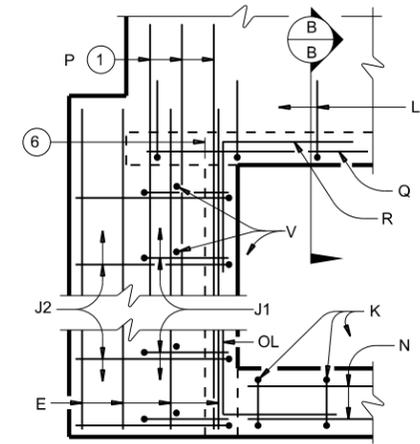

FOOTING AND TOEWALL

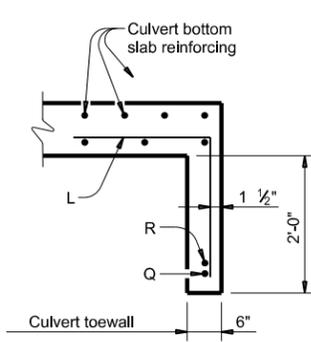

SECTION B-B (5)

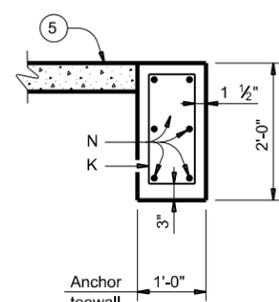

SECTION C-C


MATERIAL NOTES:
 Provide Grade 60 reinforcing steel.
 Provide galvanized reinforcing steel if required elsewhere in the plans. Synthetic fibers listed on the "Fibers for Concrete" Material Producer List (MPL) may be used in lieu of steel reinforcing in riprap concrete unless noted otherwise.
 Provide Class "C" concrete (f'c = 3,600 psi).
 Adjust reinforcing as necessary to provide a minimum clear cover of 1"
 Provide pipe runners and anchor pipes meeting the requirements of ASTM A53 (Type E or S, Gr B), ASTM A500 Gr B, or API 5LX52.
 Provide ASTM A307 bolts and nuts.
 Provide ASTM A36 steel plates.
 Galvanize all steel components, except reinforcing unless required elsewhere in the plans, after fabrication.
 Repair galvanizing damaged during transport or construction in accordance with the Item 445, "Galvanizing".
 For optional adhesive anchors, install epoxy adhesive anchorages in accordance with the manufacturer's instructions including hole size, drilling equipment and method, hole cleaning equipment and method, mixing and dispensing adhesive, and anchor insertion. Do not alter the manufacturer's mixing nozzle or dispenser. Provide anchorage rods that are clean and free of grease, oil, or any other foreign material. Demonstrate hole cleaning method to the Engineer for approval and continue the approved process for all anchorage locations. Test adhesive anchors in accordance with Item 450.3.3, "Tests." Test 3 anchors per 100 anchors installed.

GENERAL NOTES:
 Designed according to AASHTO LRFD Bridge Design Specifications.
 The safety end treatments shown herein are intended for use in those installations where out of control vehicles are likely to traverse the openings approximately perpendicular to the pipe runners.
 Pipe runners are designed for a traversing load of 1,800 pounds at yield as recommended by Research Report 280-1, "Safety Treatment of Roadside Cross-Drainage Structures", Texas Transportation Institute, March 1981.
 When structure is founded on solid rock, depth of toewalls for culverts and wingwalls may be reduced or eliminated as directed by the Engineer.
 All bolts, nuts, washers, brackets, angles, and pipe runners are considered parts of the safety end treatment for payment.
 The quantities for pipe runners, reinforcing steel, and concrete, resulting from the formulas given herein are for Contractor's information only.
 See Box Culvert Supplement (BCS) standard sheet for additional dimensions and information.


Cover dimensions are clear dimensions, unless noted otherwise. Reinforcing dimensions are out-to-out of bars.

SAFETY END TREATMENT WITH STRAIGHT WINGS FOR 0° SKEW BOX CULVERTS TYPE I ~ CROSS DRAINAGE			
SETB-SW-O			
FILE: setbs0se-20.dgn	DN: GAF	CK: CAT	DW: TxDOT
©TxDOT February 2020	CON: 0169	SECT: 07	JOB: 053, ETC
REVISIONS	HIGHWAY: US60		SHEET NO.: 135
DIST: AMA	COUNTY: GRAY		


DATE: 4/7/2021 7:27:40 AM
 FILE: F:\Projects\2019\11004.TxDOT_5x5_PS&E\03_US60_Amar.1\10\ENG\500-USTN\51 this sample drawings result from its use.
 DISCLAIMER: The use of this standard is governed by the "Texas Engineering Practice Act". No warranty of any kind is made by TxDOT for any purpose whatsoever. TxDOT assumes no responsibility for the conversion of units or the accuracy of the drawings.

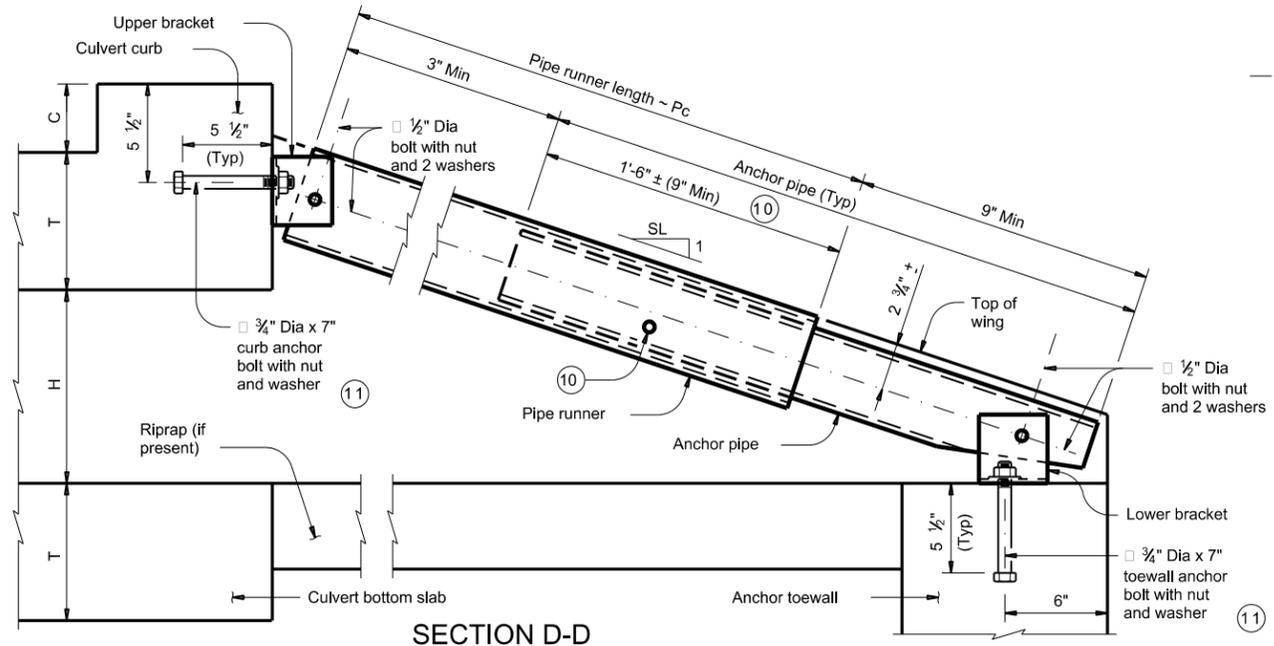


SECTION D-D
(Showing curb pipe runner.)

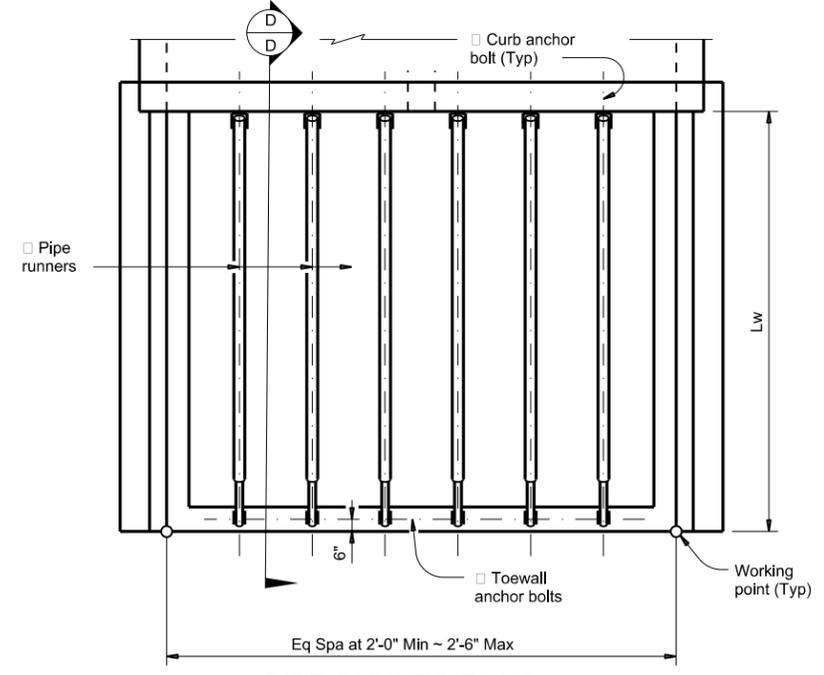


PIPE RUNNER PLAN

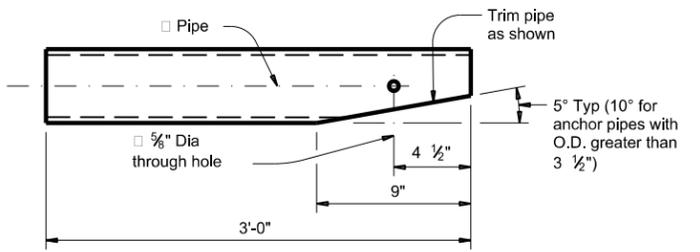

ANCHOR PIPE DETAILS

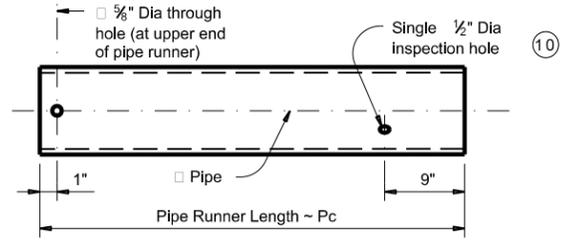

PIPE RUNNER DETAILS

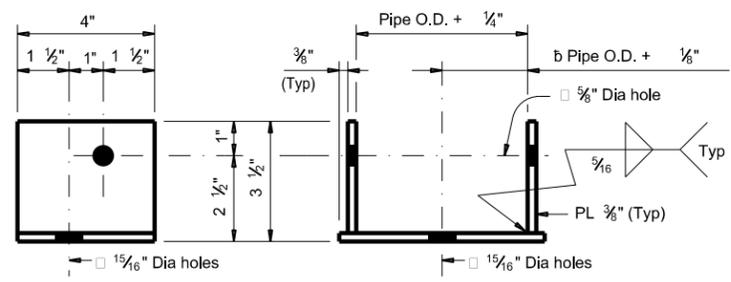

UPPER AND LOWER BRACKET DETAILS

Note: Upper and lower brackets match the required pipe diameters as shown in the table.

Maximum Pipe Runner Length (Pc)	MAXIMUM PIPE RUNNER LENGTHS AND REQUIRED PIPE RUNNER AND ANCHOR PIPE SIZES					
	Required Pipe Runner Size			Required Anchor Pipe Size		
	Pipe Size	Pipe O.D.	Pipe I.D.	Pipe Size	Pipe O.D.	Pipe I.D.
9'-4"	3" STD	3.500"	3.068"	2" STD	2.375"	2.067"
19'-0"	4" STD	4.500"	4.026"	3" STD	3.500"	3.068"
33'-6"	5" STD	5.563"	5.047"	4" STD	4.500"	4.026"

- 10 After installation of pipe runner, use the 1/2" inspection hole to ensure that the lap of the anchor pipe with the pipe runner is adequate.
- 11 At Contractor's option, an adhesive anchor may be used. Provide 3/4" Dia adhesive anchors that meet the requirements of ASTM A307. Gr A fully threaded rods. Embed threaded rods into curb, wingwalls, and toewall using a Type III, Class C, D, E, or F anchor adhesive. Minimum embedment depth is 5 1/2". Provide anchor adhesive able to achieve a basic bond strength in tension, Nba, of 20 kips. Submit signed and sealed calculations or the manufacturer's published literature showing the proposed anchor adhesive's ability to develop this load to the Engineer for approval prior to use.

PIPE RUNNER DIMENSION CALCULATIONS:

$$Pc = (Lw) (K) - (1.688)$$

Pc = Pipe runner length (feet)

K = Constant values for use in formulas

Slope SL:1 K

3:1 ~ 1.054

4:1 ~ 1.031

6:1 ~ 1.014


Bridge Division Standard

SAFETY END TREATMENT WITH STRAIGHT WINGS

FOR 0° SKEW BOX CULVERTS
TYPE I ~ CROSS DRAINAGE

SETB-SW-O

FILE: setbs0se-20.dgn	DN: GAF	CK: CAT	DW: TxDOT	CK: TxDOT
©TxDOT February 2020	CONT	SECT	JOB	HIGHWAY
REVISIONS	0169	07	053, ETC	US60
DIST	COUNTY		SHEET NO.	
AMA	GRAY		136	

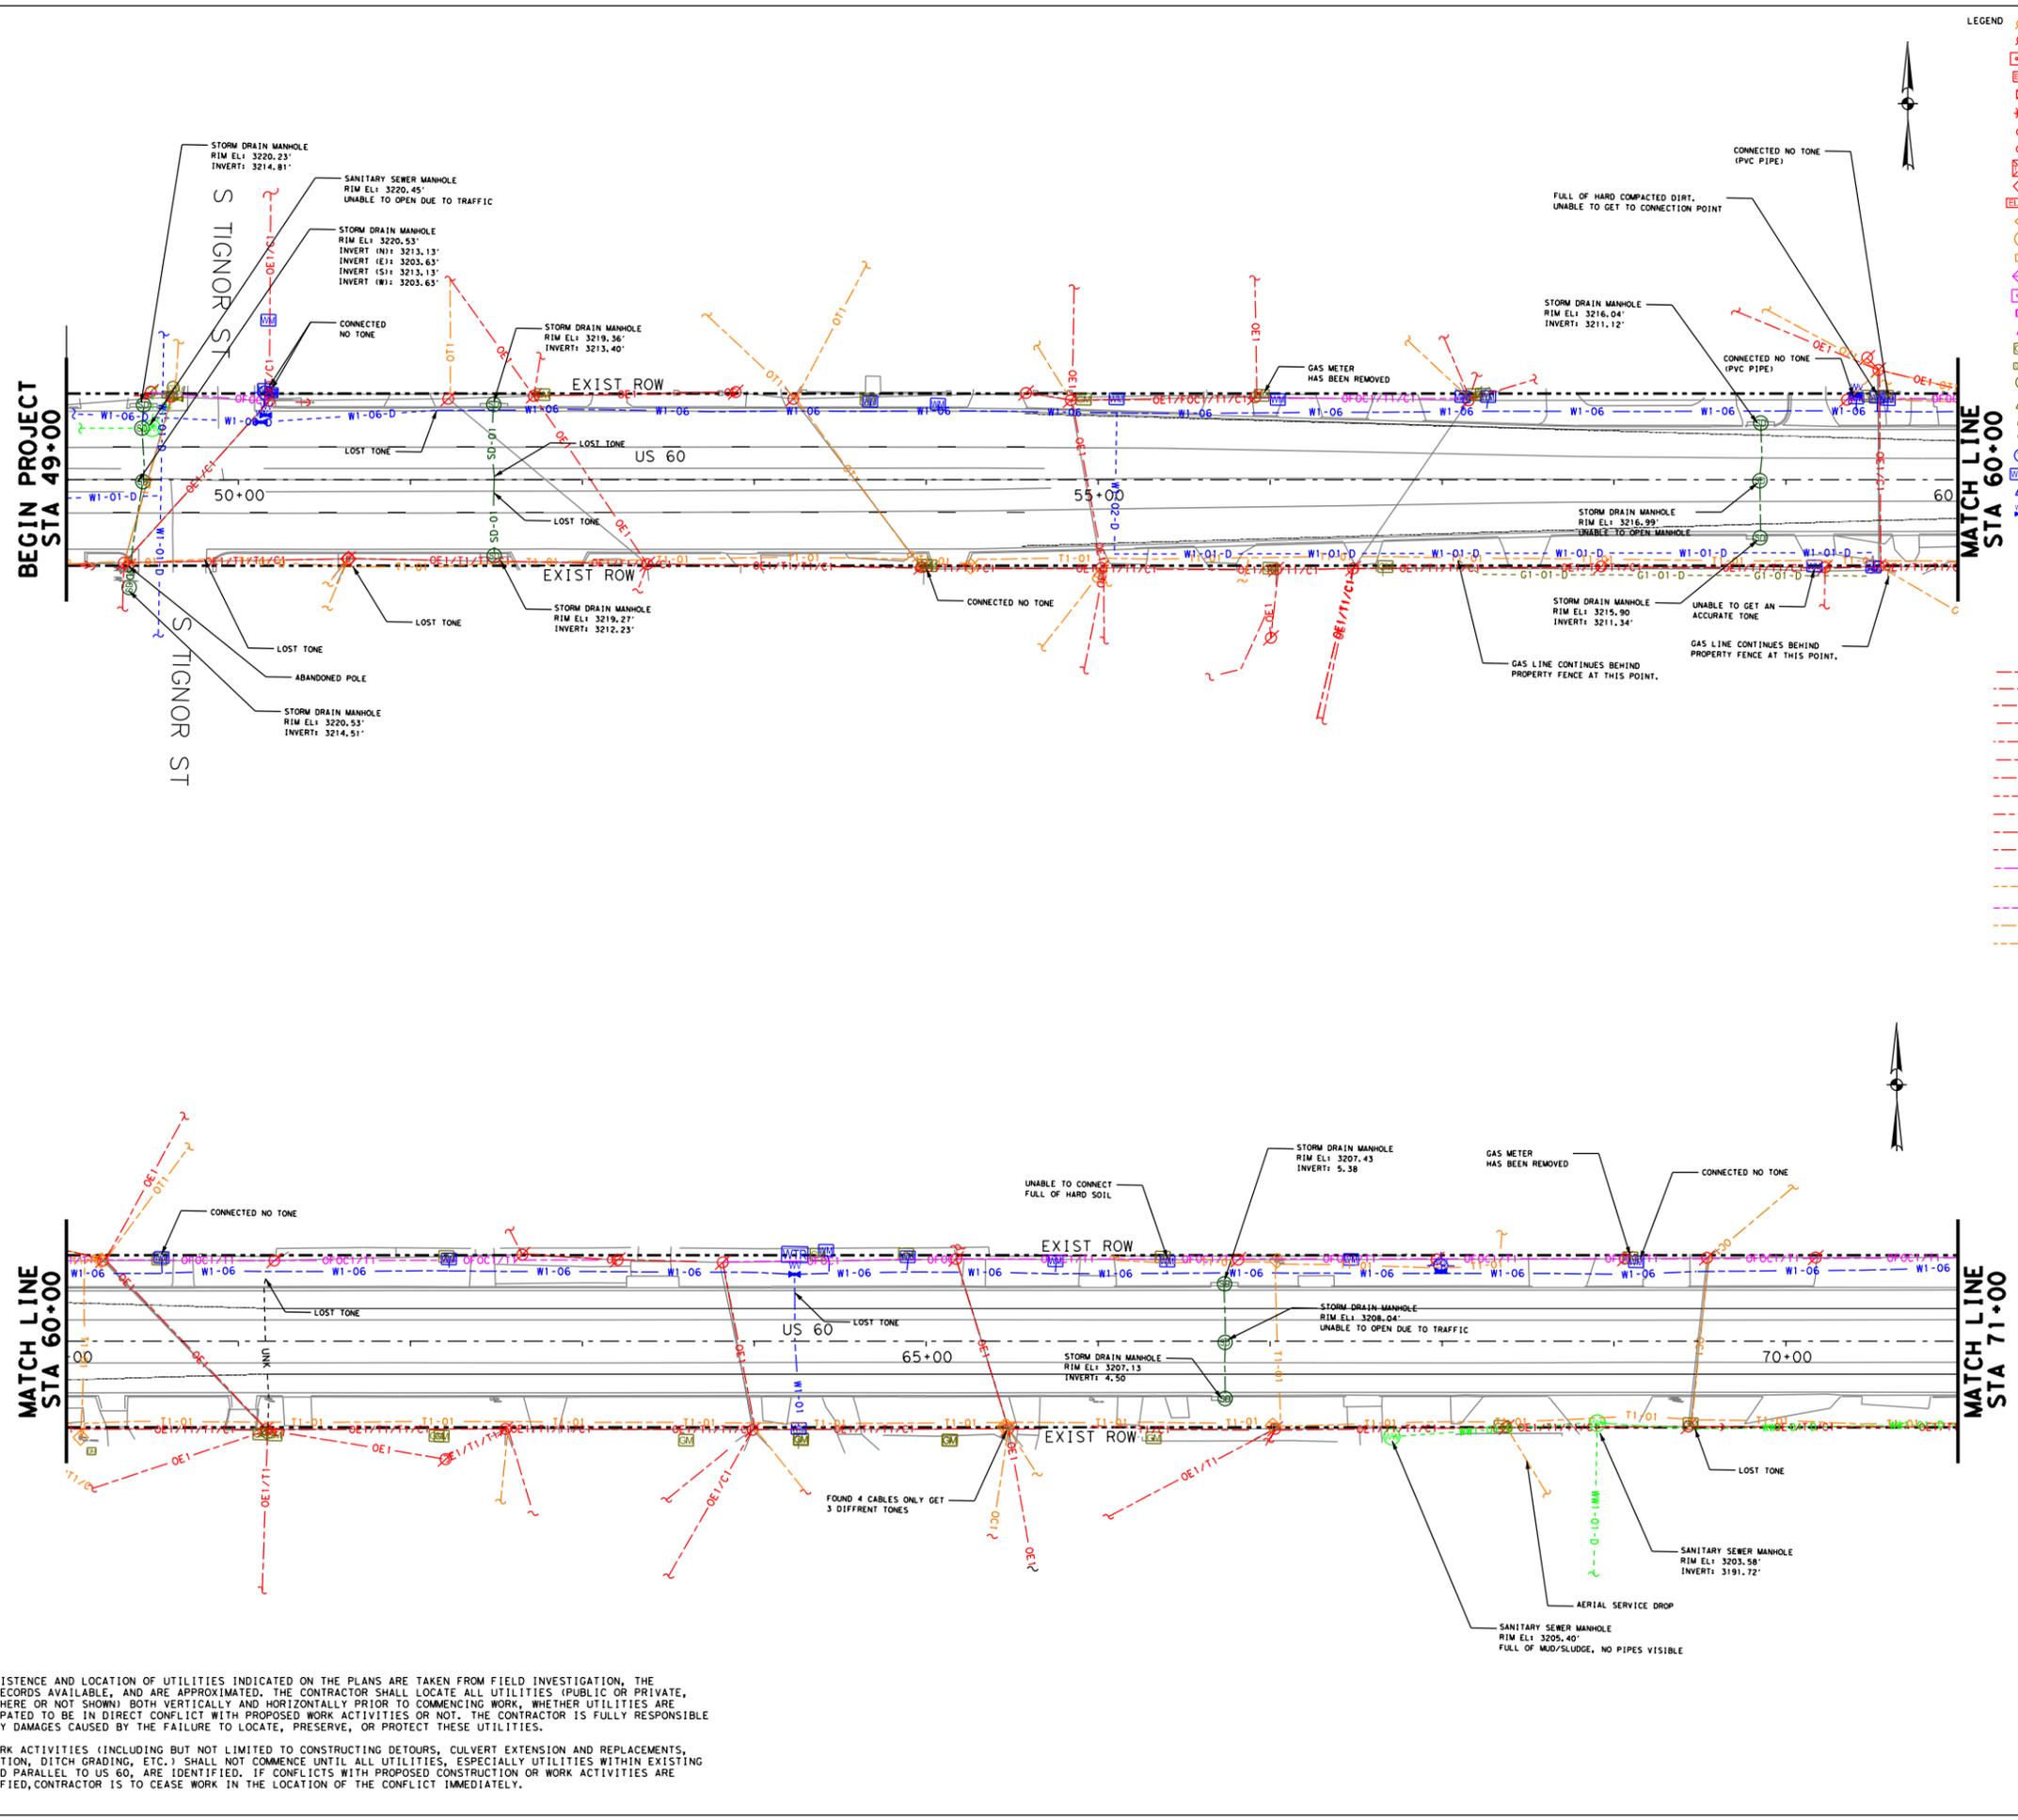

LEGEND

TELEPHONE POLE	QL LEVEL B - E1-01	ELECTRIC-XCEL/SOUTHWEST PUBLIC SERVICE.CO
POWER POLE	E3-01	ELECTRIC - TXDOT
ELECTRIC PULLBOX	FOC1-01	FIBER OPTIC - AT&T
ELECTRIC METER	FOC2-01	FIBER OPTIC - DOBSON FIBER CO
ELECTRIC SWITCH	T1-01	TELEPHONE - AT&T
ELECTRIC STREET LIGHT	C1-01	CABLE TV - CABLE ONE
ELECTRIC LANDSCAPE LIGHT	G1-01	GAS - ATMOS ENERGY
ELECTRIC TRAFFIC SIGNAL	G1-02	GAS - ATMOS ENERGY (2")
ELECTRIC TRAFFIC SWITCH BOX	G3-01	GAS - UNKNOWN
ELECTRIC CABINET	G4-01	GAS - AMARILLO NATURAL GAS
ELECTRIC MARKER	W1-01	WATER - CITY OF PAMPA
TELEPHONE PEDESTAL	W1-06	WATER - CITY OF PAMPA (6")
TELEPHONE MANHOLE	W1-10	WATER - CITY OF PAMPA (10")
TELEPHONE MARKER	WW1-01	SANITARY SEWER - CITY OF PAMPA
VIDEO-READY ACCESS DEVICE	SD-01	STORM - CITY OF PAMPA
FIBER OPTIC PULLBOX	UNK	UNKNOWN
FIBER OPTIC MARKER	QL LEVEL D	ELECTRIC-XCEL/SOUTHWEST PUBLIC SERVICE.CO
FIBER OPTIC TEST STATION	E1-01-D	ELECTRIC - TXDOT
GAS METER	E3-01-D	ELECTRIC - TXDOT
GAS MARKER	FOC1-01-D	FIBER OPTIC - AT&T
GAS REGULATOR	T1-01-D	TELEPHONE - AT&T
GAS TEST STATION	C1-01-D	CABLE TV - CABLE ONE
GAS VALVE	G1-01-D	GAS - ATMOS ENERGY
GAS VENT	G2-01-D	GAS - WEST TEXAS GAS
WATER MANHOLE	G2-03-D	GAS - WEST TEXAS GAS (3")
WATER MARKER	G3-01-D	GAS - UNKNOWN
WATER TEST STATION	W1-01-D	WATER - CITY OF PAMPA (UNKNOWN SIZE)
WATER VALVE	W1-02-D	WATER - CITY OF PAMPA (2")
	W1-06-D	WATER - CITY OF PAMPA (6")
	W1-10-D	WATER - CITY OF PAMPA (10")
	W2-04-D	WATER - TXDOT (4")
	W3-2.5-D	WATER - PRIVATE (2.5")
	W4-04-D	WATER - WESTERN EQUIPMENT (4")
	WW1-01-D	SANITARY SEWER - CITY OF PAMPA
	WW2-03-D	SANITARY SEWER - WESTERN EQUIPMENT (3")
	SD-01-D	STORM - CITY OF PAMPA
	UNK	UNKNOWN


OVERHEAD

OH1	OVERHEAD ELECTRIC TRANSMISSION - XCEL/SOUTHWESTERN PUBLIC SERVICE CO
OE1	OVERHEAD ELECTRIC - XCEL ENERGY-SOUTHWESTERN PUBLIC SERVICE CO
OE1/FOC1/T1/C1	OVERHEAD ELEC/FOC/TEL/CATV - XCEL/AT&T/AT&T/CABLE ONE
OE1/FOC1	OVERHEAD ELEC/FOC/TEL - XCEL/AT&T
OE1/FOC1/T1	OVERHEAD ELEC/FOC/TEL - XCEL/AT&T/AT&T
OE1/T1	OVERHEAD ELEC/TEL - XCEL ENERGY/AT&T
OE1/T1/T1/C1/C1	OVERHEAD ELEC/TEL/TEL/CATV/CATV - XCEL/AT&T/AT&T/CABLE ONE/CABLE ONE
OE1/T1/T1/C1	OVERHEAD ELEC/TEL/TEL/CATV - XCEL/AT&T/AT&T/CABLE ONE
OE1/T1/C1	OVERHEAD ELEC/TEL/CATV - XCEL/AT&T/CABLE ONE
OE1/C1	OVERHEAD ELEC/CATV - XCEL ENERGY/CABLE ONE
OE1/C1	OVERHEAD ELEC/CATV - XCEL ENERGY/CABLE ONE
FOC1	OVERHEAD FOC - AT&T
OT1	OVERHEAD TEL - AT&T
FOC1/T1/C1	OVERHEAD TEL/FOC/CATV - AT&T/AT&T/CABLE ONE
OT1/C1	OVERHEAD TEL/CATV - AT&T/CABLE ONE
OC1	OVERHEAD CATV - CABLE ONE



J.L.S.H.A.
4/2/2021

REV. NO.	DATE	DESCRIPTION	BY

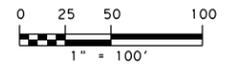

CobbFendley
13430 Northwest Freeway, Ste. 1100
Houston, Texas 77040
713.462.3242
www.cobbhendley.com



US 60
EXISTING UTILITY PLANS
STA 49+00 TO STA 71+00
SHEET 01 OF 36



FED. RD. DIV. NO.	STATE	PROJECT NO.	HIGHWAY NO.
6	TEXAS	SEE TITLE SHEET	US 60
STATE DISTRICT	COUNTY	CONTROL NO.	SECTION NO.
AMA	GRAY	0619	07
		JOB NO.	SHEET NO.
		053, ETC	139

9:45:51 AM
 F:\P\proj\2019\1004_TxDOT_5x5_PSS&E\03_US60_Amarillo\16\500\UST\N\506_SUE-02-Street\US60_SUE-01.dgn
 4/2/2021

NOTES:


- THE EXISTENCE AND LOCATION OF UTILITIES INDICATED ON THE PLANS ARE TAKEN FROM FIELD INVESTIGATION, THE BEST RECORDS AVAILABLE, AND ARE APPROXIMATED. THE CONTRACTOR SHALL LOCATE ALL UTILITIES (PUBLIC OR PRIVATE, SHOWN HERE OR NOT SHOWN) BOTH VERTICALLY AND HORIZONTALLY PRIOR TO COMMENCING WORK, WHETHER UTILITIES ARE ANTICIPATED TO BE IN DIRECT CONFLICT WITH PROPOSED WORK ACTIVITIES OR NOT. THE CONTRACTOR IS FULLY RESPONSIBLE FOR ANY DAMAGES CAUSED BY THE FAILURE TO LOCATE, PRESERVE, OR PROTECT THESE UTILITIES.
- ALL WORK ACTIVITIES (INCLUDING BUT NOT LIMITED TO CONSTRUCTING DETOURS, CULVERT EXTENSION AND REPLACEMENTS, EXCAVATION, DITCH GRADING, ETC.) SHALL NOT COMMENCE UNTIL ALL UTILITIES, ESPECIALLY UTILITIES WITHIN EXISTING ROW AND PARALLEL TO US 60, ARE IDENTIFIED. IF CONFLICTS WITH PROPOSED CONSTRUCTION OR WORK ACTIVITIES ARE IDENTIFIED, CONTRACTOR IS TO CEASE WORK IN THE LOCATION OF THE CONFLICT IMMEDIATELY.

- LEGEND
- TELEPHONE POLE
 - POWER POLE
 - ELECTRIC PULLBOX
 - ELECTRIC METER
 - ELECTRIC SWITCH
 - ELECTRIC STREET LIGHT
 - ELECTRIC LANDSCAPE LIGHT
 - ELECTRIC TRAFFIC SIGNAL
 - ELECTRIC TRAFFIC SWITCH BOX
 - ELECTRIC CABINET
 - ELECTRIC MARKER
 - TELEPHONE PEDESTAL
 - TELEPHONE MANHOLE
 - TELEPHONE MARKER
 - VIDEO-READY ACCESS DEVICE
 - FIBER OPTIC PULLBOX
 - FIBER OPTIC MARKER
 - FIBER OPTIC TEST STATION
 - GAS METER
 - GAS MARKER
 - GAS REGULATOR
 - GAS TEST STATION
 - GAS VALVE
 - GAS VENT
 - WATER MANHOLE
 - WATER MARKER
 - WATER TEST STATION
 - WATER VALVE
- QL LEVEL B
- E1-01 ELECTRIC-XCEL/SOUTHWEST PUBLIC SERVICE.CO
 - E3-01 ELECTRIC - TXDOT
 - FOC1-01 FIBER OPTIC - AT&T
 - FOC2-01 FIBER OPTIC - DOBSON FIBER CO
 - T1-01 TELEPHONE - AT&T
 - C1-01 CABLE TV - CABLE ONE
 - G1-01 GAS - ATMOS ENERGY
 - G1-02 GAS - ATMOS ENERGY (2")
 - G3-01 GAS - UNKNOWN
 - G4-01 GAS - AMARILLO NATURAL GAS
 - W1-01 WATER - CITY OF PAMPA
 - W1-06 WATER - CITY OF PAMPA (6")
 - W1-10 WATER - CITY OF PAMPA (10")
 - WW1-01 SANITARY SEWER - CITY OF PAMPA
 - SD-01 STORM - CITY OF PAMPA
 - UNK UNKNOWN
 - E1-01-D ELECTRIC-XCEL/SOUTHWEST PUBLIC SERVICE.CO
 - E3-01-D ELECTRIC - TXDOT
 - FOC1-01-D FIBER OPTIC - AT&T
 - T1-01-D TELEPHONE - AT&T
 - C1-01-D CABLE TV - CABLE ONE
 - G1-01-D GAS - ATMOS ENERGY
 - G2-01-D GAS - WEST TEXAS GAS
 - G2-03-D GAS - WEST TEXAS GAS (3")
 - G3-01-D GAS - UNKNOWN
 - W1-01-D WATER - CITY OF PAMPA (UNKNOWN SIZE)
 - W1-02-D WATER - CITY OF PAMPA (2")
 - W1-06-D WATER - CITY OF PAMPA (6")
 - W1-10-D WATER - CITY OF PAMPA (10")
 - W2-04-D WATER - TXDOT (4")
 - W3-2.5-D WATER - PRIVATE (2.5")
 - W4-04-D WATER - WESTERN EQUIPMENT (4")
 - WW1-01-D SANITARY SEWER - CITY OF PAMPA
 - WW2-03-D SANITARY SEWER - WESTERN EQUIPMENT (3")
 - SD-01-D STORM - CITY OF PAMPA
 - UNK UNKNOWN
- OVERHEAD
- OHT OVERHEAD ELECTRIC TRANSMISSION - XCEL/SOUTHWESTERN PUBLIC SERVICE CO
 - OE1 OVERHEAD ELECTRIC - XCEL ENERGY-SOUTHWESTERN PUBLIC SERVICE CO
 - OE1/FOC1/T1/C1 OVERHEAD ELEC/FOC/TEL/CATV - XCEL/AT&T/AT&T/CABLE ONE
 - OE1/FOC1 OVERHEAD ELEC/FOC/TEL - XCEL/AT&T
 - OE1/FOC1/T1 OVERHEAD ELEC/FOC/TEL - XCEL/AT&T/AT&T
 - OE1/T1 OVERHEAD ELEC/TEL - XCEL ENERGY/AT&T
 - OE1/T1/T1/C1/C1 OVERHEAD ELEC/TEL/TEL/CATV/CATV - XCEL/AT&T/AT&T/CABLE ONE/CABLE ONE
 - OE1/T1/T1/C1 OVERHEAD ELEC/TEL/TEL/CATV - XCEL/AT&T/AT&T/CABLE ONE
 - OE1/T1/C1 OVERHEAD ELEC/TEL/CATV - XCEL/AT&T/CABLE ONE
 - OE1/C1 OVERHEAD ELEC/CATV - XCEL ENERGY/CABLE ONE
 - OE1/C1 OVERHEAD ELEC/CATV - XCEL ENERGY/CABLE ONE
 - FOC1 OVERHEAD FOC - AT&T
 - OT1 OVERHEAD TEL - AT&T
 - FOC1/T1/C1 OVERHEAD TEL/FOC/CATV - AT&T/AT&T/CABLE ONE
 - OT1/C1 OVERHEAD TEL/CATV - AT&T/CABLE ONE
 - OC1 OVERHEAD CATV - CABLE ONE

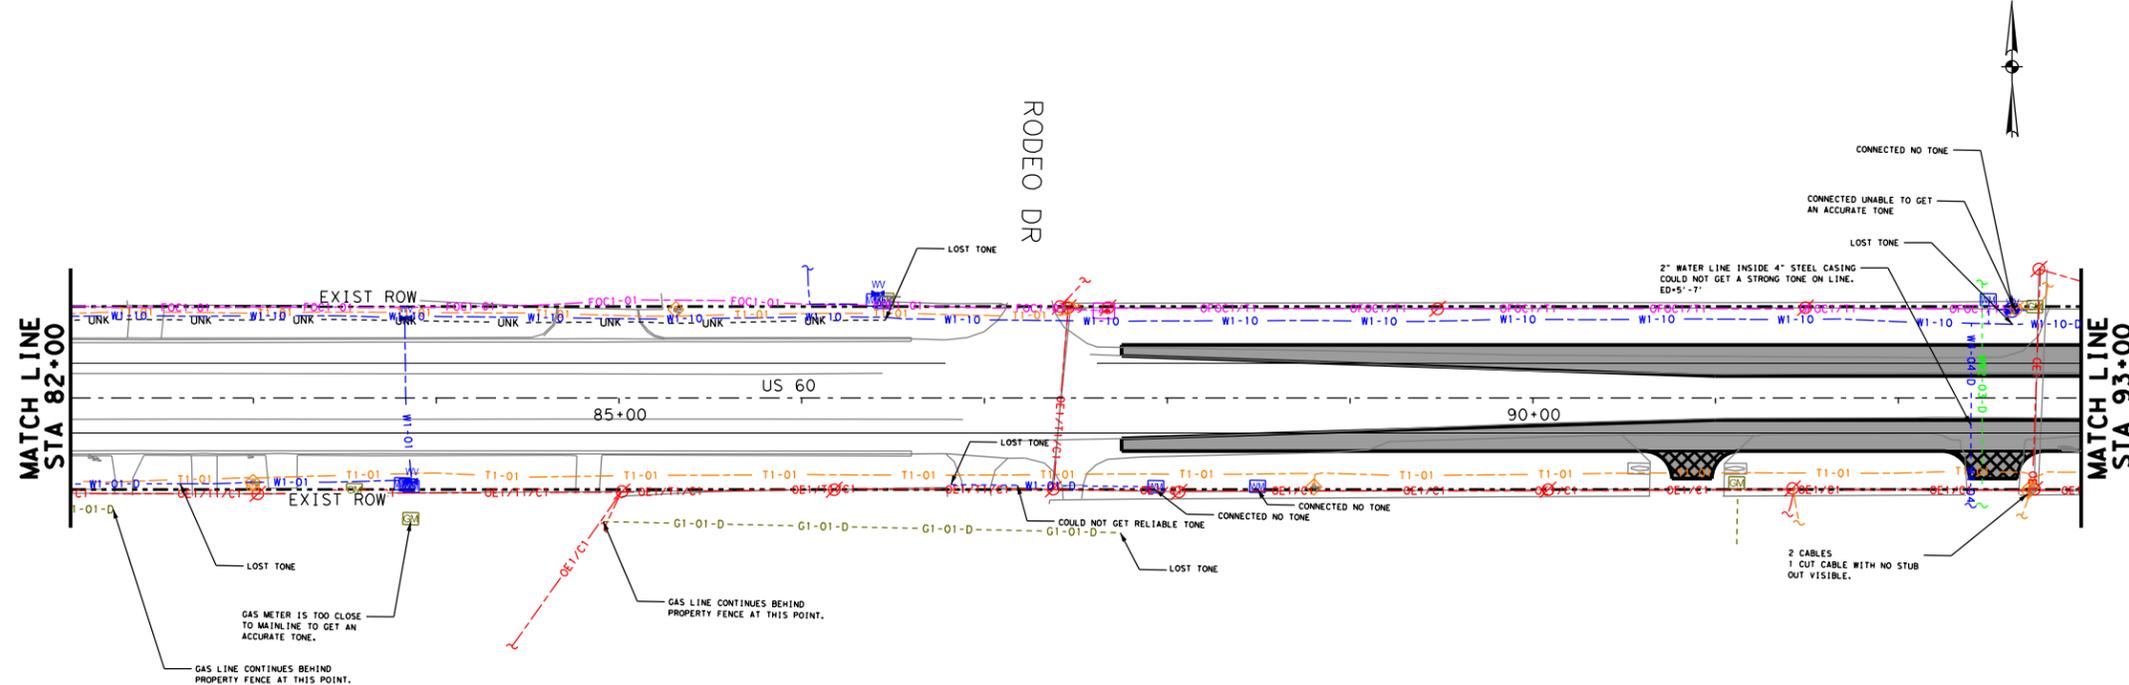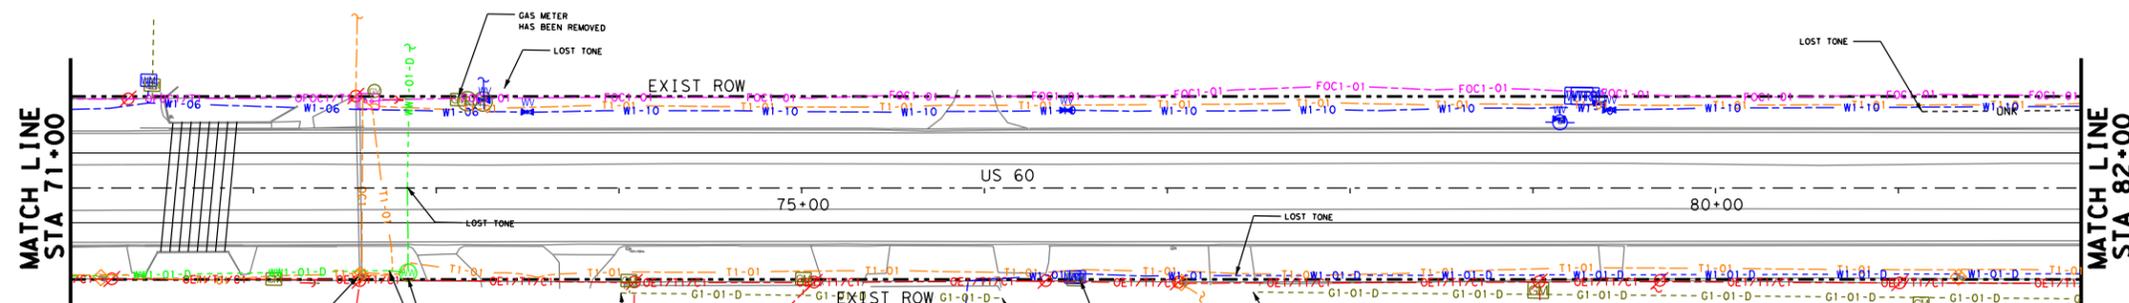

T.E.H. 4/2/2021

REV. NO.	DATE	DESCRIPTION	BY

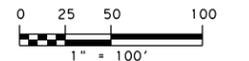

CobbFendley 13430 Northwest Freeway, Ste. 1100
Houston, Texas 77040
713.462.3242
www.cobbhendley.com




US 60
EXISTING UTILITY PLANS
STA 71+00 TO STA 93+00
SHEET 02 OF 36

FED. RD. DIV. NO.	STATE	PROJECT NO.	HIGHWAY NO.
6	TEXAS	SEE TITLE SHEET	US 60
STATE DISTRICT	COUNTY	CONTROL NO.	SECTION NO.
AMA	GRAY	0619	07
		JOB NO.	SHEET NO.
		053, ETC	140

4/12/2021 F:\P\Drawings\2019\1004_TxDOT_5x5_PSS&E\03_US60_Amarillo\16\500\UST\N\506-SUE-02-Street\US60-SUE-02.dgn 9:45:52 AM

NOTES:
1. THE EXISTENCE AND LOCATION OF UTILITIES INDICATED ON THE PLANS ARE TAKEN FROM FIELD INVESTIGATION, THE BEST RECORDS AVAILABLE, AND ARE APPROXIMATED. THE CONTRACTOR SHALL LOCATE ALL UTILITIES (PUBLIC OR PRIVATE, SHOWN HERE OR NOT SHOWN) BOTH VERTICALLY AND HORIZONTALLY PRIOR TO COMMENCING WORK, WHETHER UTILITIES ARE ANTICIPATED TO BE IN DIRECT CONFLICT WITH PROPOSED WORK ACTIVITIES OR NOT. THE CONTRACTOR IS FULLY RESPONSIBLE FOR ANY DAMAGES CAUSED BY THE FAILURE TO LOCATE, PRESERVE, OR PROTECT THESE UTILITIES.
2. ALL WORK ACTIVITIES (INCLUDING BUT NOT LIMITED TO CONSTRUCTING DETOURS, CULVERT EXTENSION AND REPLACEMENTS, EXCAVATION, DITCH GRADING, ETC.) SHALL NOT COMMENCE UNTIL ALL UTILITIES, ESPECIALLY UTILITIES WITHIN EXISTING ROW AND PARALLEL TO US 60, ARE IDENTIFIED. IF CONFLICTS WITH PROPOSED CONSTRUCTION OR WORK ACTIVITIES ARE IDENTIFIED, CONTRACTOR IS TO CEASE WORK IN THE LOCATION OF THE CONFLICT IMMEDIATELY.


94563 AW
 F:\P\02\2019\1004_T\DOT_5x5_P58E\03_US60_Amarillo\16\500\UST\N\506-SUE\02-Street\US60-SUE-03.dgn
 4/2/2021

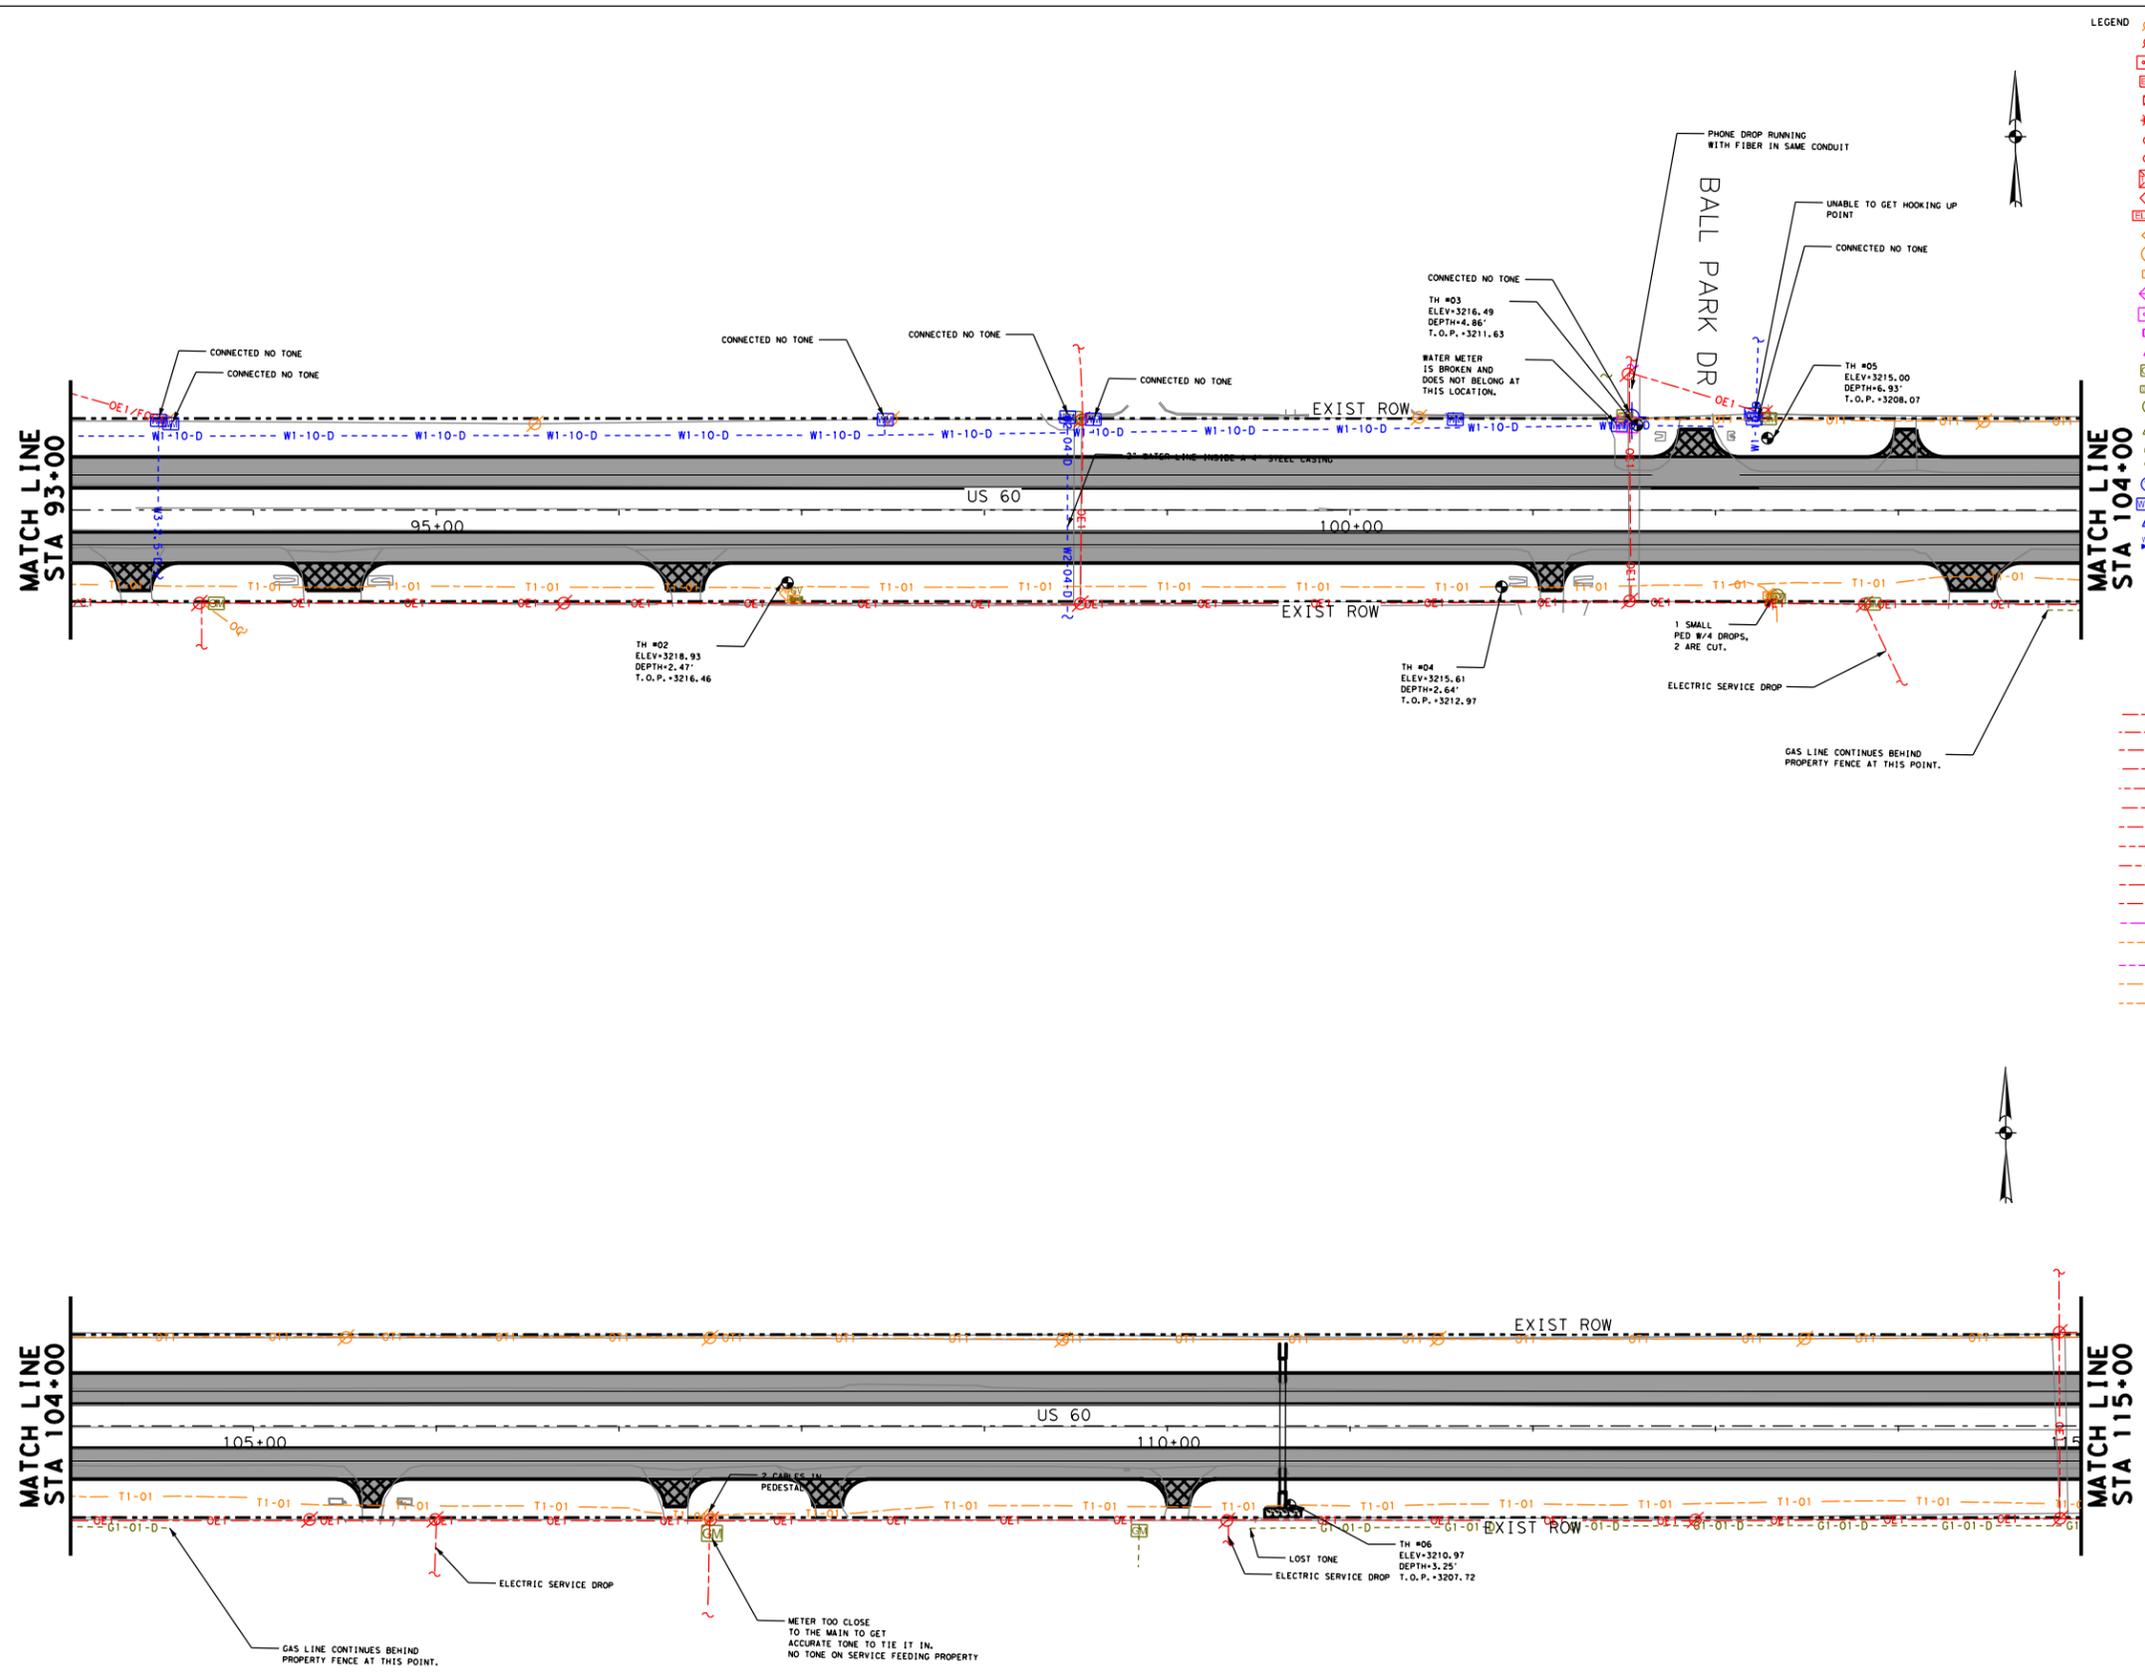

- LEGEND**
- ⊗ TELEPHONE POLE
 - ⊗ POWER POLE
 - ⊗ ELECTRIC PULLBOX
 - ⊗ ELECTRIC METER
 - ⊗ ELECTRIC SWITCH
 - ⊗ ELECTRIC STREET LIGHT
 - ⊗ ELECTRIC LANDSCAPE LIGHT
 - ⊗ ELECTRIC TRAFFIC SIGNAL
 - ⊗ ELECTRIC TRAFFIC SWITCH BOX
 - ⊗ ELECTRIC CABINET
 - ⊗ ELECTRIC MARKER
 - ⊗ TELEPHONE PEDESTAL
 - ⊗ TELEPHONE MANHOLE
 - ⊗ TELEPHONE MARKER
 - ⊗ VIDEO-READY ACCESS DEVICE
 - ⊗ FIBER OPTIC PULLBOX
 - ⊗ FIBER OPTIC MARKER
 - ⊗ FIBER OPTIC TEST STATION
 - ⊗ GAS METER
 - ⊗ GAS MARKER
 - ⊗ GAS REGULATOR
 - ⊗ GAS TEST STATION
 - ⊗ GAS VALVE
 - ⊗ GAS VENT
 - ⊗ WATER MANHOLE
 - ⊗ WATER MARKER
 - ⊗ WATER TEST STATION
 - ⊗ WATER VALVE
- QL LEVEL B**
- E1-01 --- ELECTRIC-XCEL/SOUTHWEST PUBLIC SERVICE.CO
 - E3-01 --- ELECTRIC - TXDOT
 - FOC1-01 --- FIBER OPTIC - AT&T
 - FOC2-01 --- FIBER OPTIC - DOBSON FIBER CO
 - T1-01 --- TELEPHONE - AT&T
 - C1-01 --- CABLE TV - CABLE ONE
 - G1-01 --- GAS - ATMOS ENERGY
 - G1-02 --- GAS - ATMOS ENERGY (2")
 - G3-01 --- GAS - UNKNOWN
 - G4-01 --- GAS - AMARILLO NATURAL GAS
 - W1-01 --- WATER - CITY OF PAMPA
 - W1-06 --- WATER - CITY OF PAMPA (6")
 - W1-10 --- WATER - CITY OF PAMPA (10")
 - WW1-01 --- SANITARY SEWER - CITY OF PAMPA
 - SD-01 --- STORM - CITY OF PAMPA
 - UNK --- UNKNOWN
 - QL LEVEL D --- ELECTRIC-XCEL/SOUTHWEST PUBLIC SERVICE.CO
 - E3-01-D --- ELECTRIC - TXDOT
 - FOC1-01-D --- FIBER OPTIC - AT&T
 - T1-01-D --- TELEPHONE - AT&T
 - C1-01-D --- CABLE TV - CABLE ONE
 - G1-01-D --- GAS - ATMOS ENERGY
 - G2-01-D --- GAS - WEST TEXAS GAS
 - G2-03-D --- GAS - WEST TEXAS GAS (3")
 - G3-01-D --- GAS - UNKNOWN
 - W1-01-D --- WATER - CITY OF PAMPA (UNKNOWN SIZE)
 - W1-02-D --- WATER - CITY OF PAMPA (2")
 - W1-06-D --- WATER - CITY OF PAMPA (6")
 - W1-10-D --- WATER - CITY OF PAMPA (10")
 - W2-04-D --- WATER - TXDOT (4")
 - W3-2.5-D --- WATER - PRIVATE (2.5")
 - W4-04-D --- WATER - WESTERN EQUIPMENT (4")
 - WW1-01-D --- SANITARY SEWER - CITY OF PAMPA
 - WW2-03-D --- SANITARY SEWER - WESTERN EQUIPMENT (3")
 - SD-01-D --- STORM - CITY OF PAMPA
 - UNK --- UNKNOWN
- OVERHEAD**
- OHT --- OVERHEAD ELECTRIC TRANSMISSION - XCEL/SOUTHWESTERN PUBLIC SERVICE CO
 - OE1 --- OVERHEAD ELECTRIC - XCEL ENERGY-SOUTHWESTERN PUBLIC SERVICE CO
 - OE1/FOC1/T1/C1 --- OVERHEAD ELEC/FOC/TEL/CATV - XCEL/AT&T/AT&T/CABLE ONE
 - OE1/FOC1 --- OVERHEAD ELEC/FOC/TEL - XCEL/AT&T
 - OE1/FOC1/T1 --- OVERHEAD ELEC/FOC/TEL - XCEL/AT&T/AT&T
 - OE1/T1 --- OVERHEAD ELEC/TEL - XCEL ENERGY/AT&T
 - OE1/T1/C1/C1 --- OVERHEAD ELEC/TEL/TEL/CATV/CATV - XCEL/AT&T/AT&T/CABLE ONE/CABLE ONE
 - OE1/T1/T1/C1 --- OVERHEAD ELEC/TEL/TEL/CATV - XCEL/AT&T/AT&T/CABLE ONE
 - OE1/T1/C1 --- OVERHEAD ELEC/TEL/CATV - XCEL/AT&T/CABLE ONE
 - OE1/C1 --- OVERHEAD ELEC/CATV - XCEL ENERGY/CABLE ONE
 - OE1/C1 --- OVERHEAD ELEC/CATV - XCEL ENERGY/CABLE ONE
 - FOC1 --- OVERHEAD FOC - AT&T
 - OT1 --- OVERHEAD TEL - AT&T
 - FOC1/T1/C1 --- OVERHEAD TEL/FOC/CATV - AT&T/AT&T/CABLE ONE
 - OT1/C1 --- OVERHEAD TEL/CATV - AT&T/CABLE ONE
 - OC1 --- OVERHEAD CATV - CABLE ONE



REV. NO.	DATE	DESCRIPTION	BY

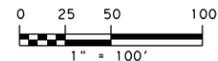

CobbFendley
 13430 Northwest Freeway, Ste. 1100
 Houston, Texas 77040
 713.462.3242
 www.cobbendley.com




US 60
EXISTING UTILITY PLANS
 STA 93+00 TO STA 115+00
 SHEET 03 OF 36

FED. RD. DIV. NO.	STATE	PROJECT NO.	HIGHWAY NO.		
6	TEXAS	SEE TITLE SHEET	US 60		
STATE DISTRICT	COUNTY	CONTROL NO.	SECTION NO.	JOB NO.	SHEET NO.
AMA	GRAY	0619	07	053, ETC	141


NOTES:

- THE EXISTENCE AND LOCATION OF UTILITIES INDICATED ON THE PLANS ARE TAKEN FROM FIELD INVESTIGATION, THE BEST RECORDS AVAILABLE, AND ARE APPROXIMATED. THE CONTRACTOR SHALL LOCATE ALL UTILITIES (PUBLIC OR PRIVATE, SHOWN HERE OR NOT SHOWN) BOTH VERTICALLY AND HORIZONTALLY PRIOR TO COMMENCING WORK, WHETHER UTILITIES ARE ANTICIPATED TO BE IN DIRECT CONFLICT WITH PROPOSED WORK ACTIVITIES OR NOT. THE CONTRACTOR IS FULLY RESPONSIBLE FOR ANY DAMAGES CAUSED BY THE FAILURE TO LOCATE, PRESERVE, OR PROTECT THESE UTILITIES.
- ALL WORK ACTIVITIES (INCLUDING BUT NOT LIMITED TO CONSTRUCTING DETOURS, CULVERT EXTENSION AND REPLACEMENTS, EXCAVATION, DITCH GRADING, ETC.) SHALL NOT COMMENCE UNTIL ALL UTILITIES, ESPECIALLY UTILITIES WITHIN EXISTING ROW AND PARALLEL TO US 60, ARE IDENTIFIED. IF CONFLICTS WITH PROPOSED CONSTRUCTION OR WORK ACTIVITIES ARE IDENTIFIED, CONTRACTOR IS TO CEASE WORK IN THE LOCATION OF THE CONFLICT IMMEDIATELY.

- LEGEND
- ⊗ TELEPHONE POLE
 - ⊗ POWER POLE
 - ⊞ ELECTRIC PULLBOX
 - ⊞ ELECTRIC METER
 - ⊞ ELECTRIC SWITCH
 - ⊞ ELECTRIC STREET LIGHT
 - ⊞ ELECTRIC LANDSCAPE LIGHT
 - ⊞ ELECTRIC TRAFFIC SIGNAL
 - ⊞ ELECTRIC TRAFFIC SWITCH BOX
 - ⊞ ELECTRIC CABINET
 - ⊞ ELECTRIC MARKER
 - ⊞ TELEPHONE PEDESTAL
 - ⊞ TELEPHONE MANHOLE
 - ⊞ TELEPHONE MARKER
 - ⊞ VIDEO-READY ACCESS DEVICE
 - ⊞ FIBER OPTIC PULLBOX
 - ⊞ FIBER OPTIC MARKER
 - ⊞ FIBER OPTIC TEST STATION
 - ⊞ GAS METER
 - ⊞ GAS MARKER
 - ⊞ GAS REGULATOR
 - ⊞ GAS TEST STATION
 - ⊞ GAS VALVE
 - ⊞ GAS VENT
 - ⊞ WATER MANHOLE
 - ⊞ WATER MARKER
 - ⊞ WATER TEST STATION
 - ⊞ WATER VALVE
- QL LEVEL B
- E1-01 ELECTRIC-XCEL/SOUTHWEST PUBLIC SERVICE.CO
 - E3-01 ELECTRIC - TXDOT
 - FOC1-01 FIBER OPTIC - AT&T
 - FOC2-01 FIBER OPTIC - DOBSON FIBER CO
 - T1-01 TELEPHONE - AT&T
 - C1-01 CABLE TV - CABLE ONE
 - G1-01 GAS - ATMOS ENERGY
 - G1-02 GAS - ATMOS ENERGY (2")
 - G3-01 GAS - UNKNOWN
 - G4-01 GAS - AMARILLO NATURAL GAS
 - W1-01 WATER - CITY OF PAMPA
 - W1-06 WATER - CITY OF PAMPA (6")
 - W1-10 WATER - CITY OF PAMPA (10")
 - WW1-01 SANITARY SEWER - CITY OF PAMPA
 - SD-01 STORM - CITY OF PAMPA
 - UNK UNKNOWN
 - QL LEVEL D
 - E1-01-D ELECTRIC-XCEL/SOUTHWEST PUBLIC SERVICE.CO
 - E3-01-D ELECTRIC - TXDOT
 - FOC1-01-D FIBER OPTIC - AT&T
 - T1-01-D TELEPHONE - AT&T
 - C1-01-D CABLE TV - CABLE ONE
 - G1-01-D GAS - ATMOS ENERGY
 - G2-01-D GAS - WEST TEXAS GAS
 - G2-03-D GAS - WEST TEXAS GAS (3")
 - G3-01-D GAS - UNKNOWN
 - W1-01-D WATER - CITY OF PAMPA (UNKNOWN SIZE)
 - W1-02-D WATER - CITY OF PAMPA (2")
 - W1-06-D WATER - CITY OF PAMPA (6")
 - W1-10-D WATER - CITY OF PAMPA (10")
 - W2-04-D WATER - TXDOT (4")
 - W3-2.5-D WATER - PRIVATE (2.5")
 - W4-04-D WATER - WESTERN EQUIPMENT (4")
 - WW1-01-D SANITARY SEWER - CITY OF PAMPA
 - WW2-03-D SANITARY SEWER - WESTERN EQUIPMENT (3")
 - SD-01-D STORM - CITY OF PAMPA
 - UNK UNKNOWN
- OVERHEAD
- OE1 OVERHEAD ELECTRIC TRANSMISSION - XCEL/SOUTHWESTERN PUBLIC SERVICE CO
 - OE1 OVERHEAD ELECTRIC - XCEL ENERGY-SOUTHWESTERN PUBLIC SERVICE CO
 - OE1/FOC1/T1/C1 OVERHEAD ELEC/FOC/TEL/CATV - XCEL/AT&T/AT&T/CABLE ONE
 - OE1/FOC1 OVERHEAD ELEC/FOC/TEL - XCEL/AT&T
 - OE1/FOC1/T1 OVERHEAD ELEC/FOC/TEL - XCEL/AT&T/AT&T
 - OE1/T1 OVERHEAD ELEC/TEL - XCEL ENERGY/AT&T
 - OE1/T1/T1/C1 OVERHEAD ELEC/TEL/TEL/CATV/CATV - XCEL/AT&T/AT&T/CABLE ONE/CABLE ONE
 - OE1/T1/T1/C1 OVERHEAD ELEC/TEL/TEL/CATV - XCEL/AT&T/AT&T/CABLE ONE
 - OE1/T1/C1 OVERHEAD ELEC/TEL/CATV - XCEL/AT&T/CABLE ONE
 - OE1/C1 OVERHEAD ELEC/CATV - XCEL ENERGY/CABLE ONE
 - OE1/C1 OVERHEAD ELEC/CATV - XCEL ENERGY/CABLE ONE
 - FOC1 OVERHEAD FOC - AT&T
 - OT1 OVERHEAD TEL - AT&T
 - FOC1/T1/C1 OVERHEAD TEL/FOC/CATV - AT&T/AT&T/CABLE ONE
 - OT1/C1 OVERHEAD TEL/CATV - AT&T/CABLE ONE
 - OC1 OVERHEAD CATV - CABLE ONE

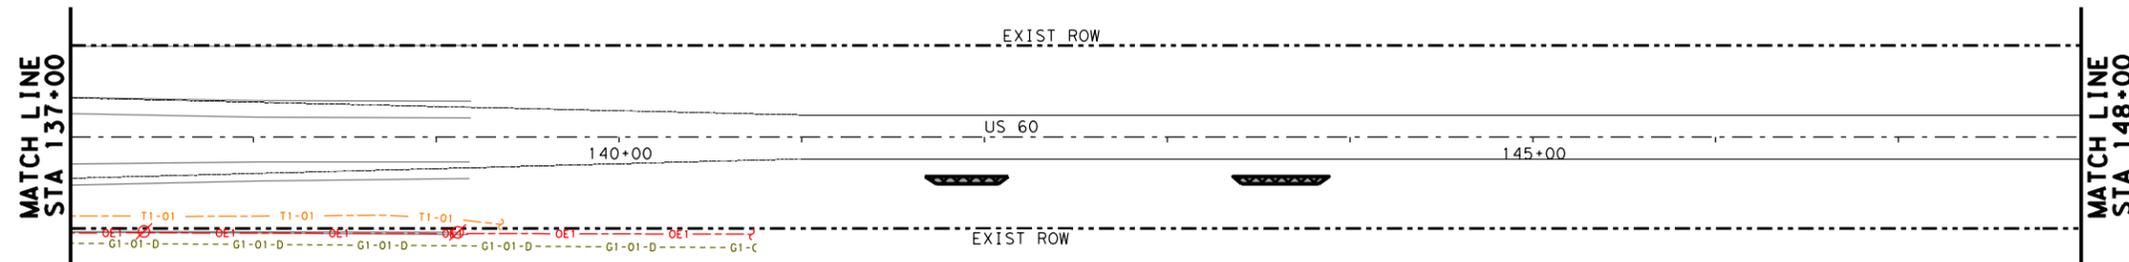

SUE RESEARCH NOT PERFORMED AFTER STA.141+00.
NO EXCAVATION WORK IS PLANNED IN THIS AREA.

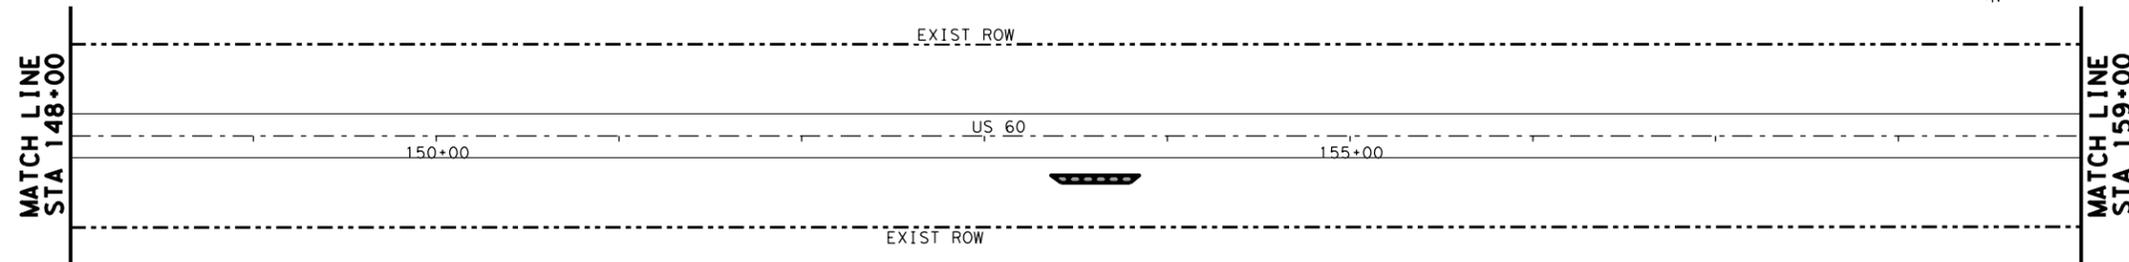


SUE RESEARCH NOT PERFORMED IN THIS AREA.
NO EXCAVATION WORK IS PLANNED IN THIS AREA.



T.E. Hunt
4/2/2021

REV. NO.	DATE	DESCRIPTION	BY

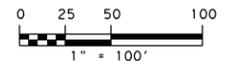

CobbFendley
13430 Northwest Freeway, Ste. 1100
Houston, Texas 77040
713.462.3242
www.cobbendley.com




US 60
EXISTING UTILITY PLANS
STA 137+00 TO STA 159+00
SHEET 05 OF 36

FED. RD. DIV. NO.	STATE	PROJECT NO.	HIGHWAY NO.		
6	TEXAS	SEE TITLE SHEET	US 60		
STATE DISTRICT	COUNTY	CONTROL NO.	SECTION NO.	JOB NO.	SHEET NO.
AMA	GRAY	0619	07	053, ETC	143


4/12/2021 F:\P\J\ref\2019\1004_TxDOT_5x5_P58E\03_US60_Amarrillo\ING500\UST\ING506-SUE\02-Sheet\US60-SUE-05.dgn 9:45:54 AM

NOTES:
1. THE EXISTENCE AND LOCATION OF UTILITIES INDICATED ON THE PLANS ARE TAKEN FROM FIELD INVESTIGATION, THE BEST RECORDS AVAILABLE, AND ARE APPROXIMATED. THE CONTRACTOR SHALL LOCATE ALL UTILITIES (PUBLIC OR PRIVATE, SHOWN HERE OR NOT SHOWN) BOTH VERTICALLY AND HORIZONTALLY PRIOR TO COMMENCING WORK, WHETHER UTILITIES ARE ANTICIPATED TO BE IN DIRECT CONFLICT WITH PROPOSED WORK ACTIVITIES OR NOT. THE CONTRACTOR IS FULLY RESPONSIBLE FOR ANY DAMAGES CAUSED BY THE FAILURE TO LOCATE, PRESERVE, OR PROTECT THESE UTILITIES.
2. ALL WORK ACTIVITIES (INCLUDING BUT NOT LIMITED TO CONSTRUCTING DETOURS, CULVERT EXTENSION AND REPLACEMENTS, EXCAVATION, DITCH GRADING, ETC.) SHALL NOT COMMENCE UNTIL ALL UTILITIES, ESPECIALLY UTILITIES WITHIN EXISTING ROW AND PARALLEL TO US 60, ARE IDENTIFIED. IF CONFLICTS WITH PROPOSED CONSTRUCTION OR WORK ACTIVITIES ARE IDENTIFIED, CONTRACTOR IS TO CEASE WORK IN THE LOCATION OF THE CONFLICT IMMEDIATELY.

- LEGEND
- ⊗ TELEPHONE POLE
 - ⊗ POWER POLE
 - ⊞ ELECTRIC PULLBOX
 - ⊞ ELECTRIC METER
 - ⊞ ELECTRIC SWITCH
 - ⊞ ELECTRIC STREET LIGHT
 - ⊞ ELECTRIC LANDSCAPE LIGHT
 - ⊞ ELECTRIC TRAFFIC SIGNAL
 - ⊞ ELECTRIC TRAFFIC SWITCH BOX
 - ⊞ ELECTRIC CABINET
 - ⊞ ELECTRIC MARKER
 - ⊞ TELEPHONE PEDESTAL
 - ⊞ TELEPHONE MANHOLE
 - ⊞ TELEPHONE MARKER
 - ⊞ VIDEO-READY ACCESS DEVICE
 - ⊞ FIBER OPTIC PULLBOX
 - ⊞ FIBER OPTIC MARKER
 - ⊞ FIBER OPTIC TEST STATION
 - ⊞ GAS METER
 - ⊞ GAS MARKER
 - ⊞ GAS REGULATOR
 - ⊞ GAS TEST STATION
 - ⊞ GAS VALVE
 - ⊞ GAS VENT
 - ⊞ WATER MANHOLE
 - ⊞ WATER MARKER
 - ⊞ WATER TEST STATION
 - ⊞ WATER VALVE
- QL LEVEL B
- E1-01 --- ELECTRIC-XCEL/SOUTHWEST PUBLIC SERVICE.CO
 - E3-01 --- ELECTRIC - TXDOT
 - FOC1-01 --- FIBER OPTIC - AT&T
 - FOC2-01 --- FIBER OPTIC - DOBSON FIBER CO
 - T1-01 --- TELEPHONE - AT&T
 - C1-01 --- CABLE TV - CABLE ONE
 - G1-01 --- GAS - ATMOS ENERGY
 - G1-02 --- GAS - ATMOS ENERGY (2")
 - G3-01 --- GAS - UNKNOWN
 - G4-01 --- GAS - AMARILLO NATURAL GAS
 - W1-01 --- WATER - CITY OF PAMPA
 - W1-06 --- WATER - CITY OF PAMPA (6")
 - W1-10 --- WATER - CITY OF PAMPA (10")
 - WW1-01 --- SANITARY SEWER - CITY OF PAMPA
 - SD-01 --- STORM - CITY OF PAMPA
 - UNK --- UNKNOWN
 - QL LEVEL D
 - E1-01-D --- ELECTRIC-XCEL/SOUTHWEST PUBLIC SERVICE.CO
 - E3-01-D --- ELECTRIC - TXDOT
 - FOC1-01-D --- FIBER OPTIC - AT&T
 - T1-01-D --- TELEPHONE - AT&T
 - C1-01-D --- CABLE TV - CABLE ONE
 - G1-01-D --- GAS - ATMOS ENERGY
 - G2-01-D --- GAS - WEST TEXAS GAS
 - G2-03-D --- GAS - WEST TEXAS GAS (3")
 - G3-01-D --- GAS - UNKNOWN
 - W1-01-D --- WATER - CITY OF PAMPA (UNKNOWN SIZE)
 - W1-02-D --- WATER - CITY OF PAMPA (2")
 - W1-06-D --- WATER - CITY OF PAMPA (6")
 - W1-10-D --- WATER - CITY OF PAMPA (10")
 - W2-04-D --- WATER - TXDOT (4")
 - W3-2.5-D --- WATER - PRIVATE (2.5")
 - W4-04-D --- WATER - WESTERN EQUIPMENT (4")
 - WW1-01-D --- SANITARY SEWER - CITY OF PAMPA
 - WW2-03-D --- SANITARY SEWER - WESTERN EQUIPMENT (3")
 - SD-01-D --- STORM - CITY OF PAMPA
 - UNK --- UNKNOWN
- OVERHEAD
- OHT --- OVERHEAD ELECTRIC TRANSMISSION - XCEL/SOUTHWESTERN PUBLIC SERVICE CO
 - OE1 --- OVERHEAD ELECTRIC - XCEL ENERGY-SOUTHWESTERN PUBLIC SERVICE CO
 - OE1/FOC1/T1/C1 --- OVERHEAD ELEC/FOC/TEL/CATV - XCEL/AT&T/AT&T/CABLE ONE
 - OE1/FOC1 --- OVERHEAD ELEC/FOC/TEL - XCEL/AT&T
 - OE1/FOC1/T1 --- OVERHEAD ELEC/FOC/TEL - XCEL/AT&T/AT&T
 - OE1/T1 --- OVERHEAD ELEC/TEL - XCEL ENERGY/AT&T
 - OE1/T1/T1/C1 --- OVERHEAD ELEC/TEL/TEL/CATV/CATV - XCEL/AT&T/AT&T/CABLE ONE/CABLE ONE
 - OE1/T1/T1/C1 --- OVERHEAD ELEC/TEL/TEL/CATV - XCEL/AT&T/AT&T/CABLE ONE
 - OE1/T1/C1 --- OVERHEAD ELEC/TEL/CATV - XCEL/AT&T/CABLE ONE
 - OE1/C1 --- OVERHEAD ELEC/CATV - XCEL ENERGY/CABLE ONE
 - OE1/C1 --- OVERHEAD ELEC/CATV - XCEL ENERGY/CABLE ONE
 - OFOC1 --- OVERHEAD FOC - AT&T
 - OT1 --- OVERHEAD TEL - AT&T
 - OFOC1/T1/C1 --- OVERHEAD TEL/FOC/CATV - AT&T/AT&T/CABLE ONE
 - OT1/C1 --- OVERHEAD TEL/CATV - AT&T/CABLE ONE
 - OC1 --- OVERHEAD CATV - CABLE ONE

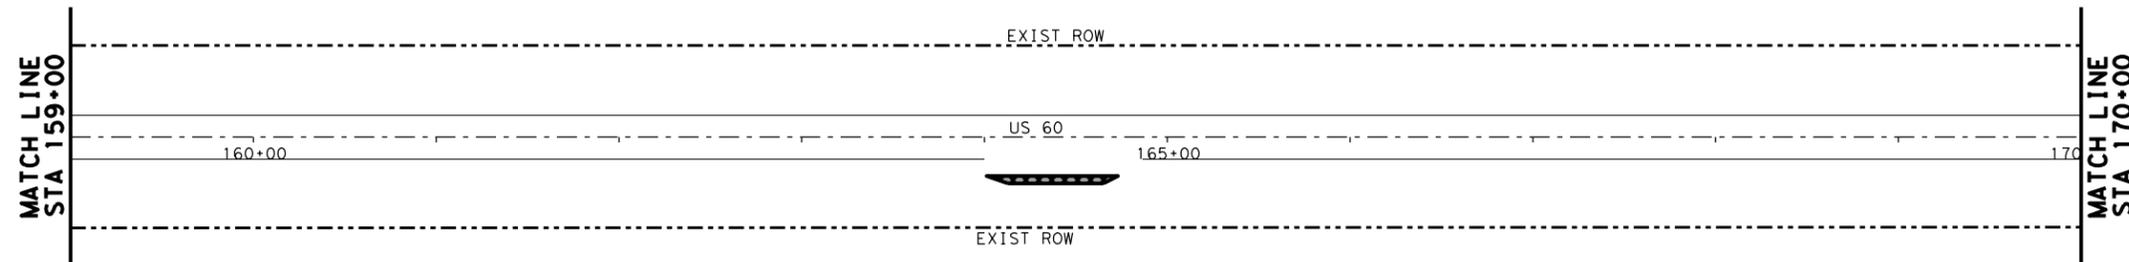

SUE RESEARCH NOT PERFORMED IN THIS AREA.
NO EXCAVATION WORK IS PLANNED IN THIS AREA.

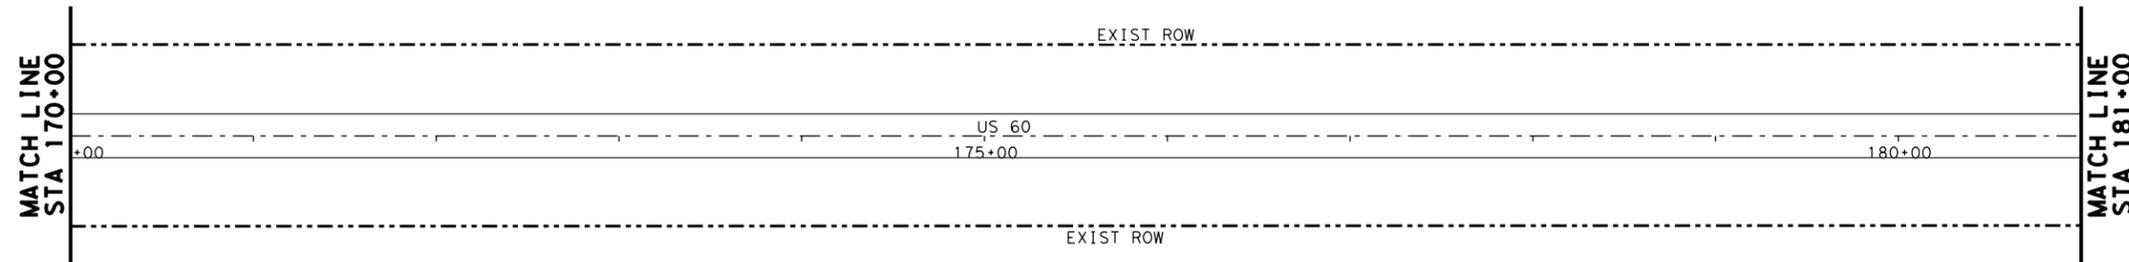

SUE RESEARCH NOT PERFORMED IN THIS AREA.
NO EXCAVATION WORK IS PLANNED IN THIS AREA.



T.E. Hunt
4/2/2021

REV. NO.	DATE	DESCRIPTION	BY



CobbFendley
 13430 Northwest Freeway, Ste. 1100
 Houston, Texas 77040
 713.462.3242
 www.cobbhendley.com



US 60
EXISTING UTILITY PLANS
STA 159+00 TO STA 181+00
SHEET 06 OF 36


FED. RD. DIV. NO.	STATE	PROJECT NO.	HIGHWAY NO.
6	TEXAS	SEE TITLE SHEET	US 60
STATE DISTRICT	COUNTY	CONTROL NO.	SECTION NO.
AMA	GRAY	0619	07
		JOB NO.	SHEET NO.
		053, ETC	144

4/2/2021
 F:\P\Jerd\2019\1004_TxDOT_5x5_P58E\03_US60_Amarrillo\EN\6500\UST\N\606-SUE\02-Sheet\US60-SUE-06.dgn
 9:45:54 AM


NOTES:

- THE EXISTENCE AND LOCATION OF UTILITIES INDICATED ON THE PLANS ARE TAKEN FROM FIELD INVESTIGATION, THE BEST RECORDS AVAILABLE, AND ARE APPROXIMATED. THE CONTRACTOR SHALL LOCATE ALL UTILITIES (PUBLIC OR PRIVATE, SHOWN HERE OR NOT SHOWN) BOTH VERTICALLY AND HORIZONTALLY PRIOR TO COMMENCING WORK, WHETHER UTILITIES ARE ANTICIPATED TO BE IN DIRECT CONFLICT WITH PROPOSED WORK ACTIVITIES OR NOT. THE CONTRACTOR IS FULLY RESPONSIBLE FOR ANY DAMAGES CAUSED BY THE FAILURE TO LOCATE, PRESERVE, OR PROTECT THESE UTILITIES.
- ALL WORK ACTIVITIES (INCLUDING BUT NOT LIMITED TO CONSTRUCTING DETOURS, CULVERT EXTENSION AND REPLACEMENTS, EXCAVATION, DITCH GRADING, ETC.) SHALL NOT COMMENCE UNTIL ALL UTILITIES, ESPECIALLY UTILITIES WITHIN EXISTING ROW AND PARALLEL TO US 60, ARE IDENTIFIED. IF CONFLICTS WITH PROPOSED CONSTRUCTION OR WORK ACTIVITIES ARE IDENTIFIED, CONTRACTOR IS TO CEASE WORK IN THE LOCATION OF THE CONFLICT IMMEDIATELY.

- LEGEND
- ⊗ TELEPHONE POLE
 - ⊗ POWER POLE
 - ⊞ ELECTRIC PULLBOX
 - ⊞ ELECTRIC METER
 - ⊞ ELECTRIC SWITCH
 - ⊞ ELECTRIC STREET LIGHT
 - ⊞ ELECTRIC LANDSCAPE LIGHT
 - ⊞ ELECTRIC TRAFFIC SIGNAL
 - ⊞ ELECTRIC TRAFFIC SWITCH BOX
 - ⊞ ELECTRIC CABINET
 - ⊞ ELECTRIC MARKER
 - ⊞ TELEPHONE PEDESTAL
 - ⊞ TELEPHONE MANHOLE
 - ⊞ TELEPHONE MARKER
 - ⊞ VIDEO-READY ACCESS DEVICE
 - ⊞ FIBER OPTIC PULLBOX
 - ⊞ FIBER OPTIC MARKER
 - ⊞ FIBER OPTIC TEST STATION
 - ⊞ GAS METER
 - ⊞ GAS MARKER
 - ⊞ GAS REGULATOR
 - ⊞ GAS TEST STATION
 - ⊞ GAS VALVE
 - ⊞ GAS VENT
 - ⊞ WATER MANHOLE
 - ⊞ WATER MARKER
 - ⊞ WATER TEST STATION
 - ⊞ WATER VALVE
- QL LEVEL B
- E1-01 --- ELECTRIC-XCEL/SOUTHWEST PUBLIC SERVICE.CO
 - E3-01 --- ELECTRIC - TXDOT
 - FOC1-01 --- FIBER OPTIC - AT&T
 - FOC2-01 --- FIBER OPTIC - DOBSON FIBER CO
 - T1-01 --- TELEPHONE - AT&T
 - C1-01 --- CABLE TV - CABLE ONE
 - G1-01 --- GAS - ATMOS ENERGY
 - G1-02 --- GAS - ATMOS ENERGY (2")
 - G3-01 --- GAS - UNKNOWN
 - G4-01 --- GAS - AMARILLO NATURAL GAS
 - W1-01 --- WATER - CITY OF PAMPA
 - W1-06 --- WATER - CITY OF PAMPA (6")
 - W1-10 --- WATER - CITY OF PAMPA (10")
 - WW1-01 --- SANITARY SEWER - CITY OF PAMPA
 - SD-01 --- STORM - CITY OF PAMPA
 - UNK --- UNKNOWN
 - QL LEVEL D
 - E1-01-D --- ELECTRIC-XCEL/SOUTHWEST PUBLIC SERVICE.CO
 - E3-01-D --- ELECTRIC - TXDOT
 - FOC1-01-D --- FIBER OPTIC - AT&T
 - T1-01-D --- TELEPHONE - AT&T
 - C1-01-D --- CABLE TV - CABLE ONE
 - G1-01-D --- GAS - ATMOS ENERGY
 - G2-01-D --- GAS - WEST TEXAS GAS
 - G2-03-D --- GAS - WEST TEXAS GAS (3")
 - G3-01-D --- GAS - UNKNOWN
 - W1-01-D --- WATER - CITY OF PAMPA (UNKNOWN SIZE)
 - W1-02-D --- WATER - CITY OF PAMPA (2")
 - W1-06-D --- WATER - CITY OF PAMPA (6")
 - W1-10-D --- WATER - CITY OF PAMPA (10")
 - W2-04-D --- WATER - TXDOT (4")
 - W3-2.5-D --- WATER - PRIVATE (2.5")
 - W4-04-D --- WATER - WESTERN EQUIPMENT (4")
 - WW1-01-D --- SANITARY SEWER - CITY OF PAMPA
 - WW2-03-D --- SANITARY SEWER - WESTERN EQUIPMENT (3")
 - SD-01-D --- STORM - CITY OF PAMPA
 - UNK --- UNKNOWN
- OVERHEAD
- OHT --- OVERHEAD ELECTRIC TRANSMISSION - XCEL/SOUTHWESTERN PUBLIC SERVICE CO
 - OE1 --- OVERHEAD ELECTRIC - XCEL ENERGY-SOUTHWESTERN PUBLIC SERVICE CO
 - OE1/FOC1/T1/C1 --- OVERHEAD ELEC/FOC/TEL/CATV - XCEL/AT&T/AT&T/CABLE ONE
 - OE1/FOC1 --- OVERHEAD ELEC/FOC/TEL - XCEL/AT&T
 - OE1/FOC1/T1 --- OVERHEAD ELEC/FOC/TEL - XCEL/AT&T/AT&T
 - OE1/T1 --- OVERHEAD ELEC/TEL - XCEL ENERGY/AT&T
 - OE1/T1/T1/C1 --- OVERHEAD ELEC/TEL/TEL/CATV - XCEL/AT&T/AT&T/CABLE ONE/CABLE ONE
 - OE1/T1/T1/C1 --- OVERHEAD ELEC/TEL/TEL/CATV - XCEL/AT&T/AT&T/CABLE ONE
 - OE1/T1/C1 --- OVERHEAD ELEC/TEL/CATV - XCEL/AT&T/CABLE ONE
 - OE1/C1 --- OVERHEAD ELEC/CATV - XCEL ENERGY/CABLE ONE
 - OE1/C1 --- OVERHEAD ELEC/CATV - XCEL ENERGY/CABLE ONE
 - OFOC1 --- OVERHEAD FOC - AT&T
 - OT1 --- OVERHEAD TEL - AT&T
 - OFOC1/T1/C1 --- OVERHEAD TEL/FOC/CATV - AT&T/AT&T/CABLE ONE
 - OT1/C1 --- OVERHEAD TEL/CATV - AT&T/CABLE ONE
 - OC1 --- OVERHEAD CATV - CABLE ONE

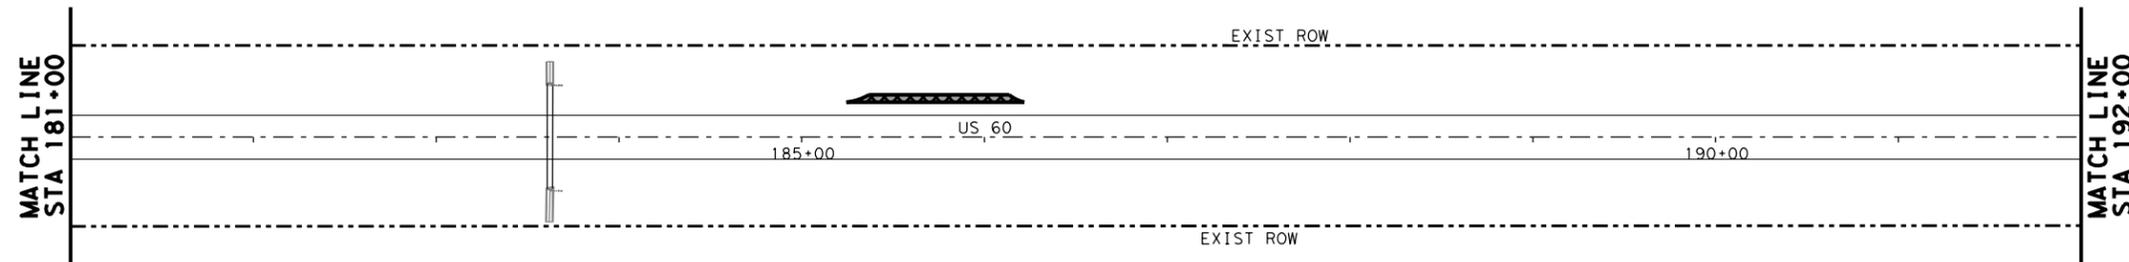


SUE RESEARCH NOT PERFORMED IN THIS AREA.
NO EXCAVATION WORK IS PLANNED IN THIS AREA.

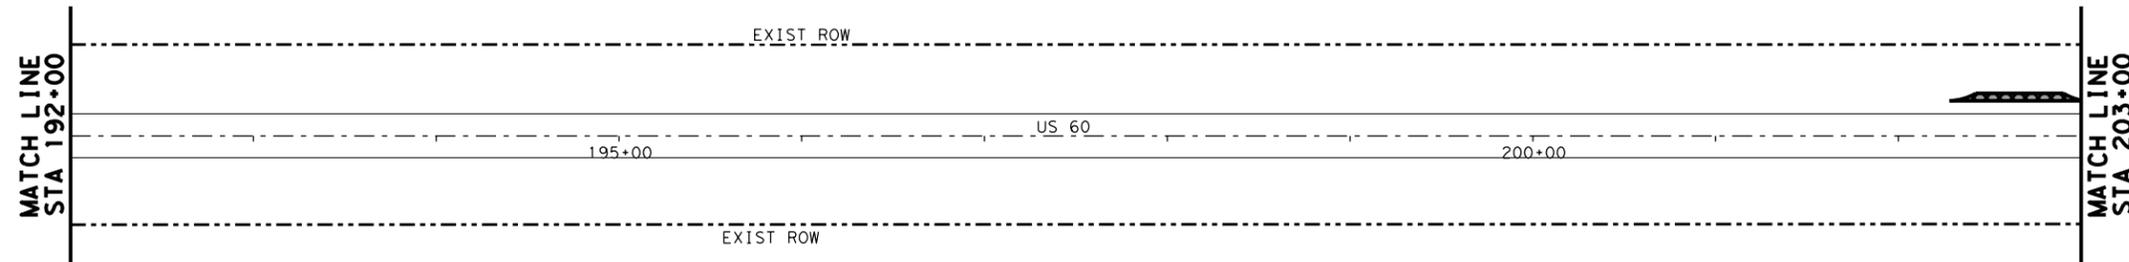

SUE RESEARCH NOT PERFORMED IN THIS AREA.
NO EXCAVATION WORK IS PLANNED IN THIS AREA.



REV. NO.	DATE	DESCRIPTION	BY

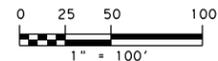

CobbFendley 13430 Northwest Freeway, Ste. 1100
Houston, Texas 77040
713.462.3242
www.cobbhendley.com



US 60
EXISTING UTILITY PLANS
STA 181+00 TO STA 203+00
SHEET 07 OF 36


FED. RD. DIV. NO.	STATE	PROJECT NO.	HIGHWAY NO.
6	TEXAS	SEE TITLE SHEET	US 60
STATE DISTRICT	COUNTY	CONTROL NO.	SECTION NO.
AMA	GRAY	0619	07
		JOB NO.	SHEET NO.
		053, ETC	145

NOTES:


- THE EXISTENCE AND LOCATION OF UTILITIES INDICATED ON THE PLANS ARE TAKEN FROM FIELD INVESTIGATION, THE BEST RECORDS AVAILABLE, AND ARE APPROXIMATED. THE CONTRACTOR SHALL LOCATE ALL UTILITIES (PUBLIC OR PRIVATE, SHOWN HERE OR NOT SHOWN) BOTH VERTICALLY AND HORIZONTALLY PRIOR TO COMMENCING WORK, WHETHER UTILITIES ARE ANTICIPATED TO BE IN DIRECT CONFLICT WITH PROPOSED WORK ACTIVITIES OR NOT. THE CONTRACTOR IS FULLY RESPONSIBLE FOR ANY DAMAGES CAUSED BY THE FAILURE TO LOCATE, PRESERVE, OR PROTECT THESE UTILITIES.
- ALL WORK ACTIVITIES (INCLUDING BUT NOT LIMITED TO CONSTRUCTING DETOURS, CULVERT EXTENSION AND REPLACEMENTS, EXCAVATION, DITCH GRADING, ETC.) SHALL NOT COMMENCE UNTIL ALL UTILITIES, ESPECIALLY UTILITIES WITHIN EXISTING ROW AND PARALLEL TO US 60, ARE IDENTIFIED. IF CONFLICTS WITH PROPOSED CONSTRUCTION OR WORK ACTIVITIES ARE IDENTIFIED, CONTRACTOR IS TO CEASE WORK IN THE LOCATION OF THE CONFLICT IMMEDIATELY.

4/12/2021
 F:\P\Proj\2019\1004_TxDOT_5x5_PSB&E\03_US60_Amarrillo\ENGIN\500-UST\N\506-SUE\02-Sheet\5-US60-SUE-07.dgn
 94555 AW

- LEGEND
- ⊗ TELEPHONE POLE
 - ⊗ POWER POLE
 - ⊗ ELECTRIC PULLBOX
 - ⊗ ELECTRIC METER
 - ⊗ ELECTRIC SWITCH
 - ⊗ ELECTRIC STREET LIGHT
 - ⊗ ELECTRIC LANDSCAPE LIGHT
 - ⊗ ELECTRIC TRAFFIC SIGNAL
 - ⊗ ELECTRIC TRAFFIC SWITCH BOX
 - ⊗ ELECTRIC CABINET
 - ⊗ ELECTRIC MARKER
 - ⊗ TELEPHONE PEDESTAL
 - ⊗ TELEPHONE MANHOLE
 - ⊗ TELEPHONE MARKER
 - ⊗ VIDEO-READY ACCESS DEVICE
 - ⊗ FIBER OPTIC PULLBOX
 - ⊗ FIBER OPTIC MARKER
 - ⊗ FIBER OPTIC TEST STATION
 - ⊗ GAS METER
 - ⊗ GAS MARKER
 - ⊗ GAS REGULATOR
 - ⊗ GAS TEST STATION
 - ⊗ GAS VALVE
 - ⊗ GAS VENT
 - ⊗ WATER MANHOLE
 - ⊗ WATER MARKER
 - ⊗ WATER TEST STATION
 - ⊗ WATER VALVE
- QL LEVEL B
- E1-01 --- ELECTRIC-XCEL/SOUTHWEST PUBLIC SERVICE.CO
 - E3-01 --- ELECTRIC - TXDOT
 - FOC1-01 --- FIBER OPTIC - AT&T
 - FOC2-01 --- FIBER OPTIC - DOBSON FIBER CO
 - T1-01 --- TELEPHONE - AT&T
 - C1-01 --- CABLE TV - CABLE ONE
 - G1-01 --- GAS - ATMOS ENERGY
 - G1-02 --- GAS - ATMOS ENERGY (2")
 - G3-01 --- GAS - UNKNOWN
 - G4-01 --- GAS - AMARILLO NATURAL GAS
 - W1-01 --- WATER - CITY OF PAMPA
 - W1-06 --- WATER - CITY OF PAMPA (6")
 - W1-10 --- WATER - CITY OF PAMPA (10")
 - WW1-01 --- SANITARY SEWER - CITY OF PAMPA
 - SD-01 --- STORM - CITY OF PAMPA
 - UNK --- UNKNOWN
 - QL LEVEL D
 - E1-01-D --- ELECTRIC-XCEL/SOUTHWEST PUBLIC SERVICE.CO
 - E3-01-D --- ELECTRIC - TXDOT
 - FOC1-01-D --- FIBER OPTIC - AT&T
 - T1-01-D --- TELEPHONE - AT&T
 - C1-01-D --- CABLE TV - CABLE ONE
 - G1-01-D --- GAS - ATMOS ENERGY
 - G2-01-D --- GAS - WEST TEXAS GAS
 - G2-03-D --- GAS - WEST TEXAS GAS (3")
 - G3-01-D --- GAS - UNKNOWN
 - W1-01-D --- WATER - CITY OF PAMPA (UNKNOWN SIZE)
 - W1-02-D --- WATER - CITY OF PAMPA (2")
 - W1-06-D --- WATER - CITY OF PAMPA (6")
 - W1-10-D --- WATER - CITY OF PAMPA (10")
 - W2-04-D --- WATER - TXDOT (4")
 - W3-2.5-D --- WATER - PRIVATE (2.5")
 - W4-04-D --- WATER - WESTERN EQUIPMENT (4")
 - WW1-01-D --- SANITARY SEWER - CITY OF PAMPA
 - WW2-03-D --- SANITARY SEWER - WESTERN EQUIPMENT (3")
 - SD-01-D --- STORM - CITY OF PAMPA
 - UNK --- UNKNOWN
- OVERHEAD
- OHT --- OVERHEAD ELECTRIC TRANSMISSION - XCEL/SOUTHWESTERN PUBLIC SERVICE CO
 - OE1 --- OVERHEAD ELECTRIC - XCEL ENERGY-SOUTHWESTERN PUBLIC SERVICE CO
 - OE1/FOC1/T1/C1 --- OVERHEAD ELEC/FOC/TEL/CATV - XCEL/AT&T/AT&T/CABLE ONE
 - OE1/FOC1 --- OVERHEAD ELEC/FOC/TEL - XCEL/AT&T
 - OE1/FOC1/T1 --- OVERHEAD ELEC/FOC/TEL - XCEL/AT&T/AT&T
 - OE1/T1 --- OVERHEAD ELEC/TEL - XCEL ENERGY/AT&T
 - OE1/T1/T1/C1 --- OVERHEAD ELEC/TEL/TEL/CATV/CATV - XCEL/AT&T/AT&T/CABLE ONE/CABLE ONE
 - OE1/T1/T1/C1 --- OVERHEAD ELEC/TEL/TEL/CATV - XCEL/AT&T/AT&T/CABLE ONE
 - OE1/T1/C1 --- OVERHEAD ELEC/TEL/CATV - XCEL/AT&T/CABLE ONE
 - OE1/C1 --- OVERHEAD ELEC/CATV - XCEL ENERGY/CABLE ONE
 - OE1/C1 --- OVERHEAD ELEC/CATV - XCEL ENERGY/CABLE ONE
 - OFOC1 --- OVERHEAD FOC - AT&T
 - OT1 --- OVERHEAD TEL - AT&T
 - OFOC1/T1/C1 --- OVERHEAD TEL/FOC/CATV - AT&T/AT&T/CABLE ONE
 - OT1/C1 --- OVERHEAD TEL/CATV - AT&T/CABLE ONE
 - OC1 --- OVERHEAD CATV - CABLE ONE

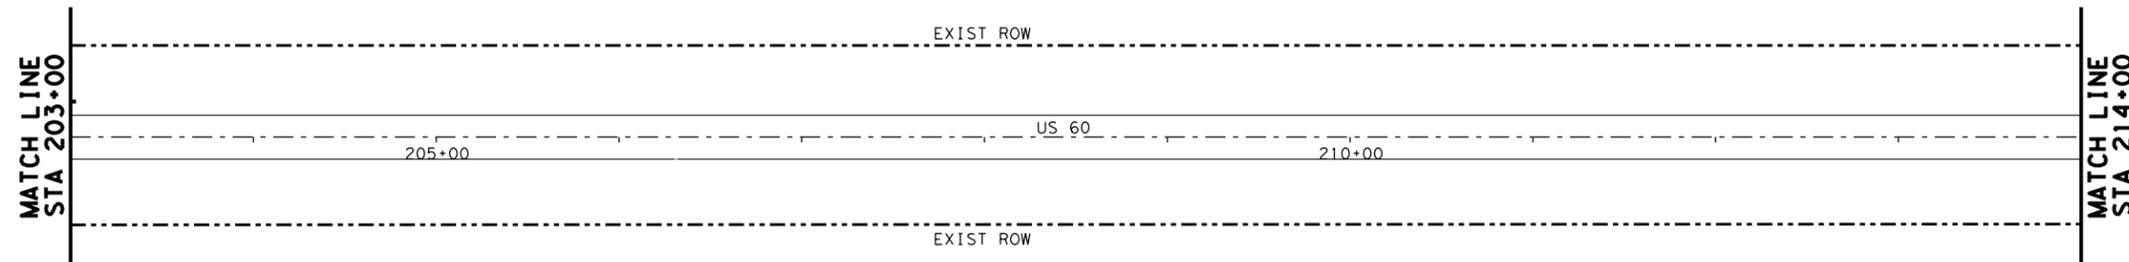

SUE RESEARCH NOT PERFORMED IN THIS AREA.
NO EXCAVATION WORK IS PLANNED IN THIS AREA.

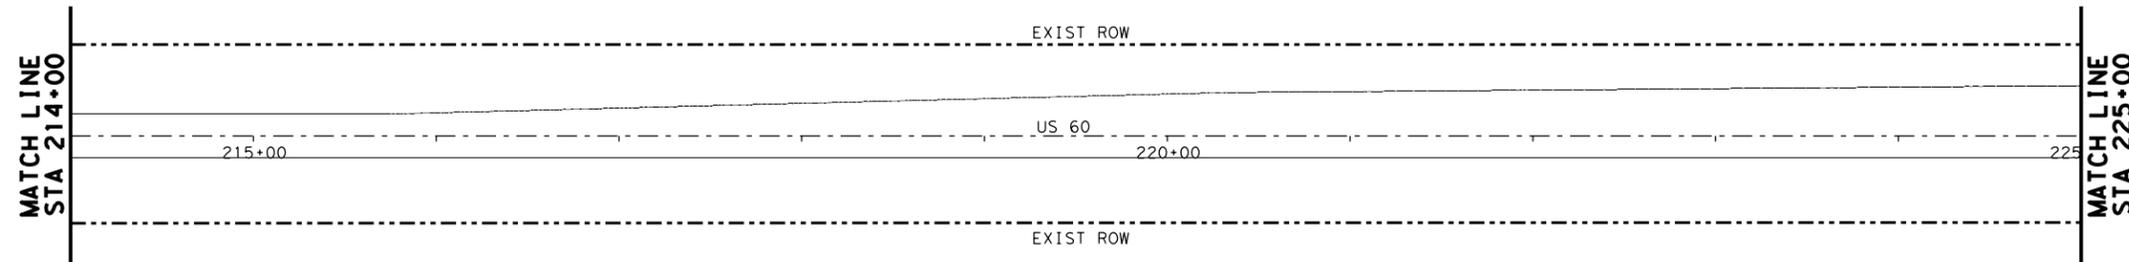


SUE RESEARCH NOT PERFORMED IN THIS AREA.
NO EXCAVATION WORK IS PLANNED IN THIS AREA.



T.E. Hunt
4/2/2021

REV. NO.	DATE	DESCRIPTION	BY

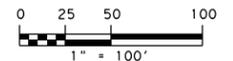

CobbFendley 13430 Northwest Freeway, Ste. 1100
Houston, Texas 77040
713.462.3242
www.cobbhendley.com




US 60
EXISTING UTILITY PLANS
STA 203+00 TO STA 225+00
SHEET 08 OF 36

FED. RD. DIV. NO.	STATE	PROJECT NO.	HIGHWAY NO.
6	TEXAS	SEE TITLE SHEET	US 60
STATE DISTRICT	COUNTY	CONTROL NO.	SECTION NO.
AMA	GRAY	0619	07
		JOB NO.	SHEET NO.
		053, ETC	146


4/12/2021 F:\P\Proj\2019\1004_TxDOT_5x5_PSB&E\03_US60_Amrt\10\ENG\500\UST\N\506-SUE\02-Sheet\5\US60-SUE-08.dgn 9:45:56 AM

NOTES:
 1. THE EXISTENCE AND LOCATION OF UTILITIES INDICATED ON THE PLANS ARE TAKEN FROM FIELD INVESTIGATION, THE BEST RECORDS AVAILABLE, AND ARE APPROXIMATED. THE CONTRACTOR SHALL LOCATE ALL UTILITIES (PUBLIC OR PRIVATE, SHOWN HERE OR NOT SHOWN) BOTH VERTICALLY AND HORIZONTALLY PRIOR TO COMMENCING WORK, WHETHER UTILITIES ARE ANTICIPATED TO BE IN DIRECT CONFLICT WITH PROPOSED WORK ACTIVITIES OR NOT. THE CONTRACTOR IS FULLY RESPONSIBLE FOR ANY DAMAGES CAUSED BY THE FAILURE TO LOCATE, PRESERVE, OR PROTECT THESE UTILITIES.
 2. ALL WORK ACTIVITIES (INCLUDING BUT NOT LIMITED TO CONSTRUCTING DETOURS, CULVERT EXTENSION AND REPLACEMENTS, EXCAVATION, DITCH GRADING, ETC.) SHALL NOT COMMENCE UNTIL ALL UTILITIES, ESPECIALLY UTILITIES WITHIN EXISTING ROW AND PARALLEL TO US 60, ARE IDENTIFIED. IF CONFLICTS WITH PROPOSED CONSTRUCTION OR WORK ACTIVITIES ARE IDENTIFIED, CONTRACTOR IS TO CEASE WORK IN THE LOCATION OF THE CONFLICT IMMEDIATELY.

- LEGEND
- ⊗ TELEPHONE POLE
 - ⊗ POWER POLE
 - ⊞ ELECTRIC PULLBOX
 - ⊞ ELECTRIC METER
 - ⊞ ELECTRIC SWITCH
 - ⊞ ELECTRIC STREET LIGHT
 - ⊞ ELECTRIC LANDSCAPE LIGHT
 - ⊞ ELECTRIC TRAFFIC SIGNAL
 - ⊞ ELECTRIC TRAFFIC SWITCH BOX
 - ⊞ ELECTRIC CABINET
 - ⊞ ELECTRIC MARKER
 - ⊞ TELEPHONE PEDESTAL
 - ⊞ TELEPHONE MANHOLE
 - ⊞ TELEPHONE MARKER
 - ⊞ VIDEO-READY ACCESS DEVICE
 - ⊞ FIBER OPTIC PULLBOX
 - ⊞ FIBER OPTIC MARKER
 - ⊞ FIBER OPTIC TEST STATION
 - ⊞ GAS METER
 - ⊞ GAS MARKER
 - ⊞ GAS REGULATOR
 - ⊞ GAS TEST STATION
 - ⊞ GAS VALVE
 - ⊞ GAS VENT
 - ⊞ WATER MANHOLE
 - ⊞ WATER MARKER
 - ⊞ WATER TEST STATION
 - ⊞ WATER VALVE
- QL LEVEL B
- E1-01 ELECTRIC-XCEL/SOUTHWEST PUBLIC SERVICE.CO
 - E3-01 ELECTRIC - TXDOT
 - FOC1-01 FIBER OPTIC - AT&T
 - FOC2-01 FIBER OPTIC - DOBSON FIBER CO
 - T1-01 TELEPHONE - AT&T
 - C1-01 CABLE TV - CABLE ONE
 - G1-01 GAS - ATMOS ENERGY
 - G1-02 GAS - ATMOS ENERGY (2")
 - G3-01 GAS - UNKNOWN
 - G4-01 GAS - AMARILLO NATURAL GAS
 - W1-01 WATER - CITY OF PAMPA
 - W1-06 WATER - CITY OF PAMPA (6")
 - W1-10 WATER - CITY OF PAMPA (10")
 - WW1-01 SANITARY SEWER - CITY OF PAMPA
 - SD-01 STORM - CITY OF PAMPA
 - UNK UNKNOWN
 - QL LEVEL D
 - E1-01-D ELECTRIC-XCEL/SOUTHWEST PUBLIC SERVICE.CO
 - E3-01-D ELECTRIC - TXDOT
 - FOC1-01-D FIBER OPTIC - AT&T
 - T1-01-D TELEPHONE - AT&T
 - C1-01-D CABLE TV - CABLE ONE
 - G1-01-D GAS - ATMOS ENERGY
 - G2-01-D GAS - WEST TEXAS GAS
 - G2-03-D GAS - WEST TEXAS GAS (3")
 - G3-01-D GAS - UNKNOWN
 - W1-01-D WATER - CITY OF PAMPA (UNKNOWN SIZE)
 - W1-02-D WATER - CITY OF PAMPA (2")
 - W1-06-D WATER - CITY OF PAMPA (6")
 - W1-10-D WATER - CITY OF PAMPA (10")
 - W2-04-D WATER - TXDOT (4")
 - W3-2.5-D WATER - PRIVATE (2.5")
 - W4-04-D WATER - WESTERN EQUIPMENT (4")
 - WW1-01-D SANITARY SEWER - CITY OF PAMPA
 - WW2-03-D SANITARY SEWER - WESTERN EQUIPMENT (3")
 - SD-01-D STORM - CITY OF PAMPA
 - UNK UNKNOWN
- OVERHEAD
- OE1 OVERHEAD ELECTRIC TRANSMISSION - XCEL/SOUTHWESTERN PUBLIC SERVICE CO
 - OE1/FOC1/T1/C1 OVERHEAD ELEC/FOC/TEL/CATV - XCEL/AT&T/AT&T/CABLE ONE
 - OE1/FOC1 OVERHEAD ELEC/FOC/TEL - XCEL/AT&T
 - OE1/FOC1/T1 OVERHEAD ELEC/FOC/TEL - XCEL/AT&T/AT&T
 - OE1/T1 OVERHEAD ELEC/TEL - XCEL ENERGY/AT&T
 - OE1/T1/T1/C1 OVERHEAD ELEC/TEL/TEL/CATV/CATV - XCEL/AT&T/AT&T/CABLE ONE/CABLE ONE
 - OE1/T1/T1/C1 OVERHEAD ELEC/TEL/TEL/CATV - XCEL/AT&T/AT&T/CABLE ONE
 - OE1/T1/C1 OVERHEAD ELEC/TEL/CATV - XCEL/AT&T/CABLE ONE
 - OE1/C1 OVERHEAD ELEC/CATV - XCEL ENERGY/CABLE ONE
 - OE1/C1 OVERHEAD ELEC/CATV - XCEL ENERGY/CABLE ONE
 - FOC1 OVERHEAD FOC - AT&T
 - OT1 OVERHEAD TEL - AT&T
 - FOC1/T1/C1 OVERHEAD TEL/FOC/CATV - AT&T/AT&T/CABLE ONE
 - OT1/C1 OVERHEAD TEL/CATV - AT&T/CABLE ONE
 - OC1 OVERHEAD CATV - CABLE ONE

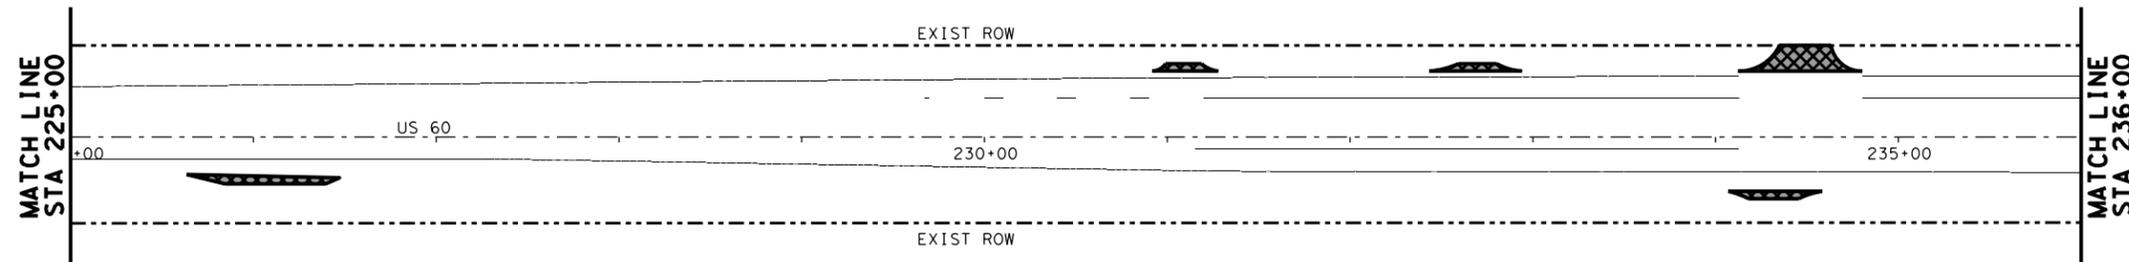

SUE RESEARCH NOT PERFORMED IN THIS AREA.
NO EXCAVATION WORK IS PLANNED IN THIS AREA.

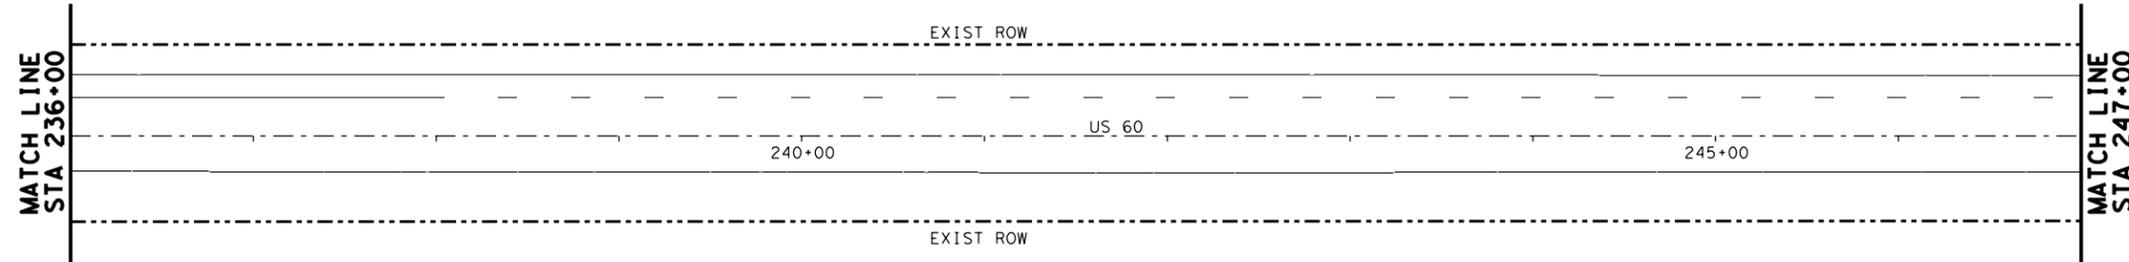


SUE RESEARCH NOT PERFORMED IN THIS AREA.
NO EXCAVATION WORK IS PLANNED IN THIS AREA.



T.E. Hunt
4/2/2021

REV. NO.	DATE	DESCRIPTION	BY

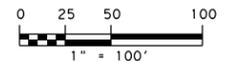

CobbFendley 13430 Northwest Freeway, Ste. 1100
Houston, Texas 77040
713.462.3242
www.cobbendley.com




US 60
EXISTING UTILITY PLANS
STA 225+00 TO STA 247+00
SHEET 09 OF 36

FED. RD. DIV. NO.	STATE	PROJECT NO.	HIGHWAY NO.
6	TEXAS	SEE TITLE SHEET	US 60
STATE DISTRICT	COUNTY	CONTROL NO.	SECTION NO.
AMA	GRAY	0619	07
		JOB NO.	SHEET NO.
		053, ETC	147


4/12/2021 F:\P\Proj\2019\1004_Tx\DOT_5x5_P58E\03_US60_Amarrillo\ENGIN\500-UST\N\506-SUE\02-Sheet\5-US60-SUE-09.dgn 9:45:56 AM

NOTES:
1. THE EXISTENCE AND LOCATION OF UTILITIES INDICATED ON THE PLANS ARE TAKEN FROM FIELD INVESTIGATION, THE BEST RECORDS AVAILABLE, AND ARE APPROXIMATED. THE CONTRACTOR SHALL LOCATE ALL UTILITIES (PUBLIC OR PRIVATE, SHOWN HERE OR NOT SHOWN) BOTH VERTICALLY AND HORIZONTALLY PRIOR TO COMMENCING WORK, WHETHER UTILITIES ARE ANTICIPATED TO BE IN DIRECT CONFLICT WITH PROPOSED WORK ACTIVITIES OR NOT. THE CONTRACTOR IS FULLY RESPONSIBLE FOR ANY DAMAGES CAUSED BY THE FAILURE TO LOCATE, PRESERVE, OR PROTECT THESE UTILITIES.
2. ALL WORK ACTIVITIES (INCLUDING BUT NOT LIMITED TO CONSTRUCTING DETOURS, CULVERT EXTENSION AND REPLACEMENTS, EXCAVATION, DITCH GRADING, ETC.) SHALL NOT COMMENCE UNTIL ALL UTILITIES, ESPECIALLY UTILITIES WITHIN EXISTING ROW AND PARALLEL TO US 60, ARE IDENTIFIED. IF CONFLICTS WITH PROPOSED CONSTRUCTION OR WORK ACTIVITIES ARE IDENTIFIED, CONTRACTOR IS TO CEASE WORK IN THE LOCATION OF THE CONFLICT IMMEDIATELY.

- LEGEND
- TELEPHONE POLE
 - POWER POLE
 - ELECTRIC PULLBOX
 - ELECTRIC METER
 - ELECTRIC SWITCH
 - ELECTRIC STREET LIGHT
 - ELECTRIC LANDSCAPE LIGHT
 - ELECTRIC TRAFFIC SIGNAL
 - ELECTRIC TRAFFIC SWITCH BOX
 - ELECTRIC CABINET
 - ELECTRIC MARKER
 - TELEPHONE PEDESTAL
 - TELEPHONE MANHOLE
 - TELEPHONE MARKER
 - VIDEO-READY ACCESS DEVICE
 - FIBER OPTIC PULLBOX
 - FIBER OPTIC MARKER
 - FIBER OPTIC TEST STATION
 - GAS METER
 - GAS MARKER
 - GAS REGULATOR
 - GAS TEST STATION
 - GAS VALVE
 - GAS VENT
 - WATER MANHOLE
 - WATER MARKER
 - WATER TEST STATION
 - WATER VALVE
- QL LEVEL B
- E1-01 ELECTRIC-XCEL/SOUTHWEST PUBLIC SERVICE CO
 - E3-01 ELECTRIC - TXDOT
 - FOC1-01 FIBER OPTIC - AT&T
 - FOC2-01 FIBER OPTIC - DOBSON FIBER CO
 - T1-01 TELEPHONE - AT&T
 - C1-01 CABLE TV - CABLE ONE
 - G1-01 GAS - ATMOS ENERGY
 - G1-02 GAS - ATMOS ENERGY (2")
 - G3-01 GAS - UNKNOWN
 - G4-01 GAS - AMARILLO NATURAL GAS
 - W1-01 WATER - CITY OF PAMPA
 - W1-06 WATER - CITY OF PAMPA (6")
 - W1-10 WATER - CITY OF PAMPA (10")
 - WW1-01 SANITARY SEWER - CITY OF PAMPA
 - SD-01 STORM - CITY OF PAMPA
 - UNK UNKNOWN
 - QL LEVEL D
 - E1-01-D ELECTRIC-XCEL/SOUTHWEST PUBLIC SERVICE CO
 - E3-01-D ELECTRIC - TXDOT
 - FOC1-01-D FIBER OPTIC - AT&T
 - T1-01-D TELEPHONE - AT&T
 - C1-01-D CABLE TV - CABLE ONE
 - G1-01-D GAS - ATMOS ENERGY
 - G2-01-D GAS - WEST TEXAS GAS
 - G2-03-D GAS - WEST TEXAS GAS (3")
 - G3-01-D GAS - UNKNOWN
 - W1-01-D WATER - CITY OF PAMPA (UNKNOWN SIZE)
 - W1-02-D WATER - CITY OF PAMPA (2")
 - W1-06-D WATER - CITY OF PAMPA (6")
 - W1-10-D WATER - CITY OF PAMPA (10")
 - W2-04-D WATER - TXDOT (4")
 - W3-2.5-D WATER - PRIVATE (2.5")
 - W4-04-D WATER - WESTERN EQUIPMENT (4")
 - WW1-01-D SANITARY SEWER - CITY OF PAMPA
 - WW2-03-D SANITARY SEWER - WESTERN EQUIPMENT (3")
 - SD-01-D STORM - CITY OF PAMPA
 - UNK UNKNOWN
- OVERHEAD
- OHT OVERHEAD ELECTRIC TRANSMISSION - XCEL/SOUTHWESTERN PUBLIC SERVICE CO
 - OE1 OVERHEAD ELECTRIC - XCEL ENERGY-SOUTHWESTERN PUBLIC SERVICE CO
 - OE1/FOC1/T1/C1 OVERHEAD ELEC/FOC/TEL/CATV - XCEL/AT&T/AT&T/CABLE ONE
 - OE1/FOC1 OVERHEAD ELEC/FOC/TEL - XCEL/AT&T
 - OE1/FOC1/T1 OVERHEAD ELEC/FOC/TEL - XCEL/AT&T/AT&T
 - OE1/T1 OVERHEAD ELEC/TEL - XCEL ENERGY/AT&T
 - OE1/T1/T1/C1 OVERHEAD ELEC/TEL/TEL/CATV/CATV - XCEL/AT&T/AT&T/CABLE ONE/CABLE ONE
 - OE1/T1/T1/C1 OVERHEAD ELEC/TEL/TEL/CATV - XCEL/AT&T/AT&T/CABLE ONE
 - OE1/T1/C1 OVERHEAD ELEC/TEL/CATV - XCEL/AT&T/CABLE ONE
 - OE1/C1 OVERHEAD ELEC/CATV - XCEL ENERGY/CABLE ONE
 - OE1/C1 OVERHEAD ELEC/CATV - XCEL ENERGY/CABLE ONE
 - FOC1 OVERHEAD FOC - AT&T
 - OT1 OVERHEAD TEL - AT&T
 - FOC1/T1/C1 OVERHEAD TEL/FOC/CATV - AT&T/AT&T/CABLE ONE
 - OT1/C1 OVERHEAD TEL/CATV - AT&T/CABLE ONE
 - OC1 OVERHEAD CATV - CABLE ONE

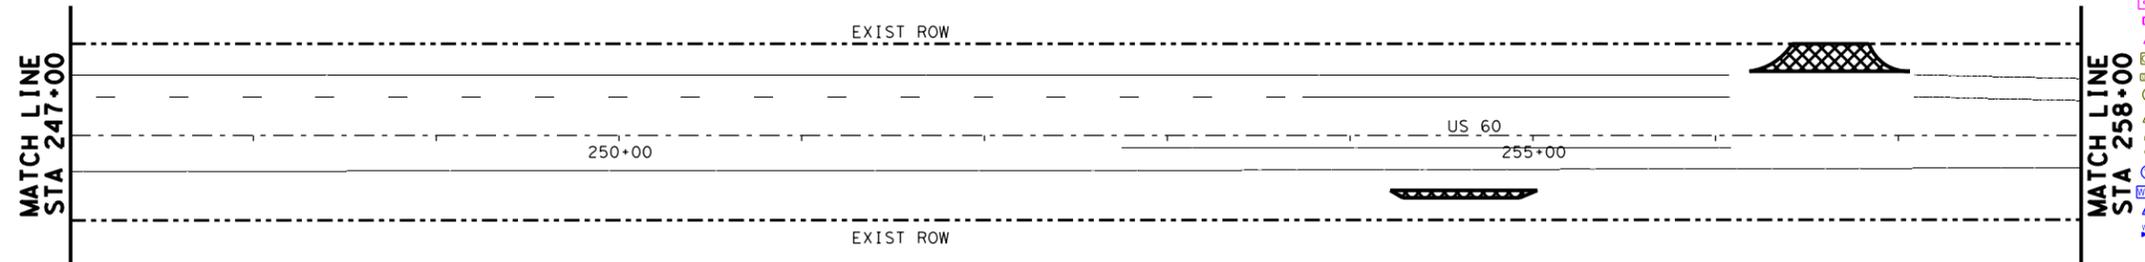

SUE RESEARCH NOT PERFORMED IN THIS AREA.
NO EXCAVATION WORK IS PLANNED IN THIS AREA.

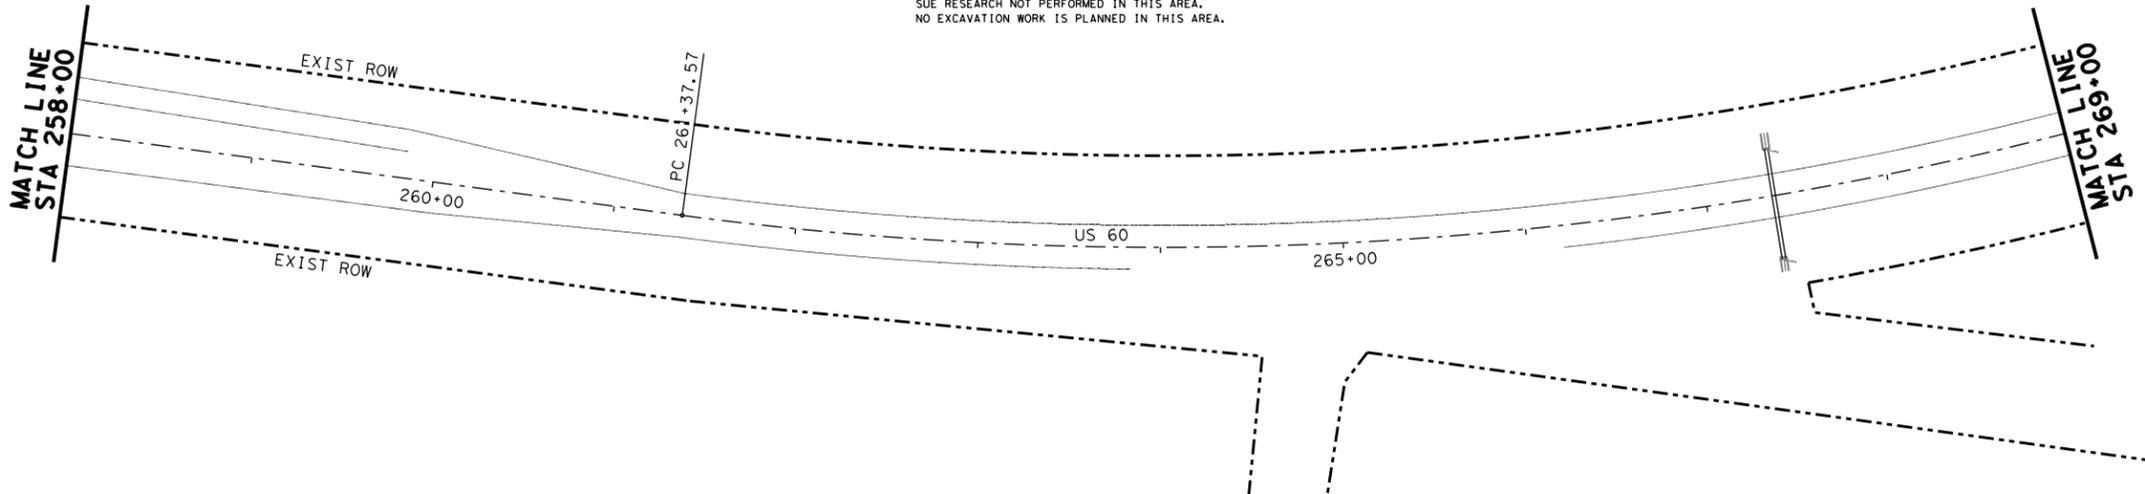


SUE RESEARCH NOT PERFORMED IN THIS AREA.
NO EXCAVATION WORK IS PLANNED IN THIS AREA.



T.E.H. II
4/2/2021

REV. NO.	DATE	DESCRIPTION	BY

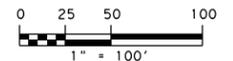

CobbFendley
13430 Northwest Freeway, Ste. 1100
Houston, Texas 77040
713.462.3242
www.cobbhendley.com




US 60
EXISTING UTILITY PLANS
STA 247+00 TO STA 269+00
SHEET 10 OF 36

FED. RD. DIV. NO.	STATE	PROJECT NO.	HIGHWAY NO.
6	TEXAS	SEE TITLE SHEET	US 60
STATE DISTRICT	COUNTY	CONTROL NO.	SECTION NO.
AMA	GRAY	0619	07
		JOB NO.	SHEET NO.
		053, ETC	148


4/12/2021 F:\P\Proj\2019\1004_TxDOT_5x5_PSE\US60_US60_Amrt\10\EN\500\UST\N\506-SUE\02-Sheet\US60-SUE-10.dgn 9:45:57 AM

NOTES:
1. THE EXISTENCE AND LOCATION OF UTILITIES INDICATED ON THE PLANS ARE TAKEN FROM FIELD INVESTIGATION, THE BEST RECORDS AVAILABLE, AND ARE APPROXIMATED. THE CONTRACTOR SHALL LOCATE ALL UTILITIES (PUBLIC OR PRIVATE, SHOWN HERE OR NOT SHOWN) BOTH VERTICALLY AND HORIZONTALLY PRIOR TO COMMENCING WORK, WHETHER UTILITIES ARE ANTICIPATED TO BE IN DIRECT CONFLICT WITH PROPOSED WORK ACTIVITIES OR NOT. THE CONTRACTOR IS FULLY RESPONSIBLE FOR ANY DAMAGES CAUSED BY THE FAILURE TO LOCATE, PRESERVE, OR PROTECT THESE UTILITIES.
2. ALL WORK ACTIVITIES (INCLUDING BUT NOT LIMITED TO CONSTRUCTING DETOURS, CULVERT EXTENSION AND REPLACEMENTS, EXCAVATION, DITCH GRADING, ETC.) SHALL NOT COMMENCE UNTIL ALL UTILITIES, ESPECIALLY UTILITIES WITHIN EXISTING ROW AND PARALLEL TO US 60, ARE IDENTIFIED. IF CONFLICTS WITH PROPOSED CONSTRUCTION OR WORK ACTIVITIES ARE IDENTIFIED, CONTRACTOR IS TO CEASE WORK IN THE LOCATION OF THE CONFLICT IMMEDIATELY.

- LEGEND
- ⊗ TELEPHONE POLE
 - ⊗ POWER POLE
 - ⊗ ELECTRIC PULLBOX
 - ⊗ ELECTRIC METER
 - ⊗ ELECTRIC SWITCH
 - ⊗ ELECTRIC STREET LIGHT
 - ⊗ ELECTRIC LANDSCAPE LIGHT
 - ⊗ ELECTRIC TRAFFIC SIGNAL
 - ⊗ ELECTRIC TRAFFIC SWITCH BOX
 - ⊗ ELECTRIC CABINET
 - ⊗ ELECTRIC MARKER
 - ⊗ TELEPHONE PEDESTAL
 - ⊗ TELEPHONE MANHOLE
 - ⊗ TELEPHONE MARKER
 - ⊗ VIDEO-READY ACCESS DEVICE
 - ⊗ FIBER OPTIC PULLBOX
 - ⊗ FIBER OPTIC MARKER
 - ⊗ FIBER OPTIC TEST STATION
 - ⊗ GAS METER
 - ⊗ GAS MARKER
 - ⊗ GAS REGULATOR
 - ⊗ GAS TEST STATION
 - ⊗ GAS VALVE
 - ⊗ GAS VENT
 - ⊗ WATER MANHOLE
 - ⊗ WATER MARKER
 - ⊗ WATER TEST STATION
 - ⊗ WATER VALVE
- QL LEVEL B
- E1-01 --- ELECTRIC-XCEL/SOUTHWEST PUBLIC SERVICE.CO
 - E3-01 --- ELECTRIC - TXDOT
 - FOC1-01 --- FIBER OPTIC - AT&T
 - FOC2-01 --- FIBER OPTIC - DOBSON FIBER CO
 - T1-01 --- TELEPHONE - AT&T
 - C1-01 --- CABLE TV - CABLE ONE
 - G1-01 --- GAS - ATMOS ENERGY
 - G1-02 --- GAS - ATMOS ENERGY (2")
 - G3-01 --- GAS - UNKNOWN
 - G4-01 --- GAS - AMARILLO NATURAL GAS
 - W1-01 --- WATER - CITY OF PAMPA
 - W1-06 --- WATER - CITY OF PAMPA (6")
 - W1-10 --- WATER - CITY OF PAMPA (10")
 - WW1-01 --- SANITARY SEWER - CITY OF PAMPA
 - SD-01 --- STORM - CITY OF PAMPA
 - UNK --- UNKNOWN
 - E1-01-D --- ELECTRIC-XCEL/SOUTHWEST PUBLIC SERVICE.CO
 - E3-01-D --- ELECTRIC - TXDOT
 - FOC1-01-D --- FIBER OPTIC - AT&T
 - T1-01-D --- TELEPHONE - AT&T
 - C1-01-D --- CABLE TV - CABLE ONE
 - G1-01-D --- GAS - ATMOS ENERGY
 - G2-01-D --- GAS - WEST TEXAS GAS
 - G2-03-D --- GAS - WEST TEXAS GAS (3")
 - G3-01-D --- GAS - UNKNOWN
 - W1-01-D --- WATER - CITY OF PAMPA (UNKNOWN SIZE)
 - W1-02-D --- WATER - CITY OF PAMPA (2")
 - W1-06-D --- WATER - CITY OF PAMPA (6")
 - W1-10-D --- WATER - CITY OF PAMPA (10")
 - W2-04-D --- WATER - TXDOT (4")
 - W3-2.5-D --- WATER - PRIVATE (2.5")
 - W4-04-D --- WATER - WESTERN EQUIPMENT (4")
 - WW1-01-D --- SANITARY SEWER - CITY OF PAMPA
 - WW2-03-D --- SANITARY SEWER - WESTERN EQUIPMENT (3")
 - SD-01-D --- STORM - CITY OF PAMPA
 - UNK --- UNKNOWN
- OVERHEAD
- OHT --- OVERHEAD ELECTRIC TRANSMISSION - XCEL/SOUTHWESTERN PUBLIC SERVICE CO
 - OE1 --- OVERHEAD ELECTRIC - XCEL ENERGY-SOUTHWESTERN PUBLIC SERVICE CO
 - OE1/FOC1/T1/C1 --- OVERHEAD ELEC/FOC/TEL/CATV - XCEL/AT&T/AT&T/CABLE ONE
 - OE1/FOC1 --- OVERHEAD ELEC/FOC/TEL - XCEL/AT&T
 - OE1/FOC1/T1 --- OVERHEAD ELEC/FOC/TEL - XCEL/AT&T/AT&T
 - OE1/T1 --- OVERHEAD ELEC/TEL - XCEL ENERGY/AT&T
 - OE1/T1/T1/C1/C1 --- OVERHEAD ELEC/TEL/TEL/CATV/CATV - XCEL/AT&T/AT&T/CABLE ONE/CABLE ONE
 - OE1/T1/T1/C1 --- OVERHEAD ELEC/TEL/TEL/CATV - XCEL/AT&T/AT&T/CABLE ONE
 - OE1/T1/C1 --- OVERHEAD ELEC/TEL/CATV - XCEL/AT&T/CABLE ONE
 - OE1/C1 --- OVERHEAD ELEC/CATV - XCEL ENERGY/CABLE ONE
 - OE1/C1 --- OVERHEAD ELEC/CATV - XCEL ENERGY/CABLE ONE
 - FOC1 --- OVERHEAD FOC - AT&T
 - OT1 --- OVERHEAD TEL - AT&T
 - FOC1/T1/C1 --- OVERHEAD TEL/FOC/CATV - AT&T/AT&T/CABLE ONE
 - OT1/C1 --- OVERHEAD TEL/CATV - AT&T/CABLE ONE
 - OC1 --- OVERHEAD CATV - CABLE ONE

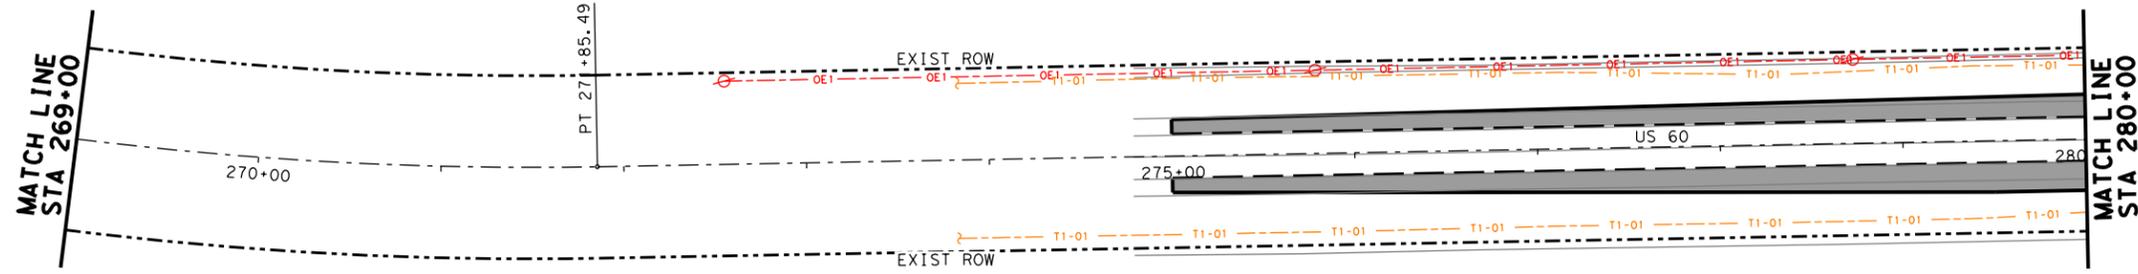

SUE RESEARCH NOT PERFORMED BEFORE STA. 274+00
NO EXCAVATION WORK IS PLANNED IN THIS AREA.

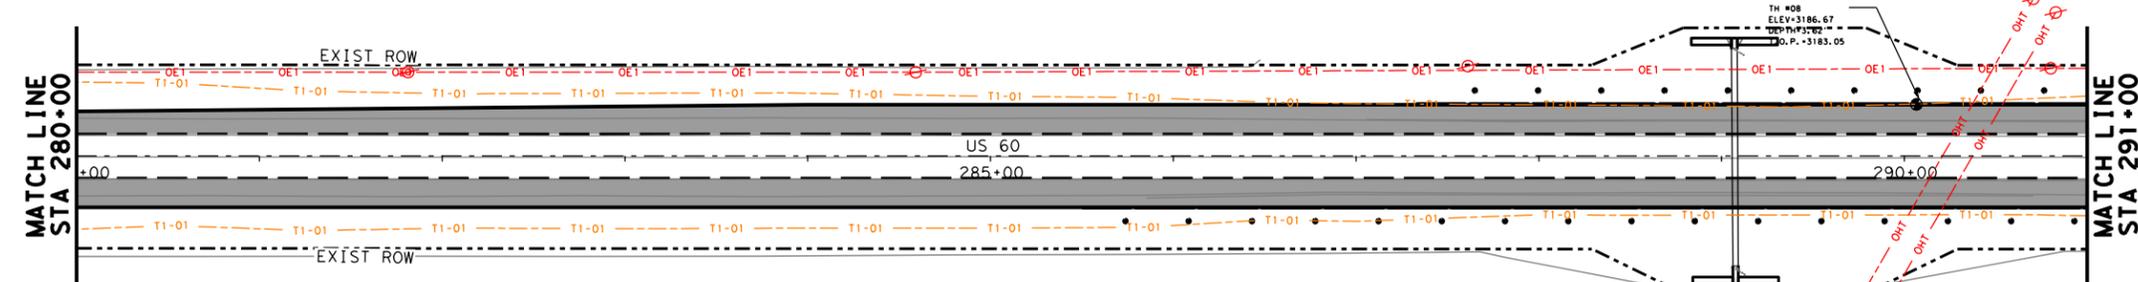

J.L.C.H.A.
4/2/2021

REV. NO.	DATE	DESCRIPTION	BY



CobbFendley
13430 Northwest Freeway, Ste. 1100
Houston, Texas 77040
713.462.3242
www.cobbhendley.com



US 60
EXISTING UTILITY PLANS
STA 269+00 TO STA 291+00



FED. RD. DIV. NO.	STATE	PROJECT NO.	HIGHWAY NO.
6	TEXAS	SEE TITLE SHEET	US 60
STATE DISTRICT	COUNTY	CONTROL NO.	SECTION NO.
AMA	GRAY	0619	07
		JOB NO.	SHEET NO.
		053, ETC	149

4/2/2021 F:\P\Proj\2019\1004_TxDOT_5x5_PSE\U3_US60_Amarillo\ING\500\UST\N\506-SUE-02-Street\US60-SUE-11.dgn 9:45:58 AM

NOTES:

- THE EXISTENCE AND LOCATION OF UTILITIES INDICATED ON THE PLANS ARE TAKEN FROM FIELD INVESTIGATION, THE BEST RECORDS AVAILABLE, AND ARE APPROXIMATED. THE CONTRACTOR SHALL LOCATE ALL UTILITIES (PUBLIC OR PRIVATE, SHOWN HERE OR NOT SHOWN) BOTH VERTICALLY AND HORIZONTALLY PRIOR TO COMMENCING WORK, WHETHER UTILITIES ARE ANTICIPATED TO BE IN DIRECT CONFLICT WITH PROPOSED WORK ACTIVITIES OR NOT. THE CONTRACTOR IS FULLY RESPONSIBLE FOR ANY DAMAGES CAUSED BY THE FAILURE TO LOCATE, PRESERVE, OR PROTECT THESE UTILITIES.
- ALL WORK ACTIVITIES (INCLUDING BUT NOT LIMITED TO CONSTRUCTING DETOURS, CULVERT EXTENSION AND REPLACEMENTS, EXCAVATION, DITCH GRADING, ETC.) SHALL NOT COMMENCE UNTIL ALL UTILITIES, ESPECIALLY UTILITIES WITHIN EXISTING ROW AND PARALLEL TO US 60, ARE IDENTIFIED. IF CONFLICTS WITH PROPOSED CONSTRUCTION OR WORK ACTIVITIES ARE IDENTIFIED, CONTRACTOR IS TO CEASE WORK IN THE LOCATION OF THE CONFLICT IMMEDIATELY.

4/12/2021
 F:\P\Proj\2019\1004_TxDOT_5x5_P&E\03_US60_Amarrillo\ENGIN\500-UST\N\506-SUE\02-Sheet\US60_SUE\13.dgn
 9:45:59 AM

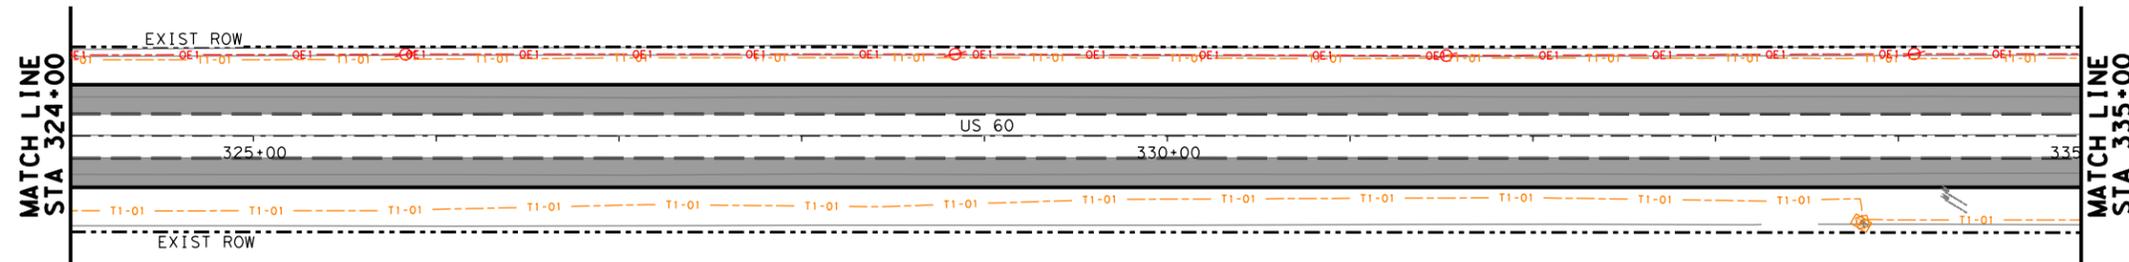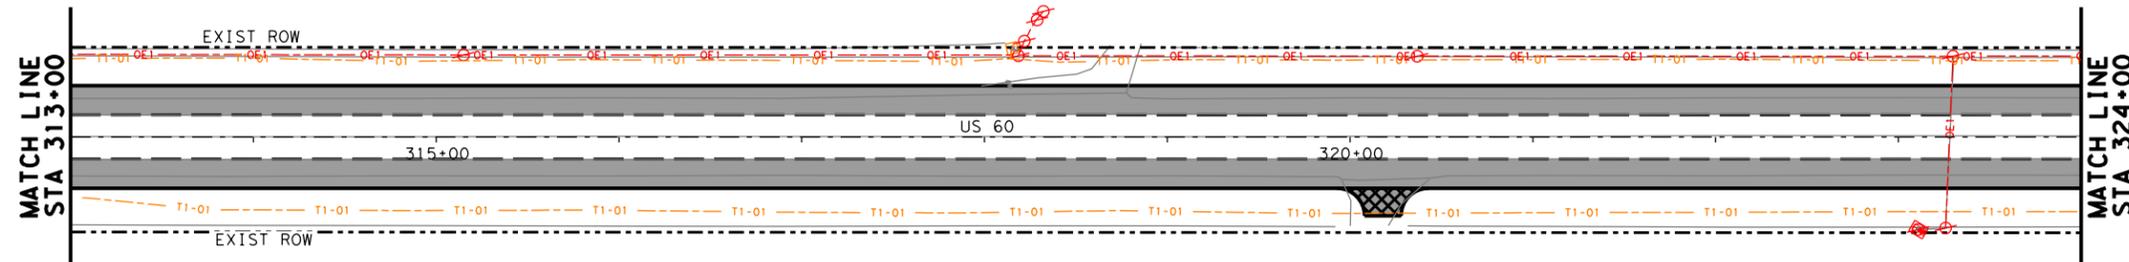

LEGEND

⊗ TELEPHONE POLE	⊗ POWER POLE	⊗ ELECTRIC PULLBOX	⊗ ELECTRIC METER	⊗ ELECTRIC SWITCH	⊗ ELECTRIC STREET LIGHT	⊗ ELECTRIC LANDSCAPE LIGHT	⊗ ELECTRIC TRAFFIC SIGNAL	⊗ ELECTRIC TRAFFIC SWITCH BOX	⊗ ELECTRIC CABINET	⊗ TELEPHONE MARKER	⊗ TELEPHONE PEDESTAL	⊗ TELEPHONE MANHOLE	⊗ TELEPHONE MARKER	⊗ VIDEO-READY ACCESS DEVICE	⊗ FIBER OPTIC PULLBOX	⊗ FIBER OPTIC MARKER	⊗ FIBER OPTIC TEST STATION	⊗ GAS METER	⊗ GAS MARKER	⊗ GAS REGULATOR	⊗ GAS TEST STATION	⊗ GAS VALVE	⊗ GAS VENT	⊗ WATER MANHOLE	⊗ WATER MARKER	⊗ WATER TEST STATION	⊗ WATER VALVE									
--- E1-01 ---	--- E3-01 ---	--- FOC1-01 ---	--- T1-01 ---	--- C1-01 ---	--- G1-01 ---	--- G1-02 ---	--- G3-01 ---	--- G4-01 ---	--- W1-01 ---	--- W1-06 ---	--- W1-10 ---	--- WW1-01 ---	--- SD-01 ---	--- UNK ---	--- UNK ---	--- UNK ---	--- UNK ---	--- E3-01-D ---	--- FOC1-01-D ---	--- T1-01-D ---	--- C1-01-D ---	--- G1-01-D ---	--- G2-01-D ---	--- G2-03-D ---	--- G3-01-D ---	--- W1-01-D ---	--- W1-02-D ---	--- W1-06-D ---	--- W1-10-D ---	--- W2-04-D ---	--- W3-2.5-D ---	--- W4-04-D ---	--- WW1-01-D ---	--- WW2-03-D ---	--- SD-01-D ---	--- UNK ---
--- OMT ---	--- OE1 ---	--- OE1/FOC1/T1/C1 ---	--- OE1/FOC1 ---	--- OE1/FOC1/T1 ---	--- OE1/T1 ---	--- OE1/T1/T1/C1 ---	--- OE1/T1/T1/C1 ---	--- OE1/T1/C1 ---	--- OE1/C1 ---	--- OE1/C1 ---	--- OFOC1 ---	--- OT1 ---	--- OFOC1/T1/C1 ---	--- OT1/C1 ---	--- OC1 ---	--- OVERHEAD ELECTRIC TRANSMISSION - XCEL/SOUTHWESTERN PUBLIC SERVICE CO	--- OVERHEAD ELECTRIC - XCEL ENERGY-SOUTHWESTERN PUBLIC SERVICE CO	--- OVERHEAD ELEC/FOC/TEL/CATV - XCEL/AT&T/AT&T/CABLE ONE	--- OVERHEAD ELEC/FOC/TEL - XCEL/AT&T	--- OVERHEAD ELEC/FOC/TEL - XCEL/AT&T/AT&T	--- OVERHEAD ELEC/TEL - XCEL ENERGY/AT&T	--- OVERHEAD ELEC/TEL/TEL/CATV/CATV - XCEL/AT&T/AT&T/CABLE ONE/CABLE ONE	--- OVERHEAD ELEC/TEL/TEL/CATV - XCEL/AT&T/AT&T/CABLE ONE	--- OVERHEAD ELEC/TEL/CATV - XCEL/AT&T/CABLE ONE	--- OVERHEAD ELEC/CATV - XCEL ENERGY/CABLE ONE	--- OVERHEAD ELEC/CATV - XCEL ENERGY/CABLE ONE	--- OVERHEAD TEL - AT&T	--- OVERHEAD TEL/FOC/CATV - AT&T/AT&T/CABLE ONE	--- OVERHEAD TEL/CATV - AT&T/CABLE ONE	--- OVERHEAD CATV - CABLE ONE						



REV. NO.	DATE	DESCRIPTION	BY



CobbFendley
 13430 Northwest Freeway, Ste. 1100
 Houston, Texas 77040
 713.462.3242
 www.cobbendley.com



**US 60
 EXISTING UTILITY PLANS
 STA 313+00 TO STA 335+00**



FED. RD. DIV. NO.	STATE	PROJECT NO.	HIGHWAY NO.		
6	TEXAS	SEE TITLE SHEET	US 60		
STATE DISTRICT	COUNTY	CONTROL NO.	SECTION NO.	JOB NO.	SHEET NO.
AMA	GRAY	0619	07	053, ETC	151

NOTES:


- THE EXISTENCE AND LOCATION OF UTILITIES INDICATED ON THE PLANS ARE TAKEN FROM FIELD INVESTIGATION, THE BEST RECORDS AVAILABLE, AND ARE APPROXIMATED. THE CONTRACTOR SHALL LOCATE ALL UTILITIES (PUBLIC OR PRIVATE, SHOWN HERE OR NOT SHOWN) BOTH VERTICALLY AND HORIZONTALLY PRIOR TO COMMENCING WORK, WHETHER UTILITIES ARE ANTICIPATED TO BE IN DIRECT CONFLICT WITH PROPOSED WORK ACTIVITIES OR NOT. THE CONTRACTOR IS FULLY RESPONSIBLE FOR ANY DAMAGES CAUSED BY THE FAILURE TO LOCATE, PRESERVE, OR PROTECT THESE UTILITIES.
- ALL WORK ACTIVITIES (INCLUDING BUT NOT LIMITED TO CONSTRUCTING DETOURS, CULVERT EXTENSION AND REPLACEMENTS, EXCAVATION, DITCH GRADING, ETC.) SHALL NOT COMMENCE UNTIL ALL UTILITIES, ESPECIALLY UTILITIES WITHIN EXISTING ROW AND PARALLEL TO US 60, ARE IDENTIFIED. IF CONFLICTS WITH PROPOSED CONSTRUCTION OR WORK ACTIVITIES ARE IDENTIFIED, CONTRACTOR IS TO CEASE WORK IN THE LOCATION OF THE CONFLICT IMMEDIATELY.

US60_SUE\13.dgn

- LEGEND
- TELEPHONE POLE
 - POWER POLE
 - ELECTRIC PULLBOX
 - ELECTRIC METER
 - ELECTRIC SWITCH
 - ELECTRIC STREET LIGHT
 - ELECTRIC LANDSCAPE LIGHT
 - ELECTRIC TRAFFIC SIGNAL
 - ELECTRIC TRAFFIC SWITCH BOX
 - ELECTRIC CABINET
 - ELECTRIC MARKER
 - TELEPHONE PEDESTAL
 - TELEPHONE MANHOLE
 - TELEPHONE MARKER
 - VIDEO-READY ACCESS DEVICE
 - FIBER OPTIC PULLBOX
 - FIBER OPTIC MARKER
 - FIBER OPTIC TEST STATION
 - GAS METER
 - GAS MARKER
 - GAS REGULATOR
 - GAS TEST STATION
 - GAS VALVE
 - GAS VENT
 - WATER MANHOLE
 - WATER MARKER
 - WATER TEST STATION
 - WATER VALVE
- QL LEVEL B
- E1-01 ELECTRIC-XCEL/SOUTHWEST PUBLIC SERVICE.CO
 - E3-01 ELECTRIC - TXDOT
 - FOC1-01 FIBER OPTIC - AT&T
 - FOC2-01 FIBER OPTIC - DOBSON FIBER CO
 - T1-01 TELEPHONE - AT&T
 - C1-01 CABLE TV - CABLE ONE
 - G1-01 GAS - ATMOS ENERGY
 - G1-02 GAS - ATMOS ENERGY (2")
 - G3-01 GAS - UNKNOWN
 - G4-01 GAS - AMARILLO NATURAL GAS
 - W1-01 WATER - CITY OF PAMPA
 - W1-06 WATER - CITY OF PAMPA (6")
 - W1-10 WATER - CITY OF PAMPA (10")
 - WW1-01 SANITARY SEWER - CITY OF PAMPA
 - SD-01 STORM - CITY OF PAMPA
 - UNK UNKNOWN
 - QL LEVEL D
 - E1-01-D ELECTRIC-XCEL/SOUTHWEST PUBLIC SERVICE.CO
 - E3-01-D ELECTRIC - TXDOT
 - FOC1-01-D FIBER OPTIC - AT&T
 - T1-01-D TELEPHONE - AT&T
 - C1-01-D CABLE TV - CABLE ONE
 - G1-01-D GAS - ATMOS ENERGY
 - G2-01-D GAS - WEST TEXAS GAS
 - G2-03-D GAS - WEST TEXAS GAS (3")
 - G3-01-D GAS - UNKNOWN
 - W1-01-D WATER - CITY OF PAMPA (UNKNOWN SIZE)
 - W1-02-D WATER - CITY OF PAMPA (2")
 - W1-06-D WATER - CITY OF PAMPA (6")
 - W1-10-D WATER - CITY OF PAMPA (10")
 - W2-04-D WATER - TXDOT (4")
 - W3-2.5-D WATER - PRIVATE (2.5")
 - W4-04-D WATER - WESTERN EQUIPMENT (4")
 - WW1-01-D SANITARY SEWER - CITY OF PAMPA
 - WW2-03-D SANITARY SEWER - WESTERN EQUIPMENT (3")
 - SD-01-D STORM - CITY OF PAMPA
 - UNK UNKNOWN
- OVERHEAD
- OHT OVERHEAD ELECTRIC TRANSMISSION - XCEL/SOUTHWESTERN PUBLIC SERVICE CO
 - OE1 OVERHEAD ELECTRIC - XCEL ENERGY-SOUTHWESTERN PUBLIC SERVICE CO
 - OE1/FOC1/T1/C1 OVERHEAD ELEC/FOC/TEL/CATV - XCEL/AT&T/AT&T/CABLE ONE
 - OE1/FOC1 OVERHEAD ELEC/FOC/TEL - XCEL/AT&T
 - OE1/FOC1/T1 OVERHEAD ELEC/FOC/TEL - XCEL/AT&T/AT&T
 - OE1/T1 OVERHEAD ELEC/TEL - XCEL ENERGY/AT&T
 - OE1/T1/T1/C1 OVERHEAD ELEC/TEL/TEL/CATV/CATV - XCEL/AT&T/AT&T/CABLE ONE/CABLE ONE
 - OE1/T1/T1/C1 OVERHEAD ELEC/TEL/TEL/CATV - XCEL/AT&T/AT&T/CABLE ONE
 - OE1/T1/C1 OVERHEAD ELEC/TEL/CATV - XCEL/AT&T/CABLE ONE
 - OE1/C1 OVERHEAD ELEC/CATV - XCEL ENERGY/CABLE ONE
 - OE1/C1 OVERHEAD ELEC/CATV - XCEL ENERGY/CABLE ONE
 - FOC1 OVERHEAD FOC - AT&T
 - OT1 OVERHEAD TEL - AT&T
 - FOC1/T1/C1 OVERHEAD TEL/FOC/CATV - AT&T/AT&T/CABLE ONE
 - OT1/C1 OVERHEAD TEL/CATV - AT&T/CABLE ONE
 - OC1 OVERHEAD CATV - CABLE ONE

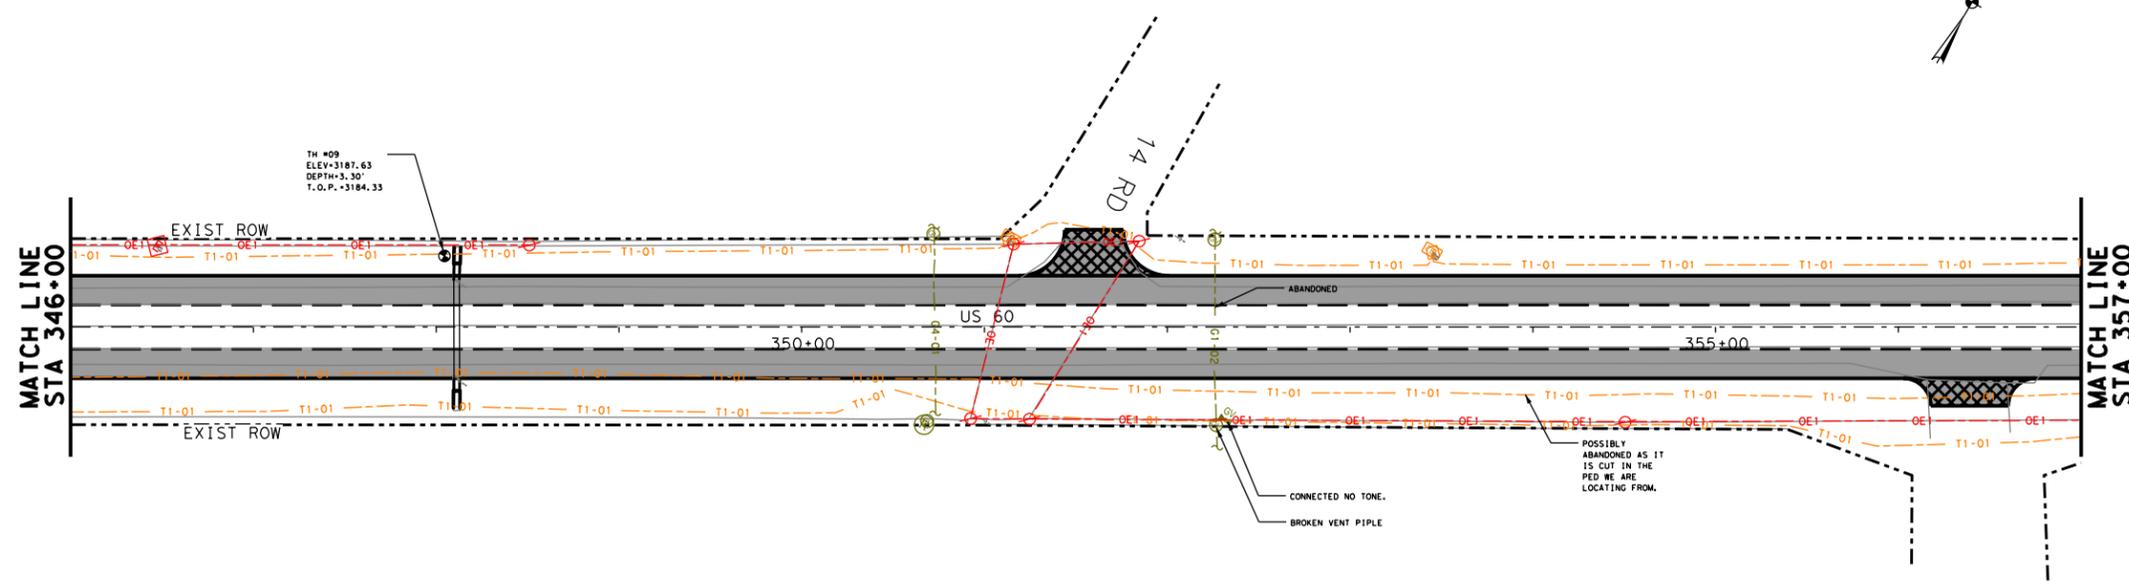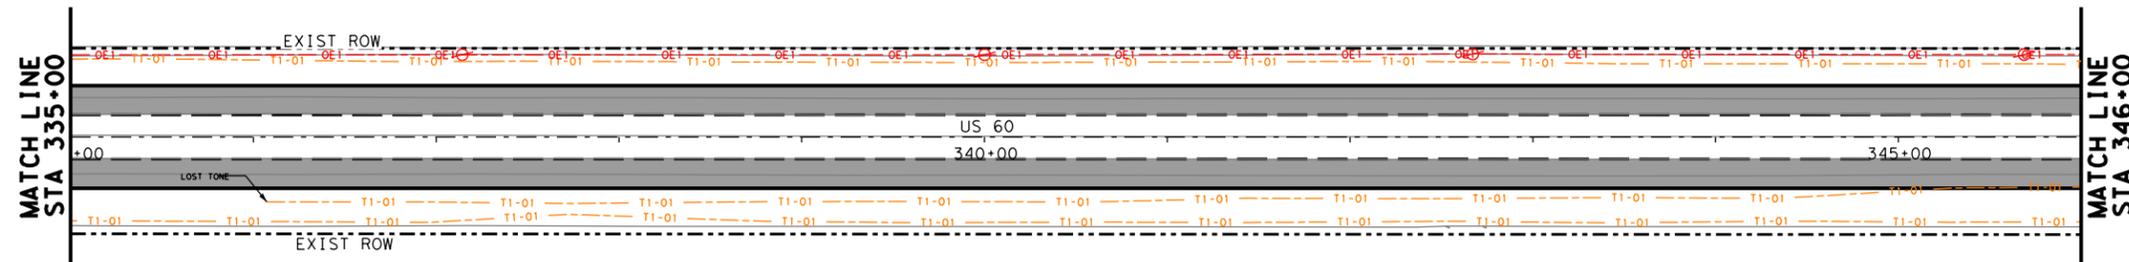

REV. NO.	DATE	DESCRIPTION	BY

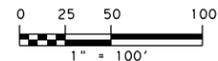

CobbFendley 13430 Northwest Freeway, Ste. 1100
Houston, Texas 77040
713.462.3242
www.cobbhendley.com





US 60
EXISTING UTILITY PLANS
STA 335+00 TO STA 357+00
SHEET 14 OF 36

FED. RD. DIV. NO.	STATE	PROJECT NO.	HIGHWAY NO.		
6	TEXAS	SEE TITLE SHEET	US 60		
STATE DISTRICT	COUNTY	CONTROL NO.	SECTION NO.	JOB NO.	SHEET NO.
AMA	GRAY	0619	07	053, ETC	152

4/12/2021 F:\P\Proj\2019\1004_Tx\DOT_5x5_P58E\03_US60_Amarillo\ENGIN\500\UST\N\506-SUE\02-Street\US60-SUE-14.dgn 9:46:00 AM


NOTES:
1. THE EXISTENCE AND LOCATION OF UTILITIES INDICATED ON THE PLANS ARE TAKEN FROM FIELD INVESTIGATION, THE BEST RECORDS AVAILABLE, AND ARE APPROXIMATED. THE CONTRACTOR SHALL LOCATE ALL UTILITIES (PUBLIC OR PRIVATE, SHOWN HERE OR NOT SHOWN) BOTH VERTICALLY AND HORIZONTALLY PRIOR TO COMMENCING WORK, WHETHER UTILITIES ARE ANTICIPATED TO BE IN DIRECT CONFLICT WITH PROPOSED WORK ACTIVITIES OR NOT. THE CONTRACTOR IS FULLY RESPONSIBLE FOR ANY DAMAGES CAUSED BY THE FAILURE TO LOCATE, PRESERVE, OR PROTECT THESE UTILITIES.
2. ALL WORK ACTIVITIES (INCLUDING BUT NOT LIMITED TO CONSTRUCTING DETOURS, CULVERT EXTENSION AND REPLACEMENTS, EXCAVATION, DITCH GRADING, ETC.) SHALL NOT COMMENCE UNTIL ALL UTILITIES, ESPECIALLY UTILITIES WITHIN EXISTING ROW AND PARALLEL TO US 60, ARE IDENTIFIED. IF CONFLICTS WITH PROPOSED CONSTRUCTION OR WORK ACTIVITIES ARE IDENTIFIED, CONTRACTOR IS TO CEASE WORK IN THE LOCATION OF THE CONFLICT IMMEDIATELY.

- LEGEND**
- TELEPHONE POLE
 - POWER POLE
 - ELECTRIC PULLBOX
 - ELECTRIC METER
 - ELECTRIC SWITCH
 - ELECTRIC STREET LIGHT
 - ELECTRIC LANDSCAPE LIGHT
 - ELECTRIC TRAFFIC SIGNAL
 - ELECTRIC TRAFFIC SWITCH BOX
 - ELECTRIC CABINET
 - ELECTRIC MARKER
 - TELEPHONE PEDESTAL
 - TELEPHONE MANHOLE
 - TELEPHONE MARKER
 - VIDEO-READY ACCESS DEVICE
 - FIBER OPTIC PULLBOX
 - FIBER OPTIC MARKER
 - FIBER OPTIC TEST STATION
 - GAS METER
 - GAS MARKER
 - GAS REGULATOR
 - GAS TEST STATION
 - GAS VALVE
 - GAS VENT
 - WATER MANHOLE
 - WATER MARKER
 - WATER TEST STATION
 - WATER VALVE
- QL LEVEL B**
- E1-01 ELECTRIC-XCEL/SOUTHWEST PUBLIC SERVICE CO
 - E3-01 ELECTRIC - TXDOT
 - FOC1-01 FIBER OPTIC - AT&T
 - FOC2-01 FIBER OPTIC - DOBSON FIBER CO
 - T1-01 TELEPHONE - AT&T
 - C1-01 CABLE TV - CABLE ONE
 - G1-01 GAS - ATMOS ENERGY
 - G1-02 GAS - ATMOS ENERGY (2")
 - G3-01 GAS - UNKNOWN
 - G4-01 GAS - AMARILLO NATURAL GAS
 - W1-01 WATER - CITY OF PAMPA
 - W1-06 WATER - CITY OF PAMPA (6")
 - W1-10 WATER - CITY OF PAMPA (10")
 - WW1-01 SANITARY SEWER - CITY OF PAMPA
 - SD-01 STORM - CITY OF PAMPA
 - UNK UNKNOWN
 - E1-01-D ELECTRIC-XCEL/SOUTHWEST PUBLIC SERVICE CO
 - E3-01-D ELECTRIC - TXDOT
 - FOC1-01-D FIBER OPTIC - AT&T
 - T1-01-D TELEPHONE - AT&T
 - C1-01-D CABLE TV - CABLE ONE
 - G1-01-D GAS - ATMOS ENERGY
 - G2-01-D GAS - WEST TEXAS GAS
 - G2-03-D GAS - WEST TEXAS GAS (3")
 - G3-01-D GAS - UNKNOWN
 - W1-01-D WATER - CITY OF PAMPA (UNKNOWN SIZE)
 - W1-02-D WATER - CITY OF PAMPA (2")
 - W1-06-D WATER - CITY OF PAMPA (6")
 - W1-10-D WATER - CITY OF PAMPA (10")
 - W2-04-D WATER - TXDOT (4")
 - W3-2.5-D WATER - PRIVATE (2.5")
 - W4-04-D WATER - WESTERN EQUIPMENT (4")
 - WW1-01-D SANITARY SEWER - CITY OF PAMPA
 - WW2-03-D SANITARY SEWER - WESTERN EQUIPMENT (3")
 - SD-01-D STORM - CITY OF PAMPA
 - UNK UNKNOWN
- OVERHEAD**
- OHT OVERHEAD ELECTRIC TRANSMISSION - XCEL/SOUTHWESTERN PUBLIC SERVICE CO
 - OE1 OVERHEAD ELECTRIC - XCEL ENERGY-SOUTHWESTERN PUBLIC SERVICE CO
 - OE1/FOC1/T1/C1 OVERHEAD ELEC/FOC/TEL/CATV - XCEL/AT&T/AT&T/CABLE ONE
 - OE1/FOC1 OVERHEAD ELEC/FOC/TEL - XCEL/AT&T
 - OE1/FOC1/T1 OVERHEAD ELEC/FOC/TEL - XCEL/AT&T/AT&T
 - OE1/T1 OVERHEAD ELEC/TEL - XCEL ENERGY/AT&T
 - OE1/T1/T1/C1 OVERHEAD ELEC/TEL/CATV/CATV - XCEL/AT&T/AT&T/CABLE ONE/CABLE ONE
 - OE1/T1/T1/C1 OVERHEAD ELEC/TEL/TEL/CATV - XCEL/AT&T/AT&T/CABLE ONE
 - OE1/T1/C1 OVERHEAD ELEC/TEL/CATV - XCEL/AT&T/CABLE ONE
 - OE1/C1 OVERHEAD ELEC/CATV - XCEL ENERGY/CABLE ONE
 - OE1/C1 OVERHEAD ELEC/CATV - XCEL ENERGY/CABLE ONE
 - FOC1 OVERHEAD FOC - AT&T
 - OT1 OVERHEAD TEL - AT&T
 - FOC1/T1/C1 OVERHEAD TEL/FOC/CATV - AT&T/AT&T/CABLE ONE
 - OT1/C1 OVERHEAD TEL/CATV - AT&T/CABLE ONE
 - OC1 OVERHEAD CATV - CABLE ONE

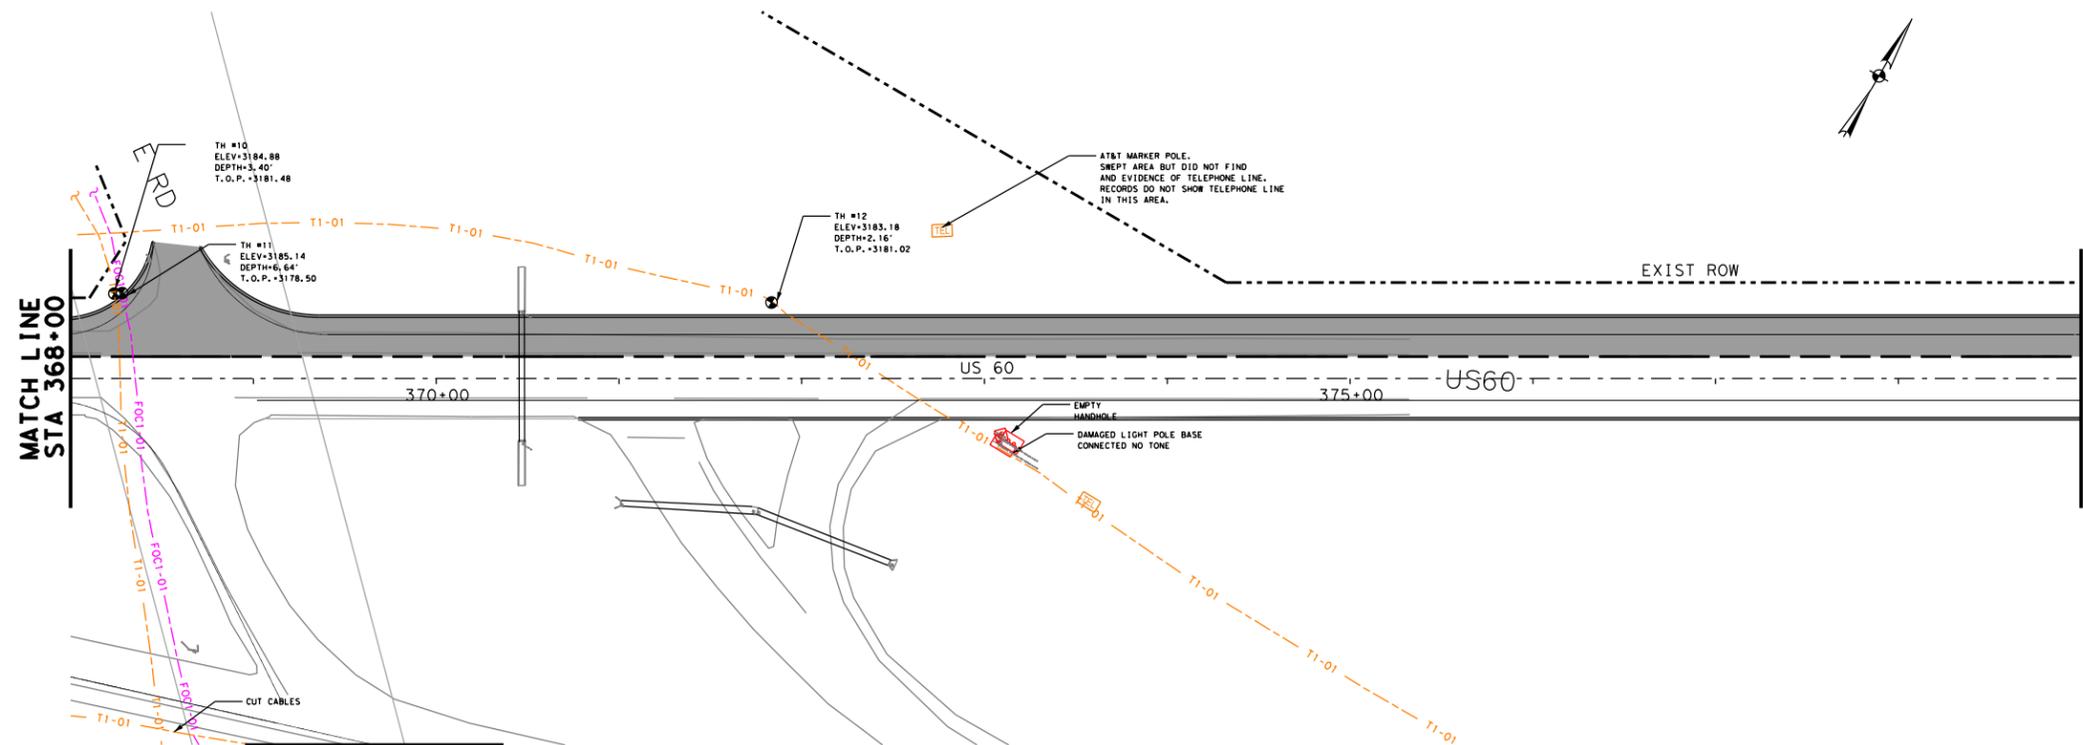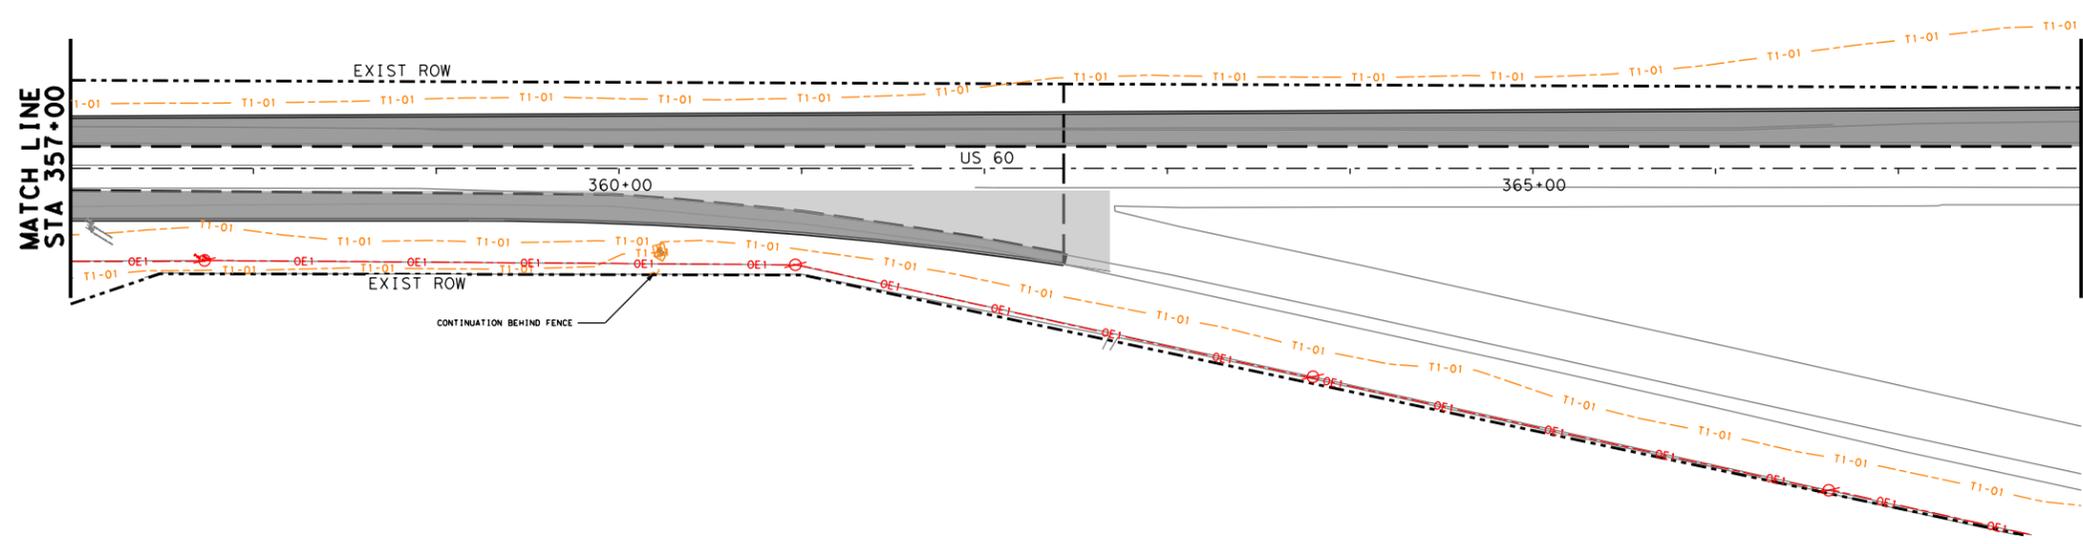

J.L.S.H.A.
4/2/2021

REV. NO.	DATE	DESCRIPTION	BY

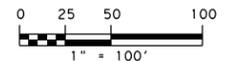

CobbFendley
 13430 Northwest Freeway, Ste. 1100
 Houston, Texas 77040
 713.462.3242
 www.cobbendley.com



**US 60
EXISTING UTILITY PLANS
STA 357+00 TO STA 379+00**

FED. RD. DIV. NO.	STATE	PROJECT NO.	HIGHWAY NO.
6	TEXAS	SEE TITLE SHEET	US 60
STATE DISTRICT	COUNTY	CONTROL NO.	SECTION NO.
AMA	GRAY	0619	07
		JOB NO.	SHEET NO.
		053, ETC	153


9:46:00 AM
 F:\P\Drawings\2019\1004_TxDOT_5x5_PSE\US60_Amarillo\ING500\UST\N506-SUE\02-Street\US60-SUE\15.dgn
 4/2/2021

NOTES:

- THE EXISTENCE AND LOCATION OF UTILITIES INDICATED ON THE PLANS ARE TAKEN FROM FIELD INVESTIGATION, THE BEST RECORDS AVAILABLE, AND ARE APPROXIMATED. THE CONTRACTOR SHALL LOCATE ALL UTILITIES (PUBLIC OR PRIVATE, SHOWN HERE OR NOT SHOWN) BOTH VERTICALLY AND HORIZONTALLY PRIOR TO COMMENCING WORK, WHETHER UTILITIES ARE ANTICIPATED TO BE IN DIRECT CONFLICT WITH PROPOSED WORK ACTIVITIES OR NOT. THE CONTRACTOR IS FULLY RESPONSIBLE FOR ANY DAMAGES CAUSED BY THE FAILURE TO LOCATE, PRESERVE, OR PROTECT THESE UTILITIES.
- ALL WORK ACTIVITIES (INCLUDING BUT NOT LIMITED TO CONSTRUCTING DETOURS, CULVERT EXTENSION AND REPLACEMENTS, EXCAVATION, DITCH GRADING, ETC.) SHALL NOT COMMENCE UNTIL ALL UTILITIES, ESPECIALLY UTILITIES WITHIN EXISTING ROW AND PARALLEL TO US 60, ARE IDENTIFIED. IF CONFLICTS WITH PROPOSED CONSTRUCTION OR WORK ACTIVITIES ARE IDENTIFIED, CONTRACTOR IS TO CEASE WORK IN THE LOCATION OF THE CONFLICT IMMEDIATELY.

**MATCH LINE
SHEET 35**

- LEGEND
- ⊗ TELEPHONE POLE
 - ⊗ POWER POLE
 - ⊞ ELECTRIC PULLBOX
 - ⊞ ELECTRIC METER
 - ⊞ ELECTRIC SWITCH
 - ⊞ ELECTRIC STREET LIGHT
 - ⊞ ELECTRIC LANDSCAPE LIGHT
 - ⊞ ELECTRIC TRAFFIC SIGNAL
 - ⊞ ELECTRIC TRAFFIC SWITCH BOX
 - ⊞ ELECTRIC CABINET
 - ⊞ ELECTRIC MARKER
 - ⊞ TELEPHONE PEDESTAL
 - ⊞ TELEPHONE MANHOLE
 - ⊞ TELEPHONE MARKER
 - ⊞ VIDEO-READY ACCESS DEVICE
 - ⊞ FIBER OPTIC PULLBOX
 - ⊞ FIBER OPTIC MARKER
 - ⊞ FIBER OPTIC TEST STATION
 - ⊞ GAS METER
 - ⊞ GAS MARKER
 - ⊞ GAS REGULATOR
 - ⊞ GAS TEST STATION
 - ⊞ GAS VALVE
 - ⊞ GAS VENT
 - ⊞ WATER MANHOLE
 - ⊞ WATER MARKER
 - ⊞ WATER TEST STATION
 - ⊞ WATER VALVE
- QL LEVEL B
- E1-01 ELECTRIC-XCEL/SOUTHWEST PUBLIC SERVICE.CO
 - E3-01 ELECTRIC - TXDOT
 - FOC1-01 FIBER OPTIC - AT&T
 - T1-01 TELEPHONE - AT&T
 - C1-01 CABLE TV - CABLE ONE
 - G1-01 GAS - ATMOS ENERGY
 - G1-02 GAS - ATMOS ENERGY (2")
 - G3-01 GAS - UNKNOWN
 - G4-01 GAS - AMARILLO NATURAL GAS
 - W1-01 WATER - CITY OF PAMPA
 - W1-06 WATER - CITY OF PAMPA (6")
 - W1-10 WATER - CITY OF PAMPA (10")
 - WW1-01 SANITARY SEWER - CITY OF PAMPA
 - SD-01 STORM - CITY OF PAMPA
 - UNK UNKNOWN
 - QL LEVEL D
 - E1-01-D ELECTRIC-XCEL/SOUTHWEST PUBLIC SERVICE.CO
 - E3-01-D ELECTRIC - TXDOT
 - FOC1-01-D FIBER OPTIC - AT&T
 - T1-01-D TELEPHONE - AT&T
 - C1-01-D CABLE TV - CABLE ONE
 - G1-01-D GAS - ATMOS ENERGY
 - G2-01-D GAS - WEST TEXAS GAS
 - G2-03-D GAS - WEST TEXAS GAS (3")
 - G3-01-D GAS - UNKNOWN
 - W1-01-D WATER - CITY OF PAMPA (UNKNOWN SIZE)
 - W1-02-D WATER - CITY OF PAMPA (2")
 - W1-06-D WATER - CITY OF PAMPA (6")
 - W1-10-D WATER - CITY OF PAMPA (10")
 - W2-04-D WATER - TXDOT (4")
 - W3-2.5-D WATER - PRIVATE (2.5")
 - W4-04-D WATER - WESTERN EQUIPMENT (4")
 - WW1-01-D SANITARY SEWER - CITY OF PAMPA
 - WW2-03-D SANITARY SEWER - WESTERN EQUIPMENT (3")
 - SD-01-D STORM - CITY OF PAMPA
 - UNK UNKNOWN
- OVERHEAD
- OE1 OVERHEAD ELECTRIC TRANSMISSION - XCEL/SOUTHWESTERN PUBLIC SERVICE CO
 - OE1 OVERHEAD ELECTRIC - XCEL ENERGY-SOUTHWESTERN PUBLIC SERVICE CO
 - OE1/FOC1/T1/C1 OVERHEAD ELEC/FOC/TEL/CATV - XCEL/AT&T/AT&T/CABLE ONE
 - OE1/FOC1 OVERHEAD ELEC/FOC/TEL - XCEL/AT&T
 - OE1/FOC1/T1 OVERHEAD ELEC/FOC/TEL - XCEL/AT&T/AT&T
 - OE1/T1 OVERHEAD ELEC/TEL - XCEL ENERGY/AT&T
 - OE1/T1/T1/C1 OVERHEAD ELEC/TEL/TEL/CATV/CATV - XCEL/AT&T/AT&T/CABLE ONE/CABLE ONE
 - OE1/T1/T1/C1 OVERHEAD ELEC/TEL/TEL/CATV - XCEL/AT&T/AT&T/CABLE ONE
 - OE1/T1/C1 OVERHEAD ELEC/TEL/CATV - XCEL/AT&T/CABLE ONE
 - OE1/C1 OVERHEAD ELEC/CATV - XCEL ENERGY/CABLE ONE
 - OE1/C1 OVERHEAD ELEC/CATV - XCEL ENERGY/CABLE ONE
 - FOC1 OVERHEAD FOC - AT&T
 - OT1 OVERHEAD TEL - AT&T
 - FOC1/T1/C1 OVERHEAD TEL/FOC/CATV - AT&T/AT&T/CABLE ONE
 - OT1/C1 OVERHEAD TEL/CATV - AT&T/CABLE ONE
 - OC1 OVERHEAD CATV - CABLE ONE

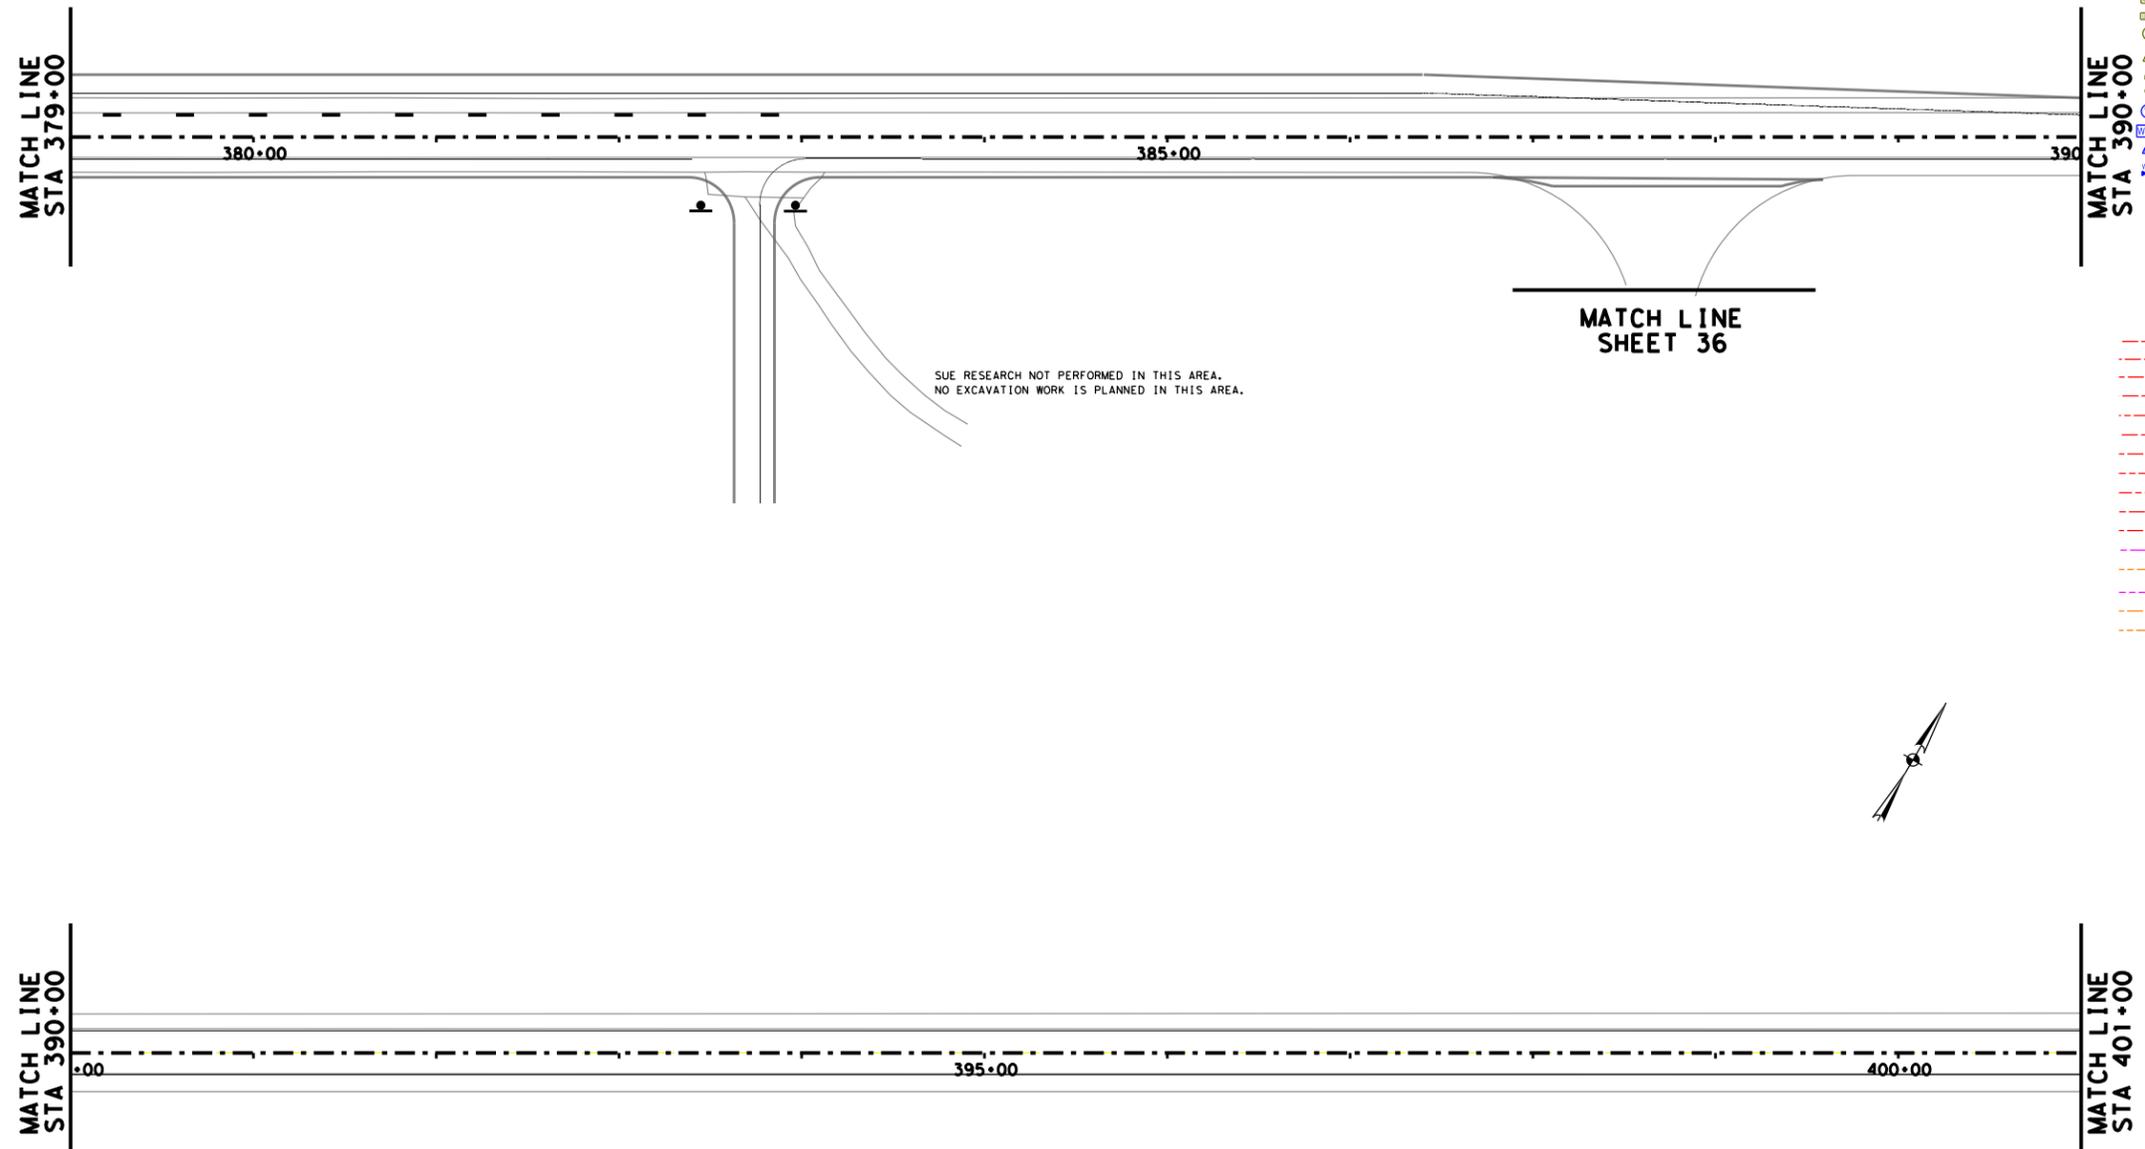

T.E. Hunt
4/2/2021

REV. NO.	DATE	DESCRIPTION	BY



CobbFendley
13430 Northwest Freeway, Ste. 1100
Houston, Texas 77040
713.462.3242
www.cobbhendley.com



US 60
EXISTING UTILITY PLANS
STA 379+00 TO STA 401+00
SHEET 16 OF 36


FED. RD. DIV. NO.	STATE	PROJECT NO.	HIGHWAY NO.		
6	TEXAS	SEE TITLE SHEET	US 60		
STATE DISTRICT	COUNTY	CONTROL NO.	SECTION NO.	JOB NO.	SHEET NO.
AMA	GRAY	0619	07	053, ETC	154

4/12/2021 F:\P\Proj\2019\1004_TxDOT_5x5_P&S\US60_SUE\03_US60_Amrt\10\EN\600-UST\N\606-SUE\02-Sheet\16-US60-SUE-16.dgn 9:46:01 AM


NOTES:
1. THE EXISTENCE AND LOCATION OF UTILITIES INDICATED ON THE PLANS ARE TAKEN FROM FIELD INVESTIGATION, THE BEST RECORDS AVAILABLE, AND ARE APPROXIMATED. THE CONTRACTOR SHALL LOCATE ALL UTILITIES (PUBLIC OR PRIVATE, SHOWN HERE OR NOT SHOWN) BOTH VERTICALLY AND HORIZONTALLY PRIOR TO COMMENCING WORK, WHETHER UTILITIES ARE ANTICIPATED TO BE IN DIRECT CONFLICT WITH PROPOSED WORK ACTIVITIES OR NOT. THE CONTRACTOR IS FULLY RESPONSIBLE FOR ANY DAMAGES CAUSED BY THE FAILURE TO LOCATE, PRESERVE, OR PROTECT THESE UTILITIES.
2. ALL WORK ACTIVITIES (INCLUDING BUT NOT LIMITED TO CONSTRUCTING DETOURS, CULVERT EXTENSION AND REPLACEMENTS, EXCAVATION, DITCH GRADING, ETC.) SHALL NOT COMMENCE UNTIL ALL UTILITIES, ESPECIALLY UTILITIES WITHIN EXISTING ROW AND PARALLEL TO US 60, ARE IDENTIFIED. IF CONFLICTS WITH PROPOSED CONSTRUCTION OR WORK ACTIVITIES ARE IDENTIFIED, CONTRACTOR IS TO CEASE WORK IN THE LOCATION OF THE CONFLICT IMMEDIATELY.

SUE RESEARCH NOT PERFORMED IN THIS AREA.
NO EXCAVATION WORK IS PLANNED IN THIS AREA.

- LEGEND
- ⊗ TELEPHONE POLE
 - ⊗ POWER POLE
 - ⊗ ELECTRIC PULLBOX
 - ⊗ ELECTRIC METER
 - ⊗ ELECTRIC SWITCH
 - ⊗ ELECTRIC STREET LIGHT
 - ⊗ ELECTRIC LANDSCAPE LIGHT
 - ⊗ ELECTRIC TRAFFIC SIGNAL
 - ⊗ ELECTRIC TRAFFIC SWITCH BOX
 - ⊗ ELECTRIC CABINET
 - ⊗ ELECTRIC MARKER
 - ⊗ TELEPHONE PEDESTAL
 - ⊗ TELEPHONE MANHOLE
 - ⊗ TELEPHONE MARKER
 - ⊗ VIDEO-READY ACCESS DEVICE
 - ⊗ FIBER OPTIC PULLBOX
 - ⊗ FIBER OPTIC MARKER
 - ⊗ FIBER OPTIC TEST STATION
 - ⊗ GAS METER
 - ⊗ GAS MARKER
 - ⊗ GAS REGULATOR
 - ⊗ GAS TEST STATION
 - ⊗ GAS VALVE
 - ⊗ GAS VENT
 - ⊗ WATER MANHOLE
 - ⊗ WATER MARKER
 - ⊗ WATER TEST STATION
 - ⊗ WATER VALVE
- QL LEVEL B - E1-01 - ELECTRIC-XCEL/SOUTHWEST PUBLIC SERVICE.CO
- E3-01 - ELECTRIC - TXDOT
- FOC1-01 - FIBER OPTIC - AT&T
- FOC2-01 - FIBER OPTIC - DOBSON FIBER CO
- T1-01 - TELEPHONE - AT&T
- C1-01 - CABLE TV - CABLE ONE
- G1-01 - GAS - ATMOS ENERGY
- G1-02 - GAS - ATMOS ENERGY (2")
- G3-01 - GAS - UNKNOWN
- G4-01 - GAS - AMARILLO NATURAL GAS
- W1-01 - WATER - CITY OF PAMPA
- W1-06 - WATER - CITY OF PAMPA (6")
- W1-10 - WATER - CITY OF PAMPA (10")
- WW1-01 - SANITARY SEWER - CITY OF PAMPA
- SD-01 - STORM - CITY OF PAMPA
- UNK - UNKNOWN
- QL LEVEL D - E1-01-D - ELECTRIC-XCEL/SOUTHWEST PUBLIC SERVICE.CO
- E3-01-D - ELECTRIC - TXDOT
- FOC1-01-D - FIBER OPTIC - AT&T
- T1-01-D - TELEPHONE - AT&T
- C1-01-D - CABLE TV - CABLE ONE
- G1-01-D - GAS - ATMOS ENERGY
- G2-01-D - GAS - WEST TEXAS GAS
- G2-03-D - GAS - WEST TEXAS GAS (3")
- G3-01-D - GAS - UNKNOWN
- W1-01-D - WATER - CITY OF PAMPA (UNKNOWN SIZE)
- W1-02-D - WATER - CITY OF PAMPA (2")
- W1-06-D - WATER - CITY OF PAMPA (6")
- W1-10-D - WATER - CITY OF PAMPA (10")
- W2-04-D - WATER - TXDOT (4")
- W3-2.5-D - WATER - PRIVATE (2.5")
- W4-04-D - WATER - WESTERN EQUIPMENT (4")
- WW1-01-D - SANITARY SEWER - CITY OF PAMPA
- WW2-03-D - SANITARY SEWER - WESTERN EQUIPMENT (3")
- SD-01-D - STORM - CITY OF PAMPA
- UNK - UNKNOWN
- OVERHEAD
- OHT - OVERHEAD ELECTRIC TRANSMISSION - XCEL/SOUTHWESTERN PUBLIC SERVICE CO
- OE1 - OVERHEAD ELECTRIC - XCEL ENERGY-SOUTHWESTERN PUBLIC SERVICE CO
- OE1/FOC1/T1/C1 - OVERHEAD ELEC/FOC/TEL/CATV - XCEL/AT&T/AT&T/CABLE ONE
- OE1/FOC1 - OVERHEAD ELEC/FOC/TEL - XCEL/AT&T
- OE1/FOC1/T1 - OVERHEAD ELEC/FOC/TEL - XCEL/AT&T/AT&T
- OE1/T1 - OVERHEAD ELEC/TEL - XCEL ENERGY/AT&T
- OE1/T1/T1/C1 - OVERHEAD ELEC/TEL/CATV/CATV - XCEL/AT&T/AT&T/CABLE ONE/CABLE ONE
- OE1/T1/T1/C1 - OVERHEAD ELEC/TEL/TEL/CATV - XCEL/AT&T/AT&T/CABLE ONE
- OE1/T1/C1 - OVERHEAD ELEC/TEL/CATV - XCEL/AT&T/CABLE ONE
- OE1/C1 - OVERHEAD ELEC/CATV - XCEL ENERGY/CABLE ONE
- OE1/C1 - OVERHEAD ELEC/CATV - XCEL ENERGY/CABLE ONE
- FOC1 - OVERHEAD FOC - AT&T
- OT1 - OVERHEAD TEL - AT&T
- FOC1/T1/C1 - OVERHEAD TEL/FOC/CATV - AT&T/AT&T/CABLE ONE
- OT1/C1 - OVERHEAD TEL/CATV - AT&T/CABLE ONE
- OC1 - OVERHEAD CATV - CABLE ONE

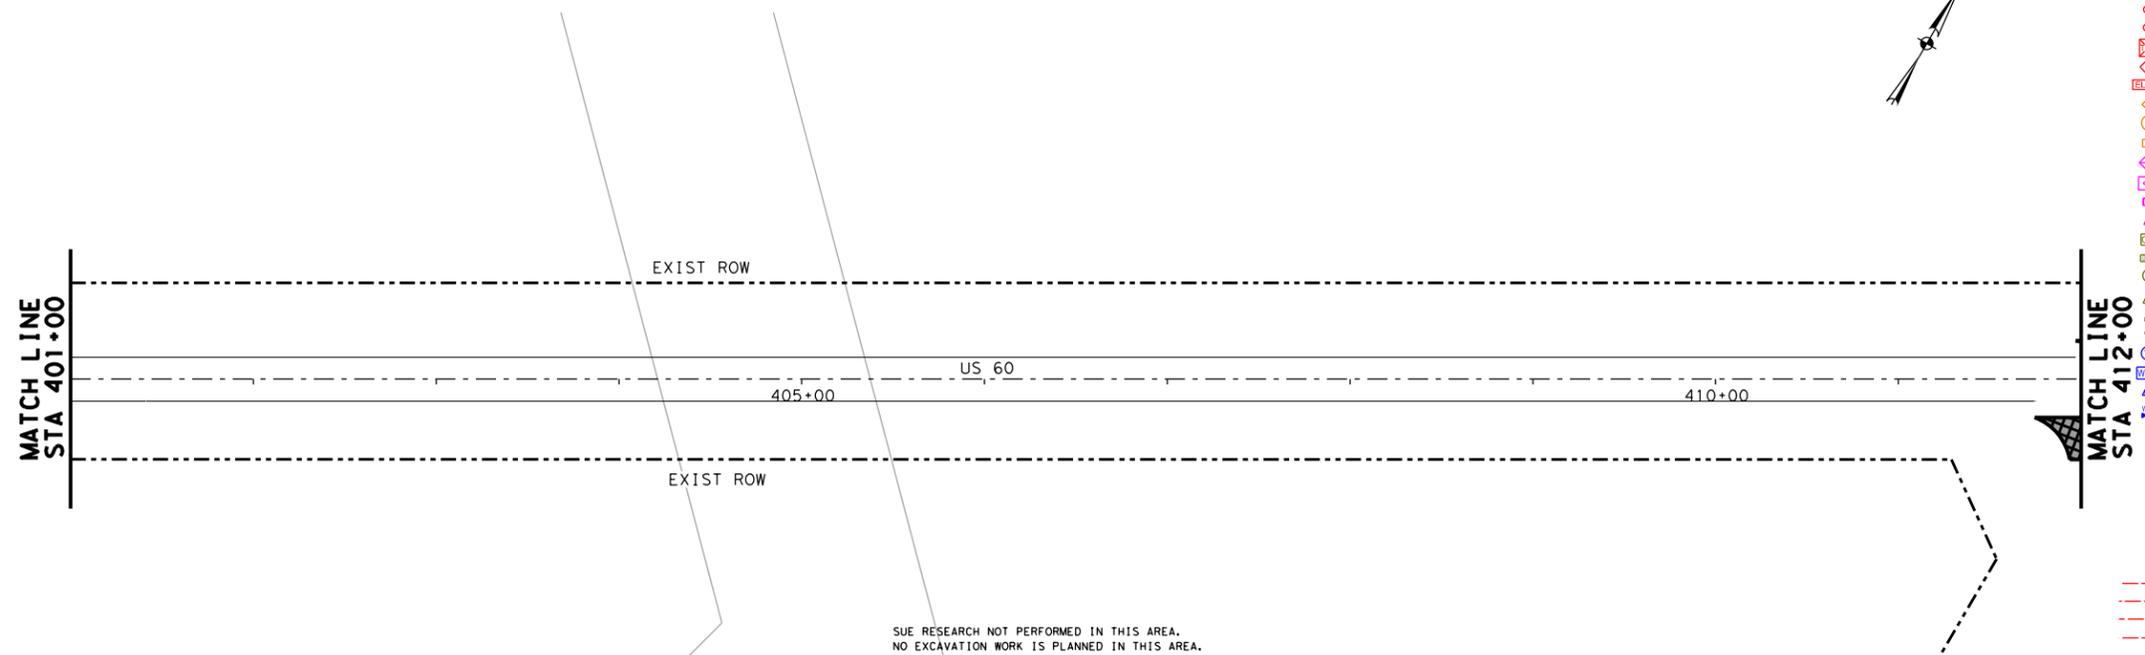

REV. NO.	DATE	DESCRIPTION	BY

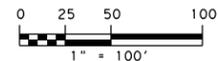

CobbFendley 13430 Northwest Freeway, Ste. 1100
Houston, Texas 77040
713.462.3242
www.cobbfendley.com



US 60
EXISTING UTILITY PLANS
STA 401+00 TO STA 423+00
SHEET 17 OF 36


FED. RD. DIV. NO.	STATE	PROJECT NO.	HIGHWAY NO.		
6	TEXAS	SEE TITLE SHEET	US 60		
STATE DISTRICT	COUNTY	CONTROL NO.	SECTION NO.	JOB NO.	SHEET NO.
AMA	GRAY	0619	07	053, ETC	155

4/12/2021
 9:46:02 AM
 F:\P\Proj\2019\1004_TxDOT_5x5_P&S\US60_Amrt\10\EN\600-UST\N\606-SUE-02-Sheet\US60-SUE-17.dgn


NOTES:

- THE EXISTENCE AND LOCATION OF UTILITIES INDICATED ON THE PLANS ARE TAKEN FROM FIELD INVESTIGATION, THE BEST RECORDS AVAILABLE, AND ARE APPROXIMATED. THE CONTRACTOR SHALL LOCATE ALL UTILITIES (PUBLIC OR PRIVATE, SHOWN HERE OR NOT SHOWN) BOTH VERTICALLY AND HORIZONTALLY PRIOR TO COMMENCING WORK, WHETHER UTILITIES ARE ANTICIPATED TO BE IN DIRECT CONFLICT WITH PROPOSED WORK ACTIVITIES OR NOT. THE CONTRACTOR IS FULLY RESPONSIBLE FOR ANY DAMAGES CAUSED BY THE FAILURE TO LOCATE, PRESERVE, OR PROTECT THESE UTILITIES.
- ALL WORK ACTIVITIES (INCLUDING BUT NOT LIMITED TO CONSTRUCTING DETOURS, CULVERT EXTENSION AND REPLACEMENTS, EXCAVATION, DITCH GRADING, ETC.) SHALL NOT COMMENCE UNTIL ALL UTILITIES, ESPECIALLY UTILITIES WITHIN EXISTING ROW AND PARALLEL TO US 60, ARE IDENTIFIED. IF CONFLICTS WITH PROPOSED CONSTRUCTION OR WORK ACTIVITIES ARE IDENTIFIED, CONTRACTOR IS TO CEASE WORK IN THE LOCATION OF THE CONFLICT IMMEDIATELY.

- LEGEND
- ⊗ TELEPHONE POLE
 - ⊗ POWER POLE
 - ⊗ ELECTRIC PULLBOX
 - ⊗ ELECTRIC METER
 - ⊗ ELECTRIC SWITCH
 - ⊗ ELECTRIC STREET LIGHT
 - ⊗ ELECTRIC LANDSCAPE LIGHT
 - ⊗ ELECTRIC TRAFFIC SIGNAL
 - ⊗ ELECTRIC TRAFFIC SWITCH BOX
 - ⊗ ELECTRIC CABINET
 - ⊗ ELECTRIC MARKER
 - ⊗ TELEPHONE PEDESTAL
 - ⊗ TELEPHONE MANHOLE
 - ⊗ TELEPHONE MARKER
 - ⊗ VIDEO-READY ACCESS DEVICE
 - ⊗ FIBER OPTIC PULLBOX
 - ⊗ FIBER OPTIC MARKER
 - ⊗ FIBER OPTIC TEST STATION
 - ⊗ GAS METER
 - ⊗ GAS MARKER
 - ⊗ GAS REGULATOR
 - ⊗ GAS TEST STATION
 - ⊗ GAS VALVE
 - ⊗ GAS VENT
 - ⊗ WATER MANHOLE
 - ⊗ WATER MARKER
 - ⊗ WATER TEST STATION
 - ⊗ WATER VALVE
- QL LEVEL B
- E1-01 ELECTRIC-XCEL/SOUTHWEST PUBLIC SERVICE.CO
 - E3-01 ELECTRIC - TXDOT
 - FOC1-01 FIBER OPTIC - AT&T
 - FOC2-01 FIBER OPTIC - DOBSON FIBER CO
 - T1-01 TELEPHONE - AT&T
 - C1-01 CABLE TV - CABLE ONE
 - G1-01 GAS - ATMOS ENERGY
 - G1-02 GAS - ATMOS ENERGY (2")
 - G3-01 GAS - UNKNOWN
 - G4-01 GAS - AMARILLO NATURAL GAS
 - W1-01 WATER - CITY OF PAMPA
 - W1-06 WATER - CITY OF PAMPA (6")
 - W1-10 WATER - CITY OF PAMPA (10")
 - WW1-01 SANITARY SEWER - CITY OF PAMPA
 - SD-01 STORM - CITY OF PAMPA
 - UNK UNKNOWN
 - QL LEVEL D
 - E1-01-D ELECTRIC-XCEL/SOUTHWEST PUBLIC SERVICE.CO
 - E3-01-D ELECTRIC - TXDOT
 - FOC1-01-D FIBER OPTIC - AT&T
 - T1-01-D TELEPHONE - AT&T
 - C1-01-D CABLE TV - CABLE ONE
 - G1-01-D GAS - ATMOS ENERGY
 - G2-01-D GAS - WEST TEXAS GAS
 - G2-03-D GAS - WEST TEXAS GAS (3")
 - G3-01-D GAS - UNKNOWN
 - W1-01-D WATER - CITY OF PAMPA (UNKNOWN SIZE)
 - W1-02-D WATER - CITY OF PAMPA (2")
 - W1-06-D WATER - CITY OF PAMPA (6")
 - W1-10-D WATER - CITY OF PAMPA (10")
 - W2-04-D WATER - TXDOT (4")
 - W3-2.5-D WATER - PRIVATE (2.5")
 - W4-04-D WATER - WESTERN EQUIPMENT (4")
 - WW1-01-D SANITARY SEWER - CITY OF PAMPA
 - WW2-03-D SANITARY SEWER - WESTERN EQUIPMENT (3")
 - SD-01-D STORM - CITY OF PAMPA
 - UNK UNKNOWN
- OVERHEAD
- OE1 OVERHEAD ELECTRIC TRANSMISSION - XCEL/SOUTHWESTERN PUBLIC SERVICE CO
 - OE1/FOC1/T1/C1 OVERHEAD ELEC/FOC/TEL/CATV - XCEL/AT&T/AT&T/CABLE ONE
 - OE1/FOC1 OVERHEAD ELEC/FOC/TEL - XCEL/AT&T
 - OE1/FOC1/T1 OVERHEAD ELEC/FOC/TEL - XCEL/AT&T/AT&T
 - OE1/T1 OVERHEAD ELEC/TEL - XCEL ENERGY/AT&T
 - OE1/T1/T1/C1 OVERHEAD ELEC/TEL/TEL/CATV/CATV - XCEL/AT&T/AT&T/CABLE ONE/CABLE ONE
 - OE1/T1/T1/C1 OVERHEAD ELEC/TEL/TEL/CATV - XCEL/AT&T/AT&T/CABLE ONE
 - OE1/T1/C1 OVERHEAD ELEC/TEL/CATV - XCEL/AT&T/CABLE ONE
 - OE1/C1 OVERHEAD ELEC/CATV - XCEL ENERGY/CABLE ONE
 - OE1/C1 OVERHEAD ELEC/CATV - XCEL ENERGY/CABLE ONE
 - FOC1 OVERHEAD FOC - AT&T
 - OT1 OVERHEAD TEL - AT&T
 - FOC1/T1/C1 OVERHEAD TEL/FOC/CATV - AT&T/AT&T/CABLE ONE
 - OT1/C1 OVERHEAD TEL/CATV - AT&T/CABLE ONE
 - OC1 OVERHEAD CATV - CABLE ONE

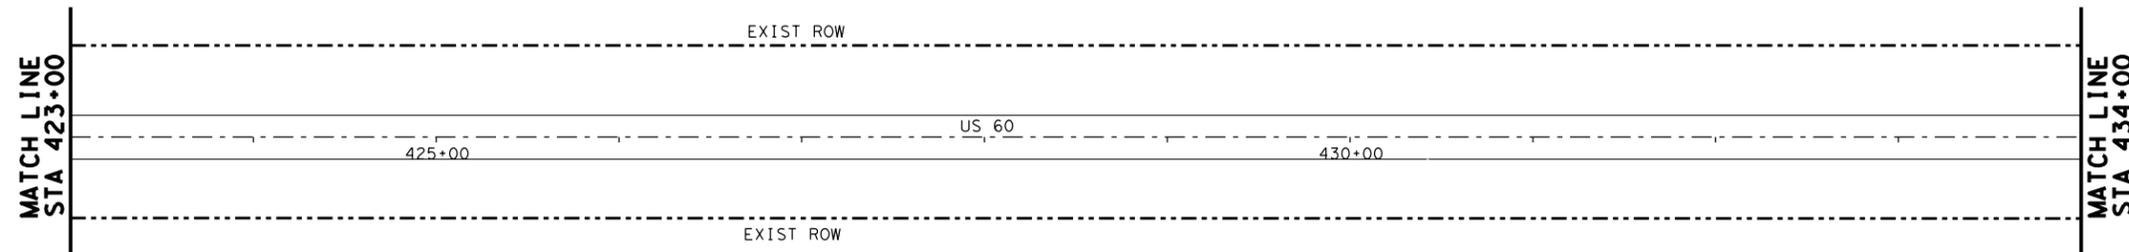


SUE RESEARCH NOT PERFORMED IN THIS AREA.
NO EXCAVATION WORK IS PLANNED IN THIS AREA.

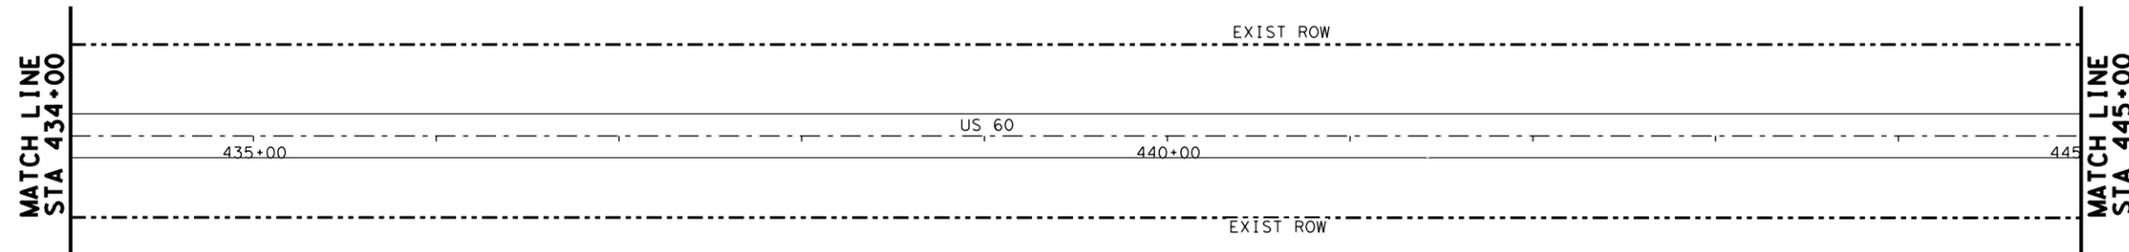

SUE RESEARCH NOT PERFORMED IN THIS AREA.
NO EXCAVATION WORK IS PLANNED IN THIS AREA.



REV. NO.	DATE	DESCRIPTION	BY

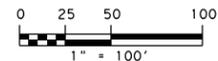

CobbFendley 13430 Northwest Freeway, Ste. 1100
Houston, Texas 77040
713.462.3242
www.cobbhendley.com

TBPE Firm Registration No. 274
TBPLS Firm Registration No. 100467



US 60
EXISTING UTILITY PLANS
STA 423+00 TO STA 445+00
SHEET 18 OF 36


FED. RD. DIV. NO.	STATE	PROJECT NO.	HIGHWAY NO.		
6	TEXAS	SEE TITLE SHEET	US 60		
STATE DISTRICT	COUNTY	CONTROL NO.	SECTION NO.	JOB NO.	SHEET NO.
AMA	GRAY	0619	07	053, ETC	156

4/12/2021 F:\P\Proj\2019\1004_TxDOT_5x5_PSB&E\03_US60_Amarrillo\ENGIN\500-UST\N\506-SUE\02-Sheet\5-US60-SUE-18.dgn 9:46:03 AM


NOTES:

- THE EXISTENCE AND LOCATION OF UTILITIES INDICATED ON THE PLANS ARE TAKEN FROM FIELD INVESTIGATION, THE BEST RECORDS AVAILABLE, AND ARE APPROXIMATED. THE CONTRACTOR SHALL LOCATE ALL UTILITIES (PUBLIC OR PRIVATE, SHOWN HERE OR NOT SHOWN) BOTH VERTICALLY AND HORIZONTALLY PRIOR TO COMMENCING WORK, WHETHER UTILITIES ARE ANTICIPATED TO BE IN DIRECT CONFLICT WITH PROPOSED WORK ACTIVITIES OR NOT. THE CONTRACTOR IS FULLY RESPONSIBLE FOR ANY DAMAGES CAUSED BY THE FAILURE TO LOCATE, PRESERVE, OR PROTECT THESE UTILITIES.
- ALL WORK ACTIVITIES (INCLUDING BUT NOT LIMITED TO CONSTRUCTING DETOURS, CULVERT EXTENSION AND REPLACEMENTS, EXCAVATION, DITCH GRADING, ETC.) SHALL NOT COMMENCE UNTIL ALL UTILITIES, ESPECIALLY UTILITIES WITHIN EXISTING ROW AND PARALLEL TO US 60, ARE IDENTIFIED. IF CONFLICTS WITH PROPOSED CONSTRUCTION OR WORK ACTIVITIES ARE IDENTIFIED, CONTRACTOR IS TO CEASE WORK IN THE LOCATION OF THE CONFLICT IMMEDIATELY.

- LEGEND
- ⊗ TELEPHONE POLE
 - ⊗ POWER POLE
 - ⊞ ELECTRIC PULLBOX
 - ⊞ ELECTRIC METER
 - ⊞ ELECTRIC SWITCH
 - ⊞ ELECTRIC STREET LIGHT
 - ⊞ ELECTRIC LANDSCAPE LIGHT
 - ⊞ ELECTRIC TRAFFIC SIGNAL
 - ⊞ ELECTRIC TRAFFIC SWITCH BOX
 - ⊞ ELECTRIC CABINET
 - ⊞ ELECTRIC MARKER
 - ⊞ TELEPHONE PEDESTAL
 - ⊞ TELEPHONE MANHOLE
 - ⊞ TELEPHONE MARKER
 - ⊞ VIDEO-READY ACCESS DEVICE
 - ⊞ FIBER OPTIC PULLBOX
 - ⊞ FIBER OPTIC MARKER
 - ⊞ FIBER OPTIC TEST STATION
 - ⊞ GAS METER
 - ⊞ GAS MARKER
 - ⊞ GAS REGULATOR
 - ⊞ GAS TEST STATION
 - ⊞ GAS VALVE
 - ⊞ GAS VENT
 - ⊞ WATER MANHOLE
 - ⊞ WATER MARKER
 - ⊞ WATER TEST STATION
 - ⊞ WATER VALVE
- QL LEVEL B
- E1-01 --- ELECTRIC-XCEL/SOUTHWEST PUBLIC SERVICE.CO
 - E3-01 --- ELECTRIC - TXDOT
 - FOC1-01 --- FIBER OPTIC - AT&T
 - FOC2-01 --- FIBER OPTIC - DOBSON FIBER CO
 - T1-01 --- TELEPHONE - AT&T
 - C1-01 --- CABLE TV - CABLE ONE
 - G1-01 --- GAS - ATMOS ENERGY
 - G1-02 --- GAS - ATMOS ENERGY (2")
 - G3-01 --- GAS - UNKNOWN
 - G4-01 --- GAS - AMARILLO NATURAL GAS
 - W1-01 --- WATER - CITY OF PAMPA
 - W1-06 --- WATER - CITY OF PAMPA (6")
 - W1-10 --- WATER - CITY OF PAMPA (10")
 - WW1-01 --- SANITARY SEWER - CITY OF PAMPA
 - SD-01 --- STORM - CITY OF PAMPA
 - UNK --- UNKNOWN
 - QL LEVEL D
 - E1-01-D --- ELECTRIC-XCEL/SOUTHWEST PUBLIC SERVICE.CO
 - E3-01-D --- ELECTRIC - TXDOT
 - FOC1-01-D --- FIBER OPTIC - AT&T
 - T1-01-D --- TELEPHONE - AT&T
 - C1-01-D --- CABLE TV - CABLE ONE
 - G1-01-D --- GAS - ATMOS ENERGY
 - G2-01-D --- GAS - WEST TEXAS GAS
 - G2-03-D --- GAS - WEST TEXAS GAS (3")
 - G3-01-D --- GAS - UNKNOWN
 - W1-01-D --- WATER - CITY OF PAMPA (UNKNOWN SIZE)
 - W1-02-D --- WATER - CITY OF PAMPA (2")
 - W1-06-D --- WATER - CITY OF PAMPA (6")
 - W1-10-D --- WATER - CITY OF PAMPA (10")
 - W2-04-D --- WATER - TXDOT (4")
 - W3-2.5-D --- WATER - PRIVATE (2.5")
 - W4-04-D --- WATER - WESTERN EQUIPMENT (4")
 - WW1-01-D --- SANITARY SEWER - CITY OF PAMPA
 - WW2-03-D --- SANITARY SEWER - WESTERN EQUIPMENT (3")
 - SD-01-D --- STORM - CITY OF PAMPA
 - UNK --- UNKNOWN
- OVERHEAD
- OHT --- OVERHEAD ELECTRIC TRANSMISSION - XCEL/SOUTHWESTERN PUBLIC SERVICE CO
 - OE1 --- OVERHEAD ELECTRIC - XCEL ENERGY-SOUTHWESTERN PUBLIC SERVICE CO
 - OE1/FOC1/T1/C1 --- OVERHEAD ELEC/FOC/TEL/CATV - XCEL/AT&T/AT&T/CABLE ONE
 - OE1/FOC1 --- OVERHEAD ELEC/FOC/TEL - XCEL/AT&T
 - OE1/FOC1/T1 --- OVERHEAD ELEC/FOC/TEL - XCEL/AT&T/AT&T
 - OE1/T1 --- OVERHEAD ELEC/TEL - XCEL ENERGY/AT&T
 - OE1/T1/T1/C1/C1 --- OVERHEAD ELEC/TEL/TEL/CATV/CATV - XCEL/AT&T/AT&T/CABLE ONE/CABLE ONE
 - OE1/T1/T1/C1 --- OVERHEAD ELEC/TEL/TEL/CATV - XCEL/AT&T/AT&T/CABLE ONE
 - OE1/T1/C1 --- OVERHEAD ELEC/TEL/CATV - XCEL/AT&T/CABLE ONE
 - OE1/C1 --- OVERHEAD ELEC/CATV - XCEL ENERGY/CABLE ONE
 - OE1/C1 --- OVERHEAD ELEC/CATV - XCEL ENERGY/CABLE ONE
 - OFOC1 --- OVERHEAD FOC - AT&T
 - OT1 --- OVERHEAD TEL - AT&T
 - OFOC1/T1/C1 --- OVERHEAD TEL/FOC/CATV - AT&T/AT&T/CABLE ONE
 - OT1/C1 --- OVERHEAD TEL/CATV - AT&T/CABLE ONE
 - OC1 --- OVERHEAD CATV - CABLE ONE

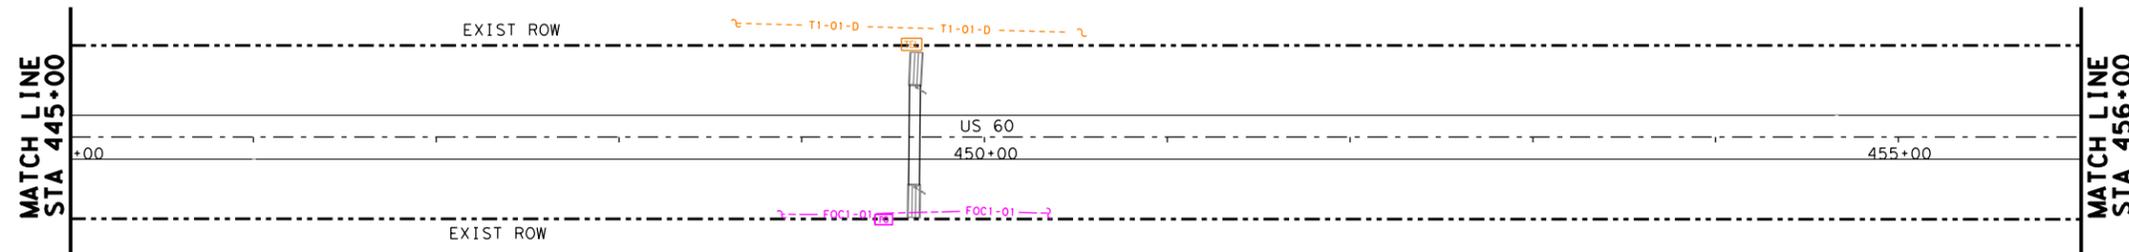

SUE RESEARCH NOT PERFORMED BEFORE STA. 448+00 OR AFTER STA. 451+00
NO EXCAVATION WORK IS PLANNED IN THIS AREA.

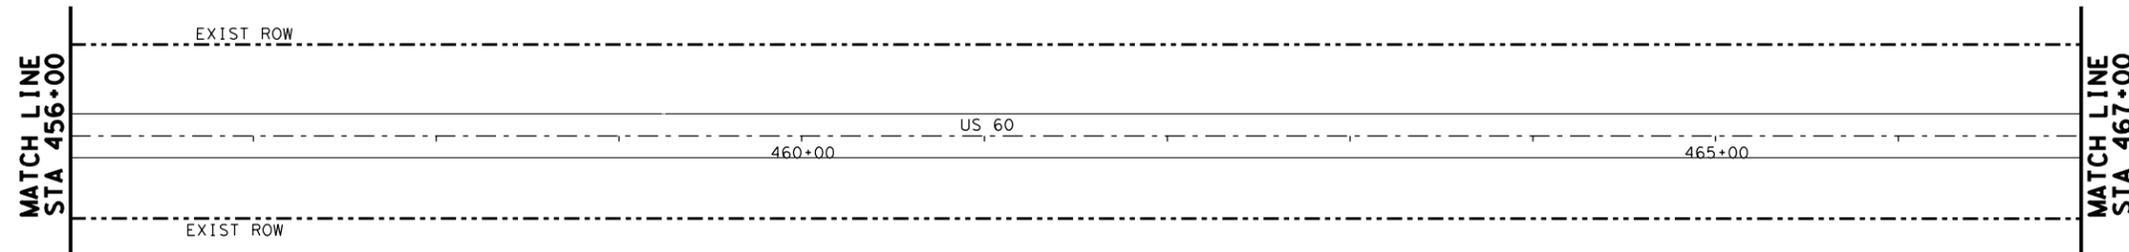


SUE RESEARCH NOT PERFORMED IN THIS AREA.
NO EXCAVATION WORK IS PLANNED IN THIS AREA.



T.E. Hunt
4/2/2021

REV. NO.	DATE	DESCRIPTION	BY

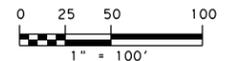

CobbFendley
13430 Northwest Freeway, Ste. 1100
Houston, Texas 77040
713.462.3242
www.cobbhendley.com




US 60
EXISTING UTILITY PLANS
STA 445+00 TO STA 467+00
SHEET 19 OF 36

FED. RD. DIV. NO.	STATE	PROJECT NO.	HIGHWAY NO.
6	TEXAS	SEE TITLE SHEET	US 60
STATE DISTRICT	COUNTY	CONTROL NO.	SECTION NO.
AMA	GRAY	0619	07
		JOB NO.	SHEET NO.
		053, ETC	157


4/12/2021 F:\P\Proj\2019\1004_TxDOT_5x5_PSE\US60_Amrt\10\EN\600-UST\N\606-SUE-02-Street\US60-SUE-19.dgn 9:46:04 AM

NOTES:
1. THE EXISTENCE AND LOCATION OF UTILITIES INDICATED ON THE PLANS ARE TAKEN FROM FIELD INVESTIGATION, THE BEST RECORDS AVAILABLE, AND ARE APPROXIMATED. THE CONTRACTOR SHALL LOCATE ALL UTILITIES (PUBLIC OR PRIVATE, SHOWN HERE OR NOT SHOWN) BOTH VERTICALLY AND HORIZONTALLY PRIOR TO COMMENCING WORK, WHETHER UTILITIES ARE ANTICIPATED TO BE IN DIRECT CONFLICT WITH PROPOSED WORK ACTIVITIES OR NOT. THE CONTRACTOR IS FULLY RESPONSIBLE FOR ANY DAMAGES CAUSED BY THE FAILURE TO LOCATE, PRESERVE, OR PROTECT THESE UTILITIES.
2. ALL WORK ACTIVITIES (INCLUDING BUT NOT LIMITED TO CONSTRUCTING DETOURS, CULVERT EXTENSION AND REPLACEMENTS, EXCAVATION, DITCH GRADING, ETC.) SHALL NOT COMMENCE UNTIL ALL UTILITIES, ESPECIALLY UTILITIES WITHIN EXISTING ROW AND PARALLEL TO US 60, ARE IDENTIFIED. IF CONFLICTS WITH PROPOSED CONSTRUCTION OR WORK ACTIVITIES ARE IDENTIFIED, CONTRACTOR IS TO CEASE WORK IN THE LOCATION OF THE CONFLICT IMMEDIATELY.

- LEGEND**
- ⊗ TELEPHONE POLE
 - ⊗ POWER POLE
 - ⊗ ELECTRIC PULLBOX
 - ⊗ ELECTRIC METER
 - ⊗ ELECTRIC SWITCH
 - ⊗ ELECTRIC STREET LIGHT
 - ⊗ ELECTRIC LANDSCAPE LIGHT
 - ⊗ ELECTRIC TRAFFIC SIGNAL
 - ⊗ ELECTRIC TRAFFIC SWITCH BOX
 - ⊗ ELECTRIC CABINET
 - ⊗ ELECTRIC MARKER
 - ⊗ TELEPHONE PEDESTAL
 - ⊗ TELEPHONE MANHOLE
 - ⊗ TELEPHONE MARKER
 - ⊗ VIDEO-READY ACCESS DEVICE
 - ⊗ FIBER OPTIC PULLBOX
 - ⊗ FIBER OPTIC MARKER
 - ⊗ FIBER OPTIC TEST STATION
 - ⊗ GAS METER
 - ⊗ GAS MARKER
 - ⊗ GAS REGULATOR
 - ⊗ GAS TEST STATION
 - ⊗ GAS VALVE
 - ⊗ GAS VENT
 - ⊗ WATER MANHOLE
 - ⊗ WATER MARKER
 - ⊗ WATER VALVE
- QL LEVEL B**
- E1-01 --- ELECTRIC-XCEL/SOUTHWEST PUBLIC SERVICE.CO
 - E3-01 --- ELECTRIC - TXDOT
 - FOC1-01 --- FIBER OPTIC - AT&T
 - T1-01 --- TELEPHONE - AT&T
 - C1-01 --- CABLE TV - CABLE ONE
 - G1-01 --- GAS - ATMOS ENERGY
 - G1-02 --- GAS - ATMOS ENERGY (2")
 - G3-01 --- GAS - UNKNOWN
 - G4-01 --- GAS - AMARILLO NATURAL GAS
 - W1-01 --- WATER - CITY OF PAMPA
 - W1-06 --- WATER - CITY OF PAMPA (6")
 - W1-10 --- WATER - CITY OF PAMPA (10")
 - WW1-01 --- SANITARY SEWER - CITY OF PAMPA
 - SD-01 --- STORM - CITY OF PAMPA
 - UNK --- UNKNOWN
 - QL LEVEL D --- ELECTRIC-XCEL/SOUTHWEST PUBLIC SERVICE.CO
 - E1-01-D --- ELECTRIC - TXDOT
 - FOC1-01-D --- FIBER OPTIC - AT&T
 - T1-01-D --- TELEPHONE - AT&T
 - C1-01-D --- CABLE TV - CABLE ONE
 - G1-01-D --- GAS - ATMOS ENERGY
 - G2-01-D --- GAS - WEST TEXAS GAS
 - G2-03-D --- GAS - WEST TEXAS GAS (3")
 - G3-01-D --- GAS - UNKNOWN
 - W1-01-D --- WATER - CITY OF PAMPA (UNKNOWN SIZE)
 - W1-02-D --- WATER - CITY OF PAMPA (2")
 - W1-06-D --- WATER - CITY OF PAMPA (6")
 - W1-10-D --- WATER - CITY OF PAMPA (10")
 - W2-04-D --- WATER - TXDOT (4")
 - W3-2.5-D --- WATER - PRIVATE (2.5")
 - W4-04-D --- WATER - WESTERN EQUIPMENT (4")
 - WW1-01-D --- SANITARY SEWER - CITY OF PAMPA
 - WW2-03-D --- SANITARY SEWER - WESTERN EQUIPMENT (3")
 - SD-01-D --- STORM - CITY OF PAMPA
 - UNK --- UNKNOWN
- OVERHEAD**
- OHT --- OVERHEAD ELECTRIC TRANSMISSION - XCEL/SOUTHWESTERN PUBLIC SERVICE CO
 - OE1 --- OVERHEAD ELECTRIC - XCEL ENERGY-SOUTHWESTERN PUBLIC SERVICE CO
 - OE1/FOC1/T1/C1 --- OVERHEAD ELEC/FOC/TEL/CATV - XCEL/AT&T/AT&T/CABLE ONE
 - OE1/FOC1 --- OVERHEAD ELEC/FOC/TEL - XCEL/AT&T
 - OE1/FOC1/T1 --- OVERHEAD ELEC/FOC/TEL - XCEL/AT&T/AT&T
 - OE1/T1 --- OVERHEAD ELEC/TEL - XCEL ENERGY/AT&T
 - OE1/T1/T1/C1/C1 --- OVERHEAD ELEC/TEL/TEL/CATV/CATV - XCEL/AT&T/AT&T/CABLE ONE/CABLE ONE
 - OE1/T1/T1/C1 --- OVERHEAD ELEC/TEL/TEL/CATV - XCEL/AT&T/AT&T/CABLE ONE
 - OE1/T1/C1 --- OVERHEAD ELEC/TEL/CATV - XCEL/AT&T/CABLE ONE
 - OE1/C1 --- OVERHEAD ELEC/CATV - XCEL ENERGY/CABLE ONE
 - OE1/C1 --- OVERHEAD ELEC/CATV - XCEL ENERGY/CABLE ONE
 - FOC1 --- OVERHEAD FOC - AT&T
 - T1 --- OVERHEAD TEL - AT&T
 - FOC1/T1/C1 --- OVERHEAD TEL/FOC/CATV - AT&T/AT&T/CABLE ONE
 - T1/C1 --- OVERHEAD TEL/CATV - AT&T/CABLE ONE
 - C1 --- OVERHEAD CATV - CABLE ONE

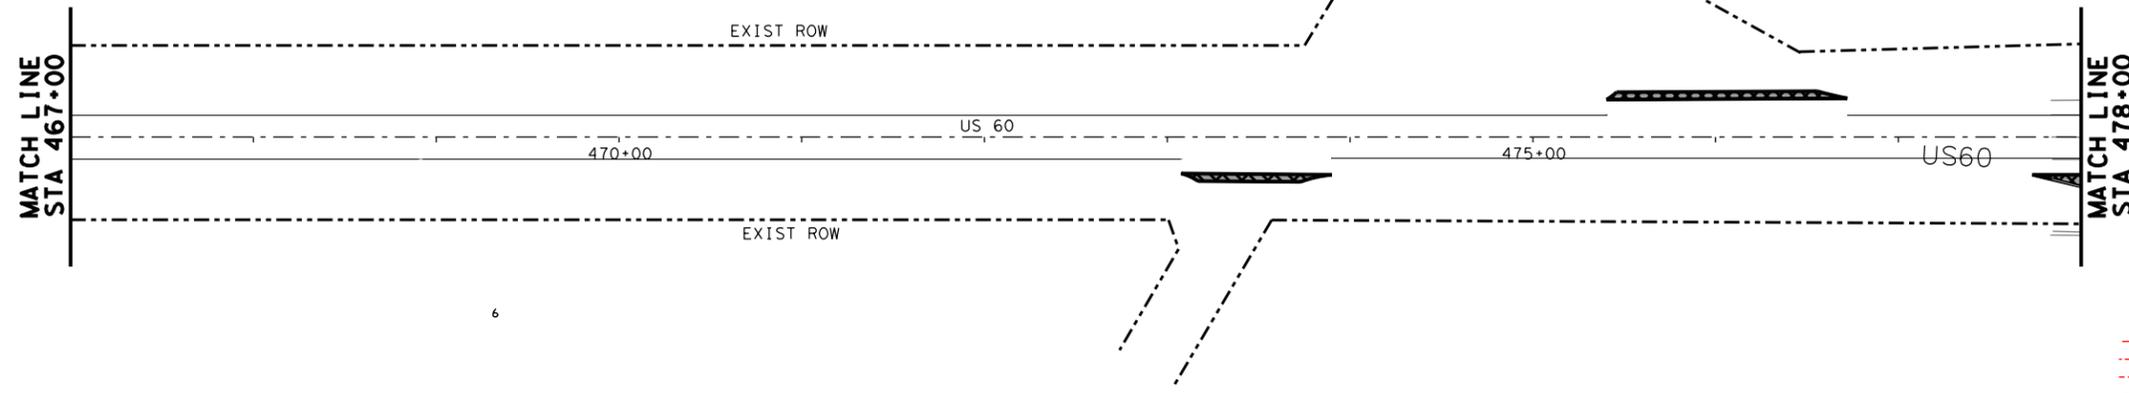

SUE RESEARCH NOT PERFORMED IN THIS AREA.
NO EXCAVATION WORK IS PLANNED IN THIS AREA.

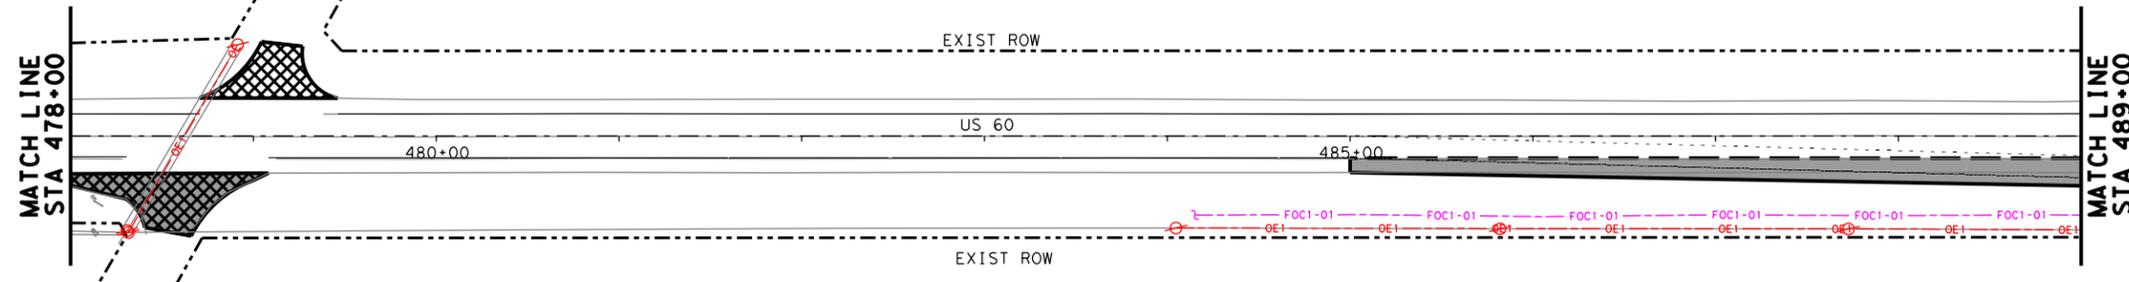


SUE RESEARCH NOT PERFORMED BEFORE STA. 484+00
SUE RESEARCH ONLY PERFORMED ON SIDE WITH
PROPOSED US 60 ROAD WIDENING.



4/2/2021

REV. NO.	DATE	DESCRIPTION	BY

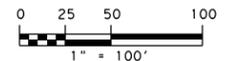

CobbFendley 13430 Northwest Freeway, Ste. 1100
Houston, Texas 77040
713.462.3242
www.cobbhendley.com



US 60
EXISTING UTILITY PLANS
STA 467+00 TO STA 489+00
SHEET 20 OF 36


FED. RD. DIV. NO.	STATE	PROJECT NO.	HIGHWAY NO.		
6	TEXAS	SEE TITLE SHEET	US 60		
STATE DISTRICT	COUNTY	CONTROL NO.	SECTION NO.	JOB NO.	SHEET NO.
AMA	GRAY	0619	07	053, ETC	158

9/4/2021 AM
 F:\P\Proj\2019\1004_TxDOT_5x5_PSS&E\03_US60_Amari\1016\16\500-UST\N\506-SUE\02-Street\US60-SUE-20.dgn
 4/2/2021


NOTES:

- THE EXISTENCE AND LOCATION OF UTILITIES INDICATED ON THE PLANS ARE TAKEN FROM FIELD INVESTIGATION, THE BEST RECORDS AVAILABLE, AND ARE APPROXIMATED. THE CONTRACTOR SHALL LOCATE ALL UTILITIES (PUBLIC OR PRIVATE, SHOWN HERE OR NOT SHOWN) BOTH VERTICALLY AND HORIZONTALLY PRIOR TO COMMENCING WORK, WHETHER UTILITIES ARE ANTICIPATED TO BE IN DIRECT CONFLICT WITH PROPOSED WORK ACTIVITIES OR NOT. THE CONTRACTOR IS FULLY RESPONSIBLE FOR ANY DAMAGES CAUSED BY THE FAILURE TO LOCATE, PRESERVE, OR PROTECT THESE UTILITIES.
- ALL WORK ACTIVITIES (INCLUDING BUT NOT LIMITED TO CONSTRUCTING DETOURS, CULVERT EXTENSION AND REPLACEMENTS, EXCAVATION, DITCH GRADING, ETC.) SHALL NOT COMMENCE UNTIL ALL UTILITIES, ESPECIALLY UTILITIES WITHIN EXISTING ROW AND PARALLEL TO US 60, ARE IDENTIFIED. IF CONFLICTS WITH PROPOSED CONSTRUCTION OR WORK ACTIVITIES ARE IDENTIFIED, CONTRACTOR IS TO CEASE WORK IN THE LOCATION OF THE CONFLICT IMMEDIATELY.

- LEGEND
- ⊗ TELEPHONE POLE
 - ⊗ POWER POLE
 - ⊗ ELECTRIC PULLBOX
 - ⊗ ELECTRIC METER
 - ⊗ ELECTRIC SWITCH
 - ⊗ ELECTRIC STREET LIGHT
 - ⊗ ELECTRIC LANDSCAPE LIGHT
 - ⊗ ELECTRIC TRAFFIC SIGNAL
 - ⊗ ELECTRIC TRAFFIC SWITCH BOX
 - ⊗ ELECTRIC CABINET
 - ⊗ ELECTRIC MARKER
 - ⊗ TELEPHONE PEDESTAL
 - ⊗ TELEPHONE MANHOLE
 - ⊗ TELEPHONE MARKER
 - ⊗ VIDEO-READY ACCESS DEVICE
 - ⊗ FIBER OPTIC PULLBOX
 - ⊗ FIBER OPTIC MARKER
 - ⊗ FIBER OPTIC TEST STATION
 - ⊗ GAS METER
 - ⊗ GAS MARKER
 - ⊗ GAS REGULATOR
 - ⊗ GAS TEST STATION
 - ⊗ GAS VALVE
 - ⊗ GAS VENT
 - ⊗ WATER MANHOLE
 - ⊗ WATER MARKER
 - ⊗ WATER TEST STATION
 - ⊗ WATER VALVE
- QL LEVEL B
- E1-01 ELECTRIC-XCEL/SOUTHWEST PUBLIC SERVICE.CO
 - E3-01 ELECTRIC - TXDOT
 - FOC1-01 FIBER OPTIC - AT&T
 - FOC2-01 FIBER OPTIC - DOBSON FIBER CO
 - T1-01 TELEPHONE - AT&T
 - C1-01 CABLE TV - CABLE ONE
 - G1-01 GAS - ATMOS ENERGY
 - G1-02 GAS - ATMOS ENERGY (2")
 - G3-01 GAS - UNKNOWN
 - G4-01 GAS - AMARILLO NATURAL GAS
 - W1-01 WATER - CITY OF PAMPA
 - W1-06 WATER - CITY OF PAMPA (6")
 - W1-10 WATER - CITY OF PAMPA (10")
 - WW1-01 SANITARY SEWER - CITY OF PAMPA
 - SD-01 STORM - CITY OF PAMPA
 - UNK - UNKNOWN
- QL LEVEL D
- E1-01-D ELECTRIC-XCEL/SOUTHWEST PUBLIC SERVICE.CO
 - E3-01-D ELECTRIC - TXDOT
 - FOC1-01-D FIBER OPTIC - AT&T
 - T1-01-D TELEPHONE - AT&T
 - C1-01-D CABLE TV - CABLE ONE
 - G1-01-D GAS - ATMOS ENERGY
 - G2-01-D GAS - WEST TEXAS GAS
 - G2-03-D GAS - WEST TEXAS GAS (3")
 - G3-01-D GAS - UNKNOWN
 - W1-01-D WATER - CITY OF PAMPA (UNKNOWN SIZE)
 - W1-02-D WATER - CITY OF PAMPA (2")
 - W1-06-D WATER - CITY OF PAMPA (6")
 - W1-10-D WATER - CITY OF PAMPA (10")
 - W2-04-D WATER - TXDOT (4")
 - W3-2.5-D WATER - PRIVATE (2.5")
 - W4-04-D WATER - WESTERN EQUIPMENT (4")
 - WW1-01-D SANITARY SEWER - CITY OF PAMPA
 - WW2-03-D SANITARY SEWER - WESTERN EQUIPMENT (3")
 - SD-01-D STORM - CITY OF PAMPA
 - UNK - UNKNOWN
- OVERHEAD
- OE1 OVERHEAD ELECTRIC TRANSMISSION - XCEL/SOUTHWESTERN PUBLIC SERVICE CO
 - OE1 OVERHEAD ELECTRIC - XCEL ENERGY-SOUTHWESTERN PUBLIC SERVICE CO
 - OE1/FOC1/T1/C1 OVERHEAD ELEC/FOC/TEL/CATV - XCEL/AT&T/AT&T/CABLE ONE
 - OE1/FOC1 OVERHEAD ELEC/FOC/TEL - XCEL/AT&T
 - OE1/FOC1/T1 OVERHEAD ELEC/FOC/TEL - XCEL/AT&T/AT&T
 - OE1/T1 OVERHEAD ELEC/TEL - XCEL ENERGY/AT&T
 - OE1/T1/T1/C1 OVERHEAD ELEC/TEL/TEL/CATV/CATV - XCEL/AT&T/AT&T/CABLE ONE/CABLE ONE
 - OE1/T1/T1 OVERHEAD ELEC/TEL/TEL/CATV - XCEL/AT&T/AT&T/CABLE ONE
 - OE1/T1/C1 OVERHEAD ELEC/TEL/CATV - XCEL/AT&T/CABLE ONE
 - OE1/C1 OVERHEAD ELEC/CATV - XCEL ENERGY/CABLE ONE
 - OE1/C1 OVERHEAD ELEC/CATV - XCEL ENERGY/CABLE ONE
 - FOC1 OVERHEAD FOC - AT&T
 - OT1 OVERHEAD TEL - AT&T
 - FOC1/T1/C1 OVERHEAD TEL/FOC/CATV - AT&T/AT&T/CABLE ONE
 - OT1/C1 OVERHEAD TEL/CATV - AT&T/CABLE ONE
 - OC1 OVERHEAD CATV - CABLE ONE

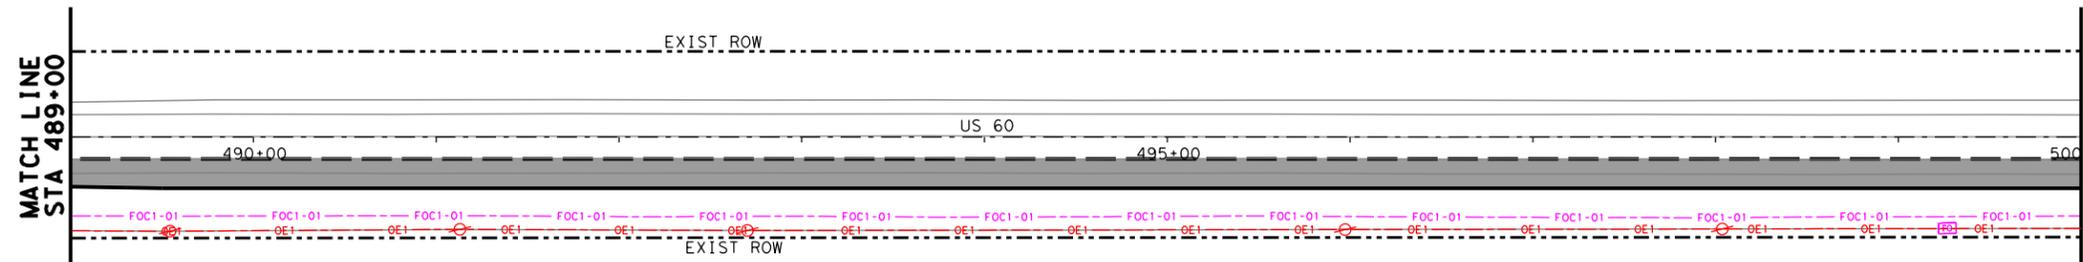

SUE RESEARCH NOT PERFORMED BEFORE STA. 484+00
 SUE RESEARCH ONLY PERFORMED ON SIDE WITH
 PROPOSED US 60 ROAD WIDENING.

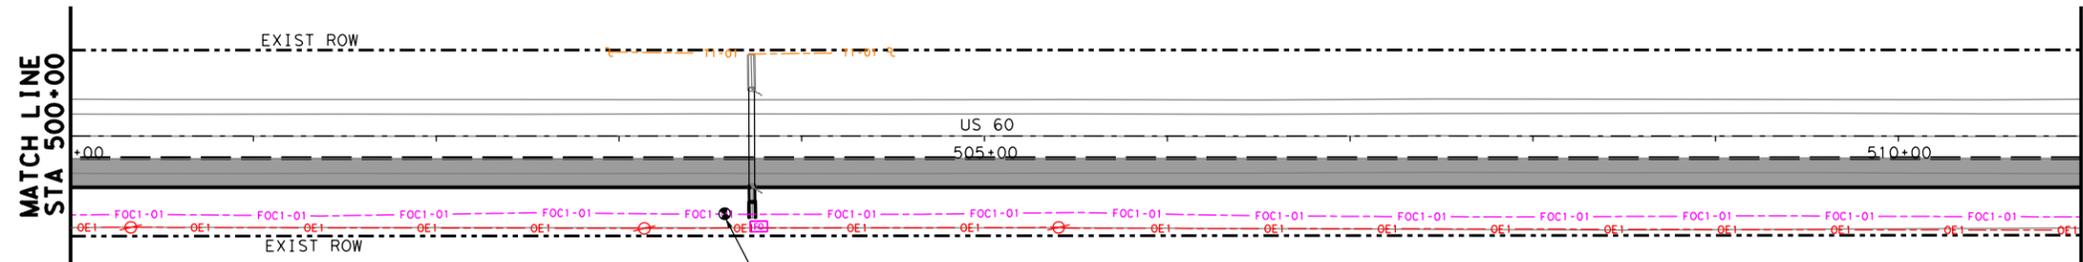


SUE RESEARCH ONLY PERFORMED ON AREAS WITH
 PROPOSED US 60 ROAD WIDENING AND PROPOSED
 DRAINAGE.



T.E. Hunt
 4/2/2021

REV. NO.	DATE	DESCRIPTION	BY

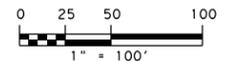

CobbFendley
 TBPE Firm Registration No. 274
 TBPLS Firm Registration No. 100467
 13430 Northwest Freeway, Ste. 1100
 Houston, Texas 77040
 713.462.3242
 www.cobbhendley.com




US 60
 EXISTING UTILITY PLANS
 STA 489+00 TO STA 511+00
 SHEET 21 OF 36

FED. RD. DIV. NO.	STATE	PROJECT NO.	HIGHWAY NO.		
6	TEXAS	SEE TITLE SHEET	US 60		
STATE DISTRICT	COUNTY	CONTROL NO.	SECTION NO.	JOB NO.	SHEET NO.
AMA	GRAY	0619	07	053, ETC	159


4/12/2021 F:\P\0\1004\2019\1004_TxDOT_5x5_PSS&E\03_US60_Amrt\10\10\US60-SUE-02-Sheet\US60-SUE-21.dgn 9:46:05 AM

NOTES:
 1. THE EXISTENCE AND LOCATION OF UTILITIES INDICATED ON THE PLANS ARE TAKEN FROM FIELD INVESTIGATION, THE BEST RECORDS AVAILABLE, AND ARE APPROXIMATED. THE CONTRACTOR SHALL LOCATE ALL UTILITIES (PUBLIC OR PRIVATE, SHOWN HERE OR NOT SHOWN) BOTH VERTICALLY AND HORIZONTALLY PRIOR TO COMMENCING WORK, WHETHER UTILITIES ARE ANTICIPATED TO BE IN DIRECT CONFLICT WITH PROPOSED WORK ACTIVITIES OR NOT. THE CONTRACTOR IS FULLY RESPONSIBLE FOR ANY DAMAGES CAUSED BY THE FAILURE TO LOCATE, PRESERVE, OR PROTECT THESE UTILITIES.
 2. ALL WORK ACTIVITIES (INCLUDING BUT NOT LIMITED TO CONSTRUCTING DETOURS, CULVERT EXTENSION AND REPLACEMENTS, EXCAVATION, DITCH GRADING, ETC.) SHALL NOT COMMENCE UNTIL ALL UTILITIES, ESPECIALLY UTILITIES WITHIN EXISTING ROW AND PARALLEL TO US 60, ARE IDENTIFIED. IF CONFLICTS WITH PROPOSED CONSTRUCTION OR WORK ACTIVITIES ARE IDENTIFIED, CONTRACTOR IS TO CEASE WORK IN THE LOCATION OF THE CONFLICT IMMEDIATELY.

- LEGEND
- ⊗ TELEPHONE POLE
 - ⊗ POWER POLE
 - ⊞ ELECTRIC PULLBOX
 - ⊞ ELECTRIC METER
 - ⊞ ELECTRIC SWITCH
 - ⊞ ELECTRIC STREET LIGHT
 - ⊞ ELECTRIC LANDSCAPE LIGHT
 - ⊞ ELECTRIC TRAFFIC SIGNAL
 - ⊞ ELECTRIC TRAFFIC SWITCH BOX
 - ⊞ ELECTRIC CABINET
 - ⊞ ELECTRIC MARKER
 - ⊞ TELEPHONE PEDESTAL
 - ⊞ TELEPHONE MANHOLE
 - ⊞ TELEPHONE MARKER
 - ⊞ VIDEO-READY ACCESS DEVICE
 - ⊞ FIBER OPTIC PULLBOX
 - ⊞ FIBER OPTIC MARKER
 - ⊞ FIBER OPTIC TEST STATION
 - ⊞ GAS METER
 - ⊞ GAS MARKER
 - ⊞ GAS REGULATOR
 - ⊞ GAS TEST STATION
 - ⊞ GAS VALVE
 - ⊞ GAS VENT
 - ⊞ WATER MANHOLE
 - ⊞ WATER MARKER
 - ⊞ WATER TEST STATION
 - ⊞ WATER VALVE
- QL LEVEL B
- E1-01 --- ELECTRIC-XCEL/SOUTHWEST PUBLIC SERVICE.CO
 - E3-01 --- ELECTRIC - TXDOT
 - FOC1-01 --- FIBER OPTIC - AT&T
 - FOC2-01 --- FIBER OPTIC - DOBSON FIBER CO
 - T1-01 --- TELEPHONE - AT&T
 - C1-01 --- CABLE TV - CABLE ONE
 - G1-01 --- GAS - ATMOS ENERGY
 - G1-02 --- GAS - ATMOS ENERGY (2")
 - G3-01 --- GAS - UNKNOWN
 - G4-01 --- GAS - AMARILLO NATURAL GAS
 - W1-01 --- WATER - CITY OF PAMPA
 - W1-06 --- WATER - CITY OF PAMPA (6")
 - W1-10 --- WATER - CITY OF PAMPA (10")
 - WW1-01 --- SANITARY SEWER - CITY OF PAMPA
 - SD-01 --- STORM - CITY OF PAMPA
 - UNK --- UNKNOWN
 - QL LEVEL D
 - E1-01-D --- ELECTRIC-XCEL/SOUTHWEST PUBLIC SERVICE.CO
 - E3-01-D --- ELECTRIC - TXDOT
 - FOC1-01-D --- FIBER OPTIC - AT&T
 - T1-01-D --- TELEPHONE - AT&T
 - C1-01-D --- CABLE TV - CABLE ONE
 - G1-01-D --- GAS - ATMOS ENERGY
 - G2-01-D --- GAS - WEST TEXAS GAS
 - G2-03-D --- GAS - WEST TEXAS GAS (3")
 - G3-01-D --- GAS - UNKNOWN
 - W1-01-D --- WATER - CITY OF PAMPA (UNKNOWN SIZE)
 - W1-02-D --- WATER - CITY OF PAMPA (2")
 - W1-06-D --- WATER - CITY OF PAMPA (6")
 - W1-10-D --- WATER - CITY OF PAMPA (10")
 - W2-04-D --- WATER - TXDOT (4")
 - W3-2.5-D --- WATER - PRIVATE (2.5")
 - W4-04-D --- WATER - WESTERN EQUIPMENT (4")
 - WW1-01-D --- SANITARY SEWER - CITY OF PAMPA
 - WW2-03-D --- SANITARY SEWER - WESTERN EQUIPMENT (3")
 - SD-01-D --- STORM - CITY OF PAMPA
 - UNK --- UNKNOWN
- OVERHEAD
- OHT --- OVERHEAD ELECTRIC TRANSMISSION - XCEL/SOUTHWESTERN PUBLIC SERVICE CO
 - OE1 --- OVERHEAD ELECTRIC - XCEL ENERGY-SOUTHWESTERN PUBLIC SERVICE CO
 - OE1/FOC1/T1/C1 --- OVERHEAD ELEC/FOC/TEL/CATV - XCEL/AT&T/AT&T/CABLE ONE
 - OE1/FOC1 --- OVERHEAD ELEC/FOC/TEL - XCEL/AT&T
 - OE1/FOC1/T1 --- OVERHEAD ELEC/FOC/TEL - XCEL/AT&T/AT&T
 - OE1/T1 --- OVERHEAD ELEC/TEL - XCEL ENERGY/AT&T
 - OE1/T1/T1/C1 --- OVERHEAD ELEC/TEL/TEL/CATV/CATV - XCEL/AT&T/AT&T/CABLE ONE/CABLE ONE
 - OE1/T1/T1/C1 --- OVERHEAD ELEC/TEL/TEL/CATV - XCEL/AT&T/AT&T/CABLE ONE
 - OE1/T1/C1 --- OVERHEAD ELEC/TEL/CATV - XCEL/AT&T/CABLE ONE
 - OE1/C1 --- OVERHEAD ELEC/CATV - XCEL ENERGY/CABLE ONE
 - OE1/C1 --- OVERHEAD ELEC/CATV - XCEL ENERGY/CABLE ONE
 - OFOC1 --- OVERHEAD FOC - AT&T
 - OT1 --- OVERHEAD TEL - AT&T
 - OFOC1/T1/C1 --- OVERHEAD TEL/FOC/CATV - AT&T/AT&T/CABLE ONE
 - OT1/C1 --- OVERHEAD TEL/CATV - AT&T/CABLE ONE
 - OC1 --- OVERHEAD CATV - CABLE ONE

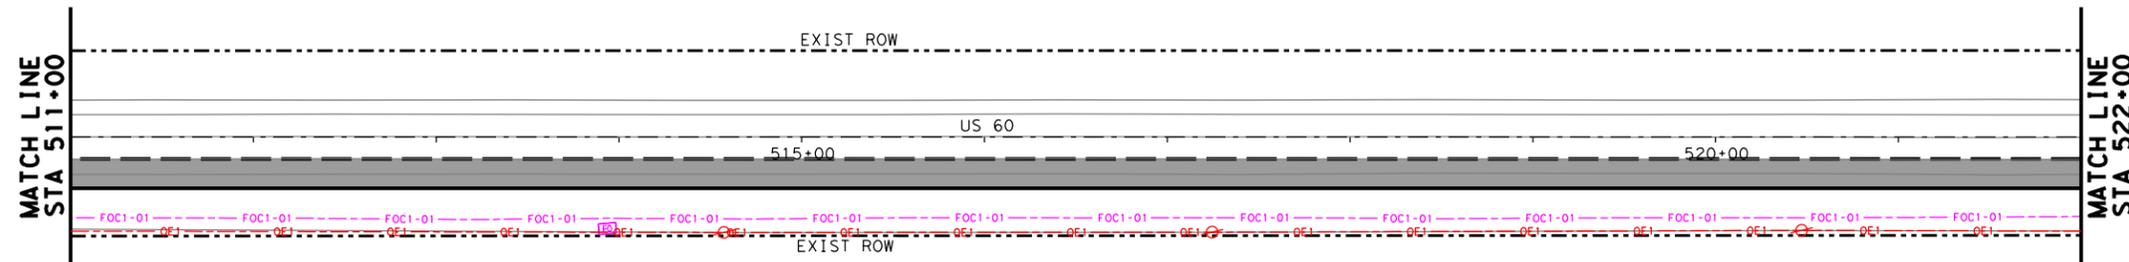

SUE RESEARCH ONLY PERFORMED ON SIDE WITH PROPOSED US 60 ROAD WIDENING.

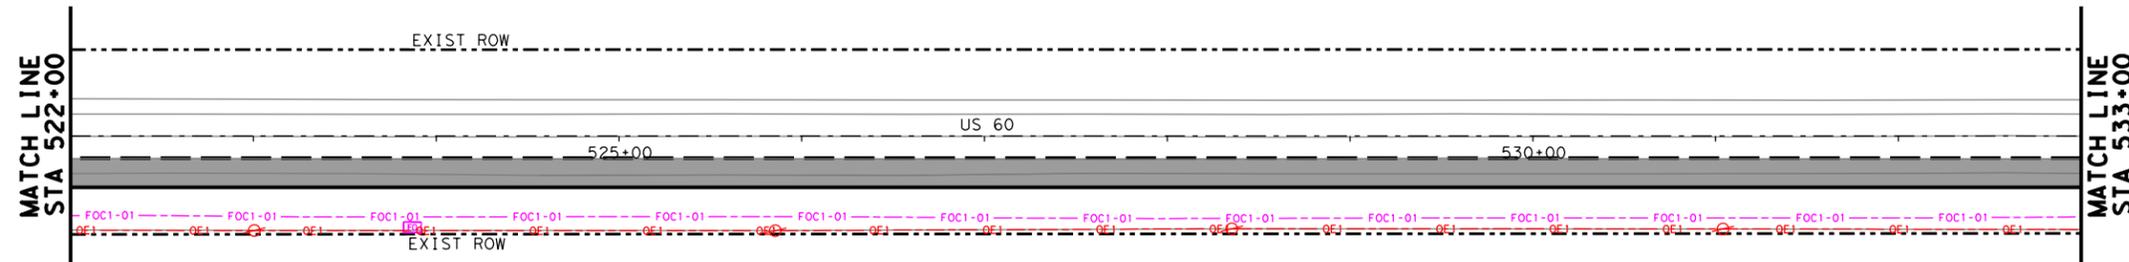

SUE RESEARCH ONLY PERFORMED ON SIDE WITH PROPOSED US 60 ROAD WIDENING.



REV. NO.	DATE	DESCRIPTION	BY



CobbFendley 13430 Northwest Freeway, Ste. 1100
Houston, Texas 77040
713.462.3242
www.cobbhendley.com



US 60
EXISTING UTILITY PLANS
STA 511+00 TO STA 533+00
SHEET 22 OF 36



FED. RD. DIV. NO.	STATE	PROJECT NO.	HIGHWAY NO.
6	TEXAS	SEE TITLE SHEET	US 60
STATE DISTRICT	COUNTY	CONTROL NO.	SECTION NO.
AMA	GRAY	0619	07
		JOB NO.	SHEET NO.
		053, ETC	160

NOTES:

- THE EXISTENCE AND LOCATION OF UTILITIES INDICATED ON THE PLANS ARE TAKEN FROM FIELD INVESTIGATION, THE BEST RECORDS AVAILABLE, AND ARE APPROXIMATED. THE CONTRACTOR SHALL LOCATE ALL UTILITIES (PUBLIC OR PRIVATE, SHOWN HERE OR NOT SHOWN) BOTH VERTICALLY AND HORIZONTALLY PRIOR TO COMMENCING WORK, WHETHER UTILITIES ARE ANTICIPATED TO BE IN DIRECT CONFLICT WITH PROPOSED WORK ACTIVITIES OR NOT. THE CONTRACTOR IS FULLY RESPONSIBLE FOR ANY DAMAGES CAUSED BY THE FAILURE TO LOCATE, PRESERVE, OR PROTECT THESE UTILITIES.
- ALL WORK ACTIVITIES (INCLUDING BUT NOT LIMITED TO CONSTRUCTING DETOURS, CULVERT EXTENSION AND REPLACEMENTS, EXCAVATION, DITCH GRADING, ETC.) SHALL NOT COMMENCE UNTIL ALL UTILITIES, ESPECIALLY UTILITIES WITHIN EXISTING ROW AND PARALLEL TO US 60, ARE IDENTIFIED. IF CONFLICTS WITH PROPOSED CONSTRUCTION OR WORK ACTIVITIES ARE IDENTIFIED, CONTRACTOR IS TO CEASE WORK IN THE LOCATION OF THE CONFLICT IMMEDIATELY.

4/12/2021 F:\P\J\ref\2019\1004_T\DOT_5x5_PSB\US60_US60-UST\N\506-SUE-02-Sheet\US60-SUE-22.dgn 9:46:06 AM


4/12/2021 9:46:07 AM F:\P\proj\2019\1004_TxDOT_5x5_PSS&E\03_US60_Amrt\10\ENG\500\UST\N\506-SUE\02-Sheet\US60-SUE-23.dgn

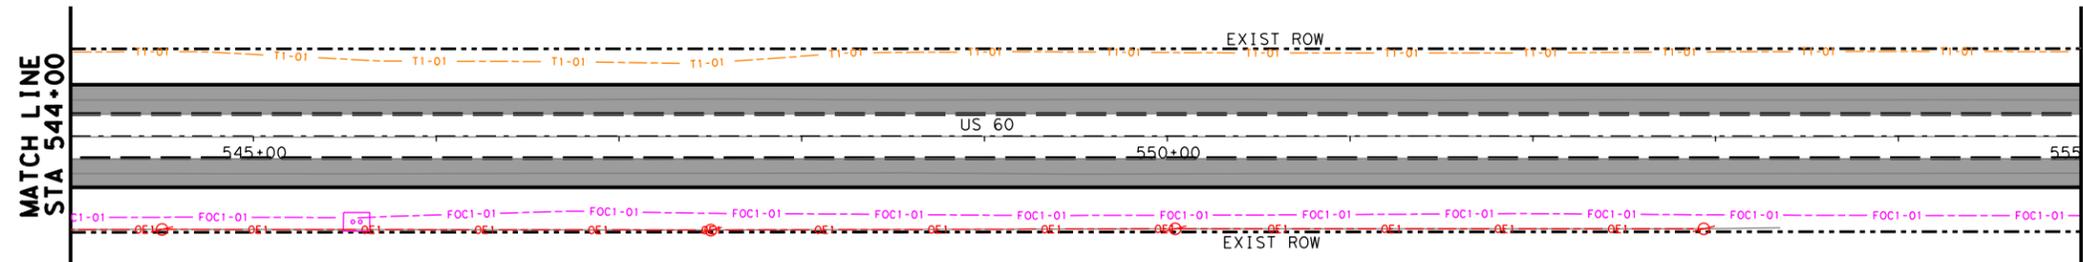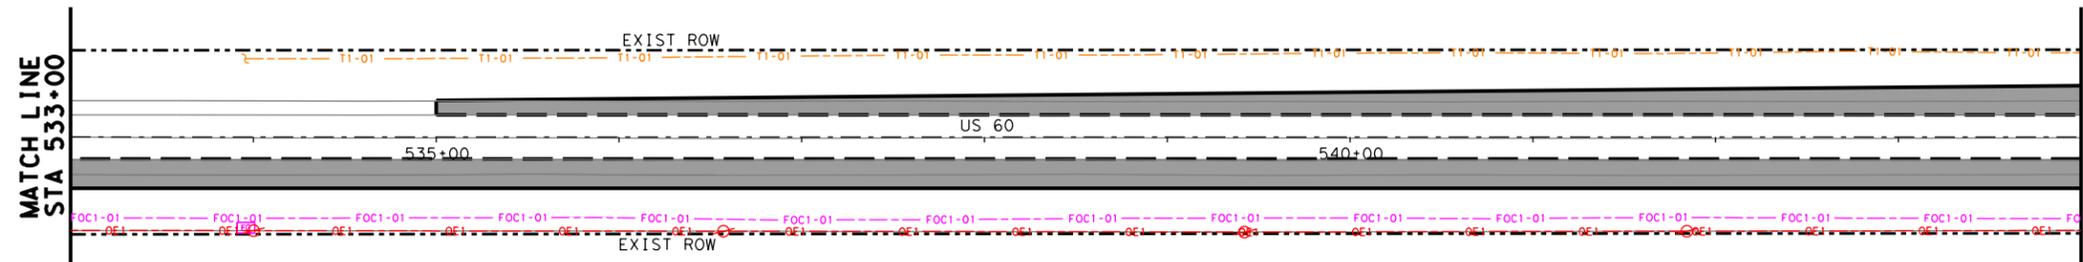

- LEGEND**
- ⊗ TELEPHONE POLE
 - ⊗ POWER POLE
 - ⊞ ELECTRIC PULLBOX
 - ⊞ ELECTRIC METER
 - ⊞ ELECTRIC SWITCH
 - ⊞ ELECTRIC STREET LIGHT
 - ⊞ ELECTRIC LANDSCAPE LIGHT
 - ⊞ ELECTRIC TRAFFIC SIGNAL
 - ⊞ ELECTRIC TRAFFIC SWITCH BOX
 - ⊞ ELECTRIC CABINET
 - ⊞ ELECTRIC MARKER
 - ⊞ TELEPHONE PEDESTAL
 - ⊞ TELEPHONE MANHOLE
 - ⊞ TELEPHONE MARKER
 - ⊞ VIDEO-READY ACCESS DEVICE
 - ⊞ FIBER OPTIC PULLBOX
 - ⊞ FIBER OPTIC MARKER
 - ⊞ FIBER OPTIC TEST STATION
 - ⊞ GAS METER
 - ⊞ GAS MARKER
 - ⊞ GAS REGULATOR
 - ⊞ GAS TEST STATION
 - ⊞ GAS VALVE
 - ⊞ GAS VENT
 - ⊞ WATER MANHOLE
 - ⊞ WATER MARKER
 - ⊞ WATER TEST STATION
 - ⊞ WATER VALVE
- QL LEVEL B**
- E1-01 --- ELECTRIC-XCEL/SOUTHWEST PUBLIC SERVICE.CO
 - E3-01 --- ELECTRIC - TXDOT
 - FOC1-01 --- FIBER OPTIC - AT&T
 - FOC2-01 --- FIBER OPTIC - DOBSON FIBER CO
 - T1-01 --- TELEPHONE - AT&T
 - C1-01 --- CABLE TV - CABLE ONE
 - G1-01 --- GAS - ATMOS ENERGY
 - G1-02 --- GAS - ATMOS ENERGY (2")
 - G3-01 --- GAS - UNKNOWN
 - G4-01 --- GAS - AMARILLO NATURAL GAS
 - W1-01 --- WATER - CITY OF PAMPA
 - W1-06 --- WATER - CITY OF PAMPA (6")
 - W1-10 --- WATER - CITY OF PAMPA (10")
 - WW1-01 --- SANITARY SEWER - CITY OF PAMPA
 - SD-01 --- STORM - CITY OF PAMPA
 - UNK --- UNKNOWN
 - QL LEVEL D --- ELECTRIC-XCEL/SOUTHWEST PUBLIC SERVICE.CO
 - E1-01-D --- ELECTRIC - TXDOT
 - FOC1-01-D --- FIBER OPTIC - AT&T
 - T1-01-D --- TELEPHONE - AT&T
 - C1-01-D --- CABLE TV - CABLE ONE
 - G1-01-D --- GAS - ATMOS ENERGY
 - G2-01-D --- GAS - WEST TEXAS GAS
 - G2-03-D --- GAS - WEST TEXAS GAS (3")
 - G3-01-D --- GAS - UNKNOWN
 - W1-01-D --- WATER - CITY OF PAMPA (UNKNOWN SIZE)
 - W1-02-D --- WATER - CITY OF PAMPA (2")
 - W1-06-D --- WATER - CITY OF PAMPA (6")
 - W1-10-D --- WATER - CITY OF PAMPA (10")
 - W2-04-D --- WATER - TXDOT (4")
 - W3-2.5-D --- WATER - PRIVATE (2.5")
 - W4-04-D --- WATER - WESTERN EQUIPMENT (4")
 - WW1-01-D --- SANITARY SEWER - CITY OF PAMPA
 - WW2-03-D --- SANITARY SEWER - WESTERN EQUIPMENT (3")
 - SD-01-D --- STORM - CITY OF PAMPA
 - UNK --- UNKNOWN
- OVERHEAD**
- OHT --- OVERHEAD ELECTRIC TRANSMISSION - XCEL/SOUTHWESTERN PUBLIC SERVICE CO
 - OE1 --- OVERHEAD ELECTRIC - XCEL ENERGY-SOUTHWESTERN PUBLIC SERVICE CO
 - OE1/FOC1/T1/C1 --- OVERHEAD ELEC/FOC/TEL/CATV - XCEL/AT&T/AT&T/CABLE ONE
 - OE1/FOC1 --- OVERHEAD ELEC/FOC/TEL - XCEL/AT&T
 - OE1/FOC1/T1 --- OVERHEAD ELEC/FOC/TEL - XCEL/AT&T/AT&T
 - OE1/T1 --- OVERHEAD ELEC/TEL - XCEL ENERGY/AT&T
 - OE1/T1/T1/C1 --- OVERHEAD ELEC/TEL/CATV/CATV - XCEL/AT&T/AT&T/CABLE ONE/CABLE ONE
 - OE1/T1/T1/C1 --- OVERHEAD ELEC/TEL/TEL/CATV - XCEL/AT&T/AT&T/CABLE ONE
 - OE1/T1/C1 --- OVERHEAD ELEC/TEL/CATV - XCEL/AT&T/CABLE ONE
 - OE1/C1 --- OVERHEAD ELEC/CATV - XCEL ENERGY/CABLE ONE
 - OE1/C1 --- OVERHEAD ELEC/CATV - XCEL ENERGY/CABLE ONE
 - OFOC1 --- OVERHEAD FOC - AT&T
 - OT1 --- OVERHEAD TEL - AT&T
 - OFOC1/T1/C1 --- OVERHEAD TEL/FOC/CATV - AT&T/AT&T/CABLE ONE
 - OT1/C1 --- OVERHEAD TEL/CATV - AT&T/CABLE ONE
 - OC1 --- OVERHEAD CATV - CABLE ONE



REV. NO.	DATE	DESCRIPTION	BY

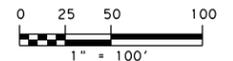

CobbFendley
 13430 Northwest Freeway, Ste. 1100
 Houston, Texas 77040
 713.462.3242
 www.cobbendley.com



**US 60
 EXISTING UTILITY PLANS
 STA 533+00 TO STA 555+00**



FED. RD. DIV. NO.	STATE	PROJECT NO.	HIGHWAY NO.
6	TEXAS	SEE TITLE SHEET	US 60
STATE DISTRICT	COUNTY	CONTROL NO.	SECTION NO.
AMA	GRAY	0619	07
		JOB NO.	SHEET NO.
		053, ETC	161

NOTES:

- THE EXISTENCE AND LOCATION OF UTILITIES INDICATED ON THE PLANS ARE TAKEN FROM FIELD INVESTIGATION, THE BEST RECORDS AVAILABLE, AND ARE APPROXIMATED. THE CONTRACTOR SHALL LOCATE ALL UTILITIES (PUBLIC OR PRIVATE, SHOWN HERE OR NOT SHOWN) BOTH VERTICALLY AND HORIZONTALLY PRIOR TO COMMENCING WORK, WHETHER UTILITIES ARE ANTICIPATED TO BE IN DIRECT CONFLICT WITH PROPOSED WORK ACTIVITIES OR NOT. THE CONTRACTOR IS FULLY RESPONSIBLE FOR ANY DAMAGES CAUSED BY THE FAILURE TO LOCATE, PRESERVE, OR PROTECT THESE UTILITIES.
- ALL WORK ACTIVITIES (INCLUDING BUT NOT LIMITED TO CONSTRUCTING DETOURS, CULVERT EXTENSION AND REPLACEMENTS, EXCAVATION, DITCH GRADING, ETC.) SHALL NOT COMMENCE UNTIL ALL UTILITIES, ESPECIALLY UTILITIES WITHIN EXISTING ROW AND PARALLEL TO US 60, ARE IDENTIFIED. IF CONFLICTS WITH PROPOSED CONSTRUCTION OR WORK ACTIVITIES ARE IDENTIFIED, CONTRACTOR IS TO CEASE WORK IN THE LOCATION OF THE CONFLICT IMMEDIATELY.

US60-SUE-23.dgn

4/12/2021 9:46:07 AM F:\P\proj\2019\1004_TxDOT_5x5_PSS&E\03_US60_Amtr\116\ENG\500\UST\N\506-SUE\02-Sheet\5-US60-SUE-24.dgn

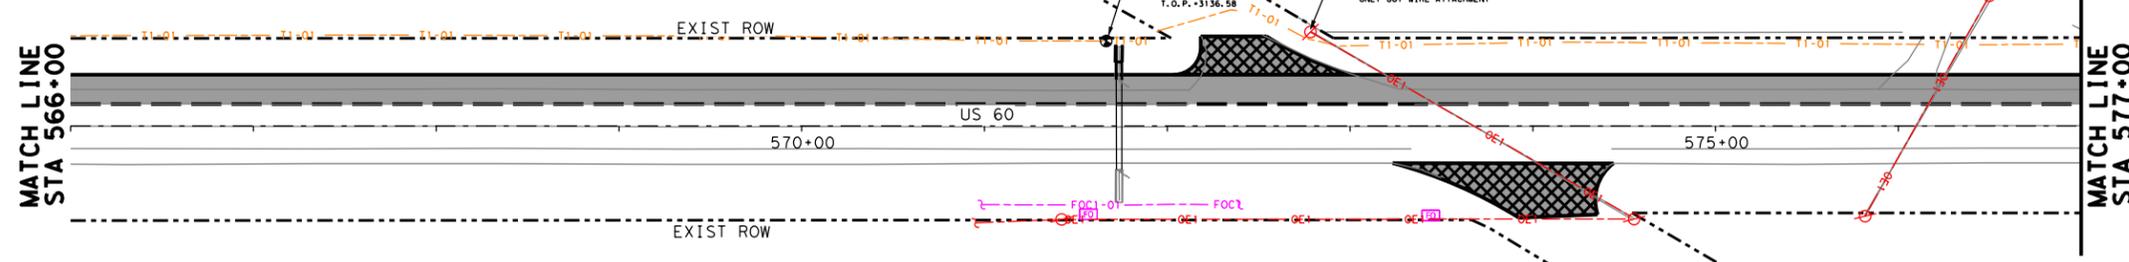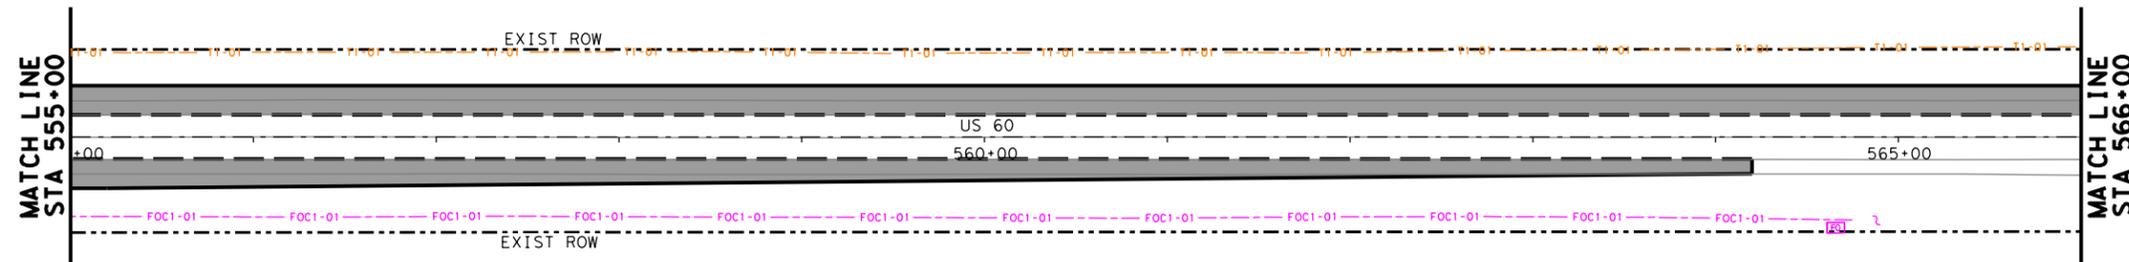


LEGEND

⊗ TELEPHONE POLE	⊗ POWER POLE	⊗ ELECTRIC PULLBOX	⊗ ELECTRIC METER	⊗ ELECTRIC SWITCH	⊗ ELECTRIC STREET LIGHT	⊗ ELECTRIC LANDSCAPE LIGHT	⊗ ELECTRIC TRAFFIC SIGNAL	⊗ ELECTRIC TRAFFIC SWITCH BOX	⊗ ELECTRIC CABINET	⊗ ELECTRIC MARKER	⊗ TELEPHONE PEDESTAL	⊗ TELEPHONE MANHOLE	⊗ TELEPHONE MARKER	⊗ VIDEO-READY ACCESS DEVICE	⊗ FIBER OPTIC PULLBOX	⊗ FIBER OPTIC MARKER	⊗ FIBER OPTIC TEST STATION	⊗ GAS METER	⊗ GAS MARKER	⊗ GAS REGULATOR	⊗ GAS TEST STATION	⊗ GAS VALVE	⊗ GAS VENT	⊗ WATER MANHOLE	⊗ WATER MARKER	⊗ WATER TEST STATION	⊗ WATER VALVE												
--- E1-01 ---	--- E3-01 ---	--- FOC1-01 ---	--- T1-01 ---	--- C1-01 ---	--- G1-01 ---	--- G1-02 ---	--- G3-01 ---	--- G4-01 ---	--- W1-01 ---	--- W1-06 ---	--- W1-10 ---	--- WW1-01 ---	--- SD-01 ---	--- UNK ---	--- E1-01-D ---	--- E3-01-D ---	--- FOC1-01-D ---	--- T1-01-D ---	--- C1-01-D ---	--- G1-01-D ---	--- G2-01-D ---	--- G2-03-D ---	--- G3-01-D ---	--- W1-01-D ---	--- W1-02-D ---	--- W1-06-D ---	--- W1-10-D ---	--- W2-04-D ---	--- W3-2.5-D ---	--- W4-04-D ---	--- WW1-01-D ---	--- WW2-03-D ---	--- SD-01-D ---	--- UNK ---					
--- OE1 ---	--- OE1/FOC1 ---	--- OE1/FOC1 ---	--- OE1/FOC1/T1 ---	--- OE1/T1 ---	--- OE1/T1/C1 ---	--- OE1/T1/T1/C1 ---	--- OE1/T1/C1 ---	--- OE1/C1 ---	--- OFOC1 ---	--- OT1 ---	--- OFOC1/T1/C1 ---	--- OT1/C1 ---	--- OC1 ---	--- OE1 ---	--- OE1/FOC1 ---	--- OE1/FOC1/T1 ---	--- OE1/T1 ---	--- OE1/T1/C1 ---	--- OE1/T1/T1/C1 ---	--- OE1/T1/C1 ---	--- OE1/C1 ---	--- OFOC1 ---	--- OT1 ---	--- OFOC1/T1/C1 ---	--- OT1/C1 ---	--- OC1 ---	--- OE1 ---	--- OE1/FOC1 ---	--- OE1/FOC1/T1 ---	--- OE1/T1 ---	--- OE1/T1/C1 ---	--- OE1/T1/T1/C1 ---	--- OE1/T1/C1 ---	--- OE1/C1 ---	--- OFOC1 ---	--- OT1 ---	--- OFOC1/T1/C1 ---	--- OT1/C1 ---	--- OC1 ---



J.L.S.H.A.
4/2/2021

REV. NO.	DATE	DESCRIPTION	BY

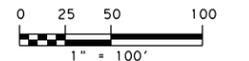

CobbFendley
 13430 Northwest Freeway, Ste. 1100
 Houston, Texas 77040
 713.462.3242
 www.cobbhendley.com




US 60
 EXISTING UTILITY PLANS
 STA 555+00 TO STA 577+00
 SHEET 24 OF 36


FED. RD. DIV. NO.	STATE	PROJECT NO.	HIGHWAY NO.
6	TEXAS	SEE TITLE SHEET	US 60
STATE DISTRICT	COUNTY	CONTROL NO.	SECTION NO.
AMA	GRAY	0619	07
		JOB NO.	SHEET NO.
		053, ETC	162

NOTES:
 1. THE EXISTENCE AND LOCATION OF UTILITIES INDICATED ON THE PLANS ARE TAKEN FROM FIELD INVESTIGATION, THE BEST RECORDS AVAILABLE, AND ARE APPROXIMATED. THE CONTRACTOR SHALL LOCATE ALL UTILITIES (PUBLIC OR PRIVATE, SHOWN HERE OR NOT SHOWN) BOTH VERTICALLY AND HORIZONTALLY PRIOR TO COMMENCING WORK, WHETHER UTILITIES ARE ANTICIPATED TO BE IN DIRECT CONFLICT WITH PROPOSED WORK ACTIVITIES OR NOT. THE CONTRACTOR IS FULLY RESPONSIBLE FOR ANY DAMAGES CAUSED BY THE FAILURE TO LOCATE, PRESERVE, OR PROTECT THESE UTILITIES.
 2. ALL WORK ACTIVITIES (INCLUDING BUT NOT LIMITED TO CONSTRUCTING DETOURS, CULVERT EXTENSION AND REPLACEMENTS, EXCAVATION, DITCH GRADING, ETC.) SHALL NOT COMMENCE UNTIL ALL UTILITIES, ESPECIALLY UTILITIES WITHIN EXISTING ROW AND PARALLEL TO US 60, ARE IDENTIFIED. IF CONFLICTS WITH PROPOSED CONSTRUCTION OR WORK ACTIVITIES ARE IDENTIFIED, CONTRACTOR IS TO CEASE WORK IN THE LOCATION OF THE CONFLICT IMMEDIATELY.

- LEGEND
- ⊗ TELEPHONE POLE
 - ⊗ POWER POLE
 - ⊗ ELECTRIC PULLBOX
 - ⊗ ELECTRIC METER
 - ⊗ ELECTRIC SWITCH
 - ⊗ ELECTRIC STREET LIGHT
 - ⊗ ELECTRIC LANDSCAPE LIGHT
 - ⊗ ELECTRIC TRAFFIC SIGNAL
 - ⊗ ELECTRIC TRAFFIC SWITCH BOX
 - ⊗ ELECTRIC CABINET
 - ⊗ ELECTRIC MARKER
 - ⊗ TELEPHONE PEDESTAL
 - ⊗ TELEPHONE MANHOLE
 - ⊗ TELEPHONE MARKER
 - ⊗ VIDEO-READY ACCESS DEVICE
 - ⊗ FIBER OPTIC PULLBOX
 - ⊗ FIBER OPTIC MARKER
 - ⊗ FIBER OPTIC TEST STATION
 - ⊗ GAS METER
 - ⊗ GAS MARKER
 - ⊗ GAS REGULATOR
 - ⊗ GAS TEST STATION
 - ⊗ GAS VALVE
 - ⊗ GAS VENT
 - ⊗ WATER MANHOLE
 - ⊗ WATER MARKER
 - ⊗ WATER VALVE
- QL LEVEL B
- E1-01 ELECTRIC-XCEL/SOUTHWEST PUBLIC SERVICE.CO
 - E3-01 ELECTRIC - TXDOT
 - FOC1-01 FIBER OPTIC - AT&T
 - FOC2-01 FIBER OPTIC - DOBSON FIBER CO
 - T1-01 TELEPHONE - AT&T
 - C1-01 CABLE TV - CABLE ONE
 - G1-01 GAS - ATMOS ENERGY
 - G1-02 GAS - ATMOS ENERGY (2")
 - G3-01 GAS - UNKNOWN
 - G4-01 GAS - AMARILLO NATURAL GAS
 - W1-01 WATER - CITY OF PAMPA
 - W1-06 WATER - CITY OF PAMPA (6")
 - W1-10 WATER - CITY OF PAMPA (10")
 - WW1-01 SANITARY SEWER - CITY OF PAMPA
 - SD-01 STORM - CITY OF PAMPA
 - UNK UNKNOWN
 - QL LEVEL D
 - E1-01-D ELECTRIC-XCEL/SOUTHWEST PUBLIC SERVICE.CO
 - E3-01-D ELECTRIC - TXDOT
 - FOC1-01-D FIBER OPTIC - AT&T
 - T1-01-D TELEPHONE - AT&T
 - C1-01-D CABLE TV - CABLE ONE
 - G1-01-D GAS - ATMOS ENERGY
 - G2-01-D GAS - WEST TEXAS GAS
 - G2-03-D GAS - WEST TEXAS GAS (3")
 - G3-01-D GAS - UNKNOWN
 - W1-01-D WATER - CITY OF PAMPA (UNKNOWN SIZE)
 - W1-02-D WATER - CITY OF PAMPA (2")
 - W1-06-D WATER - CITY OF PAMPA (6")
 - W1-10-D WATER - CITY OF PAMPA (10")
 - W2-04-D WATER - TXDOT (4")
 - W3-2.5-D WATER - PRIVATE (2.5")
 - W4-04-D WATER - WESTERN EQUIPMENT (4")
 - WW1-01-D SANITARY SEWER - CITY OF PAMPA
 - WW2-03-D SANITARY SEWER - WESTERN EQUIPMENT (3")
 - SD-01-D STORM - CITY OF PAMPA
 - UNK UNKNOWN
- OVERHEAD
- OE1 OVERHEAD ELECTRIC TRANSMISSION - XCEL/SOUTHWESTERN PUBLIC SERVICE CO
 - OE1 OVERHEAD ELECTRIC - XCEL ENERGY-SOUTHWESTERN PUBLIC SERVICE CO
 - OE1/FOC1/T1/C1 OVERHEAD ELEC/FOC/TEL/CATV - XCEL/AT&T/AT&T/CABLE ONE
 - OE1/FOC1 OVERHEAD ELEC/FOC/TEL - XCEL/AT&T
 - OE1/FOC1/T1 OVERHEAD ELEC/FOC/TEL - XCEL/AT&T/AT&T
 - OE1/T1 OVERHEAD ELEC/TEL - XCEL ENERGY/AT&T
 - OE1/T1/T1/C1/C1 OVERHEAD ELEC/TEL/TEL/CATV/CATV - XCEL/AT&T/AT&T/CABLE ONE/CABLE ONE
 - OE1/T1/T1/C1 OVERHEAD ELEC/TEL/TEL/CATV - XCEL/AT&T/AT&T/CABLE ONE
 - OE1/T1/C1 OVERHEAD ELEC/TEL/CATV - XCEL/AT&T/CABLE ONE
 - OE1/C1 OVERHEAD ELEC/CATV - XCEL ENERGY/CABLE ONE
 - OE1/C1 OVERHEAD ELEC/CATV - XCEL ENERGY/CABLE ONE
 - FOC1 OVERHEAD FOC - AT&T
 - OT1 OVERHEAD TEL - AT&T
 - FOC1/T1/C1 OVERHEAD TEL/FOC/CATV - AT&T/AT&T/CABLE ONE
 - OT1/C1 OVERHEAD TEL/CATV - AT&T/CABLE ONE
 - OC1 OVERHEAD CATV - CABLE ONE

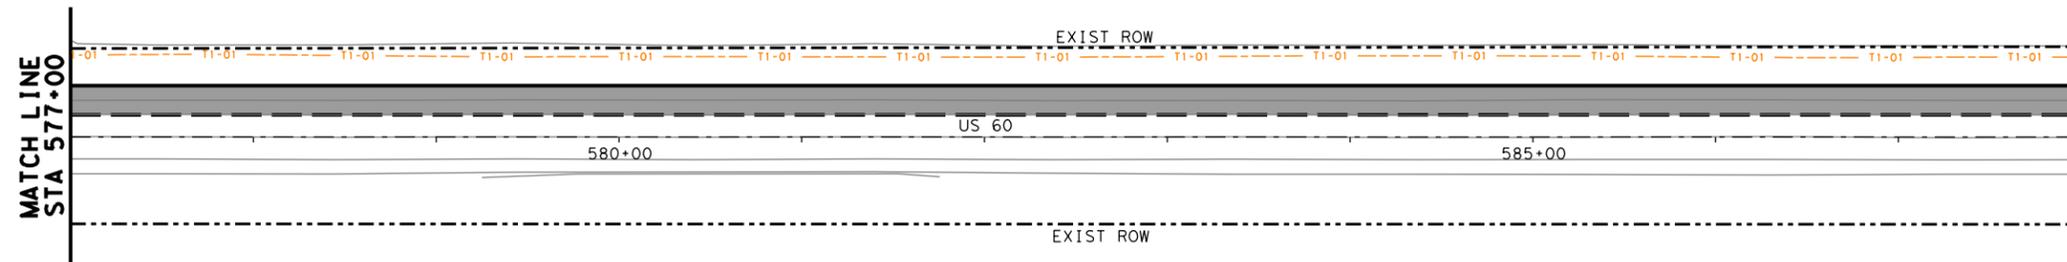

SUE RESEARCH ONLY PERFORMED ON SIDE WITH PROPOSED US 60 ROAD WIDENING.

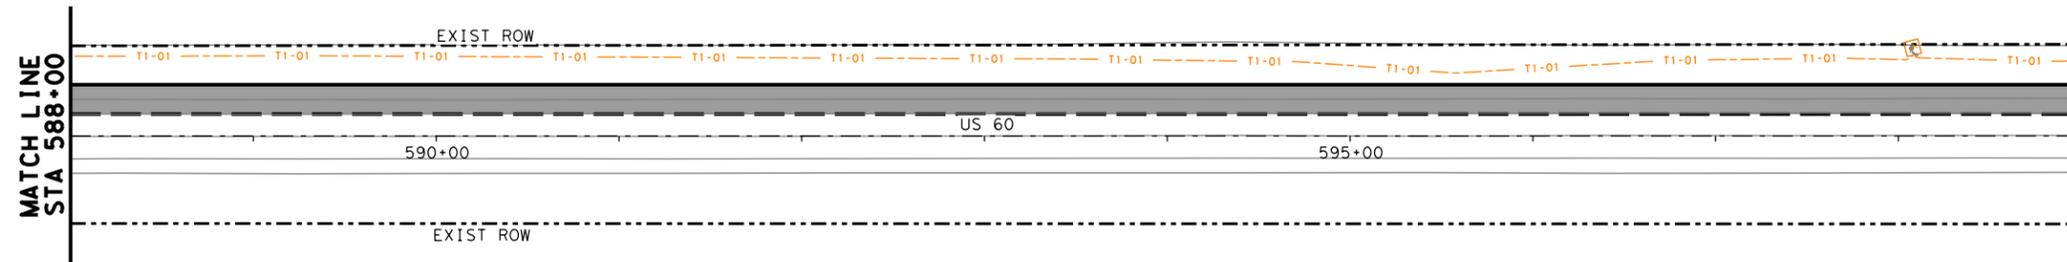


SUE RESEARCH ONLY PERFORMED ON SIDE WITH PROPOSED US 60 ROAD WIDENING.



T.E. Hunt
4/2/2021

REV. NO.	DATE	DESCRIPTION	BY

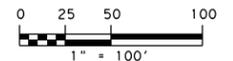

CobbFendley
 TBPE Firm Registration No. 274
 TBPLS Firm Registration No. 100467
 13430 Northwest Freeway, Ste. 1100
 Houston, Texas 77040
 713.462.3242
 www.cobbhendley.com



US 60
EXISTING UTILITY PLANS
STA 577+00 TO STA 599+00
SHEET 25 OF 36


FED. RD. DIV. NO.	STATE	PROJECT NO.	HIGHWAY NO.
6	TEXAS	SEE TITLE SHEET	US 60
STATE DISTRICT	COUNTY	CONTROL NO.	SECTION NO.
AMA	GRAY	0619	07
		JOB NO.	SHEET NO.
		053, ETC	163

NOTES:


- THE EXISTENCE AND LOCATION OF UTILITIES INDICATED ON THE PLANS ARE TAKEN FROM FIELD INVESTIGATION, THE BEST RECORDS AVAILABLE, AND ARE APPROXIMATED. THE CONTRACTOR SHALL LOCATE ALL UTILITIES (PUBLIC OR PRIVATE, SHOWN HERE OR NOT SHOWN) BOTH VERTICALLY AND HORIZONTALLY PRIOR TO COMMENCING WORK, WHETHER UTILITIES ARE ANTICIPATED TO BE IN DIRECT CONFLICT WITH PROPOSED WORK ACTIVITIES OR NOT. THE CONTRACTOR IS FULLY RESPONSIBLE FOR ANY DAMAGES CAUSED BY THE FAILURE TO LOCATE, PRESERVE, OR PROTECT THESE UTILITIES.
- ALL WORK ACTIVITIES (INCLUDING BUT NOT LIMITED TO CONSTRUCTING DETOURS, CULVERT EXTENSION AND REPLACEMENTS, EXCAVATION, DITCH GRADING, ETC.) SHALL NOT COMMENCE UNTIL ALL UTILITIES, ESPECIALLY UTILITIES WITHIN EXISTING ROW AND PARALLEL TO US 60, ARE IDENTIFIED. IF CONFLICTS WITH PROPOSED CONSTRUCTION OR WORK ACTIVITIES ARE IDENTIFIED, CONTRACTOR IS TO CEASE WORK IN THE LOCATION OF THE CONFLICT IMMEDIATELY.

4/12/2021
 9:46:08 AM
 F:\P\proj\2019\1004_TxDOT_5x5_PSS&E\03_US60_Amarillo\16\16\500-UST\N\506-SUE\02-Sheet\US60-SUE-25.dgn

- LEGEND
- ⊗ TELEPHONE POLE
 - ⊗ POWER POLE
 - ⊞ ELECTRIC PULLBOX
 - ⊞ ELECTRIC METER
 - ⊞ ELECTRIC SWITCH
 - ⊞ ELECTRIC STREET LIGHT
 - ⊞ ELECTRIC LANDSCAPE LIGHT
 - ⊞ ELECTRIC TRAFFIC SIGNAL
 - ⊞ ELECTRIC TRAFFIC SWITCH BOX
 - ⊞ ELECTRIC CABINET
 - ⊞ ELECTRIC MARKER
 - ⊞ TELEPHONE PEDESTAL
 - ⊞ TELEPHONE MANHOLE
 - ⊞ TELEPHONE MARKER
 - ⊞ VIDEO-READY ACCESS DEVICE
 - ⊞ FIBER OPTIC PULLBOX
 - ⊞ FIBER OPTIC MARKER
 - ⊞ FIBER OPTIC TEST STATION
 - ⊞ GAS METER
 - ⊞ GAS MARKER
 - ⊞ GAS REGULATOR
 - ⊞ GAS TEST STATION
 - ⊞ GAS VALVE
 - ⊞ GAS VENT
 - ⊞ WATER MANHOLE
 - ⊞ WATER MARKER
 - ⊞ WATER TEST STATION
 - ⊞ WATER VALVE
- QL LEVEL B
- E1-01 --- ELECTRIC-XCEL/SOUTHWEST PUBLIC SERVICE.CO
 - E3-01 --- ELECTRIC - TXDOT
 - FOC1-01 --- FIBER OPTIC - AT&T
 - FOC2-01 --- FIBER OPTIC - DOBSON FIBER CO
 - T1-01 --- TELEPHONE - AT&T
 - C1-01 --- CABLE TV - CABLE ONE
 - G1-01 --- GAS - ATMOS ENERGY
 - G1-02 --- GAS - ATMOS ENERGY (2")
 - G3-01 --- GAS - UNKNOWN
 - G4-01 --- GAS - AMARILLO NATURAL GAS
 - W1-01 --- WATER - CITY OF PAMPA
 - W1-06 --- WATER - CITY OF PAMPA (6")
 - W1-10 --- WATER - CITY OF PAMPA (10")
 - WW1-01 --- SANITARY SEWER - CITY OF PAMPA
 - SD-01 --- STORM - CITY OF PAMPA
 - UNK --- UNKNOWN
 - QL LEVEL D
 - E1-01-D --- ELECTRIC-XCEL/SOUTHWEST PUBLIC SERVICE.CO
 - E3-01-D --- ELECTRIC - TXDOT
 - FOC1-01-D --- FIBER OPTIC - AT&T
 - T1-01-D --- TELEPHONE - AT&T
 - C1-01-D --- CABLE TV - CABLE ONE
 - G1-01-D --- GAS - ATMOS ENERGY
 - G2-01-D --- GAS - WEST TEXAS GAS
 - G2-03-D --- GAS - WEST TEXAS GAS (3")
 - G3-01-D --- GAS - UNKNOWN
 - W1-01-D --- WATER - CITY OF PAMPA (UNKNOWN SIZE)
 - W1-02-D --- WATER - CITY OF PAMPA (2")
 - W1-06-D --- WATER - CITY OF PAMPA (6")
 - W1-10-D --- WATER - CITY OF PAMPA (10")
 - W2-04-D --- WATER - TXDOT (4")
 - W3-2.5-D --- WATER - PRIVATE (2.5")
 - W4-04-D --- WATER - WESTERN EQUIPMENT (4")
 - WW1-01-D --- SANITARY SEWER - CITY OF PAMPA
 - WW2-03-D --- SANITARY SEWER - WESTERN EQUIPMENT (3")
 - SD-01-D --- STORM - CITY OF PAMPA
 - UNK --- UNKNOWN
- OVERHEAD
- OHT --- OVERHEAD ELECTRIC TRANSMISSION - XCEL/SOUTHWESTERN PUBLIC SERVICE CO
 - OE1 --- OVERHEAD ELECTRIC - XCEL ENERGY-SOUTHWESTERN PUBLIC SERVICE CO
 - OE1/FOC1/T1/C1 --- OVERHEAD ELEC/FOC/TEL/CATV - XCEL/AT&T/AT&T/CABLE ONE
 - OE1/FOC1 --- OVERHEAD ELEC/FOC/TEL - XCEL/AT&T
 - OE1/FOC1/T1 --- OVERHEAD ELEC/FOC/TEL - XCEL/AT&T/AT&T
 - OE1/T1 --- OVERHEAD ELEC/TEL - XCEL ENERGY/AT&T
 - OE1/T1/T1/C1 --- OVERHEAD ELEC/TEL/TEL/CATV/CATV - XCEL/AT&T/AT&T/CABLE ONE/CABLE ONE
 - OE1/T1/T1/C1 --- OVERHEAD ELEC/TEL/TEL/CATV - XCEL/AT&T/AT&T/CABLE ONE
 - OE1/T1/C1 --- OVERHEAD ELEC/TEL/CATV - XCEL/AT&T/CABLE ONE
 - OE1/C1 --- OVERHEAD ELEC/CATV - XCEL ENERGY/CABLE ONE
 - OE1/C1 --- OVERHEAD ELEC/CATV - XCEL ENERGY/CABLE ONE
 - OFOC1 --- OVERHEAD FOC - AT&T
 - OT1 --- OVERHEAD TEL - AT&T
 - OFOC1/T1/C1 --- OVERHEAD TEL/FOC/CATV - AT&T/AT&T/CABLE ONE
 - OT1/C1 --- OVERHEAD TEL/CATV - AT&T/CABLE ONE
 - OC1 --- OVERHEAD CATV - CABLE ONE

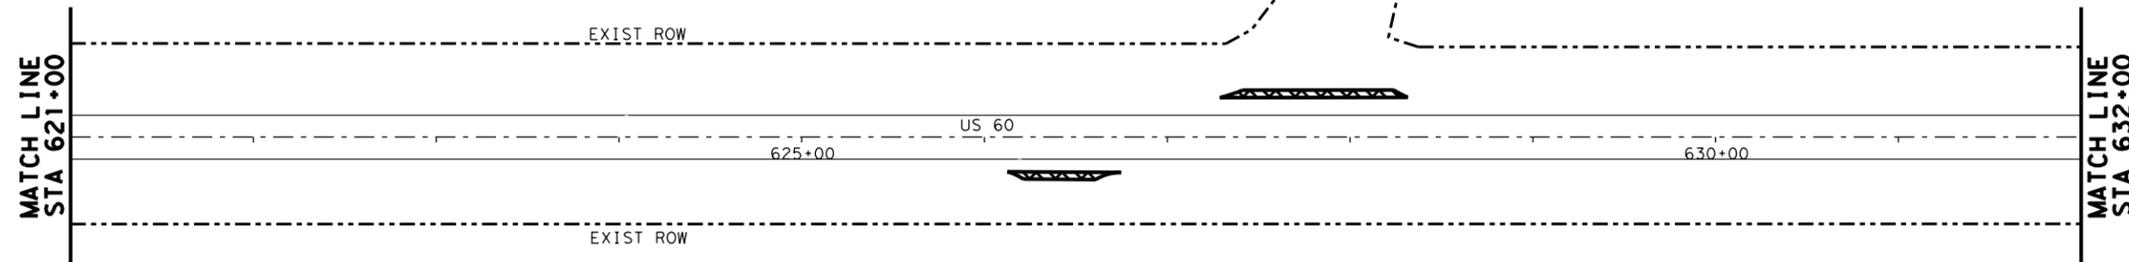

SUE RESEARCH NOT PERFORMED IN THIS AREA.
NO EXCAVATION WORK IS PLANNED IN THIS AREA.

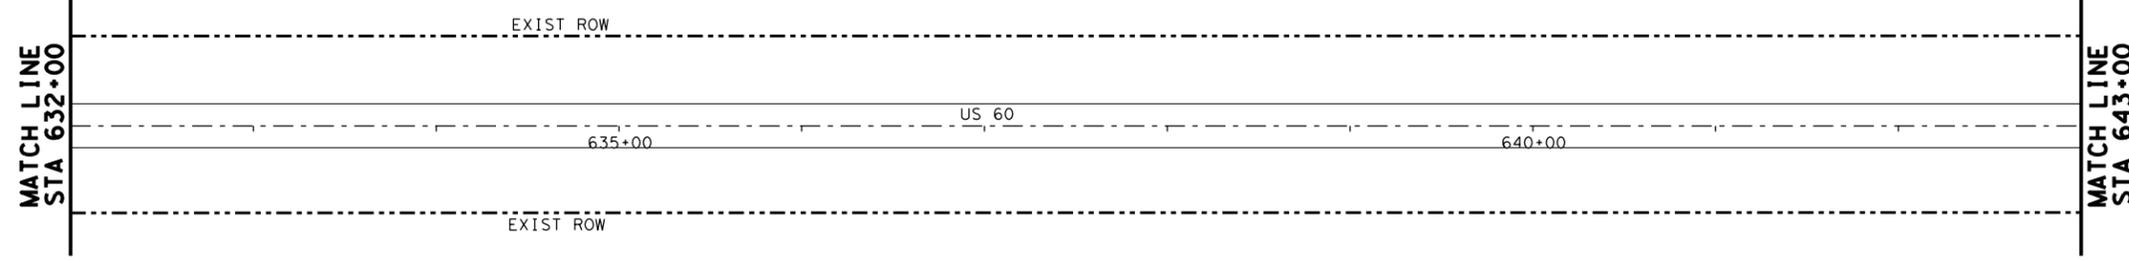


SUE RESEARCH NOT PERFORMED IN THIS AREA.
NO EXCAVATION WORK IS PLANNED IN THIS AREA.



T.E. Hunt
4/2/2021

REV. NO.	DATE	DESCRIPTION	BY

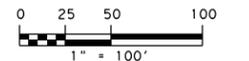

CobbFendley
 13430 Northwest Freeway, Ste. 1100
 Houston, Texas 77040
 713.462.3242
 www.cobbhendley.com



US 60
EXISTING UTILITY PLANS
STA 621+00 TO STA 643+00
SHEET 27 OF 36


FED. RD. DIV. NO.	STATE	PROJECT NO.	HIGHWAY NO.
6	TEXAS	SEE TITLE SHEET	US 60
STATE DISTRICT	COUNTY	CONTROL NO.	SECTION NO.
AMA	GRAY	0619	07
		JOB NO.	SHEET NO.
		053, ETC	165

4/12/2021
 F:\P\Proj\2019\1004_TxDOT_5x5_P&S\US60_SUE\02-Sheet\US60_SUE-27.dgn
 9:46:09 AM


NOTES:

- THE EXISTENCE AND LOCATION OF UTILITIES INDICATED ON THE PLANS ARE TAKEN FROM FIELD INVESTIGATION, THE BEST RECORDS AVAILABLE, AND ARE APPROXIMATED. THE CONTRACTOR SHALL LOCATE ALL UTILITIES (PUBLIC OR PRIVATE, SHOWN HERE OR NOT SHOWN) BOTH VERTICALLY AND HORIZONTALLY PRIOR TO COMMENCING WORK, WHETHER UTILITIES ARE ANTICIPATED TO BE IN DIRECT CONFLICT WITH PROPOSED WORK ACTIVITIES OR NOT. THE CONTRACTOR IS FULLY RESPONSIBLE FOR ANY DAMAGES CAUSED BY THE FAILURE TO LOCATE, PRESERVE, OR PROTECT THESE UTILITIES.
- ALL WORK ACTIVITIES (INCLUDING BUT NOT LIMITED TO CONSTRUCTING DETOURS, CULVERT EXTENSION AND REPLACEMENTS, EXCAVATION, DITCH GRADING, ETC.) SHALL NOT COMMENCE UNTIL ALL UTILITIES, ESPECIALLY UTILITIES WITHIN EXISTING ROW AND PARALLEL TO US 60, ARE IDENTIFIED. IF CONFLICTS WITH PROPOSED CONSTRUCTION OR WORK ACTIVITIES ARE IDENTIFIED, CONTRACTOR IS TO CEASE WORK IN THE LOCATION OF THE CONFLICT IMMEDIATELY.

- LEGEND
- ⊗ TELEPHONE POLE
 - ⊗ POWER POLE
 - ⊞ ELECTRIC PULLBOX
 - ⊞ ELECTRIC METER
 - ⊞ ELECTRIC SWITCH
 - ⊞ ELECTRIC STREET LIGHT
 - ⊞ ELECTRIC LANDSCAPE LIGHT
 - ⊞ ELECTRIC TRAFFIC SIGNAL
 - ⊞ ELECTRIC TRAFFIC SWITCH BOX
 - ⊞ ELECTRIC CABINET
 - ⊞ ELECTRIC MARKER
 - ⊞ TELEPHONE PEDESTAL
 - ⊞ TELEPHONE MANHOLE
 - ⊞ TELEPHONE MARKER
 - ⊞ VIDEO-READY ACCESS DEVICE
 - ⊞ FIBER OPTIC PULLBOX
 - ⊞ FIBER OPTIC MARKER
 - ⊞ FIBER OPTIC TEST STATION
 - ⊞ GAS METER
 - ⊞ GAS MARKER
 - ⊞ GAS REGULATOR
 - ⊞ GAS TEST STATION
 - ⊞ GAS VALVE
 - ⊞ GAS VENT
 - ⊞ WATER MANHOLE
 - ⊞ WATER MARKER
 - ⊞ WATER TEST STATION
 - ⊞ WATER VALVE
- QL LEVEL B
- E1-01 --- ELECTRIC-XCEL/SOUTHWEST PUBLIC SERVICE.CO
 - E3-01 --- ELECTRIC - TXDOT
 - FOC1-01 --- FIBER OPTIC - AT&T
 - FOC2-01 --- FIBER OPTIC - DOBSON FIBER CO
 - T1-01 --- TELEPHONE - AT&T
 - C1-01 --- CABLE TV - CABLE ONE
 - G1-01 --- GAS - ATMOS ENERGY
 - G1-02 --- GAS - ATMOS ENERGY (2")
 - G3-01 --- GAS - UNKNOWN
 - G4-01 --- GAS - AMARILLO NATURAL GAS
 - W1-01 --- WATER - CITY OF PAMPA
 - W1-06 --- WATER - CITY OF PAMPA (6")
 - W1-10 --- WATER - CITY OF PAMPA (10")
 - WW1-01 --- SANITARY SEWER - CITY OF PAMPA
 - SD-01 --- STORM - CITY OF PAMPA
 - UNK --- UNKNOWN
 - QL LEVEL D
 - E1-01-D --- ELECTRIC-XCEL/SOUTHWEST PUBLIC SERVICE.CO
 - E3-01-D --- ELECTRIC - TXDOT
 - FOC1-01-D --- FIBER OPTIC - AT&T
 - T1-01-D --- TELEPHONE - AT&T
 - C1-01-D --- CABLE TV - CABLE ONE
 - G1-01-D --- GAS - ATMOS ENERGY
 - G2-01-D --- GAS - WEST TEXAS GAS
 - G2-03-D --- GAS - WEST TEXAS GAS (3")
 - G3-01-D --- GAS - UNKNOWN
 - W1-01-D --- WATER - CITY OF PAMPA (UNKNOWN SIZE)
 - W1-02-D --- WATER - CITY OF PAMPA (2")
 - W1-06-D --- WATER - CITY OF PAMPA (6")
 - W1-10-D --- WATER - CITY OF PAMPA (10")
 - W2-04-D --- WATER - TXDOT (4")
 - W3-2.5-D --- WATER - PRIVATE (2.5")
 - W4-04-D --- WATER - WESTERN EQUIPMENT (4")
 - WW1-01-D --- SANITARY SEWER - CITY OF PAMPA
 - WW2-03-D --- SANITARY SEWER - WESTERN EQUIPMENT (3")
 - SD-01-D --- STORM - CITY OF PAMPA
 - UNK --- UNKNOWN
- OVERHEAD
- OHT --- OVERHEAD ELECTRIC TRANSMISSION - XCEL/SOUTHWESTERN PUBLIC SERVICE CO
 - OE1 --- OVERHEAD ELECTRIC - XCEL ENERGY-SOUTHWESTERN PUBLIC SERVICE CO
 - OE1/FOC1/T1/C1 --- OVERHEAD ELEC/FOC/TEL/CATV - XCEL/AT&T/AT&T/CABLE ONE
 - OE1/FOC1 --- OVERHEAD ELEC/FOC/TEL - XCEL/AT&T
 - OE1/FOC1/T1 --- OVERHEAD ELEC/FOC/TEL - XCEL/AT&T/AT&T
 - OE1/T1 --- OVERHEAD ELEC/TEL - XCEL ENERGY/AT&T
 - OE1/T1/T1/C1 --- OVERHEAD ELEC/TEL/TEL/CATV/CATV - XCEL/AT&T/AT&T/CABLE ONE/CABLE ONE
 - OE1/T1/T1/C1 --- OVERHEAD ELEC/TEL/TEL/CATV - XCEL/AT&T/AT&T/CABLE ONE
 - OE1/T1/C1 --- OVERHEAD ELEC/TEL/CATV - XCEL/AT&T/CABLE ONE
 - OE1/C1 --- OVERHEAD ELEC/CATV - XCEL ENERGY/CABLE ONE
 - OE1/C1 --- OVERHEAD ELEC/CATV - XCEL ENERGY/CABLE ONE
 - OFOC1 --- OVERHEAD FOC - AT&T
 - OT1 --- OVERHEAD TEL - AT&T
 - OFOC1/T1/C1 --- OVERHEAD TEL/FOC/CATV - AT&T/AT&T/CABLE ONE
 - OT1/C1 --- OVERHEAD TEL/CATV - AT&T/CABLE ONE
 - OC1 --- OVERHEAD CATV - CABLE ONE

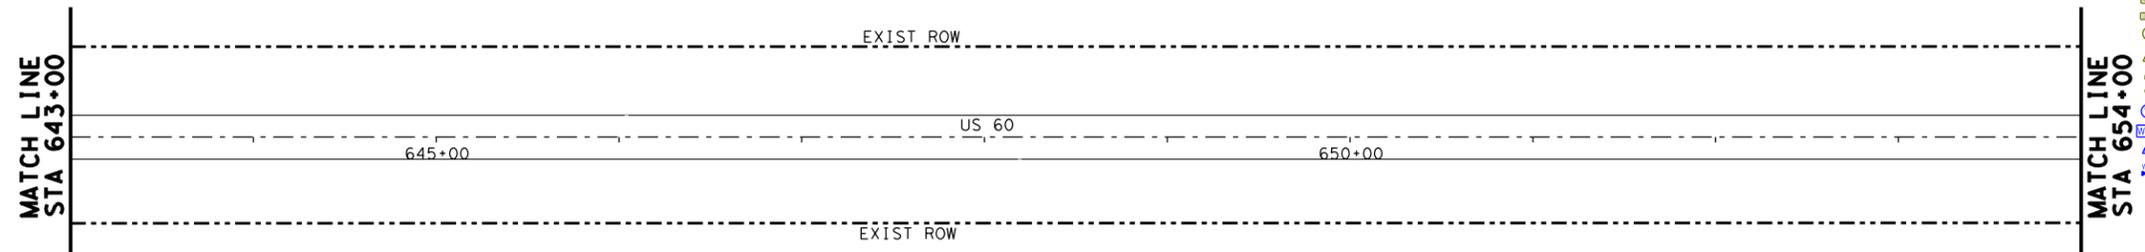

SUE RESEARCH NOT PERFORMED IN THIS AREA.
NO EXCAVATION WORK IS PLANNED IN THIS AREA.

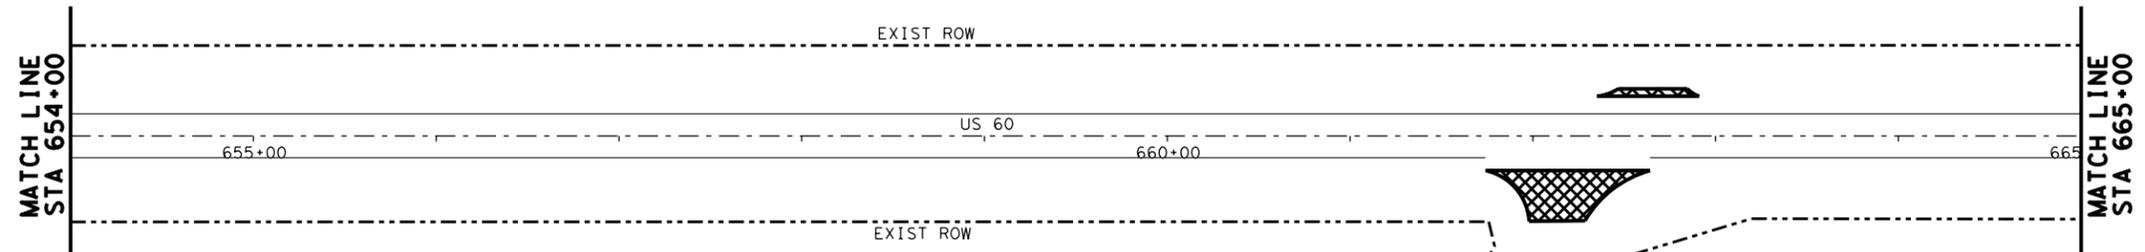

SUE RESEARCH NOT PERFORMED IN THIS AREA.
NO EXCAVATION WORK IS PLANNED IN THIS AREA.



T.E.H.
4/2/2021

REV. NO.	DATE	DESCRIPTION	BY



CobbFendley
13430 Northwest Freeway, Ste. 1100
Houston, Texas 77040
713.462.3242
www.cobbhendley.com




US 60
EXISTING UTILITY PLANS
STA 643+00 TO STA 665+00
SHEET 28 OF 36

FED. RD. DIV. NO.	STATE	PROJECT NO.	HIGHWAY NO.
6	TEXAS	SEE TITLE SHEET	US 60
STATE DISTRICT	COUNTY	CONTROL NO.	SECTION NO.
AMA	GRAY	0619	07
		JOB NO.	SHEET NO.
		053, ETC	166


- NOTES:
- THE EXISTENCE AND LOCATION OF UTILITIES INDICATED ON THE PLANS ARE TAKEN FROM FIELD INVESTIGATION, THE BEST RECORDS AVAILABLE, AND ARE APPROXIMATED. THE CONTRACTOR SHALL LOCATE ALL UTILITIES (PUBLIC OR PRIVATE, SHOWN HERE OR NOT SHOWN) BOTH VERTICALLY AND HORIZONTALLY PRIOR TO COMMENCING WORK, WHETHER UTILITIES ARE ANTICIPATED TO BE IN DIRECT CONFLICT WITH PROPOSED WORK ACTIVITIES OR NOT. THE CONTRACTOR IS FULLY RESPONSIBLE FOR ANY DAMAGES CAUSED BY THE FAILURE TO LOCATE, PRESERVE, OR PROTECT THESE UTILITIES.
 - ALL WORK ACTIVITIES (INCLUDING BUT NOT LIMITED TO CONSTRUCTING DETOURS, CULVERT EXTENSION AND REPLACEMENTS, EXCAVATION, DITCH GRADING, ETC.) SHALL NOT COMMENCE UNTIL ALL UTILITIES, ESPECIALLY UTILITIES WITHIN EXISTING ROW AND PARALLEL TO US 60, ARE IDENTIFIED. IF CONFLICTS WITH PROPOSED CONSTRUCTION OR WORK ACTIVITIES ARE IDENTIFIED, CONTRACTOR IS TO CEASE WORK IN THE LOCATION OF THE CONFLICT IMMEDIATELY.

4/12/2021 9:46:10 AM F:\P\Proj\2019\1004_TxDOT_5x5_P&S\US60_Amrt\101\US60-UST\N\506-SUE-02-Sheet\US60-SUE-28.dgn

- LEGEND**
- ⊗ TELEPHONE POLE
 - ⊗ POWER POLE
 - ⊞ ELECTRIC PULLBOX
 - ⊞ ELECTRIC METER
 - ⊞ ELECTRIC SWITCH
 - ⊞ ELECTRIC STREET LIGHT
 - ⊞ ELECTRIC LANDSCAPE LIGHT
 - ⊞ ELECTRIC TRAFFIC SIGNAL
 - ⊞ ELECTRIC TRAFFIC SWITCH BOX
 - ⊞ ELECTRIC CABINET
 - ⊞ ELECTRIC MARKER
 - ⊞ TELEPHONE PEDESTAL
 - ⊞ TELEPHONE MANHOLE
 - ⊞ TELEPHONE MARKER
 - ⊞ VIDEO-READY ACCESS DEVICE
 - ⊞ FIBER OPTIC PULLBOX
 - ⊞ FIBER OPTIC MARKER
 - ⊞ FIBER OPTIC TEST STATION
 - ⊞ GAS METER
 - ⊞ GAS MARKER
 - ⊞ GAS REGULATOR
 - ⊞ GAS TEST STATION
 - ⊞ GAS VALVE
 - ⊞ GAS VENT
 - ⊞ WATER MANHOLE
 - ⊞ WATER MARKER
 - ⊞ WATER VALVE
- QL LEVEL B**
- E1-01 --- ELECTRIC-XCEL/SOUTHWEST PUBLIC SERVICE.CO
 - E3-01 --- ELECTRIC - TXDOT
 - FOC1-01 --- FIBER OPTIC - AT&T
 - FOC2-01 --- FIBER OPTIC - DOBSON FIBER CO
 - T1-01 --- TELEPHONE - AT&T
 - C1-01 --- CABLE TV - CABLE ONE
 - G1-01 --- GAS - ATMOS ENERGY
 - G1-02 --- GAS - ATMOS ENERGY (2")
 - G3-01 --- GAS - UNKNOWN
 - G4-01 --- GAS - AMARILLO NATURAL GAS
 - W1-01 --- WATER - CITY OF PAMPA
 - W1-06 --- WATER - CITY OF PAMPA (6")
 - W1-10 --- WATER - CITY OF PAMPA (10")
 - WW1-01 --- SANITARY SEWER - CITY OF PAMPA
 - SD-01 --- STORM - CITY OF PAMPA
 - UNK --- UNKNOWN
 - QL LEVEL D --- ELECTRIC-XCEL/SOUTHWEST PUBLIC SERVICE.CO
 - E1-01-D --- ELECTRIC - TXDOT
 - FOC1-01-D --- FIBER OPTIC - AT&T
 - T1-01-D --- TELEPHONE - AT&T
 - C1-01-D --- CABLE TV - CABLE ONE
 - G1-01-D --- GAS - ATMOS ENERGY
 - G2-01-D --- GAS - WEST TEXAS GAS
 - G2-03-D --- GAS - WEST TEXAS GAS (3")
 - G3-01-D --- GAS - UNKNOWN
 - W1-01-D --- WATER - CITY OF PAMPA (UNKNOWN SIZE)
 - W1-02-D --- WATER - CITY OF PAMPA (2")
 - W1-06-D --- WATER - CITY OF PAMPA (6")
 - W1-10-D --- WATER - CITY OF PAMPA (10")
 - W2-04-D --- WATER - TXDOT (4")
 - W3-2.5-D --- WATER - PRIVATE (2.5")
 - W4-04-D --- WATER - WESTERN EQUIPMENT (4")
 - WW1-01-D --- SANITARY SEWER - CITY OF PAMPA
 - WW2-03-D --- SANITARY SEWER - WESTERN EQUIPMENT (3")
 - SD-01-D --- STORM - CITY OF PAMPA
 - UNK --- UNKNOWN
- OVERHEAD**
- OHT --- OVERHEAD ELECTRIC TRANSMISSION - XCEL/SOUTHWESTERN PUBLIC SERVICE CO
 - OE1 --- OVERHEAD ELECTRIC - XCEL ENERGY-SOUTHWESTERN PUBLIC SERVICE CO
 - OE1/FOC1/T1/C1 --- OVERHEAD ELEC/FOC/TEL/CATV - XCEL/AT&T/AT&T/CABLE ONE
 - OE1/FOC1 --- OVERHEAD ELEC/FOC/TEL - XCEL/AT&T
 - OE1/FOC1/T1 --- OVERHEAD ELEC/FOC/TEL - XCEL/AT&T/AT&T
 - OE1/T1 --- OVERHEAD ELEC/TEL - XCEL ENERGY/AT&T
 - OE1/T1/T1/C1/C1 --- OVERHEAD ELEC/TEL/TEL/CATV/CATV - XCEL/AT&T/AT&T/CABLE ONE/CABLE ONE
 - OE1/T1/T1/C1 --- OVERHEAD ELEC/TEL/TEL/CATV - XCEL/AT&T/AT&T/CABLE ONE
 - OE1/T1/C1 --- OVERHEAD ELEC/TEL/CATV - XCEL/AT&T/CABLE ONE
 - OE1/C1 --- OVERHEAD ELEC/CATV - XCEL ENERGY/CABLE ONE
 - OE1/C1 --- OVERHEAD ELEC/CATV - XCEL ENERGY/CABLE ONE
 - OFOC1 --- OVERHEAD FOC - AT&T
 - OT1 --- OVERHEAD TEL - AT&T
 - OFOC1/T1/C1 --- OVERHEAD TEL/FOC/CATV - AT&T/AT&T/CABLE ONE
 - OT1/C1 --- OVERHEAD TEL/CATV - AT&T/CABLE ONE
 - OC1 --- OVERHEAD CATV - CABLE ONE

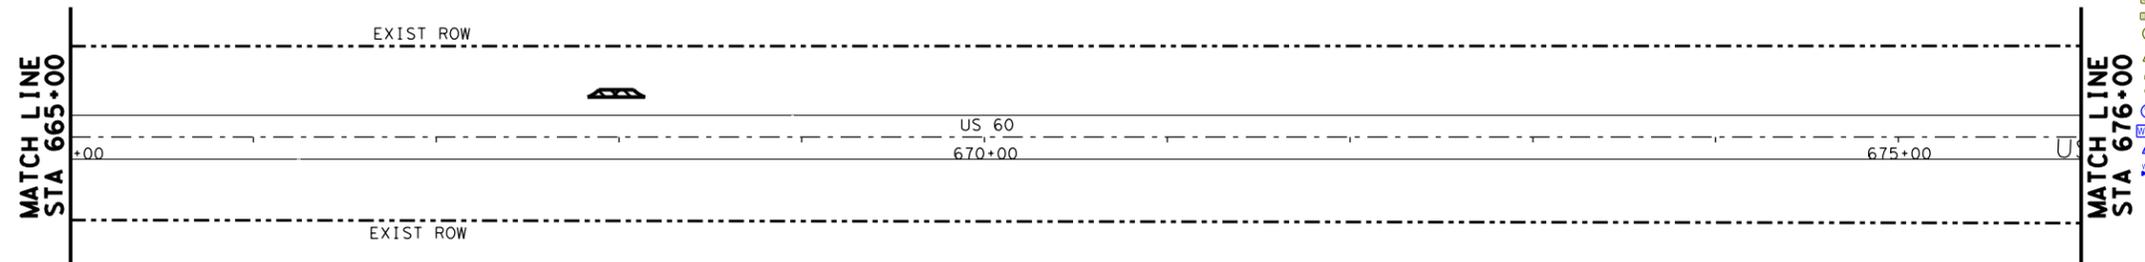

SUE RESEARCH NOT PERFORMED IN THIS AREA.
NO EXCAVATION WORK IS PLANNED IN THIS AREA.

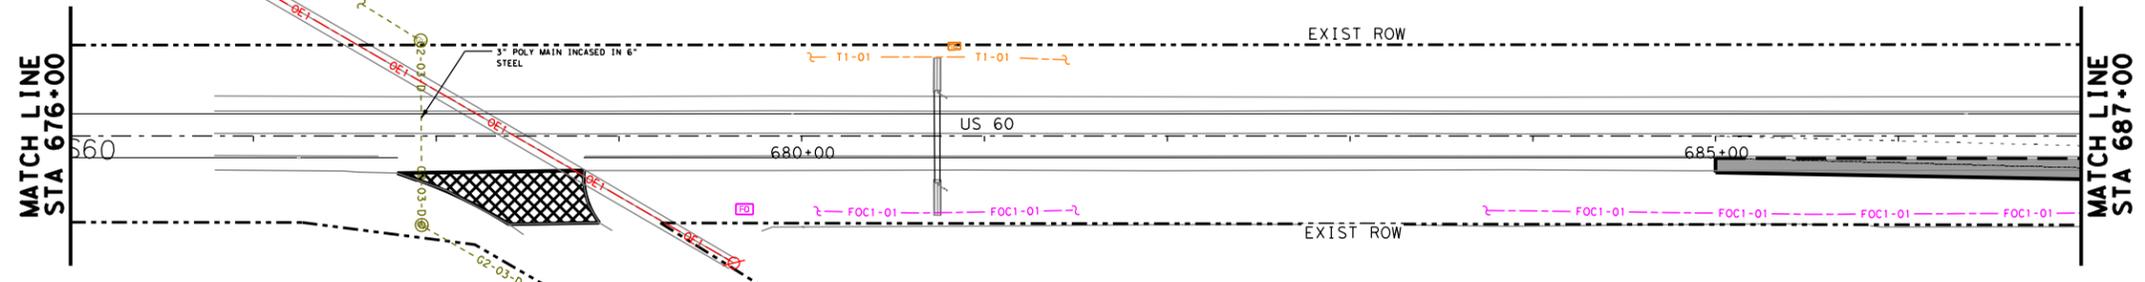


SUE RESEARCH ONLY PERFORMED ON AREAS WITH
PROPOSED US 60 ROAD WIDENING AND PROPOSED
DRAINAGE.



T.E.H.
4/2/2021

REV. NO.	DATE	DESCRIPTION	BY

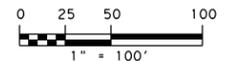

CobbFendley
13430 Northwest Freeway, Ste. 1100
Houston, Texas 77040
713.462.3242
www.cobbhendley.com





US 60
EXISTING UTILITY PLANS
STA 665+00 TO STA 687+00
SHEET 29 OF 36

FED. RD. DIV. NO.	STATE	PROJECT NO.	HIGHWAY NO.
6	TEXAS	SEE TITLE SHEET	US 60
STATE DISTRICT	COUNTY	CONTROL NO.	SECTION NO.
AMA	GRAY	0619	07
		JOB NO.	SHEET NO.
		053, ETC	167

4/12/2021 F:\P\Proj\2019\1004_TxDOT_5x5_PSS&E\03_US60_Amrt\1016\16\500\UST\N\506-SUE\02-Sheet\US60-SUE-29.dgn

- NOTES:**
- THE EXISTENCE AND LOCATION OF UTILITIES INDICATED ON THE PLANS ARE TAKEN FROM FIELD INVESTIGATION, THE BEST RECORDS AVAILABLE, AND ARE APPROXIMATED. THE CONTRACTOR SHALL LOCATE ALL UTILITIES (PUBLIC OR PRIVATE, SHOWN HERE OR NOT SHOWN) BOTH VERTICALLY AND HORIZONTALLY PRIOR TO COMMENCING WORK, WHETHER UTILITIES ARE ANTICIPATED TO BE IN DIRECT CONFLICT WITH PROPOSED WORK ACTIVITIES OR NOT. THE CONTRACTOR IS FULLY RESPONSIBLE FOR ANY DAMAGES CAUSED BY THE FAILURE TO LOCATE, PRESERVE, OR PROTECT THESE UTILITIES.
 - ALL WORK ACTIVITIES (INCLUDING BUT NOT LIMITED TO CONSTRUCTING DETOURS, CULVERT EXTENSION AND REPLACEMENTS, EXCAVATION, DITCH GRADING, ETC.) SHALL NOT COMMENCE UNTIL ALL UTILITIES, ESPECIALLY UTILITIES WITHIN EXISTING ROW AND PARALLEL TO US 60, ARE IDENTIFIED. IF CONFLICTS WITH PROPOSED CONSTRUCTION OR WORK ACTIVITIES ARE IDENTIFIED, CONTRACTOR IS TO CEASE WORK IN THE LOCATION OF THE CONFLICT IMMEDIATELY.

- LEGEND
- TELEPHONE POLE
 - POWER POLE
 - ELECTRIC PULLBOX
 - ELECTRIC METER
 - ELECTRIC SWITCH
 - ELECTRIC STREET LIGHT
 - ELECTRIC LANDSCAPE LIGHT
 - ELECTRIC TRAFFIC SIGNAL
 - ELECTRIC TRAFFIC SWITCH BOX
 - ELECTRIC CABINET
 - ELECTRIC MARKER
 - TELEPHONE PEDESTAL
 - TELEPHONE MANHOLE
 - TELEPHONE MARKER
 - VIDEO-READY ACCESS DEVICE
 - FIBER OPTIC PULLBOX
 - FIBER OPTIC MARKER
 - FIBER OPTIC TEST STATION
 - GAS METER
 - GAS MARKER
 - GAS REGULATOR
 - GAS TEST STATION
 - GAS VALVE
 - GAS VENT
 - WATER MANHOLE
 - WATER MARKER
 - WATER TEST STATION
 - WATER VALVE
- QL LEVEL B
- E1-01 ELECTRIC-XCEL/SOUTHWEST PUBLIC SERVICE CO
 - E3-01 ELECTRIC - TXDOT
 - FOC1-01 FIBER OPTIC - AT&T
 - FOC2-01 FIBER OPTIC - DOBSON FIBER CO
 - T1-01 TELEPHONE - AT&T
 - C1-01 CABLE TV - CABLE ONE
 - G1-01 GAS - ATMOS ENERGY
 - G1-02 GAS - ATMOS ENERGY (2")
 - G3-01 GAS - UNKNOWN
 - G4-01 GAS - AMARILLO NATURAL GAS
 - W1-01 WATER - CITY OF PAMPA
 - W1-06 WATER - CITY OF PAMPA (6")
 - W1-10 WATER - CITY OF PAMPA (10")
 - WW1-01 SANITARY SEWER - CITY OF PAMPA
 - SD-01 STORM - CITY OF PAMPA
 - UNK UNKNOWN
 - QL LEVEL D
 - E1-01-D ELECTRIC-XCEL/SOUTHWEST PUBLIC SERVICE CO
 - E3-01-D ELECTRIC - TXDOT
 - FOC1-01-D FIBER OPTIC - AT&T
 - T1-01-D TELEPHONE - AT&T
 - C1-01-D CABLE TV - CABLE ONE
 - G1-01-D GAS - ATMOS ENERGY
 - G2-01-D GAS - WEST TEXAS GAS
 - G2-03-D GAS - WEST TEXAS GAS (3")
 - G3-01-D GAS - UNKNOWN
 - W1-01-D WATER - CITY OF PAMPA (UNKNOWN SIZE)
 - W1-02-D WATER - CITY OF PAMPA (2")
 - W1-06-D WATER - CITY OF PAMPA (6")
 - W1-10-D WATER - CITY OF PAMPA (10")
 - W2-04-D WATER - TXDOT (4")
 - W3-2.5-D WATER - PRIVATE (2.5")
 - W4-04-D WATER - WESTERN EQUIPMENT (4")
 - WW1-01-D SANITARY SEWER - CITY OF PAMPA
 - WW2-03-D SANITARY SEWER - WESTERN EQUIPMENT (3")
 - SD-01-D STORM - CITY OF PAMPA
 - UNK UNKNOWN
- OVERHEAD
- OHT OVERHEAD ELECTRIC TRANSMISSION - XCEL/SOUTHWESTERN PUBLIC SERVICE CO
 - OE1 OVERHEAD ELECTRIC - XCEL ENERGY-SOUTHWESTERN PUBLIC SERVICE CO
 - OE1/FOC1/T1/C1 OVERHEAD ELEC/FOC/TEL/CATV - XCEL/AT&T/AT&T/CABLE ONE
 - OE1/FOC1 OVERHEAD ELEC/FOC/TEL - XCEL/AT&T
 - OE1/FOC1/T1 OVERHEAD ELEC/FOC/TEL - XCEL/AT&T/AT&T
 - OE1/T1 OVERHEAD ELEC/TEL - XCEL ENERGY/AT&T
 - OE1/T1/T1/C1 OVERHEAD ELEC/TEL/TEL/CATV/CATV - XCEL/AT&T/AT&T/CABLE ONE/CABLE ONE
 - OE1/T1/T1/C1 OVERHEAD ELEC/TEL/TEL/CATV - XCEL/AT&T/AT&T/CABLE ONE
 - OE1/T1/C1 OVERHEAD ELEC/TEL/CATV - XCEL/AT&T/CABLE ONE
 - OE1/C1 OVERHEAD ELEC/CATV - XCEL ENERGY/CABLE ONE
 - OE1/C1 OVERHEAD ELEC/CATV - XCEL ENERGY/CABLE ONE
 - FOC1 OVERHEAD FOC - AT&T
 - OT1 OVERHEAD TEL - AT&T
 - FOC1/T1/C1 OVERHEAD TEL/FOC/CATV - AT&T/AT&T/CABLE ONE
 - OT1/C1 OVERHEAD TEL/CATV - AT&T/CABLE ONE
 - OC1 OVERHEAD CATV - CABLE ONE

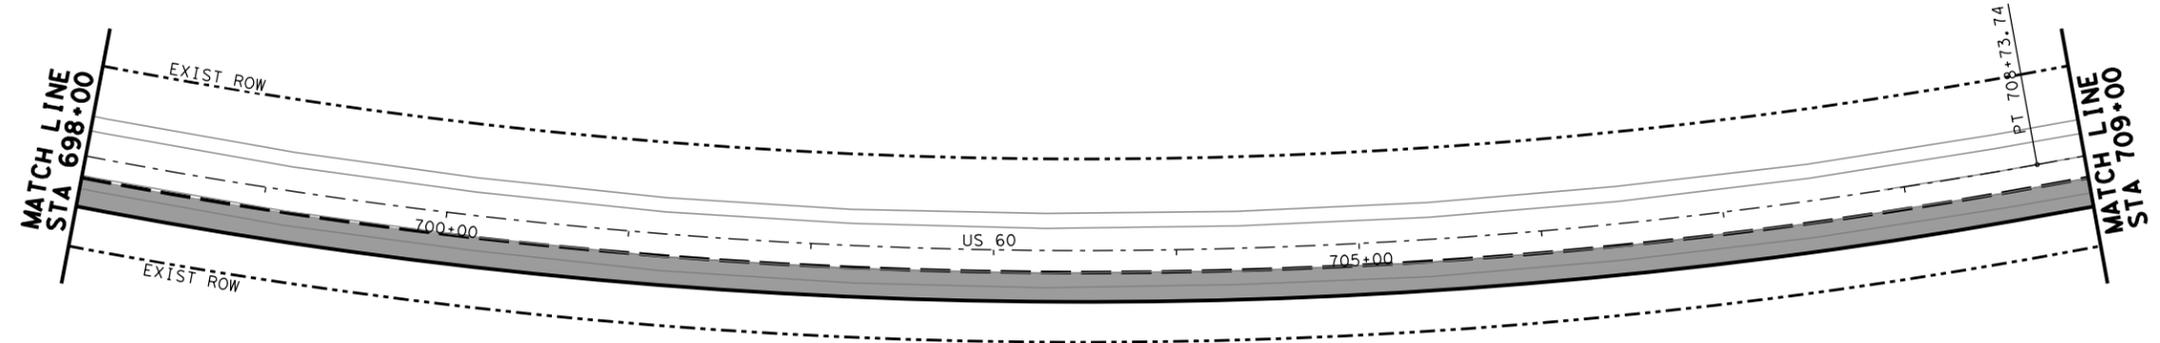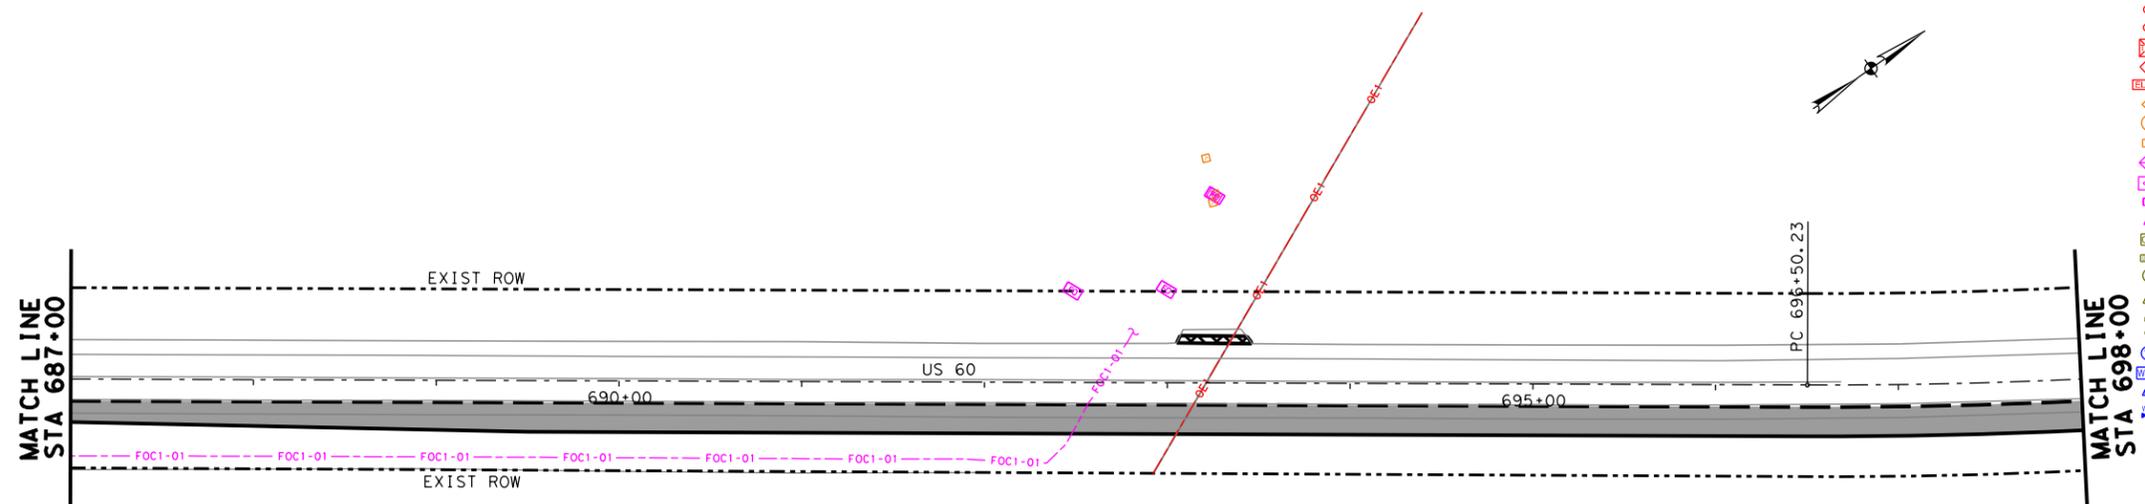


SUE RESEARCH NOT PERFORMED IN AREA.
NO EXCAVATION WORK IS PLANNED IN THIS AREA.



T.E.H.
4/2/2021

REV. NO.	DATE	DESCRIPTION	BY

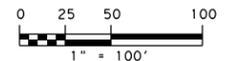

CobbFendley
13430 Northwest Freeway, Ste. 1100
Houston, Texas 77040
713.462.3242
www.cobbhendley.com



US 60
EXISTING UTILITY PLANS
STA 687+00 TO STA 709+00
SHEET 30 OF 36


FED. RD. DIV. NO.	STATE	PROJECT NO.	HIGHWAY NO.
6	TEXAS	SEE TITLE SHEET	US 60
STATE DISTRICT	COUNTY	CONTROL NO.	SECTION NO.
AMA	GRAY	0619	07
		JOB NO.	SHEET NO.
		053, ETC	168

4/2/2021 9:46:02 AM F:\P\Jerd\2019\1004_TxDOT_5x5_PSS&E\03_US60_Amarillo\ENGIN\500\UST\N\506-SUE\02-Sheet\US60-SUE-30.dgn


NOTES:

- THE EXISTENCE AND LOCATION OF UTILITIES INDICATED ON THE PLANS ARE TAKEN FROM FIELD INVESTIGATION, THE BEST RECORDS AVAILABLE, AND ARE APPROXIMATED. THE CONTRACTOR SHALL LOCATE ALL UTILITIES (PUBLIC OR PRIVATE, SHOWN HERE OR NOT SHOWN) BOTH VERTICALLY AND HORIZONTALLY PRIOR TO COMMENCING WORK, WHETHER UTILITIES ARE ANTICIPATED TO BE IN DIRECT CONFLICT WITH PROPOSED WORK ACTIVITIES OR NOT. THE CONTRACTOR IS FULLY RESPONSIBLE FOR ANY DAMAGES CAUSED BY THE FAILURE TO LOCATE, PRESERVE, OR PROTECT THESE UTILITIES.
- ALL WORK ACTIVITIES (INCLUDING BUT NOT LIMITED TO CONSTRUCTING DETOURS, CULVERT EXTENSION AND REPLACEMENTS, EXCAVATION, DITCH GRADING, ETC.) SHALL NOT COMMENCE UNTIL ALL UTILITIES, ESPECIALLY UTILITIES WITHIN EXISTING ROW AND PARALLEL TO US 60, ARE IDENTIFIED. IF CONFLICTS WITH PROPOSED CONSTRUCTION OR WORK ACTIVITIES ARE IDENTIFIED, CONTRACTOR IS TO CEASE WORK IN THE LOCATION OF THE CONFLICT IMMEDIATELY.

- LEGEND
- ⊗ TELEPHONE POLE
 - ⊗ POWER POLE
 - ⊞ ELECTRIC PULLBOX
 - ⊞ ELECTRIC METER
 - ⊞ ELECTRIC SWITCH
 - ⊞ ELECTRIC STREET LIGHT
 - ⊞ ELECTRIC LANDSCAPE LIGHT
 - ⊞ ELECTRIC TRAFFIC SIGNAL
 - ⊞ ELECTRIC TRAFFIC SWITCH BOX
 - ⊞ ELECTRIC CABINET
 - ⊞ ELECTRIC MARKER
 - ⊞ TELEPHONE PEDESTAL
 - ⊞ TELEPHONE MANHOLE
 - ⊞ TELEPHONE MARKER
 - ⊞ VIDEO-READY ACCESS DEVICE
 - ⊞ FIBER OPTIC PULLBOX
 - ⊞ FIBER OPTIC MARKER
 - ⊞ FIBER OPTIC TEST STATION
 - ⊞ GAS METER
 - ⊞ GAS MARKER
 - ⊞ GAS REGULATOR
 - ⊞ GAS TEST STATION
 - ⊞ GAS VALVE
 - ⊞ GAS VENT
 - ⊞ WATER MANHOLE
 - ⊞ WATER MARKER
 - ⊞ WATER TEST STATION
 - ⊞ WATER VALVE
- QL LEVEL B
- E1-01 — ELECTRIC-XCEL/SOUTHWEST PUBLIC SERVICE.CO
 - E3-01 — ELECTRIC - TXDOT
 - FOC1-01 — FIBER OPTIC - AT&T
 - FOC2-01 — FIBER OPTIC - DOBSON FIBER CO
 - T1-01 — TELEPHONE - AT&T
 - C1-01 — CABLE TV - CABLE ONE
 - G1-01 — GAS - ATMOS ENERGY
 - G1-02 — GAS - ATMOS ENERGY (2")
 - G3-01 — GAS - UNKNOWN
 - G4-01 — GAS - AMARILLO NATURAL GAS
 - W1-01 — WATER - CITY OF PAMPA
 - W1-06 — WATER - CITY OF PAMPA (6")
 - W1-10 — WATER - CITY OF PAMPA (10")
 - WW1-01 — SANITARY SEWER - CITY OF PAMPA
 - SD-01 — STORM - CITY OF PAMPA
 - UNK — UNKNOWN
 - QL LEVEL D
 - E1-01-D — ELECTRIC-XCEL/SOUTHWEST PUBLIC SERVICE.CO
 - E3-01-D — ELECTRIC - TXDOT
 - FOC1-01-D — FIBER OPTIC - AT&T
 - T1-01-D — TELEPHONE - AT&T
 - C1-01-D — CABLE TV - CABLE ONE
 - G1-01-D — GAS - ATMOS ENERGY
 - G2-01-D — GAS - WEST TEXAS GAS
 - G2-03-D — GAS - WEST TEXAS GAS (3")
 - G3-01-D — GAS - UNKNOWN
 - W1-01-D — WATER - CITY OF PAMPA (UNKNOWN SIZE)
 - W1-02-D — WATER - CITY OF PAMPA (2")
 - W1-06-D — WATER - CITY OF PAMPA (6")
 - W1-10-D — WATER - CITY OF PAMPA (10")
 - W2-04-D — WATER - TXDOT (4")
 - W3-2.5-D — WATER - PRIVATE (2.5")
 - W4-04-D — WATER - WESTERN EQUIPMENT (4")
 - WW1-01-D — SANITARY SEWER - CITY OF PAMPA
 - WW2-03-D — SANITARY SEWER - WESTERN EQUIPMENT (3")
 - SD-01-D — STORM - CITY OF PAMPA
 - UNK — UNKNOWN
- OVERHEAD
- OHT — OVERHEAD ELECTRIC TRANSMISSION - XCEL/SOUTHWESTERN PUBLIC SERVICE CO
 - OE1 — OVERHEAD ELECTRIC - XCEL ENERGY-SOUTHWESTERN PUBLIC SERVICE CO
 - OE1/FOC1/T1/C1 — OVERHEAD ELEC/FOC/TEL/CATV - XCEL/AT&T/AT&T/CABLE ONE
 - OE1/FOC1 — OVERHEAD ELEC/FOC/TEL - XCEL/AT&T
 - OE1/FOC1/T1 — OVERHEAD ELEC/FOC/TEL - XCEL/AT&T/AT&T
 - OE1/T1 — OVERHEAD ELEC/TEL - XCEL ENERGY/AT&T
 - OE1/T1/T1/C1 — OVERHEAD ELEC/TEL/TEL/CATV/CATV - XCEL/AT&T/AT&T/CABLE ONE/CABLE ONE
 - OE1/T1/T1/C1 — OVERHEAD ELEC/TEL/TEL/CATV - XCEL/AT&T/AT&T/CABLE ONE
 - OE1/T1/C1 — OVERHEAD ELEC/TEL/CATV - XCEL/AT&T/CABLE ONE
 - OE1/C1 — OVERHEAD ELEC/CATV - XCEL ENERGY/CABLE ONE
 - OE1/C1 — OVERHEAD ELEC/CATV - XCEL ENERGY/CABLE ONE
 - OFOC1 — OVERHEAD FOC - AT&T
 - OT1 — OVERHEAD TEL - AT&T
 - OFOC1/T1/C1 — OVERHEAD TEL/FOC/CATV - AT&T/AT&T/CABLE ONE
 - OT1/C1 — OVERHEAD TEL/CATV - AT&T/CABLE ONE
 - OC1 — OVERHEAD CATV - CABLE ONE

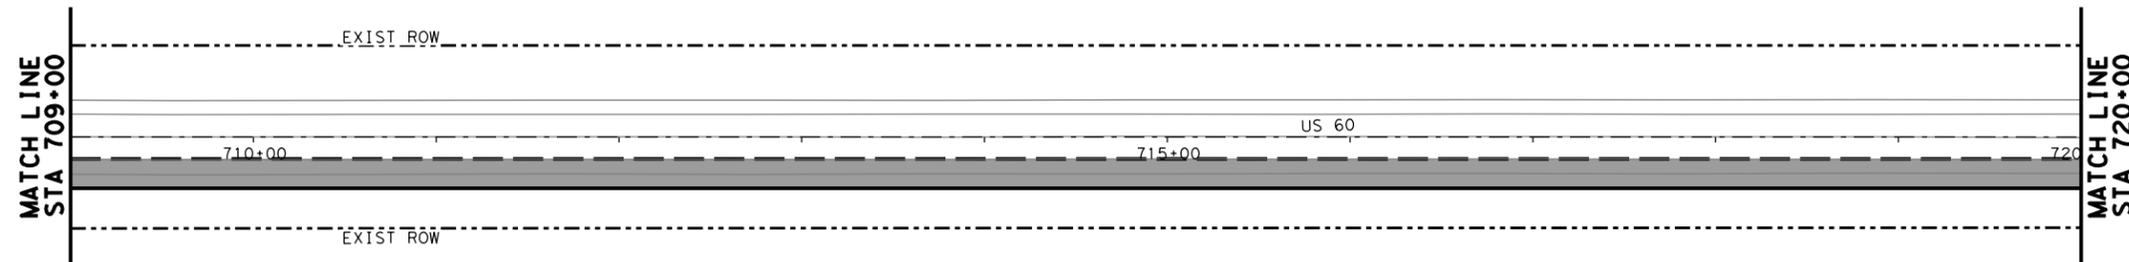

SUE RESEARCH NOT PERFORMED IN AREA.
NO EXCAVATION WORK IS PLANNED IN THIS AREA.

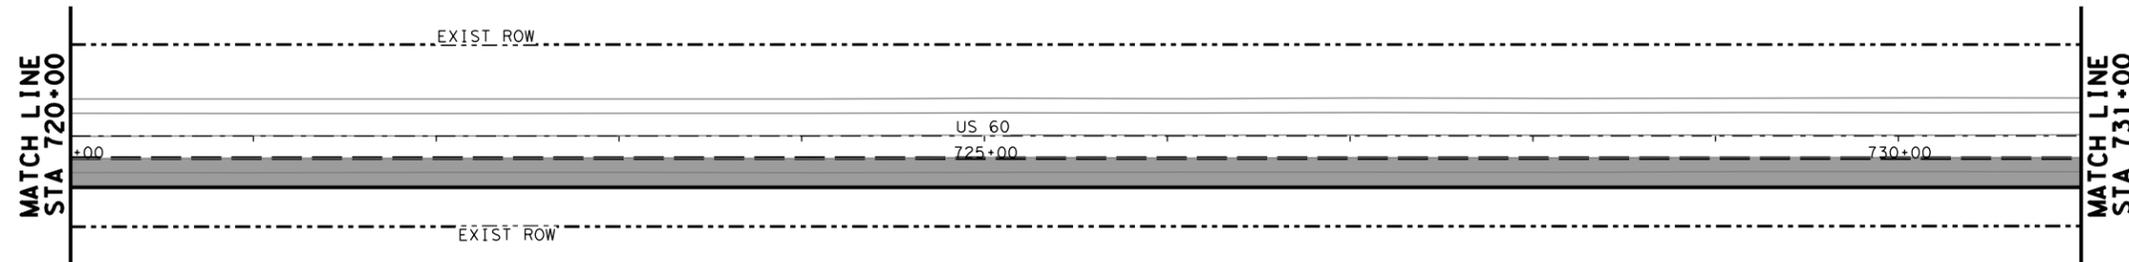

SUE RESEARCH NOT PERFORMED IN AREA.
NO EXCAVATION WORK IS PLANNED IN THIS AREA.



T.E. Hunt
4/2/2021

REV. NO.	DATE	DESCRIPTION	BY



CobbFendley
13430 Northwest Freeway, Ste. 1100
Houston, Texas 77040
713.462.3242
www.cobbendley.com




US 60
EXISTING UTILITY PLANS
STA 709+00 TO STA 731+00
SHEET 31 OF 36

FED. RD. DIV. NO.	STATE	PROJECT NO.	HIGHWAY NO.
6	TEXAS	SEE TITLE SHEET	US 60
STATE DISTRICT	COUNTY	CONTROL NO.	SECTION NO.
AMA	GRAY	0619	07
		JOB NO.	SHEET NO.
		053, ETC	169


4/12/2021 9:46:13 AM F:\P\J\ref\2019\1004_T\DOT_5x5_PSB\U3_US60_Amarrillo\ING500\UST\N\506-SUE-02-Street\US60-SUE-31.dgn

NOTES:
 1. THE EXISTENCE AND LOCATION OF UTILITIES INDICATED ON THE PLANS ARE TAKEN FROM FIELD INVESTIGATION, THE BEST RECORDS AVAILABLE, AND ARE APPROXIMATED. THE CONTRACTOR SHALL LOCATE ALL UTILITIES (PUBLIC OR PRIVATE, SHOWN HERE OR NOT SHOWN) BOTH VERTICALLY AND HORIZONTALLY PRIOR TO COMMENCING WORK, WHETHER UTILITIES ARE ANTICIPATED TO BE IN DIRECT CONFLICT WITH PROPOSED WORK ACTIVITIES OR NOT. THE CONTRACTOR IS FULLY RESPONSIBLE FOR ANY DAMAGES CAUSED BY THE FAILURE TO LOCATE, PRESERVE, OR PROTECT THESE UTILITIES.
 2. ALL WORK ACTIVITIES (INCLUDING BUT NOT LIMITED TO CONSTRUCTING DETOURS, CULVERT EXTENSION AND REPLACEMENTS, EXCAVATION, DITCH GRADING, ETC.) SHALL NOT COMMENCE UNTIL ALL UTILITIES, ESPECIALLY UTILITIES WITHIN EXISTING ROW AND PARALLEL TO US 60, ARE IDENTIFIED. IF CONFLICTS WITH PROPOSED CONSTRUCTION OR WORK ACTIVITIES ARE IDENTIFIED, CONTRACTOR IS TO CEASE WORK IN THE LOCATION OF THE CONFLICT IMMEDIATELY.

- LEGEND**
- ⊗ TELEPHONE POLE
 - ⊗ POWER POLE
 - ⊞ ELECTRIC PULLBOX
 - ⊞ ELECTRIC METER
 - ⊞ ELECTRIC SWITCH
 - ⊞ ELECTRIC STREET LIGHT
 - ⊞ ELECTRIC LANDSCAPE LIGHT
 - ⊞ ELECTRIC TRAFFIC SIGNAL
 - ⊞ ELECTRIC TRAFFIC SWITCH BOX
 - ⊞ ELECTRIC CABINET
 - ⊞ ELECTRIC MARKER
 - ⊞ TELEPHONE PEDESTAL
 - ⊞ TELEPHONE MANHOLE
 - ⊞ TELEPHONE MARKER
 - ⊞ VIDEO-READY ACCESS DEVICE
 - ⊞ FIBER OPTIC PULLBOX
 - ⊞ FIBER OPTIC MARKER
 - ⊞ FIBER OPTIC TEST STATION
 - ⊞ GAS METER
 - ⊞ GAS MARKER
 - ⊞ GAS REGULATOR
 - ⊞ GAS TEST STATION
 - ⊞ GAS VALVE
 - ⊞ GAS VENT
 - ⊞ WATER MANHOLE
 - ⊞ WATER MARKER
 - ⊞ WATER TEST STATION
 - ⊞ WATER VALVE
- QL LEVEL B**
- E1-01 --- ELECTRIC-XCEL/SOUTHWEST PUBLIC SERVICE.CO
 - E3-01 --- ELECTRIC - TXDOT
 - FOC1-01 --- FIBER OPTIC - AT&T
 - FOC2-01 --- FIBER OPTIC - DOBSON FIBER CO
 - T1-01 --- TELEPHONE - AT&T
 - C1-01 --- CABLE TV - CABLE ONE
 - G1-01 --- GAS - ATMOS ENERGY
 - G1-02 --- GAS - ATMOS ENERGY (2")
 - G3-01 --- GAS - UNKNOWN
 - G4-01 --- GAS - AMARILLO NATURAL GAS
 - W1-01 --- WATER - CITY OF PAMPA
 - W1-06 --- WATER - CITY OF PAMPA (6")
 - W1-10 --- WATER - CITY OF PAMPA (10")
 - WW1-01 --- SANITARY SEWER - CITY OF PAMPA
 - SD-01 --- STORM - CITY OF PAMPA
 - UNK --- UNKNOWN
 - QL LEVEL D --- ELECTRIC-XCEL/SOUTHWEST PUBLIC SERVICE.CO
 - E1-01-D --- ELECTRIC - TXDOT
 - FOC1-01-D --- FIBER OPTIC - AT&T
 - T1-01-D --- TELEPHONE - AT&T
 - C1-01-D --- CABLE TV - CABLE ONE
 - G1-01-D --- GAS - ATMOS ENERGY
 - G2-01-D --- GAS - WEST TEXAS GAS
 - G2-03-D --- GAS - WEST TEXAS GAS (3")
 - G3-01-D --- GAS - UNKNOWN
 - W1-01-D --- WATER - CITY OF PAMPA (UNKNOWN SIZE)
 - W1-02-D --- WATER - CITY OF PAMPA (2")
 - W1-06-D --- WATER - CITY OF PAMPA (6")
 - W1-10-D --- WATER - CITY OF PAMPA (10")
 - W2-04-D --- WATER - TXDOT (4")
 - W3-2.5-D --- WATER - PRIVATE (2.5")
 - W4-04-D --- WATER - WESTERN EQUIPMENT (4")
 - WW1-01-D --- SANITARY SEWER - CITY OF PAMPA
 - WW2-03-D --- SANITARY SEWER - WESTERN EQUIPMENT (3")
 - SD-01-D --- STORM - CITY OF PAMPA
 - UNK --- UNKNOWN
- OVERHEAD**
- OHT --- OVERHEAD ELECTRIC TRANSMISSION - XCEL/SOUTHWESTERN PUBLIC SERVICE CO
 - OE1 --- OVERHEAD ELECTRIC - XCEL ENERGY-SOUTHWESTERN PUBLIC SERVICE CO
 - OE1/FOC1/T1/C1 --- OVERHEAD ELEC/FOC/TEL/CATV - XCEL/AT&T/AT&T/CABLE ONE
 - OE1/FOC1 --- OVERHEAD ELEC/FOC/TEL - XCEL/AT&T
 - OE1/FOC1/T1 --- OVERHEAD ELEC/FOC/TEL - XCEL/AT&T/AT&T
 - OE1/T1 --- OVERHEAD ELEC/TEL - XCEL ENERGY/AT&T
 - OE1/T1/T1/C1 --- OVERHEAD ELEC/TEL/TEL/CATV/CATV - XCEL/AT&T/AT&T/CABLE ONE/CABLE ONE
 - OE1/T1/T1/C1 --- OVERHEAD ELEC/TEL/TEL/CATV - XCEL/AT&T/AT&T/CABLE ONE
 - OE1/T1/C1 --- OVERHEAD ELEC/TEL/CATV - XCEL/AT&T/CABLE ONE
 - OE1/C1 --- OVERHEAD ELEC/CATV - XCEL ENERGY/CABLE ONE
 - OE1/C1 --- OVERHEAD ELEC/CATV - XCEL ENERGY/CABLE ONE
 - OFOC1 --- OVERHEAD FOC - AT&T
 - OT1 --- OVERHEAD TEL - AT&T
 - OFOC1/T1/C1 --- OVERHEAD TEL/FOC/CATV - AT&T/AT&T/CABLE ONE
 - OT1/C1 --- OVERHEAD TEL/CATV - AT&T/CABLE ONE
 - OC1 --- OVERHEAD CATV - CABLE ONE

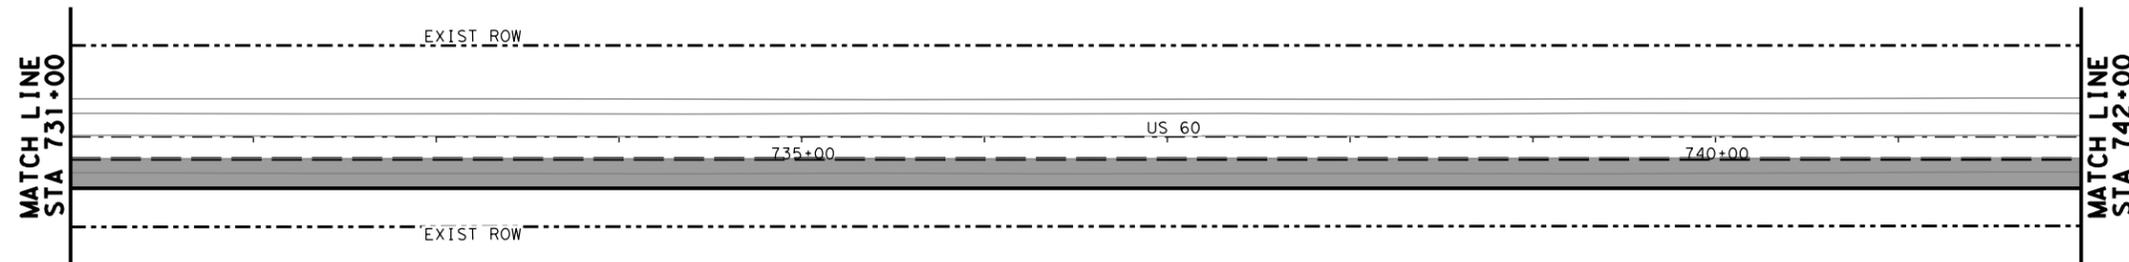

SUE RESEARCH NOT PERFORMED IN AREA.
NO EXCAVATION WORK IS PLANNED IN THIS AREA.

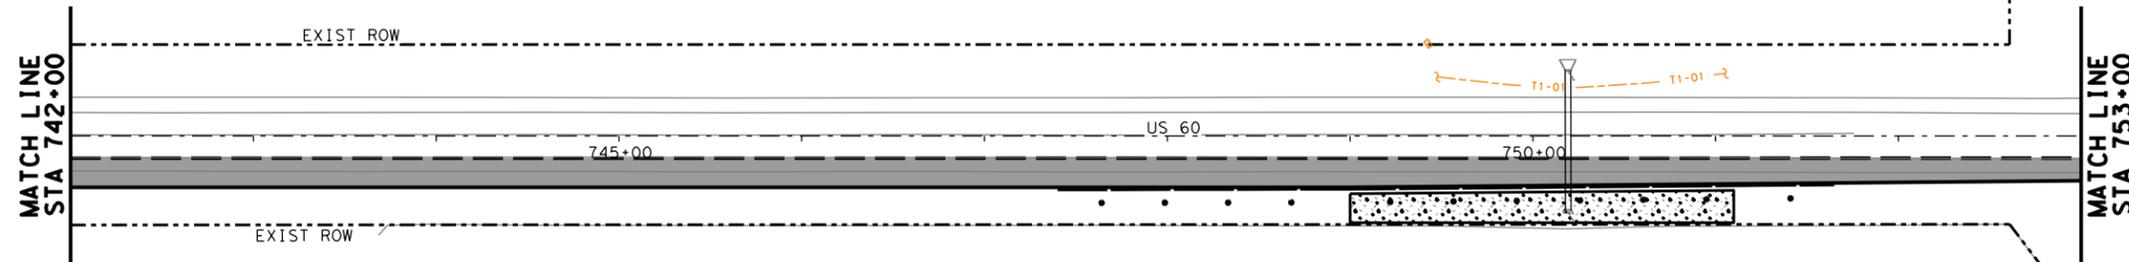


SUE RESEARCH ONLY PERFORMED IN AREAS
WITH PROPOSED DRAINAGE.



T.E. Hunt
4/2/2021

REV. NO.	DATE	DESCRIPTION	BY

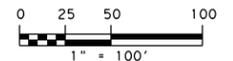

CobbFendley
13430 Northwest Freeway, Ste. 1100
Houston, Texas 77040
713.462.3242
www.cobbhendley.com



US 60
EXISTING UTILITY PLANS
STA 731+00 TO STA 753+00
SHEET 32 OF 36


FED. RD. DIV. NO.	STATE	PROJECT NO.	HIGHWAY NO.
6	TEXAS	SEE TITLE SHEET	US 60
STATE DISTRICT	COUNTY	CONTROL NO.	SECTION NO.
AMA	GRAY	0619	07
		JOB NO.	SHEET NO.
		053, ETC	170

4/2/2021 9:46:13 AM F:\P\proj\2019\1004_TxDOT_5x5_P&S\US60_US60_US60-UST\N\US60-US60-UST\N\US60-US60-UST\N\US60-SUE-32.dgn


NOTES:

- THE EXISTENCE AND LOCATION OF UTILITIES INDICATED ON THE PLANS ARE TAKEN FROM FIELD INVESTIGATION, THE BEST RECORDS AVAILABLE, AND ARE APPROXIMATED. THE CONTRACTOR SHALL LOCATE ALL UTILITIES (PUBLIC OR PRIVATE, SHOWN HERE OR NOT SHOWN) BOTH VERTICALLY AND HORIZONTALLY PRIOR TO COMMENCING WORK, WHETHER UTILITIES ARE ANTICIPATED TO BE IN DIRECT CONFLICT WITH PROPOSED WORK ACTIVITIES OR NOT. THE CONTRACTOR IS FULLY RESPONSIBLE FOR ANY DAMAGES CAUSED BY THE FAILURE TO LOCATE, PRESERVE, OR PROTECT THESE UTILITIES.
- ALL WORK ACTIVITIES (INCLUDING BUT NOT LIMITED TO CONSTRUCTING DETOURS, CULVERT EXTENSION AND REPLACEMENTS, EXCAVATION, DITCH GRADING, ETC.) SHALL NOT COMMENCE UNTIL ALL UTILITIES, ESPECIALLY UTILITIES WITHIN EXISTING ROW AND PARALLEL TO US 60, ARE IDENTIFIED. IF CONFLICTS WITH PROPOSED CONSTRUCTION OR WORK ACTIVITIES ARE IDENTIFIED, CONTRACTOR IS TO CEASE WORK IN THE LOCATION OF THE CONFLICT IMMEDIATELY.

- LEGEND**
- ⊗ TELEPHONE POLE
 - ⊗ POWER POLE
 - ⊞ ELECTRIC PULLBOX
 - ⊞ ELECTRIC METER
 - ⊞ ELECTRIC SWITCH
 - ⊞ ELECTRIC STREET LIGHT
 - ⊞ ELECTRIC LANDSCAPE LIGHT
 - ⊞ ELECTRIC TRAFFIC SIGNAL
 - ⊞ ELECTRIC TRAFFIC SWITCH BOX
 - ⊞ ELECTRIC CABINET
 - ⊞ ELECTRIC MARKER
 - ⊞ TELEPHONE PEDESTAL
 - ⊞ TELEPHONE MANHOLE
 - ⊞ TELEPHONE MARKER
 - ⊞ VIDEO-READY ACCESS DEVICE
 - ⊞ FIBER OPTIC PULLBOX
 - ⊞ FIBER OPTIC MARKER
 - ⊞ FIBER OPTIC TEST STATION
 - ⊞ GAS METER
 - ⊞ GAS MARKER
 - ⊞ GAS REGULATOR
 - ⊞ GAS TEST STATION
 - ⊞ GAS VALVE
 - ⊞ GAS VENT
 - ⊞ WATER MANHOLE
 - ⊞ WATER MARKER
 - ⊞ WATER TEST STATION
 - ⊞ WATER VALVE
- QL LEVEL B**
- E1-01 --- ELECTRIC-XCEL/SOUTHWEST PUBLIC SERVICE.CO
 - E3-01 --- ELECTRIC - TXDOT
 - FOC1-01 --- FIBER OPTIC - AT&T
 - FOC2-01 --- FIBER OPTIC - DOBSON FIBER CO
 - T1-01 --- TELEPHONE - AT&T
 - C1-01 --- CABLE TV - CABLE ONE
 - G1-01 --- GAS - ATMOS ENERGY
 - G1-02 --- GAS - ATMOS ENERGY (2")
 - G3-01 --- GAS - UNKNOWN
 - G4-01 --- GAS - AMARILLO NATURAL GAS
 - W1-01 --- WATER - CITY OF PAMPA
 - W1-06 --- WATER - CITY OF PAMPA (6")
 - W1-10 --- WATER - CITY OF PAMPA (10")
 - WW1-01 --- SANITARY SEWER - CITY OF PAMPA
 - SD-01 --- STORM - CITY OF PAMPA
 - UNK --- UNKNOWN
 - QL LEVEL D --- ELECTRIC-XCEL/SOUTHWEST PUBLIC SERVICE.CO
 - E3-01-D --- ELECTRIC - TXDOT
 - FOC1-01-D --- FIBER OPTIC - AT&T
 - T1-01-D --- TELEPHONE - AT&T
 - C1-01-D --- CABLE TV - CABLE ONE
 - G1-01-D --- GAS - ATMOS ENERGY
 - G2-01-D --- GAS - WEST TEXAS GAS
 - G2-03-D --- GAS - WEST TEXAS GAS (3")
 - G3-01-D --- GAS - UNKNOWN
 - W1-01-D --- WATER - CITY OF PAMPA (UNKNOWN SIZE)
 - W1-02-D --- WATER - CITY OF PAMPA (2")
 - W1-06-D --- WATER - CITY OF PAMPA (6")
 - W1-10-D --- WATER - CITY OF PAMPA (10")
 - W2-04-D --- WATER - TXDOT (4")
 - W3-2.5-D --- WATER - PRIVATE (2.5")
 - W4-04-D --- WATER - WESTERN EQUIPMENT (4")
 - WW1-01-D --- SANITARY SEWER - CITY OF PAMPA
 - WW2-03-D --- SANITARY SEWER - WESTERN EQUIPMENT (3")
 - SD-01-D --- STORM - CITY OF PAMPA
 - UNK --- UNKNOWN
- OVERHEAD**
- OHT --- OVERHEAD ELECTRIC TRANSMISSION - XCEL/SOUTHWESTERN PUBLIC SERVICE CO
 - OE1 --- OVERHEAD ELECTRIC - XCEL ENERGY-SOUTHWESTERN PUBLIC SERVICE CO
 - OE1/FOC1/T1/C1 --- OVERHEAD ELEC/FOC/TEL/CATV - XCEL/AT&T/AT&T/CABLE ONE
 - OE1/FOC1 --- OVERHEAD ELEC/FOC/TEL - XCEL/AT&T
 - OE1/FOC1/T1 --- OVERHEAD ELEC/FOC/TEL - XCEL/AT&T/AT&T
 - OE1/T1 --- OVERHEAD ELEC/TEL - XCEL ENERGY/AT&T
 - OE1/T1/T1/C1 --- OVERHEAD ELEC/TEL/TEL/CATV - XCEL/AT&T/AT&T/CABLE ONE/CABLE ONE
 - OE1/T1/T1/C1 --- OVERHEAD ELEC/TEL/TEL/CATV - XCEL/AT&T/AT&T/CABLE ONE
 - OE1/T1/C1 --- OVERHEAD ELEC/TEL/CATV - XCEL/AT&T/CABLE ONE
 - OE1/C1 --- OVERHEAD ELEC/CATV - XCEL ENERGY/CABLE ONE
 - OE1/C1 --- OVERHEAD ELEC/CATV - XCEL ENERGY/CABLE ONE
 - OFOC1 --- OVERHEAD FOC - AT&T
 - OT1 --- OVERHEAD TEL - AT&T
 - OFOC1/T1/C1 --- OVERHEAD TEL/FOC/CATV - AT&T/AT&T/CABLE ONE
 - OT1/C1 --- OVERHEAD TEL/CATV - AT&T/CABLE ONE
 - OC1 --- OVERHEAD CATV - CABLE ONE

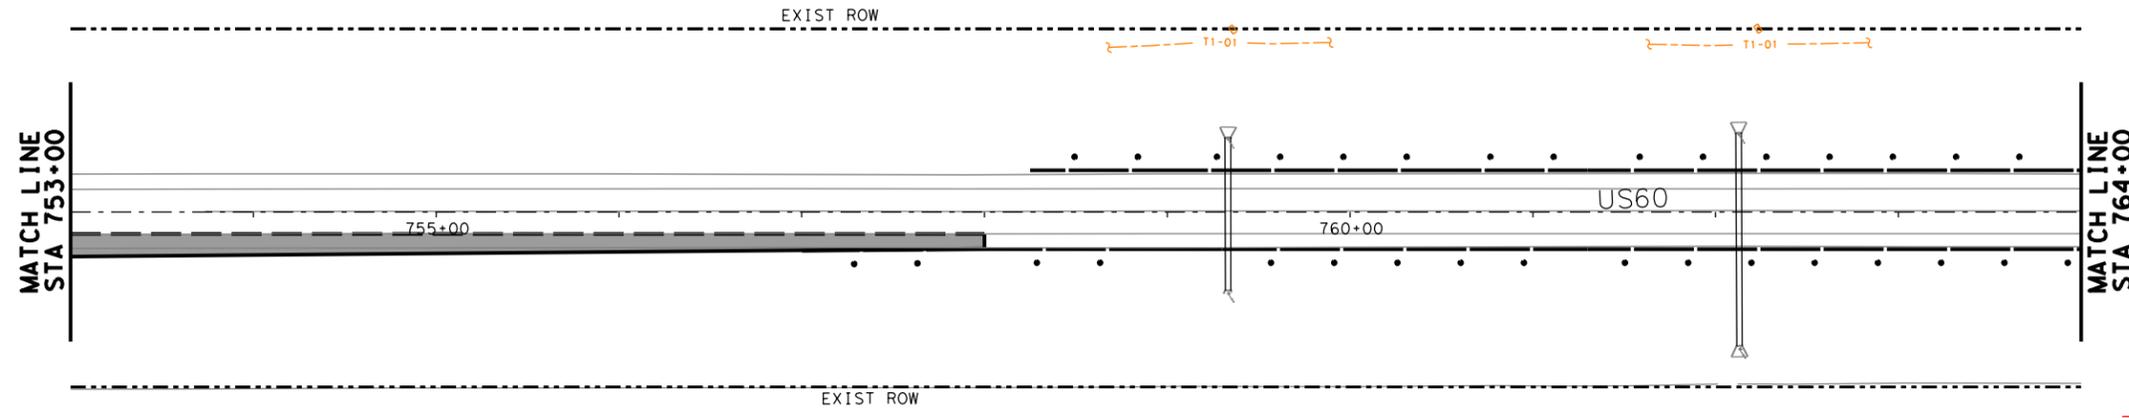


SUE RESEARCH ONLY PERFORMED IN AREAS WITH PROPOSED DRAINAGE.

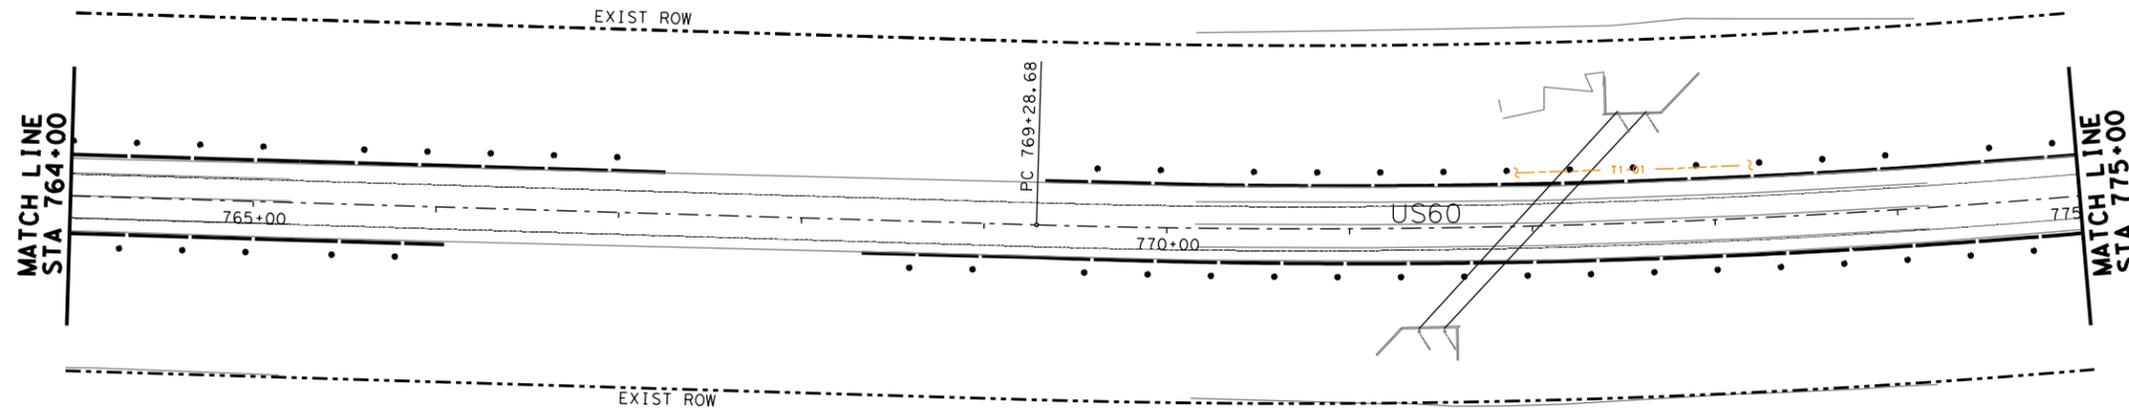

SUE RESEARCH ONLY PERFORMED IN AREAS WITH PROPOSED DRAINAGE.



REV. NO.	DATE	DESCRIPTION	BY

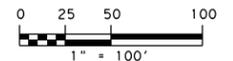

CobbFendley 13430 Northwest Freeway, Ste. 1100
Houston, Texas 77040
713.462.3242
www.cobbhendley.com



**US 60
EXISTING UTILITY PLANS
STA 753+00 TO STA 775+00**

FED. RD. DIV. NO.	STATE	PROJECT NO.	HIGHWAY NO.		
6	TEXAS	SEE TITLE SHEET	US 60		
STATE DISTRICT	COUNTY	CONTROL NO.	SECTION NO.	JOB NO.	SHEET NO.
AMA	GRAY	0619	07	053, ETC	171


NOTES:

- THE EXISTENCE AND LOCATION OF UTILITIES INDICATED ON THE PLANS ARE TAKEN FROM FIELD INVESTIGATION, THE BEST RECORDS AVAILABLE, AND ARE APPROXIMATED. THE CONTRACTOR SHALL LOCATE ALL UTILITIES (PUBLIC OR PRIVATE, SHOWN HERE OR NOT SHOWN) BOTH VERTICALLY AND HORIZONTALLY PRIOR TO COMMENCING WORK, WHETHER UTILITIES ARE ANTICIPATED TO BE IN DIRECT CONFLICT WITH PROPOSED WORK ACTIVITIES OR NOT. THE CONTRACTOR IS FULLY RESPONSIBLE FOR ANY DAMAGES CAUSED BY THE FAILURE TO LOCATE, PRESERVE, OR PROTECT THESE UTILITIES.
- ALL WORK ACTIVITIES (INCLUDING BUT NOT LIMITED TO CONSTRUCTING DETOURS, CULVERT EXTENSION AND REPLACEMENTS, EXCAVATION, DITCH GRADING, ETC.) SHALL NOT COMMENCE UNTIL ALL UTILITIES, ESPECIALLY UTILITIES WITHIN EXISTING ROW AND PARALLEL TO US 60, ARE IDENTIFIED. IF CONFLICTS WITH PROPOSED CONSTRUCTION OR WORK ACTIVITIES ARE IDENTIFIED, CONTRACTOR IS TO CEASE WORK IN THE LOCATION OF THE CONFLICT IMMEDIATELY.


4/2/2021 F:\P\Proj\2019\1004_TxDOT_5x5_PSS&E\03_US60_Amarty\10\ENGIN\500\UST\N\506-SUE\02-Sheet\US60-SUE-33.dgn 9:46:14 AM

US60-SUE-33.dgn

- LEGEND
- ⊗ TELEPHONE POLE
 - ⊗ POWER POLE
 - ⊞ ELECTRIC PULLBOX
 - ⊞ ELECTRIC METER
 - ⊞ ELECTRIC SWITCH
 - ⊞ ELECTRIC STREET LIGHT
 - ⊞ ELECTRIC LANDSCAPE LIGHT
 - ⊞ ELECTRIC TRAFFIC SIGNAL
 - ⊞ ELECTRIC TRAFFIC SWITCH BOX
 - ⊞ ELECTRIC CABINET
 - ⊞ ELECTRIC MARKER
 - ⊞ TELEPHONE PEDESTAL
 - ⊞ TELEPHONE MANHOLE
 - ⊞ TELEPHONE MARKER
 - ⊞ VIDEO-READY ACCESS DEVICE
 - ⊞ FIBER OPTIC PULLBOX
 - ⊞ FIBER OPTIC MARKER
 - ⊞ FIBER OPTIC TEST STATION
 - ⊞ GAS METER
 - ⊞ GAS MARKER
 - ⊞ GAS REGULATOR
 - ⊞ GAS TEST STATION
 - ⊞ GAS VALVE
 - ⊞ GAS VENT
 - ⊞ WATER MANHOLE
 - ⊞ WATER MARKER
 - ⊞ WATER VALVE
- QL LEVEL B -
- E1-01 --- ELECTRIC-XCEL/SOUTHWEST PUBLIC SERVICE.CO
 - E3-01 --- ELECTRIC - TXDOT
 - FOC1-01 --- FIBER OPTIC - AT&T
 - FOC2-01 --- FIBER OPTIC - DOBSON FIBER CO
 - T1-01 --- TELEPHONE - AT&T
 - C1-01 --- CABLE TV - CABLE ONE
 - G1-01 --- GAS - ATMOS ENERGY
 - G1-02 --- GAS - ATMOS ENERGY (2")
 - G3-01 --- GAS - UNKNOWN
 - G4-01 --- GAS - AMARILLO NATURAL GAS
 - W1-01 --- WATER - CITY OF PAMPA
 - W1-06 --- WATER - CITY OF PAMPA (6")
 - W1-10 --- WATER - CITY OF PAMPA (10")
 - WW1-01 --- SANITARY SEWER - CITY OF PAMPA
 - SD-01 --- STORM - CITY OF PAMPA
 - UNK --- UNKNOWN
 - UNK --- UNKNOWN
 - E1-01-D --- ELECTRIC-XCEL/SOUTHWEST PUBLIC SERVICE.CO
 - E3-01-D --- ELECTRIC - TXDOT
 - FOC1-01-D --- FIBER OPTIC - AT&T
 - T1-01-D --- TELEPHONE - AT&T
 - C1-01-D --- CABLE TV - CABLE ONE
 - G1-01-D --- GAS - ATMOS ENERGY
 - G2-01-D --- GAS - WEST TEXAS GAS
 - G2-03-D --- GAS - WEST TEXAS GAS (3")
 - G3-01-D --- GAS - UNKNOWN
 - W1-01-D --- WATER - CITY OF PAMPA (UNKNOWN SIZE)
 - W1-02-D --- WATER - CITY OF PAMPA (2")
 - W1-06-D --- WATER - CITY OF PAMPA (6")
 - W1-10-D --- WATER - CITY OF PAMPA (10")
 - W2-04-D --- WATER - TXDOT (4")
 - W3-2.5-D --- WATER - PRIVATE (2.5")
 - W4-04-D --- WATER - WESTERN EQUIPMENT (4")
 - WW1-01-D --- SANITARY SEWER - CITY OF PAMPA
 - WW2-03-D --- SANITARY SEWER - WESTERN EQUIPMENT (3")
 - SD-01-D --- STORM - CITY OF PAMPA
 - UNK --- UNKNOWN
- OVERHEAD
- OHT --- OVERHEAD ELECTRIC TRANSMISSION - XCEL/SOUTHWESTERN PUBLIC SERVICE CO
 - OE1 --- OVERHEAD ELECTRIC - XCEL ENERGY-SOUTHWESTERN PUBLIC SERVICE CO
 - OE1/FOC1/T1/C1 --- OVERHEAD ELEC/FOC/TEL/CATV - XCEL/AT&T/AT&T/CABLE ONE
 - OE1/FOC1 --- OVERHEAD ELEC/FOC/TEL - XCEL/AT&T
 - OE1/FOC1/T1 --- OVERHEAD ELEC/FOC/TEL - XCEL/AT&T/AT&T
 - OE1/T1 --- OVERHEAD ELEC/TEL - XCEL ENERGY/AT&T
 - OE1/T1/T1/C1/C1 --- OVERHEAD ELEC/TEL/TEL/CATV/CATV - XCEL/AT&T/AT&T/CABLE ONE/CABLE ONE
 - OE1/T1/T1/C1 --- OVERHEAD ELEC/TEL/TEL/CATV - XCEL/AT&T/AT&T/CABLE ONE
 - OE1/T1/C1 --- OVERHEAD ELEC/TEL/CATV - XCEL/AT&T/CABLE ONE
 - OE1/C1 --- OVERHEAD ELEC/CATV - XCEL ENERGY/CABLE ONE
 - OE1/C1 --- OVERHEAD ELEC/CATV - XCEL ENERGY/CABLE ONE
 - OFOC1 --- OVERHEAD FOC - AT&T
 - OT1 --- OVERHEAD TEL - AT&T
 - OFOC1/T1/C1 --- OVERHEAD TEL/FOC/CATV - AT&T/AT&T/CABLE ONE
 - OT1/C1 --- OVERHEAD TEL/CATV - AT&T/CABLE ONE
 - OC1 --- OVERHEAD CATV - CABLE ONE

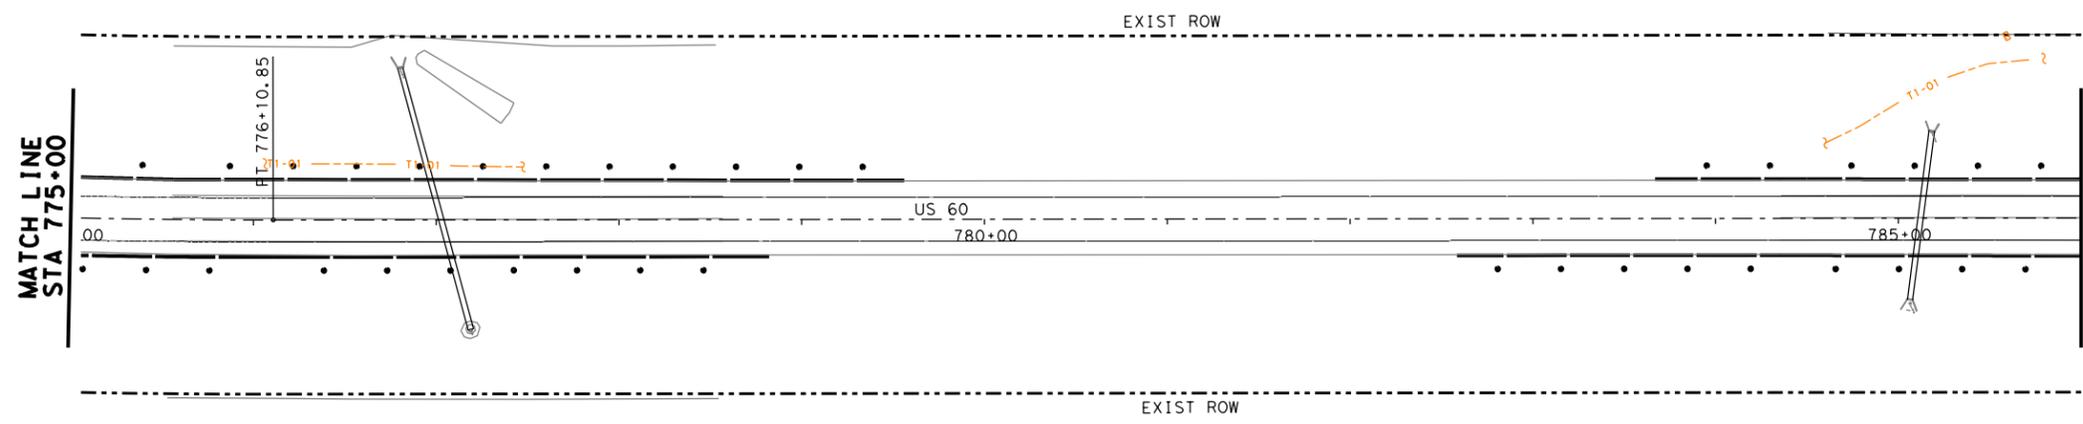

SUE RESEARCH ONLY PERFORMED IN AREAS WITH PROPOSED DRAINAGE.

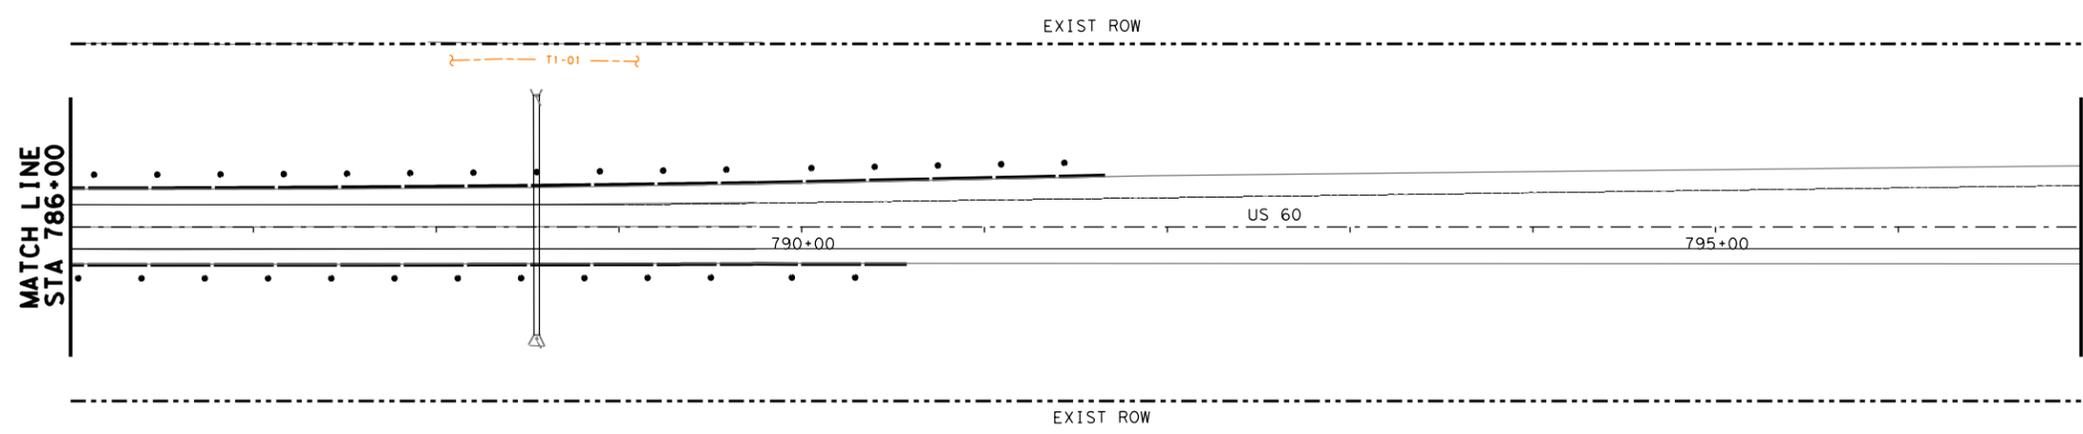


SUE RESEARCH ONLY PERFORMED IN AREAS WITH PROPOSED DRAINAGE.



T.E.H. 4/2/2021

REV. NO.	DATE	DESCRIPTION	BY

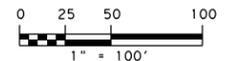

CobbFendley 13430 Northwest Freeway, Ste. 1100
Houston, Texas 77040
713.462.3242
www.cobbhendley.com




US 60
EXISTING UTILITY PLAN
STA 775+00 TO STA 797+00
SHEET 34 OF 36

FED. RD. DIV. NO.	STATE	PROJECT NO.	HIGHWAY NO.		
6	TEXAS	SEE TITLE SHEET	US 60		
STATE DISTRICT	COUNTY	CONTROL NO.	SECTION NO.	JOB NO.	SHEET NO.
AMA	GRAY	0619	07	053, ETC	172

4/2/2021 F:\P\Proj\2019\1004_TxDOT_5x5_PSE\03_US60_Amarillo\ING500\UST\N\506-SUE\02-Sheet\34-US60-SUE-34.dgn 9:46:05 AM


NOTES:
1. THE EXISTENCE AND LOCATION OF UTILITIES INDICATED ON THE PLANS ARE TAKEN FROM FIELD INVESTIGATION, THE BEST RECORDS AVAILABLE, AND ARE APPROXIMATED. THE CONTRACTOR SHALL LOCATE ALL UTILITIES (PUBLIC OR PRIVATE, SHOWN HERE OR NOT SHOWN) BOTH VERTICALLY AND HORIZONTALLY PRIOR TO COMMENCING WORK, WHETHER UTILITIES ARE ANTICIPATED TO BE IN DIRECT CONFLICT WITH PROPOSED WORK ACTIVITIES OR NOT. THE CONTRACTOR IS FULLY RESPONSIBLE FOR ANY DAMAGES CAUSED BY THE FAILURE TO LOCATE, PRESERVE, OR PROTECT THESE UTILITIES.
2. ALL WORK ACTIVITIES (INCLUDING BUT NOT LIMITED TO CONSTRUCTING DETOURS, CULVERT EXTENSION AND REPLACEMENTS, EXCAVATION, DITCH GRADING, ETC.) SHALL NOT COMMENCE UNTIL ALL UTILITIES, ESPECIALLY UTILITIES WITHIN EXISTING ROW AND PARALLEL TO US 60, ARE IDENTIFIED. IF CONFLICTS WITH PROPOSED CONSTRUCTION OR WORK ACTIVITIES ARE IDENTIFIED, CONTRACTOR IS TO CEASE WORK IN THE LOCATION OF THE CONFLICT IMMEDIATELY.

- LEGEND**
- ⊗ TELEPHONE POLE
 - ⊗ POWER POLE
 - ⊗ ELECTRIC PULLBOX
 - ⊗ ELECTRIC METER
 - ⊗ ELECTRIC SWITCH
 - ⊗ ELECTRIC STREET LIGHT
 - ⊗ ELECTRIC LANDSCAPE LIGHT
 - ⊗ ELECTRIC TRAFFIC SIGNAL
 - ⊗ ELECTRIC TRAFFIC SWITCH BOX
 - ⊗ ELECTRIC CABINET
 - ⊗ ELECTRIC MARKER
 - ⊗ TELEPHONE PEDESTAL
 - ⊗ TELEPHONE MANHOLE
 - ⊗ TELEPHONE MARKER
 - ⊗ VIDEO-READY ACCESS DEVICE
 - ⊗ FIBER OPTIC PULLBOX
 - ⊗ FIBER OPTIC MARKER
 - ⊗ FIBER OPTIC TEST STATION
 - ⊗ GAS METER
 - ⊗ GAS MARKER
 - ⊗ GAS REGULATOR
 - ⊗ GAS TEST STATION
 - ⊗ GAS VALVE
 - ⊗ GAS VENT
 - ⊗ WATER MANHOLE
 - ⊗ WATER MARKER
 - ⊗ WATER TEST STATION
 - ⊗ WATER VALVE
- QL LEVEL B**
- E1-01 --- ELECTRIC-XCEL/SOUTHWEST PUBLIC SERVICE.CO
 - E3-01 --- ELECTRIC - TXDOT
 - FOC1-01 --- FIBER OPTIC - AT&T
 - FOC2-01 --- FIBER OPTIC - DOBSON FIBER CO
 - T1-01 --- TELEPHONE - AT&T
 - C1-01 --- CABLE TV - CABLE ONE
 - G1-01 --- GAS - ATMOS ENERGY
 - G1-02 --- GAS - ATMOS ENERGY (2")
 - G3-01 --- GAS - UNKNOWN
 - G4-01 --- GAS - AMARILLO NATURAL GAS
 - W1-01 --- WATER - CITY OF PAMPA
 - W1-06 --- WATER - CITY OF PAMPA (6")
 - W1-10 --- WATER - CITY OF PAMPA (10")
 - WW1-01 --- SANITARY SEWER - CITY OF PAMPA
 - SD-01 --- STORM - CITY OF PAMPA
 - UNK --- UNKNOWN
 - UNK --- UNKNOWN
 - E1-01-D --- ELECTRIC-XCEL/SOUTHWEST PUBLIC SERVICE.CO
 - E3-01-D --- ELECTRIC - TXDOT
 - FOC1-01-D --- FIBER OPTIC - AT&T
 - T1-01-D --- TELEPHONE - AT&T
 - C1-01-D --- CABLE TV - CABLE ONE
 - G1-01-D --- GAS - ATMOS ENERGY
 - G2-01-D --- GAS - WEST TEXAS GAS
 - G2-03-D --- GAS - WEST TEXAS GAS (3")
 - G3-01-D --- GAS - UNKNOWN
 - W1-01-D --- WATER - CITY OF PAMPA (UNKNOWN SIZE)
 - W1-02-D --- WATER - CITY OF PAMPA (2")
 - W1-06-D --- WATER - CITY OF PAMPA (6")
 - W1-10-D --- WATER - CITY OF PAMPA (10")
 - W2-04-D --- WATER - TXDOT (4")
 - W3-2.5-D --- WATER - PRIVATE (2.5")
 - W4-04-D --- WATER - WESTERN EQUIPMENT (4")
 - WW1-01-D --- SANITARY SEWER - CITY OF PAMPA
 - WW2-03-D --- SANITARY SEWER - WESTERN EQUIPMENT (3")
 - SD-01-D --- STORM - CITY OF PAMPA
 - UNK --- UNKNOWN
- OVERHEAD**
- OHT --- OVERHEAD ELECTRIC TRANSMISSION - XCEL/SOUTHWESTERN PUBLIC SERVICE CO
 - OE1 --- OVERHEAD ELECTRIC - XCEL ENERGY-SOUTHWESTERN PUBLIC SERVICE CO
 - OE1/FOC1/T1/C1 --- OVERHEAD ELEC/FOC/TEL/CATV - XCEL/AT&T/AT&T/CABLE ONE
 - OE1/FOC1 --- OVERHEAD ELEC/FOC/TEL - XCEL/AT&T
 - OE1/FOC1/T1 --- OVERHEAD ELEC/FOC/TEL - XCEL/AT&T/AT&T
 - OE1/T1 --- OVERHEAD ELEC/TEL - XCEL ENERGY/AT&T
 - OE1/T1/T1/C1/C1 --- OVERHEAD ELEC/TEL/TEL/CATV/CATV - XCEL/AT&T/AT&T/CABLE ONE/CABLE ONE
 - OE1/T1/T1/C1 --- OVERHEAD ELEC/TEL/TEL/CATV - XCEL/AT&T/AT&T/CABLE ONE
 - OE1/T1/C1 --- OVERHEAD ELEC/TEL/CATV - XCEL/AT&T/CABLE ONE
 - OE1/C1 --- OVERHEAD ELEC/CATV - XCEL ENERGY/CABLE ONE
 - OE1/C1 --- OVERHEAD ELEC/CATV - XCEL ENERGY/CABLE ONE
 - OFOC1 --- OVERHEAD FOC - AT&T
 - OT1 --- OVERHEAD TEL - AT&T
 - OFOC1/T1/C1 --- OVERHEAD TEL/FOC/CATV - AT&T/AT&T/CABLE ONE
 - OT1/C1 --- OVERHEAD TEL/CATV - AT&T/CABLE ONE
 - OC1 --- OVERHEAD CATV - CABLE ONE

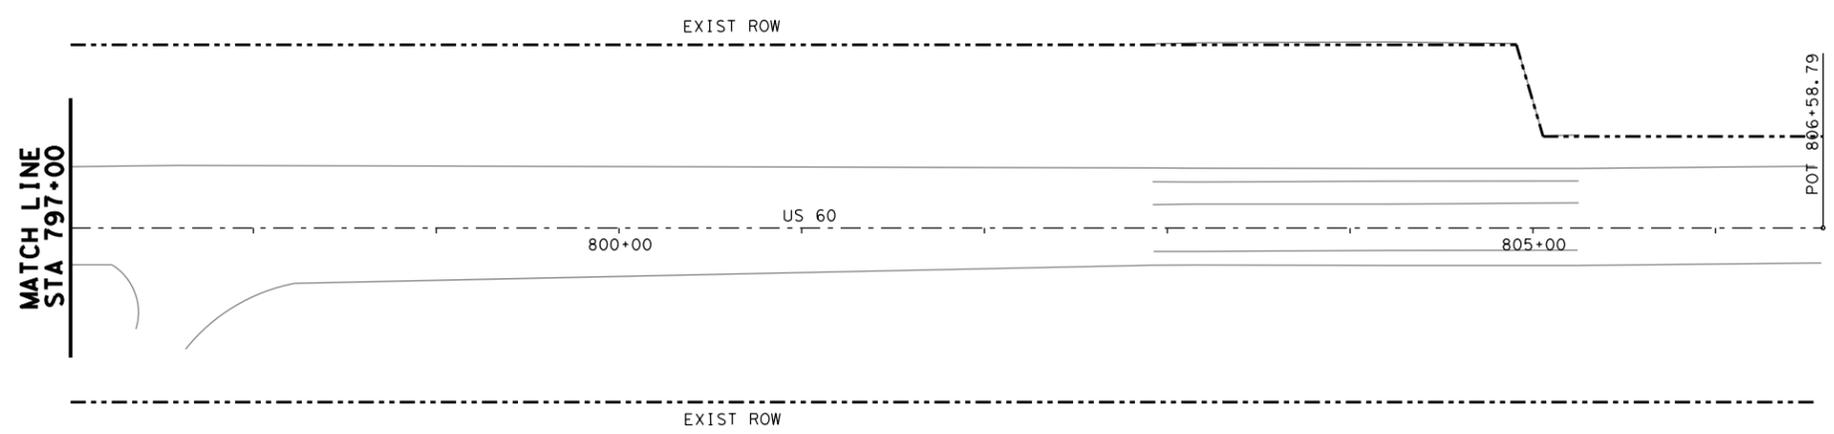

SUE RESEARCH NOT PERFORMED IN THIS AREA.
NO EXCAVATION WORK IS PLANNED IN THIS AREA.

MATCH LINE SHEET 15

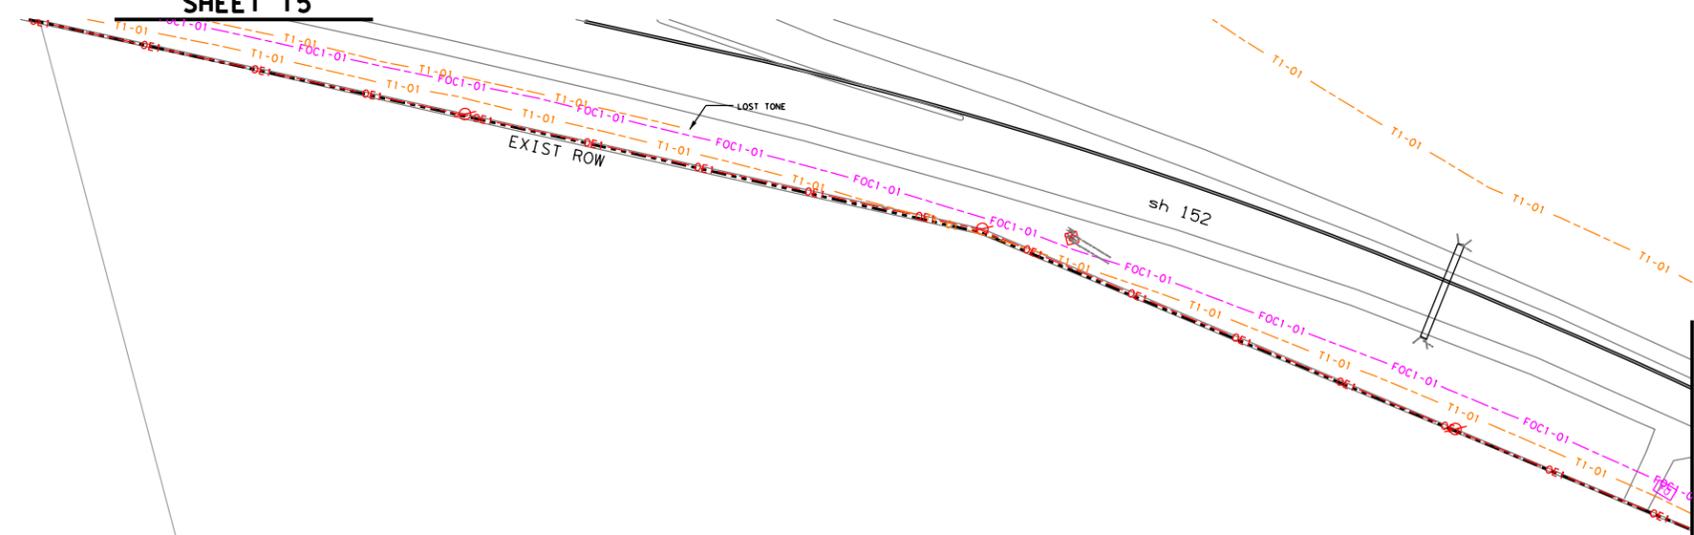

T.E. Hunt
4/2/2021

REV. NO.	DATE	DESCRIPTION	BY

0 25 50 100
1" = 100'

CobbFendley 13430 Northwest Freeway, Ste. 1100
Houston, Texas 77040
713.462.3242
www.cobbhendley.com



US 60
EXISTING UTILTIY PLANS
STA 797+00 TO STA 806+58.79
& SHEET 15
SHEET 35 OF 36

FED. RD. DIV. NO.	STATE	PROJECT NO.	HIGHWAY NO.		
6	TEXAS	SEE TITLE SHEET	US 60		
STATE DISTRICT	COUNTY	CONTROL NO.	SECTION NO.	JOB NO.	SHEET NO.
AMA	GRAY	0619	07	053, ETC	173


4/2/2021 9:46:05 AM F:\P\proj\2019\1004_TxDOT_5x5_P&S\US60_Amarillo\ENGIN\500\UST\N\506-SUE\02-Sheet\US60-SUE-35.dgn

NOTES:

- THE EXISTENCE AND LOCATION OF UTILITIES INDICATED ON THE PLANS ARE TAKEN FROM FIELD INVESTIGATION, THE BEST RECORDS AVAILABLE, AND ARE APPROXIMATED. THE CONTRACTOR SHALL LOCATE ALL UTILITIES (PUBLIC OR PRIVATE, SHOWN HERE OR NOT SHOWN) BOTH VERTICALLY AND HORIZONTALLY PRIOR TO COMMENCING WORK, WHETHER UTILITIES ARE ANTICIPATED TO BE IN DIRECT CONFLICT WITH PROPOSED WORK ACTIVITIES OR NOT. THE CONTRACTOR IS FULLY RESPONSIBLE FOR ANY DAMAGES CAUSED BY THE FAILURE TO LOCATE, PRESERVE, OR PROTECT THESE UTILITIES.
- ALL WORK ACTIVITIES (INCLUDING BUT NOT LIMITED TO CONSTRUCTING DETOURS, CULVERT EXTENSION AND REPLACEMENTS, EXCAVATION, DITCH GRADING, ETC.) SHALL NOT COMMENCE UNTIL ALL UTILITIES, ESPECIALLY UTILITIES WITHIN EXISTING ROW AND PARALLEL TO US 60, ARE IDENTIFIED. IF CONFLICTS WITH PROPOSED CONSTRUCTION OR WORK ACTIVITIES ARE IDENTIFIED, CONTRACTOR IS TO CEASE WORK IN THE LOCATION OF THE CONFLICT IMMEDIATELY.


MATCH LINE
SHEET 16

MATCH LINE
SHEET 35

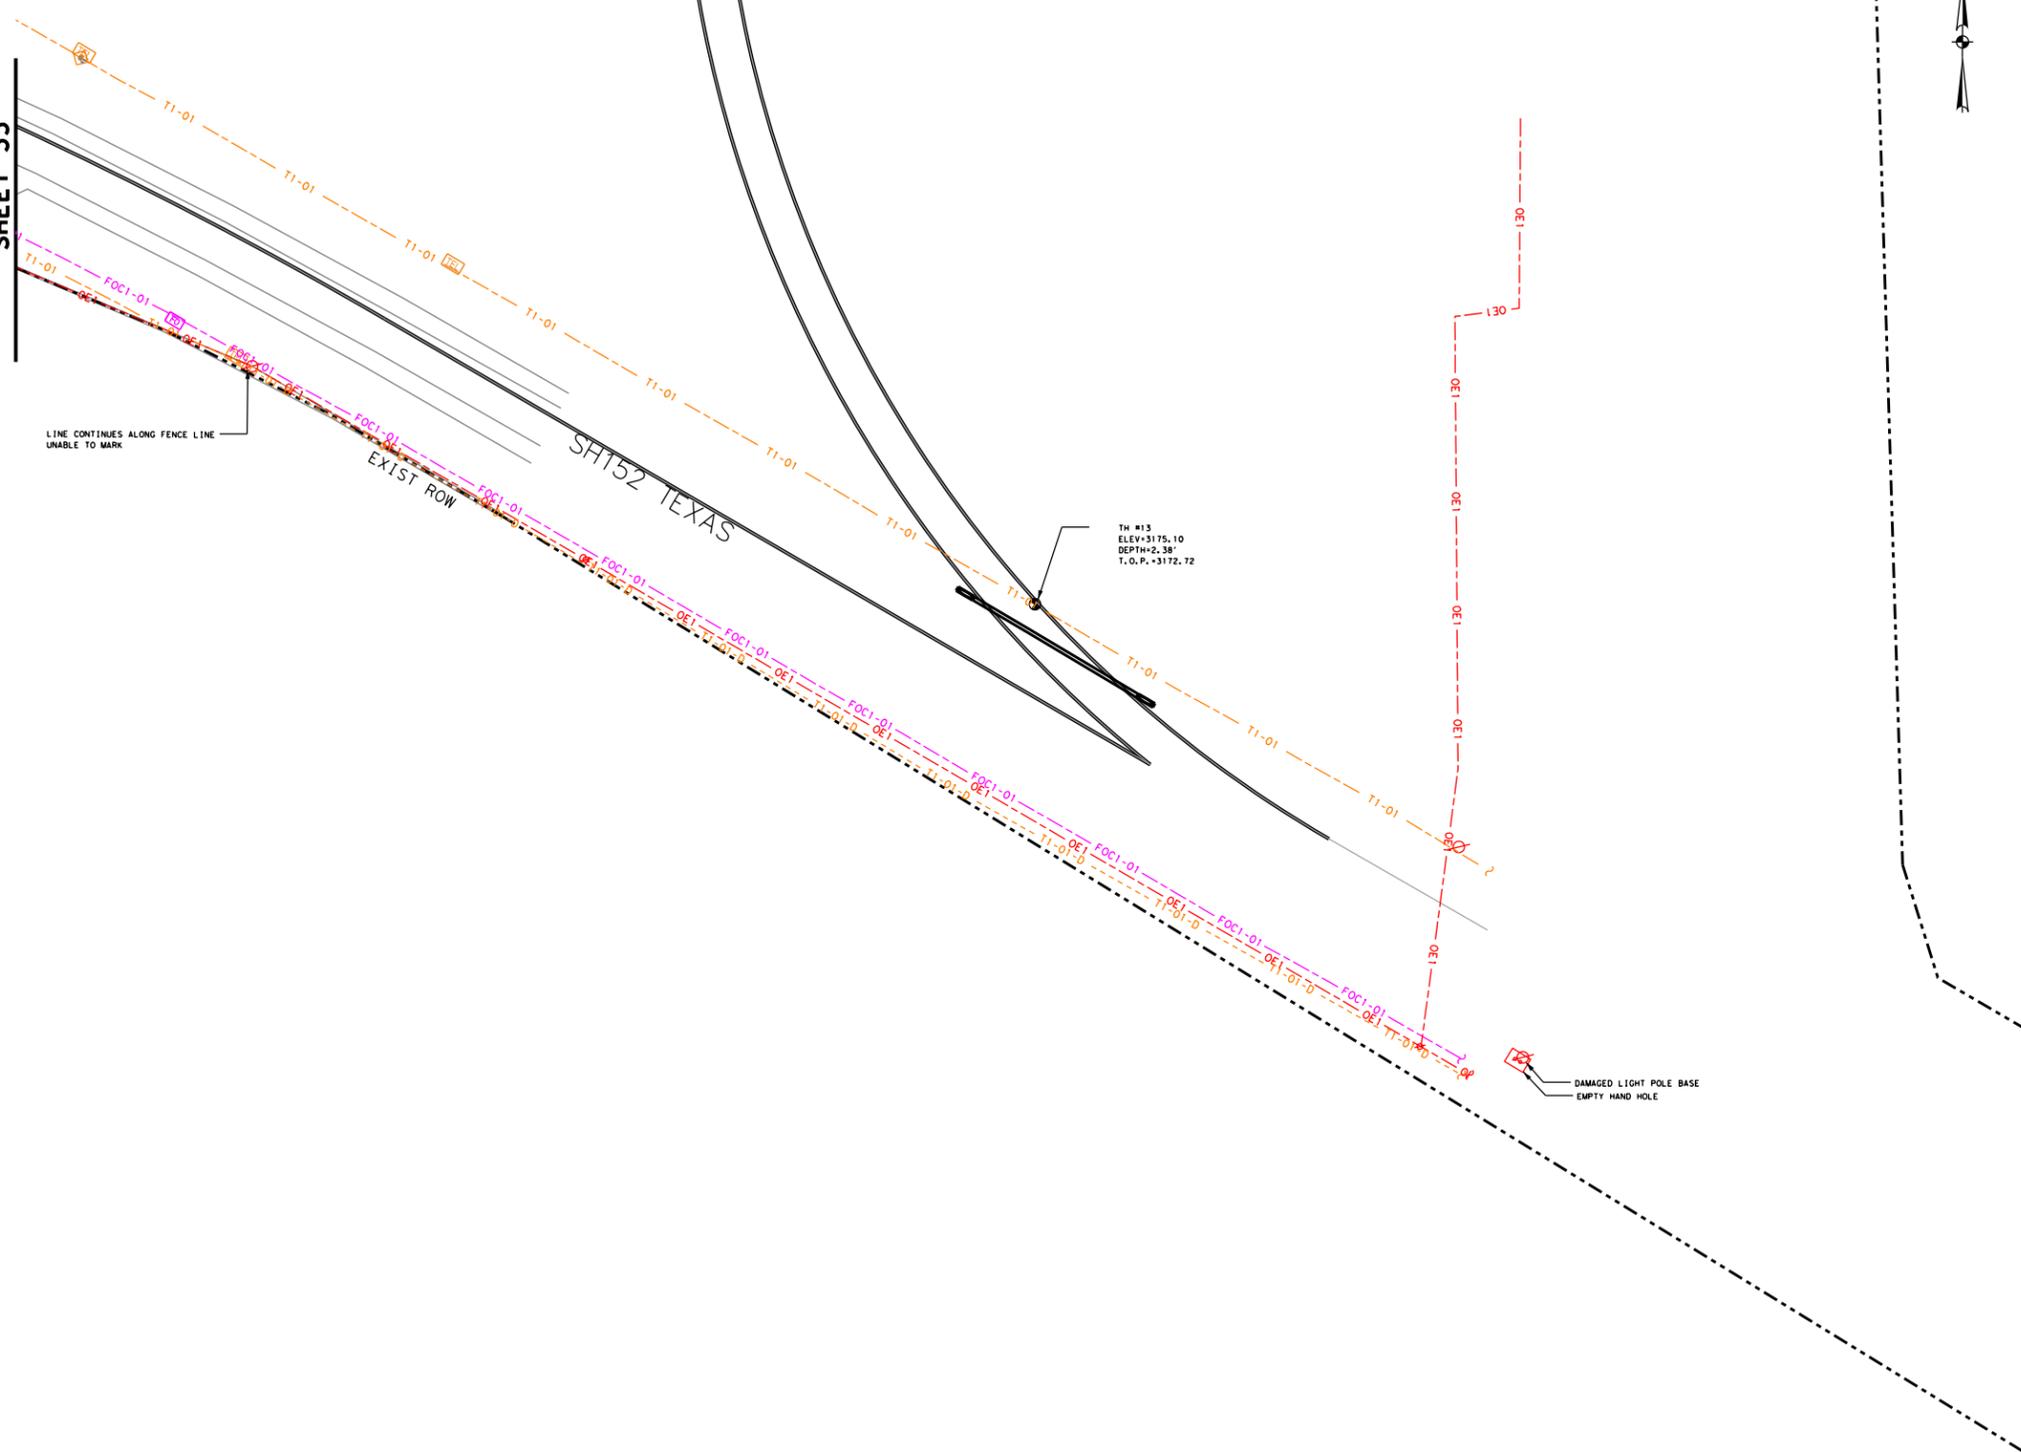

LEGEND

⊗ TELEPHONE POLE	⊗ POWER POLE	⊠ ELECTRIC PULLBOX	⊠ ELECTRIC METER	⊠ ELECTRIC SWITCH	⊠ ELECTRIC STREET LIGHT	⊠ ELECTRIC LANDSCAPE LIGHT	⊠ ELECTRIC TRAFFIC SIGNAL	⊠ ELECTRIC TRAFFIC SWITCH BOX	⊠ ELECTRIC CABINET	⊠ ELECTRIC MARKER	⊠ TELEPHONE PEDESTAL	⊠ TELEPHONE MANHOLE	⊠ TELEPHONE MARKER	⊠ VIDEO-READY ACCESS DEVICE	⊠ FIBER OPTIC PULLBOX	⊠ FIBER OPTIC MARKER	⊠ FIBER OPTIC TEST STATION	⊠ GAS METER	⊠ GAS MARKER	⊠ GAS REGULATOR	⊠ GAS TEST STATION	⊠ GAS VALVE	⊠ GAS VENT	⊠ WATER MANHOLE	⊠ WATER MARKER	⊠ WATER TEST STATION	⊠ WATER VALVE																																					
OL LEVEL B - E1-01	E3-01	FOC1-01	T1-01	C1-01	G1-01	G1-02	G3-01	G4-01	W1-01	W1-06	W1-10	WW1-01	SD-01	UNK	OL LEVEL D	E1-01-D	E3-01-D	FOC1-01-D	T1-01-D	C1-01-D	G1-01-D	G2-01-D	G2-03-D	G3-01-D	W1-01-D	W1-02-D	W1-06-D	W1-10-D	W2-04-D	W3-2.5-D	W4-04-D	WW1-01-D	WW2-03-D	SD-01-D	UNK																													
OVERHEAD	OHT	OE1	OE1/FOC1/T1/C1	OE1/FOC1	OE1/FOC1/T1	OE1/T1	OE1/T1/T1/C1	OE1/T1/C1	OE1/C1	FOC1	OT1	FOC1/T1/C1	OT1/C1	OC1	OVERHEAD ELECTRIC TRANSMISSION - XCEL/SOUTHWESTERN PUBLIC SERVICE CO	OVERHEAD ELECTRIC - XCEL ENERGY-SOUTHWESTERN PUBLIC SERVICE CO	OVERHEAD ELEC/FOC1/T1/C1 - XCEL/AT&T/AT&T/CABLE ONE	OVERHEAD ELEC/FOC1/TEL - XCEL/AT&T	OVERHEAD ELEC/FOC1/TEL - XCEL/AT&T/AT&T	OVERHEAD ELEC/TEL - XCEL ENERGY/AT&T	OVERHEAD ELEC/TEL/CATV/CATV - XCEL/AT&T/AT&T/CABLE ONE/CABLE ONE	OVERHEAD ELEC/TEL/TEL/CATV - XCEL/AT&T/AT&T/CABLE ONE	OVERHEAD ELEC/TEL/CATV - XCEL/AT&T/CABLE ONE	OVERHEAD ELEC/CATV - XCEL ENERGY/CABLE ONE	OVERHEAD ELEC/CATV - XCEL ENERGY/CABLE ONE	OVERHEAD TEL - AT&T	OVERHEAD TEL/FOC1/CATV - AT&T/AT&T/CABLE ONE	OVERHEAD TEL/CATV - AT&T/CABLE ONE	OVERHEAD CATV - CABLE ONE	OVERHEAD ELECTRIC - XCEL/SOUTHWESTERN PUBLIC SERVICE CO	ELECTRIC - TXDOT	FIBER OPTIC - AT&T	TELEPHONE - AT&T	CABLE TV - CABLE ONE	GAS - ATMOS ENERGY	GAS - ATMOS ENERGY (2")	GAS - UNKNOWN	GAS - AMARILLO NATURAL GAS	WATER - CITY OF PAMPA	WATER - CITY OF PAMPA (6")	WATER - CITY OF PAMPA (10")	SANITARY SEWER - CITY OF PAMPA	STORM - CITY OF PAMPA	UNKNOWN	ELECTRIC - XCEL/SOUTHWESTERN PUBLIC SERVICE CO	ELECTRIC - TXDOT	FIBER OPTIC - AT&T	TELEPHONE - AT&T	CABLE TV - CABLE ONE	GAS - ATMOS ENERGY	GAS - WEST TEXAS GAS	GAS - WEST TEXAS GAS (3")	GAS - UNKNOWN	WATER - CITY OF PAMPA (UNKNOWN SIZE)	WATER - CITY OF PAMPA (2")	WATER - CITY OF PAMPA (6")	WATER - CITY OF PAMPA (10")	WATER - TXDOT (4")	WATER - PRIVATE (2.5")	WATER - WESTERN EQUIPMENT (4")	SANITARY SEWER - CITY OF PAMPA	SANITARY SEWER - WESTERN EQUIPMENT (3")	STORM - CITY OF PAMPA	UNKNOWN

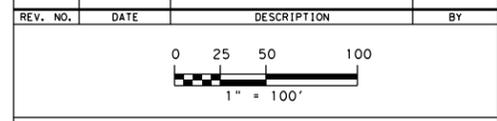

CobbFendley 13430 Northwest Freeway, Ste. 1100
Houston, Texas 77040
713.462.3242
www.cobbhendley.com



US 60
EXISTING UTILITY PLANS
SHEET 35 & SHEET 16

FED. RD. DIV. NO.	STATE	PROJECT NO.	HIGHWAY NO.		
6	TEXAS	SEE TITLE SHEET	US 60		
STATE DISTRICT	COUNTY	CONTROL NO.	SECTION NO.	JOB NO.	SHEET NO.
AMA	GRAY	0619	07	053, ETC	174

4/12/2021 9:46:06 AM F:\P\proj\2019\1004_TxDOT_5x5_PSS&E\03_US60_Amrt\10\EN\500-UST\N\506-SUE\02-Sheet\US60-SUE-36.dgn

NOTES:

- THE EXISTENCE AND LOCATION OF UTILITIES INDICATED ON THE PLANS ARE TAKEN FROM FIELD INVESTIGATION, THE BEST RECORDS AVAILABLE, AND ARE APPROXIMATED. THE CONTRACTOR SHALL LOCATE ALL UTILITIES (PUBLIC OR PRIVATE, SHOWN HERE OR NOT SHOWN) BOTH VERTICALLY AND HORIZONTALLY PRIOR TO COMMENCING WORK, WHETHER UTILITIES ARE ANTICIPATED TO BE IN DIRECT CONFLICT WITH PROPOSED WORK ACTIVITIES OR NOT. THE CONTRACTOR IS FULLY RESPONSIBLE FOR ANY DAMAGES CAUSED BY THE FAILURE TO LOCATE, PRESERVE, OR PROTECT THESE UTILITIES.
- ALL WORK ACTIVITIES (INCLUDING BUT NOT LIMITED TO CONSTRUCTING DETOURS, CULVERT EXTENSION AND REPLACEMENTS, EXCAVATION, DITCH GRADING, ETC.) SHALL NOT COMMENCE UNTIL ALL UTILITIES, ESPECIALLY UTILITIES WITHIN EXISTING ROW AND PARALLEL TO US 60, ARE IDENTIFIED. IF CONFLICTS WITH PROPOSED CONSTRUCTION OR WORK ACTIVITIES ARE IDENTIFIED, CONTRACTOR IS TO CEASE WORK IN THE LOCATION OF THE CONFLICT IMMEDIATELY.

SUMMARY OF SMALL SIGNS

DISCLAIMER: The use of this standard is governed by the "Texas Engineering Practice Act". No warranty of any kind is made by TxDOT for any purpose whatsoever. TxDOT assumes no responsibility for the conversion of this standard to other formats or for incorrect results or damages resulting from its use.

DATE: FILE:

PLAN SHEET NO.	SIGN NO.	SIGN NOMENCLATURE	SIGN	DIMENSIONS	FLAT ALUMINUM (TYPE A)	EXAL ALUMINUM (TYPE G)	SM RD SGN ASSM TY XXXXX (X) XX (X-XXXX)				BRIDGE MOUNT CLEARANCE SIGNS (See Note 2)	
							POST TYPE	POSTS	ANCHOR TYPE	MOUNTING DESIGNATION		
										PREFABRICATED		1EXT or 2EXT = # of Ext BM = Extruded Wind Beam WC = 1.12 #/ft Wing Channel EXAL= Extruded Alum Sign Panels
		M1-4		24 x 24								
	2	M1-6T		24 x 24								
		I-2aT		30 x 24								
		D10-7aT		3 x 10								
		R1-1		36 x 36								
3	5	I-2aT		30 x 24								
	6	R2-1		30 x 36								
	7	D3-2	 (BROWN BACKGROUND)	36 x 30								
	8	M2-1		21 x 15								
M1-6L			24 x 24									
4	1	D1-3		66 x 36								
	2	R2-1		30 x 36								

ALUMINUM SIGN BLANKS THICKNESS	
Square Feet	Minimum Thickness
Less than 7.5	0.100"
7.5 or Greater	0.125"

The Standard Highway Sign Designs for Texas (SHSD) can be found at the following website:
<http://www.txdot.gov/>

- NOTE:**
- Sign supports shall be located as shown on the plans, except that the Engineer may shift the sign supports, within design guidelines, where necessary to secure a more desirable location or to avoid conflict with utilities. Unless otherwise shown on the plans, the Contractor shall stake and the Engineer will verify all sign support locations.
 - For installation of bridge mount clearance signs, see Bridge Mounted Clearance Sign Assembly (BMCS) Standard Sheet.
 - For Sign Support Descriptive Codes, see Sign Mounting Details Small Roadside Signs General Notes & Details SMD(GEN).



SUMMARY OF SMALL SIGNS

SOSS

FILE: slums16.dgn	DN: TxDOT	CK: TxDOT	DW: TxDOT	CR: TxDOT
© TxDOT May 1987	CONT	SECT	JOB	HIGHWAY
REVISIONS	0169	07	053, ETC	US60
4-16	DIST	COUNTY	SHEET NO.	
8-16	AMA	GRAY	175	

SUMMARY OF SMALL SIGNS

DISCLAIMER: The use of this standard is governed by the "Texas Engineering Practice Act". No warranty of any kind is made by TxDOT for any purpose whatsoever. TxDOT assumes no responsibility for the conversion of this standard to other formats or for incorrect results or damages resulting from its use.

DATE: FILE:

PLAN SHEET NO.	SIGN NO.	SIGN NOMENCLATURE	SIGN	DIMENSIONS	FLAT ALUMINUM (TYPE A)	EXAL ALUMINUM (TYPE G)	SM RD SGN ASSM TY XXXXX (X) XX (X-XXXX)				BRIDGE MOUNT CLEARANCE SIGNS (See Note 2)	
							POST TYPE	POSTS	ANCHOR TYPE	MOUNTING DESIGNATION		
										PREFABRICATED		1EXT or 2EXT = # of Ext BM = Extruded Wind Beam WC = 1.12 #/ft Wing Channel EXAL= Extruded Alum Sign Panels
							FRP = Fiberglass TWT = Thin-Wall 10BWG = 10 BWG S80 = Sch 80	1 or 2	UA=Universal Conc UB=Universal Bolt SA=Slipbase-Conc SB=Slipbase-Bolt WS=Wedge Steel WP=Wedge Plastic	P = "Plain" T = "T" U = "U"	TY = TYPE TY N TY S	
4	3	R3-7R		36 x 36				10BWG	1	SA	T	
	6	D20-1TR		24 x 24				10BWG	1	SA	T	
6	1	D21-1TR		VAR x 12				10BWG	1	SA	T	
	2	R2-1		30 x 36				10BWG	1	SA	T	
	3	R2-1		30 x 36				10BWG	1	SA	T	
	4	D21-1TL		72 x 12				10BWG	1	SA	T	
	5	D15-10T		54 x 42				10BWG	1	SA	T	
	6	W17-9T		78 x 24				10BWG	1	SA	T	
7	1	R2-1		30 x 36				10BWG	1	SA	T	
	2	R2-1		30 x 36				10BWG	1	SA	T	
9	1	D20-1TL		24 x 24				10BWG	1	SA	T	
	3	D20-1TR		24 x 24				10BWG	1	SA	T	

ALUMINUM SIGN BLANKS THICKNESS	
Square Feet	Minimum Thickness
Less than 7.5	0.100"
7.5 or Greater	0.125"

The Standard Highway Sign Designs for Texas (SHSD) can be found at the following website.
<http://www.txdot.gov/>

- NOTE:**
- Sign supports shall be located as shown on the plans, except that the Engineer may shift the sign supports, within design guidelines, where necessary to secure a more desirable location or to avoid conflict with utilities. Unless otherwise shown on the plans, the Contractor shall stake and the Engineer will verify all sign support locations.
 - For installation of bridge mount clearance signs, see Bridge Mounted Clearance Sign Assembly (BMCS) Standard Sheet.
 - For Sign Support Descriptive Codes, see Sign Mounting Details Small Roadside Signs General Notes & Details SMD(GEN).



SUMMARY OF SMALL SIGNS


SOSS

FILE: slums16.dgn	DN: TxDOT	CK: TxDOT	DW: TxDOT	CK: TxDOT
© TxDOT May 1987	CONT	SECT	JOB	HIGHWAY
REVISIONS	0169	07	053, ETC	US60
4-16	DIST	COUNTY	SHEET NO.	
8-16	AMA	GRAY	176	

SUMMARY OF SMALL SIGNS

DISCLAIMER: The use of this standard is governed by the "Texas Engineering Practice Act". No warranty of any kind is made by TxDOT for any purpose whatsoever. TxDOT assumes no responsibility for the conversion of this standard to other formats or for incorrect results or damages resulting from its use.

DATE: FILE:

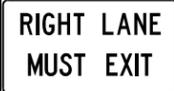PLAN SHEET NO.	SIGN NO.	SIGN NOMENCLATURE	SIGN	DIMENSIONS	FLAT ALUMINUM (TYPE A)	EXAL ALUMINUM (TYPE G)	SM RD SGN ASSM TY XXXXX (X) XX (X-XXXX)				BRIDGE MOUNT CLEARANCE SIGNS (See Note 2)	
							POST TYPE	POSTS	ANCHOR TYPE	MOUNTING DESIGNATION		
										PREFABRICATED		1EXT or 2EXT = # of Ext BM = Extruded Wind Beam WC = 1.12 #/ft Wing Channel EXAL= Extruded Alum Sign Panels
							FRP = Fiberglass TWT = Thin-Wall 10BWG = 10 BWG S80 = Sch 80	1 or 2	UA=Universal Conc UB=Universal Bolt SA=Slipbase-Conc SB=Slipbase-Bolt WS=Wedge Steel WP=Wedge Plastic	P = "Plain" T = "T" U = "U"	TY = TYPE TY N TY S	
9	4	R3-7R		36 x 36			10BWG	1	SA	T		
10	1	D21-1TL		78 x 12			10BWG	1	SA	T		
	2	D20-3TR		24 x 24			10BWG	1	SA	T		
11	4	R4-3		24 x 30			10BWG	1	SA	T		
12	1	W9-2TL		36 x 36			10BWG	1	SA	T		
	2	W9-1R		36 x 36			10BWG	1	SA	T		
	3	M1-4		24 x 24								
		M1-6T		24 x 24			10BWG	1	SA	P		
		D10-7aT		3 x 10								
13	1	W17-9T		78 x 24			10BWG	1	SA	T		
	2	R3-33R		78 x 36			10BWG	1	SA	T		
	3	D8-1T		60 x 48			S80	1	SA	T		

ALUMINUM SIGN BLANKS THICKNESS	
Square Feet	Minimum Thickness
Less than 7.5	0.100"
7.5 or Greater	0.125"

The Standard Highway Sign Designs for Texas (SHSD) can be found at the following website:
<http://www.txdot.gov/>

- NOTE:**
- Sign supports shall be located as shown on the plans, except that the Engineer may shift the sign supports, within design guidelines, where necessary to secure a more desirable location or to avoid conflict with utilities. Unless otherwise shown on the plans, the Contractor shall stake and the Engineer will verify all sign support locations.
 - For installation of bridge mount clearance signs, see Bridge Mounted Clearance Sign Assembly (BMCS) Standard Sheet.
 - For Sign Support Descriptive Codes, see Sign Mounting Details Small Roadside Signs General Notes & Details SMD(GEN).



SUMMARY OF SMALL SIGNS

SOSS

FILE: slums16.dgn	DN: TxDOT	CK: TxDOT	DW: TxDOT	CR: TxDOT
© TxDOT May 1987	CONT	SECT	JOB	HIGHWAY
REVISIONS	0169	07	053, ETC	US60
4-16	DIST	COUNTY	SHEET NO.	
8-16	AMA	GRAY	177	

SUMMARY OF SMALL SIGNS

DISCLAIMER: The use of this standard is governed by the "Texas Engineering Practice Act". No warranty of any kind is made by TxDOT for any purpose whatsoever. TxDOT assumes no responsibility for the conversion of this standard to other formats or for incorrect results or damages resulting from its use.

PLAN SHEET NO.	SIGN NO.	SIGN NOMENCLATURE	SIGN	DIMENSIONS	FLAT ALUMINUM (TYPE A)	EXAL ALUMINUM (TYPE G)	SM RD SGN ASSM TY XXXXX (X) XX (X-XXXX)				BRIDGE MOUNT CLEARANCE SIGNS (See Note 2)
							POST TYPE	POSTS	ANCHOR TYPE	MOUNTING DESIGNATION	
							FRP = Fiberglass TWT = Thin-Wall 10BWG = 10 BWG S80 = Sch 80	1 or 2	UA=Universal Conc UB=Universal Bolt SA=Slipbase-Conc SB=Slipbase-Bolt WS=Wedge Steel WP=Wedge Plastic	PREFABRICATED P = "Plain" T = "T" U = "U"	
14	1	M2-1		21 x 15			10BWG	1	SA	P	
		M1-6T		24 x 24							
	2	D20-1TL		24 x 24			10BWG	1	SA	T	
	3	D1-2		66 x 24			10BWG	1	SA	T	
	4	R1-1		36 x 36			10BWG	1	SA	T	
	6	R3-7R		36 x 36			10BWG	1	SA	T	
	7	D20-1TR		24 x 24			10BWG	1	SA	T	
15	1	D8-1aT		60 x 48			S80	1	SA	T	
	2	M3-2		24 x 12			10BWG	1	SA	U	
		M1-4		24 x 24							
		M6-3		21 x 15							
		M3-2		24 x 12							

ALUMINUM SIGN BLANKS THICKNESS	
Square Feet	Minimum Thickness
Less than 7.5	0.100"
7.5 or Greater	0.125"

The Standard Highway Sign Designs for Texas (SHSD) can be found at the following website:
<http://www.txdot.gov/>

- NOTE:**
- Sign supports shall be located as shown on the plans, except that the Engineer may shift the sign supports, within design guidelines, where necessary to secure a more desirable location or to avoid conflict with utilities. Unless otherwise shown on the plans, the Contractor shall stake and the Engineer will verify all sign support locations.
 - For installation of bridge mount clearance signs, see Bridge Mounted Clearance Sign Assembly (BMCS) Standard Sheet.
 - For Sign Support Descriptive Codes, see Sign Mounting Details Small Roadside Signs General Notes & Details SMD(GEN).



SUMMARY OF SMALL SIGNS

SOSS

FILE: slums16.dgn	DN: TxDOT	CK: TxDOT	DW: TxDOT	CR: TxDOT
© TxDOT May 1987	CONT	SECT	JOB	HIGHWAY
REVISIONS	0169	07	053, ETC	US60
4-16	DIST	COUNTY	SHEET NO.	
8-16	AMA	GRAY	178	

SUMMARY OF SMALL SIGNS

DISCLAIMER: The use of this standard is governed by the "Texas Engineering Practice Act". No warranty of any kind is made by TxDOT for any purpose whatsoever. TxDOT assumes no responsibility for the conversion of this standard to other formats or for incorrect results or damages resulting from its use.

DATE: FILE:

PLAN SHEET NO.	SIGN NO.	SIGN NOMENCLATURE	SIGN	DIMENSIONS	FLAT ALUMINUM (TYPE A)	EXAL ALUMINUM (TYPE G)	SM RD SGN ASSM TY XXXXX (X) XX (X-XXXX)				BRIDGE MOUNT CLEARANCE SIGNS (See Note 2)	
							POST TYPE	POSTS	ANCHOR TYPE	MOUNTING DESIGNATION		
										PREFABRICATED		1EXT or 2EXT = # of Ext BM = Extruded Wind Beam WC = 1.12 #/ft Wing Channel EXAL= Extruded Alum Sign Panels
		M1-6T		24 x 24			10BWG	1	SA	U		
	2	M6-2R		21 x 15								
	4	D20-1TL		24 x 24			10BWG	1	SA	T		
	5	R1-1		36 x 36			10BWG	1	SA	T		
	6	R1-2		48 x 48 x 48			10BWG	1	SA	T		
15		M3-2		24 x 12								
		M1-6T		24 x 24								
		M6-1		21 x 15								
		M3-4		24 x 12			S80	1	SA	U		
		M1-4		24 x 24								
		M1-6T		24 x 24								
		M6-3		21 x 15								

ALUMINUM SIGN BLANKS THICKNESS	
Square Feet	Minimum Thickness
Less than 7.5	0.100"
7.5 or Greater	0.125"

The Standard Highway Sign Designs for Texas (SHSD) can be found at the following website:
<http://www.txdot.gov/>

- NOTE:**
- Sign supports shall be located as shown on the plans, except that the Engineer may shift the sign supports, within design guidelines, where necessary to secure a more desirable location or to avoid conflict with utilities. Unless otherwise shown on the plans, the Contractor shall stake and the Engineer will verify all sign support locations.
 - For installation of bridge mount clearance signs, see Bridge Mounted Clearance Sign Assembly (BMCS) Standard Sheet.
 - For Sign Support Descriptive Codes, see Sign Mounting Details Small Roadside Signs General Notes & Details SMD(GEN).



SUMMARY OF SMALL SIGNS


SOSS

FILE: slums16.dgn	DN: TxDOT	CK: TxDOT	DW: TxDOT	CR: TxDOT
© TxDOT May 1987	CONT	SECT	JOB	HIGHWAY
REVISIONS	0169	07	053, ETC	US60
4-16	DIST	COUNTY	SHEET NO.	
8-16	AMA	GRAY	179	

SUMMARY OF SMALL SIGNS

DISCLAIMER: The use of this standard is governed by the "Texas Engineering Practice Act". No warranty of any kind is made by TxDOT for any purpose whatsoever. TxDOT assumes no responsibility for the conversion of this standard to other formats or for incorrect results or damages resulting from its use.

DATE: FILE:

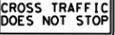PLAN SHEET NO.	SIGN NO.	SIGN NOMENCLATURE	SIGN	DIMENSIONS	FLAT ALUMINUM (TYPE A)	EXAL ALUMINUM (TYPE G)	SM RD SGN ASSM TY XXXXX (X) XX (X-XXXX)				BRIDGE MOUNT CLEARANCE SIGNS (See Note 2)		
							POST TYPE	POSTS	ANCHOR TYPE	MOUNTING DESIGNATION			
										PREFABRICATED		1EXT or 2EXT = # of Ext BM = Extruded Wind Beam WC = 1.12 #/ft Wing Channel EXAL= Extruded Alum Sign Panels	
	9	D1-2		66 x 24			10BWG	1	SA	T			
15	10	M2-1		21 x 15			10BWG	1	SA	P			
		M1-6T		24 x 24									
	11	D20-1TR		24 x 24			10BWG	1	SA	T			
	13	M3-2		24 x 12			10BWG	1	SA	P			
M1-4			24 x 24										
16	1	D15-10T		54 x 48			S80	1	SA	T			
	4	R1-1		36 x 36			10BWG	1	SA	P	BM		
		W4-4P		36 x 24									
	5	R4-3		24 x 30			10BWG	1	SA	P			
	6	R1-1		36 x 36			10BWG	1	SA	T			

ALUMINUM SIGN BLANKS THICKNESS	
Square Feet	Minimum Thickness
Less than 7.5	0.100"
7.5 or Greater	0.125"

The Standard Highway Sign Designs for Texas (SHSD) can be found at the following website.
<http://www.txdot.gov/>

- NOTE:**
- Sign supports shall be located as shown on the plans, except that the Engineer may shift the sign supports, within design guidelines, where necessary to secure a more desirable location or to avoid conflict with utilities. Unless otherwise shown on the plans, the Contractor shall stake and the Engineer will verify all sign support locations.
 - For installation of bridge mount clearance signs, see Bridge Mounted Clearance Sign Assembly (BMCS) Standard Sheet.
 - For Sign Support Descriptive Codes, see Sign Mounting Details Small Roadside Signs General Notes & Details SMD(GEN).



SUMMARY OF SMALL SIGNS


SOSS

FILE: slums16.dgn	DN: TxDOT	CK: TxDOT	DW: TxDOT	CR: TxDOT
© TxDOT May 1987	CONT	SECT	JOB	HIGHWAY
REVISIONS	0169	07	053, ETC	US60
4-16	DIST	COUNTY	SHEET NO.	
8-16	AMA	GRAY	180	

SUMMARY OF SMALL SIGNS

DISCLAIMER: The use of this standard is governed by the "Texas Engineering Practice Act". No warranty of any kind is made by TxDOT for any purpose whatsoever. TxDOT assumes no responsibility for the conversion of this standard to other formats or for incorrect results or damages resulting from its use.

DATE: FILE:

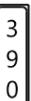PLAN SHEET NO.	SIGN NO.	SIGN NOMENCLATURE	SIGN	DIMENSIONS	FLAT ALUMINUM (TYPE A)	EXAL ALUMINUM (TYPE G)	SM RD SGN ASSM TY XXXXX (X) XX (X-XXXX)				BRIDGE MOUNT CLEARANCE SIGNS (See Note 2)	
							POST TYPE	POSTS	ANCHOR TYPE	MOUNTING DESIGNATION		
										PREFABRICATED		1EXT or 2EXT = # of Ext BM = Extruded Wind Beam WC = 1.12 #/ft Wing Channel EXAL= Extruded Alum Sign Panels
16	7	M2-1		21 x 15			10BWG	1	SA	P		
		M1-6F		24 x 24			10BWG	1	SA	P		
17	1	M1-6F		24 x 24			10BWG	1	SA	P		
		M6-4		21 x 15			10BWG	1	SA	P		
	2	M1-4		24 x 24			10BWG	1	SA	P		
		M6-4		21 x 15			10BWG	1	SA	P		
	3	M1-4		24 x 24			10BWG	1	SA	P		
		M6-4		21 x 15			10BWG	1	SA	P		
	4	M1-6F		24 x 24			10BWG	1	SA	P		
		M6-4		21 x 15			10BWG	1	SA	P		
	5	M1-4		24 x 24			10BWG	1	SA	P		
		D10-7aT		3 x 10								

ALUMINUM SIGN BLANKS THICKNESS	
Square Feet	Minimum Thickness
Less than 7.5	0.100"
7.5 or Greater	0.125"

The Standard Highway Sign Designs for Texas (SHSD) can be found at the following website:
<http://www.txdot.gov/>

- NOTE:**
- Sign supports shall be located as shown on the plans, except that the Engineer may shift the sign supports, within design guidelines, where necessary to secure a more desirable location or to avoid conflict with utilities. Unless otherwise shown on the plans, the Contractor shall stake and the Engineer will verify all sign support locations.
 - For installation of bridge mount clearance signs, see Bridge Mounted Clearance Sign Assembly (BMCS) Standard Sheet.
 - For Sign Support Descriptive Codes, see Sign Mounting Details Small Roadside Signs General Notes & Details SMD(GEN).



SUMMARY OF SMALL SIGNS



SOSS

FILE: slums16.dgn	DN: TxDOT	CK: TxDOT	DW: TxDOT	CR: TxDOT
© TxDOT May 1987	CONT	SECT	JOB	HIGHWAY
REVISIONS	0169	07	053, ETC	US60
4-16	DIST	COUNTY	SHEET NO.	
8-16	AMA	GRAY	181	

SUMMARY OF SMALL SIGNS

DISCLAIMER: The use of this standard is governed by the "Texas Engineering Practice Act". No warranty of any kind is made by TxDOT for any purpose whatsoever. TxDOT assumes no responsibility for the conversion of this standard to other formats or for incorrect results or damages resulting from its use.

DATE: FILE:

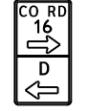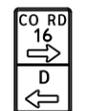PLAN SHEET NO.	SIGN NO.	SIGN NOMENCLATURE	SIGN	DIMENSIONS	FLAT ALUMINUM (TYPE A)	EXAL ALUMINUM (TYPE G)	SM RD SGN ASSM TY XXXXX (X) XX (X-XXXX)				BRIDGE MOUNT CLEARANCE SIGNS (See Note 2)	
							POST TYPE	POSTS	ANCHOR TYPE	MOUNTING DESIGNATION		
										PREFABRICATED		1EXT or 2EXT = # of Ext BM = Extruded Wind Beam WC = 1.12 #/ft Wing Channel EXAL= Extruded Alum Sign Panels
17	6	D8-1aT		60 x 48			S80	1	SA	T		
18	1	M2-1		21 x 15			10BWG	1	SA	P		
		M1-6F		24 x 24								
	2	D8-1T		60 x 48			S80	1	SA	T		
20	1	D20-5T		24 x 42			10BWG	1	SA	P		
	2	R1-1		36 x 36			10BWG	1	SA	T		
	3	R1-1		36 x 36			10BWG	1	SA	T		
	4	R1-1		36 x 36			10BWG	1	SA	T		
	5	D20-5T		24 x 42			10BWG	1	SA	P		
21	1	R4-3		24 x 30			10BWG	1	SA	P		
	2	D15-10T		54 x 48			S80	1	SA	T		
22	1	M1-4		24 x 24			10BWG	1	SA	P		

ALUMINUM SIGN BLANKS THICKNESS	
Square Feet	Minimum Thickness
Less than 7.5	0.100"
7.5 or Greater	0.125"

The Standard Highway Sign Designs for Texas (SHSD) can be found at the following website:
<http://www.txdot.gov/>

- NOTE:**
- Sign supports shall be located as shown on the plans, except that the Engineer may shift the sign supports, within design guidelines, where necessary to secure a more desirable location or to avoid conflict with utilities. Unless otherwise shown on the plans, the Contractor shall stake and the Engineer will verify all sign support locations.
 - For installation of bridge mount clearance signs, see Bridge Mounted Clearance Sign Assembly (BMCS) Standard Sheet.
 - For Sign Support Descriptive Codes, see Sign Mounting Details Small Roadside Signs General Notes & Details SMD(GEN).



SUMMARY OF SMALL SIGNS

SOSS

FILE: slums16.dgn	DN: TxDOT	CK: TxDOT	DW: TxDOT	CK: TxDOT
© TxDOT May 1987	CONT	SECT	JOB	HIGHWAY
REVISIONS	0169	07	053, ETC	US60
4-16	DIST	COUNTY	SHEET NO.	
8-16	AMA	GRAY	182	

SUMMARY OF SMALL SIGNS

DISCLAIMER: The use of this standard is governed by the "Texas Engineering Practice Act". No warranty of any kind is made by TxDOT for any purpose whatsoever. TxDOT assumes no responsibility for the conversion of this standard to other formats or for incorrect results or damages resulting from its use.

DATE: FILE:

PLAN SHEET NO.	SIGN NO.	SIGN NOMENCLATURE	SIGN	DIMENSIONS	FLAT ALUMINUM (TYPE A)	EXAL ALUMINUM (TYPE G)	SM RD SGN ASSM TY XXXXX (X) XX (X-XXXX)				BRIDGE MOUNT CLEARANCE SIGNS (See Note 2)			
							POST TYPE	POSTS	ANCHOR TYPE	MOUNTING DESIGNATION				
										PREFABRICATED		1EXT or 2EXT = # of Ext BM = Extruded Wind Beam WC = 1.12 #/ft Wing Channel EXAL= Extruded Alum Sign Panels		
							FRP = Fiberglass TWT = Thin-Wall 10BWG = 10 BWG S80 = Sch 80	1 or 2	UA=Universal Conc UB=Universal Bolt SA=Slipbase-Conc SB=Slipbase-Bolt WS=Wedge Steel WP=Wedge Plastic	P = "Plain" T = "T" U = "U"	TY = TYPE TY N TY S			
22	1	D10-7aT		3 x 10						10BWG	1	SA	P	
	2	D15-11T		54 x 48						S80	1	SA	T	
23	1	W9-1R		36 x 36						10BWG	1	SA	T	
	2	W9-2TL		36 x 36						10BWG	1	SA	T	
24	1	W9-2TL		36 x 36						10BWG	1	SA	T	
	2	W9-1R		36 x 36						10BWG	1	SA	T	
	3	D20-2T		24 x 24						10BWG	1	SA	T	
	4	R1-1		36 x 36						10BWG	1	SA	T	
	5	R1-1		36 x 36						10BWG	1	SA	T	
25	1	D20-2T		24 x 24						10BWG	1	SA	T	
	2	D15-10T		54 x 48						S80	1	SA	T	
	3	D20-1TR		24 x 24						10BWG	1	SA	T	

ALUMINUM SIGN BLANKS THICKNESS	
Square Feet	Minimum Thickness
Less than 7.5	0.100"
7.5 or Greater	0.125"

The Standard Highway Sign Designs for Texas (SHSD) can be found at the following website:
<http://www.txdot.gov/>

- NOTE:**
- Sign supports shall be located as shown on the plans, except that the Engineer may shift the sign supports, within design guidelines, where necessary to secure a more desirable location or to avoid conflict with utilities. Unless otherwise shown on the plans, the Contractor shall stake and the Engineer will verify all sign support locations.
 - For installation of bridge mount clearance signs, see Bridge Mounted Clearance Sign Assembly (BMCS) Standard Sheet.
 - For Sign Support Descriptive Codes, see Sign Mounting Details Small Roadside Signs General Notes & Details SMD(GEN).



SUMMARY OF SMALL SIGNS

SOSS

FILE: slums16.dgn	DN: TxDOT	CK: TxDOT	DW: TxDOT	CR: TxDOT
© TxDOT May 1987	CONT	SECT	JOB	HIGHWAY
REVISIONS	0169	07	053, ETC	US60
4-16	DIST	COUNTY	SHEET NO.	
8-16	AMA	GRAY	183	

SUMMARY OF SMALL SIGNS

DISCLAIMER: The use of this standard is governed by the "Texas Engineering Practice Act". No warranty of any kind is made by TxDOT for any purpose whatsoever. TxDOT assumes no responsibility for the conversion of this standard to other formats or for incorrect results or damages resulting from its use.

DATE: FILE:

PLAN SHEET NO.	SIGN NO.	SIGN NOMENCLATURE	SIGN	DIMENSIONS	FLAT ALUMINUM (TYPE A)	EXAL ALUMINUM (TYPE G)	SM RD SGN ASSM TY XXXXX (X) XX (X-XXXX)				BRIDGE MOUNT CLEARANCE SIGNS (See Note 2) TY = TYPE TY N TY S
							POST TYPE	POSTS	ANCHOR TYPE	MOUNTING DESIGNATION	
							FRP = Fiberglass TWT = Thin-Wall 10BWG = 10 BWG S80 = Sch 80	1 or 2	UA=Universal Conc UB=Universal Bolt SA=Slipbase-Conc SB=Slipbase-Bolt WS=Wedge Steel WP=Wedge Plastic	PREFABRICATED P = "Plain" T = "T" U = "U"	
26	1	R1-1		36 x 36			10BWG	1	SA	T	
	2	D20-1TL		24 x 24			10BWG	1	SA	T	
	3	R4-3		24 x 30			10BWG	1	SA	P	
27	1	R1-1		36 x 36			10BWG	1	SA	T	
	2	M1-4		24 x 24			10BWG	1	SA	P	
		D10-7aT		3 x 10							
28	1	D20-1TR		24 x 24			10BWG	1	SA	T	
	2	R1-1		36 x 36			10BWG	1	SA	T	
29	1	D20-1TL		24 x 24			10BWG	1	SA	T	
	2	D20-1TR		24 x 24			10BWG	1	SA	T	
	3	R1-1		36 x 36			10BWG	1	SA	T	
	4	D20-1TL		24 x 24			10BWG	1	SA	T	

ALUMINUM SIGN BLANKS THICKNESS	
Square Feet	Minimum Thickness
Less than 7.5	0.100"
7.5 or Greater	0.125"

The Standard Highway Sign Designs for Texas (SHSD) can be found at the following website.
<http://www.txdot.gov/>

- NOTE:**
- Sign supports shall be located as shown on the plans, except that the Engineer may shift the sign supports, within design guidelines, where necessary to secure a more desirable location or to avoid conflict with utilities. Unless otherwise shown on the plans, the Contractor shall stake and the Engineer will verify all sign support locations.
 - For installation of bridge mount clearance signs, see Bridge Mounted Clearance Sign Assembly (BMCS) Standard Sheet.
 - For Sign Support Descriptive Codes, see Sign Mounting Details Small Roadside Signs General Notes & Details SMD(GEN).



SUMMARY OF SMALL SIGNS


SOSS

FILE: slums16.dgn	DN: TxDOT	CK: TxDOT	DW: TxDOT	CR: TxDOT
© TxDOT May 1987	CONT	SECT	JOB	HIGHWAY
REVISIONS	0169	07	053, ETC	US60
4-16	DIST	COUNTY	SHEET NO.	
8-16	AMA	GRAY	184	

SUMMARY OF SMALL SIGNS

DISCLAIMER: The use of this standard is governed by the "Texas Engineering Practice Act". No warranty of any kind is made by TxDOT for any purpose whatsoever. TxDOT assumes no responsibility for the conversion of this standard to other formats or for incorrect results or damages resulting from its use.

DATE: FILE:

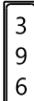PLAN SHEET NO.	SIGN NO.	SIGN NOMENCLATURE	SIGN	DIMENSIONS	FLAT ALUMINUM (TYPE A)	EXAL ALUMINUM (TYPE G)	SM RD SGN ASSM TY XXXXX (X) XX (X-XXXX)				BRIDGE MOUNT CLEARANCE SIGNS (See Note 2)	
							POST TYPE	POSTS	ANCHOR TYPE	MOUNTING DESIGNATION		
										PREFABRICATED		1EXT or 2EXT = # of Ext BM = Extruded Wind Beam WC = 1.12 #/ft Wing Channel EXAL= Extruded Alum Sign Panels
							FRP = Fiberglass TWT = Thin-Wall 10BWG = 10 BWG S80 = Sch 80	1 or 2	UA=Universal Conc UB=Universal Bolt SA=Slipbase-Conc SB=Slipbase-Bolt WS=Wedge Steel WP=Wedge Plastic	P = "Plain" T = "T" U = "U"	TY = TYPE TY N TY S	
30	1	R4-3		24 x 30				10BWG	1	SA	P	
31	1	D15-10T		54 x 48				S80	1	SA	T	
	2	W9-1R		36 x 36				10BWG	1	SA	T	
32	1	W9-2TL		36 x 36				10BWG	1	SA	T	
	2	M1-4		24 x 24				10BWG	1	SA	P	
		D10-7aT		3 x 10								
33	1	R2-1		30 x 36				10BWG	1	SA	T	
34	1	R4-1		24 x 30				10BWG	1	SA	P	
	2	D15-11T		54 x 48				S80	1	SA	T	
	3	D20-1TR		24 x 24				10BWG	1	SA	T	
35	2	D20-1TL		24 x 24				10BWG	1	SA	T	

ALUMINUM SIGN BLANKS THICKNESS	
Square Feet	Minimum Thickness
Less than 7.5	0.100"
7.5 or Greater	0.125"

The Standard Highway Sign Designs for Texas (SHSD) can be found at the following website.
<http://www.txdot.gov/>

- NOTE:**
- Sign supports shall be located as shown on the plans, except that the Engineer may shift the sign supports, within design guidelines, where necessary to secure a more desirable location or to avoid conflict with utilities. Unless otherwise shown on the plans, the Contractor shall stake and the Engineer will verify all sign support locations.
 - For installation of bridge mount clearance signs, see Bridge Mounted Clearance Sign Assembly (BMCS) Standard Sheet.
 - For Sign Support Descriptive Codes, see Sign Mounting Details Small Roadside Signs General Notes & Details SMD(GEN).




SUMMARY OF SMALL SIGNS

SOSS

FILE: slums16.dgn	DN: TxDOT	CK: TxDOT	DW: TxDOT	CR: TxDOT
© TxDOT May 1987	CONT	SECT	JOB	HIGHWAY
REVISIONS	0169	07	053, ETC	US60
4-16	DIST	COUNTY	SHEET NO.	
8-16	AMA	GRAY	185	

4/7/2021 7:27:46 AM F:\Projects\2019\1004_Traffic\560_Amari\16\US60-USTN\509-Traffic\02-Signing\US60_TRAF-SPM-01.dgn

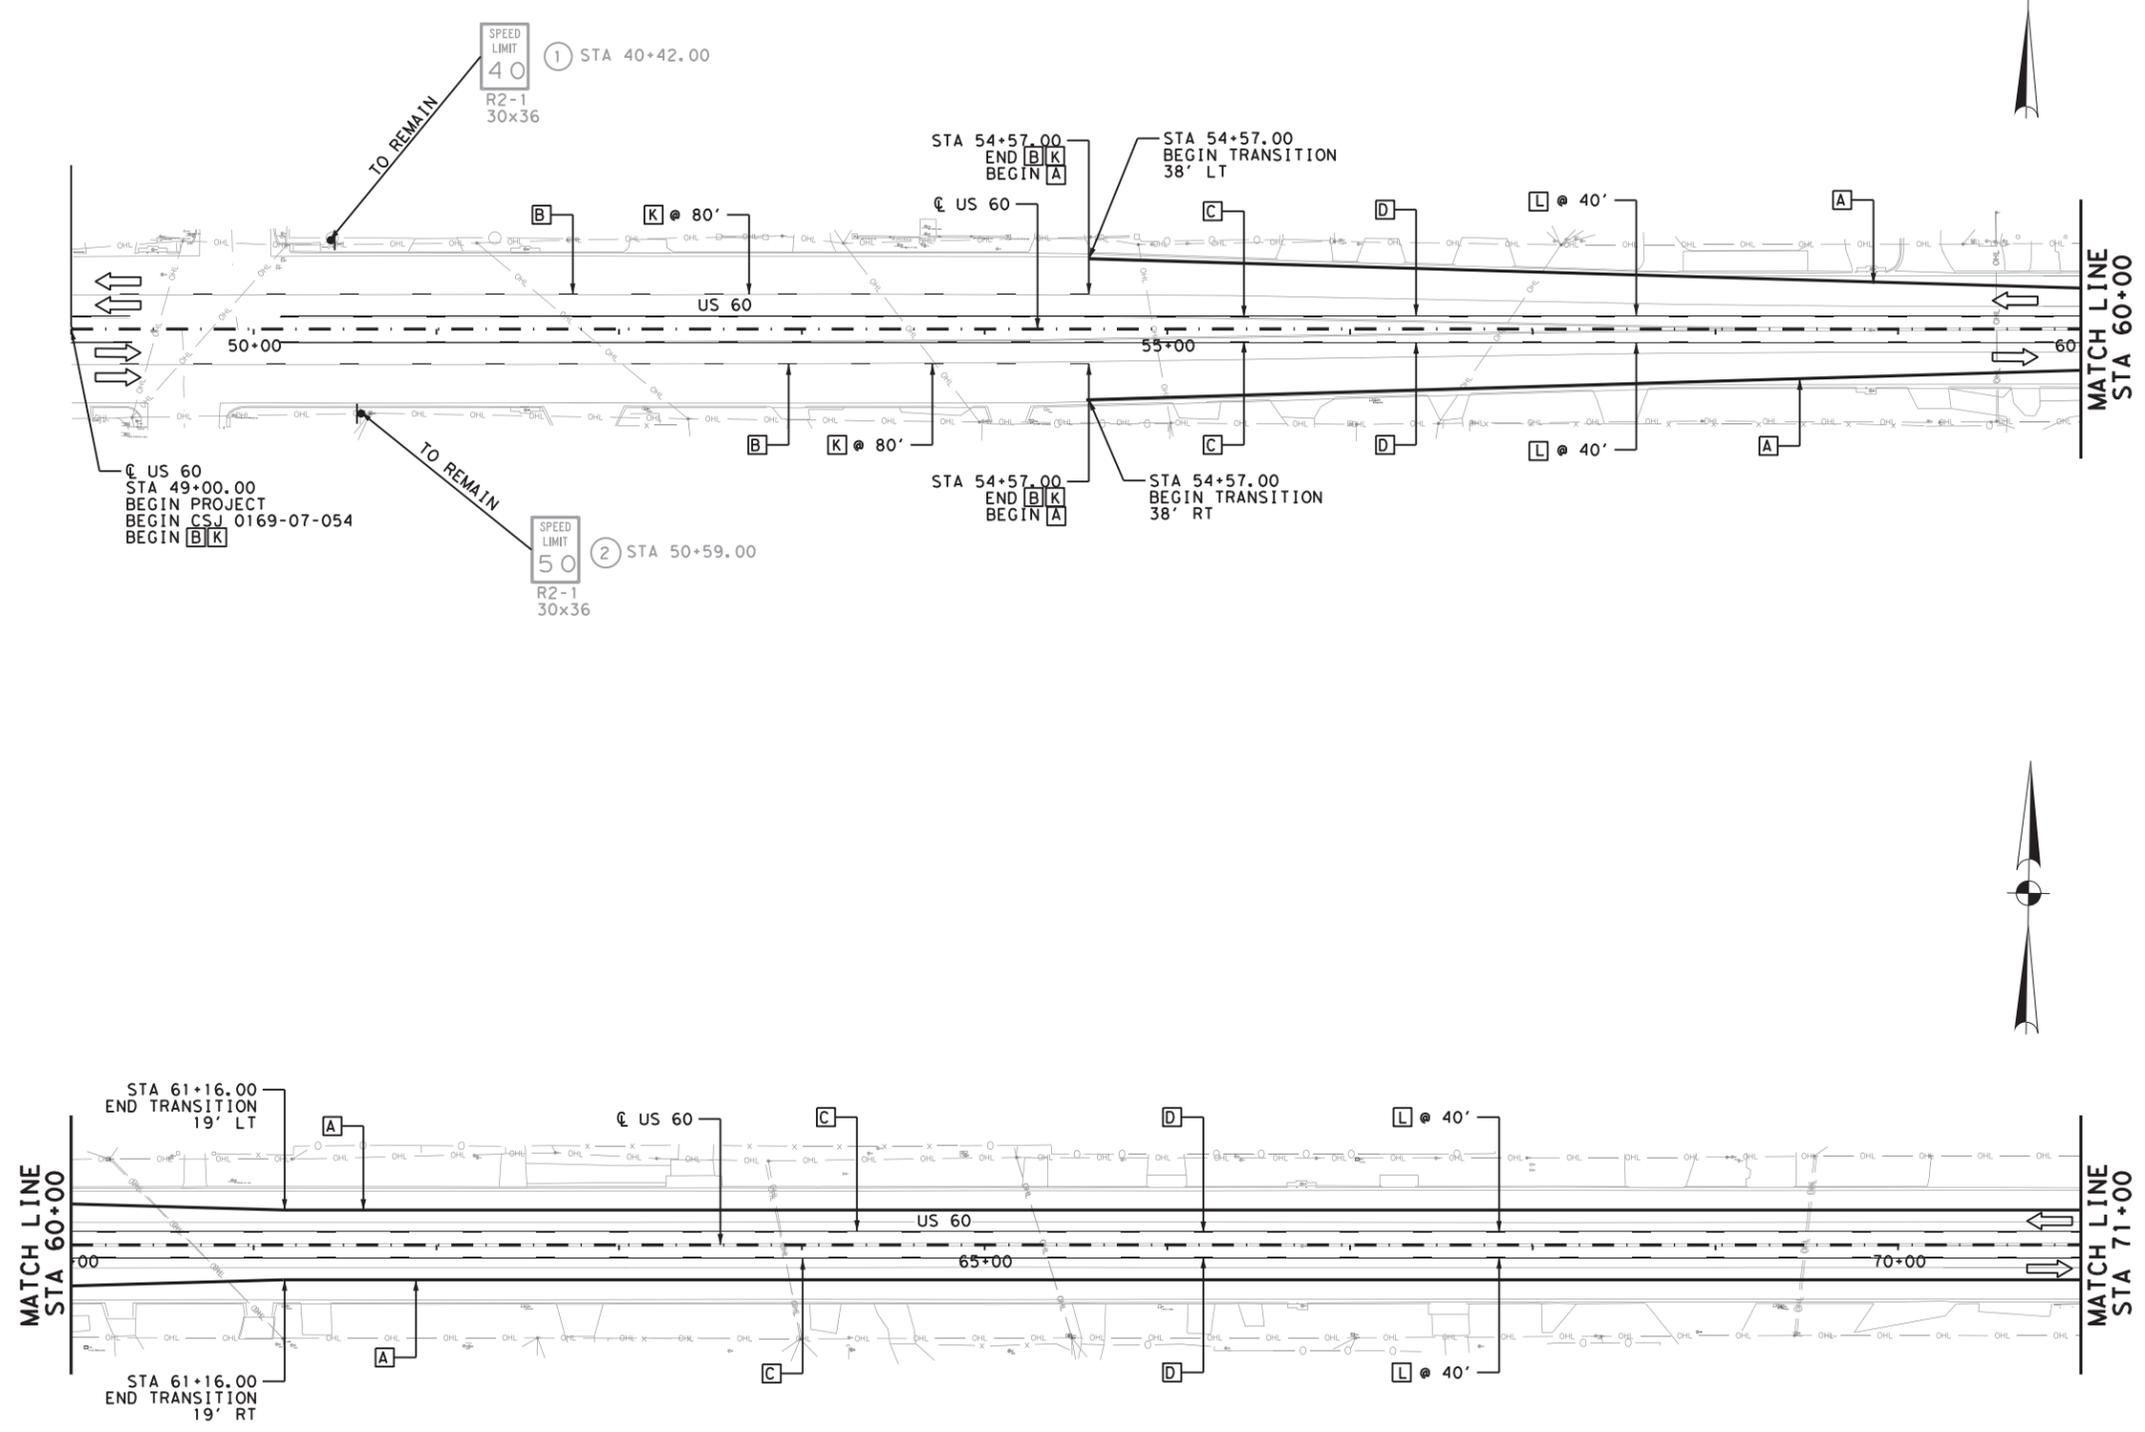

LEGEND

- A RE PM W/RET REQ TY I (W) 4" (SLD)
- B RE PM W/RET REQ TY I (W) 4" (BRK)
- C RE PM W/RET REQ TY I (Y) 4" (SLD)
- D RE PM W/RET REQ TY I (Y) 4" (BRK)
- E REFL PAV MRK TY I (W) 4" (DOT)
- F REFL PAV MRK TY I (W) 8" (SLD)
- G REFL PAV MRK TY I (W) 12" (SLD)
- H REFL PAV MRK TY I (W) 24" (SLD)
- I REFL PAV MRK TY I (Y) 24" (SLD)
- J REFL PAV MRK TY I (W) (LNDPARW)
- K REFL PAV MRKR TY I-C
- L REFL PAV MRKR TY II-A-A
- M OBJECT MARKER
- N RELF PAV MRK TY I (W) (ARROW)
- ⊙ SIGN NUMBER
- ⇨ EXIST DIRECTION OF TRAFFIC
- ⇨ PROP DIRECTION OF TRAFFIC
- ⊙ PROP WHITE FLX GF2 DELINEATOR (BI)

04/07/2021

Bo L. Ratto

0 25 50 100
1" = 100'

REV. NO.	DATE	DESCRIPTION	BY

CobbFendley 13430 Northwest Freeway, Ste. 1100
Houston, Texas 77040
713.462.3242
www.cobbhendley.com




SIGNING AND PAVEMENT MARKING PLANS
STA 49+00 TO STA 71+00
SHEET 1 OF 35



FED. RD. DIV. NO.	STATE	PROJECT NO.	HIGHWAY NO.
6	TEXAS	(SEE TITLE SHEET)	US60
STATE DISTRICT	COUNTY	CONTROL NO.	SECTION NO.
AMA	GRAY	0169	07
		JOB NO.	SHEET NO.
		053, ETC	186

US60_TRAF-SPM-01.dgn

4/7/2021 7:27:47 AM F:\P\0\0\0\004_Traffic\US60_Amari\06\US60-UST\03-Street\US60_Traf-Sign-02.dgn

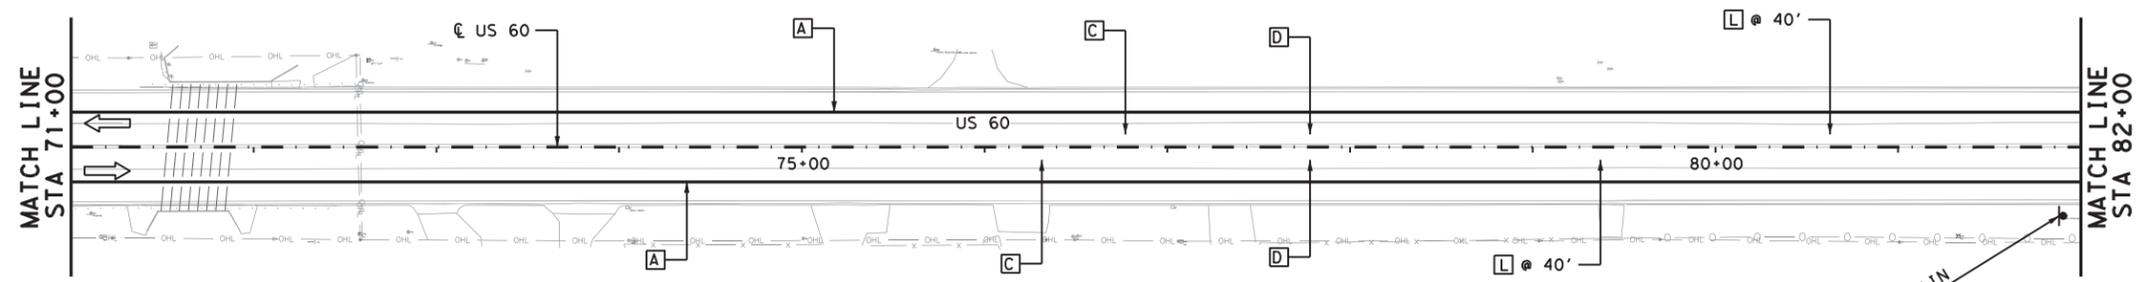

- LEGEND**
- A RE PM W/RET REQ TY I (W) 4" (SLD)
 - B RE PM W/RET REQ TY I (W) 4" (BRK)
 - C RE PM W/RET REQ TY I (Y) 4" (SLD)
 - D RE PM W/RET REQ TY I (Y) 4" (BRK)
 - E REFL PAV MRK TY I (W) 4" (DOT)
 - F REFL PAV MRK TY I (W) 8" (SLD)
 - G REFL PAV MRK TY I (W) 12" (SLD)
 - H REFL PAV MRK TY I (W) 24" (SLD)
 - I REFL PAV MRK TY I (Y) 24" (SLD)
 - J REFL PAV MRK TY I (W) (LNDPARW)
 - K REFL PAV MRKR TY I-C
 - L REFL PAV MRKR TY II-A-A
 - M OBJECT MARKER
 - N RELF PAV MRK TY I (W) (ARROW)
 - # SIGN NUMBER
 - EXIST DIRECTION OF TRAFFIC
 - ➔ PROP DIRECTION OF TRAFFIC
 - ⦿ PROP WHITE FLX GF2 DELINEATOR (BI)

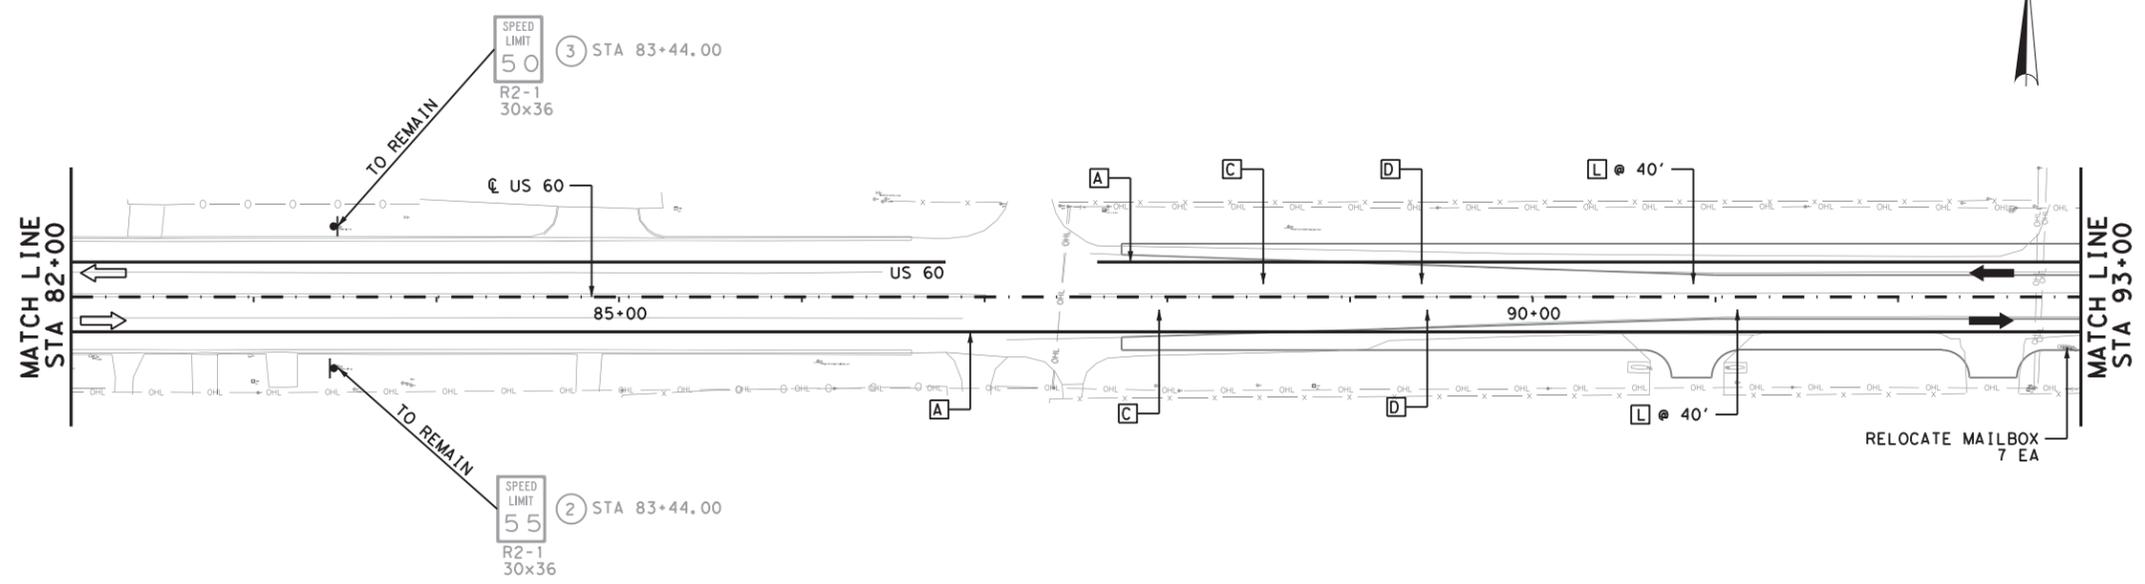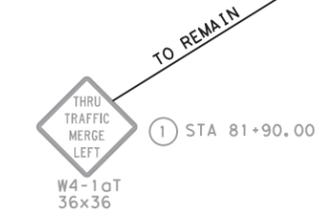

04/07/2021

Bo L. Ratto

REV. NO.	DATE	DESCRIPTION	BY

CobbFendley 13430 Northwest Freeway, Ste. 1100
Houston, Texas 77040
713.462.3242
www.cobbhendley.com


Texas Department of Transportation

SIGNING AND PAVEMENT MARKING PLANS
STA 71+00 TO STA 93+00
SHEET 2 OF 35

FED. RD. DIV. NO.	STATE	PROJECT NO.	HIGHWAY NO.		
6	TEXAS	(SEE TITLE SHEET)	US60		
STATE DISTRICT	COUNTY	CONTROL NO.	SECTION NO.	JOB NO.	SHEET NO.
AMA	GRAY	0169	07	053, ETC	187

US60_Traf-Sign-02.dgn

4/7/2021 7:27:50 AM F:\P\J\2019\1004_Tx\DOT_5x5_P5&E\03_US60_Amar\11616\NG500\UST\N509-Traffic\02-Signing\US60-TRAF-SPM-05.dgn

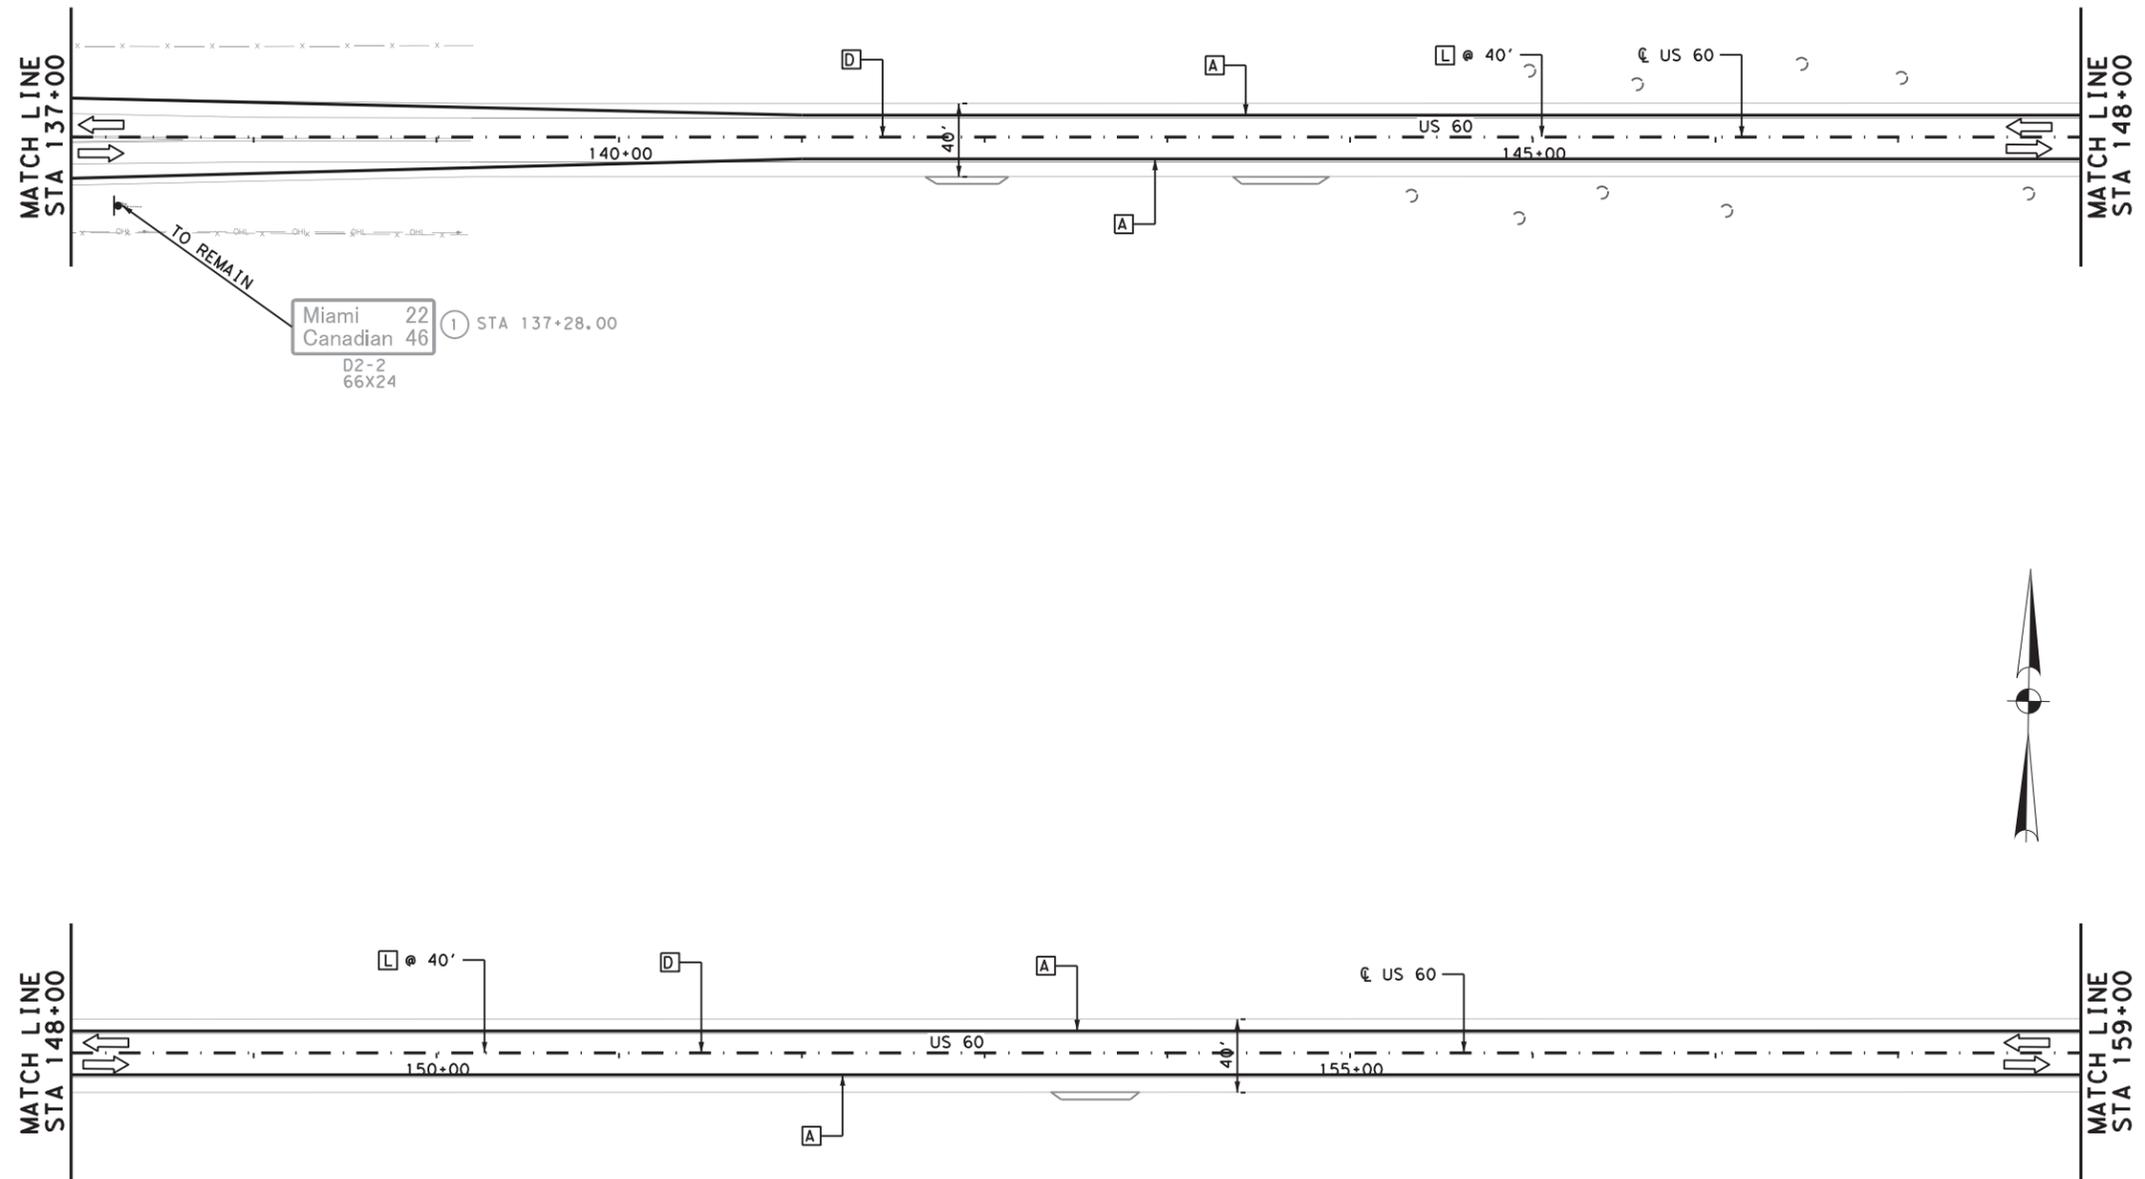

LEGEND

- A RE PM W/RET REQ TY I (W) 4" (SLD)
- B RE PM W/RET REQ TY I (W) 4" (BRK)
- C RE PM W/RET REQ TY I (Y) 4" (SLD)
- D RE PM W/RET REQ TY I (Y) 4" (BRK)
- E REFL PAV MRK TY I (W) 4" (DOT)
- F REFL PAV MRK TY I (W) 8" (SLD)
- G REFL PAV MRK TY I (W) 12" (SLD)
- H REFL PAV MRK TY I (W) 24" (SLD)
- I REFL PAV MRK TY I (Y) 24" (SLD)
- J REFL PAV MRK TY I (W) (LNDPARW)
- K REFL PAV MRKR TY I-C
- L REFL PAV MRKR TY II-A-A
- M OBJECT MARKER
- N REFL PAV MRK TY I (W) (ARROW)
- # SIGN NUMBER
- ↔ EXIST DIRECTION OF TRAFFIC
- ➔ PROP DIRECTION OF TRAFFIC
- ⦿ PROP WHITE FLX GF2 DELINEATOR (BI)

04/07/2021

Bo L. Ratto

REV. NO.	DATE	DESCRIPTION	BY

CobbFendley 13430 Northwest Freeway, Ste. 1100
Houston, Texas 77040
713.462.3242
www.cobbhendley.com




SIGNING AND PAVEMENT MARKING PLANS
STA 137+00 TO STA 159+00
SHEET 5 OF 35

FED. RD. DIV. NO.	STATE	PROJECT NO.	HIGHWAY NO.
6	TEXAS	(SEE TITLE SHEET)	US60
STATE DISTRICT	COUNTY	CONTROL NO.	SECTION NO.
AMA	GRAY	0169	07
			JOB NO.
			053, ETC
			SHEET NO.
			190

US60-TRAF-SPM-05.dgn

4/7/2021 7:27:51 AM F:\Projects\2019\1004_Traffic\560_Amendment\US60-Traffic\02-Signing\US60_Traffic_Signing.dgn

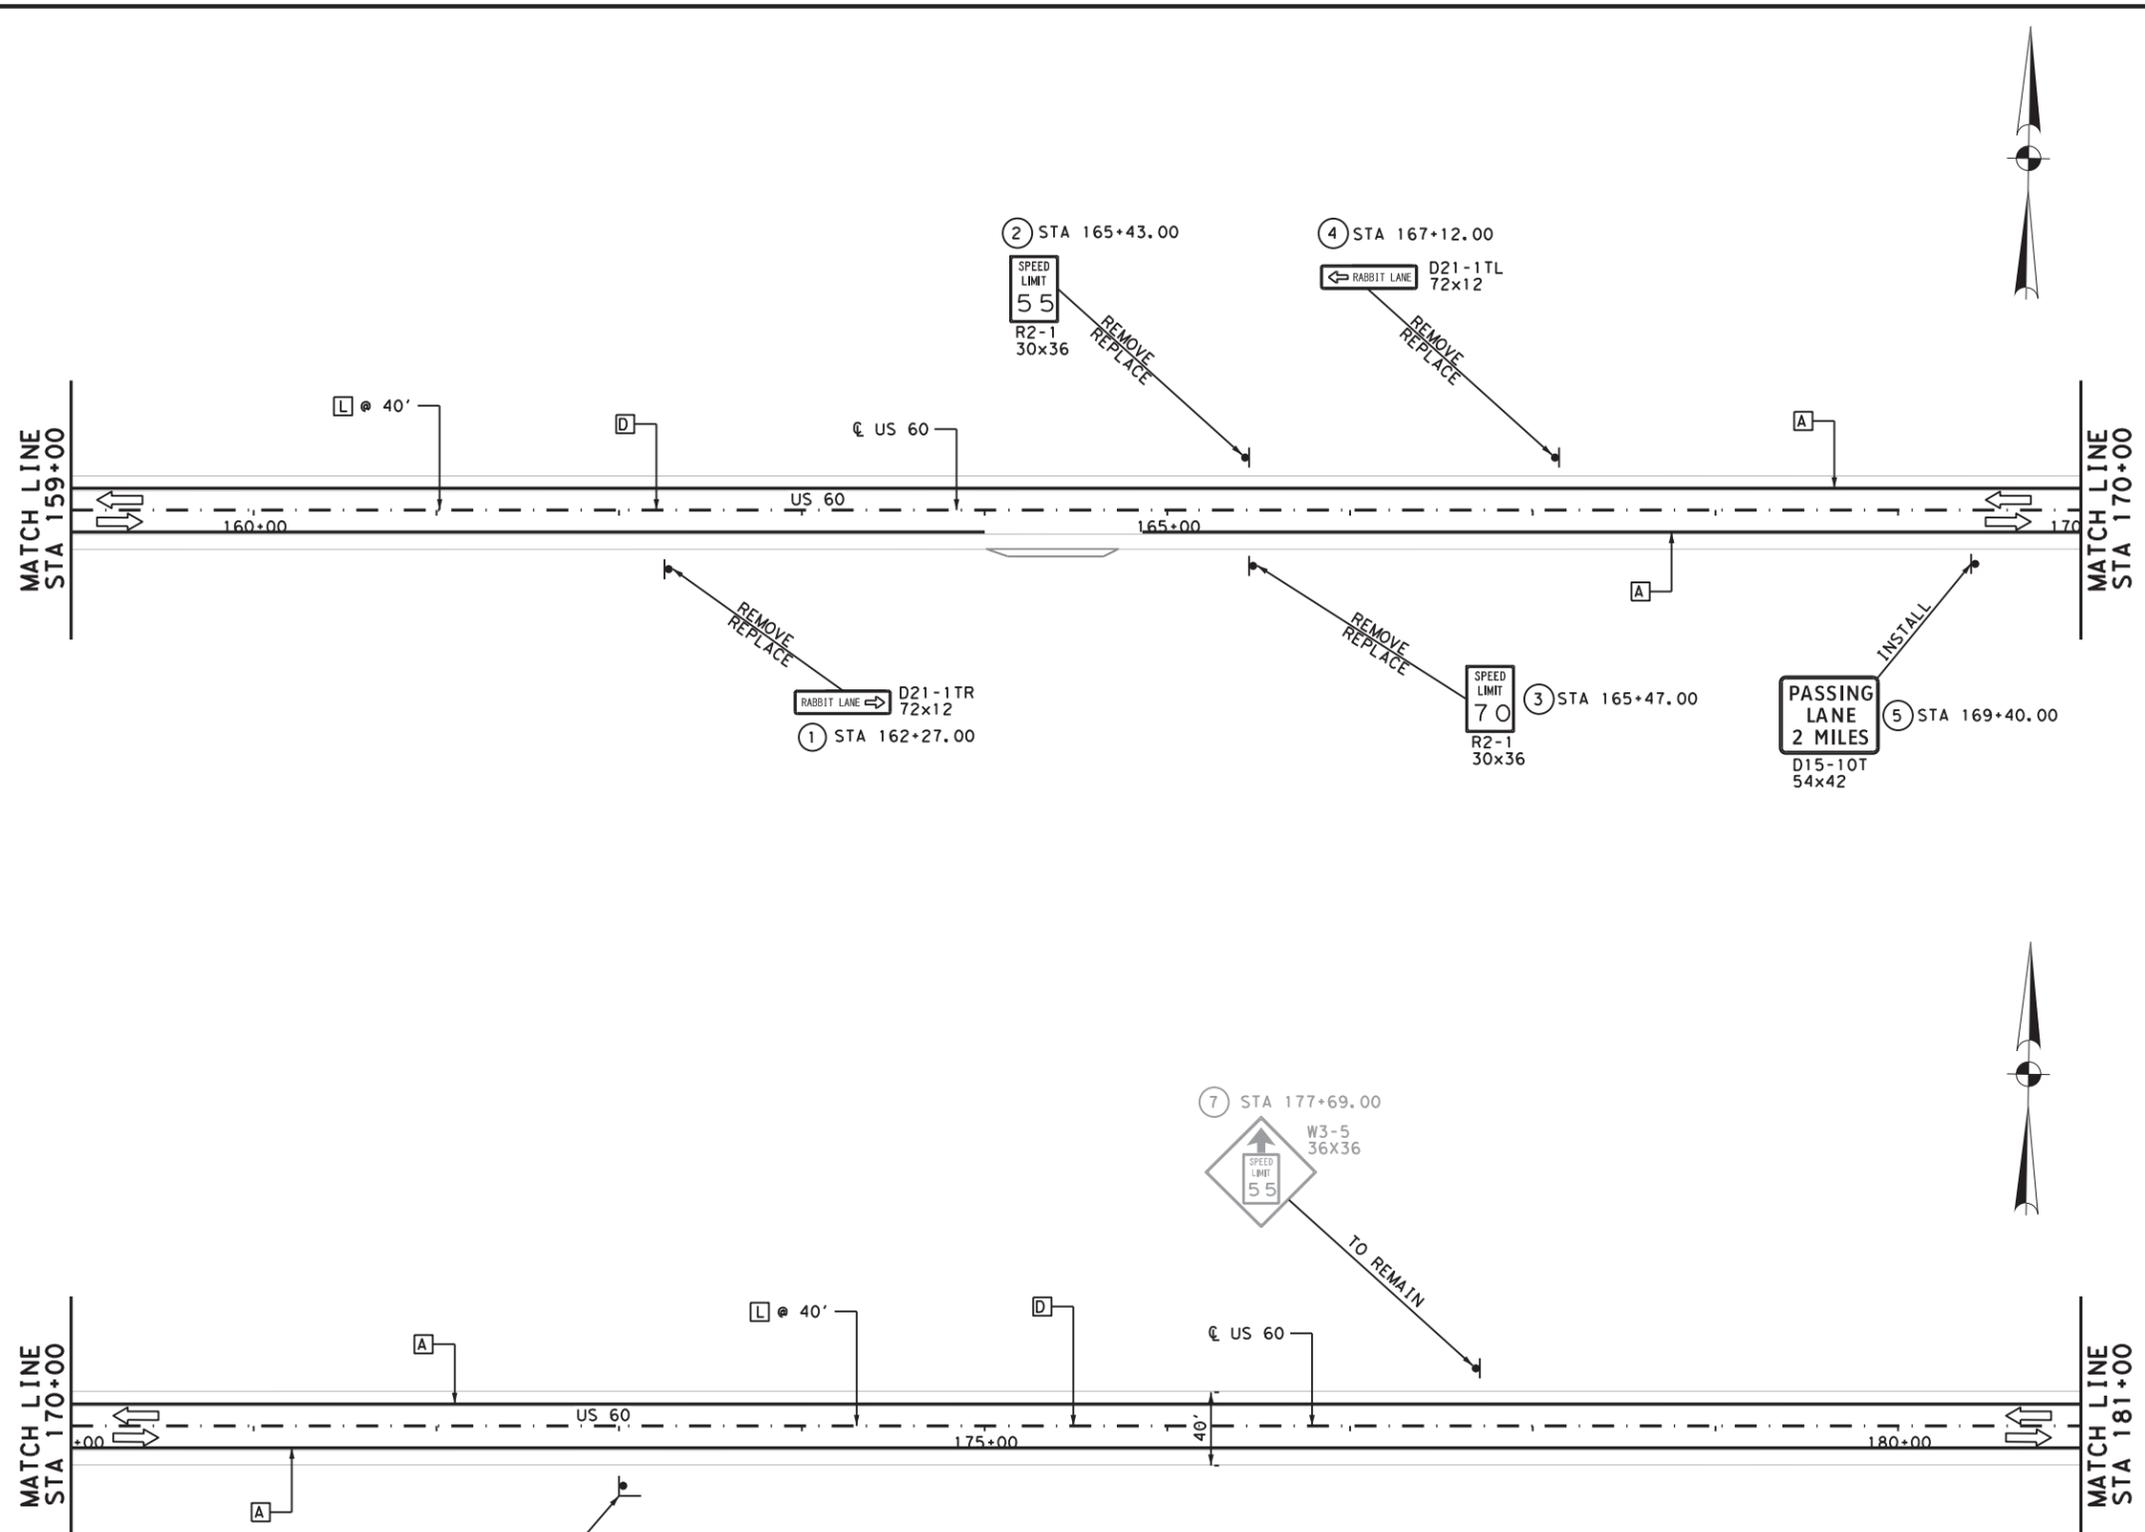

- LEGEND**
- A RE PM W/RET REQ TY I (W) 4" (SLD)
 - B RE PM W/RET REQ TY I (W) 4" (BRK)
 - C RE PM W/RET REQ TY I (Y) 4" (SLD)
 - D RE PM W/RET REQ TY I (Y) 4" (BRK)
 - E REFL PAV MRK TY I (W) 4" (DOT)
 - F REFL PAV MRK TY I (W) 8" (SLD)
 - G REFL PAV MRK TY I (W) 12" (SLD)
 - H REFL PAV MRK TY I (W) 24" (SLD)
 - I REFL PAV MRK TY I (Y) 24" (SLD)
 - J REFL PAV MRK TY I (W) (LNDPARW)
 - K REFL PAV MRKR TY I-C
 - L REFL PAV MRKR TY II-A-A
 - M OBJECT MARKER
 - N RELF PAV MRK TY I (W) (ARROW)
 - # SIGN NUMBER
 - EXIST DIRECTION OF TRAFFIC
 - ➔ PROP DIRECTION OF TRAFFIC
 - ⦿ PROP WHITE FLX GF2 DELINEATOR (BI)

04/07/2021

Bo L. Ratto

REV. NO.	DATE	DESCRIPTION	BY

CobbFendley 13430 Northwest Freeway, Ste. 1100
Houston, Texas 77040
713.462.3242
www.cobbhendley.com


Texas Department of Transportation

SIGNING AND PAVEMENT MARKING PLANS
STA 159+00 TO STA 181+00
SHEET 6 OF 35

FED. RD. DIV. NO.	STATE	PROJECT NO.	HIGHWAY NO.
6	TEXAS	(SEE TITLE SHEET)	US60
STATE DISTRICT	COUNTY	CONTROL NO.	SECTION NO.
AMA	GRAY	0169	07
		JOB NO.	SHEET NO.
		053, ETC	191

US60_TRAFF-Signing.dgn

4/7/2021 7:27:52 AM F:\Proj\62019\1004_Traffic\US60_Amari\16\EN\600-UST\IN\609-Traffic\02-Sheets\US60_Traf-Sign-07.dgn

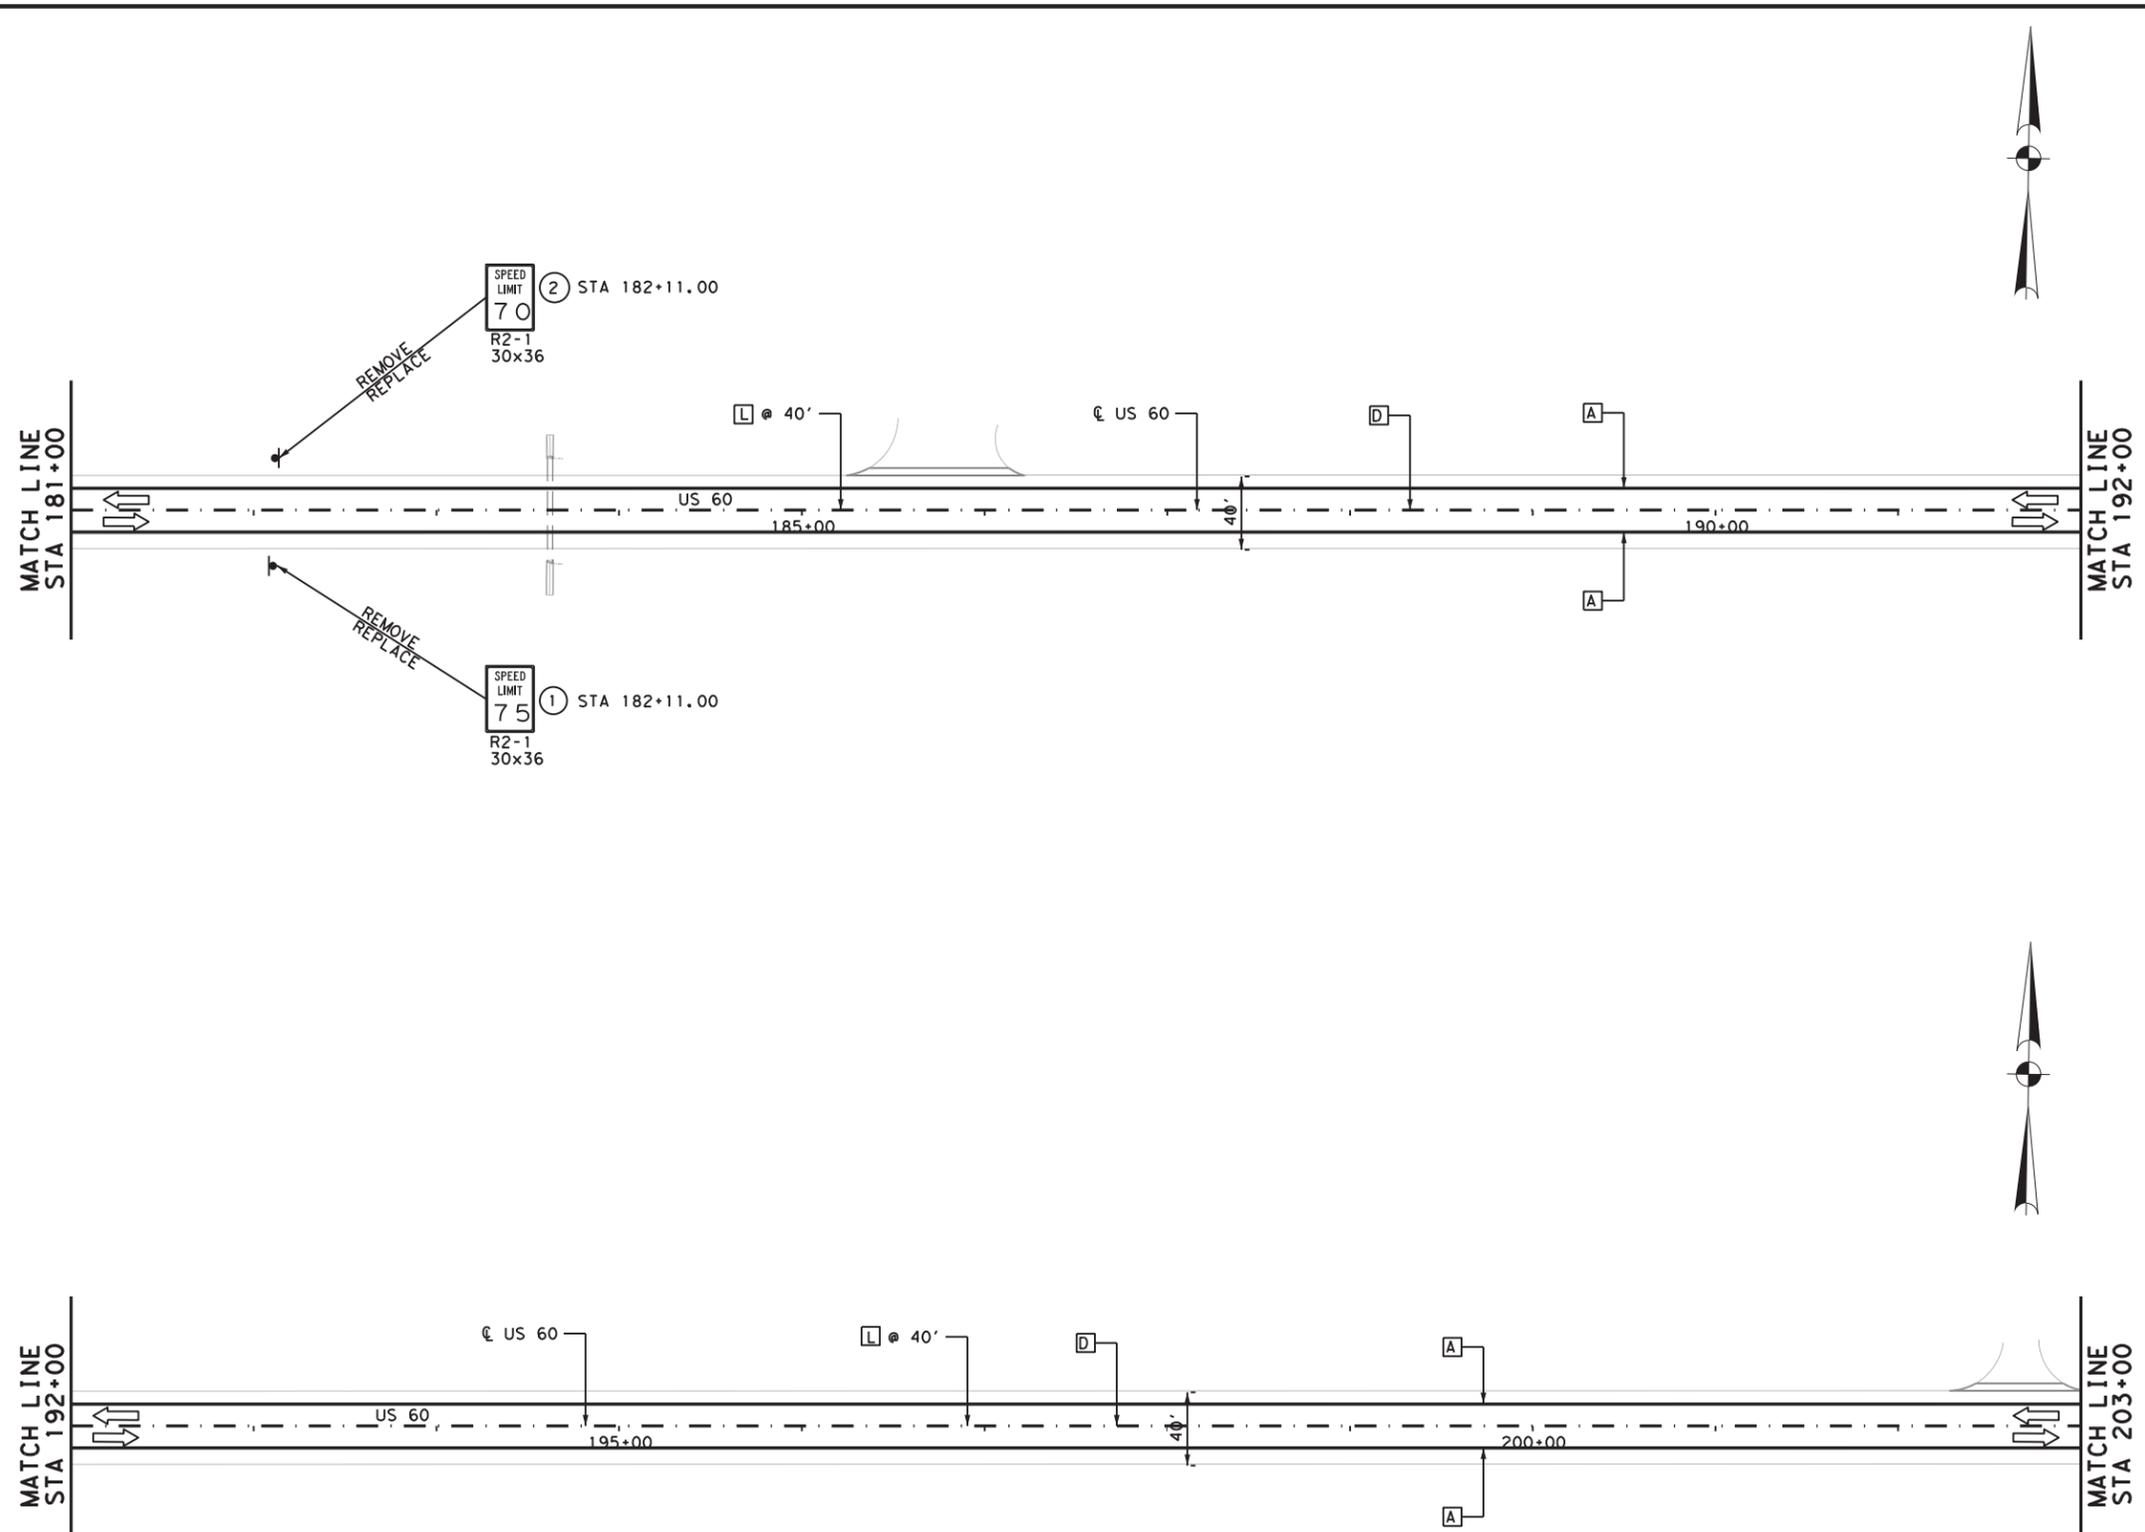

- LEGEND**
- A RE PM W/RET REQ TY I (W) 4" (SLD)
 - B RE PM W/RET REQ TY I (W) 4" (BRK)
 - C RE PM W/RET REQ TY I (Y) 4" (SLD)
 - D RE PM W/RET REQ TY I (Y) 4" (BRK)
 - E REFL PAV MRK TY I (W) 4" (DOT)
 - F REFL PAV MRK TY I (W) 8" (SLD)
 - G REFL PAV MRK TY I (W) 12" (SLD)
 - H REFL PAV MRK TY I (W) 24" (SLD)
 - I REFL PAV MRK TY I (Y) 24" (SLD)
 - J REFL PAV MRK TY I (W) (LNDPARW)
 - K REFL PAV MRKR TY I-C
 - L REFL PAV MRKR TY II-A-A
 - M OBJECT MARKER
 - N RELF PAV MRK TY I (W) (ARROW)
 - # SIGN NUMBER
 - ⇄ EXIST DIRECTION OF TRAFFIC
 - ➔ PROP DIRECTION OF TRAFFIC
 - ⊙ PROP WHITE FLX GF2 DELINEATOR (BI)

04/07/2021

Bo L. Ratto

REV. NO.	DATE	DESCRIPTION	BY

CobbFendley 13430 Northwest Freeway, Ste. 1100
Houston, Texas 77040
713.462.3242
www.cobbfendley.com




Texas Department of Transportation

SIGNING AND PAVEMENT MARKING PLANS
STA 181+00 TO STA 203+00
SHEET 7 OF 35

FED. RD. DIV. NO.	STATE	PROJECT NO.	HIGHWAY NO.
6	TEXAS	(SEE TITLE SHEET)	US60
STATE DISTRICT	COUNTY	CONTROL NO.	SECTION NO.
AMA	GRAY	0169	07
		JOB NO.	SHEET NO.
		053, ETC	192

US60_Traf-Sign-07.dgn

4/7/2021 7:27:59 AM F:\P\0\jerd\2019\1004_Tx\DOT_5x5_P5&E\03_US60_Amar\116\EN\600-UST\1\609-Traffic\02-Sheets\US60_TRAF-SPM-08.dgn

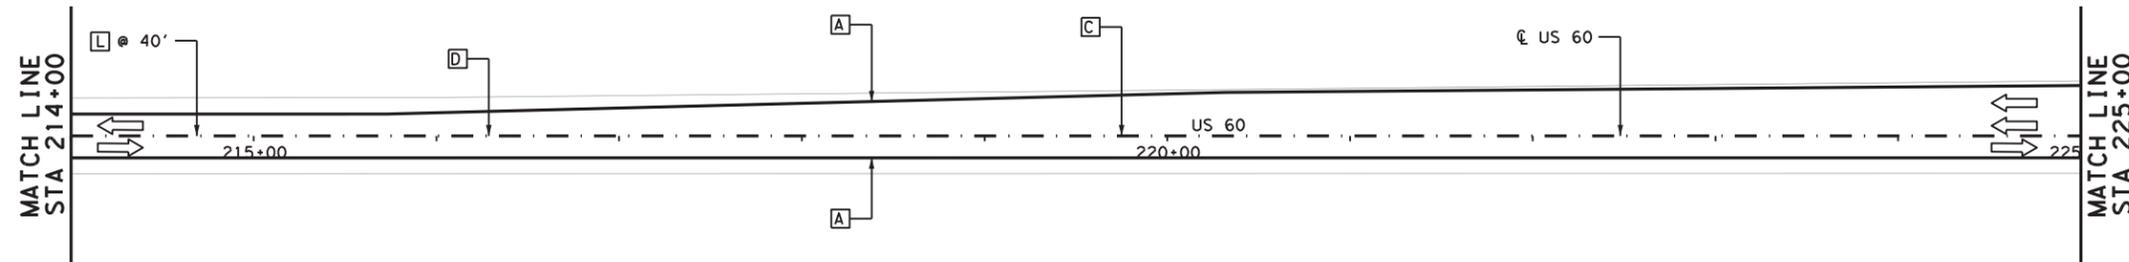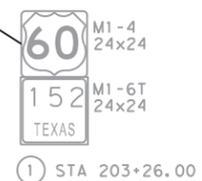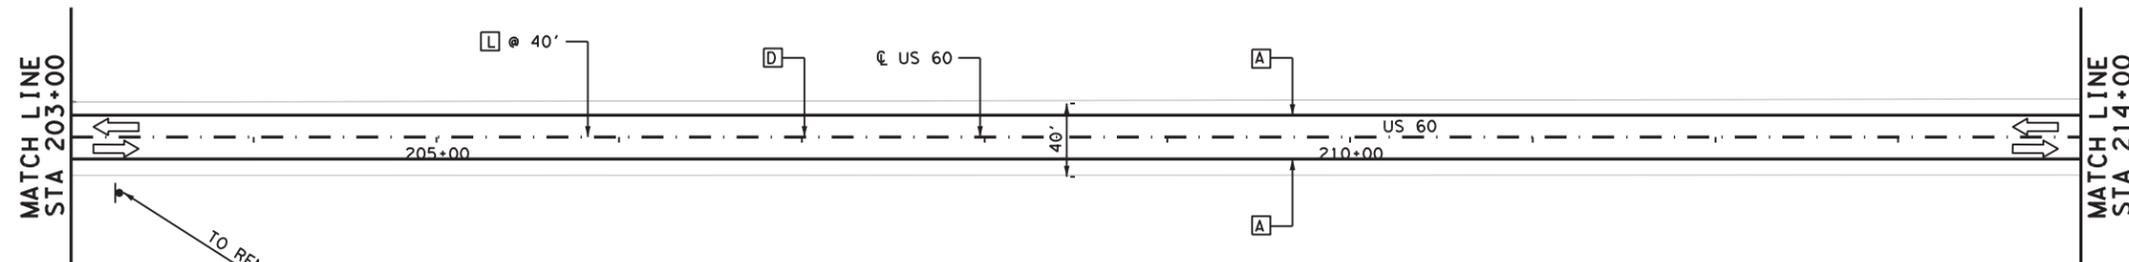

LEGEND

- A RE PM W/RET REQ TY I (W) 4" (SLD)
- B RE PM W/RET REQ TY I (W) 4" (BRK)
- C RE PM W/RET REQ TY I (Y) 4" (SLD)
- D RE PM W/RET REQ TY I (Y) 4" (BRK)
- E REFL PAV MRK TY I (W) 4" (DOT)
- F REFL PAV MRK TY I (W) 8" (SLD)
- G REFL PAV MRK TY I (W) 12" (SLD)
- H REFL PAV MRK TY I (W) 24" (SLD)
- I REFL PAV MRK TY I (Y) 24" (SLD)
- J REFL PAV MRK TY I (W) (LNDPARW)
- K REFL PAV MRKR TY I-C
- L REFL PAV MRKR TY II-A-A
- M OBJECT MARKER
- N RELF PAV MRK TY I (W) (ARROW)
- # SIGN NUMBER
- ⇨ EXIST DIRECTION OF TRAFFIC
- ⇨ PROP DIRECTION OF TRAFFIC
- ⊙ PROP WHITE FLX GF2 DELINEATOR (BI)

04/07/2021

Bo L. Ratto

REV. NO.	DATE	DESCRIPTION	BY

CobbFendley 13430 Northwest Freeway, Ste. 1100
Houston, Texas 77040
713.462.3242
www.cobbhendley.com





SIGNING AND PAVEMENT MARKING PLANS
STA 203+00 TO STA 225+00
SHEET **8** OF **35**

FED. RD. DIV. NO.	STATE	PROJECT NO.	HIGHWAY NO.
6	TEXAS	(SEE TITLE SHEET)	US60
STATE DISTRICT	COUNTY	CONTROL NO.	SECTION NO.
AMA	GRAY	0169	07
			JOB NO.
			053, ETC
			SHEET NO.
			193

US60_TRAF-SPM-08.dgn

LEGEND

- A RE PM W/RET REQ TY I (W)4" (SLD)
- B RE PM W/RET REQ TY I (W)4" (BRK)
- C RE PM W/RET REQ TY I (Y)4" (SLD)
- D RE PM W/RET REQ TY I (Y)4" (BRK)
- E REFL PAV MRK TY I (W)4" (DOT)
- F REFL PAV MRK TY I (W)8" (SLD)
- G REFL PAV MRK TY I (W)12" (SLD)
- H REFL PAV MRK TY I (W)24" (SLD)
- I REFL PAV MRK TY I (Y)24" (SLD)
- J REFL PAV MRK TY I (W) (LNDPARW)
- K REFL PAV MRKR TY I-C
- L REFL PAV MRKR TY II-A-A
- M OBJECT MARKER
- N RELF PAV MRK TY I (W) (ARROW)
- # SIGN NUMBER
- ⇨ EXIST DIRECTION OF TRAFFIC
- ⇩ PROP DIRECTION OF TRAFFIC
- ⦿ PROP WHITE FLX GF2 DELINEATOR (BI)

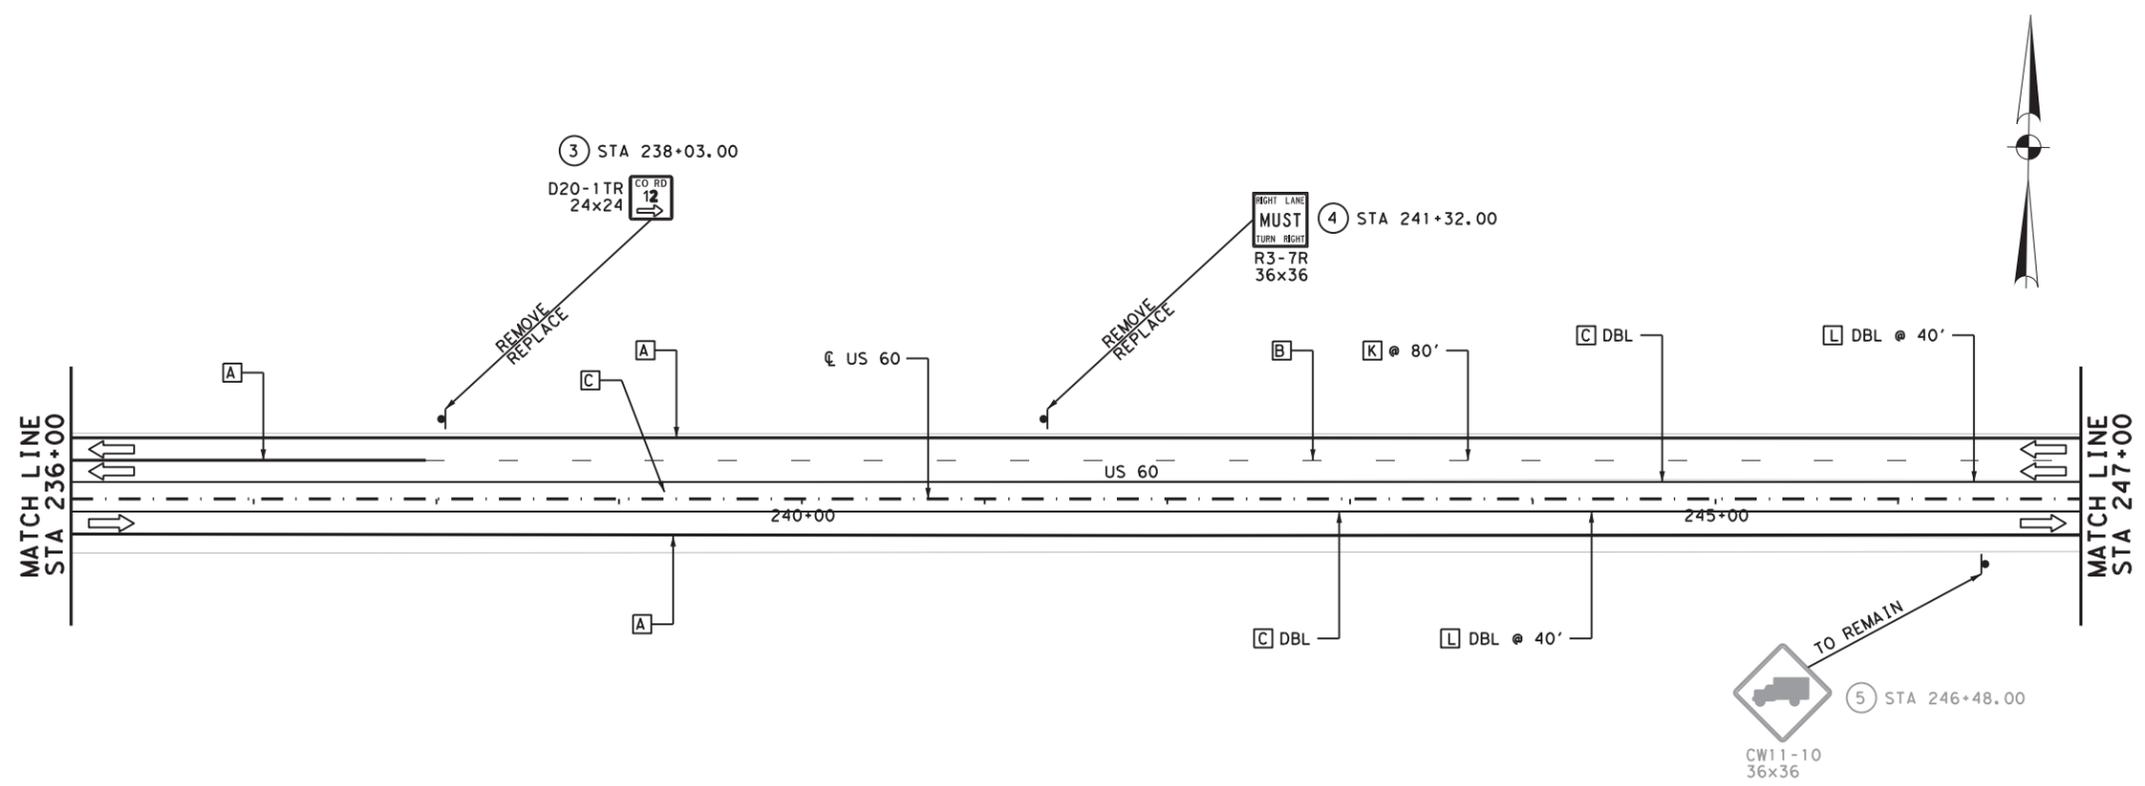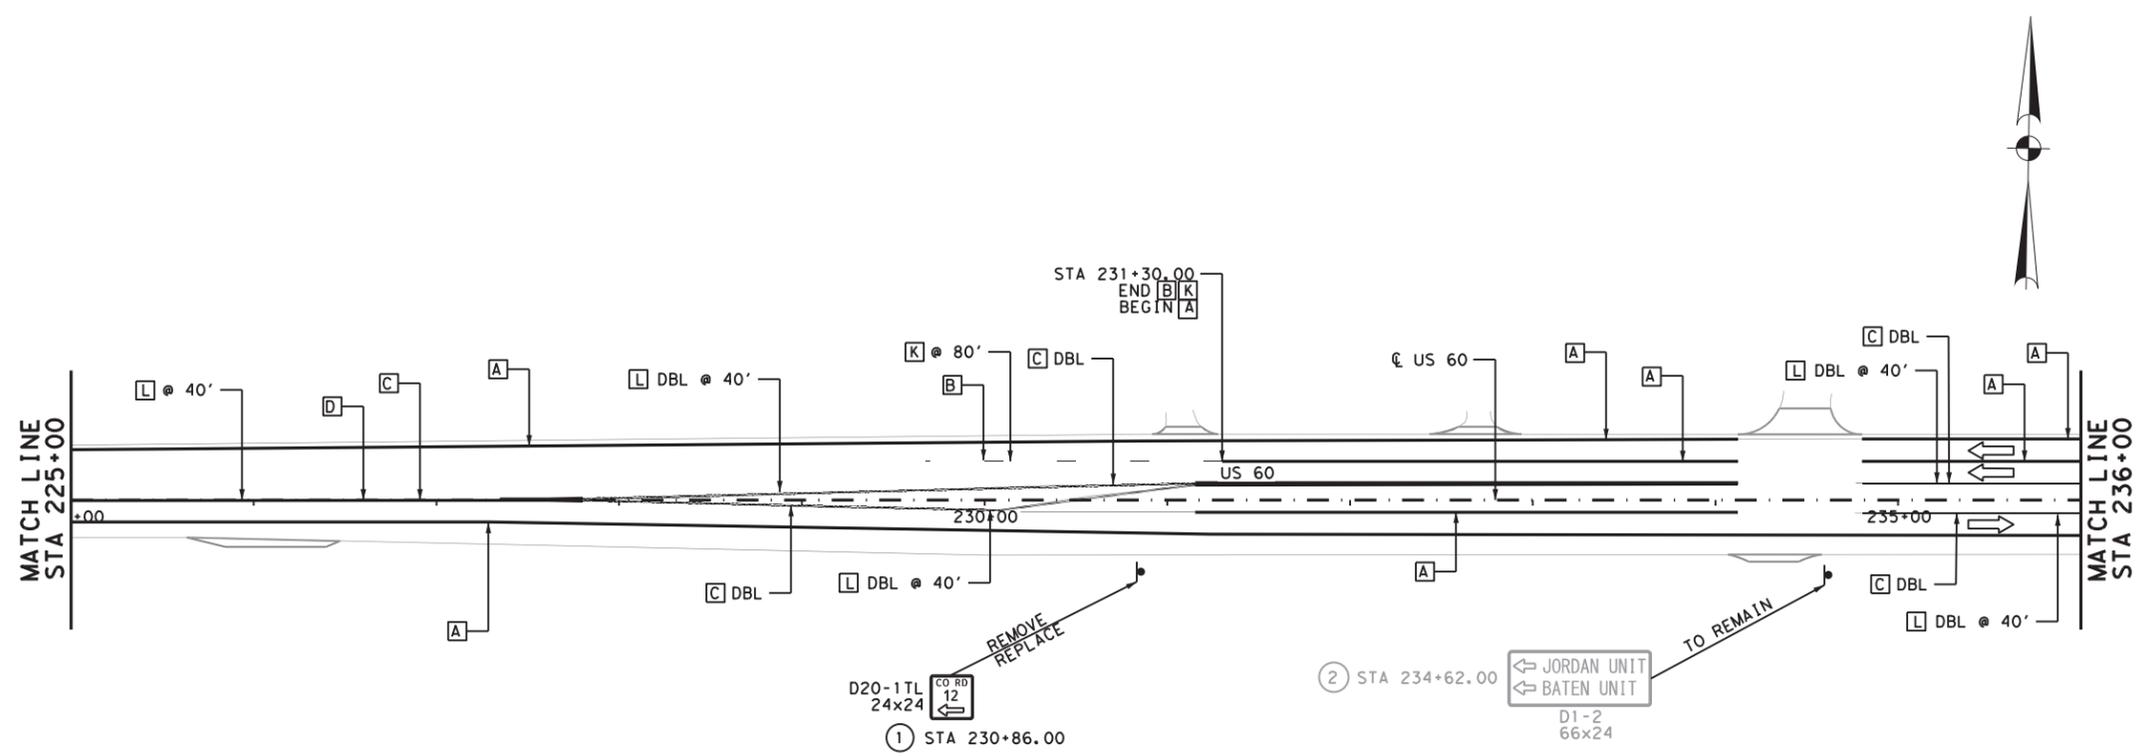

04/07/2021

Bo L. Ratto

REV. NO.	DATE	DESCRIPTION	BY

CobbFendley 13430 Northwest Freeway, Ste. 1100
Houston, Texas 77040
713.462.3242
www.cobbhendley.com

Texas Department of Transportation

SIGNING AND PAVEMENT MARKING PLANS
STA 225+00 TO STA 247+00

SHEET **9** OF **35**



FED. RD. DIV. NO.	STATE	PROJECT NO.	HIGHWAY NO.
6	TEXAS	(SEE TITLE SHEET)	US60
STATE DISTRICT	COUNTY	CONTROL NO.	SECTION NO.
AMA	GRAY	0169	07
			JOB NO.
			053, ETC
			SHEET NO.
			194

4/7/2021 7:27:53 AM F:\Proj\62019\1004_Traffic_Plan\US60_Amarillo\ENGIN\500-USTIN\509-Traffic\02-Sheets\US60_TRAF-SPM-09.dgn

US60_TRAF-SPM-09.dgn

LEGEND

- A RE PM W/RET REQ TY I (W) 4" (SLD)
- B RE PM W/RET REQ TY I (W) 4" (BRK)
- C RE PM W/RET REQ TY I (Y) 4" (SLD)
- D RE PM W/RET REQ TY I (Y) 4" (BRK)
- E REFL PAV MRK TY I (W) 4" (DOT)
- F REFL PAV MRK TY I (W) 8" (SLD)
- G REFL PAV MRK TY I (W) 12" (SLD)
- H REFL PAV MRK TY I (W) 24" (SLD)
- I REFL PAV MRK TY I (Y) 24" (SLD)
- J REFL PAV MRK TY I (W) (LNDPARW)
- K REFL PAV MRKR TY I-C
- L REFL PAV MRKR TY II-A-A
- M OBJECT MARKER
- N RELF PAV MRK TY I (W) (ARROW)
- # SIGN NUMBER
- EXIST DIRECTION OF TRAFFIC
- ➔ PROP DIRECTION OF TRAFFIC
- ⊙ PROP WHITE FLX GF2 DELINEATOR (BI)

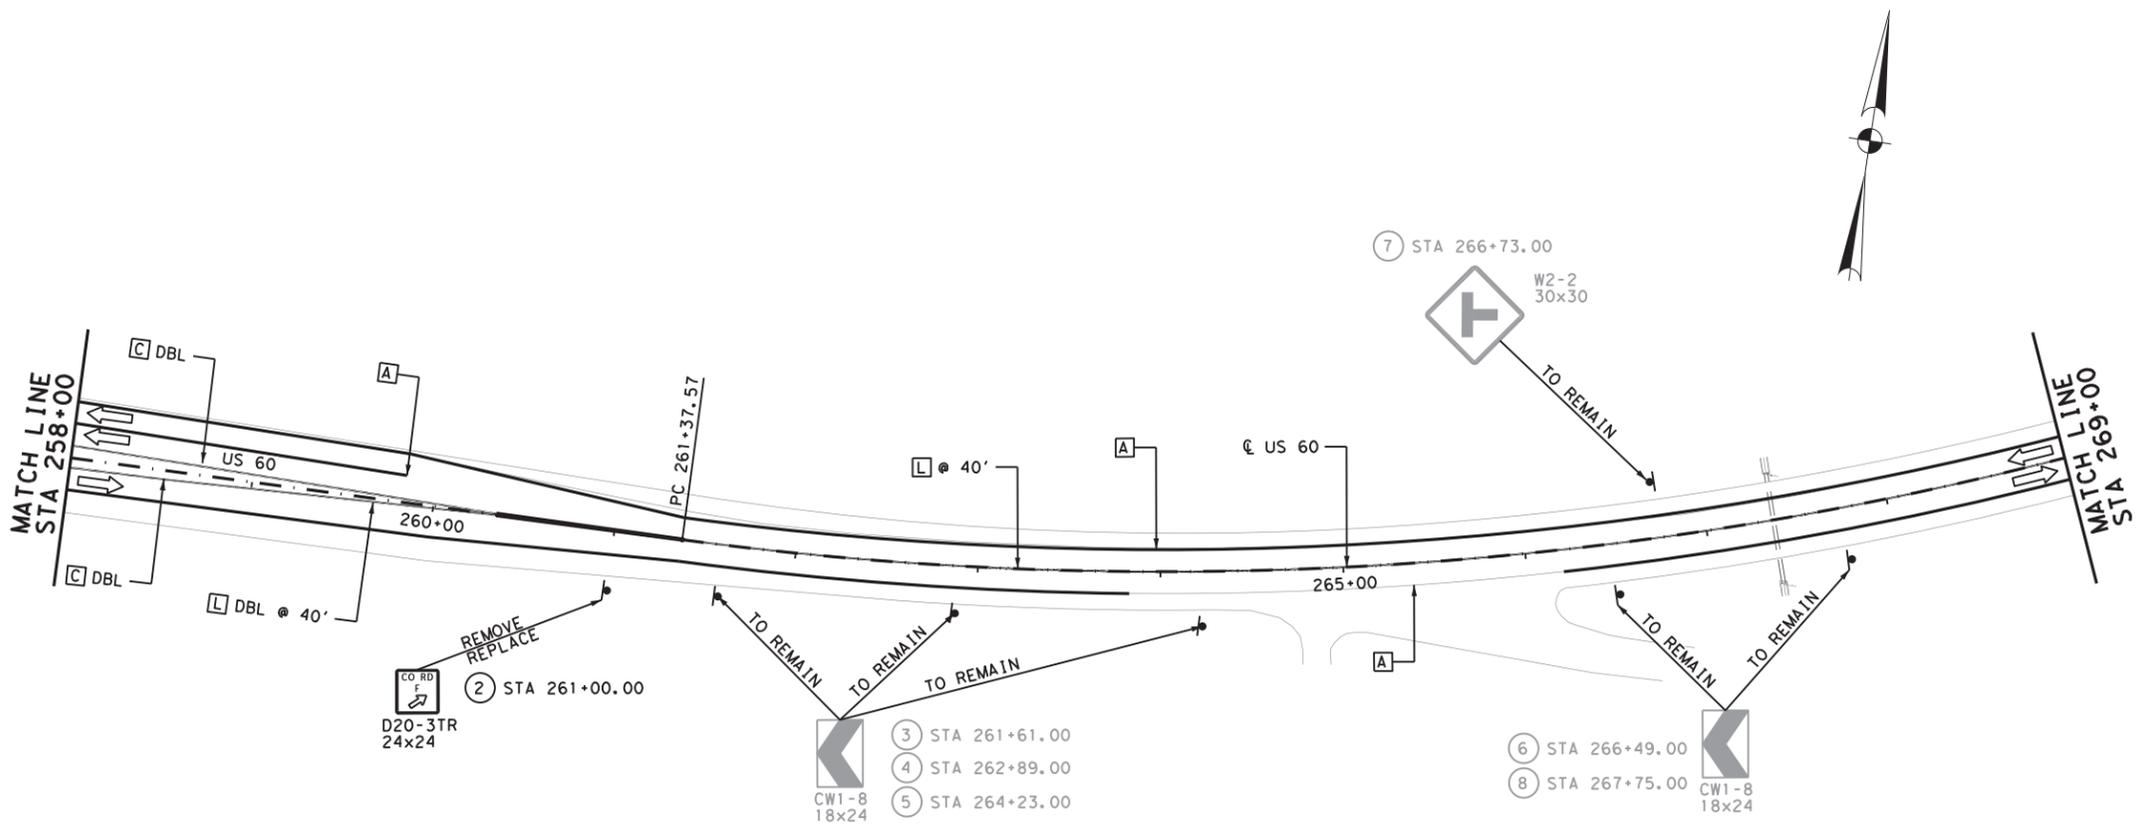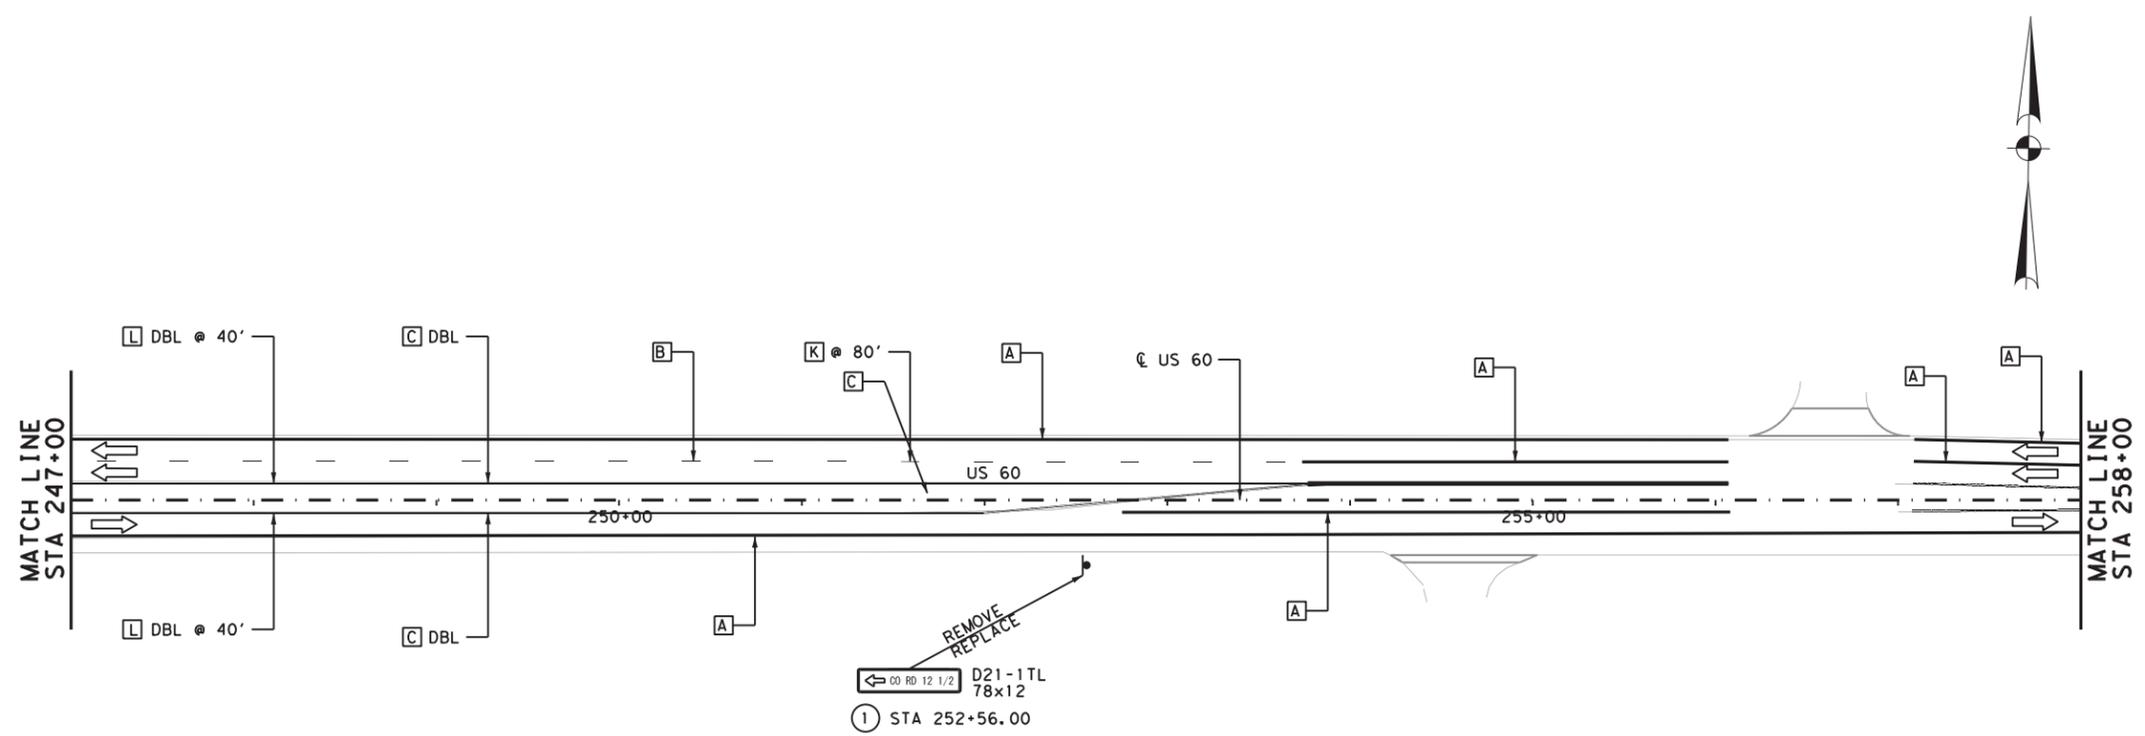

04/07/2021

Bo L. Ratto

REV. NO.	DATE	DESCRIPTION	BY

CobbFendley 13430 Northwest Freeway, Ste. 1100
Houston, Texas 77040
713.462.3242
www.cobbhendley.com

Texas Department of Transportation


SIGNING AND PAVEMENT MARKING PLANS
STA 247+00 TO STA 269+00

SHEET 10 OF 35


FED. RD. DIV. NO.	STATE	PROJECT NO.	HIGHWAY NO.
6	TEXAS	(SEE TITLE SHEET)	US60
STATE DISTRICT	COUNTY	CONTROL NO.	SECTION NO.
AMA	GRAY	0169	07
			JOB NO.
			053, ETC
			SHEET NO.
			195

4/7/2021 7:27:54 AM F:\Proj\2019\1004_Traffic\560_US60_Amrt\1016\EN\500-UST\N\509-Traffic\02-Sheets\US60_Traf-Sign.dgn

4/7/2021 7:27:55 AM F:\Proj\2019\1004_Traffic\US60_Amendment\US60-Traffic\02-Signing\US60_TRAF-Signing.dgn

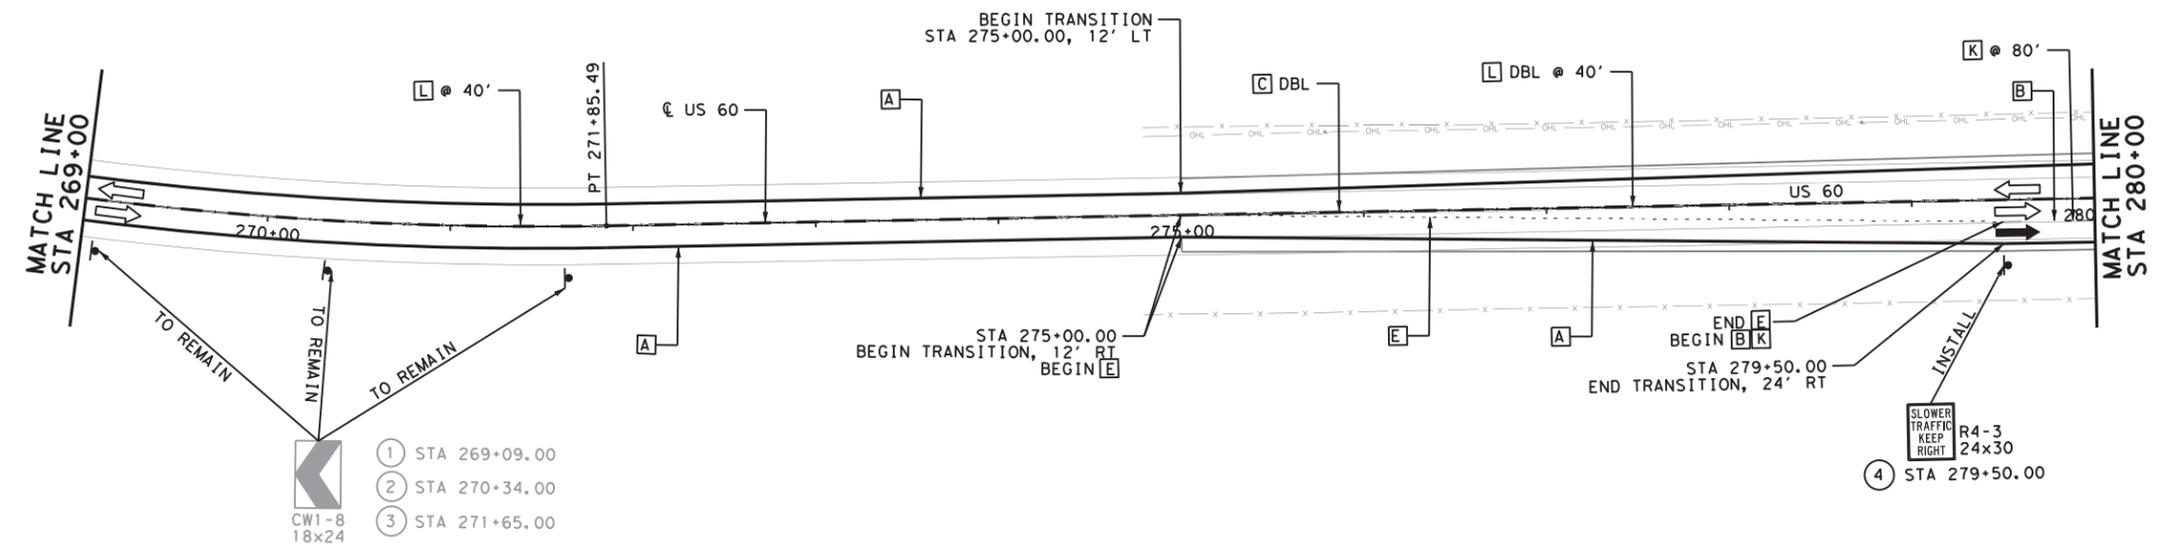

- CW1-8
18x24
- ① STA 269+09.00
 - ② STA 270+34.00
 - ③ STA 271+65.00

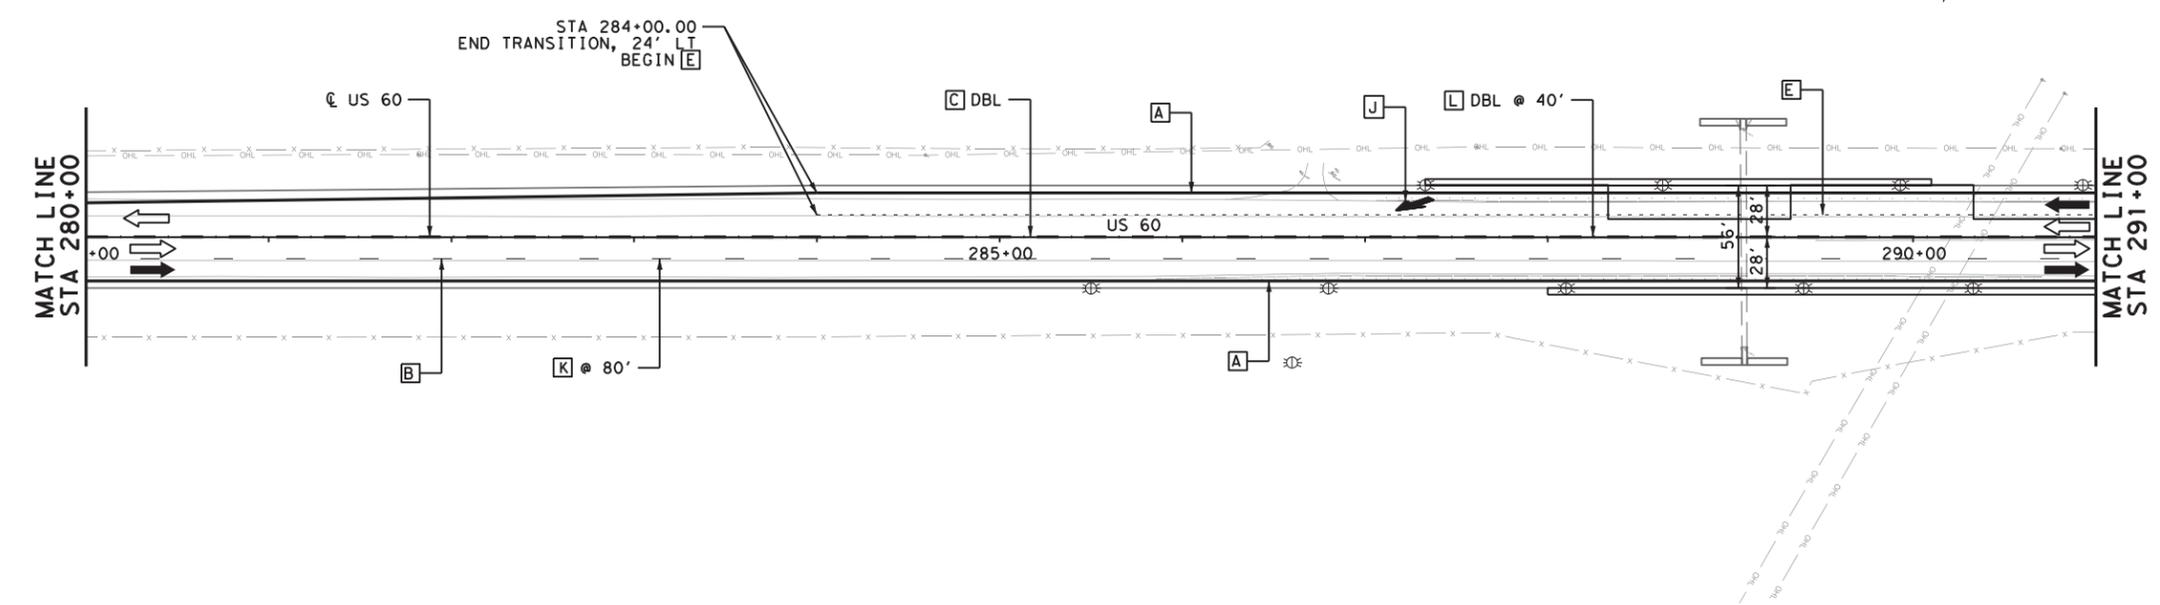

- LEGEND**
- A RE PM W/RET REQ TY I (W)4" (SLD)
 - B RE PM W/RET REQ TY I (W)4" (BRK)
 - C RE PM W/RET REQ TY I (Y)4" (SLD)
 - D RE PM W/RET REQ TY I (Y)4" (BRK)
 - E REFL PAV MRK TY I (W)4" (DOT)
 - F REFL PAV MRK TY I (W)8" (SLD)
 - G REFL PAV MRK TY I (W)12" (SLD)
 - H REFL PAV MRK TY I (W)24" (SLD)
 - I REFL PAV MRK TY I (Y)24" (SLD)
 - J REFL PAV MRK TY I (W) (LNDPARW)
 - K REFL PAV MRKR TY I-C
 - L REFL PAV MRKR TY II-A-A
 - M OBJECT MARKER
 - N REFL PAV MRK TY I (W) (ARROW)
 - ⊙ SIGN NUMBER
 - ⇨ EXIST DIRECTION OF TRAFFIC
 - ⇨ PROP DIRECTION OF TRAFFIC
 - ⊙ PROP WHITE FLX GF2 DELINEATOR (BI)

04/07/2021

Bo L. Ratto

REV. NO.	DATE	DESCRIPTION	BY

CobbFendley 13430 Northwest Freeway, Ste. 1100
Houston, Texas 77040
713.462.3242
www.cobbfendley.com



Texas Department of Transportation

SIGNING AND PAVEMENT MARKING PLANS
STA 269+00 TO STA 291+00
SHEET 11 OF 35

FED. RD. DIV. NO.	STATE	PROJECT NO.	HIGHWAY NO.
6	TEXAS	(SEE TITLE SHEET)	US60
STATE DISTRICT	COUNTY	CONTROL NO.	SECTION NO.
AMA	GRAY	0169	07
		JOB NO.	SHEET NO.
		053, ETC	196

US60_TRAF-Signing.dgn

4/7/2021 7:27:56 AM F:\Proj\2019\1004_Traffic\US60_Amendment\US60-Traffic\2-Street\US60_Traf-SPM-12.dgn

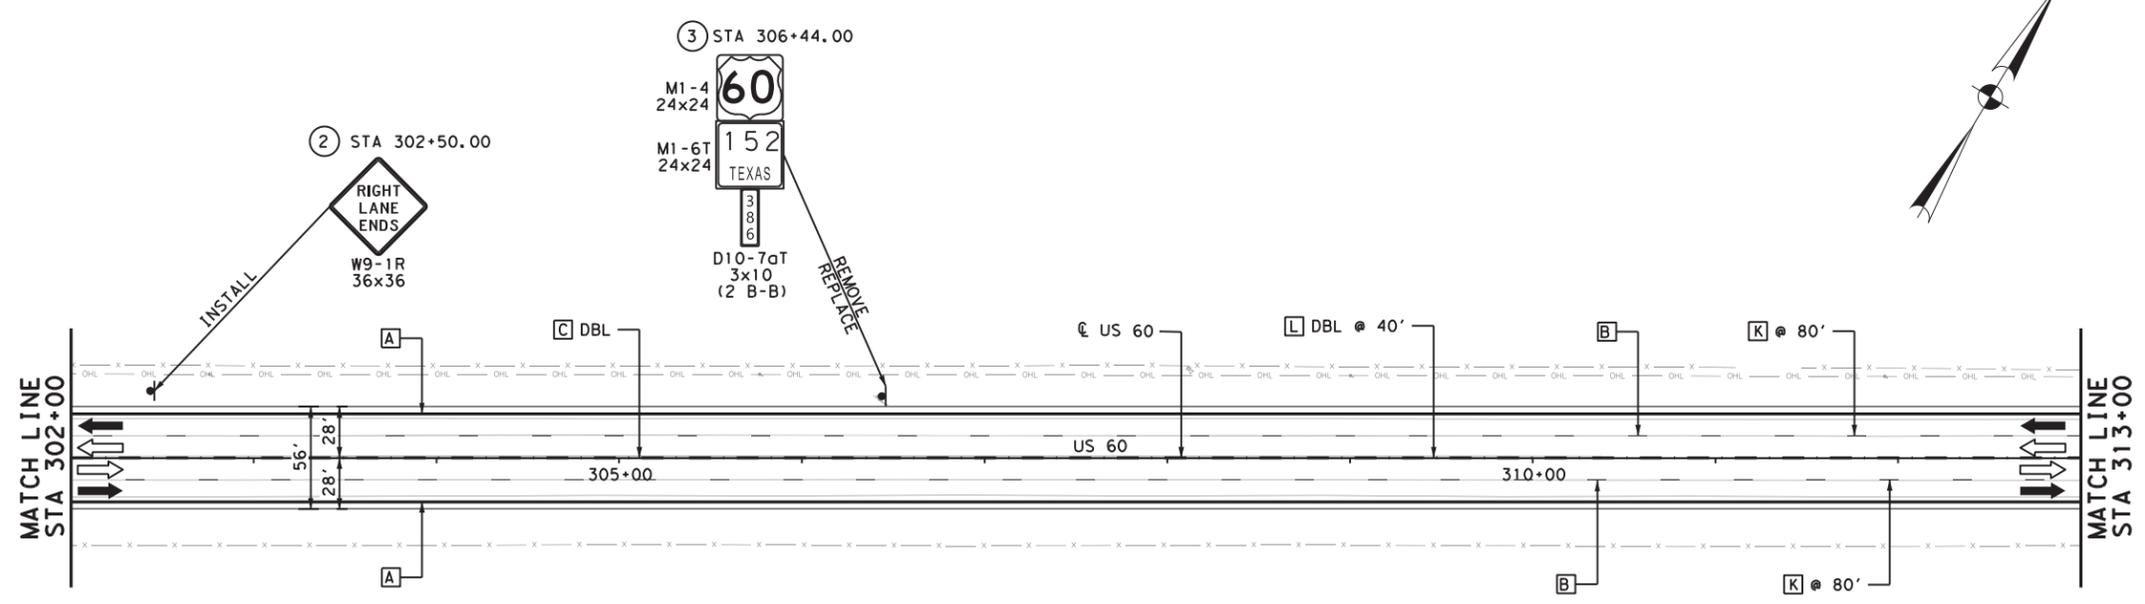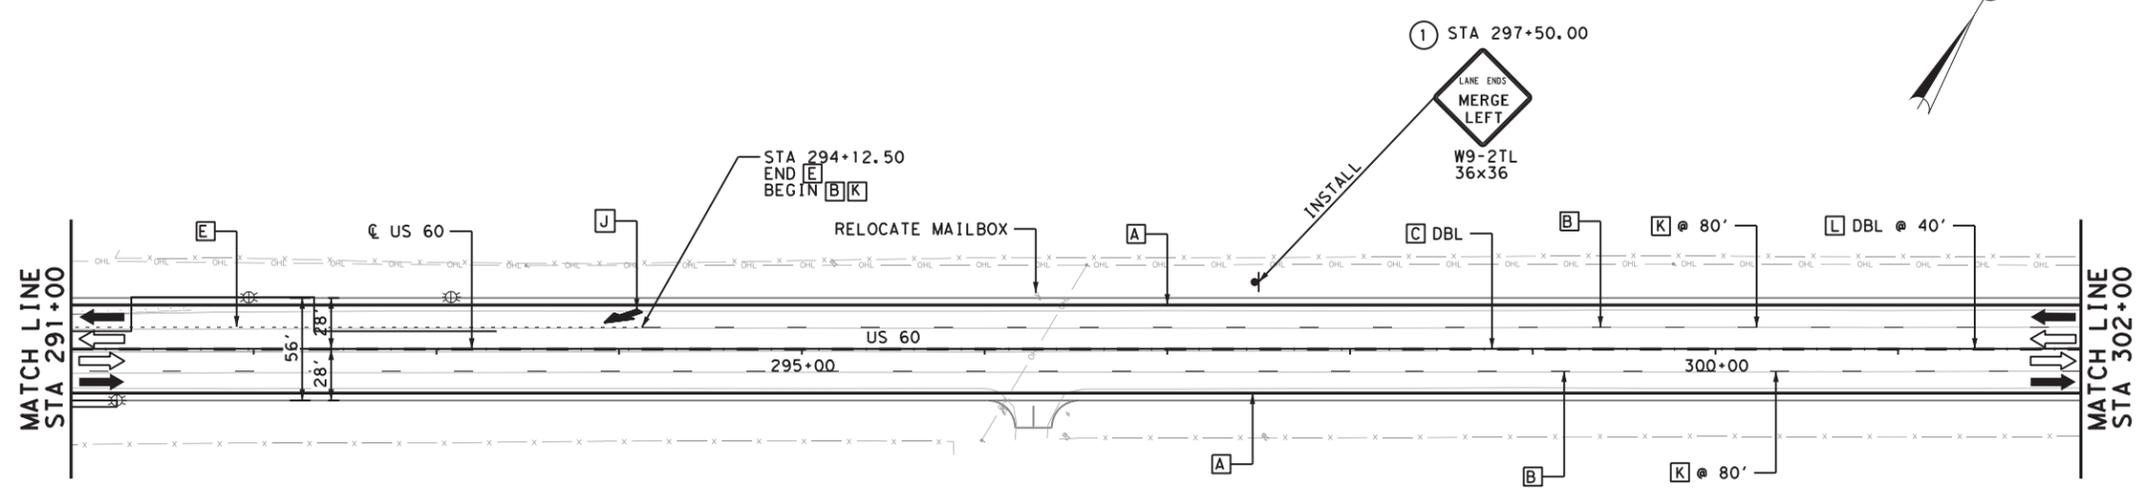

LEGEND

- A RE PM W/RET REQ TY I (W)4" (SLD)
- B RE PM W/RET REQ TY I (W)4" (BRK)
- C RE PM W/RET REQ TY I (Y)4" (SLD)
- D RE PM W/RET REQ TY I (Y)4" (BRK)
- E REFL PAV MRK TY I (W)4" (DOT)
- F REFL PAV MRK TY I (W)8" (SLD)
- G REFL PAV MRK TY I (W)12" (SLD)
- H REFL PAV MRK TY I (W)24" (SLD)
- I REFL PAV MRK TY I (Y)24" (SLD)
- J REFL PAV MRK TY I (W) (LNDPARW)
- K REFL PAV MRKR TY I-C
- L REFL PAV MRKR TY II-A-A
- M OBJECT MARKER
- N RELF PAV MRK TY I (W) (ARROW)
- # SIGN NUMBER
- EXIST DIRECTION OF TRAFFIC
- ➔ PROP DIRECTION OF TRAFFIC
- ⦿ PROP WHITE FLX GF2 DELINEATOR (BI)

04/07/2021

Bo L. Ratto

0 25 50 100
1" = 100'

REV. NO.	DATE	DESCRIPTION	BY

CobbFendley 13430 Northwest Freeway, Ste. 1100
Houston, Texas 77040
713.462.3242
www.cobbfendley.com



Texas Department of Transportation

SIGNING AND PAVEMENT MARKING PLANS
STA 291+00 TO STA 313+00
SHEET 12 OF 35

FED. RD. DIV. NO.	STATE	PROJECT NO.	HIGHWAY NO.
6	TEXAS	(SEE TITLE SHEET)	US60
STATE DISTRICT	COUNTY	CONTROL NO.	SECTION NO.
AMA	GRAY	0169	07
		JOB NO.	SHEET NO.
		053, ETC	197

US60-Traf-SPM-12.dgn

4/7/2021 7:27:57 AM F:\P\Projects\2019\1004_Traffic\560-US60-AM\1161616\500-UST\1\509-Traffic\02-Signing\US60_TRAF-SPM-13.dgn

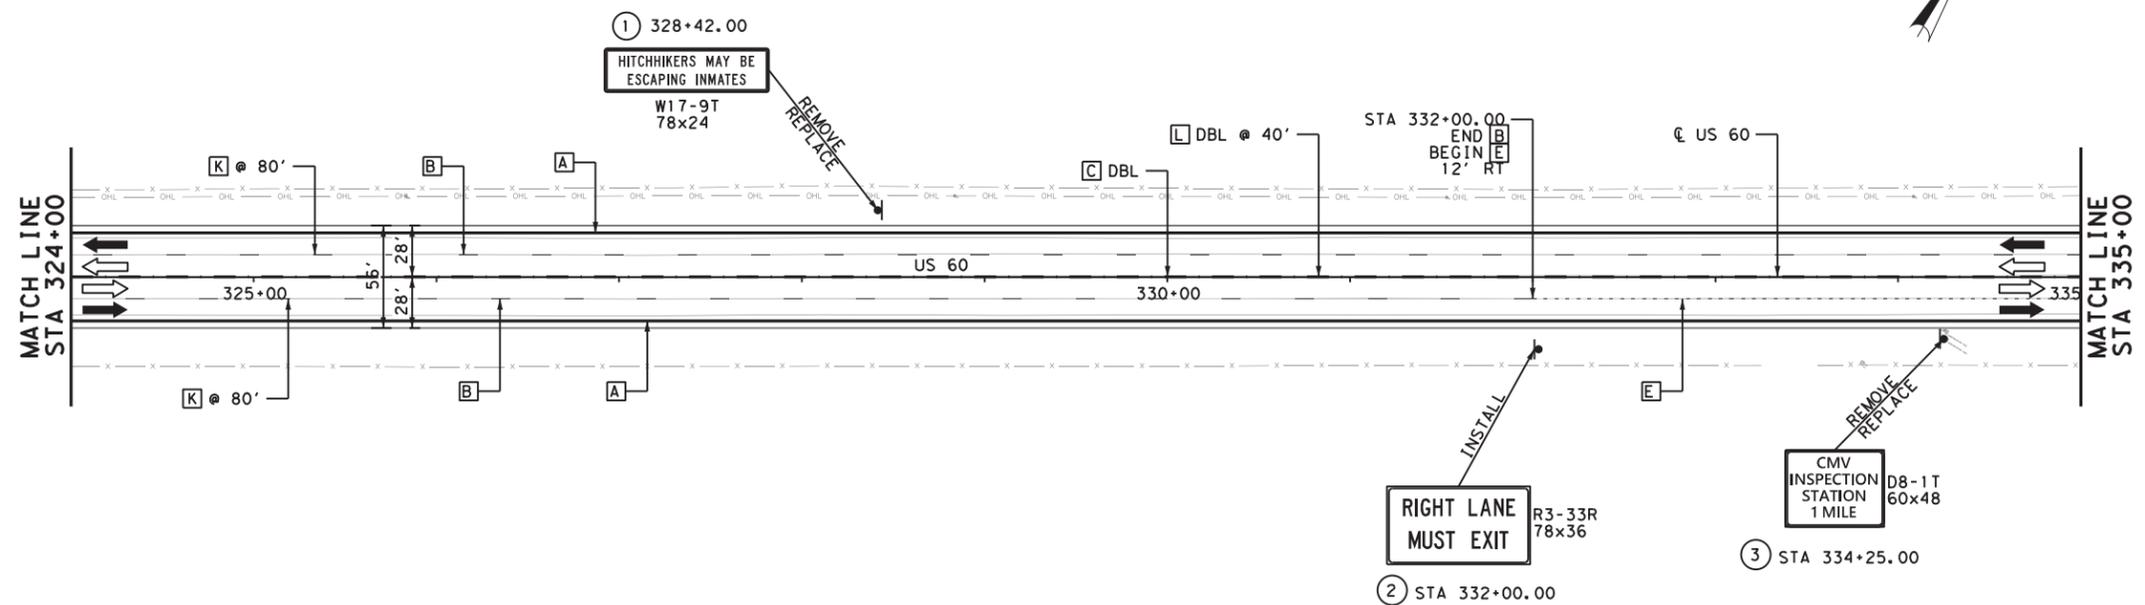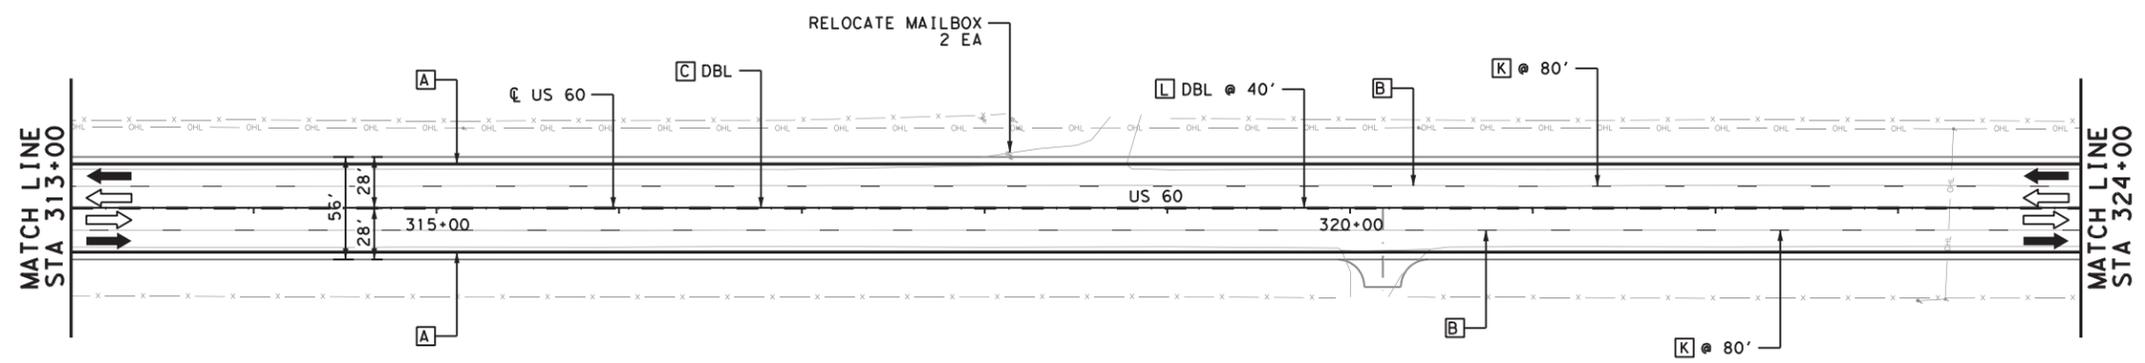

LEGEND

- A RE PM W/RET REQ TY I (W)4" (SLD)
- B RE PM W/RET REQ TY I (W)4" (BRK)
- C RE PM W/RET REQ TY I (Y)4" (SLD)
- D RE PM W/RET REQ TY I (Y)4" (BRK)
- E REFL PAV MRK TY I (W)4" (DOT)
- F REFL PAV MRK TY I (W)8" (SLD)
- G REFL PAV MRK TY I (W)12" (SLD)
- H REFL PAV MRK TY I (W)24" (SLD)
- I REFL PAV MRK TY I (Y)24" (SLD)
- J REFL PAV MRK TY I (W) (LNDPARW)
- K REFL PAV MRKR TY I-C
- L REFL PAV MRKR TY II-A-A
- M OBJECT MARKER
- N RELF PAV MRK TY I (W) (ARROW)
- # SIGN NUMBER
- EXIST DIRECTION OF TRAFFIC
- ➔ PROP DIRECTION OF TRAFFIC
- ⊙ PROP WHITE FLX GF2 DELINEATOR (BI)

04/07/2021

Bo L. Ratto

0 25 50 100
1" = 100'

REV. NO.	DATE	DESCRIPTION	BY

CobbFendley 13430 Northwest Freeway, Ste. 1100
Houston, Texas 77040
713.462.3242
www.cobbhendley.com





SIGNING AND PAVEMENT MARKING PLANS
STA 313+00 TO STA 335+00
SHEET 13 OF 35

FED. RD. DIV. NO.	STATE	PROJECT NO.	HIGHWAY NO.
6	TEXAS	(SEE TITLE SHEET)	US60
STATE DISTRICT	COUNTY	CONTROL NO.	SECTION NO.
AMA	GRAY	0169	07
		JOB NO.	SHEET NO.
		053, ETC	198

US60_TRAF-SPM-13.dgn

LEGEND

- A RE PM W/RET REQ TY I (W)4" (SLD)
- B RE PM W/RET REQ TY I (W)4" (BRK)
- C RE PM W/RET REQ TY I (Y)4" (SLD)
- D RE PM W/RET REQ TY I (Y)4" (BRK)
- E REFL PAV MRK TY I (W)4" (DOT)
- F REFL PAV MRK TY I (W)8" (SLD)
- G REFL PAV MRK TY I (W)12" (SLD)
- H REFL PAV MRK TY I (W)24" (SLD)
- I REFL PAV MRK TY I (Y)24" (SLD)
- J REFL PAV MRK TY I (W) (LNDPARW)
- K REFL PAV MRKR TY I-C
- L REFL PAV MRKR TY II-A-A
- M OBJECT MARKER
- N RELF PAV MRK TY I (W) (ARROW)
- Ⓢ SIGN NUMBER
- ⇨ EXIST DIRECTION OF TRAFFIC
- ⇩ PROP DIRECTION OF TRAFFIC
- ⊙ PROP WHITE FLX GF2 DELINEATOR (BI)

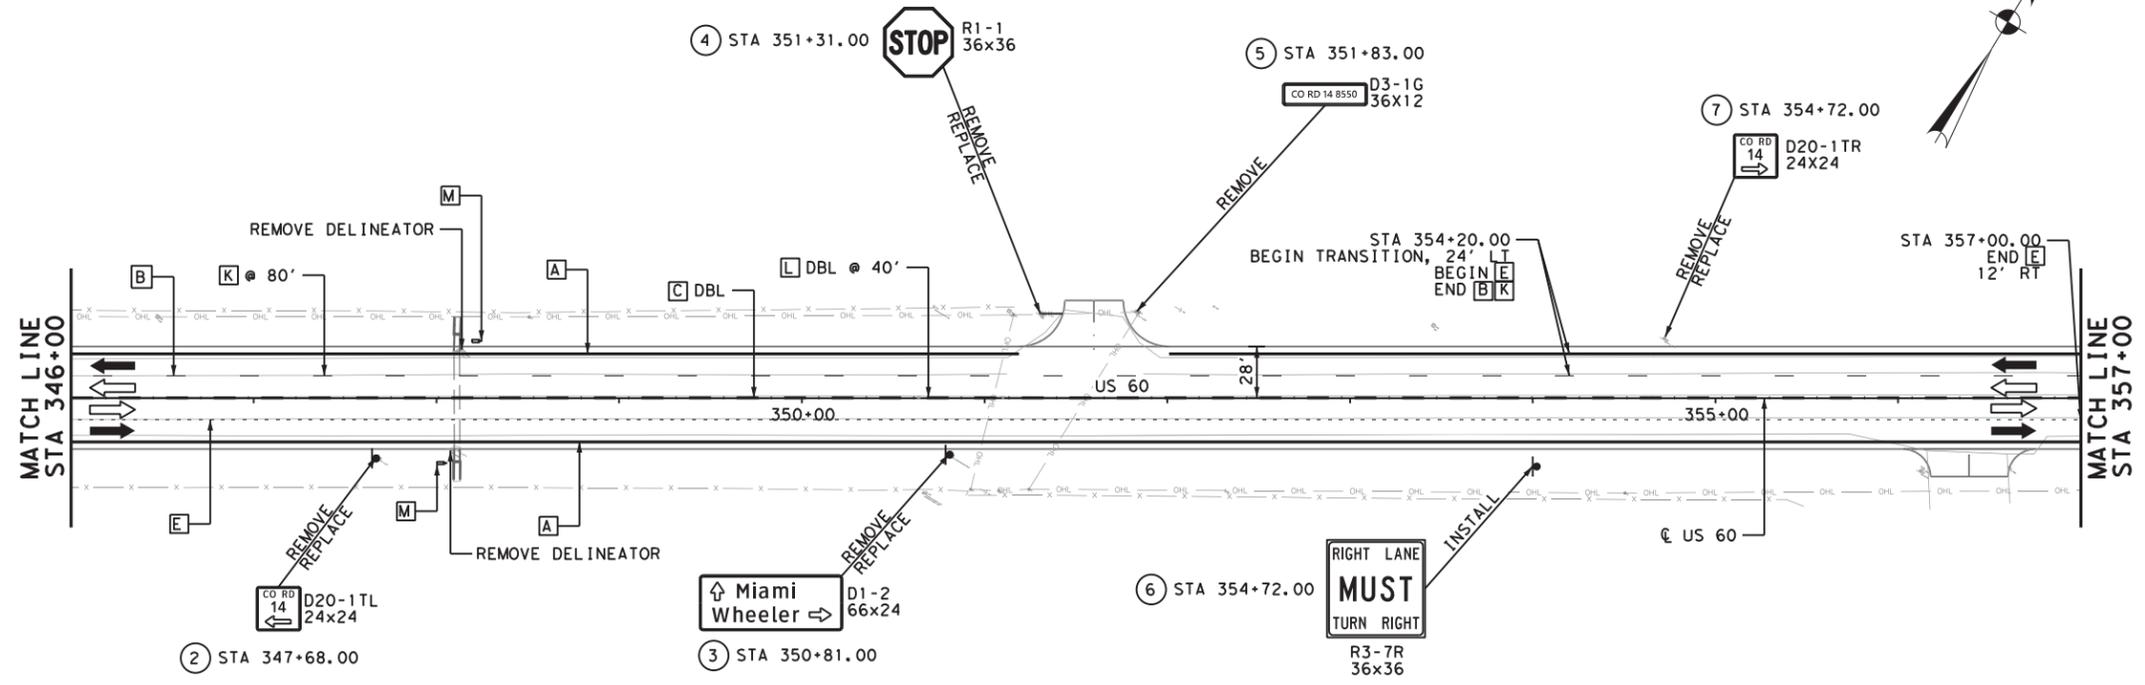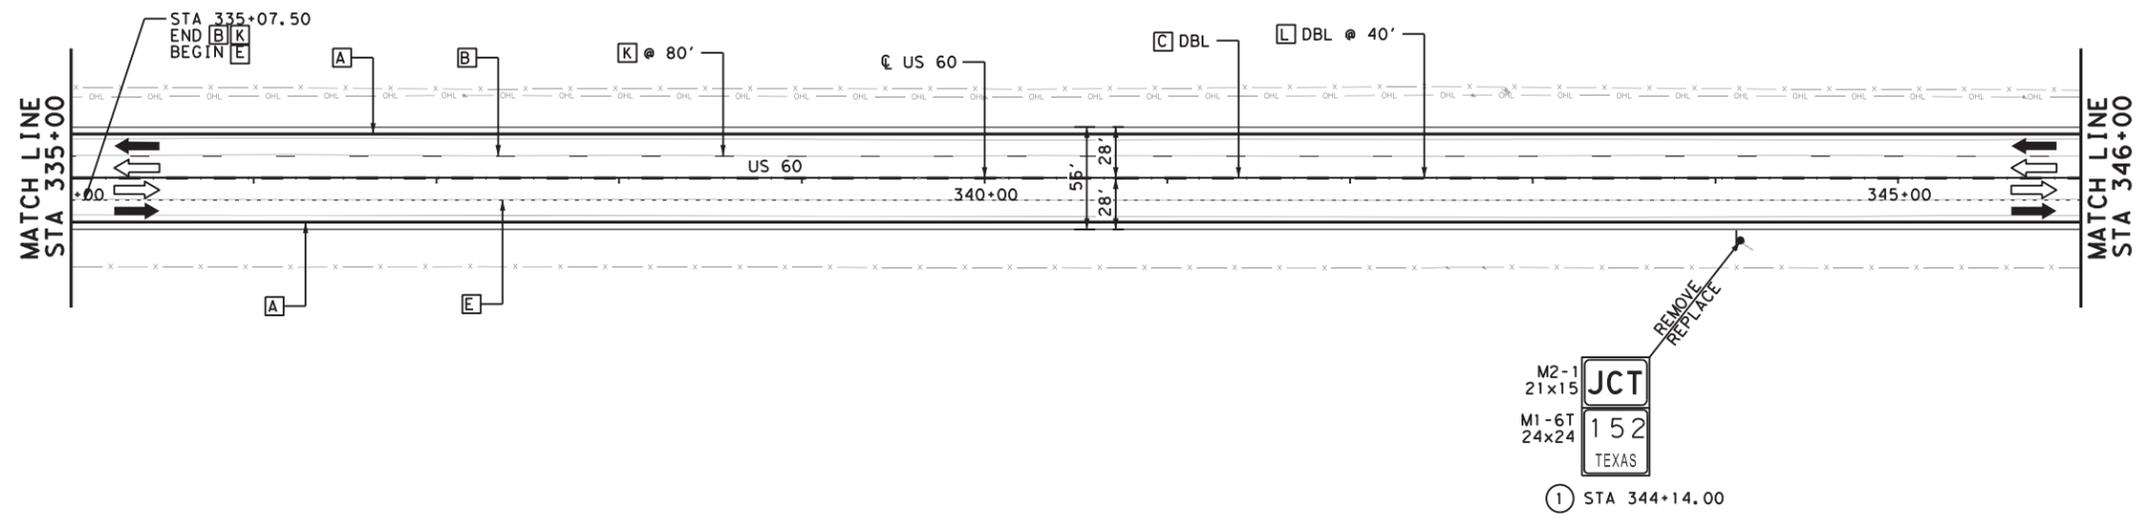

04/07/2021

Bo L. Ratto

0 25 50 100
1" = 100'

REV. NO.	DATE	DESCRIPTION	BY

CobbFendley 13430 Northwest Freeway, Ste. 1100
Houston, Texas 77040
713.462.3242
www.cobbendley.com

Texas Department of Transportation

SIGNING AND PAVEMENT MARKING PLANS
STA 335+00 TO STA 357+00
SHEET 14 OF 35

FED. RD. DIV. NO.	STATE	PROJECT NO.	HIGHWAY NO.
6	TEXAS	(SEE TITLE SHEET)	US60
STATE DISTRICT	COUNTY	CONTROL NO.	SECTION NO.
AMA	GRAY	0169	07
			JOB NO.
			053, ETC
			SHEET NO.
			199



4/7/2021 7:27:58 AM F:\P\Projects\2019\1004_Traffic\1016\US60-000\USTN\509-Traffic\02-Signing\US60_TRAF-SPM-14.dgn

LEGEND

- A RE PM W/RET REQ TY I (W) 4" (SLD)
- B RE PM W/RET REQ TY I (W) 4" (BRK)
- C RE PM W/RET REQ TY I (Y) 4" (SLD)
- D RE PM W/RET REQ TY I (Y) 4" (BRK)
- E REFL PAV MRK TY I (W) 4" (DOT)
- F REFL PAV MRK TY I (W) 8" (SLD)
- G REFL PAV MRK TY I (W) 12" (SLD)
- H REFL PAV MRK TY I (W) 24" (SLD)
- I REFL PAV MRK TY I (Y) 24" (SLD)
- J REFL PAV MRK TY I (W) (LNDPARW)
- K REFL PAV MRKR TY I-C
- L REFL PAV MRKR TY II-A-A
- M OBJECT MARKER
- N RELF PAV MRK TY I (W) (ARROW)
- # SIGN NUMBER
- EXIST DIRECTION OF TRAFFIC
- ➔ PROP DIRECTION OF TRAFFIC
- ☉ PROP WHITE FLX GF2 DELINEATOR (BI)

NOTE:

1. SEE US60 & SH152 INTERSECTION LAYOUT FOR PAVEMENT MARKING LAYOUT.
- * STOP SIGN WITH SOLAR PANEL UNIT TO BE RELOCATED TO STA 382+04.00 AT NEW PROPOSED SH 152 AND US 60 INTERSECTION.

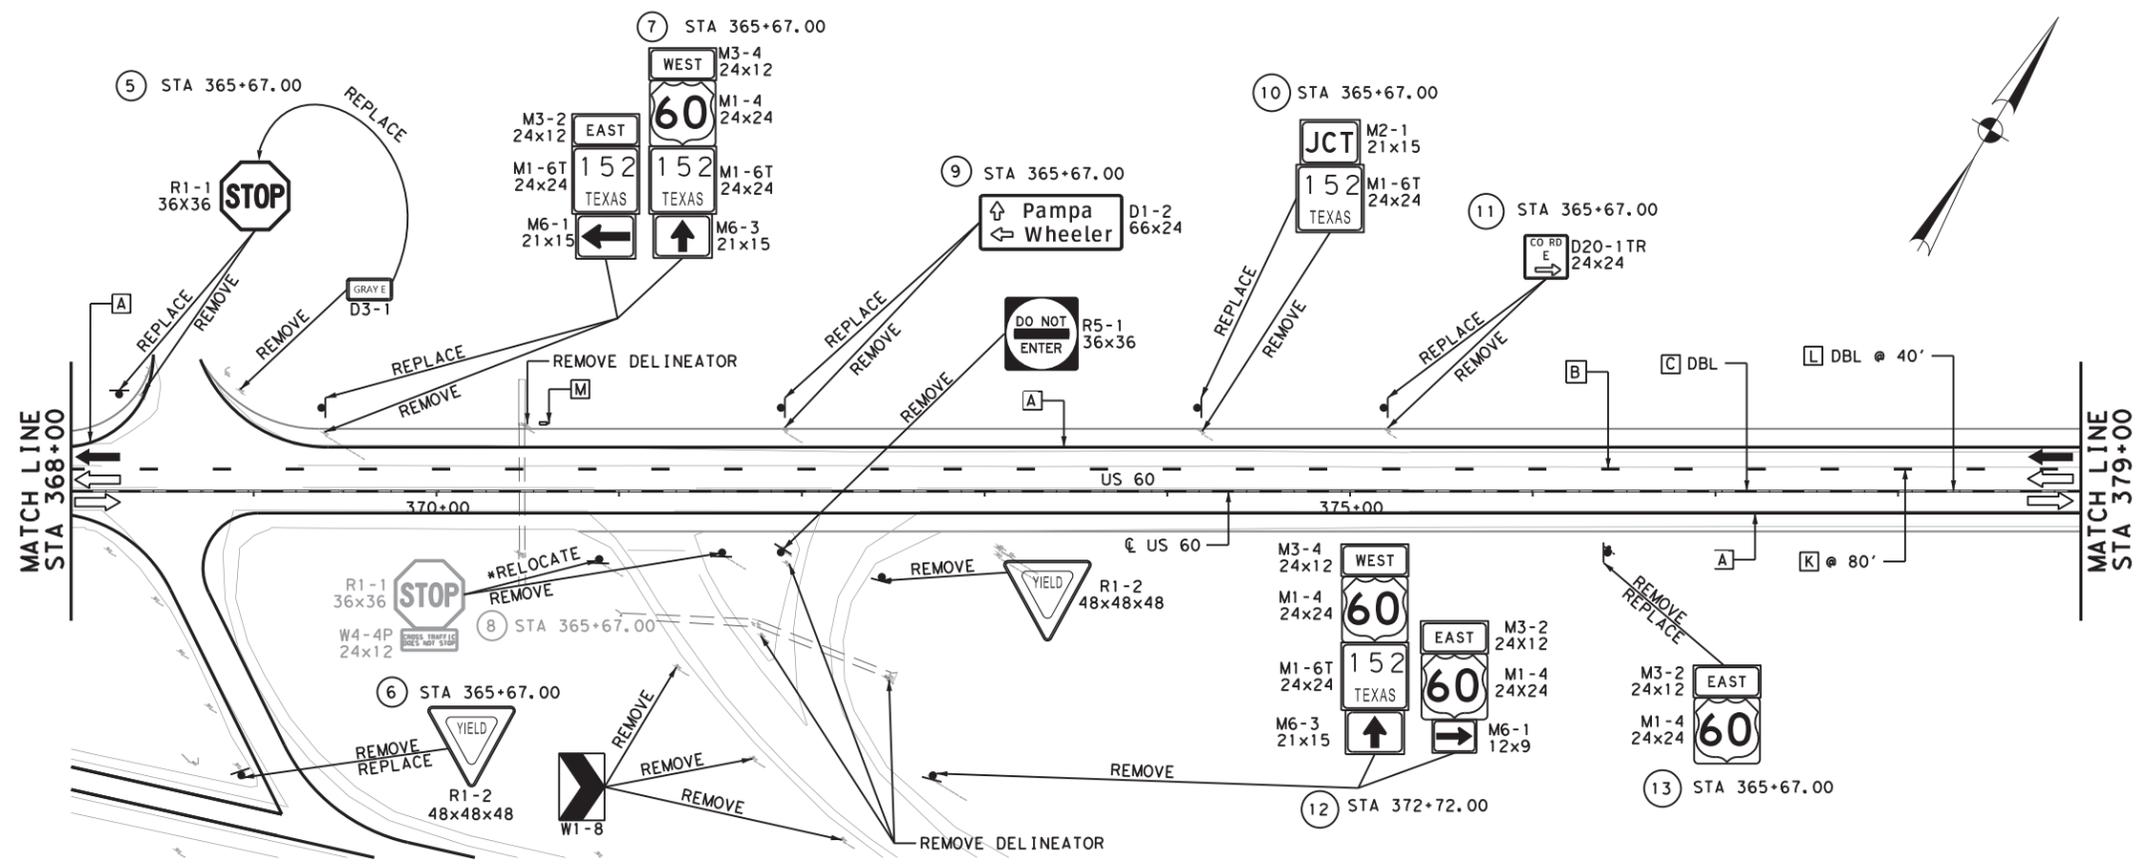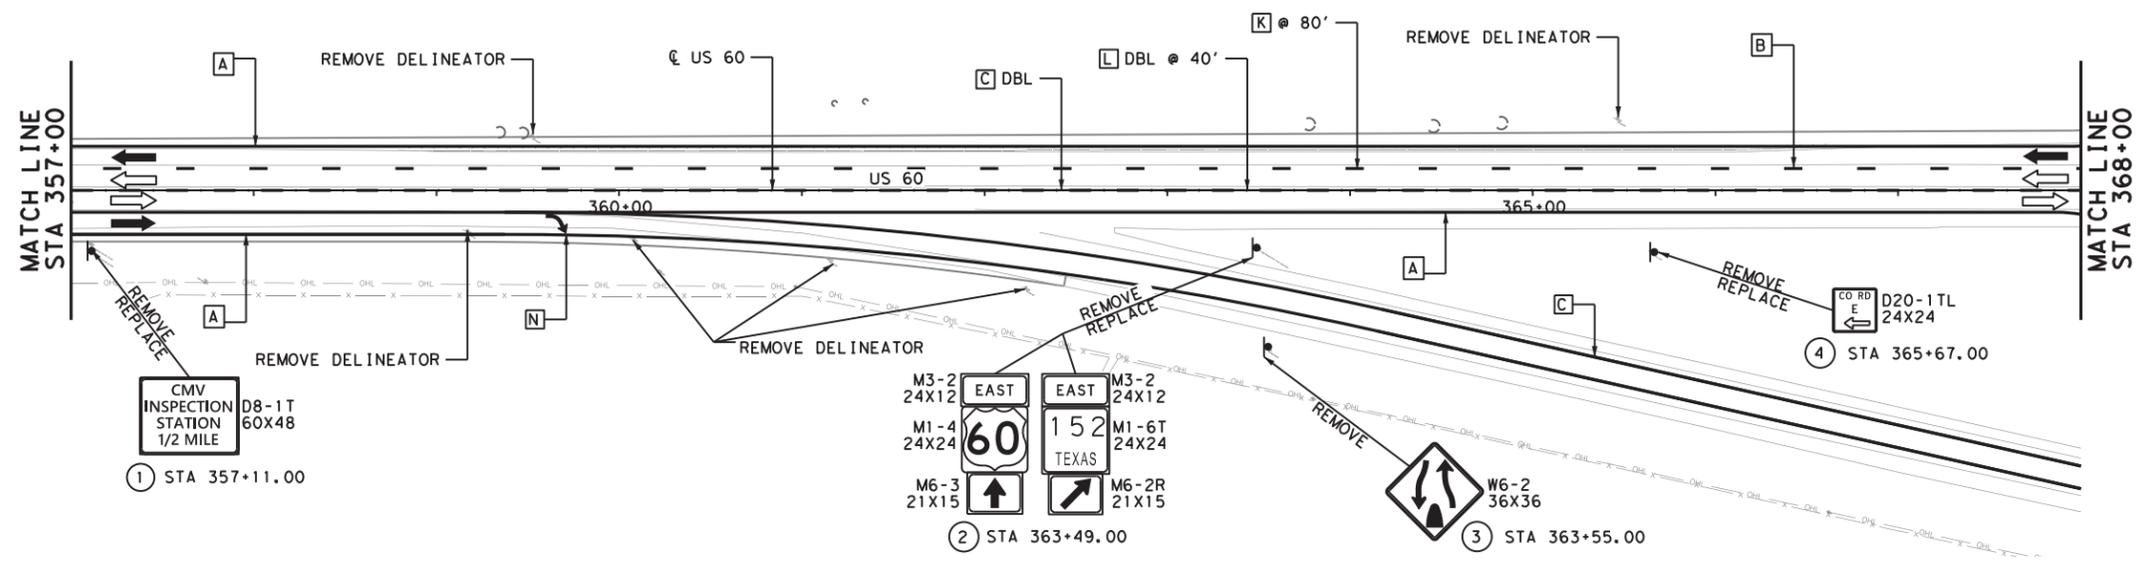

04/07/2021

Bo L. Ratto
Professional Engineer

REV. NO.	DATE	DESCRIPTION	BY

CobbFendley 13430 Northwest Freeway, Ste. 1100
Houston, Texas 77040
713.462.3242
www.cobbhendley.com




SIGNING AND PAVEMENT MARKING PLANS
STA 357+00 TO STA 379+00
SHEET 15 OF 35

FED. RD. DIV. NO.	STATE	PROJECT NO.	HIGHWAY NO.
6	TEXAS	(SEE TITLE SHEET)	US60
STATE DISTRICT	COUNTY	CONTROL NO.	SECTION NO.
AMA	GRAY	0169	07
			JOB NO.
			053, ETC
			SHEET NO.
			200


4/7/2021 7:27:59 AM F:\Proj\6218\2019\1004_Traffic\560_Amanti\616\616\500\UST\N\509-Traffic\02-Signing\US60_Traf-Sign-15.dgn

LEGEND

- A RE PM W/RET REQ TY I (W) 4" (SLD)
- B RE PM W/RET REQ TY I (W) 4" (BRK)
- C RE PM W/RET REQ TY I (Y) 4" (SLD)
- D RE PM W/RET REQ TY I (Y) 4" (BRK)
- E REFL PAV MRK TY I (W) 4" (DOT)
- F REFL PAV MRK TY I (W) 8" (SLD)
- G REFL PAV MRK TY I (W) 12" (SLD)
- H REFL PAV MRK TY I (W) 24" (SLD)
- I REFL PAV MRK TY I (Y) 24" (SLD)
- J REFL PAV MRK TY I (W) (LNDPARW)
- K REFL PAV MRKR TY I-C
- L REFL PAV MRKR TY II-A-A
- M OBJECT MARKER
- N RELF PAV MRK TY I (W) (ARROW)
- # SIGN NUMBER
- EXIST DIRECTION OF TRAFFIC
- ➔ PROP DIRECTION OF TRAFFIC
- ⊙ PROP WHITE FLX GF2 DELINEATOR (BI)

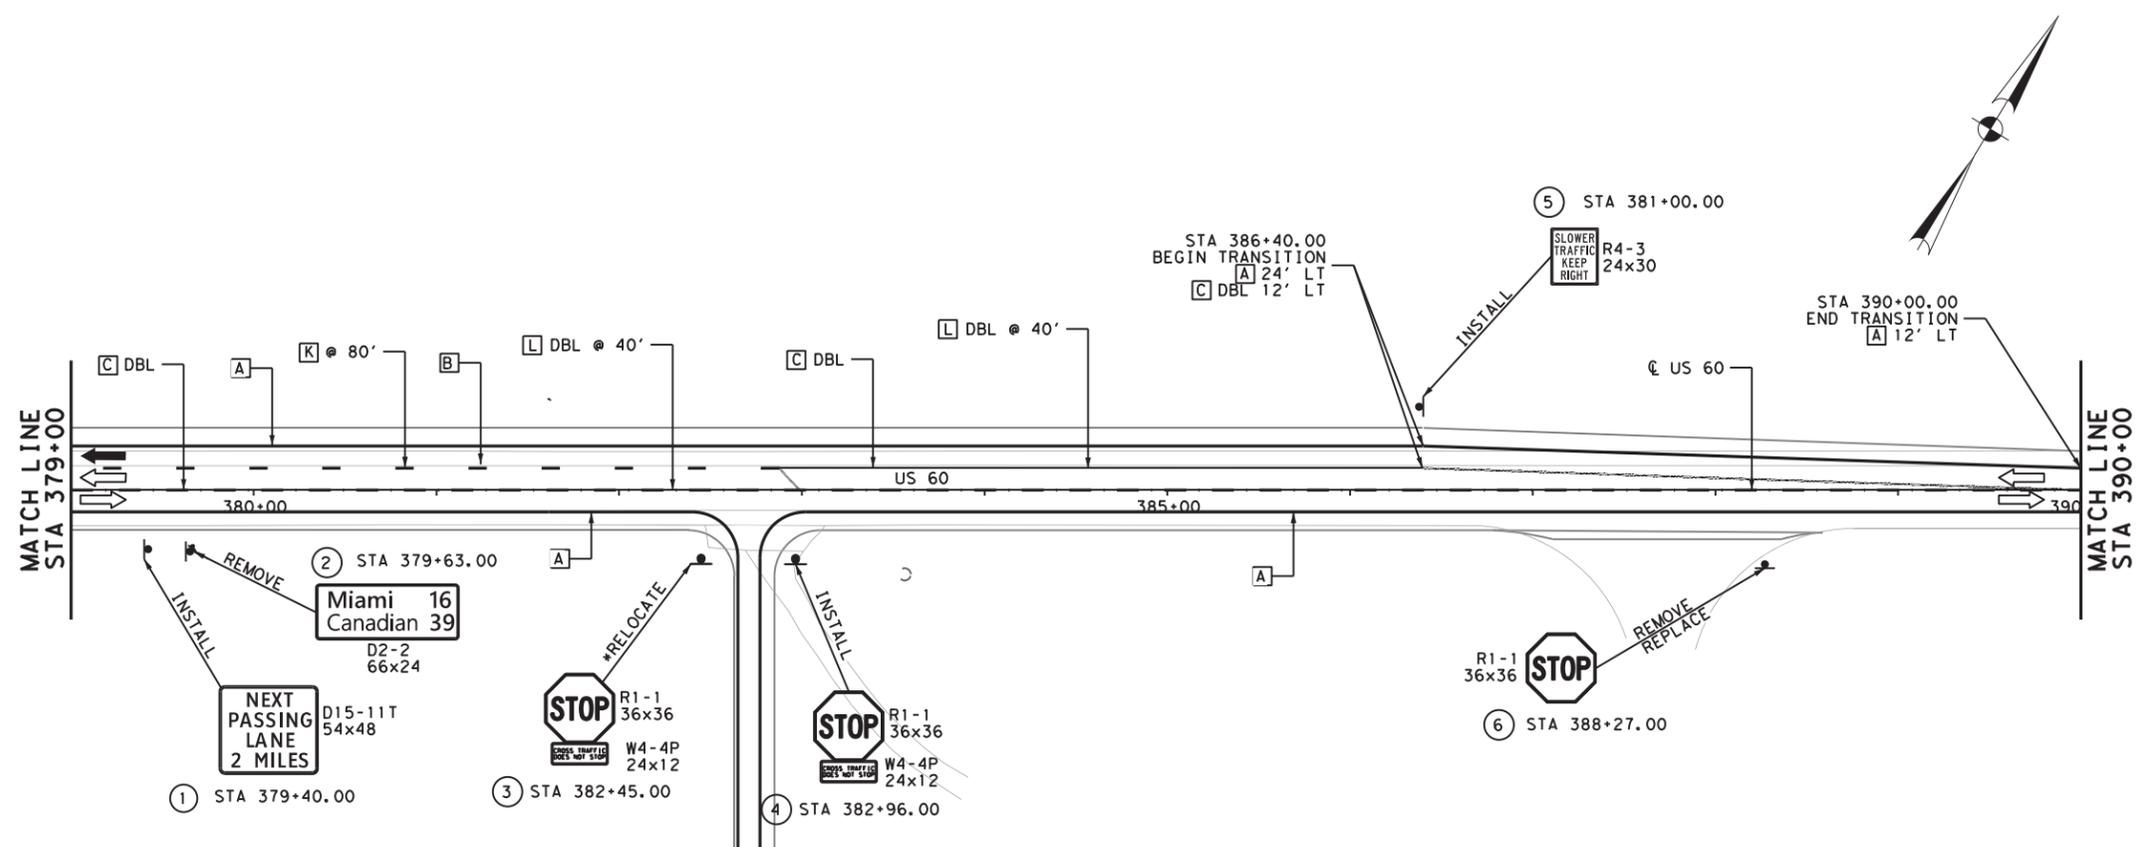

* SIGN WITH SOLAR UNIT TO BE REPLACE AT APPROX STA 382+45.00

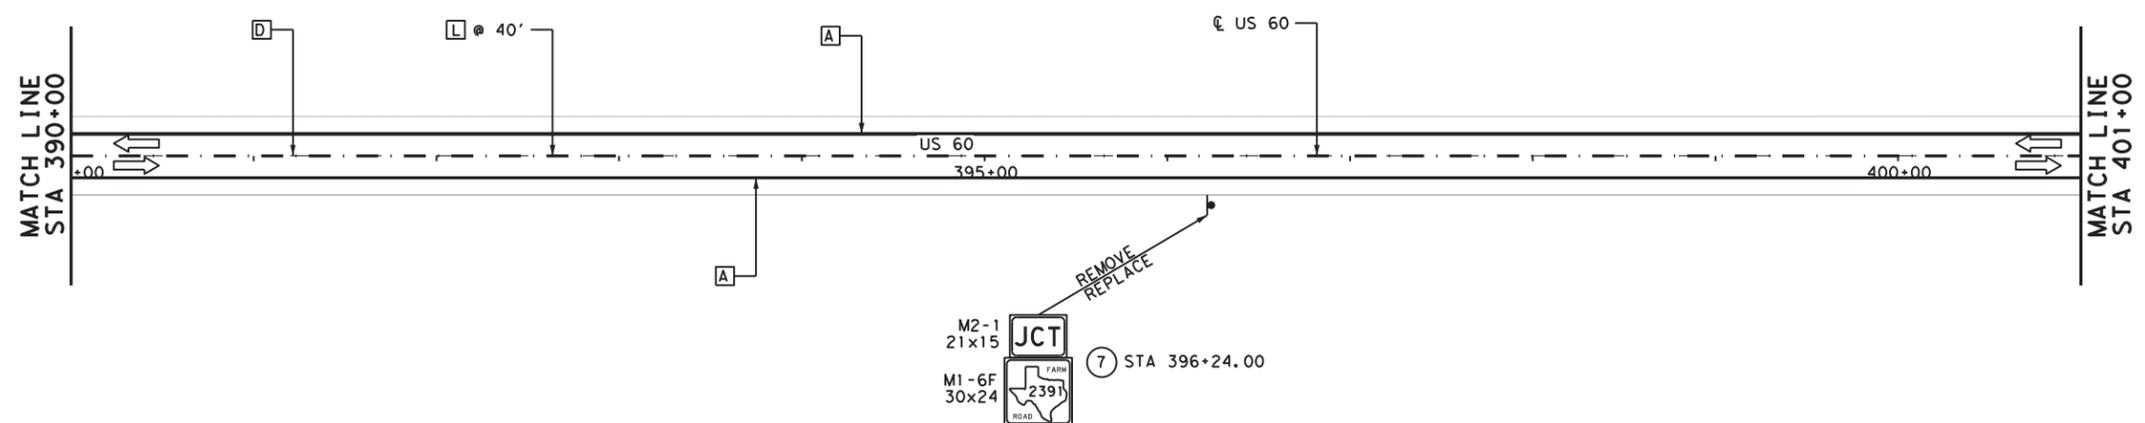

04/07/2021

Bo L. Ratto

0 25 50 100
1" = 100'

REV. NO.	DATE	DESCRIPTION	BY

CobbFendley 13430 Northwest Freeway, Ste. 1100
Houston, Texas 77040
713.462.3242
www.cobbhendley.com



SIGNING AND PAVEMENT MARKING PLANS
STA 379+00 TO STA 401+00
SHEET 16 OF 35



FED. RD. DIV. NO.	STATE	PROJECT NO.	HIGHWAY NO.
6	TEXAS	(SEE TITLE SHEET)	US60
STATE DISTRICT	COUNTY	CONTROL NO.	SECTION NO.
AMA	GRAY	0169	07
			JOB NO. SHEET NO.
			053, ETC 201

4/7/2021 7:28:00 AM F:\P\J\1616\1616\US60-TRAFFIC\02-Signing\US60-TRAFF-SPM-16.dgn

US60-TRAFF-SPM-16.dgn

LEGEND

- A RE PM W/RET REQ TY I (W) 4" (SLD)
- B RE PM W/RET REQ TY I (W) 4" (BRK)
- C RE PM W/RET REQ TY I (Y) 4" (SLD)
- D RE PM W/RET REQ TY I (Y) 4" (BRK)
- E REFL PAV MRK TY I (W) 4" (DOT)
- F REFL PAV MRK TY I (W) 8" (SLD)
- G REFL PAV MRK TY I (W) 12" (SLD)
- H REFL PAV MRK TY I (W) 24" (SLD)
- I REFL PAV MRK TY I (Y) 24" (SLD)
- J REFL PAV MRK TY I (W) (LNDPARW)
- K REFL PAV MRKR TY I-C
- L REFL PAV MRKR TY II-A-A
- M OBJECT MARKER
- N RELF PAV MRK TY I (W) (ARROW)
- # SIGN NUMBER
- ⇨ EXIST DIRECTION OF TRAFFIC
- ⇩ PROP DIRECTION OF TRAFFIC
- ☉ PROP WHITE FLX GF2 DELINEATOR (BI)

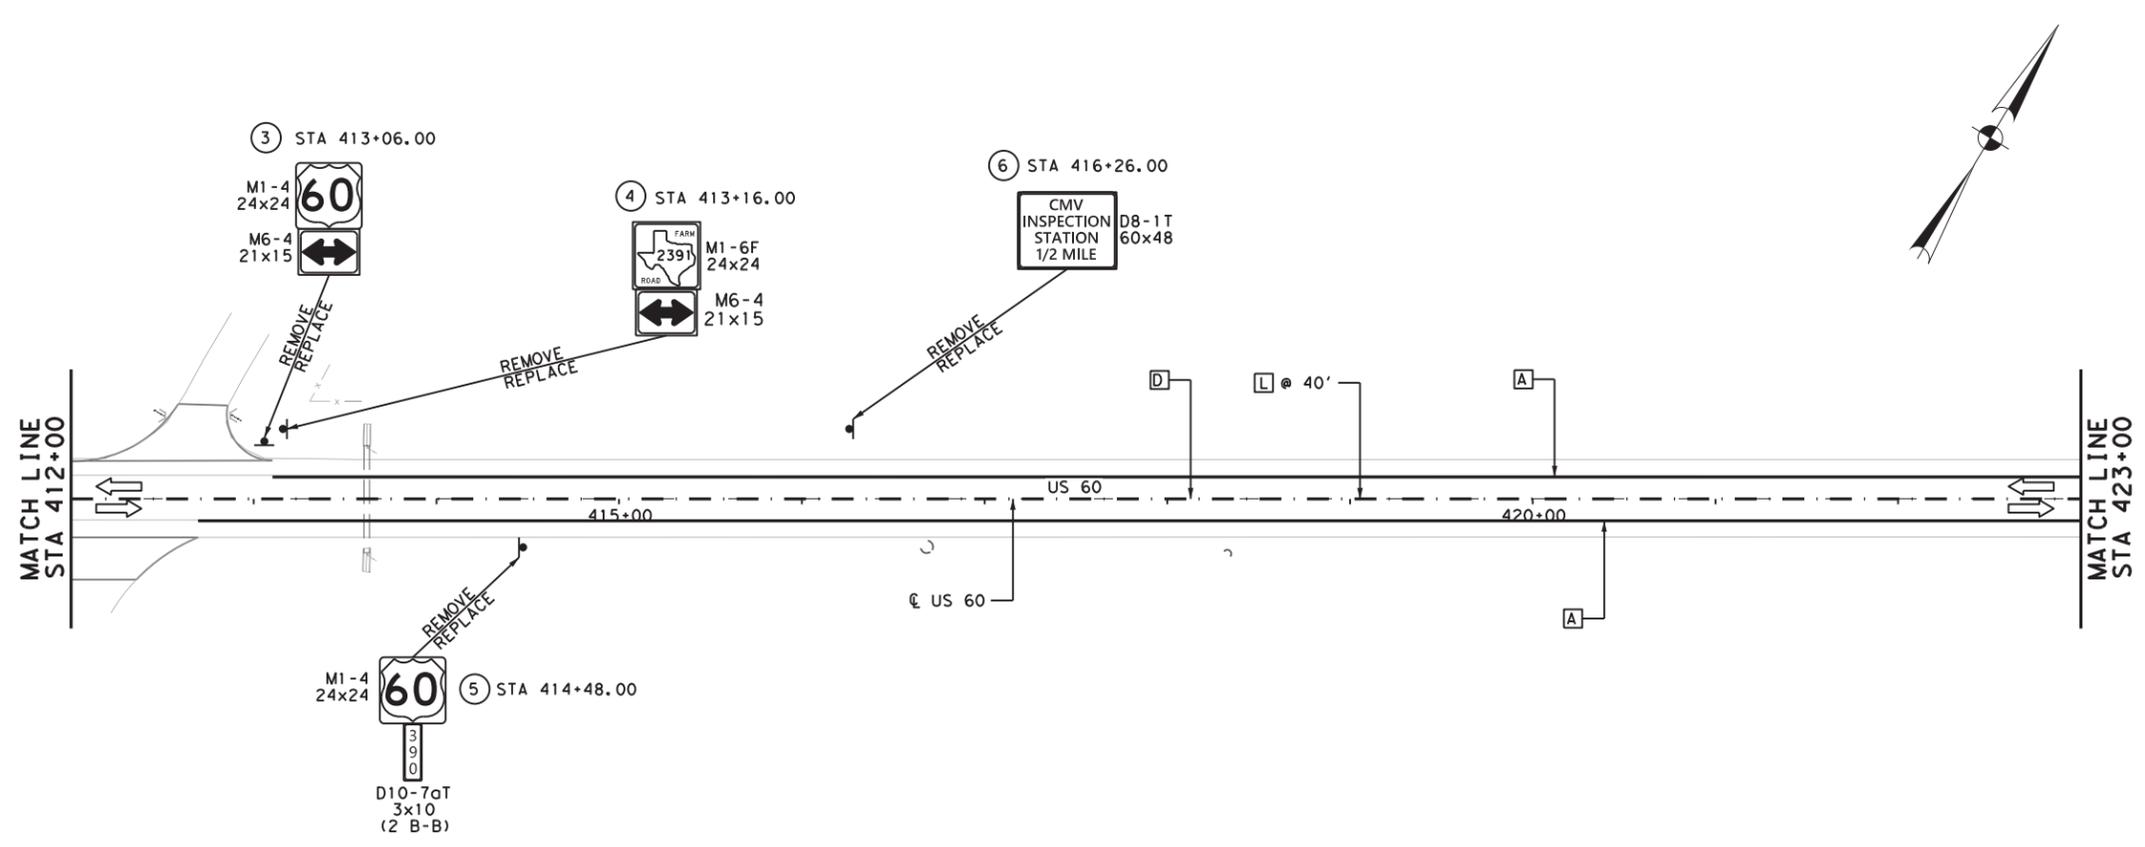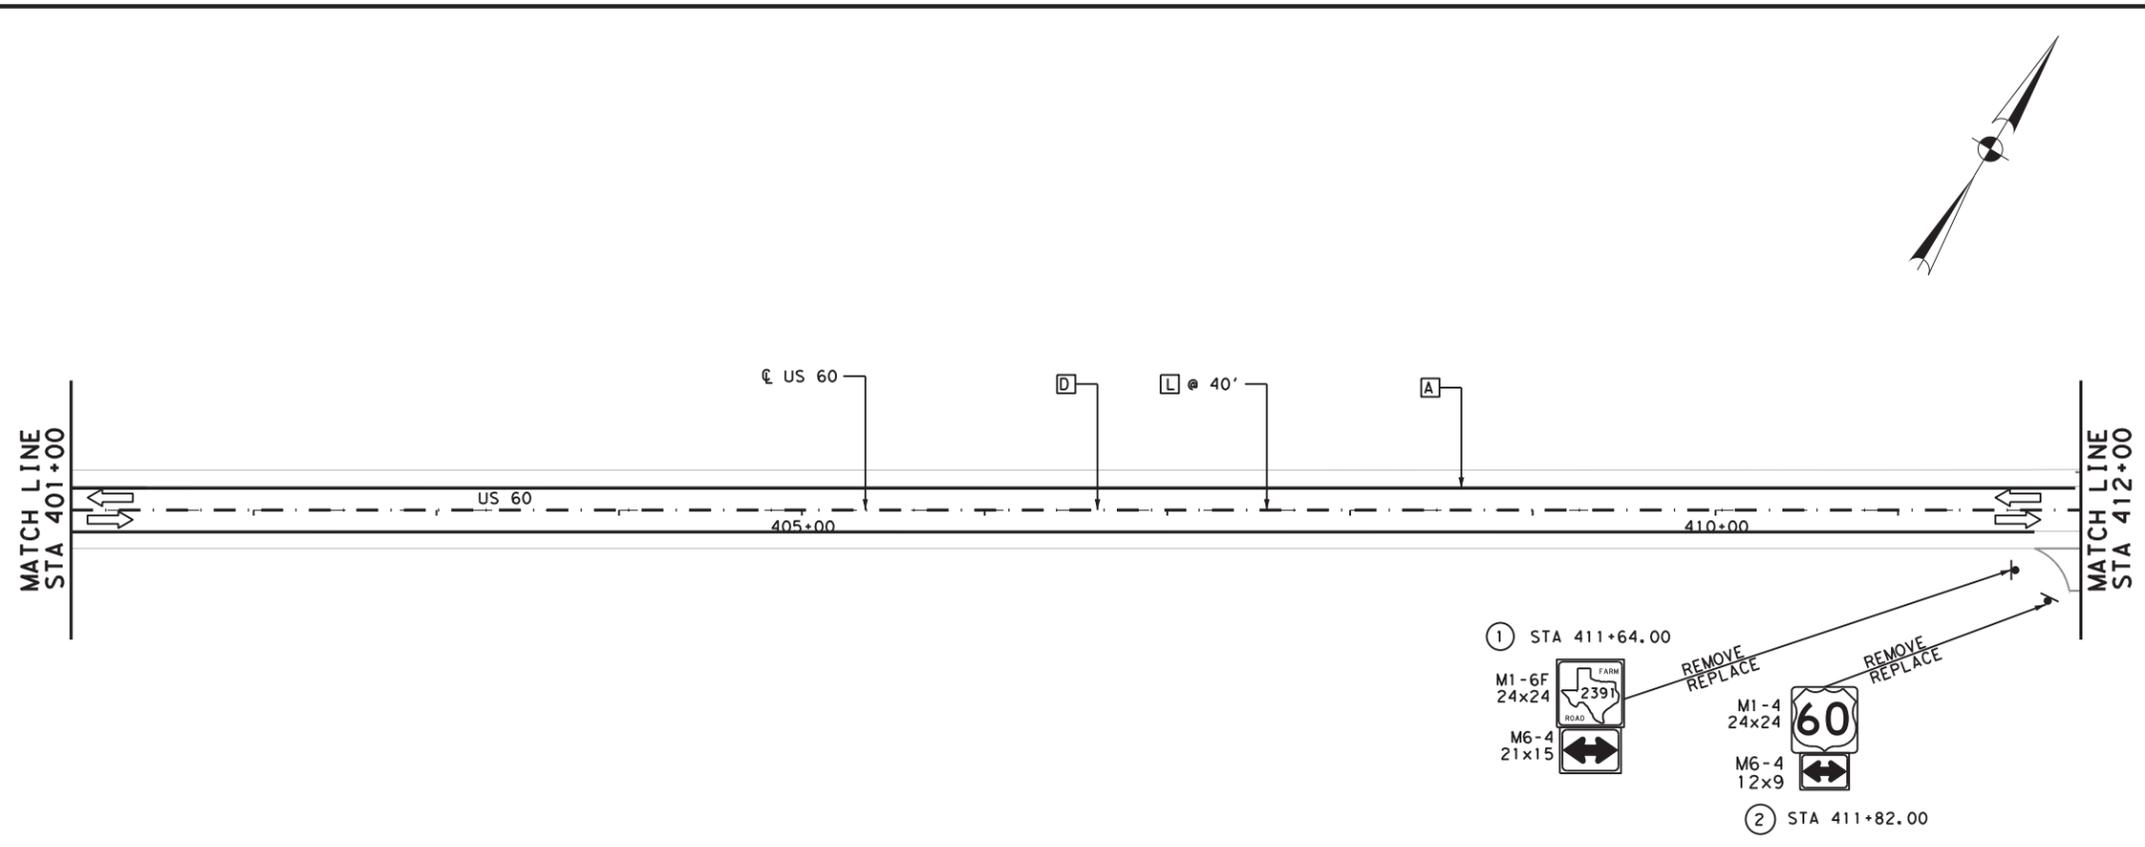

04/07/2021

Bo L. Ratto

REV. NO.	DATE	DESCRIPTION	BY

CobbFendley 13430 Northwest Freeway, Ste. 1100
Houston, Texas 77040
713.462.3242
www.cobbhendley.com

Texas Department of Transportation


SIGNING AND PAVEMENT MARKING PLANS
STA 401+00 TO STA 423+00
SHEET 17 OF 35

FED. RD. DIV. NO.	STATE	PROJECT NO.	HIGHWAY NO.
6	TEXAS	(SEE TITLE SHEET)	US60
STATE DISTRICT	COUNTY	CONTROL NO.	SECTION NO.
AMA	GRAY	0169	07
			JOB NO.
			053, ETC
			SHEET NO.
			202

4/7/2021 7:28:01 AM F:\Proj\62019\1004_Traffic\5x10_PSS&E\03_US60_Amarr\11616\6500\USTN\509-Traffic\02-Sheets\US60_TRAF-SPM17.dgn

US60_TRAF-SPM17.dgn

4/7/2021 7:28:02 AM F:\Proj\62019\1004_Traffic\DOT_515_P5&E\03_US60_Amanti\616\616\500-UST\1\509-Traffic\02-Sheets\US60_TRAF-SPM-18.dgn

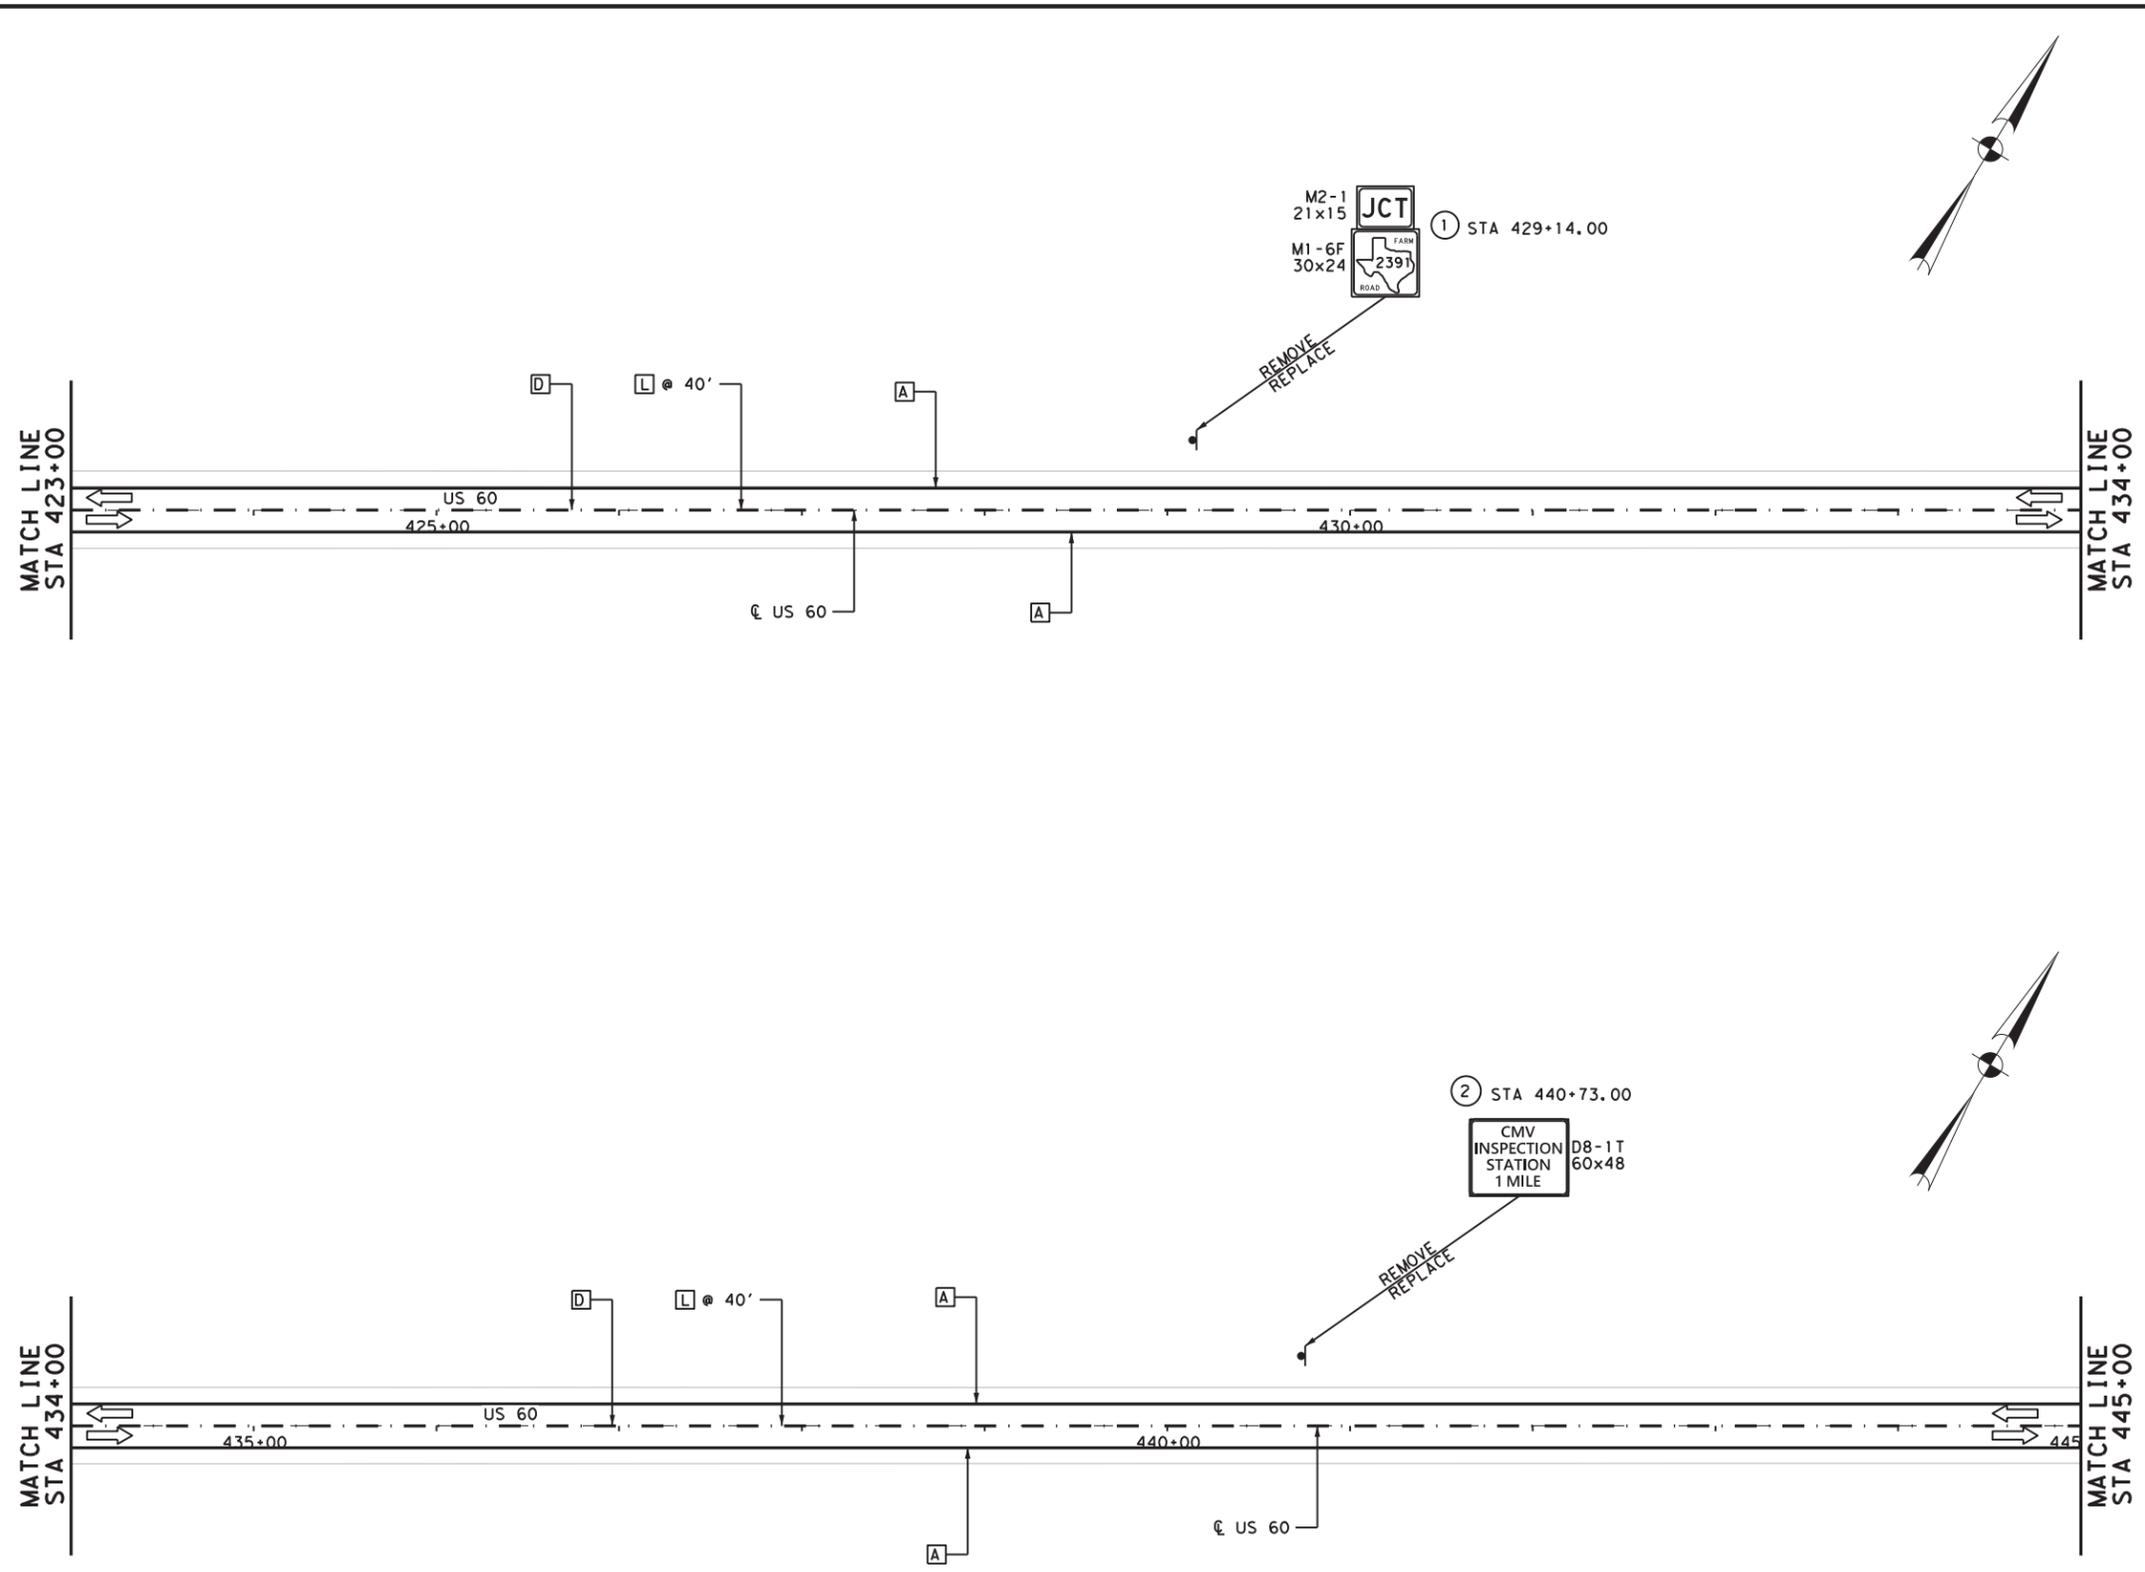

LEGEND

- A RE PM W/RET REQ TY I (W) 4" (SLD)
- B RE PM W/RET REQ TY I (W) 4" (BRK)
- C RE PM W/RET REQ TY I (Y) 4" (SLD)
- D RE PM W/RET REQ TY I (Y) 4" (BRK)
- E REFL PAV MRK TY I (W) 4" (DOT)
- F REFL PAV MRK TY I (W) 8" (SLD)
- G REFL PAV MRK TY I (W) 12" (SLD)
- H REFL PAV MRK TY I (W) 24" (SLD)
- I REFL PAV MRK TY I (Y) 24" (SLD)
- J REFL PAV MRK TY I (W) (LNDPARW)
- K REFL PAV MRKR TY I-C
- L REFL PAV MRKR TY II-A-A
- M OBJECT MARKER
- N RELF PAV MRK TY I (W) (ARROW)
- # SIGN NUMBER
- ⇨ EXIST DIRECTION OF TRAFFIC
- ⇨ PROP DIRECTION OF TRAFFIC
- ☉ PROP WHITE FLX GF2 DELINEATOR (BI)

04/07/2021

Bo L. Ratto

0 25 50 100
1" = 100'

REV. NO.	DATE	DESCRIPTION	BY

CobbFendley 13430 Northwest Freeway, Ste. 1100
Houston, Texas 77040
713.462.3242
www.cobbhendley.com





SIGNING AND PAVEMENT MARKING PLANS
STA 423+00 TO STA 445+00
SHEET 18 OF 35

FED. RD. DIV. NO.	STATE	PROJECT NO.		HIGHWAY NO.
6	TEXAS	(SEE TITLE SHEET)		US60
STATE DISTRICT	COUNTY	CONTROL NO.	SECTION NO.	JOB SHEET NO.
AMA	GRAY	0169	07	053, ETC 203

US60_TRAF-SPM-18.dgn

4/7/2021 7:28:03 AM F:\P\Jedr\2019\1004_Tx\DOT_dx3_Ps&E\03_US60_Amar\116\EN\500-UST\N\509-Traffic\02-Sheets\US60_TRAF-SFM\19.dgn

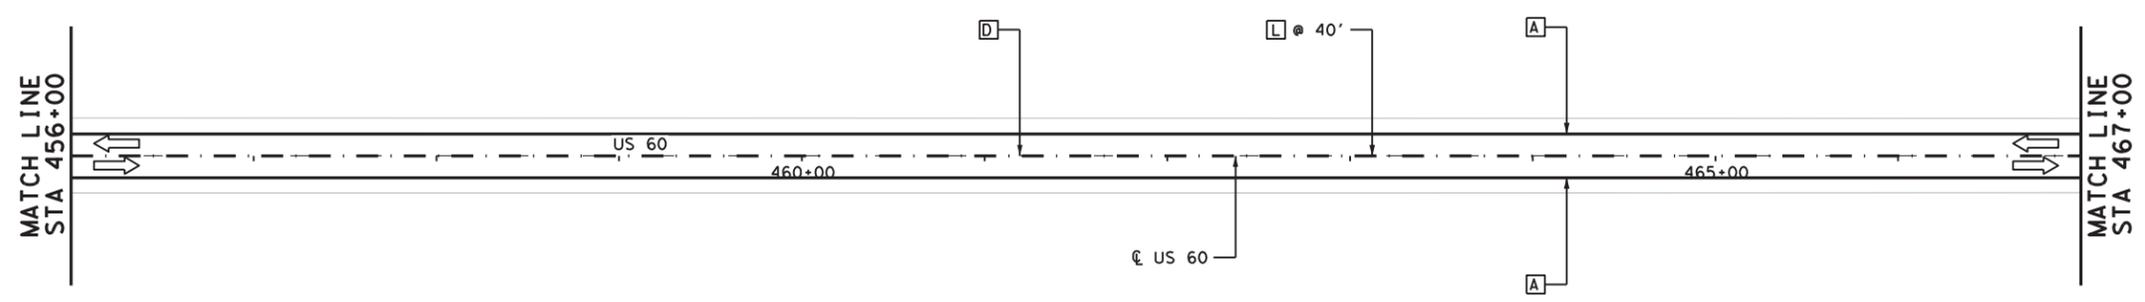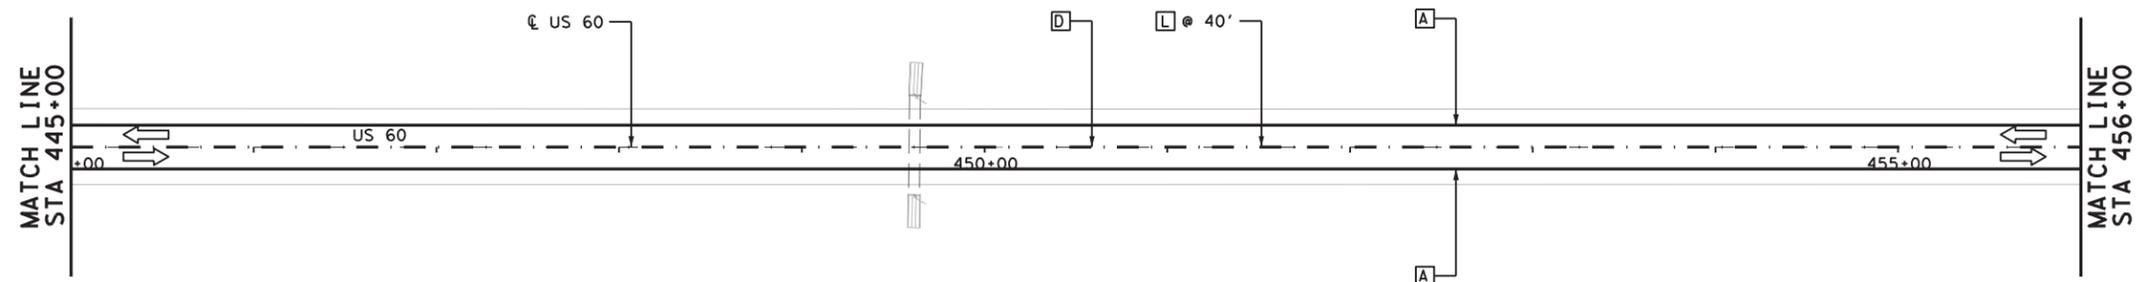

LEGEND

- A RE PM W/RET REQ TY I (W) 4" (SLD)
- B RE PM W/RET REQ TY I (W) 4" (BRK)
- C RE PM W/RET REQ TY I (Y) 4" (SLD)
- D RE PM W/RET REQ TY I (Y) 4" (BRK)
- E REFL PAV MRK TY I (W) 4" (DOT)
- F REFL PAV MRK TY I (W) 8" (SLD)
- G REFL PAV MRK TY I (W) 12" (SLD)
- H REFL PAV MRK TY I (W) 24" (SLD)
- I REFL PAV MRK TY I (Y) 24" (SLD)
- J REFL PAV MRK TY I (W) (LNDPARW)
- K REFL PAV MRKR TY I-C
- L REFL PAV MRKR TY II-A-A
- M OBJECT MARKER
- N RELF PAV MRK TY I (W) (ARROW)
- # SIGN NUMBER
- ⇄ EXIST DIRECTION OF TRAFFIC
- ➔ PROP DIRECTION OF TRAFFIC
- ☉ PROP WHITE FLX GF2 DELINEATOR (BI)

04/07/2021

Bo L. Ratto

REV. NO.	DATE	DESCRIPTION	BY

CobbFendley 13430 Northwest Freeway, Ste. 1100
Houston, Texas 77040
713.462.3242
www.cobbhendley.com





SIGNING AND PAVEMENT MARKING PLANS
STA 445+00 TO STA 467+00
SHEET 19 OF 35

FED. RD. DIV. NO.	STATE	PROJECT NO.	HIGHWAY NO.
6	TEXAS	(SEE TITLE SHEET)	US60
STATE DISTRICT	COUNTY	CONTROL NO.	SECTION NO.
AMA	GRAY	0169	07
			JOB NO.
			053, ETC
			SHEET NO.
			204

US60_TRAF-SFM\19.dgn

LEGEND

- A RE PM W/RET REQ TY I (W) 4" (SLD)
- B RE PM W/RET REQ TY I (W) 4" (BRK)
- C RE PM W/RET REQ TY I (Y) 4" (SLD)
- D RE PM W/RET REQ TY I (Y) 4" (BRK)
- E REFL PAV MRK TY I (W) 4" (DOT)
- F REFL PAV MRK TY I (W) 8" (SLD)
- G REFL PAV MRK TY I (W) 12" (SLD)
- H REFL PAV MRK TY I (W) 24" (SLD)
- I REFL PAV MRK TY I (Y) 24" (SLD)
- J REFL PAV MRK TY I (W) (LNDPARW)
- K REFL PAV MRKR TY I-C
- L REFL PAV MRKR TY II-A-A
- M OBJECT MARKER
- N RELF PAV MRK TY I (W) (ARROW)
- # SIGN NUMBER
- ⇨ EXIST DIRECTION OF TRAFFIC
- ⇩ PROP DIRECTION OF TRAFFIC
- ⊙ PROP WHITE FLX GF2 DELINEATOR (BI)

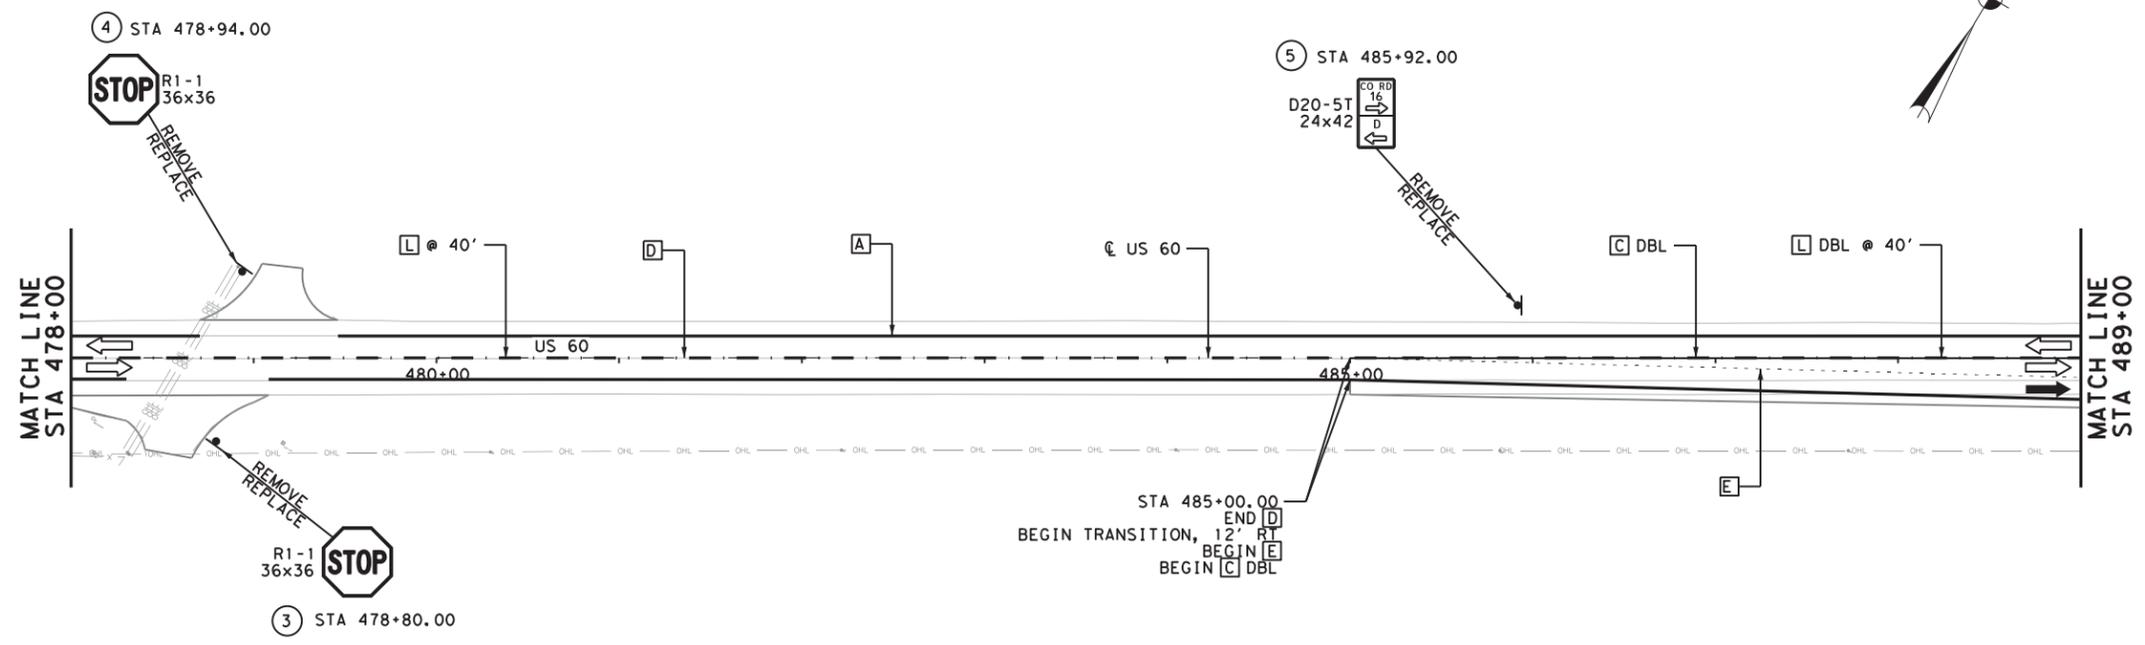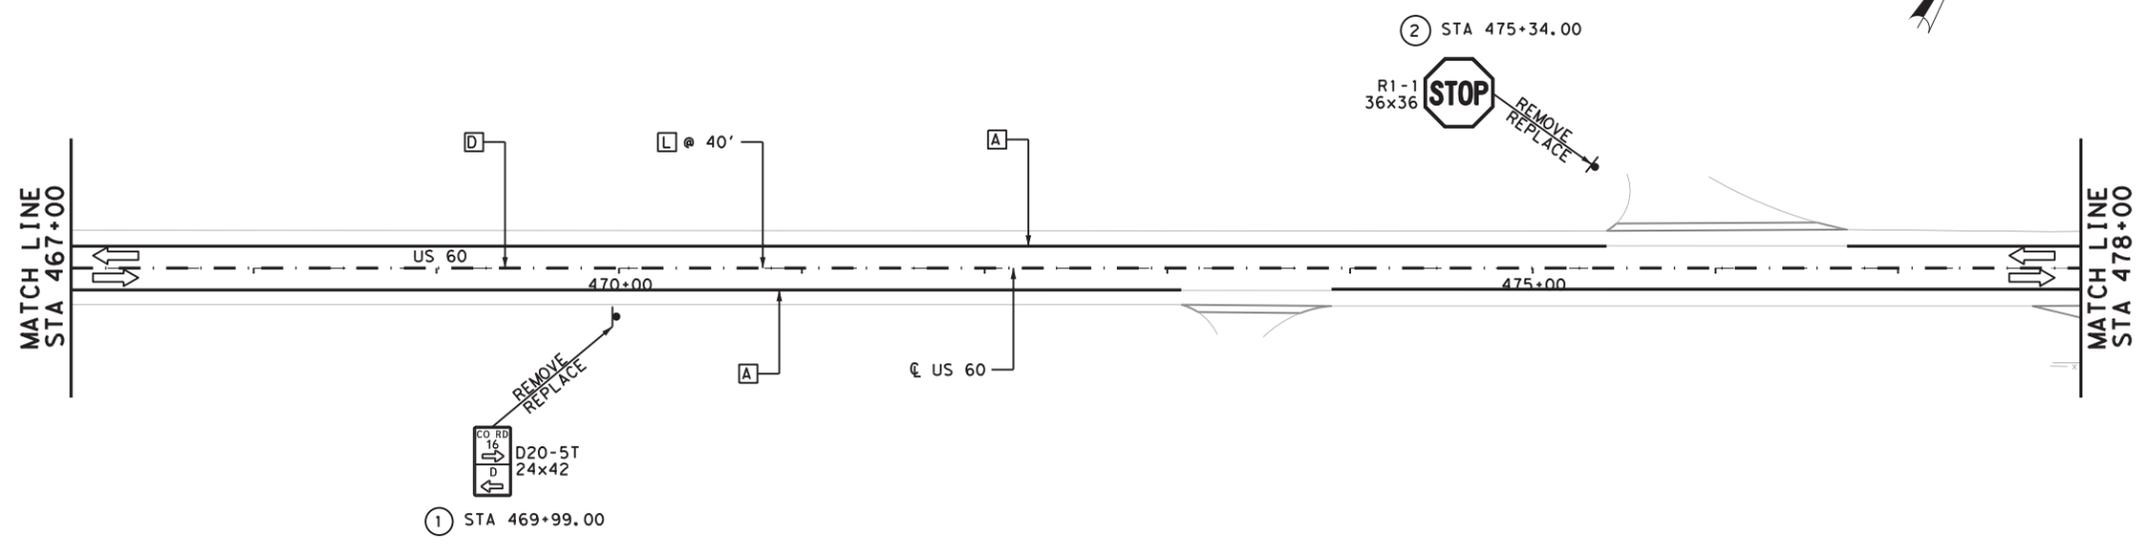

04/07/2021

Bo L. Ratto

0 25 50 100
1" = 100'

REV. NO.	DATE	DESCRIPTION	BY

CobbFendley 13430 Northwest Freeway, Ste. 1100
Houston, Texas 77040
713.462.3242
www.cobbhendley.com

Texas Department of Transportation


SIGNING AND PAVEMENT MARKING PLANS
STA 467+00 TO STA 489+00

SHEET 20 OF 35

FED. RD. DIV. NO.	STATE	PROJECT NO.	HIGHWAY NO.
6	TEXAS	(SEE TITLE SHEET)	US60
STATE DISTRICT	COUNTY	CONTROL NO.	SECTION NO.
AMA	GRAY	0169	07
			JOB NO.
			053, ETC
			SHEET NO.
			205

4/7/2021 7:28:04 AM F:\Proj\62019\1004_Traffic\DOT_5x5_P55E\03_US60_Amtr\1616\1616\500\USTN\509-Traffic\02-Sheets\US60_TRAF-SPM-20.dgn

4/7/2021 7:28:04 AM F:\Proj\62019\1004_Traffic\106\US60-AM\116\EN\600-UST\1\509-Traffic\02-Sheets\US60-TRAF-SPW-21.dgn

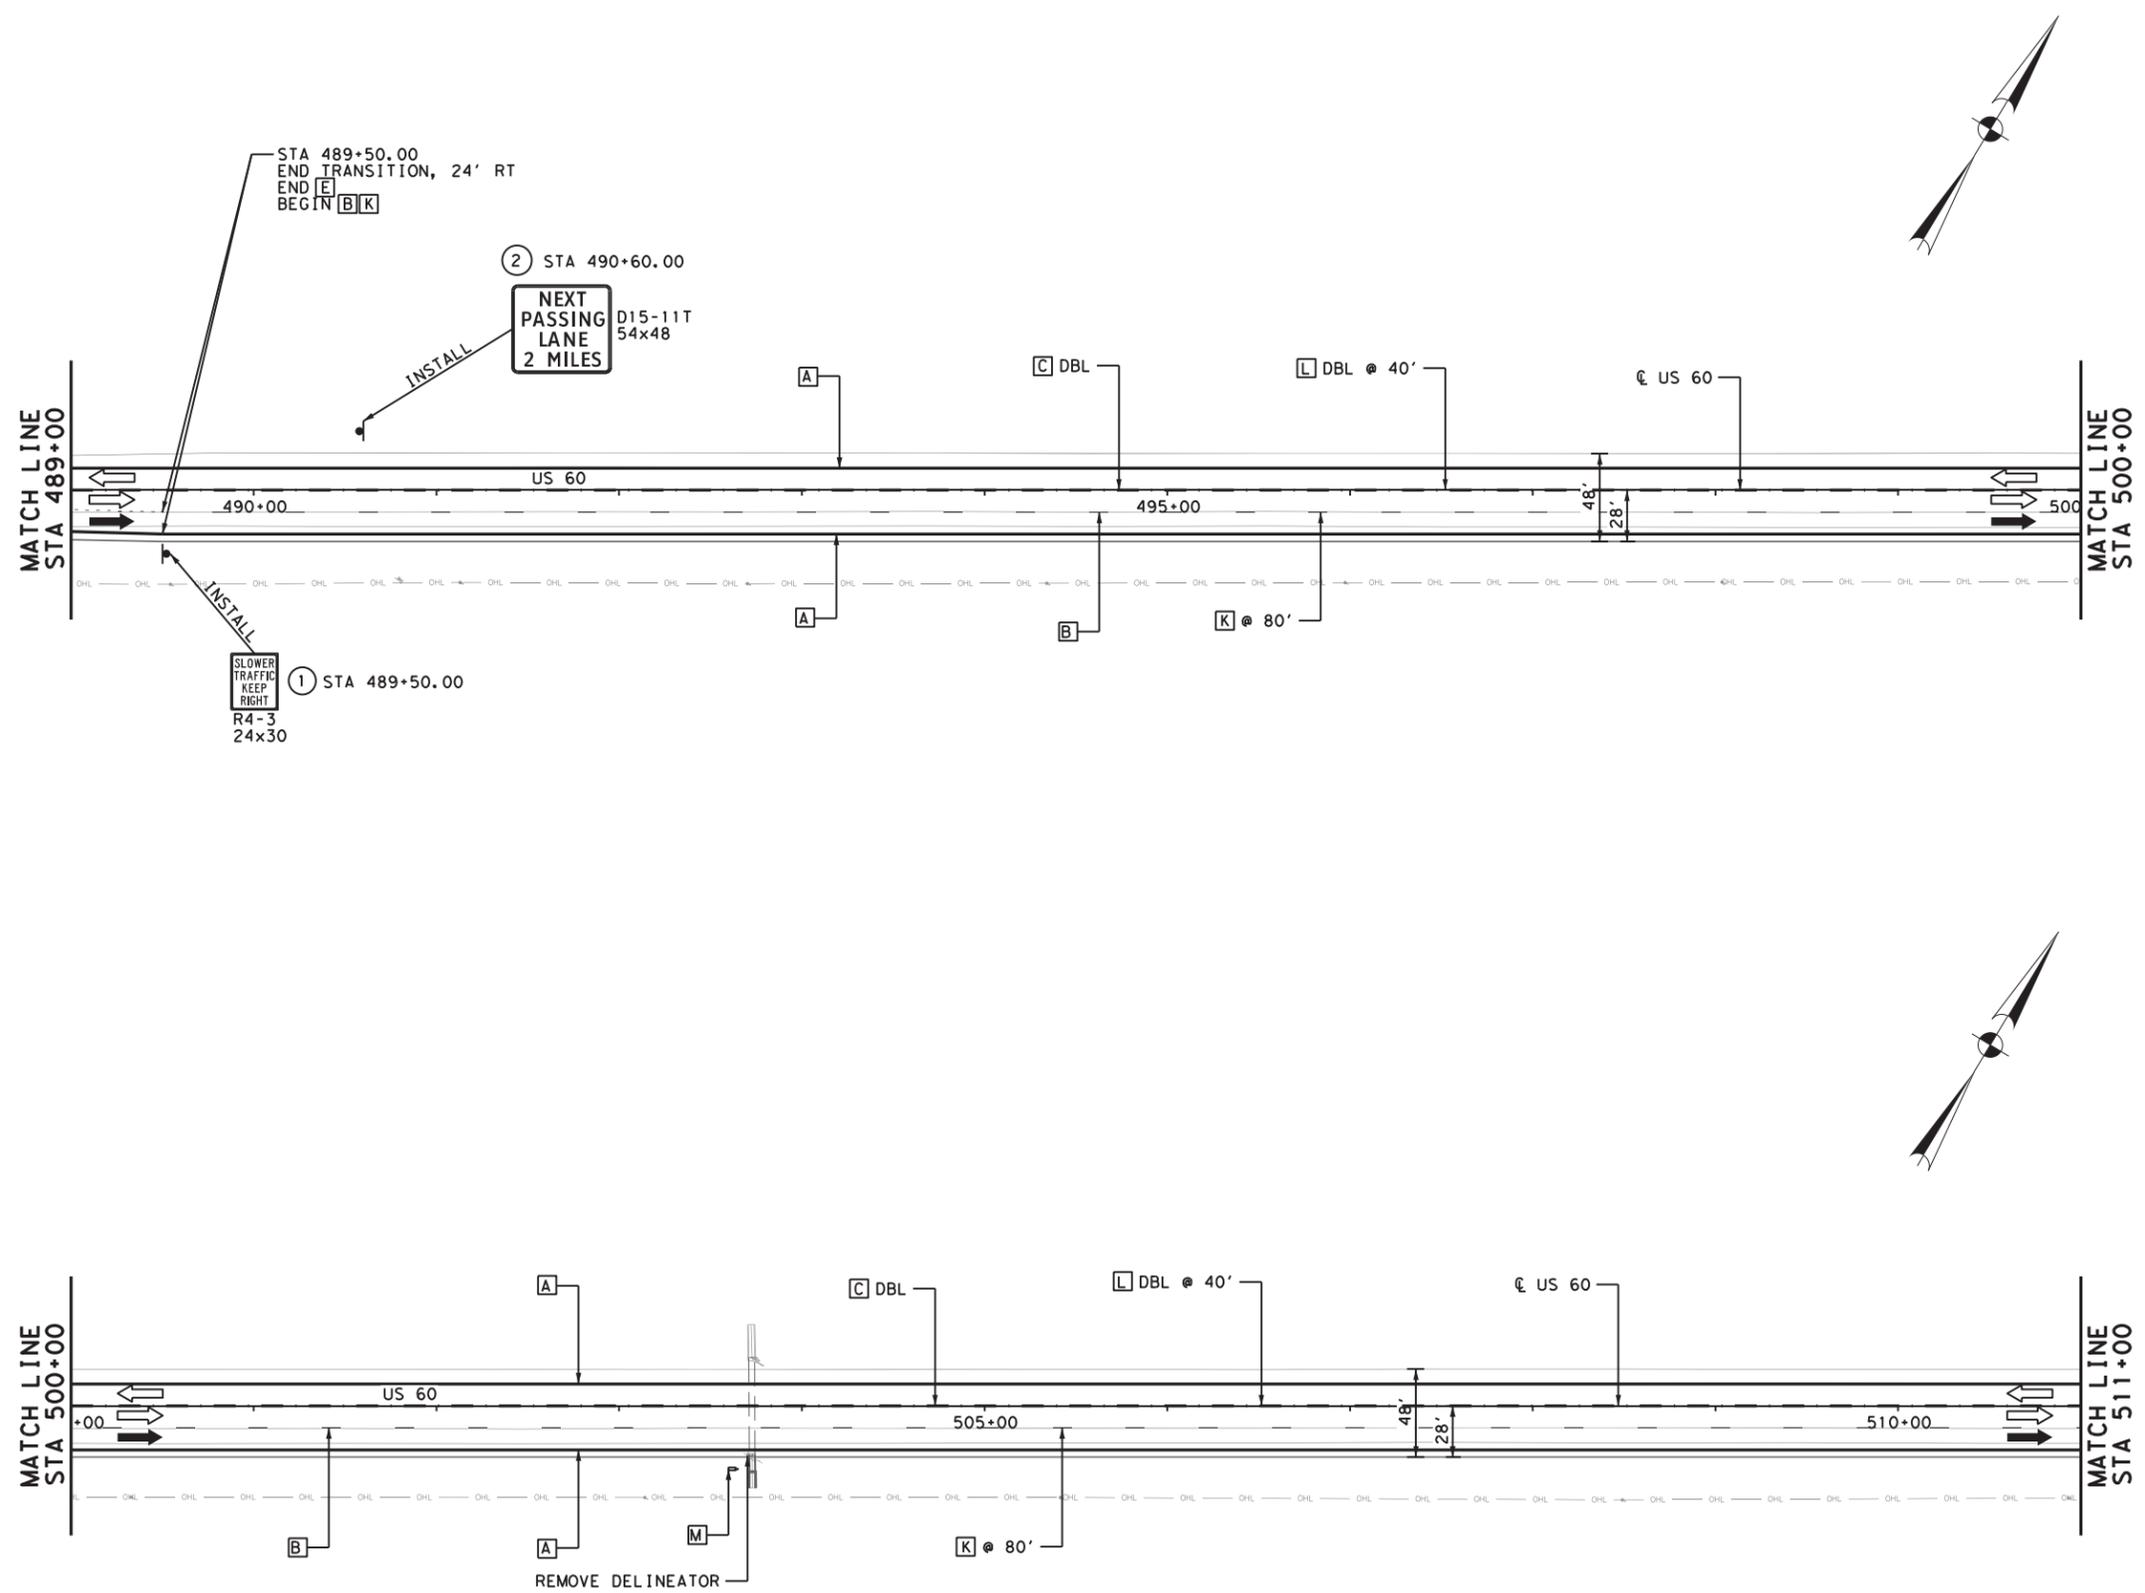

- LEGEND**
- [A] RE PM W/RET REQ TY I (W) 4" (SLD)
 - [B] RE PM W/RET REQ TY I (W) 4" (BRK)
 - [C] RE PM W/RET REQ TY I (Y) 4" (SLD)
 - [D] RE PM W/RET REQ TY I (Y) 4" (BRK)
 - [E] REFL PAV MRK TY I (W) 4" (DOT)
 - [F] REFL PAV MRK TY I (W) 8" (SLD)
 - [G] REFL PAV MRK TY I (W) 12" (SLD)
 - [H] REFL PAV MRK TY I (W) 24" (SLD)
 - [I] REFL PAV MRK TY I (Y) 24" (SLD)
 - [J] REFL PAV MRK TY I (W) (LNDPARW)
 - [K] REFL PAV MRKR TY I-C
 - [L] REFL PAV MRKR TY II-A-A
 - [M] OBJECT MARKER
 - [N] REFL PAV MRK TY I (W) (ARROW)
 - # SIGN NUMBER
 - ⇨ EXIST DIRECTION OF TRAFFIC
 - ⇨ PROP DIRECTION OF TRAFFIC
 - ⊙ PROP WHITE FLX GF2 DELINEATOR (BI)

04/07/2021

Bo L. Ratto

REV. NO.	DATE	DESCRIPTION	BY

CobbFendley 13430 Northwest Freeway, Ste. 1100
Houston, Texas 77040
713.462.3242
www.cobbfendley.com





SIGNING AND PAVEMENT MARKING PLANS
STA 489+00 TO STA 511+00
SHEET 21 OF 35

FED. RD. DIV. NO.	STATE	PROJECT NO.	HIGHWAY NO.
6	TEXAS	(SEE TITLE SHEET)	US60
STATE DISTRICT	COUNTY	CONTROL NO.	SECTION NO.
AMA	GRAY	0169	07
			JOB NO.
			053, ETC
			SHEET NO.
			206

US60-TRAF-SPW-21.dgn

4/7/2021 7:28:05 AM F:\Proj\62019\1004_Traffic\560_Amarr\16\EN\6500-UST\1\509-Traffic\02-Sheet\US60_TRAF-SFM-22.dgn

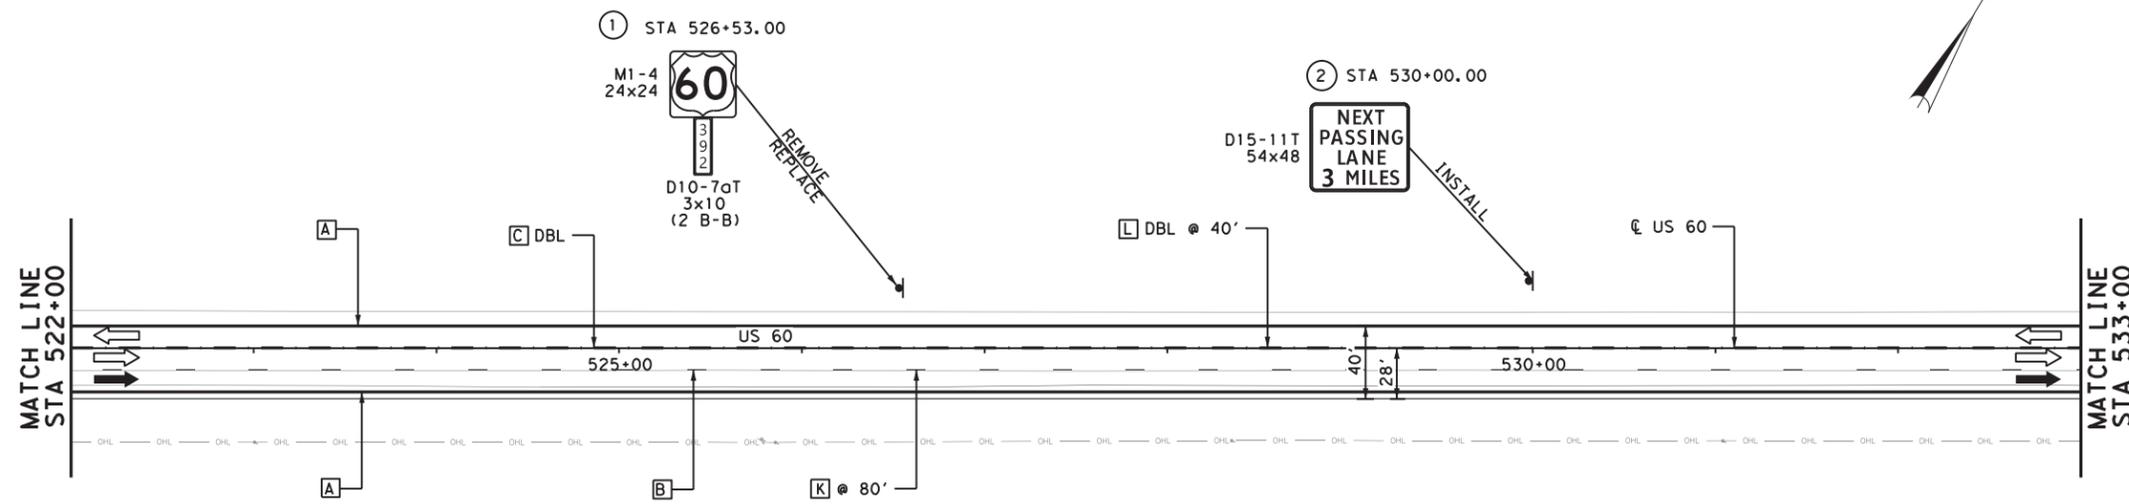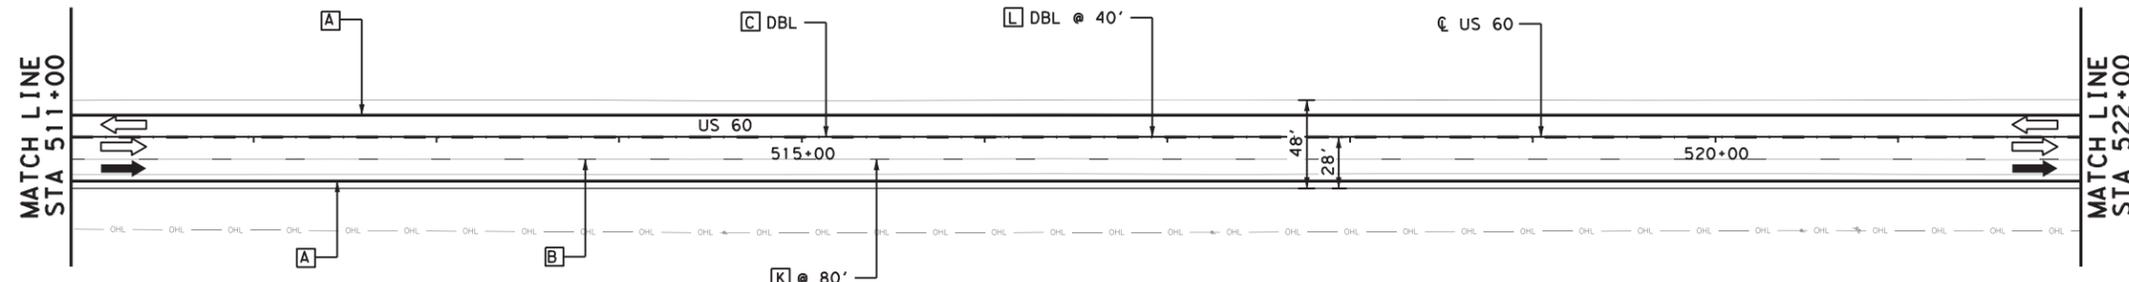

LEGEND

- A RE PM W/RET REQ TY I (W) 4" (SLD)
- B RE PM W/RET REQ TY I (W) 4" (BRK)
- C RE PM W/RET REQ TY I (Y) 4" (SLD)
- D RE PM W/RET REQ TY I (Y) 4" (BRK)
- E REFL PAV MRK TY I (W) 4" (DOT)
- F REFL PAV MRK TY I (W) 8" (SLD)
- G REFL PAV MRK TY I (W) 12" (SLD)
- H REFL PAV MRK TY I (W) 24" (SLD)
- I REFL PAV MRK TY I (Y) 24" (SLD)
- J REFL PAV MRK TY I (W) (LNDPARW)
- K REFL PAV MRKR TY I-C
- L REFL PAV MRKR TY II-A-A
- M OBJECT MARKER
- N REFL PAV MRK TY I (W) (ARROW)
- # SIGN NUMBER
- ⇨ EXIST DIRECTION OF TRAFFIC
- ⇩ PROP DIRECTION OF TRAFFIC
- ⊙ PROP WHITE FLX GF2 DELINEATOR (BI)

04/07/2021

Bo L. Ratto

REV. NO.	DATE	DESCRIPTION	BY

CobbFendley 13430 Northwest Freeway, Ste. 1100
Houston, Texas 77040
713.462.3242
www.cobbhendley.com





SIGNING AND PAVEMENT MARKING PLANS
STA 511+00 TO STA 533+00

SHEET 22 OF 35

FED. RD. DIV. NO.	STATE	PROJECT NO.	HIGHWAY NO.
6	TEXAS	(SEE TITLE SHEET)	US60
STATE DISTRICT	COUNTY	CONTROL NO.	SECTION NO.
AMA	GRAY	0169	07
			JOB NO.
			053, ETC
			SHEET NO.
			207

US60_TRAF-SFM-22.dgn

4/7/2021
 F:\Projects\2019\1004_Traffic\Drawings\US60-Traffic\SPM-23.dgn
 7:28:06 AM

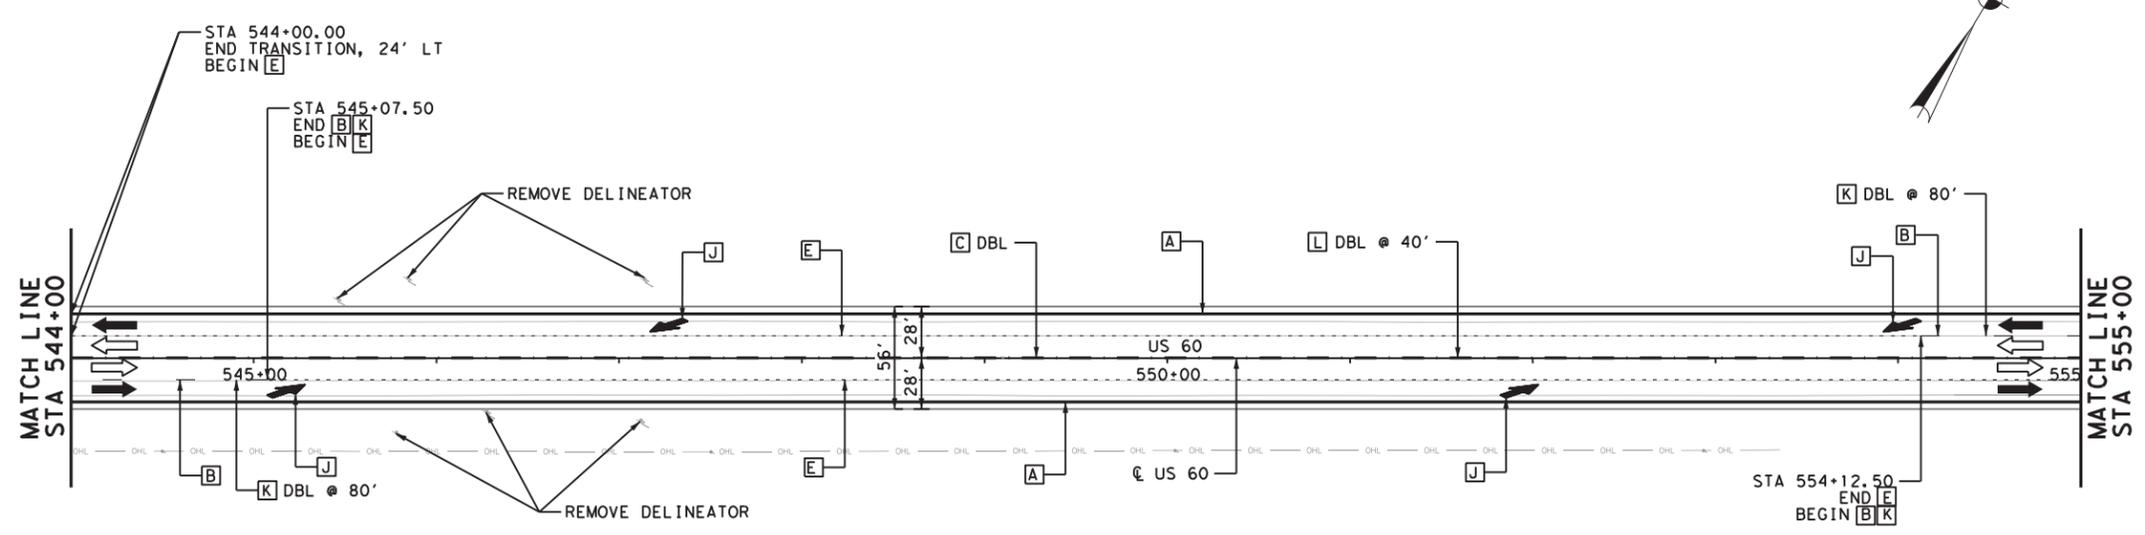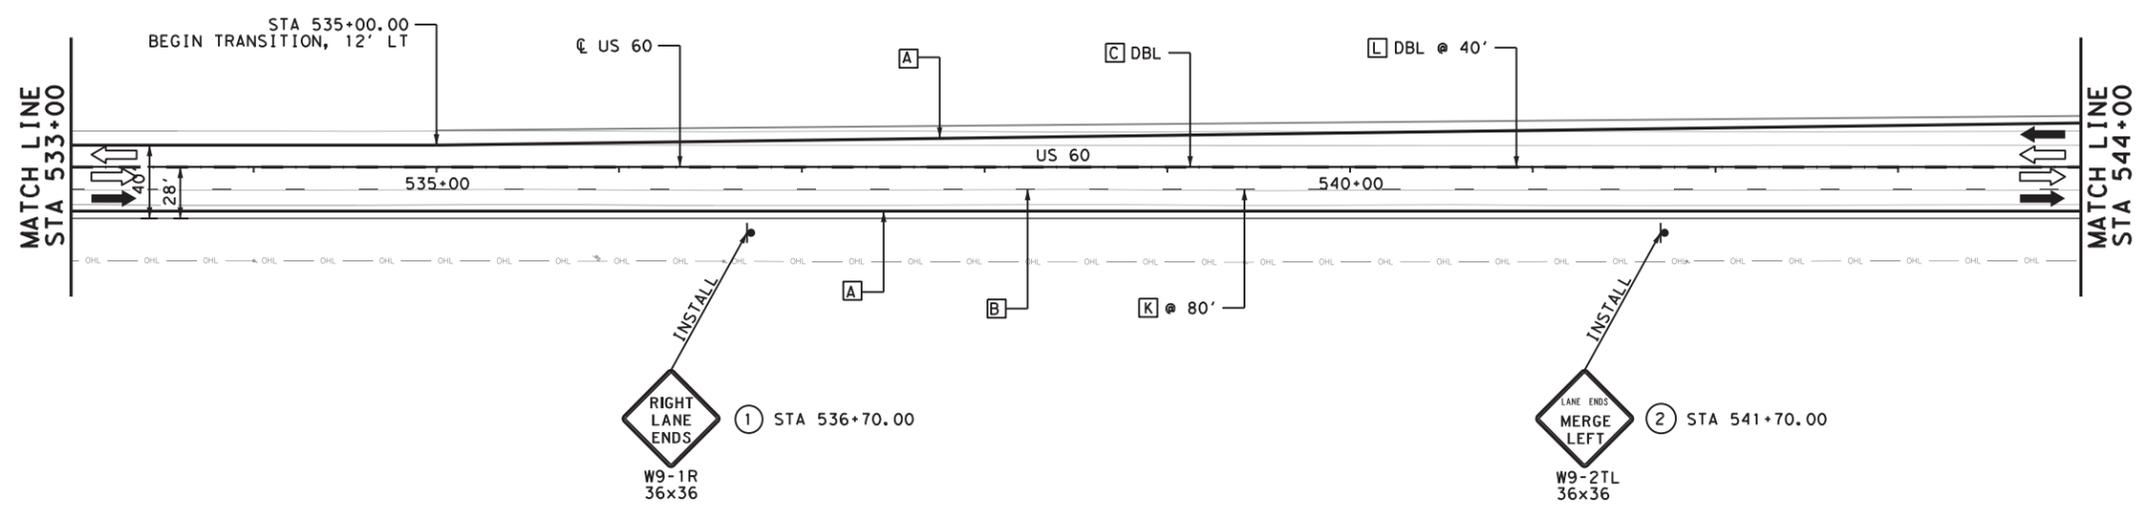

LEGEND

- A RE PM W/RET REQ TY I (W) 4" (SLD)
- B RE PM W/RET REQ TY I (W) 4" (BRK)
- C RE PM W/RET REQ TY I (Y) 4" (SLD)
- D RE PM W/RET REQ TY I (Y) 4" (BRK)
- E REFL PAV MRK TY I (W) 4" (DOT)
- F REFL PAV MRK TY I (W) 8" (SLD)
- G REFL PAV MRK TY I (W) 12" (SLD)
- H REFL PAV MRK TY I (W) 24" (SLD)
- I REFL PAV MRK TY I (Y) 24" (SLD)
- J REFL PAV MRK TY I (W) (LNDPARW)
- K REFL PAV MRKR TY I-C
- L REFL PAV MRKR TY II-A-A
- M OBJECT MARKER
- N REFL PAV MRK TY I (W) (ARROW)
- ⊙ SIGN NUMBER
- ⇨ EXIST DIRECTION OF TRAFFIC
- ⇩ PROP DIRECTION OF TRAFFIC
- ⦿ PROP WHITE FLX GF2 DELINEATOR (BI)

04/07/2021

Bo L. Ratto

REV. NO.	DATE	DESCRIPTION	BY

CobbFendley 13430 Northwest Freeway, Ste. 1100
 Houston, Texas 77040
 TBPE Firm Registration No. 274 713.462.3242
 TBPLS Firm Registration No. 100467 www.cobbhendley.com





SIGNING AND PAVEMENT MARKING PLANS
 STA 533+00 TO STA 555+00
 SHEET 23 OF 35

FED. RD. DIV. NO.	STATE	PROJECT NO.	HIGHWAY NO.
6	TEXAS	(SEE TITLE SHEET)	US60
STATE DISTRICT	COUNTY	CONTROL NO.	SECTION NO.
AMA	GRAY	0169	07
			JOB NO.
			053, ETC
			SHEET NO.
			208

US60-TRAF-SPM-23.dgn

4/7/2021 7:28:09 AM F:\Projects\2019\1004_Traffic\Drawings\US60_Amendment\US60-Traffic\26-Signing\US60-Traf-SPM-26.dgn

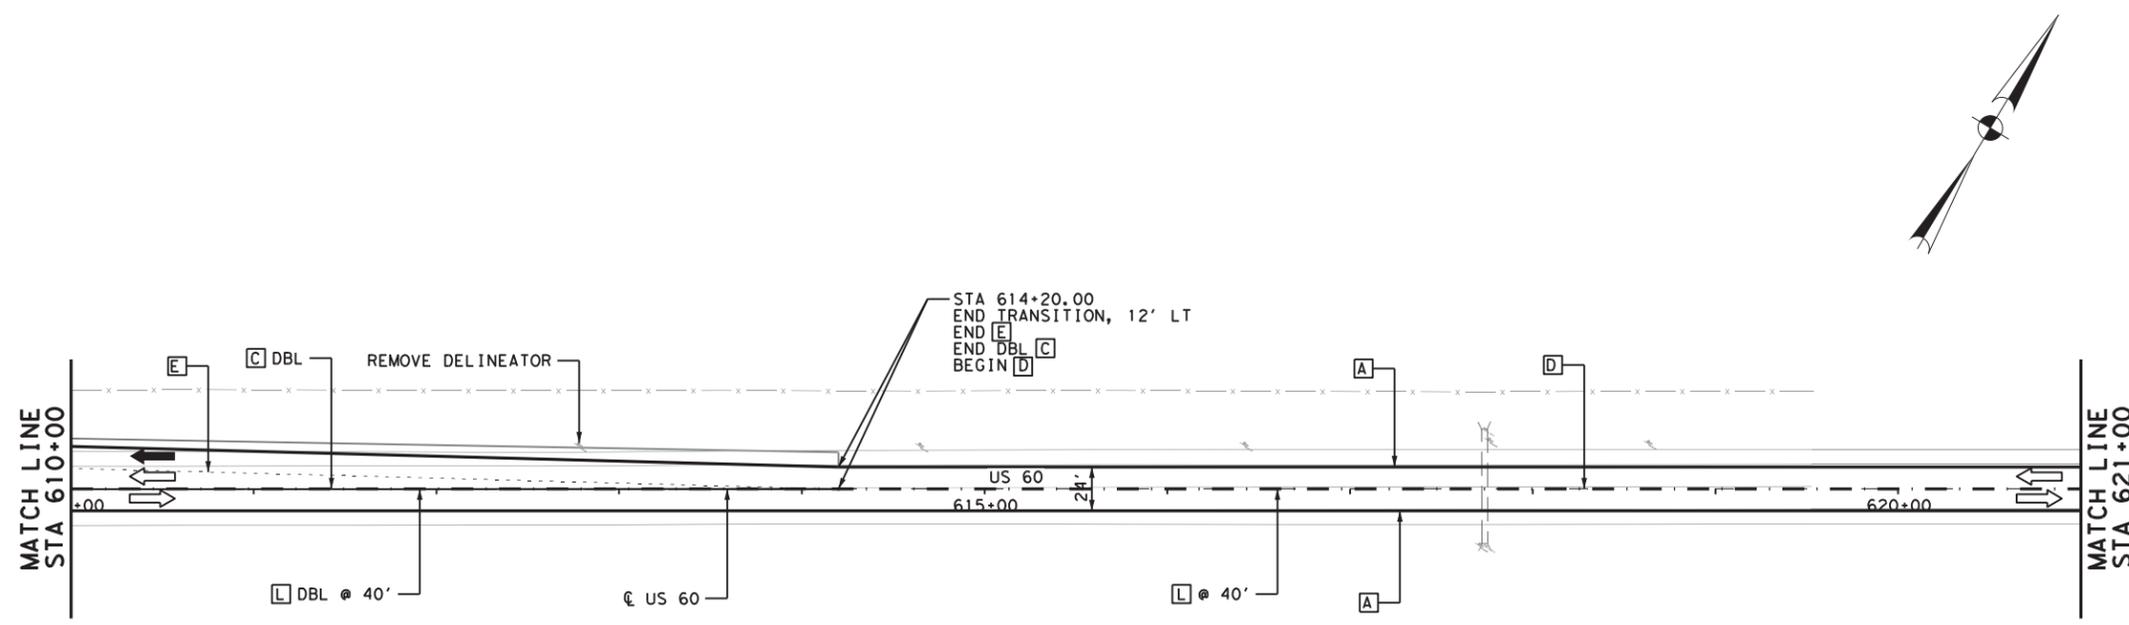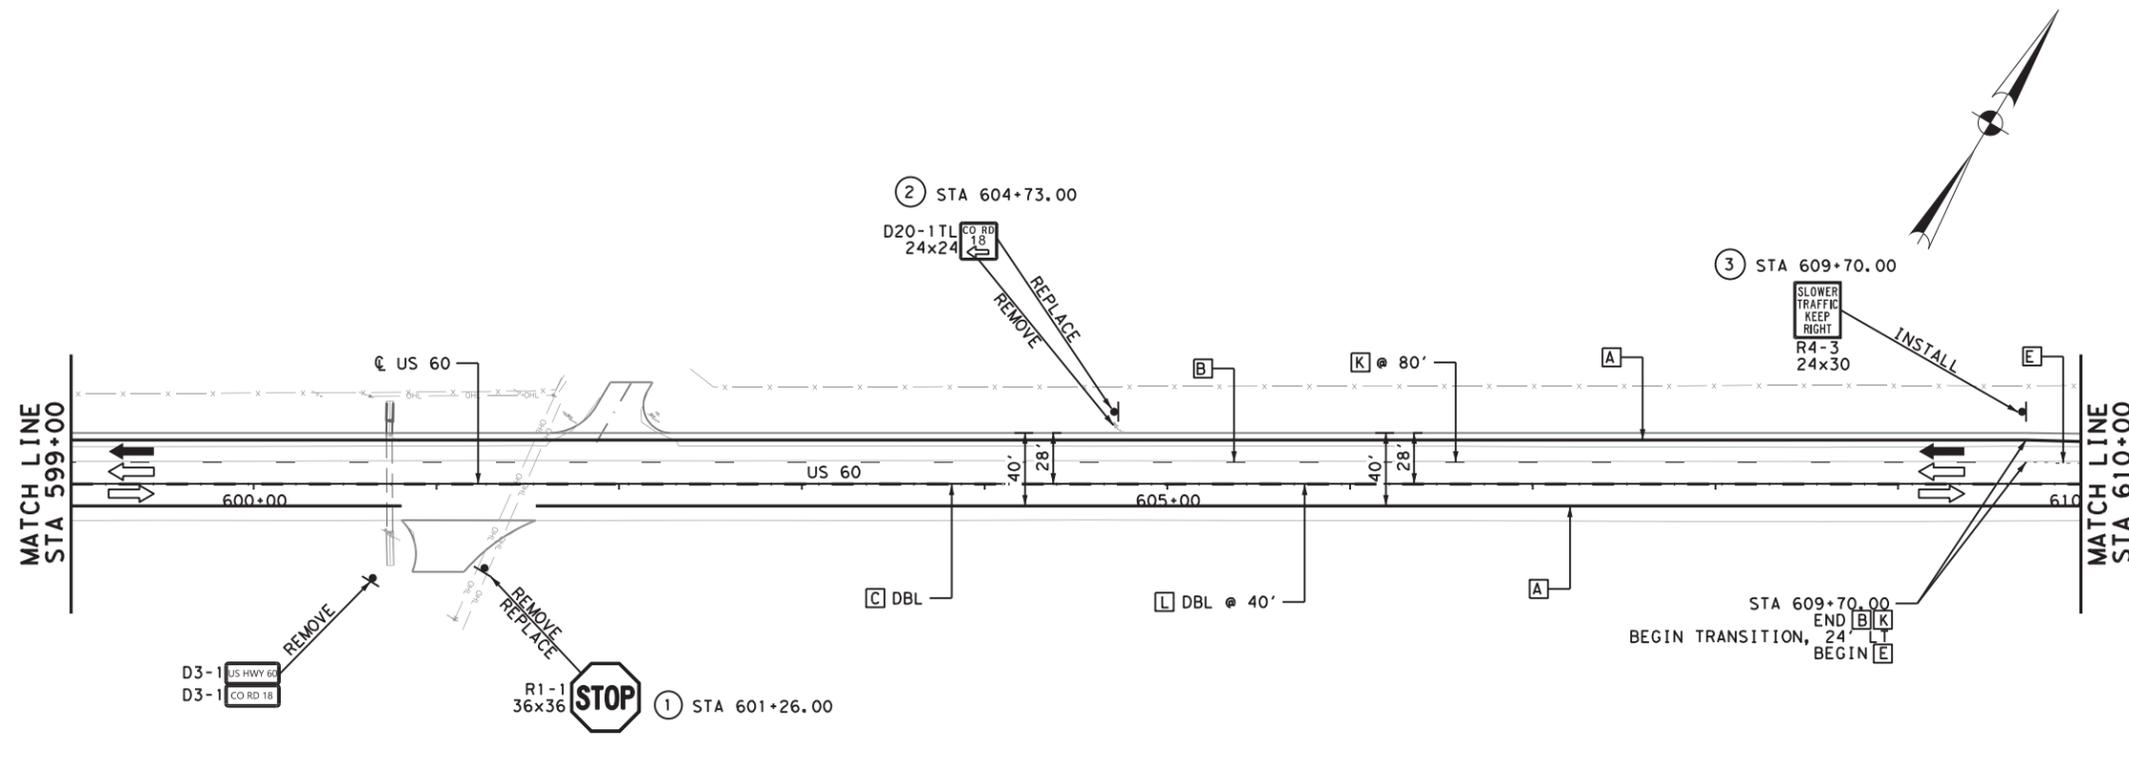

LEGEND

- A RE PM W/RET REQ TY I (W) 4" (SLD)
- B RE PM W/RET REQ TY I (W) 4" (BRK)
- C RE PM W/RET REQ TY I (Y) 4" (SLD)
- D RE PM W/RET REQ TY I (Y) 4" (BRK)
- E REFL PAV MRK TY I (W) 4" (DOT)
- F REFL PAV MRK TY I (W) 8" (SLD)
- G REFL PAV MRK TY I (W) 12" (SLD)
- H REFL PAV MRK TY I (W) 24" (SLD)
- I REFL PAV MRK TY I (Y) 24" (SLD)
- J REFL PAV MRK TY I (W) (LNDPARW)
- K REFL PAV MRKR TY I-C
- L REFL PAV MRKR TY II-A-A
- M OBJECT MARKER
- N RELF PAV MRK TY I (W) (ARROW)
- # SIGN NUMBER
- ⇨ EXIST DIRECTION OF TRAFFIC
- ⇨ PROP DIRECTION OF TRAFFIC
- ⊙ PROP WHITE FLX GF2 DELINEATOR (BI)

04/07/2021

Bo L. Ratto

0 25 50 100
1" = 100'

REV. NO.	DATE	DESCRIPTION	BY

CobbFendley 13430 Northwest Freeway, Ste. 1100
Houston, Texas 77040
713.462.3242
www.cobbhendley.com





SIGNING AND PAVEMENT MARKING PLANS
STA 599+00 TO STA 621+00
SHEET 26 OF 35

FED. RD. DIV. NO.	STATE	PROJECT NO.	HIGHWAY NO.
6	TEXAS	(SEE TITLE SHEET)	US60
STATE DISTRICT	COUNTY	CONTROL NO.	SECTION NO.
AMA	GRAY	0169	07
		JOB NO.	SHEET NO.
		053, ETC	211

US60-Traf-SPM-26.dgn

LEGEND

- [A] RE PM W/RET REQ TY I (W) 4" (SLD)
- [B] RE PM W/RET REQ TY I (W) 4" (BRK)
- [C] RE PM W/RET REQ TY I (Y) 4" (SLD)
- [D] RE PM W/RET REQ TY I (Y) 4" (BRK)
- [E] REFL PAV MRK TY I (W) 4" (DOT)
- [F] REFL PAV MRK TY I (W) 8" (SLD)
- [G] REFL PAV MRK TY I (W) 12" (SLD)
- [H] REFL PAV MRK TY I (W) 24" (SLD)
- [I] REFL PAV MRK TY I (Y) 24" (SLD)
- [J] REFL PAV MRK TY I (W) (LNDPARW)
- [K] REFL PAV MRKR TY I-C
- [L] REFL PAV MRKR TY II-A-A
- [M] OBJECT MARKER
- [N] RELF PAV MRK TY I (W) (ARROW)
- ⊙ SIGN NUMBER
- ⇨ EXIST DIRECTION OF TRAFFIC
- ⇩ PROP DIRECTION OF TRAFFIC
- ⊙ PROP WHITE FLX GF2 DELINEATOR (BI)

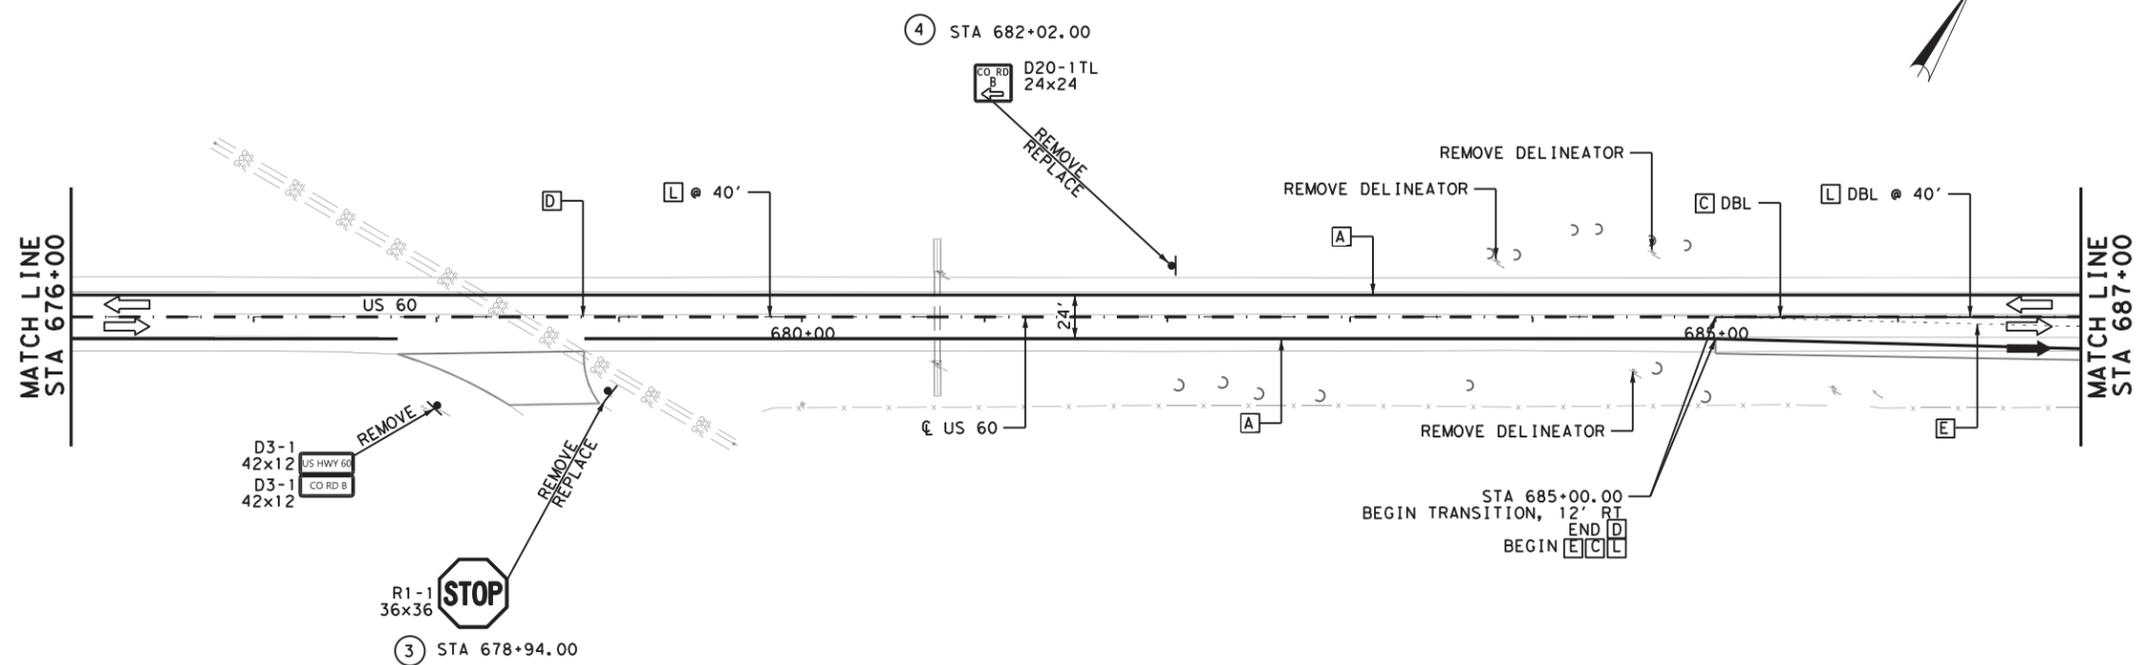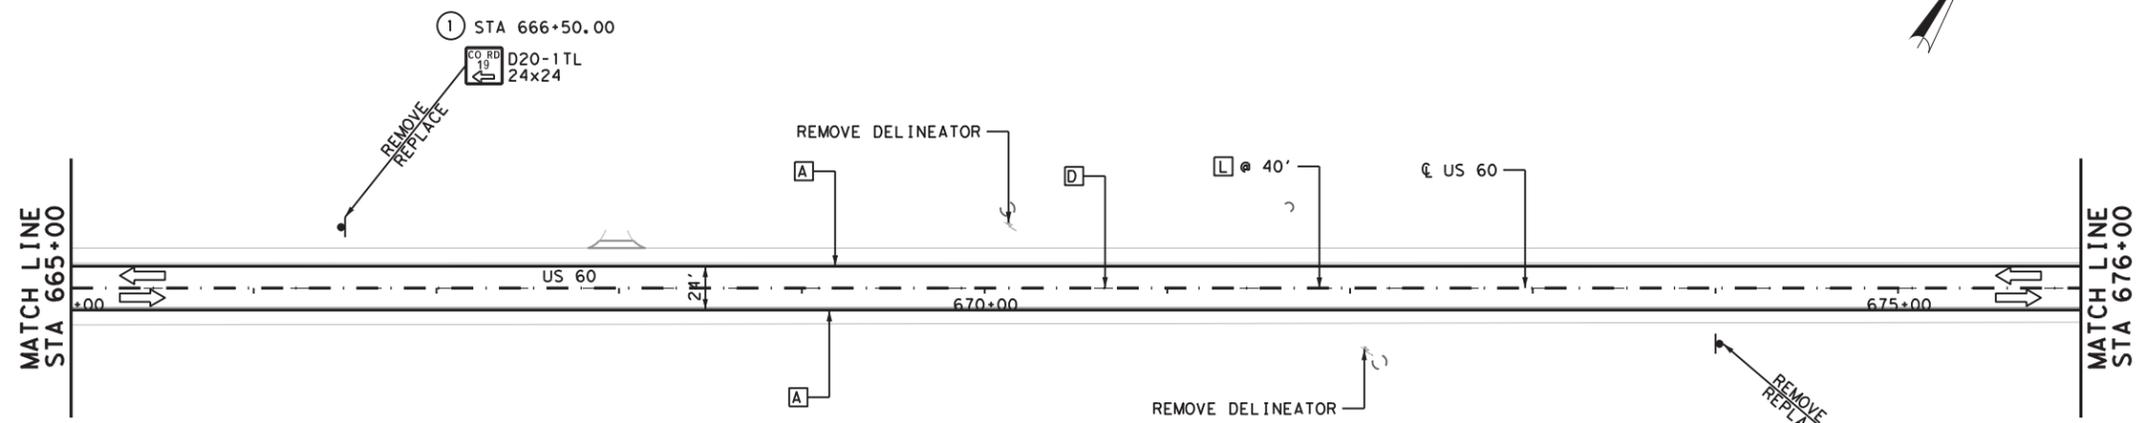

04/07/2021

Bo L. Ratto

REV. NO.	DATE	DESCRIPTION	BY

CobbFendley 13430 Northwest Freeway, Ste. 1100
Houston, Texas 77040
713.462.3242
www.cobbhendley.com





SIGNING AND PAVEMENT MARKING PLANS
STA 665+00 TO STA 687+00

SHEET 29 OF 35

FED. RD. DIV. NO.	STATE	PROJECT NO.	HIGHWAY NO.
6	TEXAS	(SEE TITLE SHEET)	US60
STATE DISTRICT	COUNTY	CONTROL NO.	SECTION NO.
AMA	GRAY	0169	07
			JOB NO.
			053, ETC
			SHEET NO.
			214

4/7/2021 7:28:12 AM F:\Proj\665-687\665-687\TRAFFIC\US60-TRAFFIC\02-Signing\US60-TRAFFIC-SPM-29.dgn

4/7/2021 7:28:14 AM F:\Proj\62019\1004_Traffic\DOT_5x5_P&S\US60_Amarillo\EN\500\UST\N\509-Traffic\02-Sheets\US60_TRAF-SPW-31.dgn

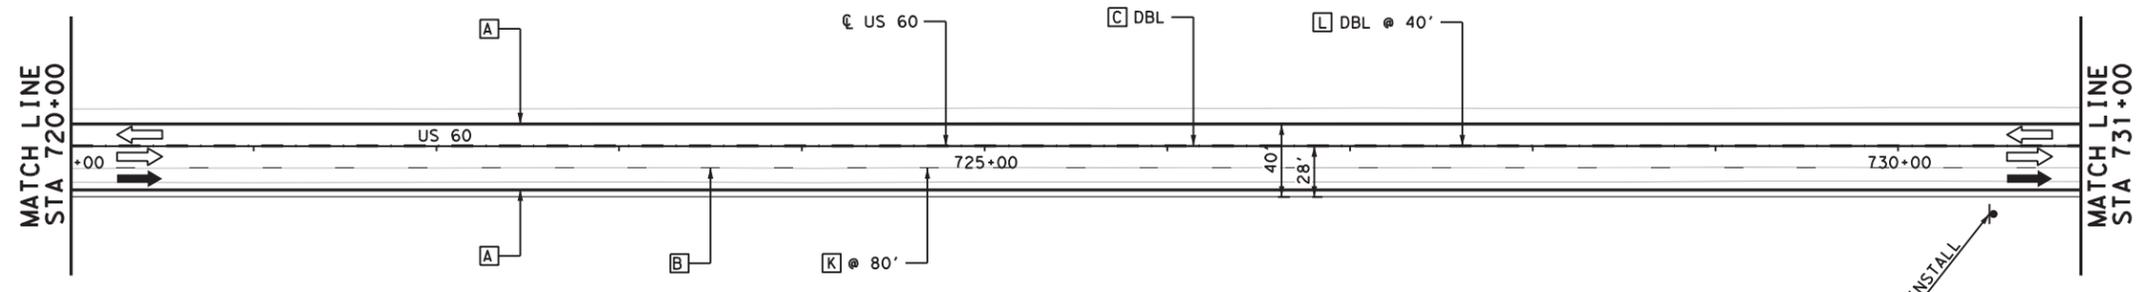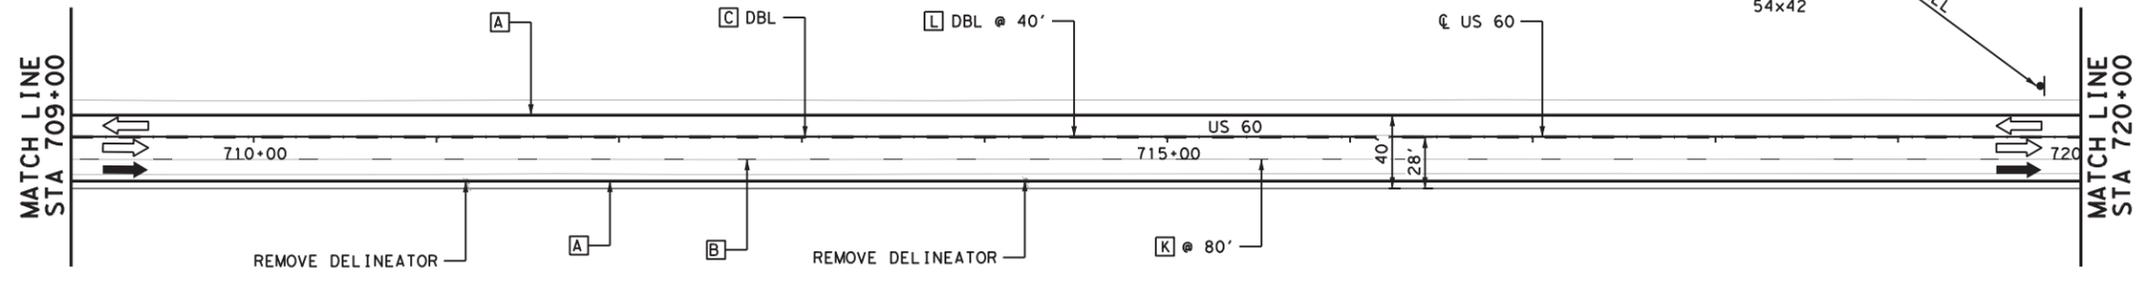

- LEGEND**
- A RE PM W/RET REQ TY I (W) 4" (SLD)
 - B RE PM W/RET REQ TY I (W) 4" (BRK)
 - C RE PM W/RET REQ TY I (Y) 4" (SLD)
 - D RE PM W/RET REQ TY I (Y) 4" (BRK)
 - E REFL PAV MRK TY I (W) 4" (DOT)
 - F REFL PAV MRK TY I (W) 8" (SLD)
 - G REFL PAV MRK TY I (W) 12" (SLD)
 - H REFL PAV MRK TY I (W) 24" (SLD)
 - I REFL PAV MRK TY I (Y) 24" (SLD)
 - J REFL PAV MRK TY I (W) (LNDPARW)
 - K REFL PAV MRKR TY I-C
 - L REFL PAV MRKR TY II-A-A
 - M OBJECT MARKER
 - N RELF PAV MRK TY I (W) (ARROW)
 - # SIGN NUMBER
 - ⇨ EXIST DIRECTION OF TRAFFIC
 - ⇩ PROP DIRECTION OF TRAFFIC
 - ☉ PROP WHITE FLX GF2 DELINEATOR (BI)

04/07/2021

Bo L. Ratto

0 25 50 100
1" = 100'

REV. NO.	DATE	DESCRIPTION	BY

CobbFendley 13430 Northwest Freeway, Ste. 1100
Houston, Texas 77040
713.462.3242
www.cobbhendley.com


Texas Department of Transportation

SIGNING AND PAVEMENT MARKING PLANS
STA 709+00 TO STA 731+00
SHEET 31 OF 35

FED. RD. DIV. NO.	STATE	PROJECT NO.	HIGHWAY NO.		
6	TEXAS	(SEE TITLE SHEET)	US60		
STATE DISTRICT	COUNTY	CONTROL NO.	SECTION NO.	JOB NO.	SHEET NO.
AMA	GRAY	0169	07	053, ETC	216

US60_TRAF-SPW-31.dgn

4/7/2021 7:28:15 AM F:\P\Projects\2019\1004_Traffic\DOT_5x5_P5&E\03_US60_Amarillo\EN\6500\UST\N\509-Traffic\02-Sheets\US60_TRAF-SPW-32.dgn

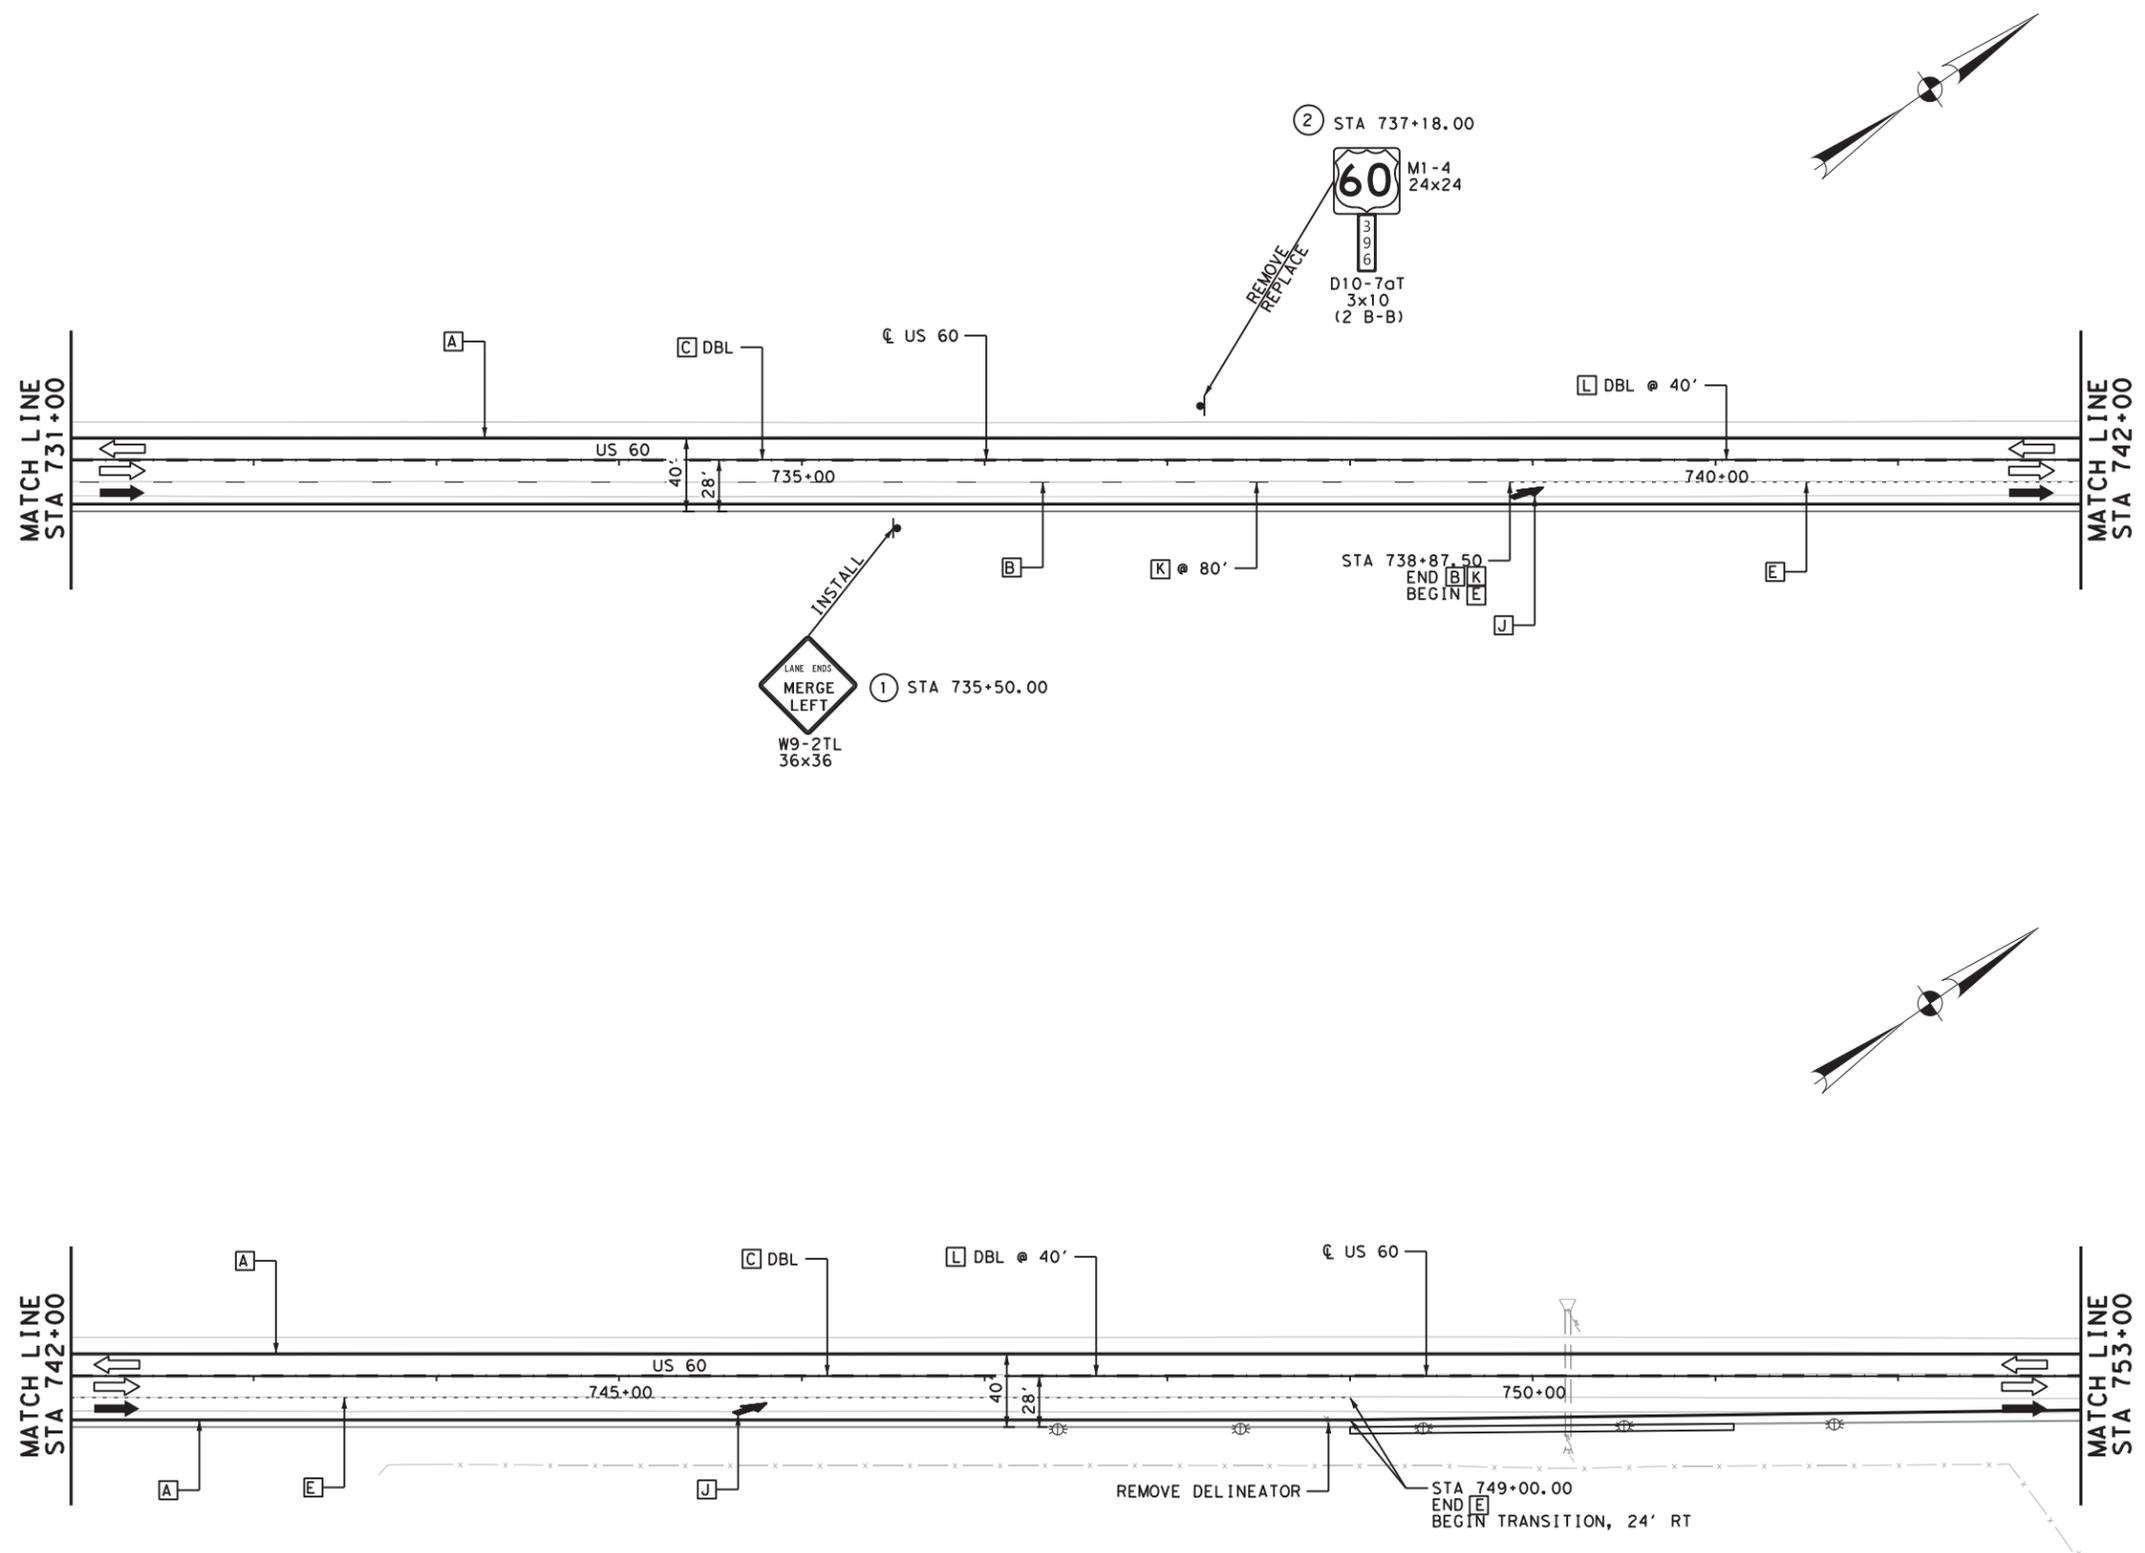

- LEGEND**
- A RE PM W/RET REQ TY I (W) 4" (SLD)
 - B RE PM W/RET REQ TY I (W) 4" (BRK)
 - C RE PM W/RET REQ TY I (Y) 4" (SLD)
 - D RE PM W/RET REQ TY I (Y) 4" (BRK)
 - E REFL PAV MRK TY I (W) 4" (DOT)
 - F REFL PAV MRK TY I (W) 8" (SLD)
 - G REFL PAV MRK TY I (W) 12" (SLD)
 - H REFL PAV MRK TY I (W) 24" (SLD)
 - I REFL PAV MRK TY I (Y) 24" (SLD)
 - J REFL PAV MRK TY I (W) (LNDPARW)
 - K REFL PAV MRKR TY I-C
 - L REFL PAV MRKR TY II-A-A
 - M OBJECT MARKER
 - N RELF PAV MRK TY I (W) (ARROW)
 - ⊙ SIGN NUMBER
 - ⇨ EXIST DIRECTION OF TRAFFIC
 - ⇩ PROP DIRECTION OF TRAFFIC
 - ⊙ PROP WHITE FLX GF2 DELINEATOR (BI)

04/07/2021

Bo L. Ratto

0 25 50 100
1" = 100'

REV. NO.	DATE	DESCRIPTION	BY

CobbFendley 13430 Northwest Freeway, Ste. 1100
Houston, Texas 77040
713.462.3242
www.cobbhendley.com





SIGNING AND PAVEMENT MARKING PLANS
STA 731+00 TO STA 753+00
SHEET 32 OF 35

FED. RD. DIV. NO.	STATE	PROJECT NO.	HIGHWAY NO.
6	TEXAS	(SEE TITLE SHEET)	US60
STATE DISTRICT	COUNTY	CONTROL NO.	SECTION NO.
AMA	GRAY	0169	07
		JOB NO.	SHEET NO.
		053, ETC	217

US60_TRAF-SPW-32.dgn

4/7/2021 7:28:16 AM F:\Proj\2019\1004_Traffic\DOT_5x5_P5&E\03_US60_Amarillo\EN\500\UST\N\509-Traffic\02-Sheets\US60_TRAF-SPW-33.dgn

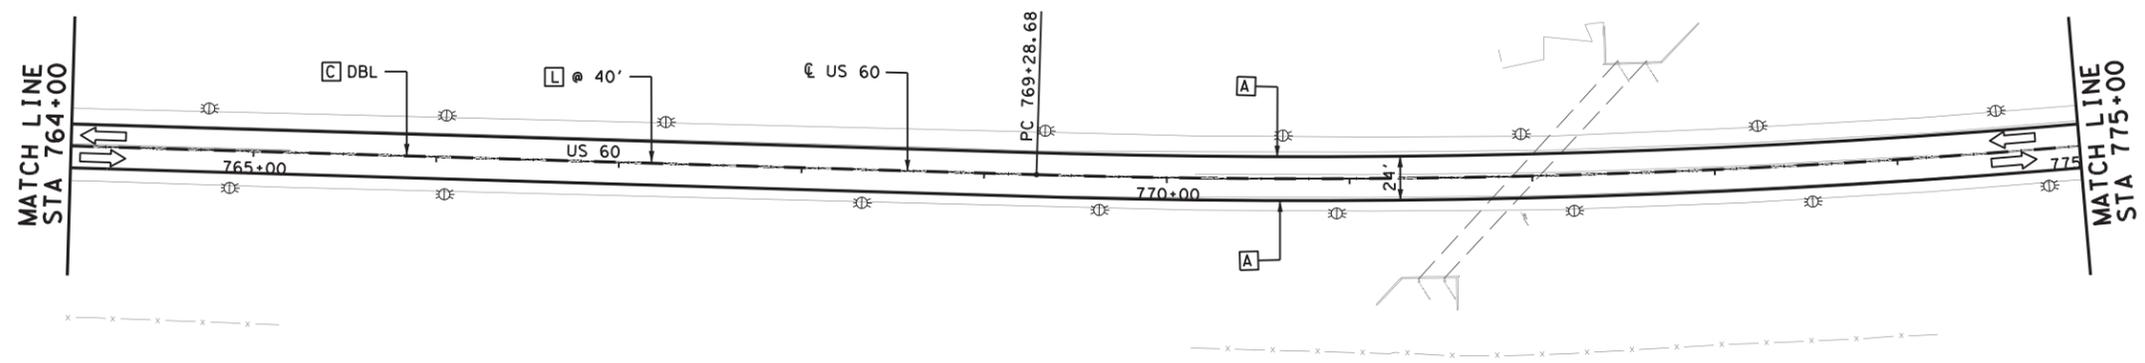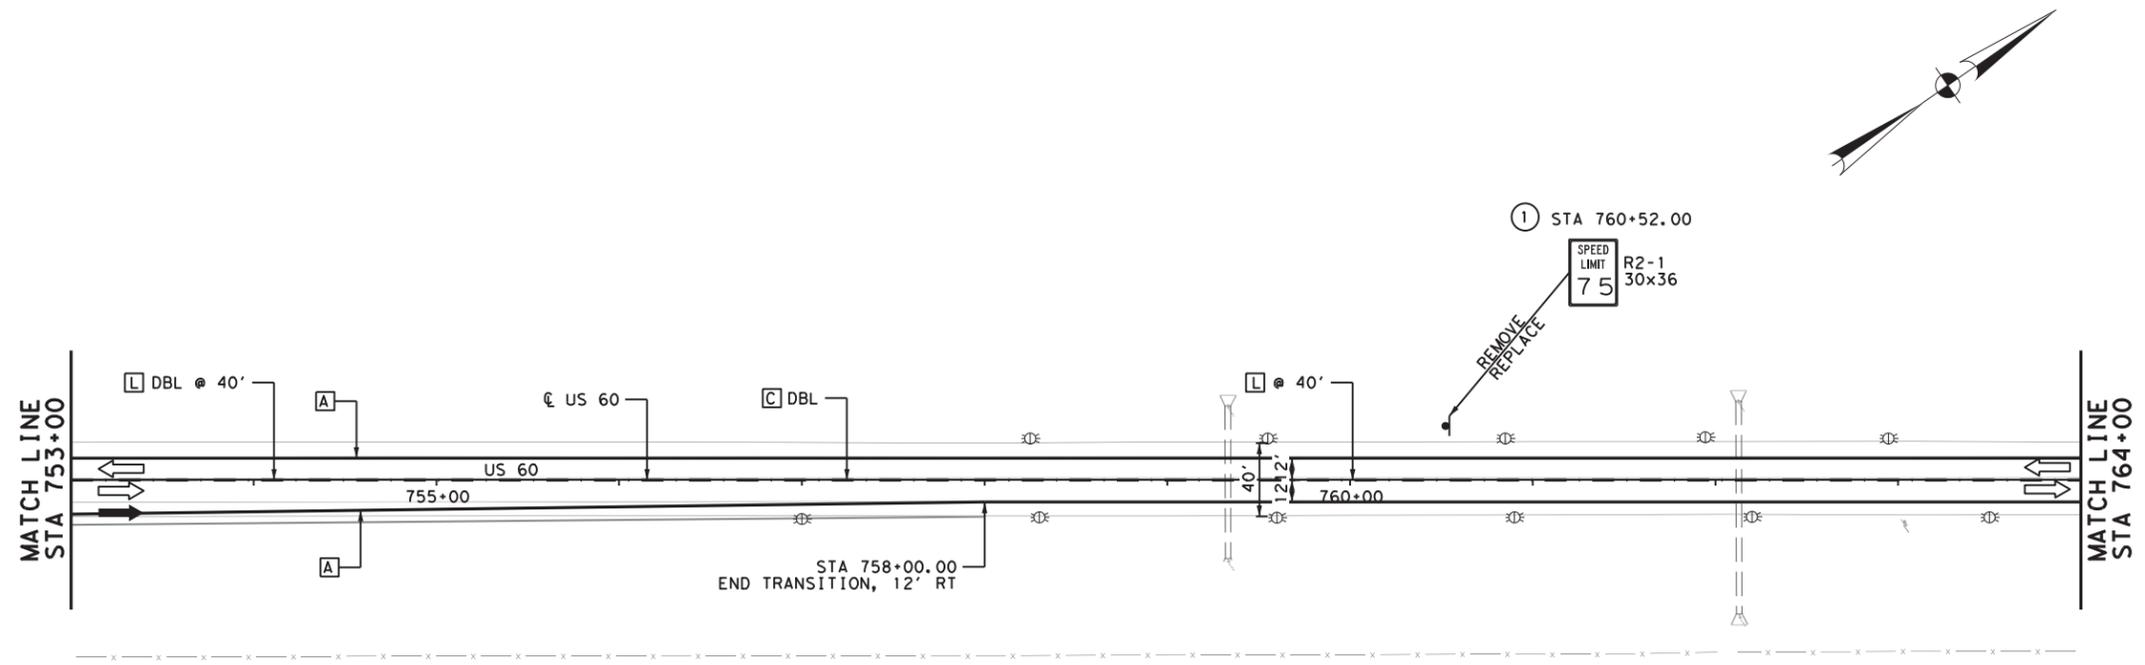

LEGEND

- A RE PM W/RET REQ TY I (W) 4" (SLD)
- B RE PM W/RET REQ TY I (W) 4" (BRK)
- C RE PM W/RET REQ TY I (Y) 4" (SLD)
- D RE PM W/RET REQ TY I (Y) 4" (BRK)
- E REFL PAV MRK TY I (W) 4" (DOT)
- F REFL PAV MRK TY I (W) 8" (SLD)
- G REFL PAV MRK TY I (W) 12" (SLD)
- H REFL PAV MRK TY I (W) 24" (SLD)
- I REFL PAV MRK TY I (Y) 24" (SLD)
- J REFL PAV MRK TY I (W) (LNDPARW)
- K REFL PAV MRKR TY I-C
- L REFL PAV MRKR TY II-A-A
- M OBJECT MARKER
- N REFL PAV MRK TY I (W) (ARROW)
- # SIGN NUMBER
- EXIST DIRECTION OF TRAFFIC
- ➔ PROP DIRECTION OF TRAFFIC
- ⦿ PROP WHITE FLX GF2 DELINEATOR (BI)

04/07/2021

Bo L. Ratto

REV. NO.	DATE	DESCRIPTION	BY

CobbFendley 13430 Northwest Freeway, Ste. 1100
Houston, Texas 77040
713.462.3242
www.cobbhendley.com





SIGNING AND PAVEMENT MARKING PLANS
STA 753+00 TO STA 775+00

SHEET 33 OF 35

FED. RD. DIV. NO.	STATE	PROJECT NO.	HIGHWAY NO.
6	TEXAS	(SEE TITLE SHEET)	US60
STATE DISTRICT	COUNTY	CONTROL NO.	SECTION NO.
AMA	GRAY	0169	07
		JOB NO.	SHEET NO.
		053, ETC	218

US60_TRAF-SPW-33.dgn

4/7/2021 7:28:17 AM F:\Proj\62019\1004_Traffic\560_Amari\1616\560-UST\Traffic\02-Signing\US60_TRAF-SPW-34.dgn

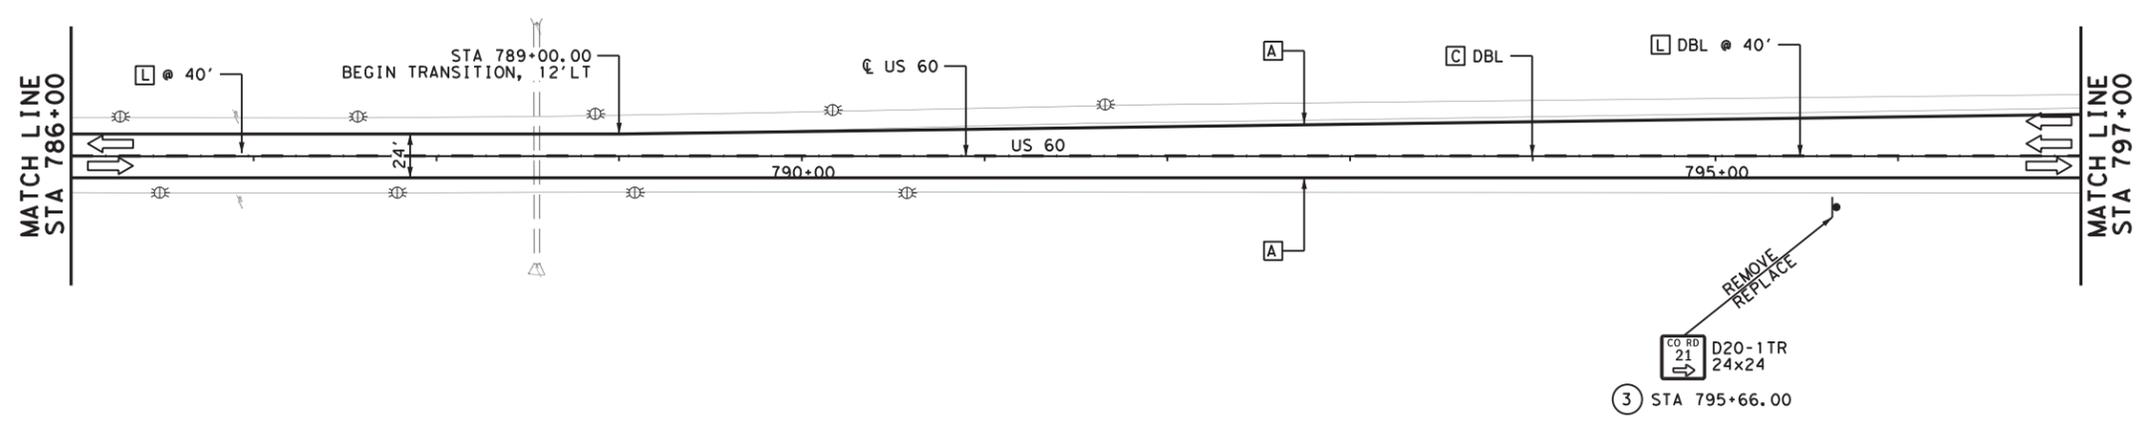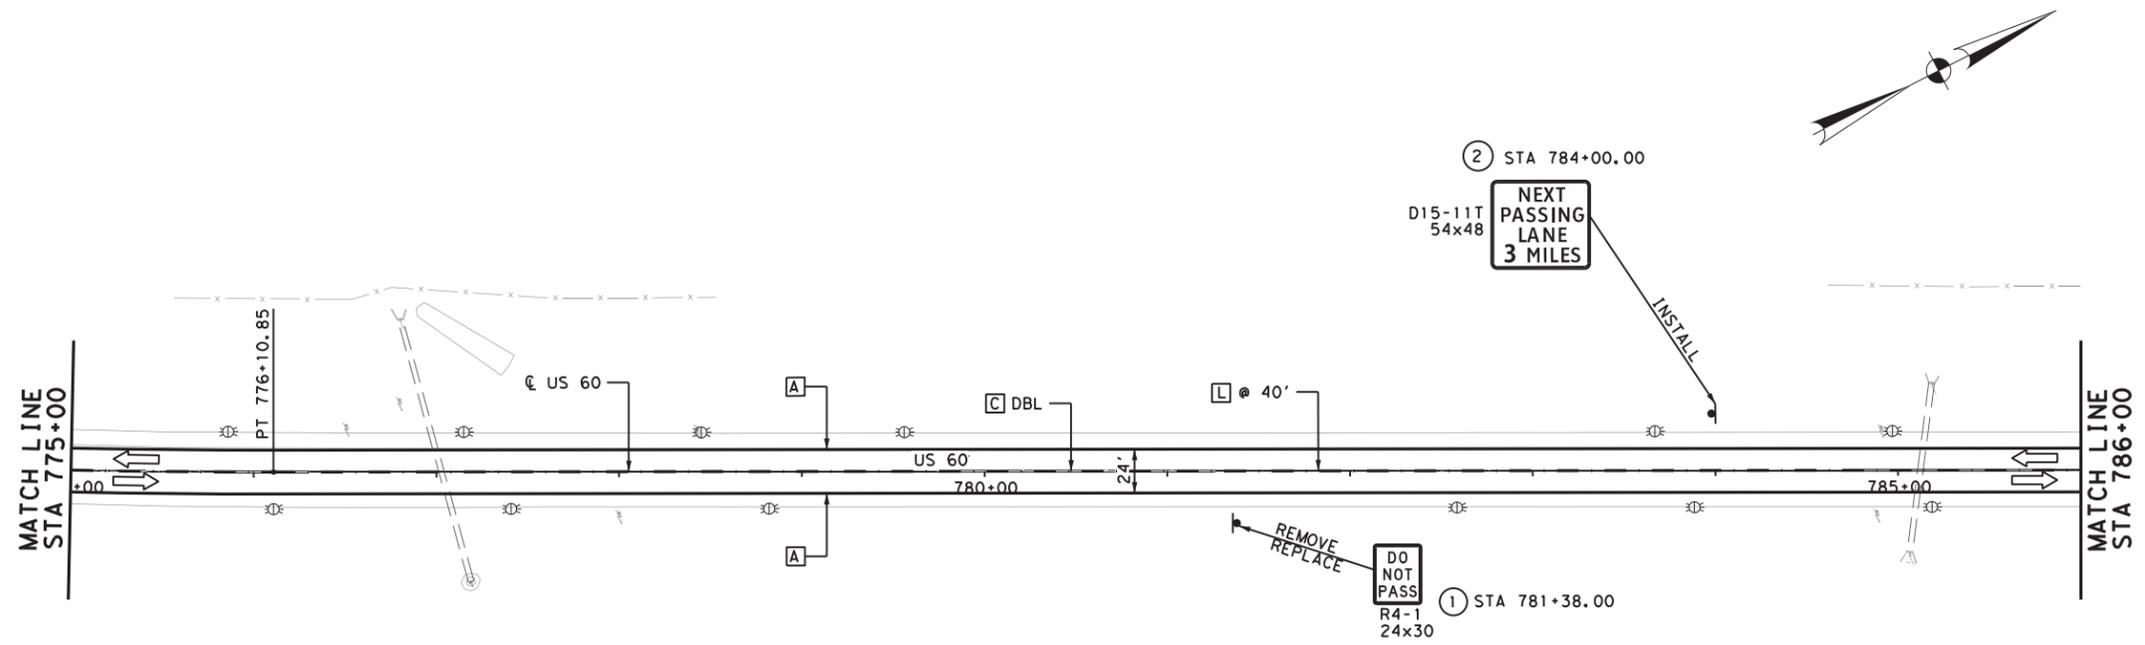

- LEGEND**
- A RE PM W/RET REQ TY I (W) 4" (SLD)
 - B RE PM W/RET REQ TY I (W) 4" (BRK)
 - C RE PM W/RET REQ TY I (Y) 4" (SLD)
 - D RE PM W/RET REQ TY I (Y) 4" (BRK)
 - E REFL PAV MRK TY I (W) 4" (DOT)
 - F REFL PAV MRK TY I (W) 8" (SLD)
 - G REFL PAV MRK TY I (W) 12" (SLD)
 - H REFL PAV MRK TY I (W) 24" (SLD)
 - I REFL PAV MRK TY I (Y) 24" (SLD)
 - J REFL PAV MRK TY I (W) (LNDPARW)
 - K REFL PAV MRKR TY I-C
 - L REFL PAV MRKR TY II-A-A
 - M OBJECT MARKER
 - N RELF PAV MRK TY I (W) (ARROW)
 - # SIGN NUMBER
 - ⇨ EXIST DIRECTION OF TRAFFIC
 - ⇨ PROP DIRECTION OF TRAFFIC
 - ⊙ PROP WHITE FLX GF2 DELINEATOR (BI)

04/07/2021

Bo L. Ratto

0 25 50 100
1" = 100'

REV. NO.	DATE	DESCRIPTION	BY

CobbFendley 13430 Northwest Freeway, Ste. 1100
Houston, Texas 77040
713.462.3242
www.cobbhendley.com


Texas Department of Transportation

SIGNING AND PAVEMENT MARKING PLANS
STA 775+00 TO STA 797+00
SHEET 34 OF 35

FED. RD. DIV. NO.	STATE	PROJECT NO.	HIGHWAY NO.		
6	TEXAS	(SEE TITLE SHEET)	US60		
STATE DISTRICT	COUNTY	CONTROL NO.	SECTION NO.	JOB NO.	SHEET NO.
AMA	GRAY	0169	07	053, ETC	219

US60_TRAF-SPW-34.dgn

4/7/2021 7:28:17 AM F:\Proj\2019\1004_Traffic\5-5_P&E\03_US60_Amarillo\ENGIN\500-UST\N\509-Traffic\02-Sheet\US60-TRAF-SPW-35.dgn

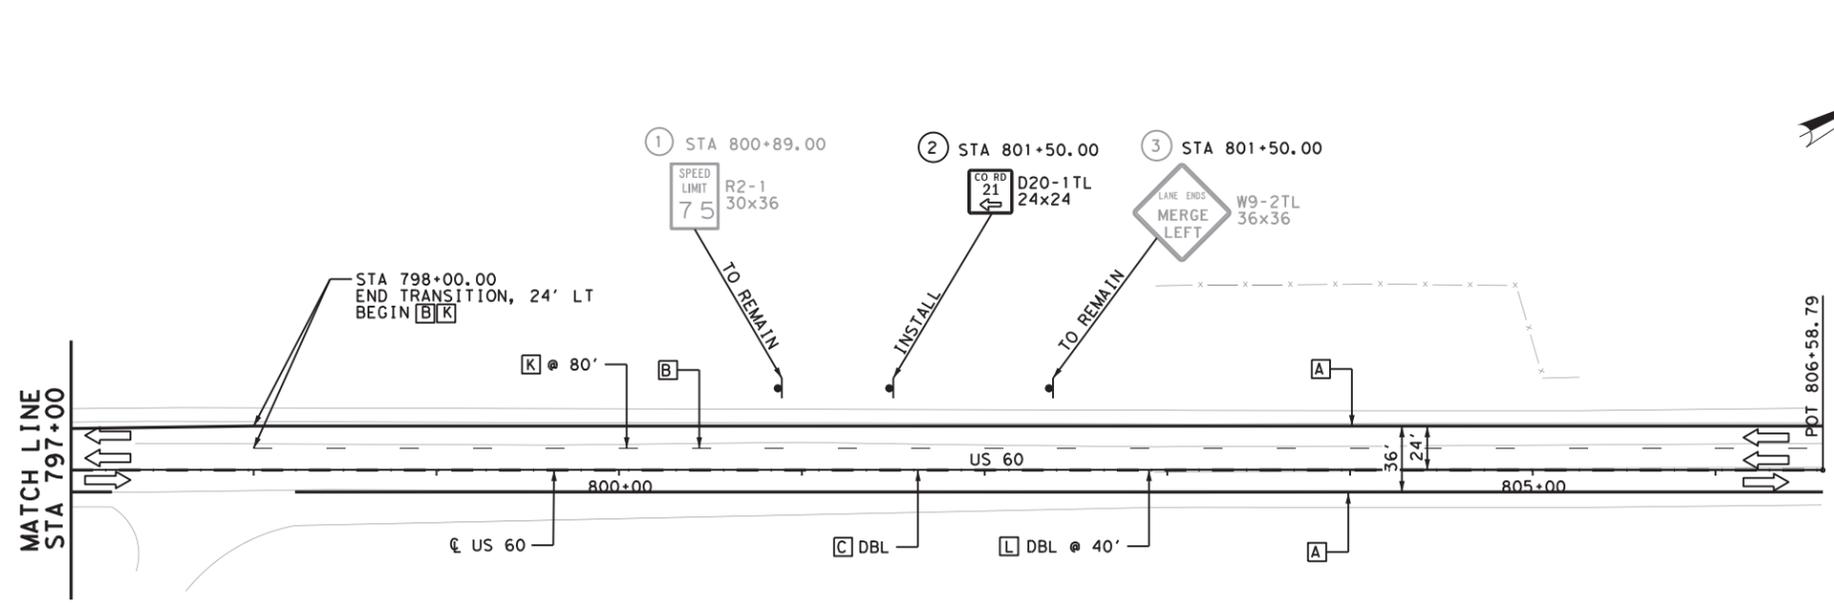

LEGEND

- A RE PM W/RET REQ TY I (W) 4" (SLD)
- B RE PM W/RET REQ TY I (W) 4" (BRK)
- C RE PM W/RET REQ TY I (Y) 4" (SLD)
- D RE PM W/RET REQ TY I (Y) 4" (BRK)
- E REFL PAV MRK TY I (W) 4" (DOT)
- F REFL PAV MRK TY I (W) 8" (SLD)
- G REFL PAV MRK TY I (W) 12" (SLD)
- H REFL PAV MRK TY I (W) 24" (SLD)
- I REFL PAV MRK TY I (Y) 24" (SLD)
- J REFL PAV MRK TY I (W) (LNDPARW)
- K REFL PAV MRKR TY I-C
- L REFL PAV MRKR TY II-A-A
- M OBJECT MARKER
- N RELF PAV MRK TY I (W) (ARROW)
- # SIGN NUMBER
- ⇨ EXIST DIRECTION OF TRAFFIC
- ⇨ PROP DIRECTION OF TRAFFIC
- ⦿ PROP WHITE FLX GF2 DELINEATOR (BI)

04/07/2021

Bo L. Ratto

REV. NO.	DATE	DESCRIPTION	BY

CobbFendley 13430 Northwest Freeway, Ste. 1100
Houston, Texas 77040
713.462.3242
www.cobbhendley.com






**SIGNING AND
PAVEMENT MARKING PLANS**
STA 797+00 TO STA 806+58.79
SHEET 35 OF 35

FED. RD. DIV. NO.	STATE	PROJECT NO.	HIGHWAY NO.
6	TEXAS	(SEE TITLE SHEET)	US60
STATE DISTRICT	COUNTY	CONTROL NO.	SECTION NO.
AMA	GRAY	0169	07
			JOB NO.
			053, ETC
			SHEET NO.
			220

US60-TRAF-SPW-35.dgn



- LEGEND:**
- TRAFFIC FLOW ARROW
 - [A] REFL PAV MRK TY I (W) 4" (SLD)
 - [B] REFL PAV MRK TY I (W) 8" (SLD)
 - [C] REFL PAV MRK TY I (W) 24" (SLD)
 - [D] REFL PAV MRK TY I (Y) 4" (SLD)
 - [E] REFL PAV MRKR TY II-A-A @ 80' O.C.
 - [F] REFL PAV MRKR TY I-C @ 20' O.C.
 - [G] REFL PAV MRKR TY I (W) (ARROW)
 - [H] REFL PAV MRKR TY I (W) (WORD)
 - [I] REFL PAV MRKR TY I (W) 4" (BRK)
 - INSTL DEL ASSM (D-SY) SZ1 (YFLX) GND (BR) @ 75' SPA

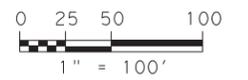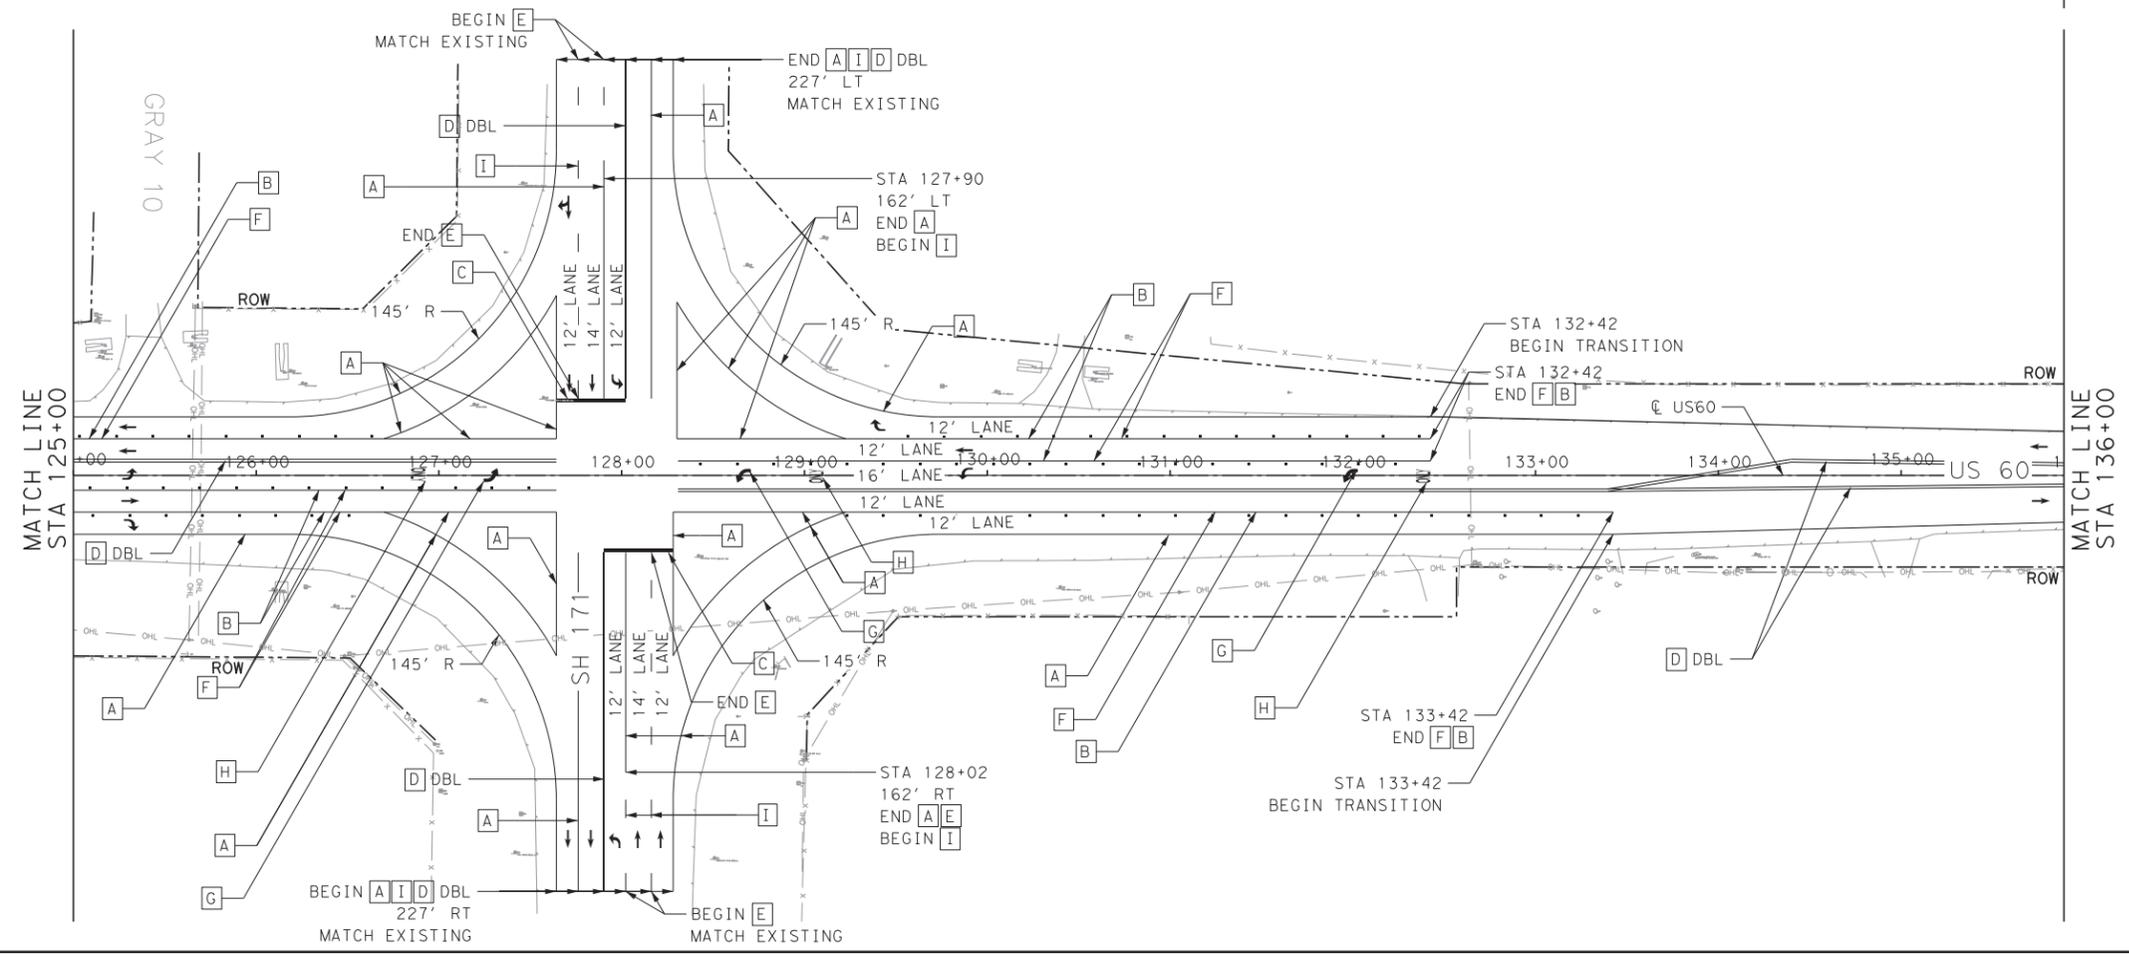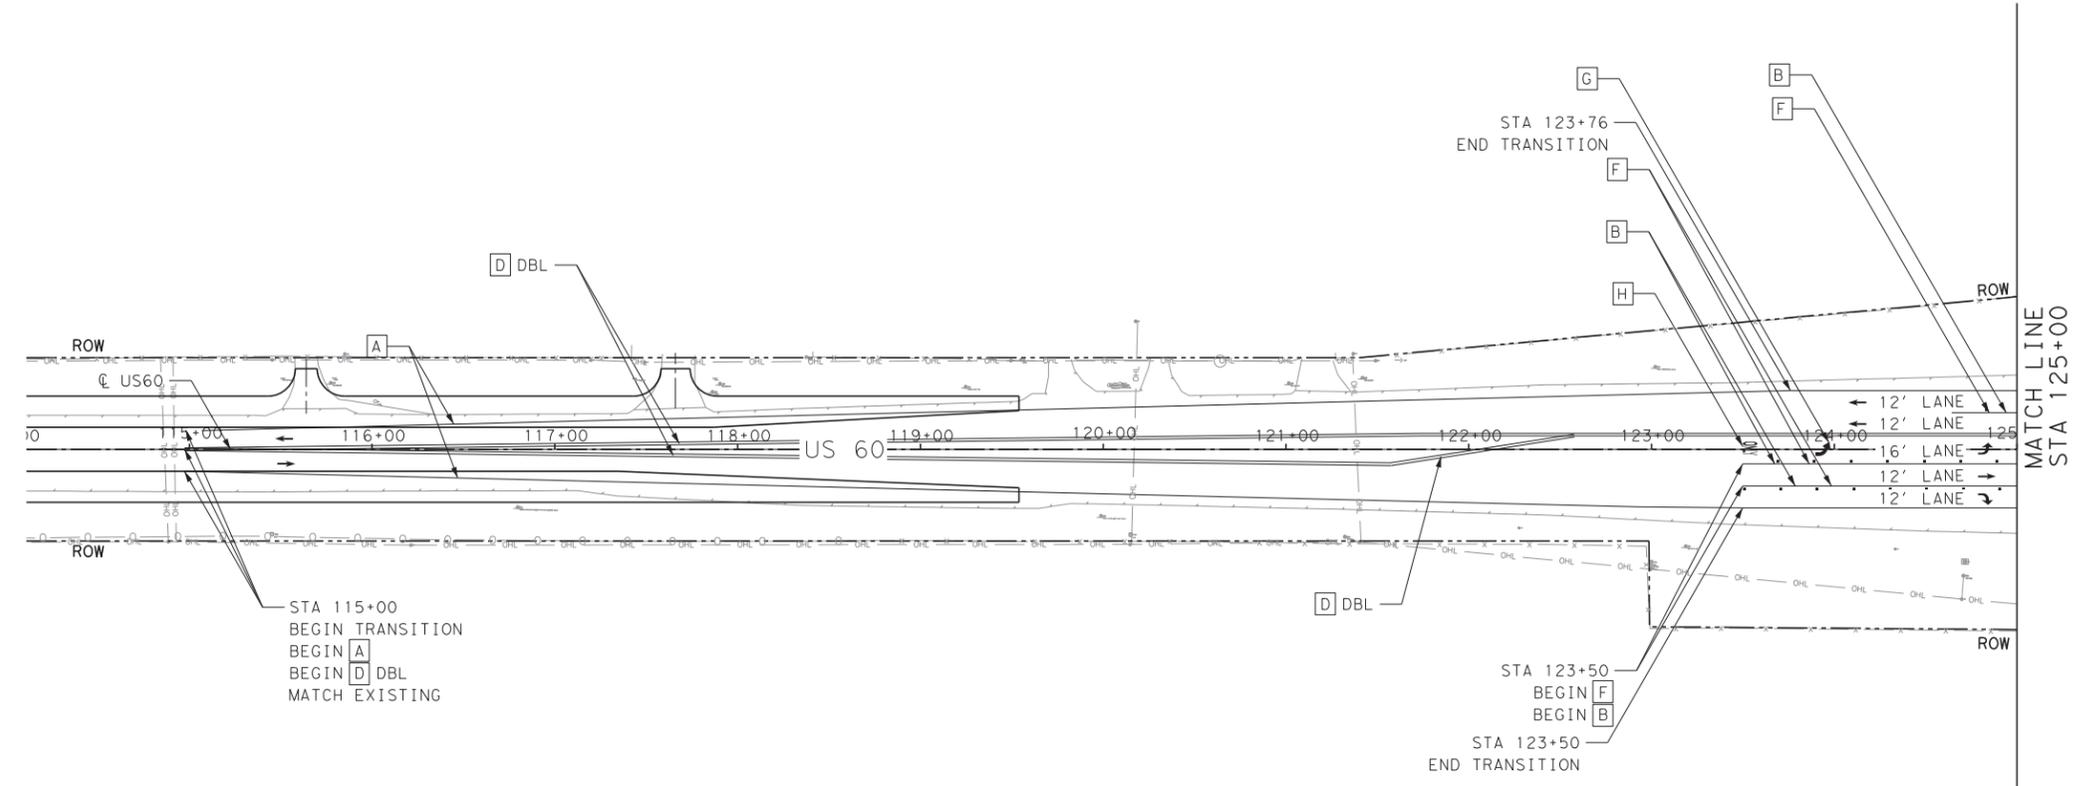

REV. NO.	DATE	DESCRIPTION	BY

LAMB-STAR ENGINEERING, L.L.C.
 5700 W. PLANO PARKWAY, SUITE 1000
 PLANO, TEXAS 75093 (214) 440-3600
 TEXAS REGISTERED ENGINEERING FIRM F-9073




**US60 & SH171
 PAVEMENT MARKINGS**

SHEET 1 OF 2

FED. RD. DIV. NO.	STATE	PROJECT NO.	HIGHWAY NO.		
6	TEXAS	SEE TITLE SHEET	US 60		
STATE DISTRICT	COUNTY	CONTROL NO.	SECTION NO.	JOB NO.	SHEET NO.
AMA	GRAY	0169	07	053, ETC	221

3/31/2021 3:56:43 PM L:\Projects\B2000495_03 - Cobb, Fenley - Amarillo District - US 60\CAD\Eng\Sheets\US60-SH171_P\WRK_001.dgn

US60-SH171_P\WRK_001.dgn

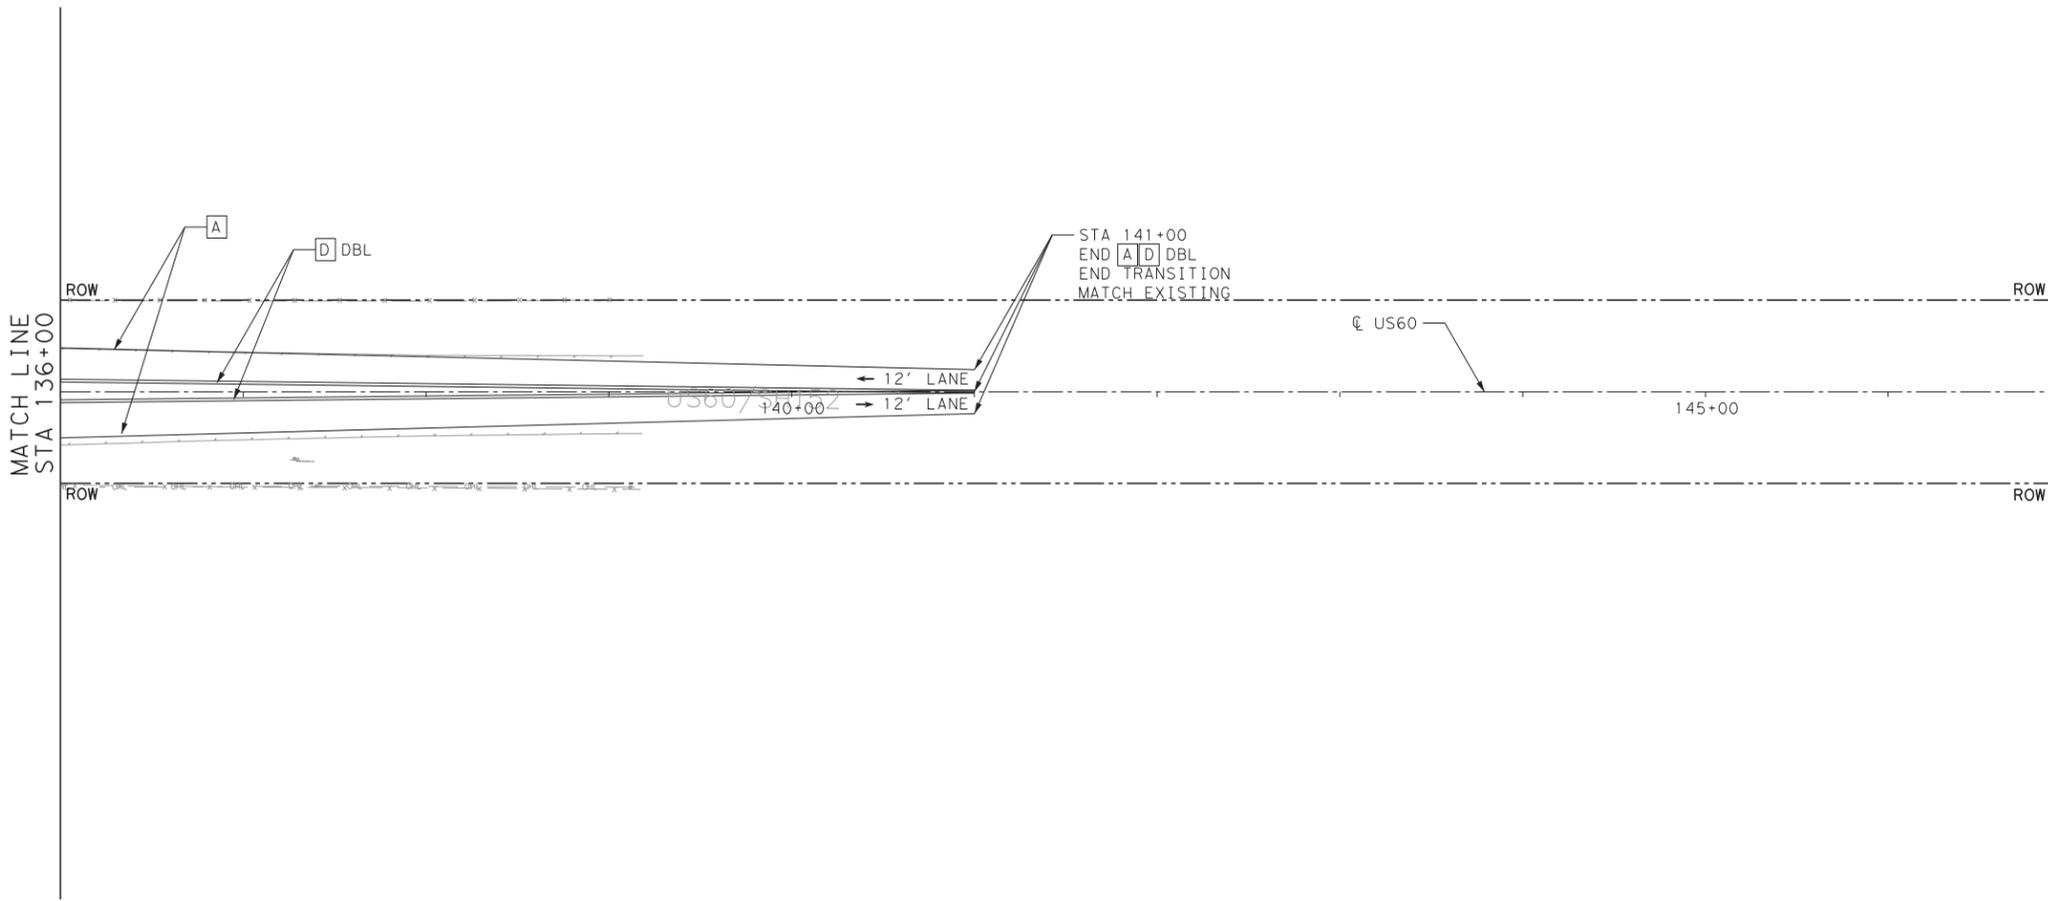

LEGEND:

- TRAFFIC FLOW ARROW
- [A] REFL PAV MRK TY I (W) 4" (SLD)
- [B] REFL PAV MRK TY I (W) 8" (SLD)
- [C] REFL PAV MRK TY I (W) 24" (SLD)
- [D] REFL PAV MRK TY I (Y) 4" (SLD)
- [E] REFL PAV MRKR TY II-A-A @ 80' O.C.
- [F] REFL PAV MRKR TY I-C @ 20' O.C.
- [G] REFL PAV MRKR TY I (W) (ARROW)
- [H] REFL PAV MRKR TY I (W) (WORD)
- [I] REFL PAV MRKR TY I (W) 4" (BRK)
- INSTL DEL ASSM (D-SY) SZ1 (YFLX) GND (BR) @ 75' SPA

REV. NO.	DATE	DESCRIPTION	BY

LAMB-STAR ENGINEERING, L.L.C.
 5700 W. PLANO PARKWAY, SUITE 1000
 PLANO, TEXAS 75093 (214) 440-3600
 TEXAS REGISTERED ENGINEERING FIRM F-9073



**US60 & SH171
PAVEMENT MARKINGS**


SHEET 2 OF 2

FED. RD. DIV. NO.	STATE	PROJECT NO.		HIGHWAY NO.	
6	TEXAS	SEE TITLE SHEET	SEE TITLE SHEET	US 60	US 60
STATE DISTRICT	COUNTY	CONTROL NO.	SECTION NO.	JOB NO.	SHEET NO.
AMA	GRAY	0169	07	053, ETC	222

3/31/2021 3:56:48 PM
 L:\Projects\B200495_03 - Cobb, Fendley - Amarillo District - US 60CAD\Eng\Sheets\US60-SH171-P\MRK_002.dgn

US60-SH171-P\MRK_002.dgn

3/31/2021 3:58:53 PM
 L:\Projects\B200495_03 - Cobb, Fendley - Amarillo District - US 60\CAD\Eng\Sheets\SH152_P\MRK_001.dgn

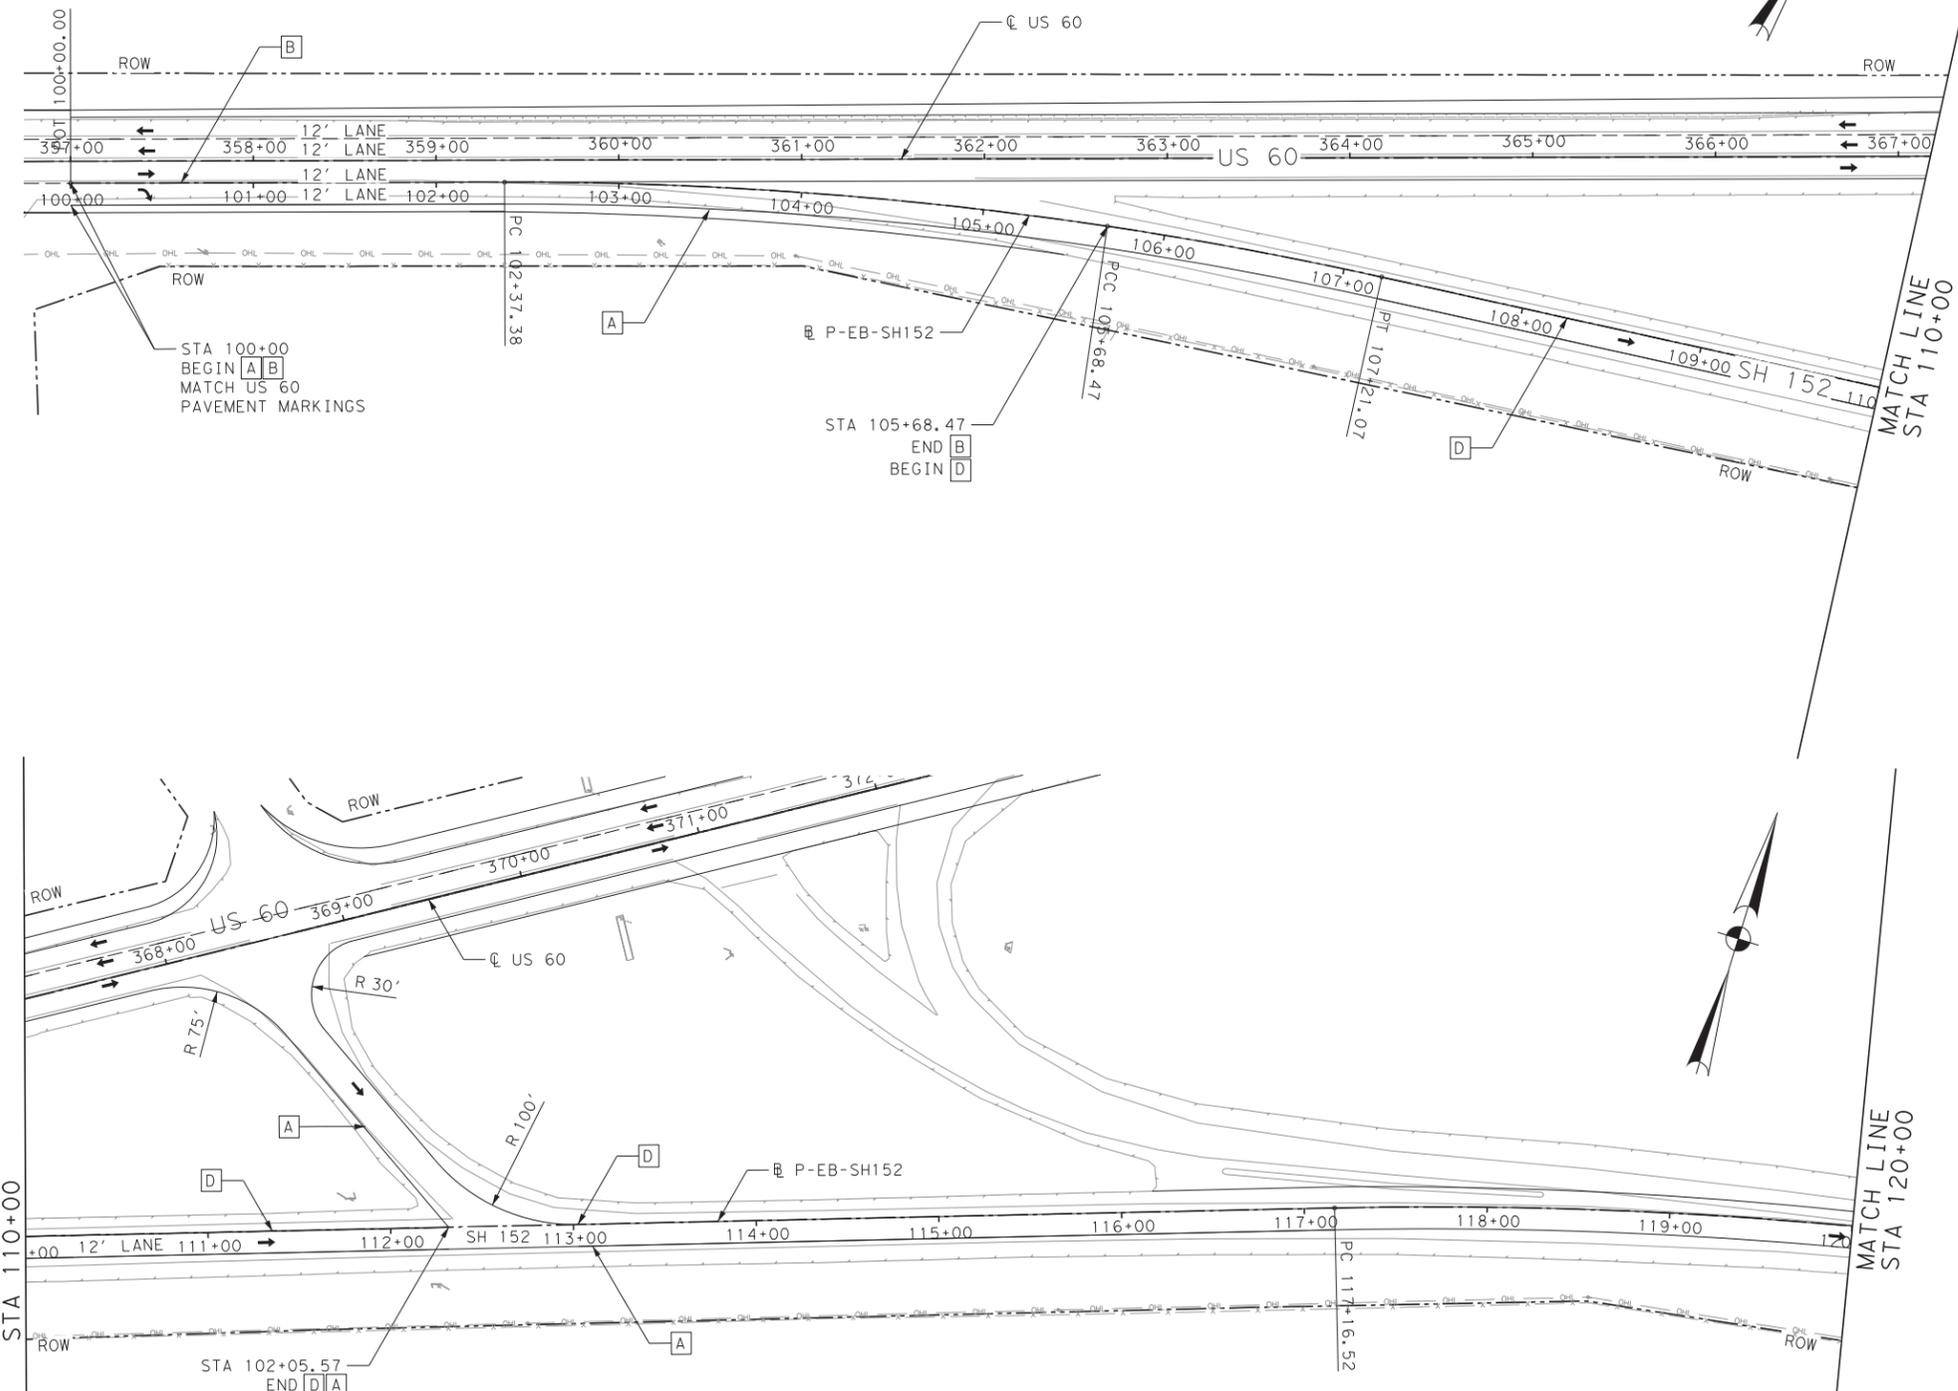

- LEGEND:**
- TRAFFIC FLOW ARROW
 - [A] REFL PAV MRK TY I (W) 4" (SLD)
 - [B] REFL PAV MRK TY I (W) 8" (SLD)
 - [C] REFL PAV MRK TY I (W) 24" (SLD)
 - [D] REFL PAV MRK TY I (Y) 4" (SLD)
 - [E] REFL PAV MRKR TY II-A-A @ 80' O.C.
 - [F] REFL PAV MRKR TY I-C @ 20' O.C.
 - [G] REFL PAV MRKR TY I (W) (ARROW)
 - [H] REFL PAV MRKR TY I (W) (WORD)
 - [I] REFL PAV MRKR TY I (W) 4" (BRK)
 - INSTL DEL ASSM (D-SY) SZ1 (YFLX) GND (BR) @ 75' SPA

0 25 50 100
 1" = 100'

REV. NO.	DATE	DESCRIPTION	BY

LAMB-STAR ENGINEERING, L.L.C.
 5700 W. PLANO PARKWAY, SUITE 1000
 PLANO, TEXAS 75093 (214) 440-3600
 TEXAS REGISTERED ENGINEERING FIRM F-9073




SH152
 PAVEMENT MARKINGS

SHEET 1 OF 3

FED. RD. DIV. NO.	STATE	PROJECT NO.	HIGHWAY NO.		
6	TEXAS	SEE TITLE SHEET	US 60		
STATE DISTRICT	COUNTY	CONTROL NO.	SECTION NO.	JOB NO.	SHEET NO.
AMA	GRAY	0169	07	053, ETC	223


SH152_P\MRK_001.dgn

3/31/2021 3:58:57 PM
 L:\Projects\B2009495_03 - Cobb, Fendley - Amarillo District - US 60\CAD\Eng\Sheets\SH152_P\WRK_002.dgn

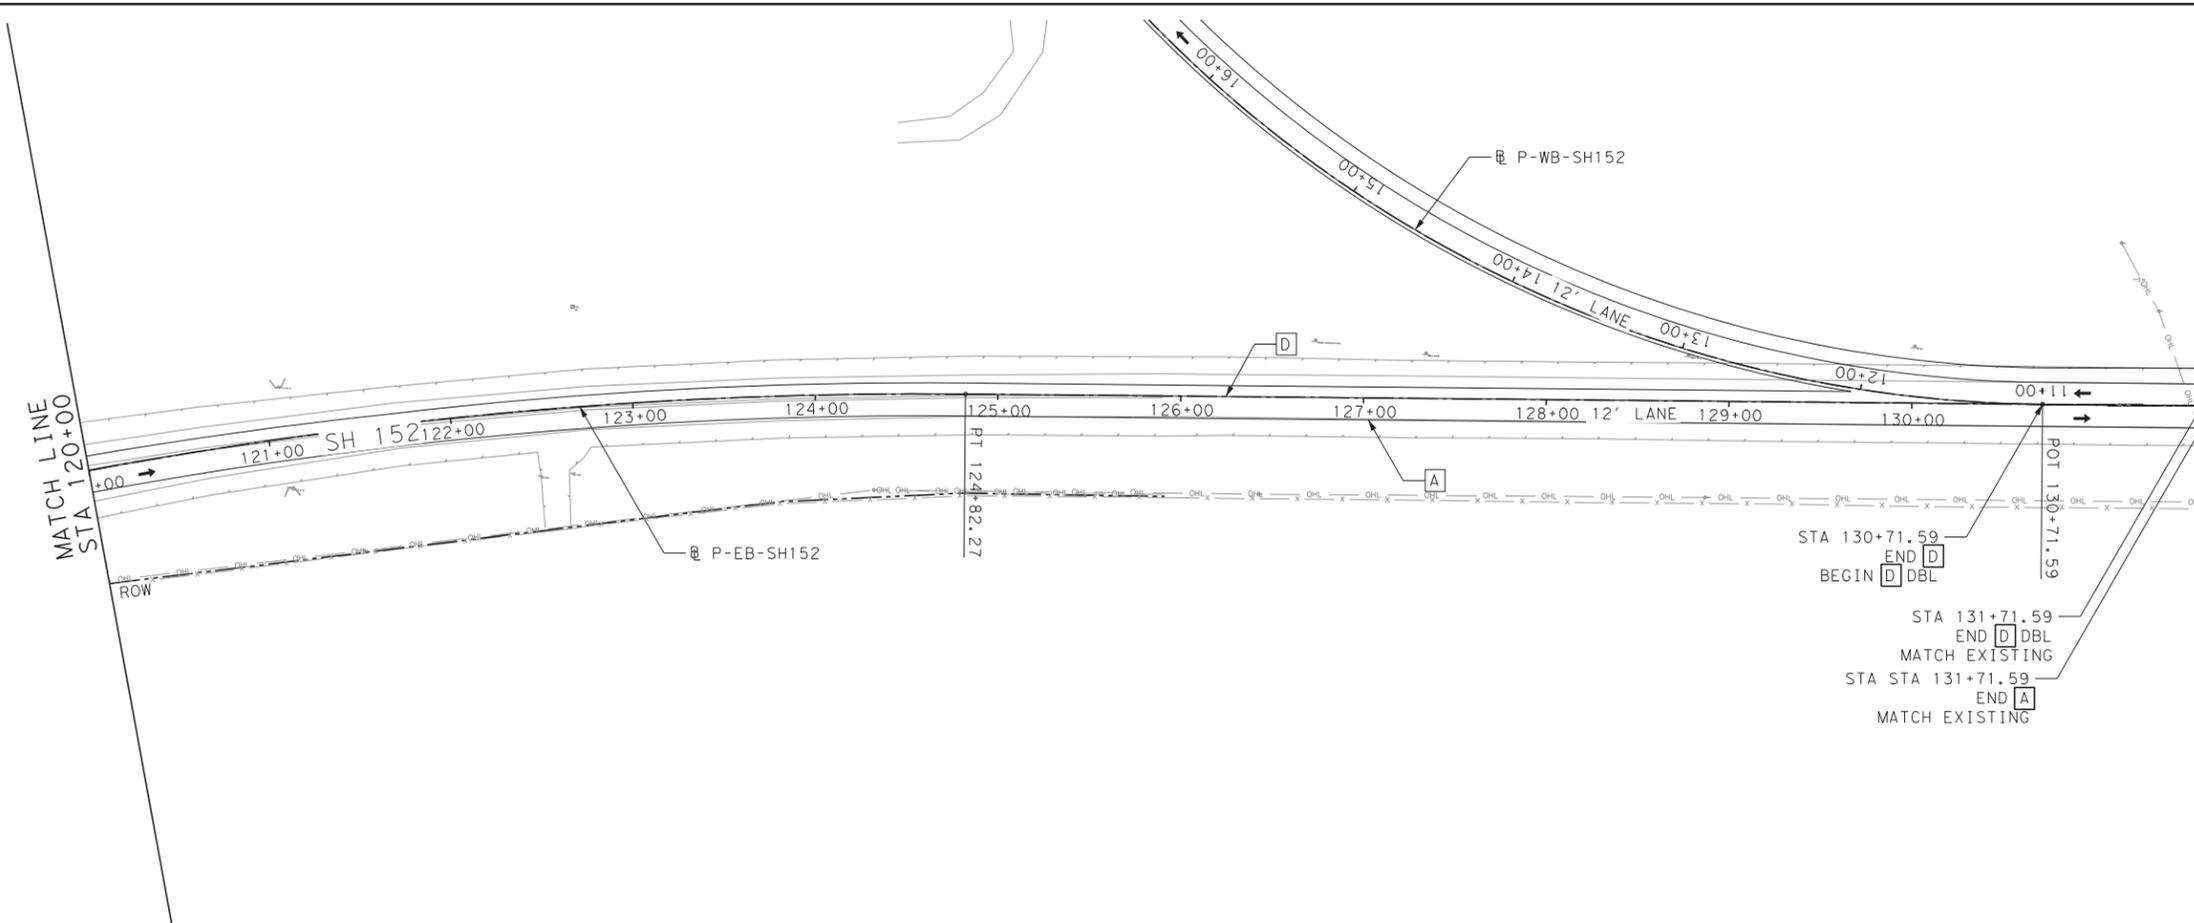

LEGEND:

- TRAFFIC FLOW ARROW
- [A] REFL PAV MRK TY I (W) 4" (SLD)
- [B] REFL PAV MRK TY I (W) 8" (SLD)
- [C] REFL PAV MRK TY I (W) 24" (SLD)
- [D] REFL PAV MRK TY I (Y) 4" (SLD)
- [E] REFL PAV MRKR TY II-A-A @ 80' O.C.
- [F] REFL PAV MRKR TY I-C @ 20' O.C.
- [G] REFL PAV MRKR TY I (W) (ARROW)
- [H] REFL PAV MRKR TY I (W) (WORD)
- [I] REFL PAV MRKR TY I (W) 4" (BRK)
- INSTL DEL ASSM (D-SY) SZ1 (YFLX) GND (BR) @ 75' SPA

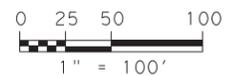

REV. NO.	DATE	DESCRIPTION	BY

LAMB-STAR ENGINEERING, L.L.C.
 5700 W. PLANO PARKWAY, SUITE 1000
 PLANO, TEXAS 75093 (214) 440-3600
 TEXAS REGISTERED ENGINEERING FIRM F-9073




**SH152
 PAVEMENT MARKINGS**

SHEET 2 OF 3



FED. RD. DIV. NO.	STATE	PROJECT NO.	HIGHWAY NO.		
6	TEXAS	SEE TITLE SHEET	US 60		
STATE DISTRICT	COUNTY	CONTROL NO.	SECTION NO.	JOB NO.	SHEET NO.
AMA	GRAY	0169	07	053, ETC	224

SH152_P\WRK_002.dgn

3/31/2021 3:59:03 PM L:\Projects\B200495_03 - Cobb, Fenley - Amarillo District - US 60CAD\Eng\Sheets\SH152_P\MRK_003.dgn

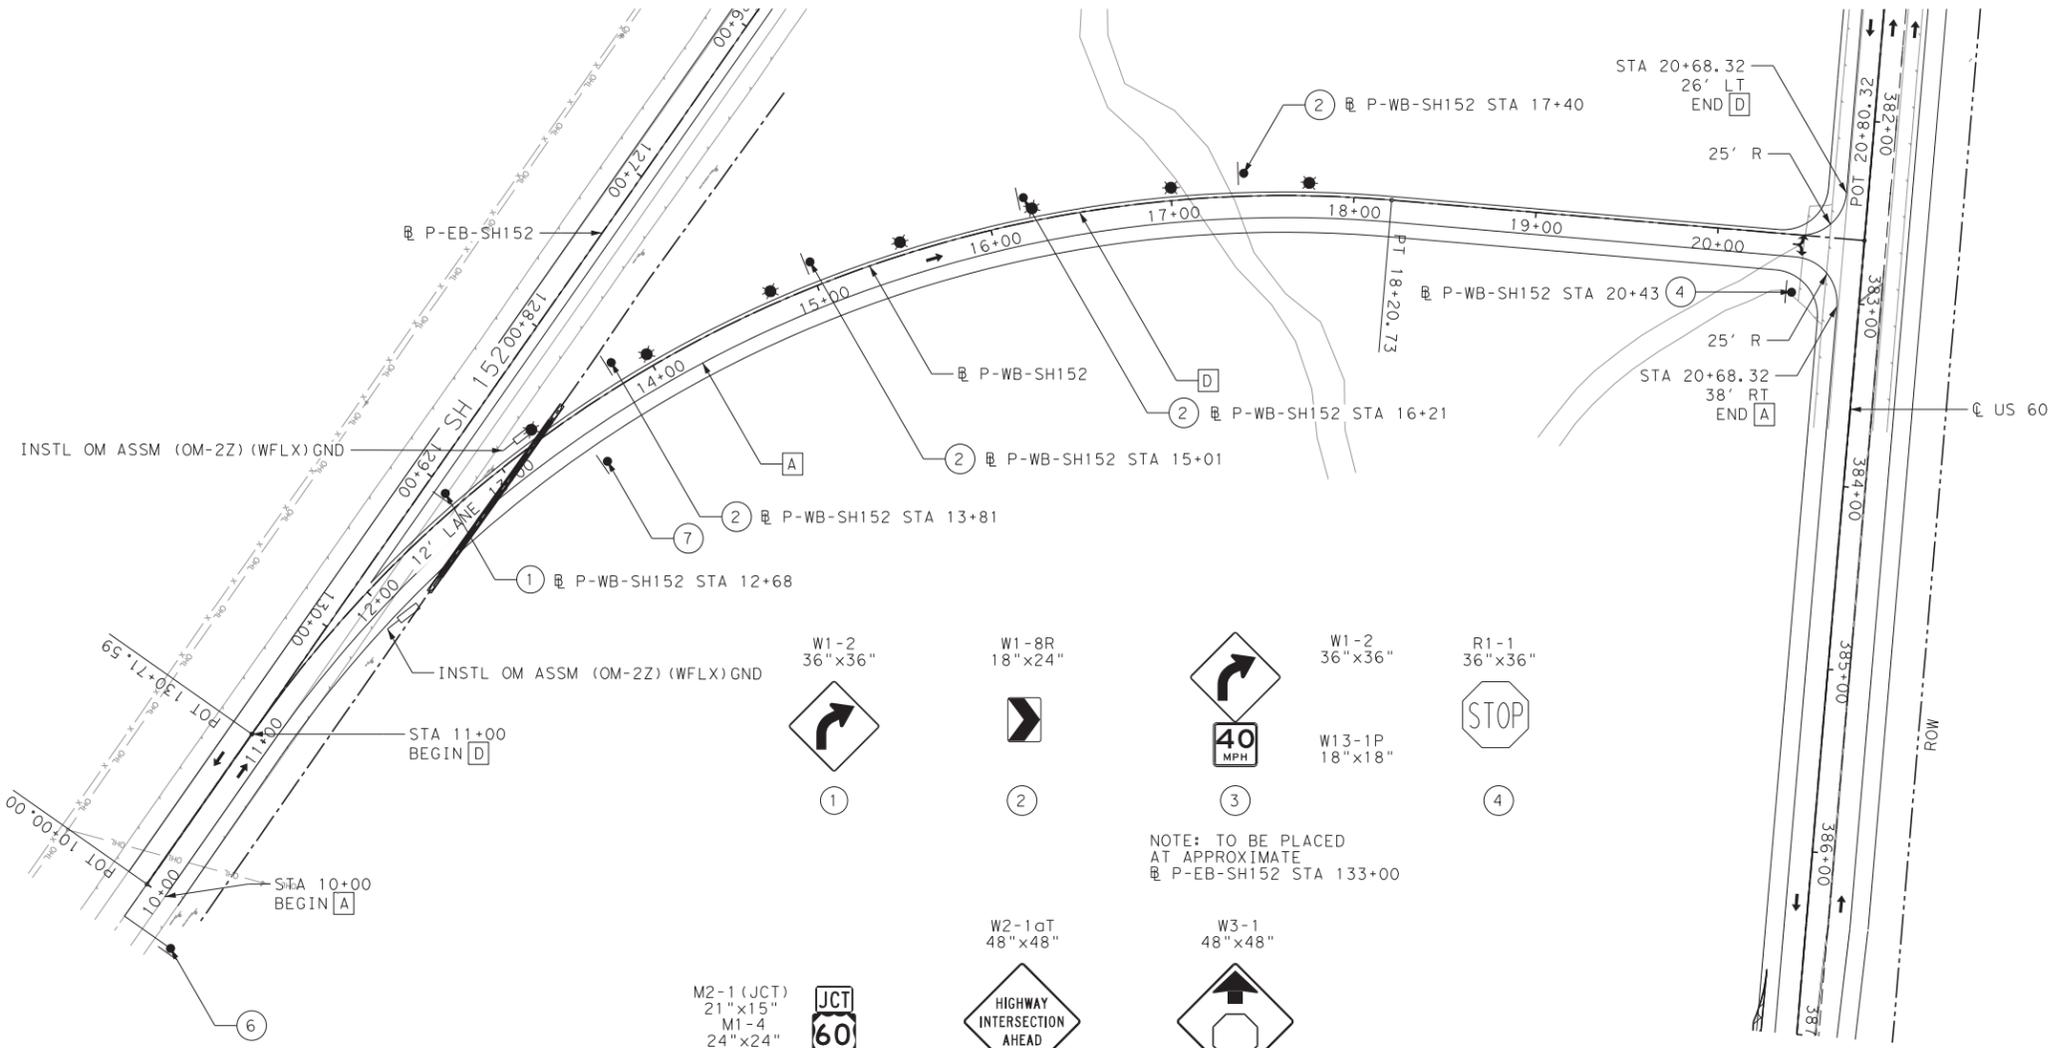

- LEGEND:**
- TRAFFIC FLOW ARROW
 - [A] REFL PAV MRK TY I (W) 4" (SLD)
 - [B] REFL PAV MRK TY I (W) 8" (SLD)
 - [C] REFL PAV MRK TY I (W) 24" (SLD)
 - [D] REFL PAV MRK TY I (Y) 4" (SLD)
 - [E] REFL PAV MRKR TY II-A-A @ 80' O.C.
 - [F] REFL PAV MRKR TY I-C @ 20' O.C.
 - [G] REFL PAV MRKR TY I (W) (ARROW)
 - [H] REFL PAV MRKR TY I (W) (WORD)
 - [I] REFL PAV MRKR TY I (W) 4" (BRK)
 - INSTL DEL ASSM (D-SY) SZ1 (YFLX) GND (BR) @ 75' SPA

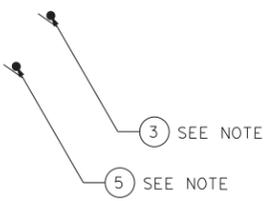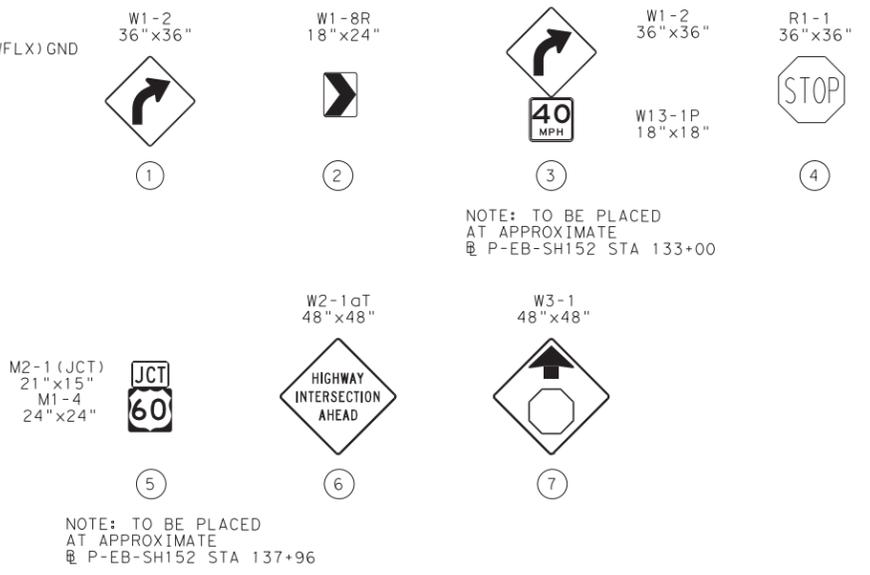

REV. NO.	DATE	DESCRIPTION	BY

LAMB-STAR ENGINEERING, L.L.C.
 5700 W. PLANO PARKWAY, SUITE 1000
 PLANO, TEXAS 75093 (214) 440-3600
 TEXAS REGISTERED ENGINEERING FIRM F-9073




SH 152
PAVEMENT MARKINGS


SHEET 3 OF 3

FED. RD. DIV. NO.	STATE	PROJECT NO.	HIGHWAY NO.
6	TEXAS	SEE TITLE SHEET	US 60
STATE DISTRICT	COUNTY	CONTROL NO.	SECTION NO.
AMA	GRAY	0169	07
		JOB NO.	SHEET NO.
		053, ETC	225


SH152_P\MRK_003.dgn

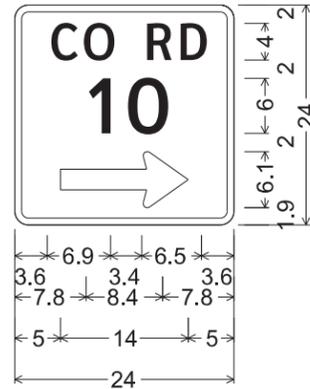


Identifier : D20-1TR_24x24;
 1.5" Radius, 0.8" Border, White on Green;
 [CO RD] ClearviewHwy-3-W;
 [10] ClearviewHwy-3-W;
 Standard Arrow Custom 14.0" X 6.1" 0°;

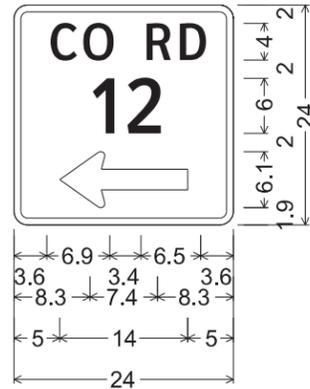


Identifier : D20-1TL_24x24;
 1.5" Radius, 0.8" Border, White on Green;
 [CO RD] ClearviewHwy-3-W;
 [12] ClearviewHwy-3-W;
 Standard Arrow Custom 14.0" X 6.1" 180°;

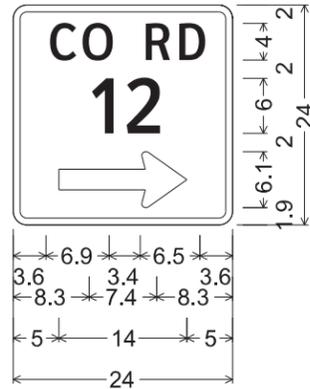


Identifier : D20-1TR_24x24;
 1.5" Radius, 0.8" Border, White on Green;
 [CO RD] ClearviewHwy-3-W;
 [12] ClearviewHwy-3-W;
 Standard Arrow Custom 14.0" X 6.1" 0°;

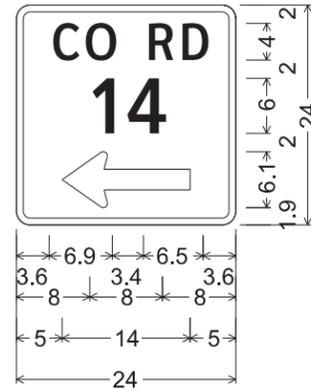


Identifier : D20-1TL_24x24;
 1.5" Radius, 0.8" Border, White on Green;
 [CO RD] ClearviewHwy-3-W;
 [14] ClearviewHwy-3-W;
 Standard Arrow Custom 14.0" X 6.1" 180°;

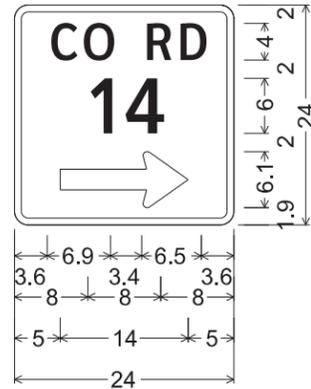


Identifier : D20-1TR_24x24;
 1.5" Radius, 0.8" Border, White on Green;
 [CO RD] ClearviewHwy-3-W;
 [14] ClearviewHwy-3-W;
 Standard Arrow Custom 14.0" X 6.1" 0°;

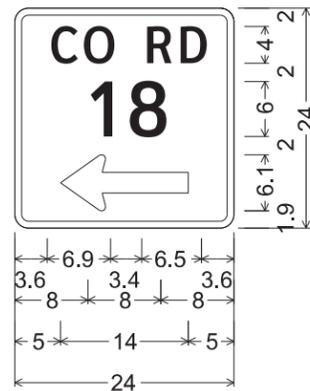


Identifier : D20-1TL_24x24;
 1.5" Radius, 0.8" Border, White on Green;
 [CO RD] ClearviewHwy-3-W;
 [18] ClearviewHwy-3-W;
 Standard Arrow Custom 14.0" X 6.1" 180°;

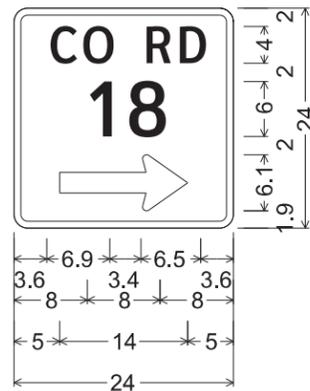


Identifier : D20-1TR_24x24;
 1.5" Radius, 0.8" Border, White on Green;
 [CO RD] ClearviewHwy-3-W;
 [18] ClearviewHwy-3-W;
 Standard Arrow Custom 14.0" X 6.1" 0°;

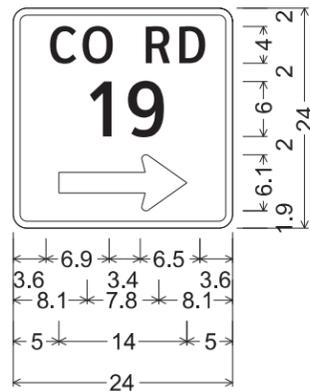


Identifier : D20-1TR_24x24;
 1.5" Radius, 0.8" Border, White on Green;
 [CO RD] ClearviewHwy-3-W;
 [19] ClearviewHwy-3-W;
 Standard Arrow Custom 14.0" X 6.1" 0°;

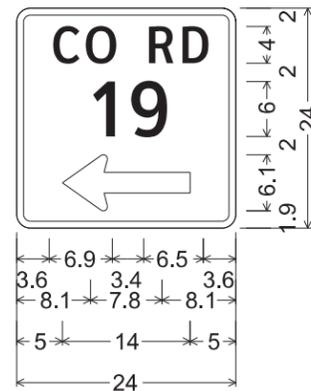


Identifier : D20-1TL_24x24;
 1.5" Radius, 0.8" Border, White on Green;
 [CO RD] ClearviewHwy-3-W;
 [19] ClearviewHwy-3-W;
 Standard Arrow Custom 14.0" X 6.1" 180°;

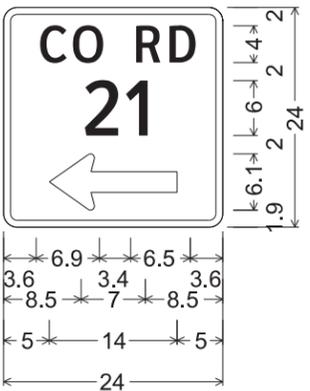


Identifier : D20-1TL_24x24;
 1.5" Radius, 0.8" Border, White on Green;
 [CO RD] ClearviewHwy-3-W;
 [21] ClearviewHwy-3-W;
 Standard Arrow Custom 14.0" X 6.1" 180°;

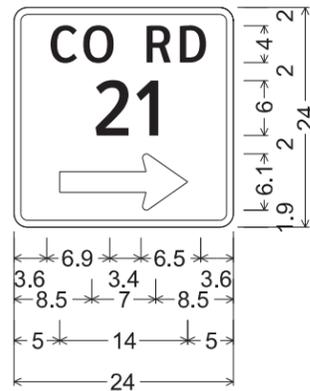

Identifier : D20-1TR_24x24;
 1.5" Radius, 0.8" Border, White on Green;
 [CO RD] ClearviewHwy-3-W;
 [21] ClearviewHwy-3-W;
 Standard Arrow Custom 14.0" X 6.1" 0°;

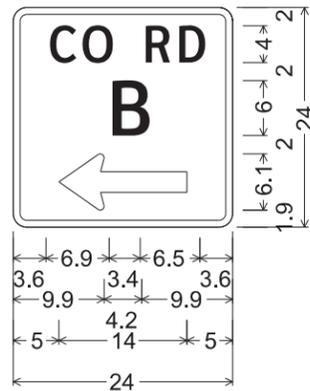

Identifier : D20-1TL_24x24;
 1.5" Radius, 0.8" Border, White on Green;
 [CO RD] ClearviewHwy-3-W;
 [B] ClearviewHwy-3-W;
 Standard Arrow Custom 14.0" X 6.1" 180°;

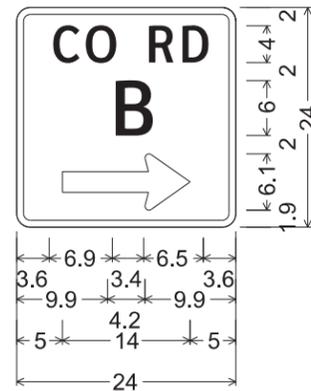

Identifier : D20-1TR_24x24;
 1.5" Radius, 0.8" Border, White on Green;
 [CO RD] ClearviewHwy-3-W;
 [B] ClearviewHwy-3-W;
 Standard Arrow Custom 14.0" X 6.1" 0°;

4/7/2021 7:28:18 AM F:\Proj\62019\1004_Traffic\560-US60-AM\11616\ENG\500-UST\N\509-Traffic\02-Sheets\US60-Traf-Sign-Detail.dgn

04/07/2021

Bo L. Ratto
 SCALE: NTS


REV. NO.	DATE	DESCRIPTION	BY

13430 Northwest Freeway, Ste. 1100
 Houston, Texas 77040
 713.462.3242
 www.cobbhendley.com


SIGN DETAIL

FED. RD. DIV. NO.		STATE		PROJECT NO.		HIGHWAY NO.	
6		TEXAS		(SEE TITLE SHEET)		US60	
STATE DISTRICT	COUNTY	CONTROL NO.	SECTION NO.	JOB NO.	SHEET NO.		
AMA	GRAY	0169	07	053, ETC	226		


SHEET 1 OF 3

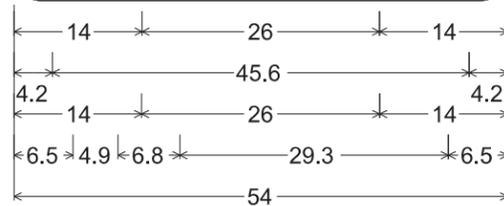

Identifier : D15-11T_54x48;
 3.0" Radius, 1.0" Border, White on Green;
 [NEXT] ClearviewHwy-3-W;
 [PASSING] ClearviewHwy-3-W;
 [LANE] ClearviewHwy-3-W;
 [2 MILES] ClearviewHwy-3-W;

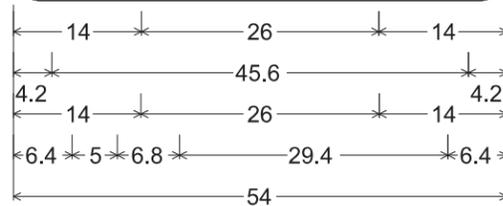

Identifier : D15-11T_54x48;
 3.0" Radius, 1.0" Border, White on Green;
 [NEXT] ClearviewHwy-3-W;
 [PASSING] ClearviewHwy-3-W;
 [LANE] ClearviewHwy-3-W;
 [3 MILES] ClearviewHwy-3-W;

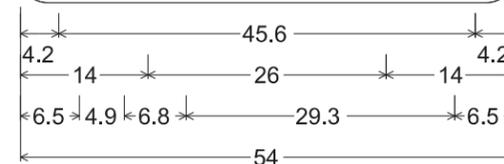

Identifier : D15-10T_54x42;
 3.0" Radius, 1.0" Border, White on Green;
 [PASSING] ClearviewHwy-3-W;
 [LANE] ClearviewHwy-3-W;
 [2 MILES] ClearviewHwy-3-W;

04/07/2021

Bo L. Ratto
SCALE: NTS

REV. NO.	DATE	DESCRIPTION	BY

CobbFendley 13430 Northwest Freeway, Ste. 1100
 Houston, Texas 77040
 TBPE Firm Registration No. 274 713.462.3242
 TBPLS Firm Registration No. 100467 www.cobbhendley.com













SIGN DETAIL

FED. RD. DIV. NO.	STATE	PROJECT NO.		HIGHWAY NO.	
6	TEXAS	(SEE TITLE SHEET)		US60	
STATE DISTRICT	COUNTY	CONTROL NO.	SECTION NO.	JOB NO.	SHEET NO.
AMA	GRAY	0169	07	053, ETC	228

DISCLAIMER: The use of this standard is governed by the "Texas Engineering Practice Act". No warranty of any kind is made by TxDOT for any purpose whatsoever. TxDOT assumes no responsibility for the conversion of units or for the use of this standard for purposes other than those intended.

DATE: 4/7/2021 7:28:21 AM
 FILE: F:\Projects\2019\11004.TxDOT_5x5_PS&E\03_US60_Amarillo\ENG\500-USTN\509-11004-03-01.dwg

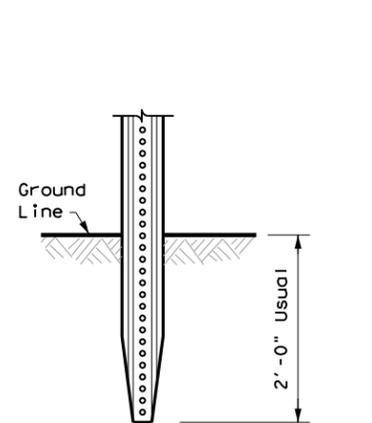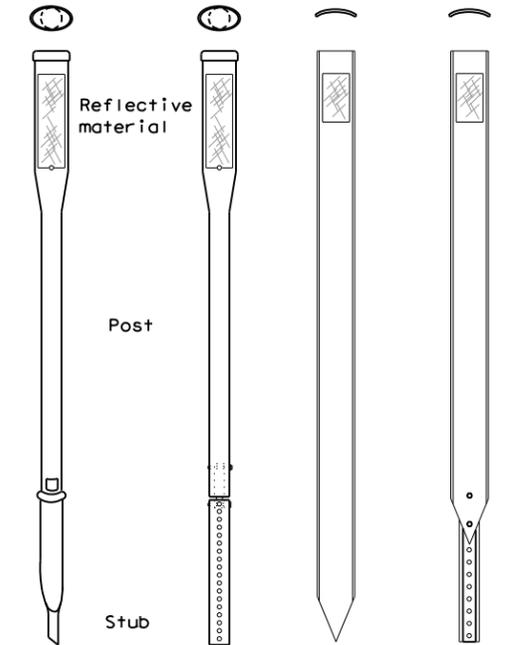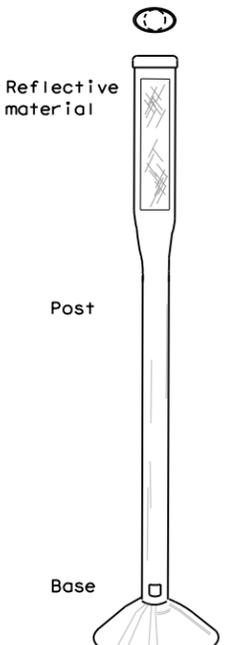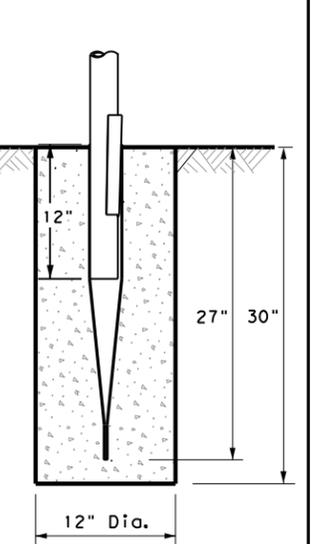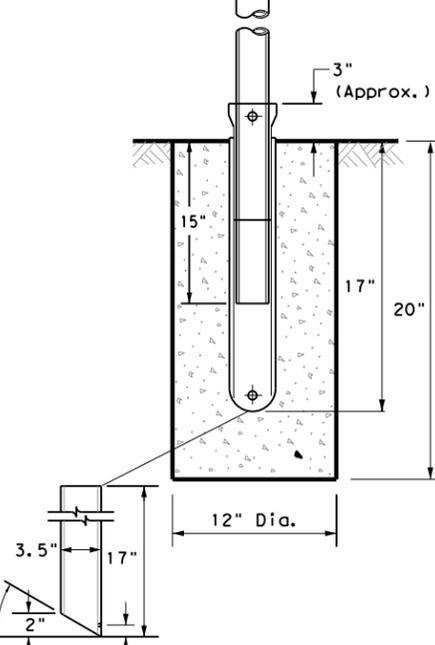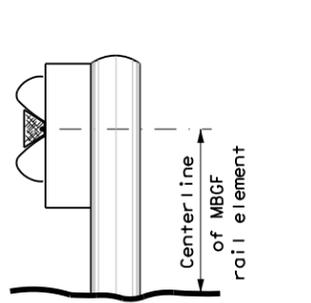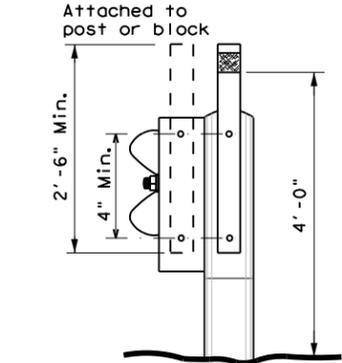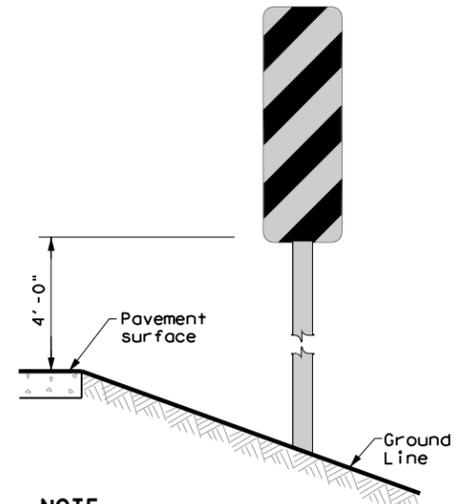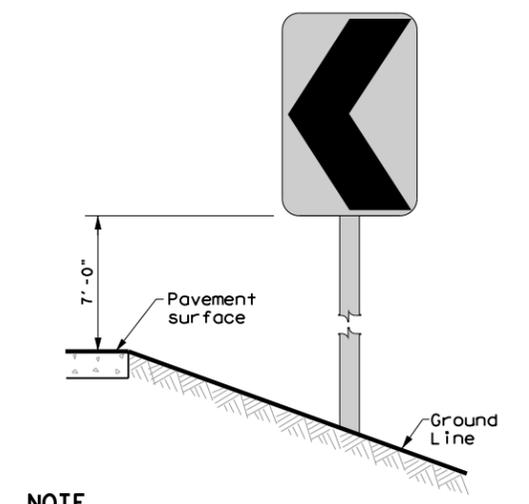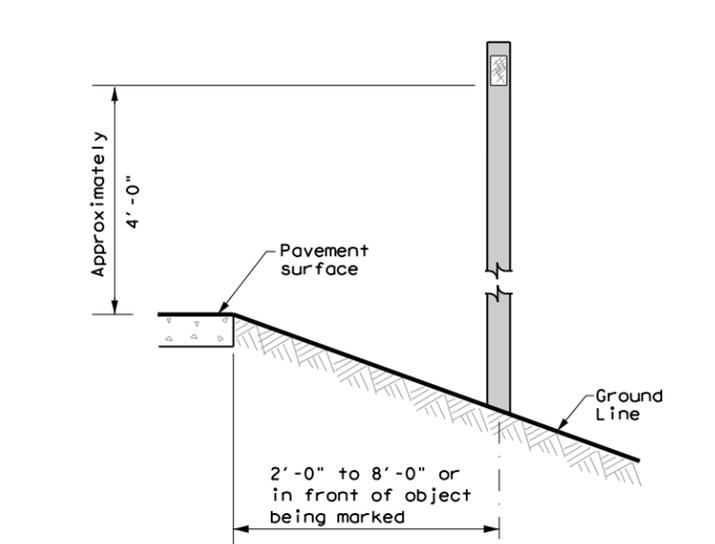
POST TYPE AND SUPPORT FOUNDATION DETAILS				TYPE OF BARRIER MOUNTS																										
WING CHANNEL (WC)	FLEXIBLE POSTS (YFLX, WFLX)		WEDGE ANCHOR SYSTEMS		GUARD FENCE ATTACHMENT																									
GND	GND	SRF	WAS	WAP	GF 1																									
 <p style="text-align: center;">2'-0" Usual</p>			 <p style="text-align: center;">12" Dia.</p>	 <p style="text-align: center;">12" Dia.</p>																										
	EMBEDDED	SURFACE MOUNT	STEEL	PLASTIC	CONCRETE TRAFFIC BARRIER (CTB)																									
NOTES 1. Embedded Wing Channel (WC) post option may be used for Type 2 Object Markers and Delineators only. 2. 1.12 lbs/ft steel per ASTM A 1011 SS Gr. 50, or ASTM A499.		NOTES 1. See "Flexible Delineator and Object Marker Posts" Material Producer List for approved devices. 2. Install per manufacturer's recommendations. 3. Post length may vary to meet field conditions. 4. When using yellow delineators with flexible posts to separate opposing direction of travel, such as centerline or median use, the flexible posts shall be yellow.		NOTE 1. Install per manufacturer's recommendations.																										
TYPES 1,3, AND 4 OBJECT MARKERS AND CHEVRONS		CHEVRONS AND ONE DIRECTION LARGE ARROW SIGN		DELINEATORS AND TYPE 2 OBJECT MARKERS																										
																														
NOTE Mounting at 4 feet to the bottom of the chevron is permitted for chevrons that will not exceed a height of 6'-6" to the top of the chevron (sizes 24" x 30" and smaller)		NOTE Chevrons 30" x 36" and larger shall be mounted at a height of 7' to the bottom of the chevron. Chevron sign and ONE DIRECTION LARGE ARROW sign (W1-9T) shall be installed per SMD standard sheets and paid under item 644.		See general notes 1, 2 and 3.																										
GENERAL NOTES 1. Place delineators on a section of roadway at a consistent distance from the edge of pavement. 2. Where a restriction prevents consistent placement from the pavement edge, place the affected object markers in line with the innermost edge of the obstruction. 3. When Type 2 object markers and delineators are more than 8'-0" from the edge of the pavement, it may not be possible to maintain a height of approximately 4'-0". If this is the case, place the object marker or delineator as close to the desired height as possible. 4. Install all delineators, object markers and barrier reflectors in accordance with the manufacturer's recommendation. 5. Barrier reflectors should be installed a minimum of 18 inches above the edge of the pavement surface. 6. Diagonal stripes on Type 3 object markers shall slope down toward the intended travel lane.																														
 Traffic Safety Division Standard																														
<h2 style="margin: 0;">DELINEATOR & OBJECT MARKER INSTALLATION</h2> <h3 style="margin: 0;">D & OM(2)-20</h3>																														
<table border="1" style="width: 100%; border-collapse: collapse; font-size: small;"> <tr> <td>FILE: dom2-20.dgn</td> <td>DN: TxDOT</td> <td>CK: TxDOT</td> <td>DW: TxDOT</td> <td>CR: TxDOT</td> </tr> <tr> <td>© TxDOT August 2004</td> <td>CONT</td> <td>SECT</td> <td>JOB</td> <td>HIGHWAY</td> </tr> <tr> <td>REVISIONS</td> <td>0169</td> <td>07</td> <td>053, ETC</td> <td>US60</td> </tr> <tr> <td>10-09 3-15</td> <td>DIST</td> <td>COUNTY</td> <td colspan="2">SHEET NO.</td> </tr> <tr> <td>4-10 7-20</td> <td>AMA</td> <td>GRAY</td> <td colspan="2" style="text-align: right;">230</td> </tr> </table>						FILE: dom2-20.dgn	DN: TxDOT	CK: TxDOT	DW: TxDOT	CR: TxDOT	© TxDOT August 2004	CONT	SECT	JOB	HIGHWAY	REVISIONS	0169	07	053, ETC	US60	10-09 3-15	DIST	COUNTY	SHEET NO.		4-10 7-20	AMA	GRAY	230	
FILE: dom2-20.dgn	DN: TxDOT	CK: TxDOT	DW: TxDOT	CR: TxDOT																										
© TxDOT August 2004	CONT	SECT	JOB	HIGHWAY																										
REVISIONS	0169	07	053, ETC	US60																										
10-09 3-15	DIST	COUNTY	SHEET NO.																											
4-10 7-20	AMA	GRAY	230																											

DATE: 4/7/2021 7:28:26 AM
 FILE: F:\Projects\2019\11004.TxDOT_5x5_PS&E\03_US60_Amarillo\ENG\500-USTN\509-11004-509-11004.dgn
 The use of this standard is governed by the "Texas Engineering Practice Act". No warranty of any kind is made by TxDOT for any purpose whatsoever. TxDOT assumes no responsibility for the conversion of units or for the accuracy of the information contained herein.

MINIMUM WARNING DEVICES AT CURVES WITH ADVISORY SPEEDS

Amount by which Advisory Speed is less than Posted Speed	Curve Advisory Speed	
	Turn (30 MPH or less)	Curve (35 MPH or more)
5 MPH & 10 MPH	• RPMs	• RPMs
15 MPH & 20 MPH	• RPMs and One Direction Large Arrow sign	• RPMs and Chevrons; or • RPMs and One Direction Large Arrow sign where geometric conditions or roadside obstacles prevent the installation of chevrons.
25 MPH & more	• RPMs and Chevrons; or • RPMs and One Direction Large Arrow sign where geometric conditions or roadside obstacles prevent the installation of chevrons	• RPMs and Chevrons


SUGGESTED SPACING FOR DELINEATORS ON HORIZONTAL CURVES

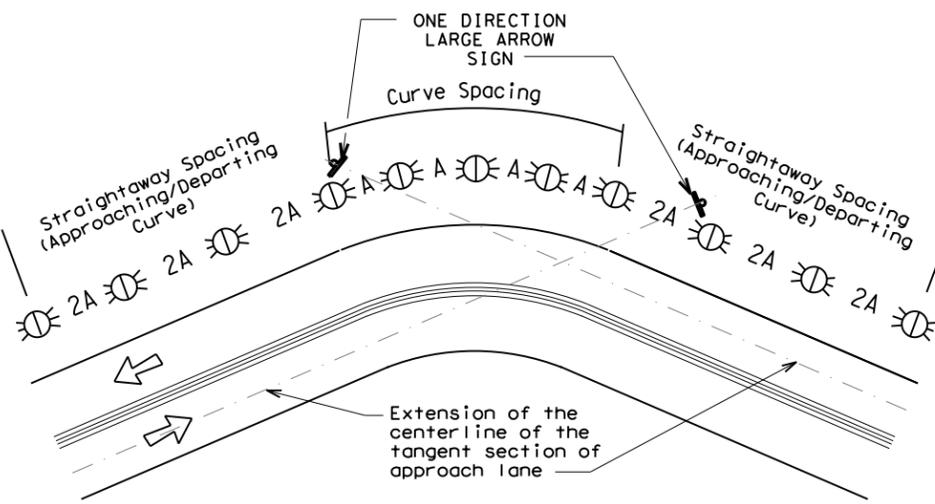

NOTE

ONE DIRECTION LARGE ARROW (W1-6) sign should be located at approximately and perpendicular to the extension of the centerline of the tangent section of approach lane.

SUGGESTED SPACING FOR CHEVRONS ON HORIZONTAL CURVES

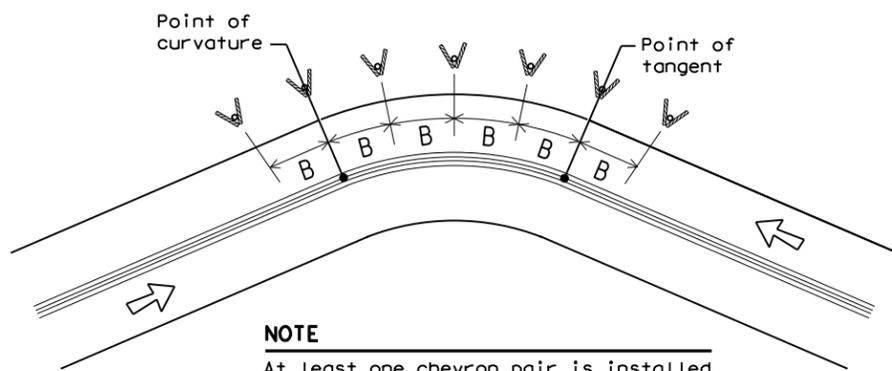

NOTE

At least one chevron pair is installed beyond the point of tangent in tangent section.

DELINEATOR AND CHEVRON SPACING

WHEN DEGREE OF CURVE OR RADIUS IS KNOWN				
Degree of Curve	FEET			
	Radius of Curve	Spacing in Curve	Spacing in Straightaway	Chevron Spacing in Curve
		A	2A	B
1	5730	225	450	—
2	2865	160	320	—
3	1910	130	260	200
4	1433	110	220	160
5	1146	100	200	160
6	955	90	180	160
7	819	85	170	160
8	716	75	150	160
9	637	75	150	120
10	573	70	140	120
11	521	65	130	120
12	478	60	120	120
13	441	60	120	120
14	409	55	110	80
15	382	55	110	80
16	358	55	110	80
19	302	50	100	80
23	249	40	80	80
29	198	35	70	40
38	151	30	60	40
57	101	20	40	40

Curve delineator approach and departure spacing should include 3 delineators spaced at 2A. This spacing should be used during design preparation or when the degree of curve is known.

DELINEATOR AND CHEVRON SPACING

WHEN DEGREE OF CURVE OR RADIUS IS NOT KNOWN			
Advisory Speed (MPH)	Spacing in Curve	Spacing in Straightaway	Chevron Spacing in Curve
	A	2xA	B
65	130	260	200
60	110	220	160
55	100	200	160
50	85	170	160
45	75	150	120
40	70	140	120
35	60	120	120
30	55	110	80
25	50	100	80
20	40	80	80
15	35	70	40

If the degree of curve is not known, delineator spacing may be determined based on the Advisory Speed of the curve. Use the delineator curve spacing for each Advisory Speed (MPH).

DELINEATOR AND OBJECT MARKER APPLICATION AND SPACING

CONDITION	REQUIRED TREATMENT	MINIMUM SPACING
Frwy./Exp. Tangent	RPMs	See PM-series and FPM-series standard sheets
Frwy./Exp. Curve	Single delineators on right side	See delineator spacing table
Frwy/Exp. Ramp	Single delineators on at least one side of ramp (should be on outside of curves) (see Detail 3 on D&OM(4))	100 feet on ramp tangents Use delineator spacing table for ramp curves ("straightway spacing" does not apply to ramp curves)
Acceleration/Deceleration Lane	Double delineators (see Detail 3 on D&OM(4))	100 feet (See Detail 3 on D & OM (4))
Truck Escape Ramp	Single red delineators on both sides	50 feet
Bridge Rail (steel or concrete) and Metal Beam Guard Fence	Bi-Directional Delineators when undivided with one lane each direction Single Delineators when multiple lanes each direction	Equal spacing (100' max) but not less than 3 delineators
Concrete Traffic Barrier (CTB) or Steel Traffic Barrier	Barrier reflectors matching the color of the edge line	Equal spacing 100' max
Cable Barrier	Reflectors matching the color of the edge line	Every 5th cable barrier post (up to 100' max)
Guard Rail Terminus/Impact Head	Divided highway - Object marker on approach end Undivided 2-lane highways - Object marker on approach and departure end	Requires reflective sheeting provided by manufacturer per D & OM (VIA) or a Type 3 Object Marker (OM-3) in front of the terminal end See D & OM (5) and D & OM (6)
Bridges with no Approach Rail	Type 3 Object Marker (OM-3) at end of rail and 3 single delineators approaching rail	See D & OM(5)
Reduced Width Approaches to Bridge Rail	Type 2 and Type 3 Object Markers (OM-3) and 3 single delineators approaching bridge	Requires reflective sheeting provided by manufacturer per D & OM (VIA) or a Type 3 Object Marker (OM-3) in front of the terminal end See D & OM (5)
Culverts without MBGF	Type 2 Object Markers	See Detail 2 on D & OM(4)
Crossovers	Double yellow delineators and RPMs	See Detail 1 on D & OM (4)
Pavement Narrowing (lane merge) on Freeways/Expressway	Single delineators adjacent to affected lane for full length of transition	100 feet

NOTES

- Unless indicated otherwise, the delineator or barrier reflector color shall conform to the color of the pavement edge line on the side of the road where the delineators or barrier reflectors are placed.
- Barrier reflectors may be used to replace required delineators.
- Single red delineators may be mounted on the back side of delineator posts for wrong way driver applications

LEGEND	
	Bi-directional Delineator
	Delineator
	Sign


Traffic Safety Division Standard

DELINEATOR & OBJECT MARKER PLACEMENT DETAILS

D & OM(3)-20

FILE: dom3-20.dgn	DW: TxDOT	CK: TxDOT	OW: TxDOT	CR: TxDOT
© TxDOT August 2004	CONT	SECT	JOB	HIGHWAY
REVISIONS		0169 07	053, ETC	US60
3-15 8-15	DIST	COUNTY	SHEET NO.	
8-15 7-20	AMA	GRAY	231	


**TWO-WAY, TWO LANE ROADWAY
WITH REDUCED WIDTH APPROACH RAIL**

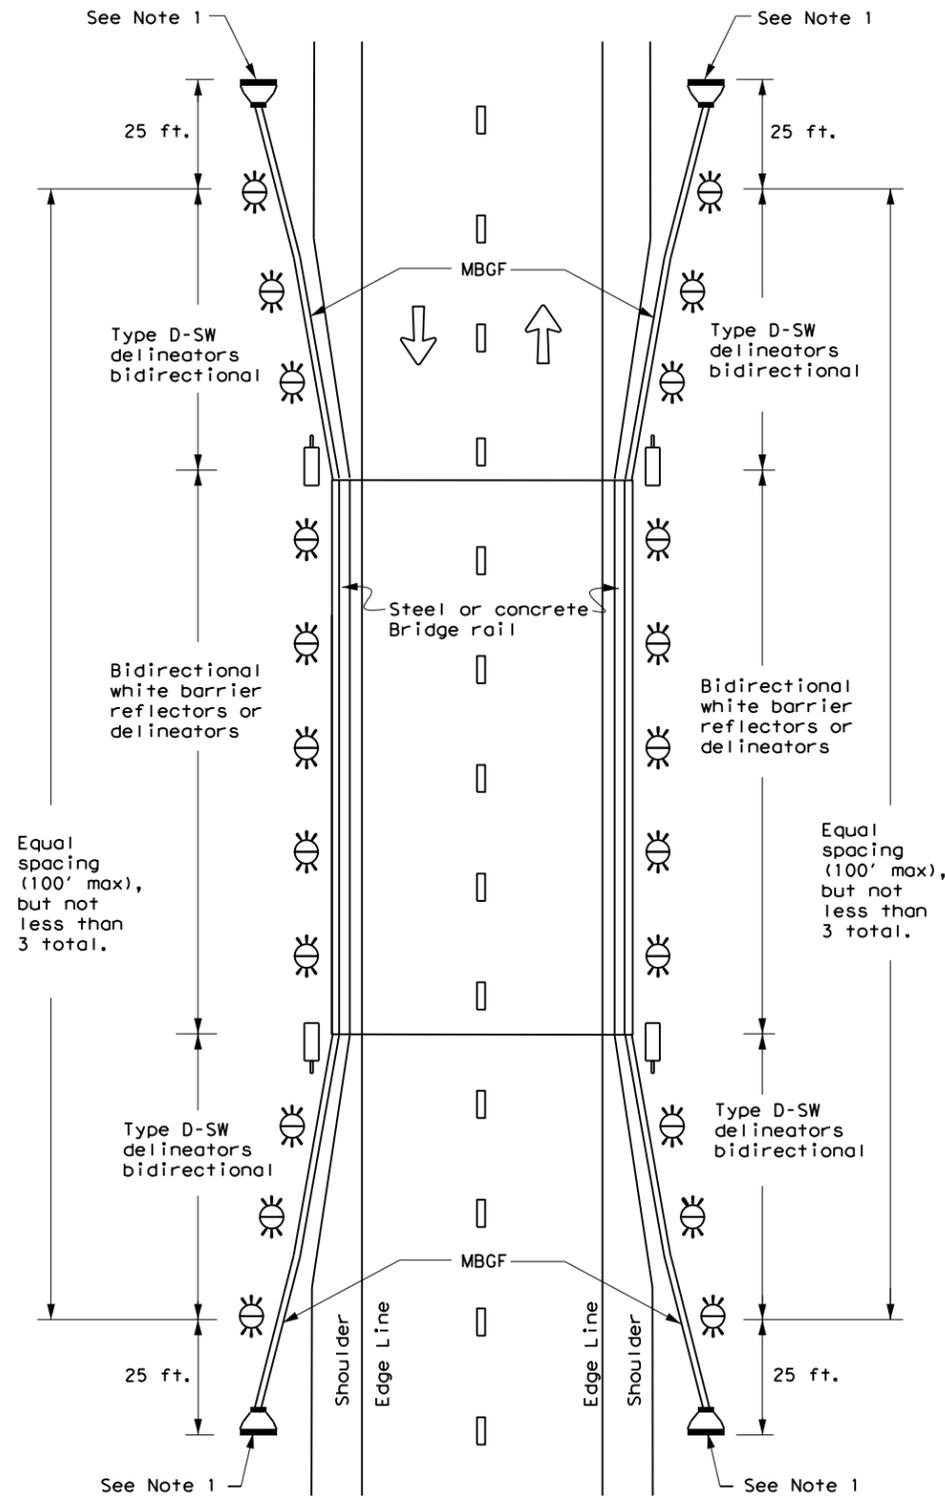

NOTE:

1. Terminal ends require reflective sheeting provided by manufacturer per D & OM (VIA) or a Type 3 Object Marker (OM-3) in front of the terminal end.


**TWO-WAY, TWO LANE ROADWAY
WITH METAL BEAM GUARD FENCE (MBGF)**

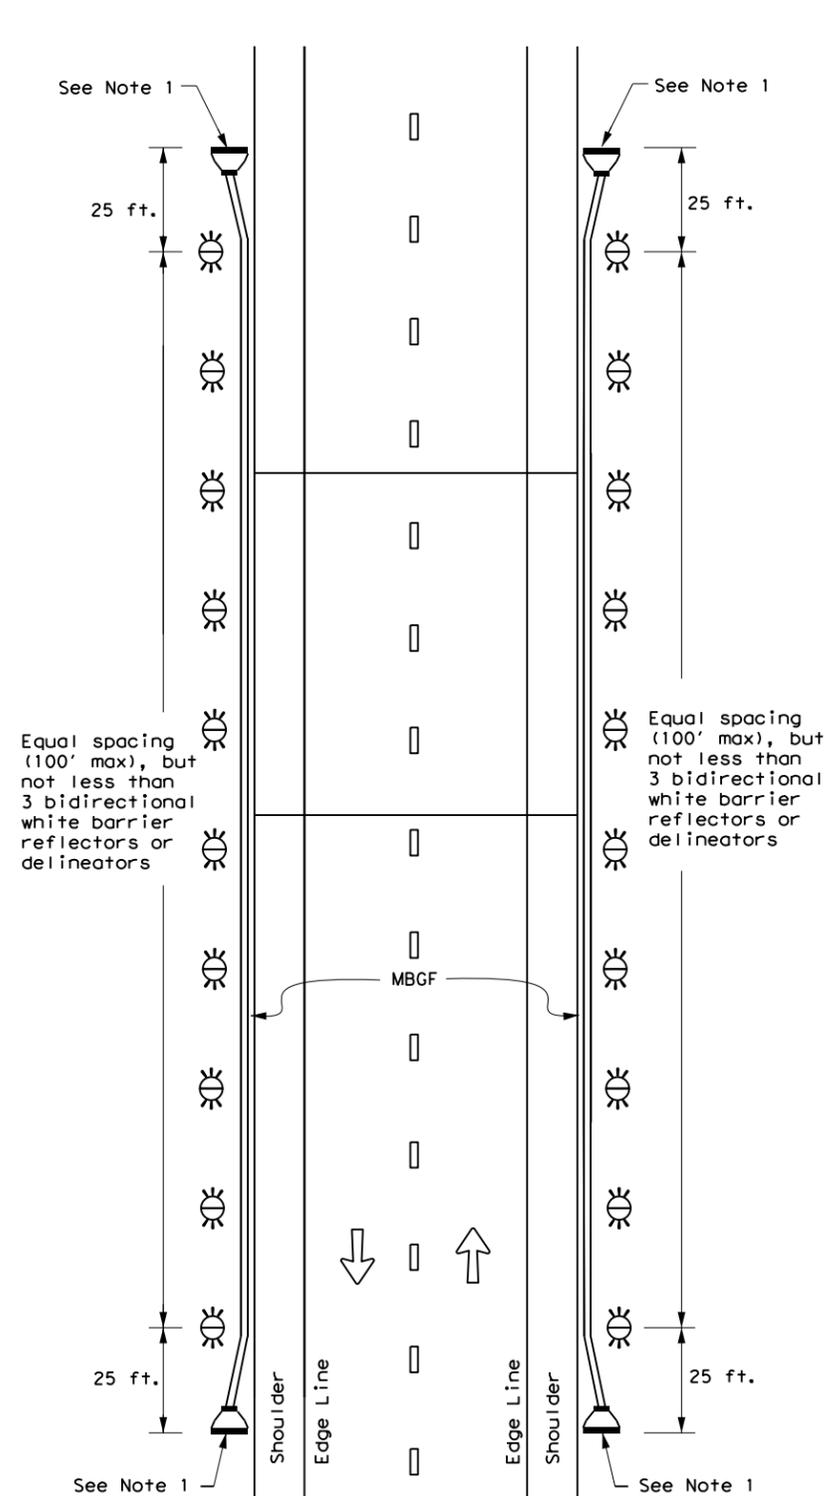

NOTE:

1. Terminal ends require reflective sheeting provided by manufacturer per D & OM (VIA) or a Type 3 Object Marker (OM-3) in front of the terminal end.

**TWO-WAY, TWO LANE ROADWAY
BRIDGE WITH NO APPROACH RAIL**

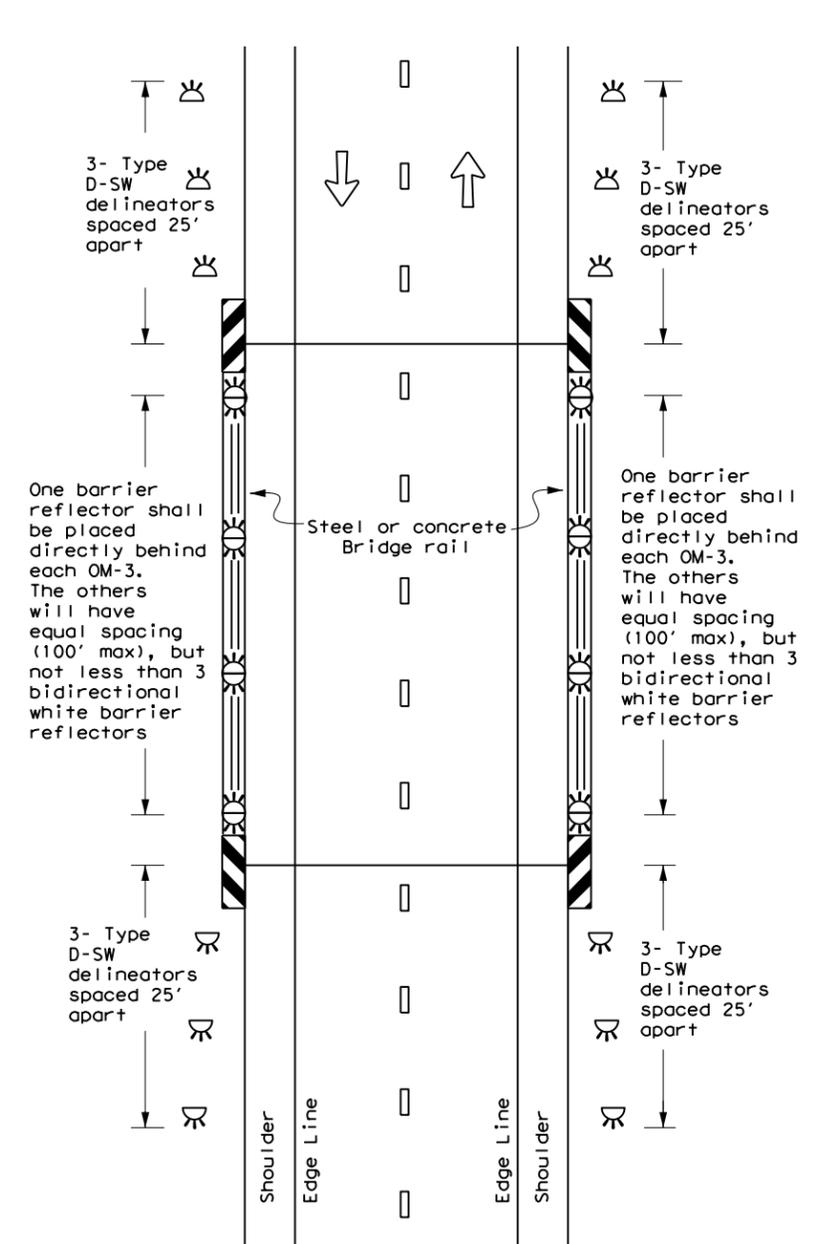

LEGEND

	Bidirectional Delineator
	Delineator
	OM-3
	OM-2
	Terminal End
	Traffic Flow



**DELINEATOR &
OBJECT MARKER
PLACEMENT DETAILS**

D & OM(5) - 20








FILE: dom5-20.dgn	DN: TxDOT	CK: TxDOT	DW: TxDOT	CR: TxDOT
© TxDOT August 2015	CONT	SECT	JOB	HIGHWAY
REVISIONS	0169	07	053, ETC	US60
7-20	DIST	COUNTY	SHEET NO.	
	AMA	GRAY	233	

DISCLAIMER: The use of this standard is governed by the "Texas Engineering Practice Act". No warranty of any kind is made by TxDOT for any purpose whatsoever. TxDOT assumes no responsibility for the conversion of any standard or specification to a different standard or specification.


DATE: 4/7/2021 7:28:27 AM
 FILE: F:\Projects\2019\11004.TxDOT_5x5_PS&E\03_US60_Amarillo\ENG\500-USTN\509-11004-055-000.dwg

DISCLAIMER: The use of this standard is governed by the "Texas Engineering Practice Act". No warranty of any kind is made by TxDOT for any purpose whatsoever. TxDOT assumes no responsibility for the conversion of units or for any errors or omissions in this standard or for any damages resulting from its use.

DATE: 4/7/2021 7:28:27 AM
 FILE: F:\Projects\2019\11004.TxDOT_5x5_PS&E\03_US60_Amarillo\ENG\500-USTN\509-11-19-2019\509-11-19-2019.dwg

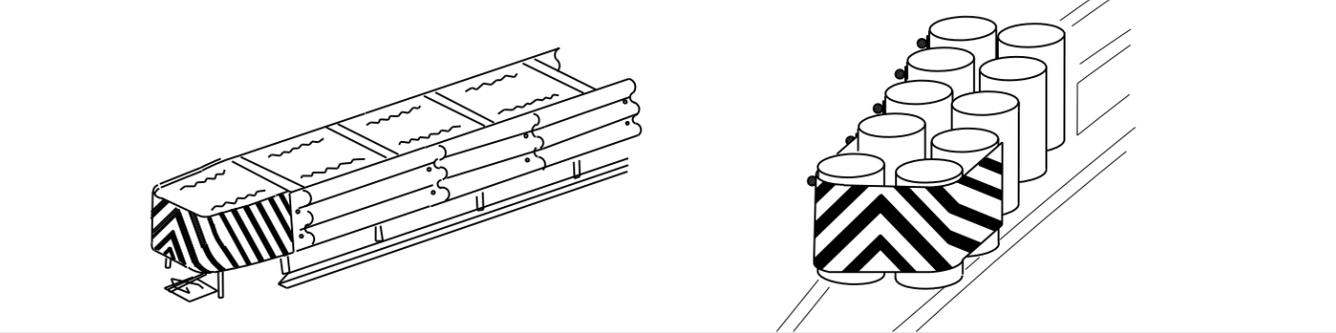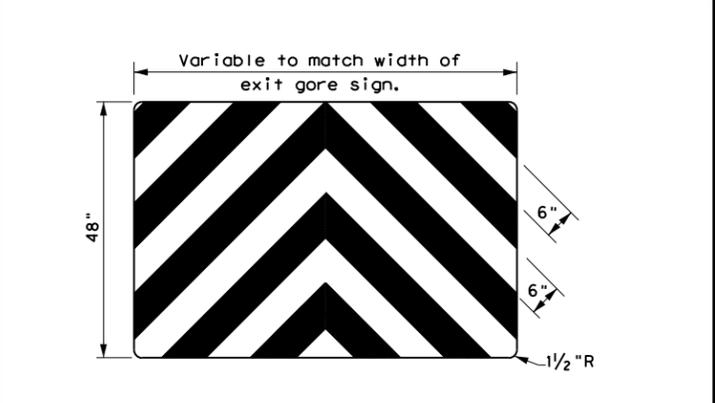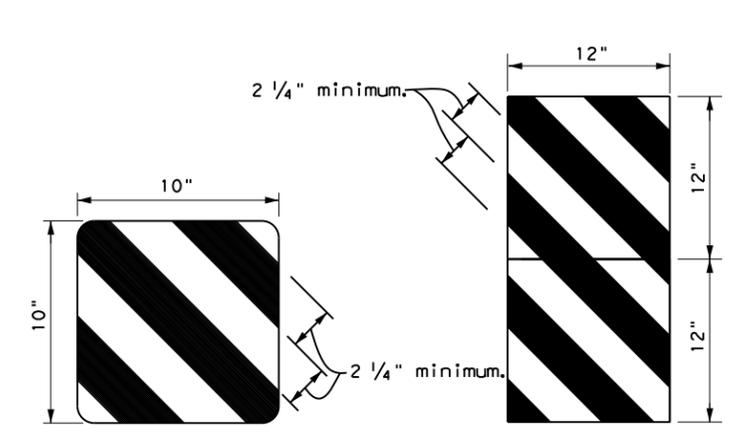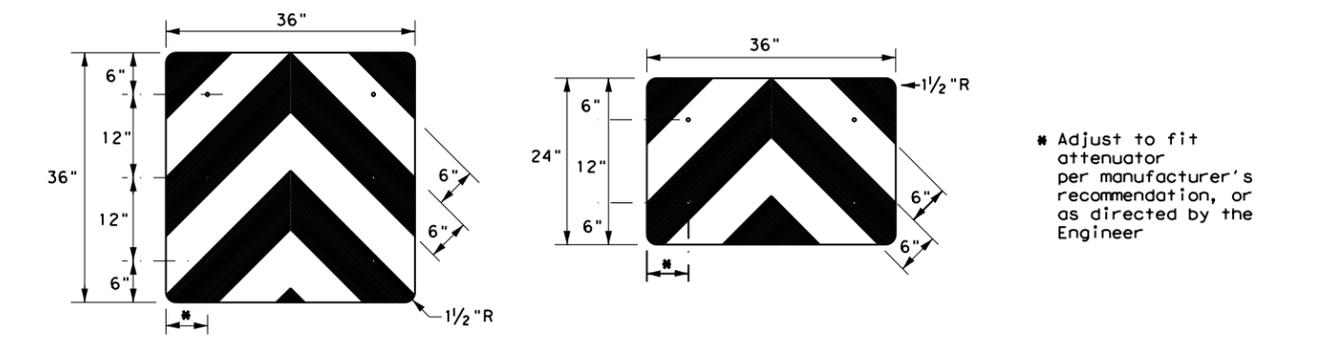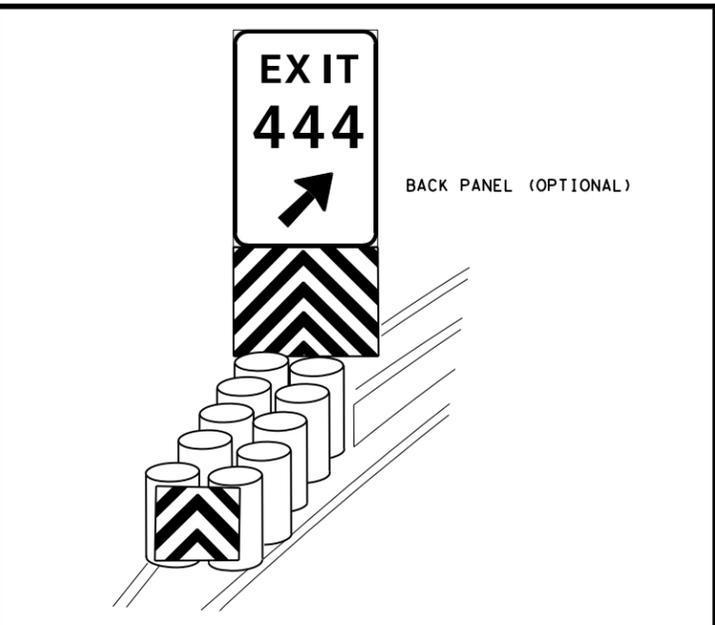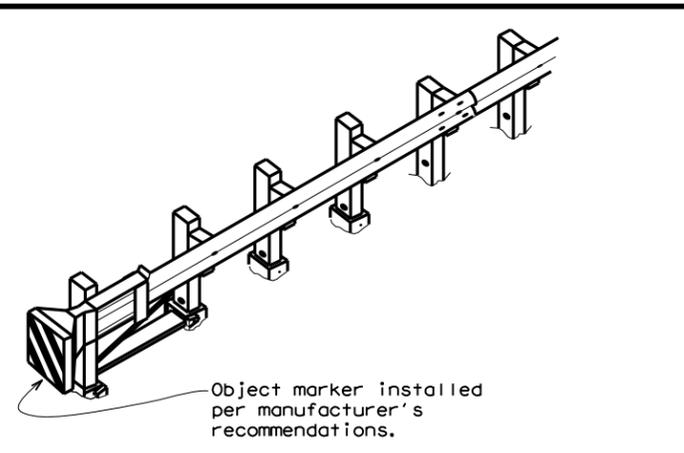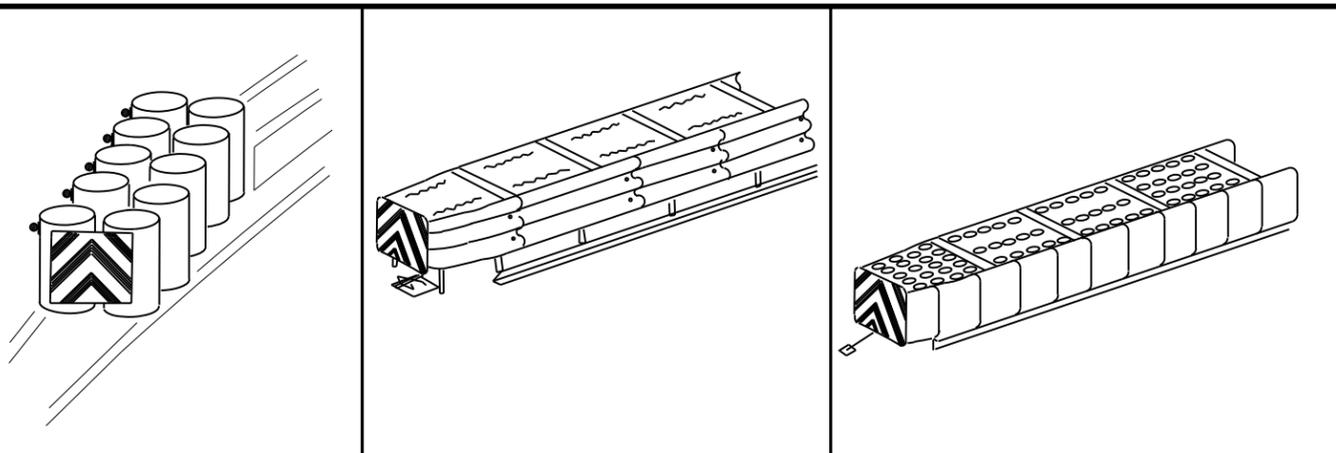

OBJECT MARKERS SMALLER THAN 3 FT²

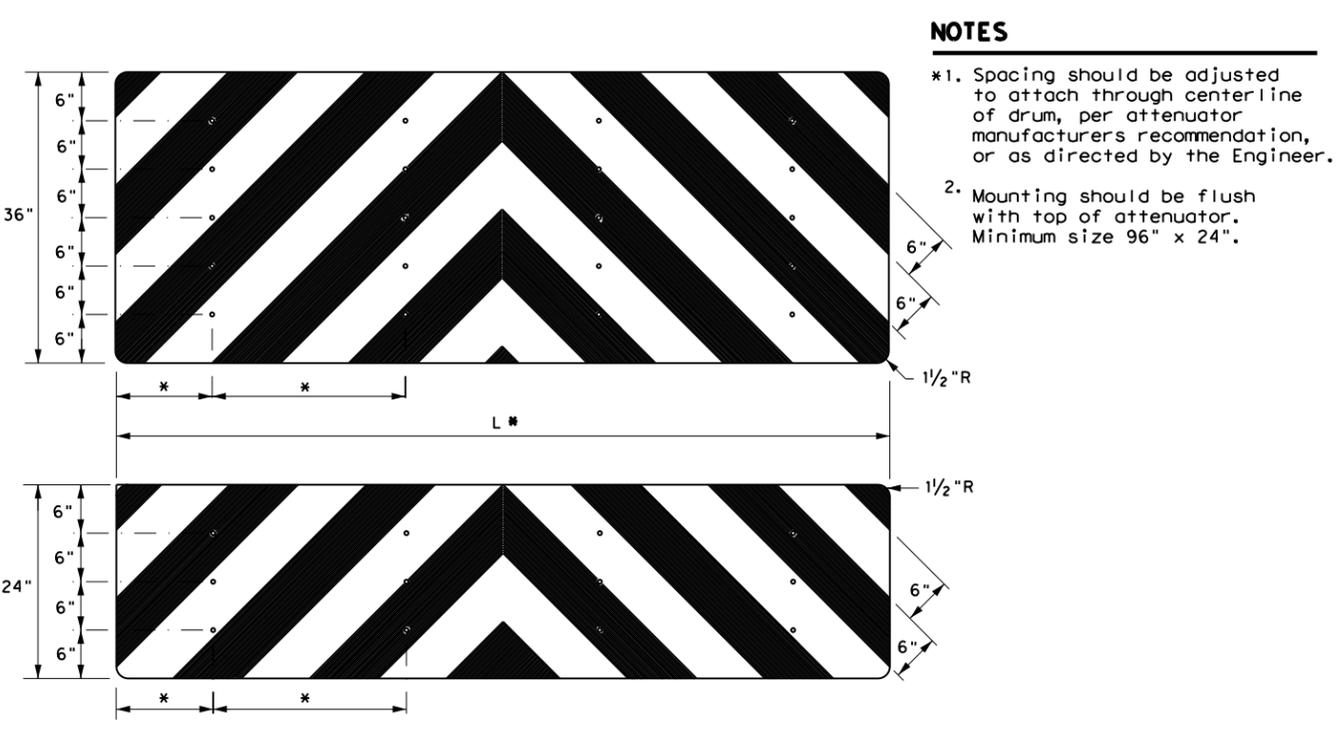

- NOTES**
- Spacing should be adjusted to attach through centerline of drum, per attenuator manufacturer's recommendation, or as directed by the Engineer.
 - Mounting should be flush with top of attenuator. Minimum size 96" x 24".


NOTES

- Object Markers shall conform to the Texas MUTCD and meet the color and reflectivity requirement of Department Material Specification DMS 8300. Background shall be yellow reflective sheeting (Type B or C) and Chevron shall be black.
- Object Markers may be fabricated from adhesive backed reflective sheeting applied directly to guardrail end treatment, or applied directly to an "end cap" as per the manufacturer's recommendation. Direct applied sheeting shall provide a smooth surface and have no wrinkles, air bubbles, cuts or tears. A radius at the corners is not required for direct applied sheeting.
- Object Marker size may be reduced to fit smaller devices. Width of alternating black and yellow stripes are typically 6". Object Markers smaller than 3ft may have reduced width stripes of a minimum of 2 1/4".
- Pop rivets, screws, or nuts and bolts may be used to attach object markers and reflectors. Holes, slots or other openings may be cut or drilled through object markers to allow cable or other attachments.
- Object Marker at nose of attenuator is subsidiary to the attenuator.
- See D & OM (1-4) for required barrier reflectors.


<p>DELINEATOR & OBJECT MARKER FOR VEHICLE IMPACT ATTENUATORS</p> <p>D & OM(VIA) -20</p>			
FILE: domvia20.dgn	DN: TxDOT	CK: TxDOT	DW: TxDOT
© TxDOT December 1989	CONT	SECT	JOB
REVISIONS	0169	07	053, ETC
4-92 8-04	DIST	COUNTY	SHEET NO.
8-95 3-15	AMA	GRAY	234
4-98 7-20			
20G			

REFLECTIVE RAISED PAVEMENT MARKERS FOR VEHICLE POSITIONING GUIDANCE



DISCLAIMER: The use of this standard is governed by the "Texas Engineering Practice Act". No warranty of any kind is made by TxDOT for any purpose whatsoever. TxDOT assumes no responsibility for the conversion of units or for the use of this standard in any project. TxDOT is not responsible for incorrect results or damages resulting from its use.
 DATE: 4/7/2021 7:28:28 AM
 FILE: F:\Projects\2019\11004.TxDOT_5x5_P&E\03_US60_Amarillo\ENG\500-USTN\509-11-19-2019\030909.dwg

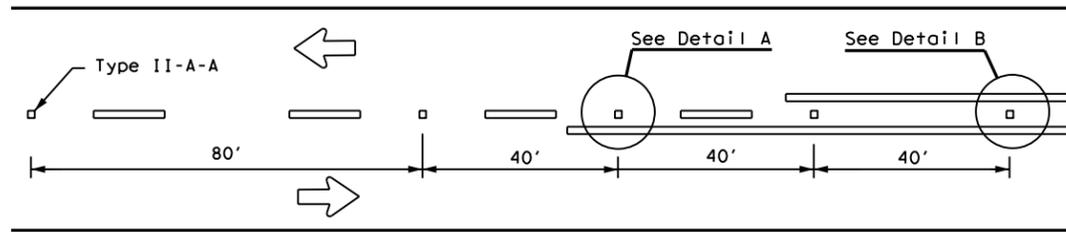


CENTERLINE FOR ALL TWO LANE ROADWAYS

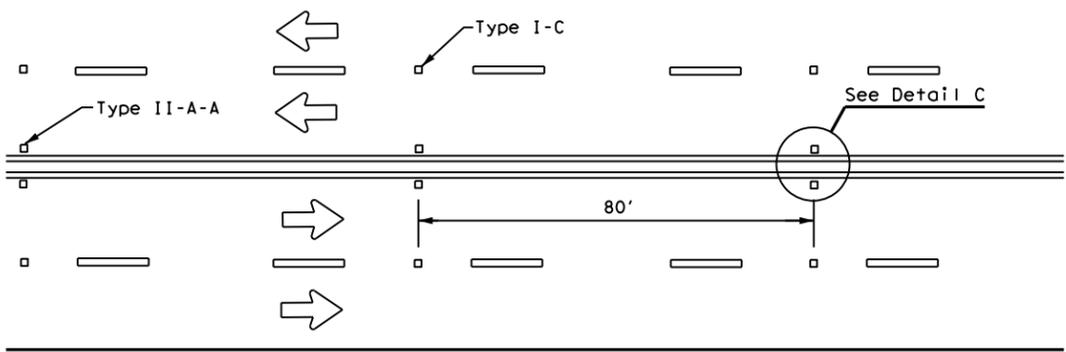

**CENTERLINE & LANE LINES
FOR FOUR LANE TWO-WAY HIGHWAYS**

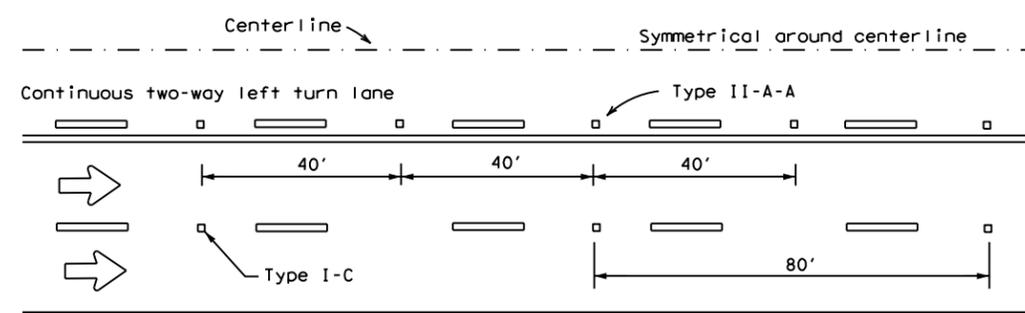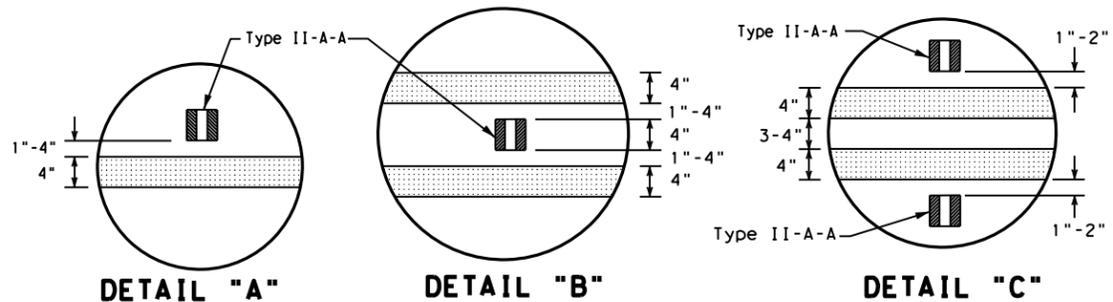

CENTERLINE AND LANE LINES FOR TWO-WAY LEFT TURN LANE

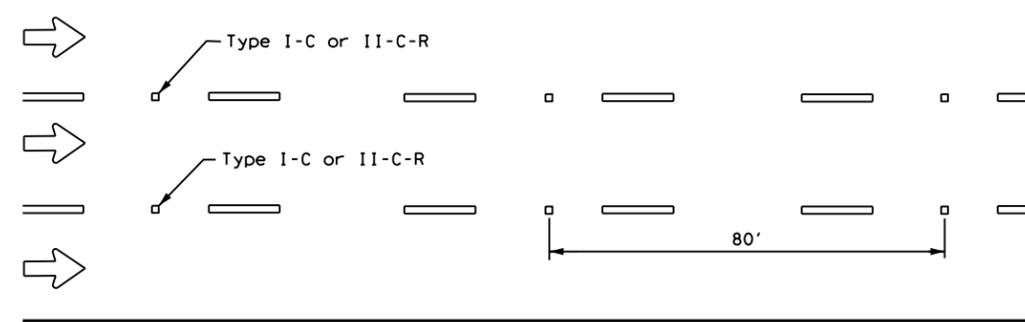


LANE LINES FOR ONE-WAY ROADWAY (NON-FREEWAY FACILITIES)


Raised pavement markers Type II-C-R shall have clear face toward normal traffic and red face toward wrong-way traffic.

MATERIAL SPECIFICATIONS	
PAVEMENT MARKERS (REFLECTORIZED)	DMS-4200
EPOXY AND ADHESIVES	DMS-6100
BITUMINOUS ADHESIVE FOR PAVEMENT MARKERS	DMS-6130
TRAFFIC PAINT	DMS-8200
HOT APPLIED THERMOPLASTIC	DMS-8220
PERMANENT PREFABRICATED PAVEMENT MARKINGS	DMS-8240


All pavement marking materials shall meet the required Departmental Material Specifications as specified by the plans.

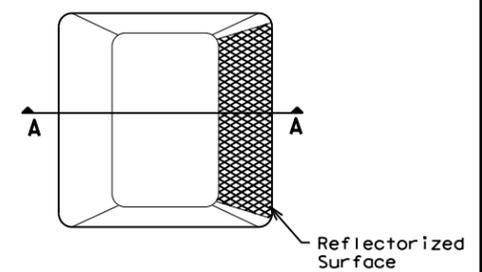

Type I (Top View)

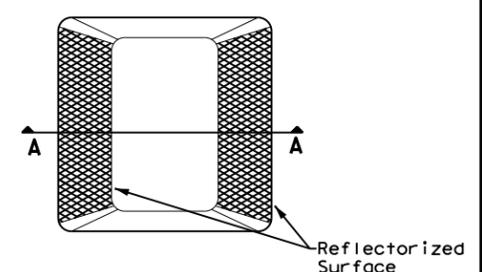


Type II (Top View)

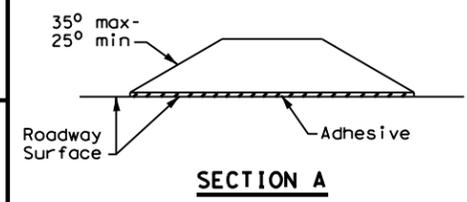


RAISED PAVEMENT MARKERS

GENERAL NOTES

- All raised pavement markers placed in broken lines shall be placed in line with and midway between the stripes.
- On concrete pavements the raised pavement markers should be placed to one side of the longitudinal joints.

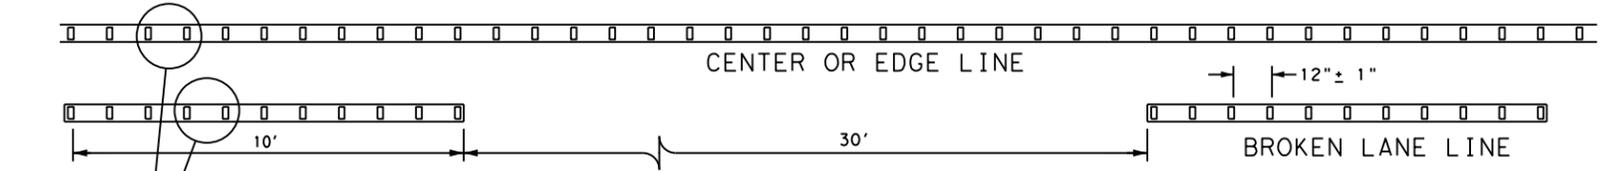

**REFLECTORIZED PROFILE
PATTERN DETAIL
USING REFLECTIVE PROFILE PAVEMENT MARKINGS**

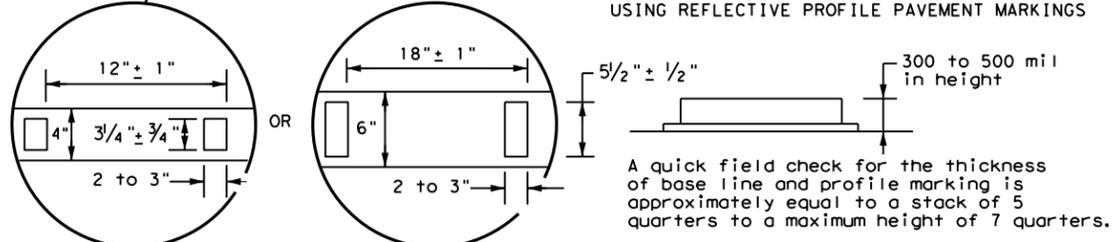

NOTE
Profile markings shall not be placed on roadways with a posted speed limit of 45 MPH or less.



POSITION GUIDANCE USING RAISED MARKERS REFLECTORIZED PROFILE MARKINGS PM(2) - 20

FILE: pm2-20.dgn	DN:	CK:	DW:	CK:
© TxDOT April 1977	CONT	SECT	JOB	HIGHWAY
4-92 2-10	0169	07	053, ETC	US60
5-00 2-12	DIST	COUNTY	SHEET NO.	
8-00 6-20	AMA	GRAY	236	

DISCLAIMER: The use of this standard is governed by the "Texas Engineering Practice Act". No warranty of any kind is made by TxDOT for any purpose whatsoever. TxDOT assumes no responsibility for the conversion of this standard to other formats or for incorrect results or damages resulting from its use.

DATE: 4/7/2021 7:28:29 AM
 FILE: F:\Projects\2019\11004.TxDOT\5x5*PS&E\03.US60*Amari\110.ENG\500-USTN\509-Traffic\05-Standard.smdgen.dgn

SIGN SUPPORT DESCRIPTIVE CODES

(Descriptive Codes correspond to project estimate and quantities sheets)

SM RD SGN ASSM TY XXXXX(X)XX(X-XXXX)

Post Type

FRP = Fiberglass Reinforced Plastic Pipe (see SMD(FRP))
 TWT = Thin-Walled Tubing (see SMD(TWT))
 10BWG = 10 BWG Tubing (see SMD(SLIP-1) to (SLIP-3))
 S80 = Schedule 80 Pipe (see SMD(SLIP-1) to (SLIP-3))

Number of Posts (1 or 2)


Anchor Type

UA = Universal Anchor - Concreted (see SMD(FRP) and (TWT))
 UB = Universal Anchor - Bolted down (see SMD(FRP) and (TWT))
 WS = Wedge Anchor Steel - (see SMD(TWT))
 WP = Wedge Anchor Plastic (see SMD(TWT))
 SA = Slipbase - Concreted (see SMD(SLIP-1) to (SLIP-3))
 SB = Slipbase - Bolted Down (see SMD(SLIP-1) to (SLIP-3))

Sign Mounting Designation



P = Prefab. "Plain" (see SMD(SLIP-1) to (SLIP-3), (TWT), (FRP))
 T = Prefab. "T" (see SMD(SLIP-1) to (SLIP-3), (TWT))
 U = Prefab. "U" (see SMD(SLIP-1) to (SLIP-3))
 IF REQUIRED
 1EXT or 2EXT = Number of Extensions (see SMD(SLIP-1) to (SLIP-3), (TWT))
 BM = Extruded Wind Beam (see SMD(SLIP-1) to (SLIP-3))
 WC = 1.12 #/ft Wing Channel (see SMD(SLIP-1) to (SLIP-3))
 EXAL = Extruded Aluminum Sign Panels (see SMD(SLIP-3))

REQUIRED CLEARANCE FOR BREAKAWAY SUPPORT



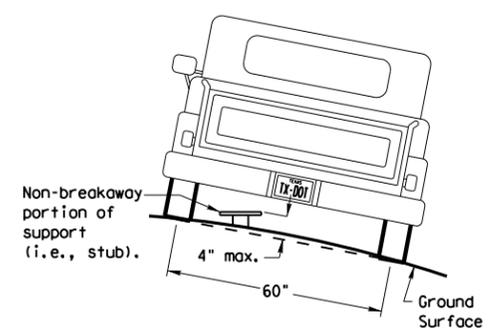


To avoid vehicle undercarriage snagging, any substantial remains of a breakaway support, when it is broken away, should not project more than 4 inches above a 60-inch chord (i.e., typical space between wheel paths).


SIGN LOCATION

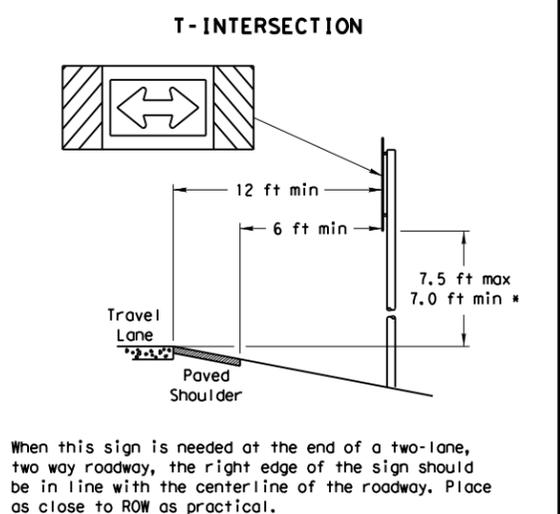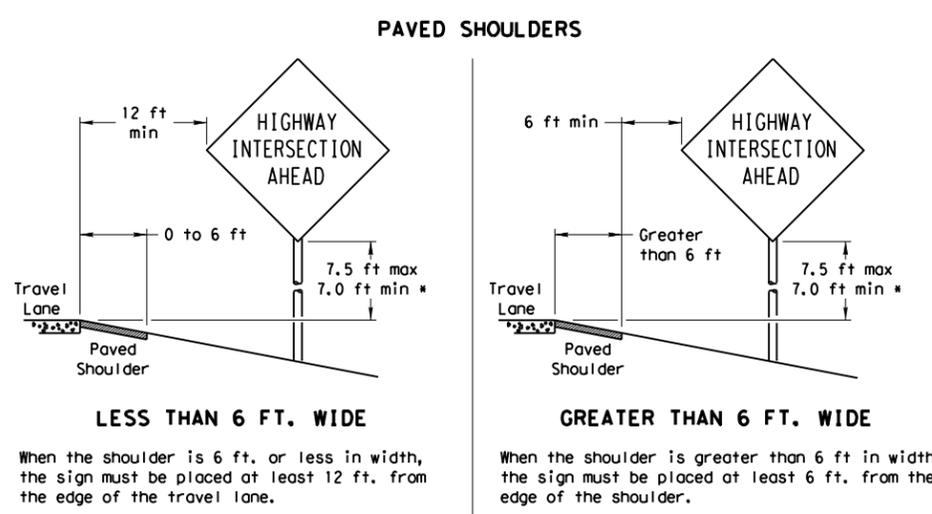

No more than 2 sign posts should be located within a 7 ft. circle.

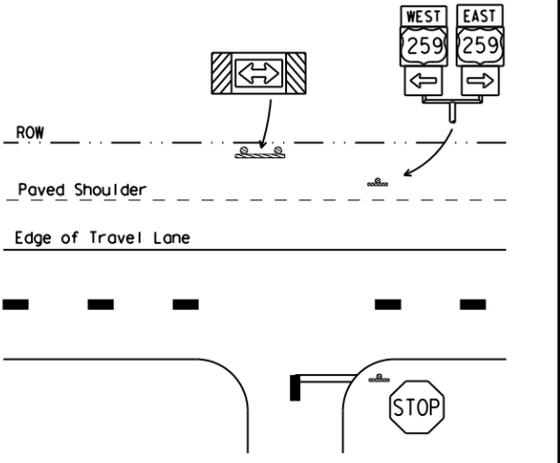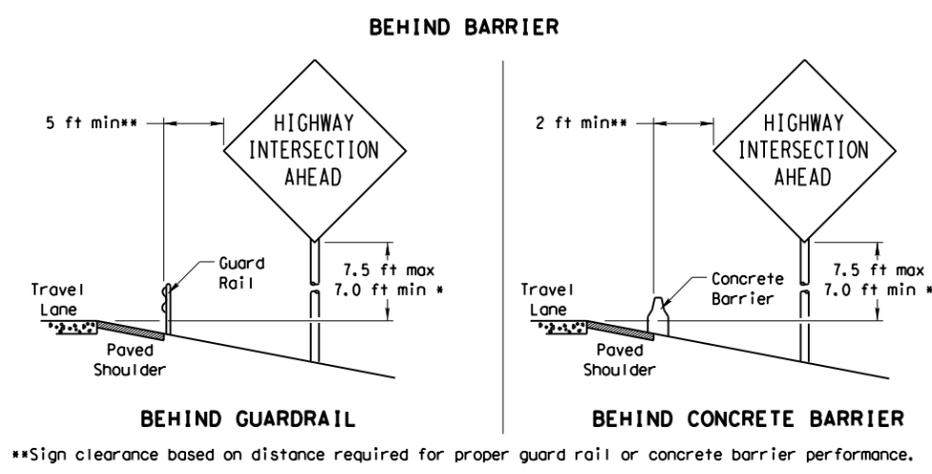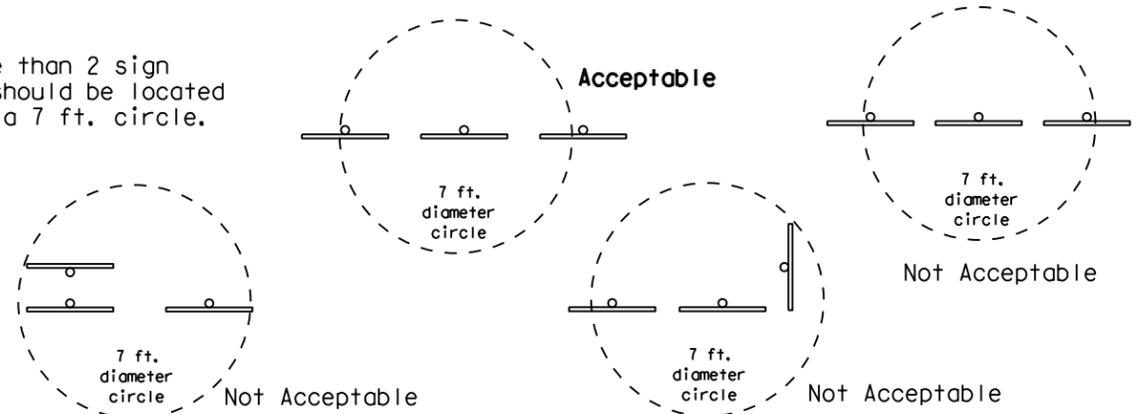

TYPICAL SIGN ATTACHMENT DETAIL

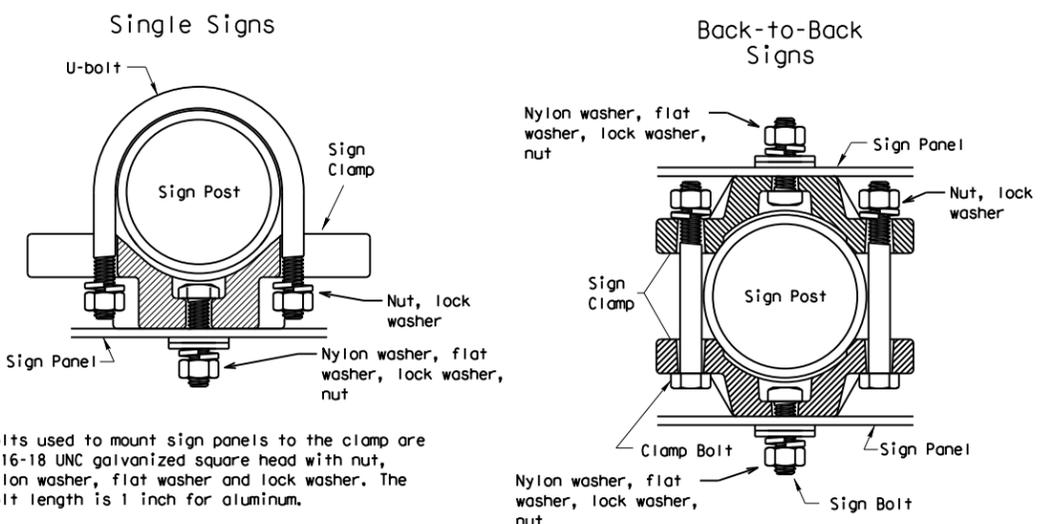


Bolts used to mount sign panels to the clamp are 5/16-18 UNC galvanized square head with nut, nylon washer, flat washer and lock washer. The bolt length is 1 inch for aluminum.

When two sign clamps are used to mount signs back-to-back, use a 5/16-18 UNC galvanized hex head per ASTM A307 with nut and helical-spring lock washer. The approximate bolt lengths for various post sizes and sign clamp types are given in the table at right. The bolt length may need to be adjusted depending upon field conditions.


Sign clamps may be either the specific size clamp or the universal clamp.

Pipe Diameter	Approximate Bolt Length	
	Specific Clamp	Universal Clamp
2" nominal	3"	3 or 3 1/2"
2 1/2" nominal	3 or 3 1/2"	3 1/2 or 4"
3" nominal	3 1/2 or 4"	4 1/2"


SIGNS WITH PLAQUES

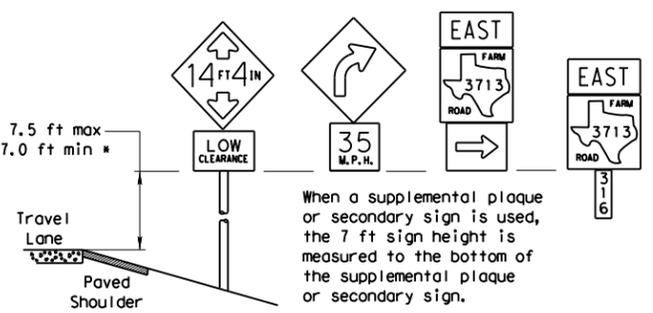

CURB & GUTTER OR RAISED ISLAND

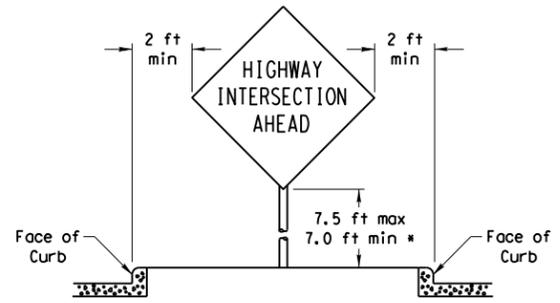

RESTRICTED RIGHT-OF-WAY (When 6 ft min. is not possible.)

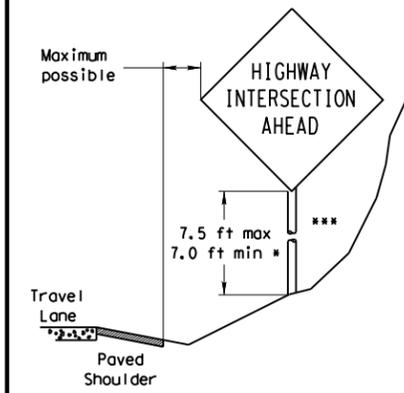

Right-of-way restrictions may be created by rocks, water, vegetation, forest, buildings, a narrow island, or other factors.

In situations where a lateral restriction prevents the minimum horizontal clearance from the edge of the travel lane, signs should be placed as far from the travel lane as practical.

*** Post may be shorter if protected by guardrail or if Engineer determines the post could not be hit due to extreme slope.

- * Signs shall be mounted using the following condition that results in the greatest sign elevation:
- (1) a minimum of 7 to a maximum of 7.5 feet above the edge of the travel lane or
 - (2) a minimum of 7 to a maximum of 7.5 feet above the grade at the base of the support when sign is installed on the backslope.
- The maximum values may be increased when directed by the Engineer.
- See the Traffic Operations Division website for detailed drawings of sign clamps, Triangular Slipbase System components and Wedge Anchor System components.
- The website address is:
<http://www.txdot.gov/publications/traffic.htm>




SIGN MOUNTING DETAILS SMALL ROADSIDE SIGNS GENERAL NOTES & DETAILS SMD (GEN) - 08

© TxDOT July 2002		DN: TxDOT	CK: TxDOT	DW: TxDOT	CK: TxDOT
9-08	REVISIONS	CONT	SECT	JOB	HIGHWAY
		0169	07	053, ETC	US60
		DIST	COUNTY		SHEET NO.
		AMA	GRAY		237

DISCLAIMER: The use of this standard is governed by the "Texas Engineering Practice Act". No warranty of any kind is made by TxDOT for any purpose whatsoever. TxDOT assumes no responsibility for the conversion of this standard to other formats or for incorrect results or damages resulting from its use.

DATE: 4/7/2021 7:28:30 AM
 FILE: F:\Projects\2019\11004.TxDOT\5x5*PS&E\03.US60*Amari\110\ENG\500-USTN\509-Traffic\05-Standard.smdsl.dgn

TRIANGULAR SLIPBASE INSTALLATION GENERAL REQUIREMENTS

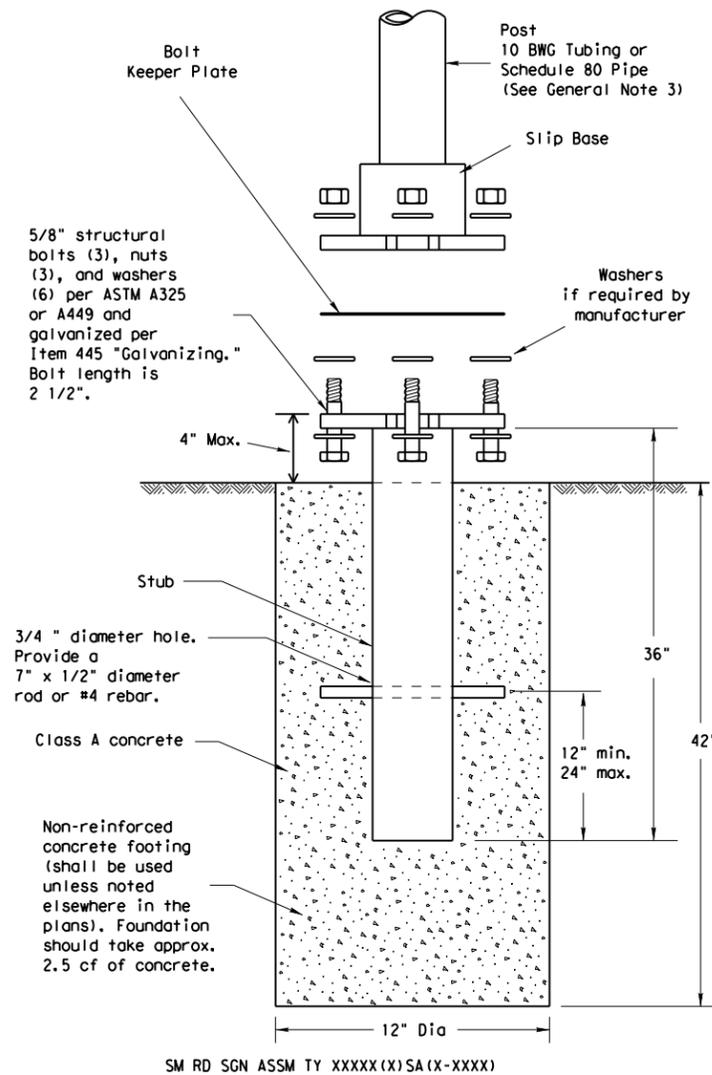

NOTE

There are various devices approved for the Triangular Slipbase System. Please reference the Material Producer List for approved slip base systems. http://www.txdot.gov/business/producer_list.htm
 The devices shall be installed per manufacturers' recommendations. Installation procedures shall be provided to the Engineer by Contractor.

GENERAL NOTES:

- Slip base shall be permanently marked to indicate manufacturer. Method, design, and location of marking are subject to approval of the TxDOT Traffic Standards Engineer.
- Material used as post with this system shall conform to the following specifications:
 - 10 BWG Tubing (2.875" outside diameter)
 - 0.134" nominal wall thickness
 - Seamless or electric-resistance welded steel tubing or pipe
 - Steel shall be HSLAS Gr 55 per ASTM A1011 or ASTM A1008
 - Other steels may be used if they meet the following:
 - 55,000 PSI minimum yield strength
 - 70,000 PSI minimum tensile strength
 - 20% minimum elongation in 2"
 - Wall thickness (uncoated) shall be within the range of 0.122" to 0.138"
 - Outside diameter (uncoated) shall be within the range of 2.867" to 2.883"
 - Galvanization per ASTM A123 or ASTM A653 G210. For precoated steel tubing (ASTM A653), recoat tube outside diameter weld seam by metallizing with zinc wire per ASTM B833.
 - Schedule 80 Pipe (2.875" outside diameter)
 - 0.276" nominal wall thickness
 - Steel tubing per ASTM A500 Gr C
 - Other seamless or electric-resistance welded steel tubing or pipe with equivalent outside diameter and wall thickness may be used if they meet the following:
 - 46,000 PSI minimum yield strength
 - 62,000 PSI minimum tensile strength
 - 21% minimum elongation in 2"
 - Wall thickness (uncoated) shall be within the range of 0.248" to 0.304"
 - Outside diameter (uncoated) shall be within the range of 2.855" to 2.895"
 - Galvanization per ASTM A123
- See the Traffic Operations Division website for detailed drawings of sign clamps and Texas Universal Triangular Slipbase System components. The website address is: <http://www.txdot.gov/publications/traffic.htm>
- Sign supports shall not be spliced except where shown. Sign support posts shall not be spliced.

ASSEMBLY PROCEDURE


Foundation

- Prepare 12-inch diameter by 42-inch deep hole. If solid rock is encountered, the depth of the foundation may be reduced such that it is embedded a minimum of 18 inches into the solid rock.
- The Engineer may permit batches of concrete less than 2 cubic yards to be mixed with a portable, motor-driven concrete mixer. For small placements less than 0.5 cubic yards, hand mixing in a suitable container may be allowed by Engineer. Concrete shall be Class A.
- Push the pipe end of the slip base stub into the center of the concrete. Rotate the stub back and forth while pushing it down into the concrete to assure good contact between the concrete and stub. Continue to work the stub into the concrete until it is between 2 to 4 inches above the ground.
- Plumb the stub. Allow a minimum of 4 days to set, unless otherwise directed by the Engineer.
- The triangular slipbase system is multidirectional and is designed to release when struck from any direction.

Support

- Cut support so that the bottom of the sign will be 7 to 7.5 feet above the edge of the travelway (i.e., edge of the closest lane) when slip plate is below the edge of pavement or 7 to 7.5 feet above slip plate when the slip plate is above the edge of the travelway. The cut shall be plumb and straight.
- Attach sign to support using connections shown. When multiple signs are installed on the same support, ensure the minimum clearance between each sign is maintained. See SMD(SLIP-2) for clearances based on sign types.

CONCRETE ANCHOR

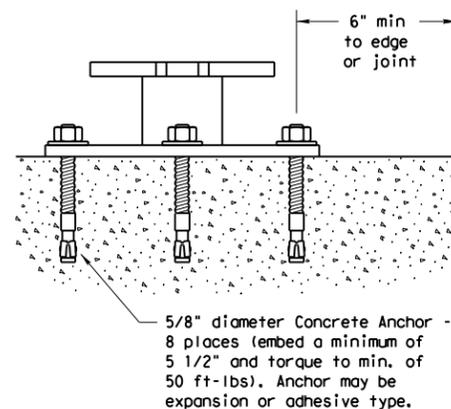

Concrete anchor consists of 5/8" diameter stud bolt with UNC series bolt threads on the upper end. Heavy hex nut per ASTM A563, and hardened washer per ASTM F436. The stud bolt shall have a minimum yield and ultimate tensile strength of 50 and 75 KSI, respectively. Nuts, bolts and washers shall be galvanized per Item 445, "Galvanizing." Adhesive type anchors shall have stud bolts installed with Type III epoxy per DMS-6100, "Epoxyes and Adhesives." Adhesive anchors may be loaded after adequate epoxy cure time per the manufacturer's recommendations. Top of bolt shall extend at least flush with top of the nut when installed. The anchor, when installed in 4000 psi normal-weight concrete with a 5 1/2" minimum embedment, shall have a minimum allowable tension and shear of 3900 and 3100 psi, respectively.





Texas Department of Transportation
 Traffic Operations Division

SIGN MOUNTING DETAILS SMALL ROADSIDE SIGNS TRIANGULAR SLIPBASE SYSTEM SMD(SLIP-1)-08










© TxDOT July 2002		DN: TxDOT	CK: TxDOT	DW: TxDOT	CK: TxDOT
9-08	REVISIONS		CONTRACT	SECTION	JOB
			0169	07	053, ETC
	DIST	COUNTY	SHEET NO.		
		AMA	GRAY		238

DISCLAIMER: The use of this standard is governed by the "Texas Engineering Practice Act". No warranty of any kind is made by TxDOT for any purpose whatsoever. TxDOT assumes no responsibility for the conversion of this standard to other formats or for incorrect results or damages resulting from its use.

DATE: 4/7/2021 7:28:30 AM
 FILE: F:\Projects\2019\11004.TxDOT\5x5*PS&E\03.US60*Amar.II\0.ENG\500-USTN\509-Traffic\05-Standard.smds2.dgn

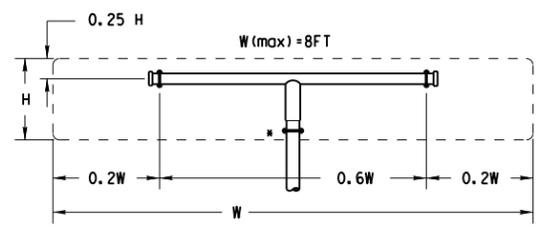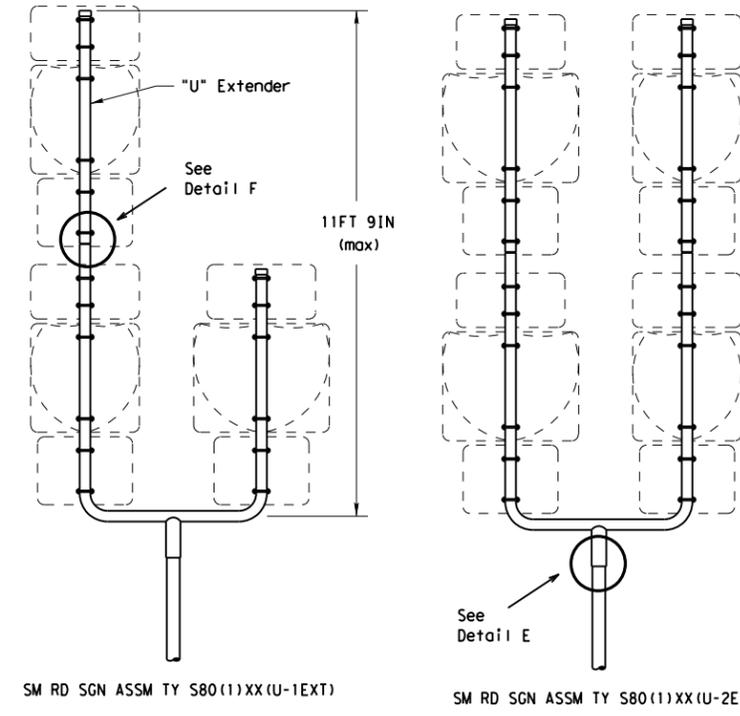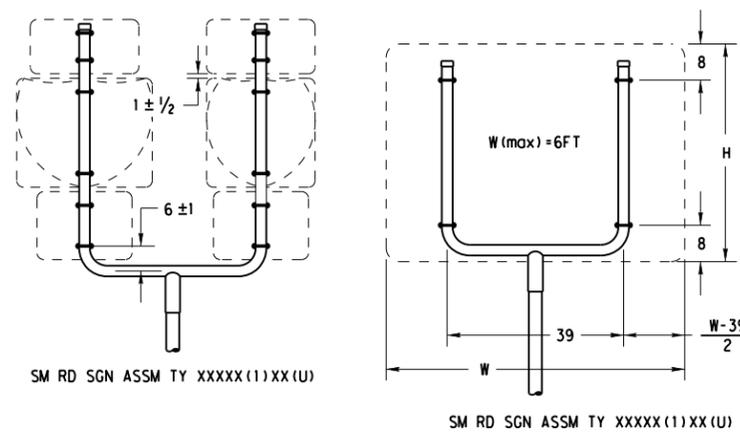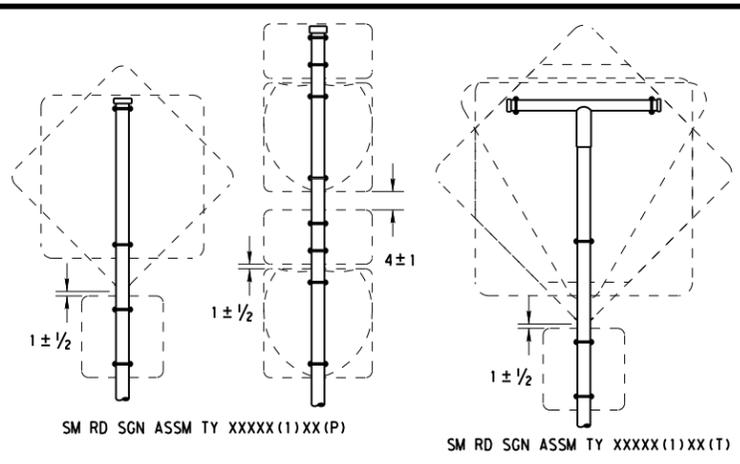

All dimensions are in english unless detailed otherwise.

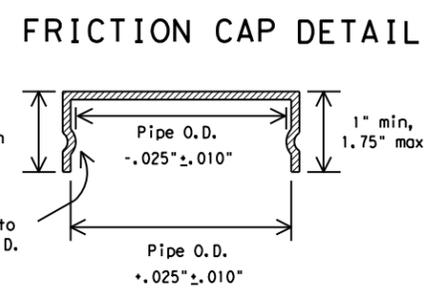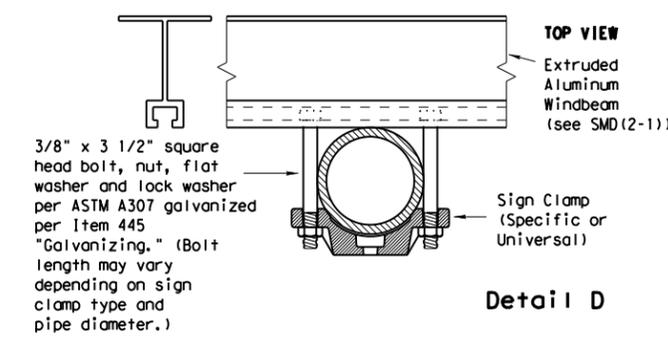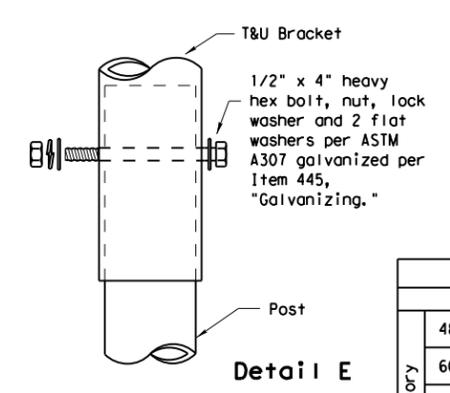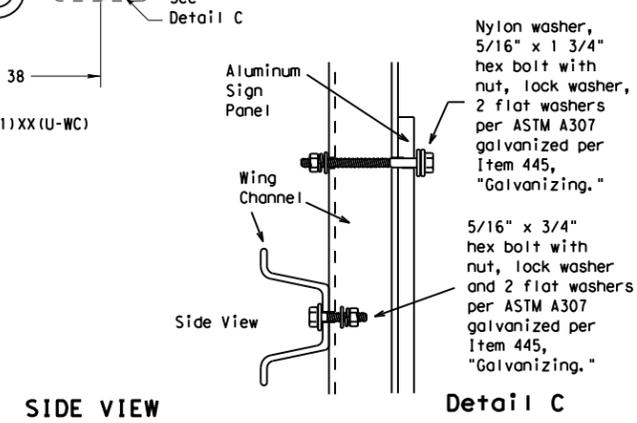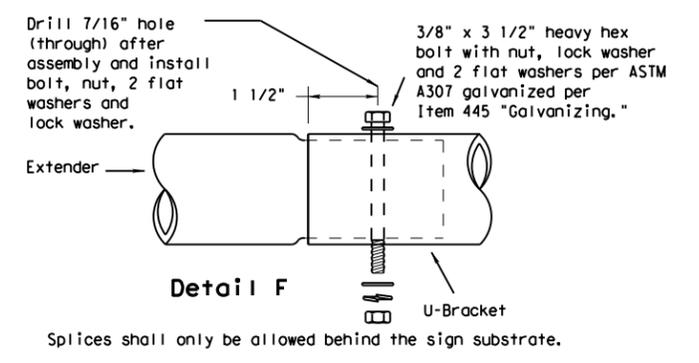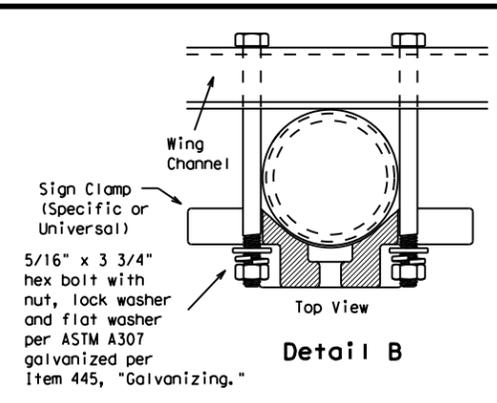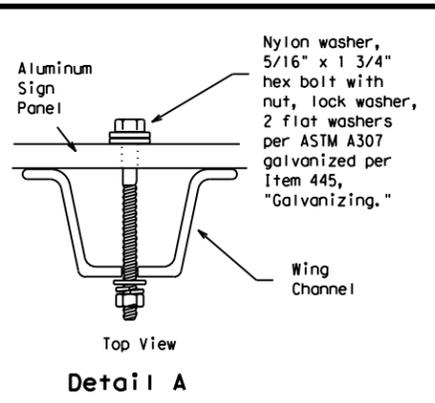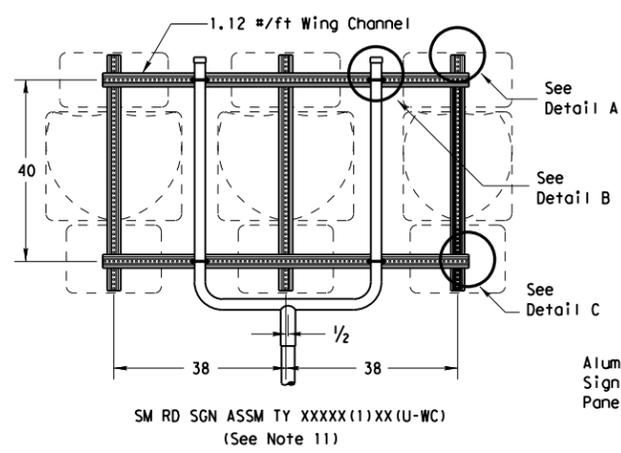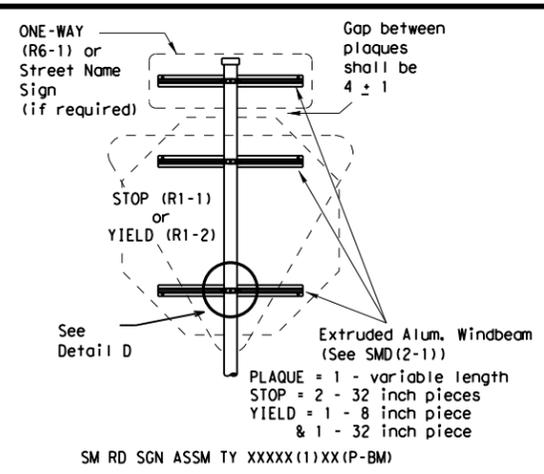

Friction caps may be manufactured from hot rolled or cold rolled steel sheets. The minimum sheet metal thickness shall be 24 gauge for all cap sizes. The rim edges shall be reasonably straight and smooth. Caps shall be sized and formed in such a manner as to produce a drive-on friction fit and have no tendency to rock when seated on the pipe. The depth shall be sufficient to give positive protection against entrance of rainwater. They shall be free of sharp creases or indentations and show no evidence of metal fracture. Caps shall have an electrodeposited coating of zinc in accordance with the requirements of ASTM B633 Class FE/ZN 8.

GENERAL NOTES:

1. SIGN SUPPORT # OF POSTS MAX. SIGN AREA

10 BWG	1	16 SF
10 BWG	2	32 SF
Sch 80	1	32 SF
Sch 80	2	64 SF
2. The Engineer may require that a Schedule 80 post be used in place of a 10 BWG where a sign height is abnormally high due to a fill slope.
3. Sign supports shall not be spliced except where shown. Sign support posts shall not be spliced.
4. Aluminum sign blanks shall conform to Departmental Material Specifications DMS-7110 and shall have the following minimum thicknesses: 0.080 for signs less than 7.5 sq. ft., 0.100 for signs 7.5 to 15 sq. ft., and 0.125 for signs greater than 15 sq. ft.
5. Signs that require specific supports due to reasons in addition to windloading are indicated on the "REQUIRED SUPPORT" table on this sheet.
6. For horizontal rectangular signs fabricated from flat aluminum, T-brackets are used for signs 24 inches or less in height. U-brackets are used for signs of greater height.
7. When two triangular slipbase supports are used to support a single sign, they shall not be "rigidly" connected to each other except through the sign panel. This will allow each support to act independently when impacted by an errant vehicle.
8. Wing channel shall meet ASTM A 1011 SS Gr 50 and be galvanized per ASTM A 123.
9. Excess pipe, wing channel, or windbeam shall be cut off so that it does not extend beyond the sign panel (i.e., excess support shall not be visible when the sign is viewed from the front.) Repair galvanized coating at cut support ends per Item 445, "Galvanizing."
10. Additional route markers may be added vertically, provided the total sign area does not exceed the maximum allowable amount per Note 1.
11. Additional sign clamp required on the "T-bracket" post for 24 inch height signs. Place the clamp 3 inches above bottom of sign when possible.
12. Post open ends shall be fitted with Friction Caps.
13. Sign blanks shall be the sizes and shapes shown on the plans.

REQUIRED SUPPORT		
	SIGN DESCRIPTION	SUPPORT
Regulatory	48-inch STOP sign (R1-1)	TY 10BWG(1)XX(T) TY 10BWG(1)XX(P-BM)
	60-inch YIELD sign (R1-2)	TY 10BWG(1)XX(T) TY 10BWG(1)XX(P-BM)
	48x16-inch ONE-WAY sign (R6-1)	TY 10BWG(1)XX(T) TY 10BWG(1)XX(P-BM)
	36x48, 48x36, and 48x48-inch signs	TY 10BWG(1)XX(T)
Warning	48x60-inch signs	TY S80(1)XX(T)
	48x48-inch signs (diamond or square)	TY 10BWG(1)XX(T)
	48x60-inch signs	TY S80(1)XX(T)
	48-inch Advance School X-ing sign (S1-1)	TY 10BWG(1)XX(T)
	48-inch School X-ing sign (S2-1)	TY 10BWG(1)XX(T)
	Large Arrow sign (W1-6 & W1-7)	TY 10BWG(1)XX(T)













SIGN MOUNTING DETAILS
 SMALL ROADSIDE SIGNS
 TRIANGULAR SLIPBASE SYSTEM
 SMD(SLIP-2)-08

© TxDOT July 2002		DN: TxDOT	CK: TxDOT	DW: TxDOT	CK: TxDOT
9-08	REVISIONS	CON: 0169	SECT: 07	JOB: 053, ETC	HIGHWAY: US60
		DIST: AMA	COUNTY: GRAY	SHEET NO. 239	

DISCLAIMER: The use of this standard is governed by the "Texas Engineering Practice Act". No warranty of any kind is made by TxDOT for any purpose whatsoever. TxDOT assumes no responsibility for the conversion of this standard to other formats or for incorrect results or damages resulting from its use.

DATE: 4/7/2021 7:28:31 AM
 FILE: F:\Projects\2019\11004.TxDOT\5x5*PS&E\03_US60*Amari\110\ENG\500-USTN\509-Traffic\05-Standard.smds3.dgn

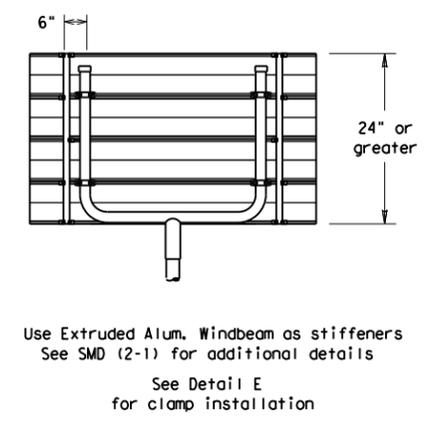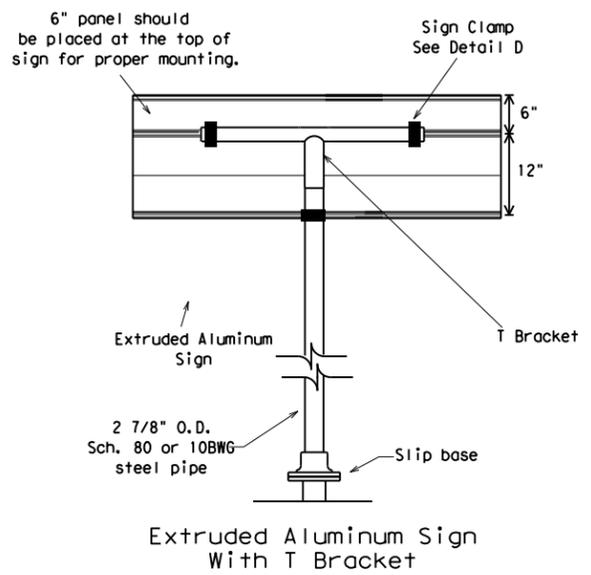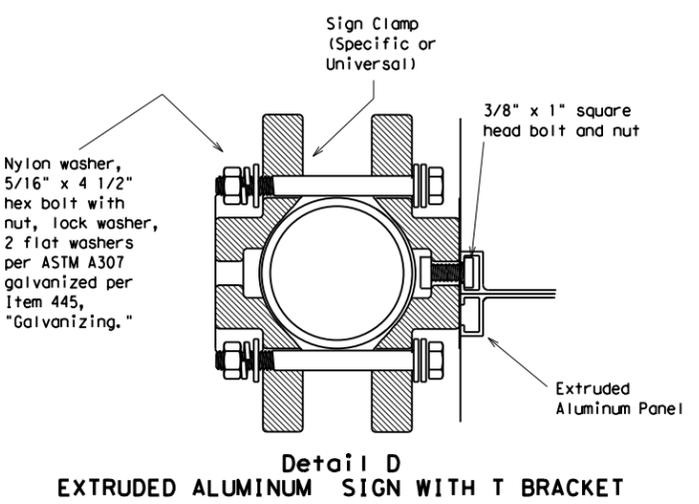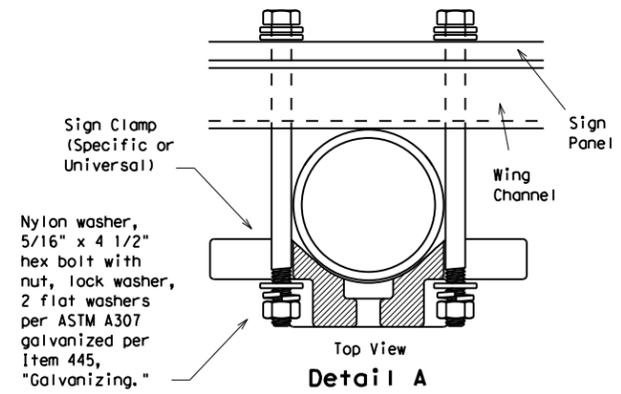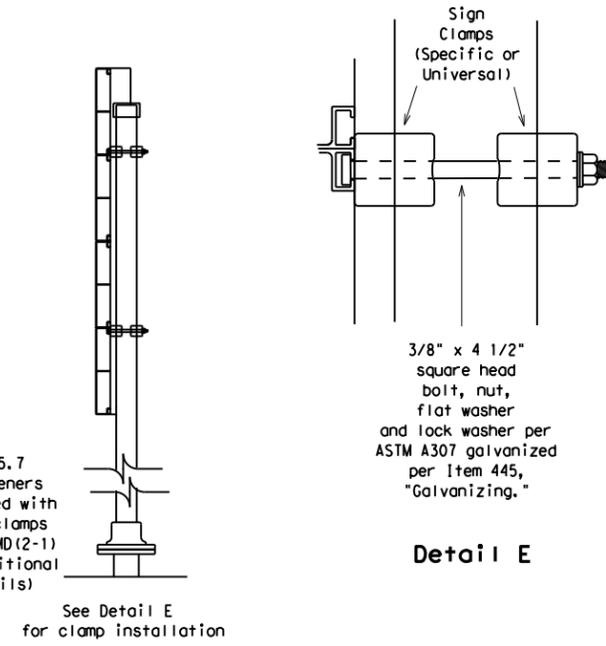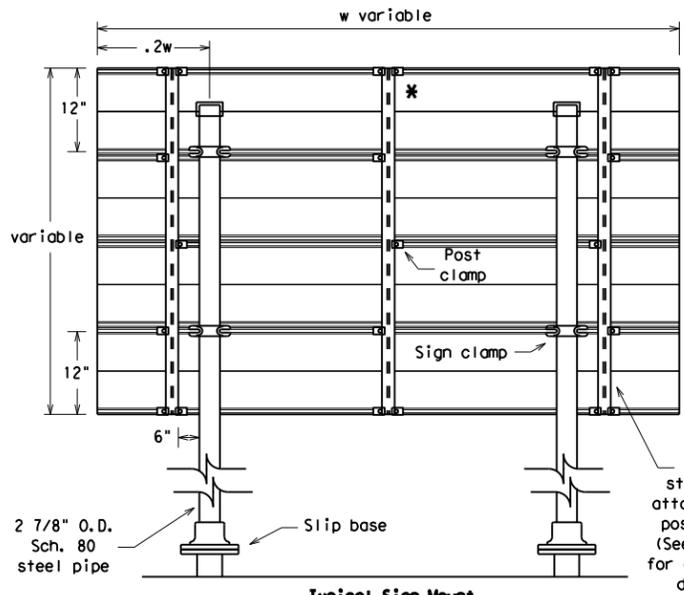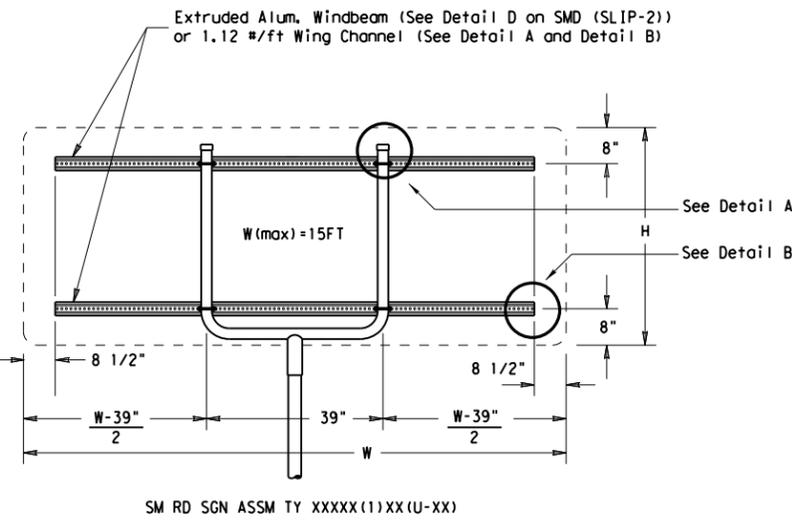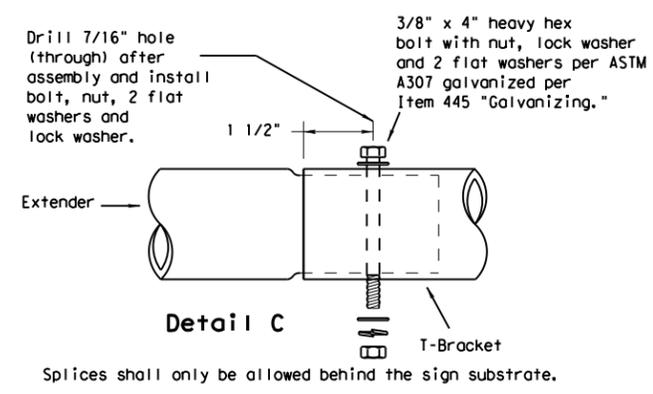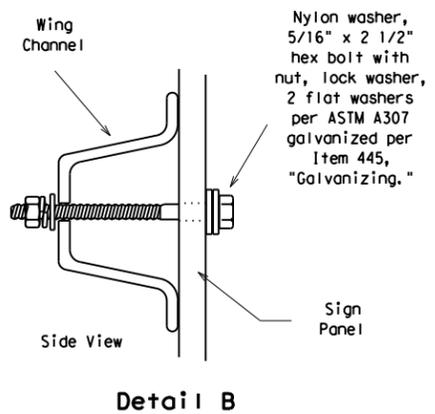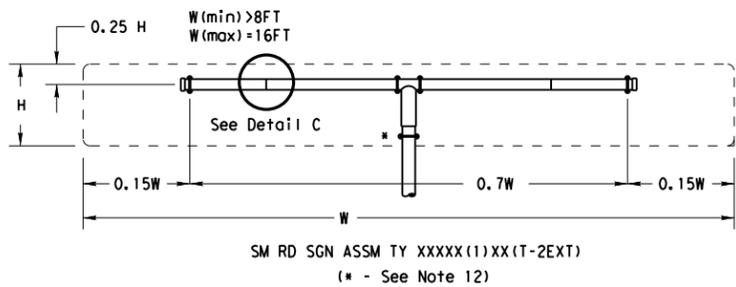

GENERAL NOTES:

- | SIGN SUPPORT | # OF POSTS | MAX. SIGN AREA |
|--------------|------------|----------------|
| 10 BWG | 1 | 16 SF |
| 10 BWG | 2 | 32 SF |
| Sch 80 | 1 | 32 SF |
| Sch 80 | 2 | 64 SF |
- The Engineer may require that a Schedule 80 post be used in place of a 10 BWG where a sign height is abnormally high due to a fill slope.
- Sign supports shall not be spliced except where shown. Sign support posts shall not be spliced.
- Aluminum sign blanks shall conform to Departmental Material Specifications DMS-7110 and shall have the following minimum thicknesses: 0.080 for signs less than 7.5 sq. ft., 0.100 for signs 7.5 to 15 sq. ft., and 0.125 for signs greater than 15 sq. ft.
- Signs that require specific supports due to reasons in addition to windloading are indicated on the "REQUIRED SUPPORT" table on this sheet.
- For horizontal rectangular signs fabricated from flat aluminum, T-brackets are used for signs 24 inches or less in height. U-brackets are used for signs of greater height.
- When two triangular slipbase supports are used to support a single sign, they shall not be "rigidly" connected to each other except through the sign panel. This will allow each support to act independently when impacted by an errant vehicle.
- Wing channel shall meet ASTM A 1011 SS Gr 50 and be galvanized per ASTM A 123.
- Excess pipe, wing channel, or windbeam shall be cut off so that it does not extend beyond the sign panel (i.e., excess support shall not be visible when the sign is viewed from the front.) Repair galvanized coating at cut support ends per Item 445, "Galvanizing."
- Sign blanks shall be the sizes and shapes shown on the plans.
- Additional sign clamp required on the "T-bracket" post for 24 inch high signs. Place the clamp 3 inches above bottom of sign when possible.
- Post open ends shall be fitted with Friction Caps.

REQUIRED SUPPORT		
	SIGN DESCRIPTION	SUPPORT
Regulatory	48-inch STOP sign (R1-1)	TY 10BWG(1)XX(T) TY 10BWG(1)XX(P-BM)
	60-inch YIELD sign (R1-2)	TY 10BWG(1)XX(T) TY 10BWG(1)XX(P-BM)
	48x16-inch ONE-WAY sign (R6-1)	TY 10BWG(1)XX(T) TY 10BWG(1)XX(P-BM)
	36x48, 48x36, and 48x48-inch signs	TY 10BWG(1)XX(T)
Warning	48x60-inch signs	TY S80(1)XX(T)
	48x48-inch signs (diamond or square)	TY 10BWG(1)XX(T)
	48x60-inch signs	TY S80(1)XX(T)
	48-inch Advance School X-ing sign (S1-1)	TY 10BWG(1)XX(T)
	48-inch School X-ing sign (S2-1)	TY 10BWG(1)XX(T)
	Large Arrow sign (W1-6 & W1-7)	TY 10BWG(1)XX(T)




**SIGN MOUNTING DETAILS
 SMALL ROADSIDE SIGNS
 TRIANGULAR SLIPBASE SYSTEM
 SMD(SLIP-3)-08**


© TxDOT July 2002		DN: TxDOT	CK: TxDOT	DW: TxDOT	CK: TxDOT
9-08	REVISIONS	CONT	SECT	JOB	HIGHWAY
		0169	07	053, ETC	US60
		DIST	COUNTY		SHEET NO.
		AMA	GRAY		240

DISCLAIMER: The use of this standard is governed by the "Texas Engineering Practice Act". No warranty of any kind is made by TxDOT for any purpose whatsoever. TxDOT assumes no responsibility for the conversion of units or for the accuracy of any information derived from this standard. TxDOT is not responsible for any errors or omissions in this standard or for any damages resulting from its use.

DATE: 4/7/2021 7:28:31 AM
 FILE: F:\Projects\2019\11004.TxDOT_5x5_PS&E_V03_US60_Amarillo\ENG\500-USTN\509-11004-PS&E_V03_US60.dgn

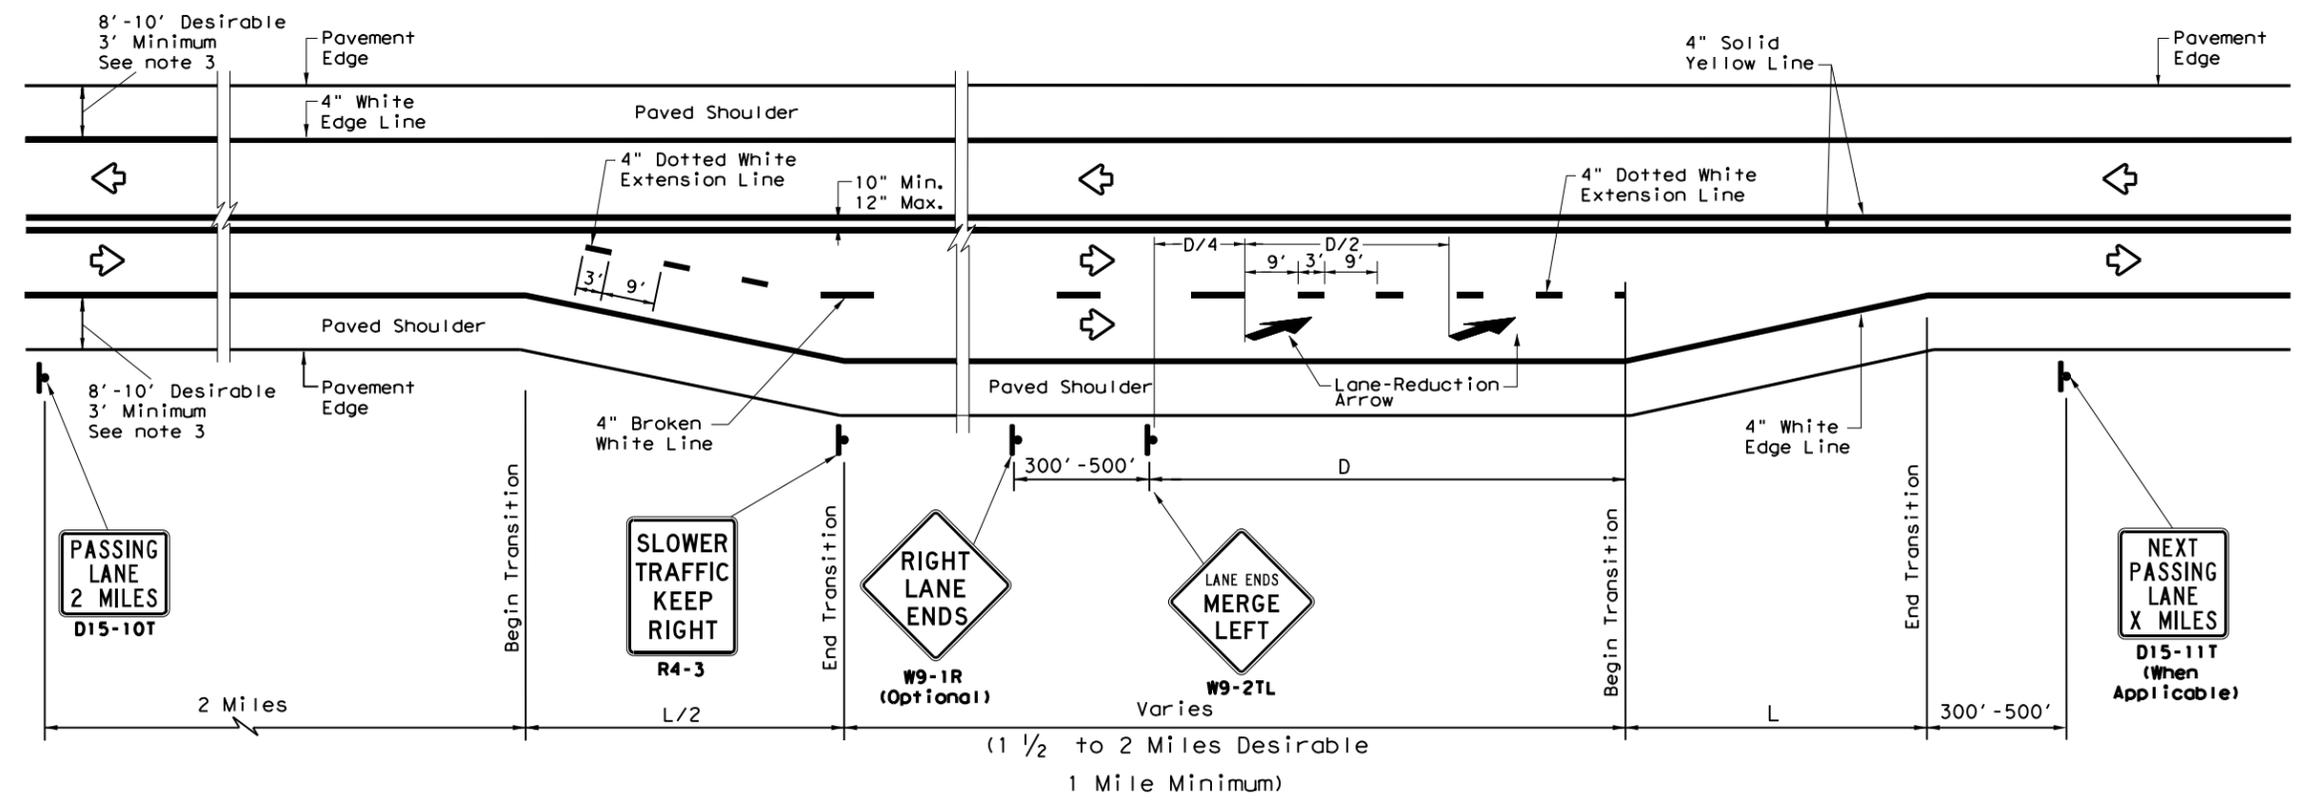

SEPARATED

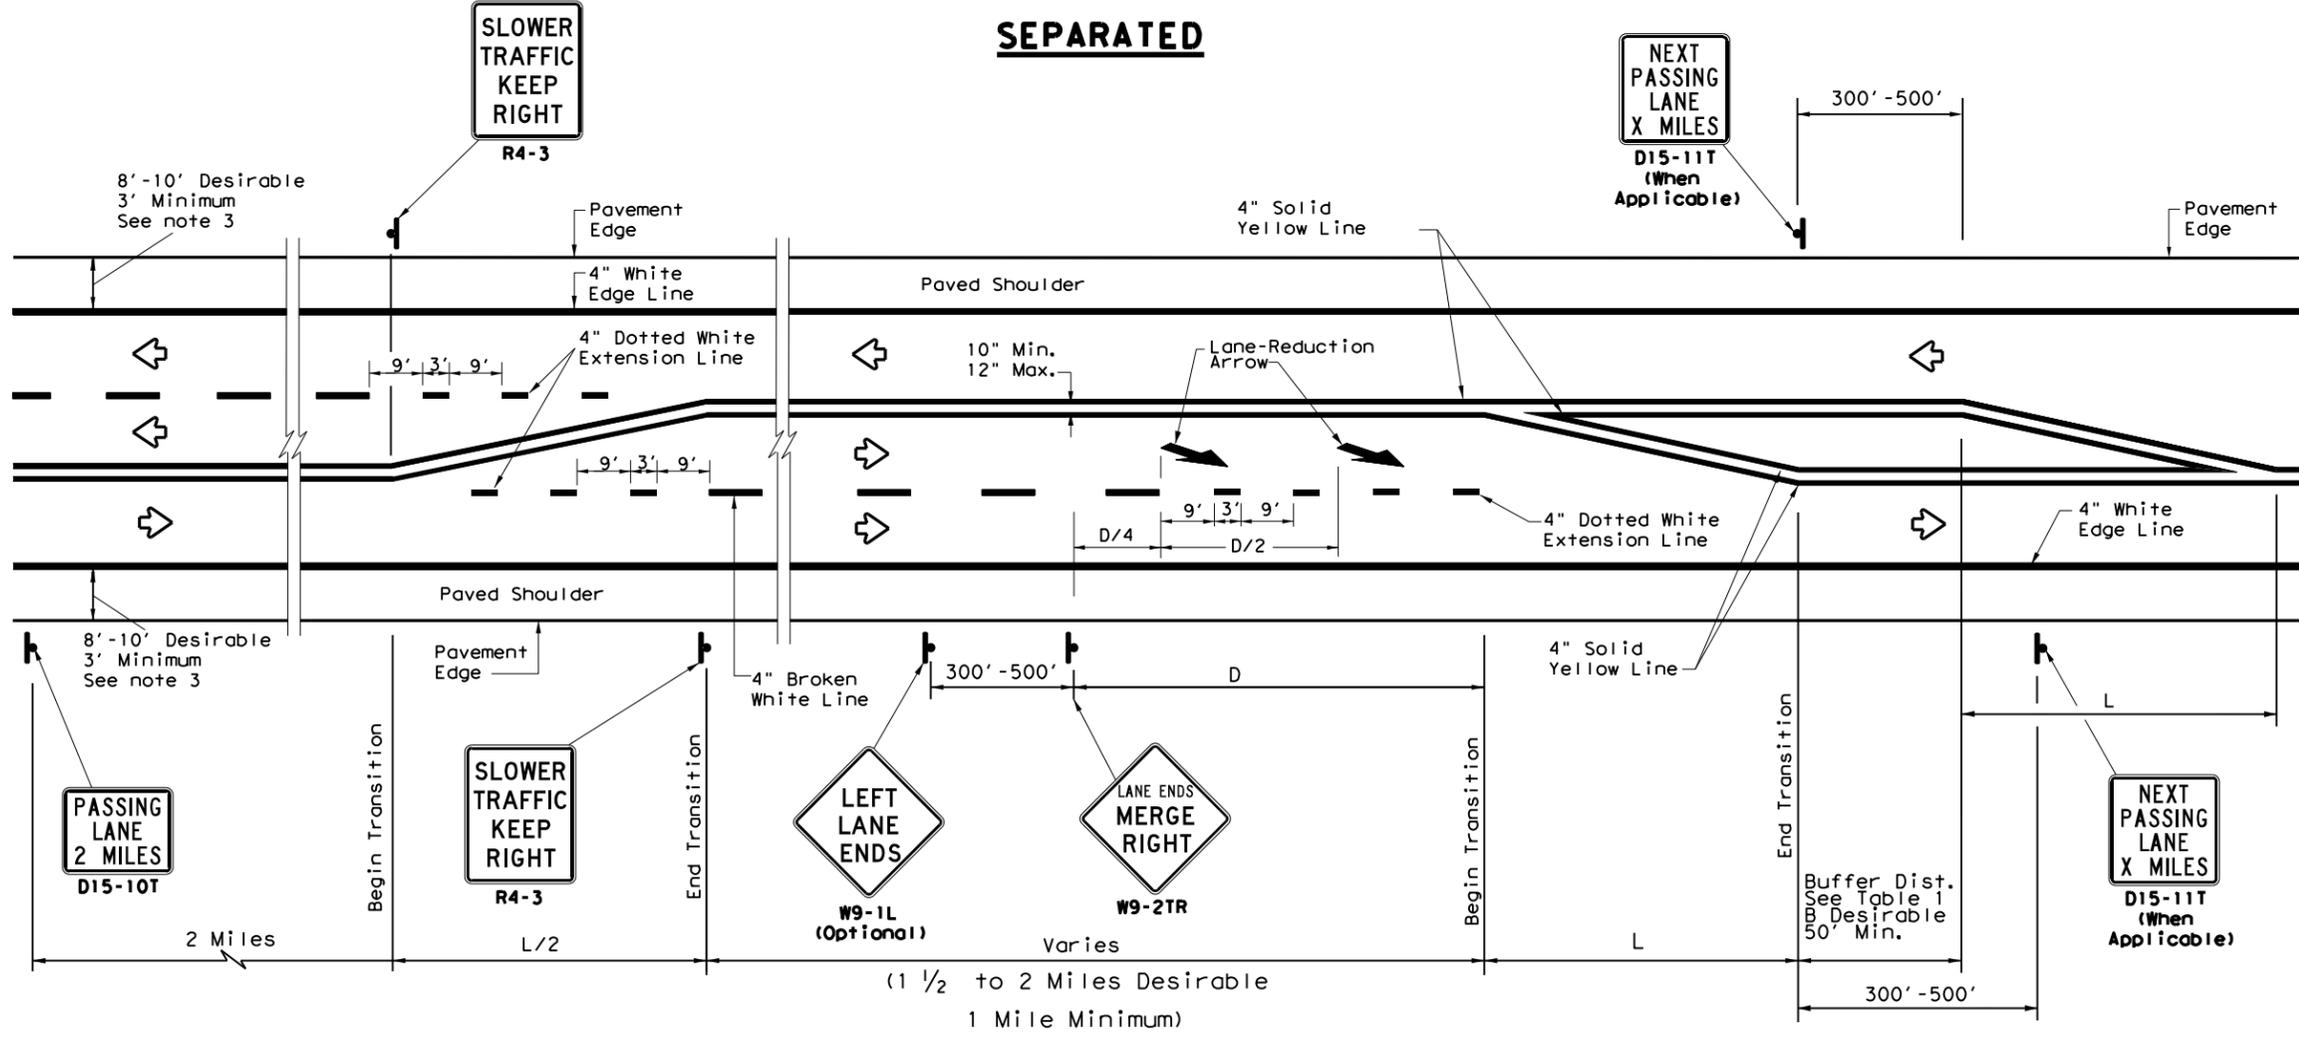

ALTERNATING

LEGEND	
	Sign
	Traffic Flow

TYPICAL TAPER LENGTH (L)	
Formula *	$L = WS$

* Transition length should be rounded up to nearest 5 foot increment.

L=Length of Transition (FT)
 W=Width of Offset (FT)
 S=Posted Speed (MPH)

EXAMPLE
 A 12 foot lane is added on a 70 mph roadway. The length of the transition should be:
 $L = 12 \times 70 = 840 \text{ ft}$

**TABLE 1
 ADVANCE WARNING SIGN
 DISTANCE (D)
 AND BUFFER DISTANCE (B)**

Posted Speed	D (FT)	B (FT)
40	670	305
45	775	360
50	885	425
55	990	495
60	1100	570
65	1200	645
70	1250	730
75	1350	820

GENERAL NOTES

- For minimum and desirable design details, see the Roadway Design Manual, Chapter 4, Section 6, Super 2 Highways.
- For Raised Pavement Markers (RPM) details, see Pavement Markings Standard sheet, PM(2). Note that RPMs are not recommended on the 4" dotted white extension lines.
- For rumble strip options available for the designed shoulder width, see rumble strip standard sheet RS(4).



**TEXAS SUPER 2
 PASSING LANES**

TS2 (PL-1) - 18

FILE: ts2-1-18.dgn	DN:	CK:	DW:	CK:
© TxDOT May 2010	CONT	SECT	JOB	HIGHWAY
REVISIONS	0169	07	053, ETC	US60
2-12	DIST	COUNTY	SHEET NO.	
3-12	AMA	GRAY	241	
3-18				

REQUIREMENTS FOR INDEPENDENT MOUNTED ROUTE SIGNS


SHEETING REQUIREMENTS		
USAGE	COLOR	SIGN FACE MATERIAL
BACKGROUND	WHITE	TYPE A SHEETING
BACKGROUND	ALL OTHERS	TYPE B OR C SHEETING
LEGEND & BORDERS	WHITE	TYPE A SHEETING
LEGEND & BORDERS	BLACK	ACRYLIC NON-REFLECTIVE FILM
LEGEND & BORDERS	ALL OTHERS	TYPE B OR C SHEETING



TYPICAL EXAMPLES

REQUIREMENTS FOR BLUE, BROWN & GREEN D AND I SERIES GUIDE SIGNS

SHEETING REQUIREMENTS		
USAGE	COLOR	SIGN FACE MATERIAL
BACKGROUND	ALL	TYPE B OR C SHEETING
LEGEND & BORDERS	WHITE	TYPE D SHEETING
LEGEND, SYMBOLS & BORDERS	ALL OTHERS	TYPE B OR C SHEETING

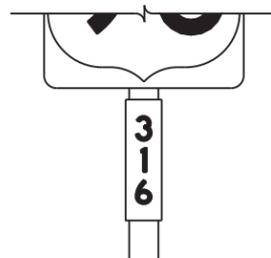

TYPICAL EXAMPLES

GENERAL NOTES:

1. Signs to be furnished shall be as detailed elsewhere in the plans and/or as shown on sign tabulation sheet. Standard sign designs and arrow dimensions can be found in the "Standard Highway Sign Designs for Texas" (SHSD).
2. White legend shall use the Clearview Alphabet. The following Clearview fonts shall be used to replace the existing white Federal Highway Administration (FHWA) Standard Highway Alphabets, when not specified in the SHSD, or in the plans.

B	CV-1W
C	CV-2W
D	CV-3W
E	CV-4W
Emod	CV-5WR
F	CV-6W
3. Route sign legend (i.e. IH, US, SH and FM shields) shall use the Federal Highway Administration (FHWA) Standard Highway Alphabets B, C, D, E, Emod or F).
4. Lateral spacing between letters and numerals shall conform with the SHSD, and any approved changes thereto. Lateral spacing of legend shall provide a balanced appearance when spacing is not shown.
5. Independent mounted route sign with white or colored legend and borders shall be applied by screening process with transparent color ink, transparent colored overlay film to white background sheeting or cut-out white sheeting to colored background sheeting, or combination thereof. White legend, symbols and borders on all other signs shall be cut-out white sheeting applied to colored background sheeting.
6. Information regarding borders and radii for signs is found in the "Standard Highway Sign Designs for Texas". Dimensions shown and described for borders and corner radii on parent sign are nominal. Borders may vary in width as much as 1/2 inch. Corner radii above 3 inches may vary in width as much as 1 inch. Borders and corner radii within a parent sign must be of matching widths. The sign area outside the corner radius should be trimmed or rounded.
7. Sign substrate shall be any material that meets the Departmental Material Specification requirements of DMS-7110 or approved alternative.
8. Mounting details of roadside signs are shown in the "SMD series" Standard Plan Sheets.

DEPARTMENTAL MATERIAL SPECIFICATIONS

ALUMINUM SIGN BLANKS	DMS-7110
SIGN FACE MATERIALS	DMS-8300

ALUMINUM SIGN BLANKS THICKNESS

Square Feet	Minimum Thickness
Less than 7.5	0.080 0.100
7.5 to 15	0.100
7.5 or Greater Greater than 15	0.125

The Standard Highway Sign Designs for Texas (SHSD) can be found at the following website.

<http://www.txdot.gov/>



04/07/2021

Bo L. Ratto

US 60
TYPICAL SIGN
REQUIREMENTS

TSR(3)-13 (MOD)

Texas Department of Transportation

SHEET 1 OF 1


REVISED MINIMUM SIGN BLANK THICKNESS

DSN	CK	CONT	SECT	JOB	HIGHWAY
\$D1	\$C1	\$0169	07	053, ETC	US60
DRWN	CK	DIST	COUNTY		SHEET NO.
\$D2	\$C2	AMA	GRAY		243

DATE: 4/7/2021 7:28:33 AM
 FILE: F:\Projects\2019\11004.TxDOT_5x5_PS&E\03_US60_Amarillo\ENG\500-USTN\509-Traffic\05-Standard\TSR(4)-13_MOD.DGN

REQUIREMENTS FOR RED BACKGROUND REGULATORY SIGNS

(STOP, YIELD, DO NOT ENTER AND WRONG WAY SIGNS)

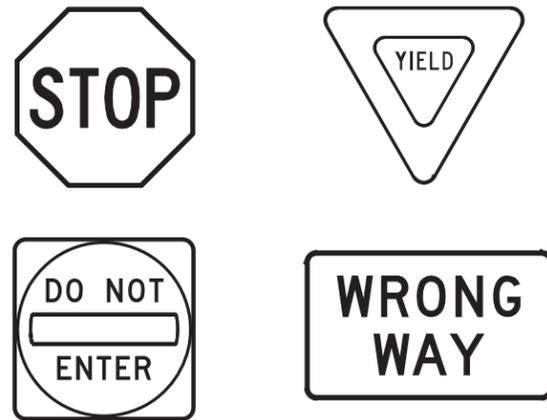

REQUIREMENTS FOR FOUR SPECIFIC SIGNS ONLY

SHEETING REQUIREMENTS		
USAGE	COLOR	SIGN FACE MATERIAL
BACKGROUND	RED	TYPE B OR C SHEETING
BACKGROUND	WHITE	TYPE B OR C SHEETING
LEGEND & BORDERS	WHITE	TYPE B OR C SHEETING
LEGEND	RED	TYPE B OR C SHEETING

REQUIREMENTS FOR WHITE BACKGROUND REGULATORY SIGNS


(EXCLUDING STOP, YIELD, DO NOT ENTER AND WRONG WAY SIGNS)



TYPICAL EXAMPLES

SHEETING REQUIREMENTS		
USAGE	COLOR	SIGN FACE MATERIAL
BACKGROUND	WHITE	TYPE A SHEETING
BACKGROUND	ALL OTHERS	TYPE B OR C SHEETING
LEGEND, BORDERS AND SYMBOLS	BLACK	ACRYLIC NON-REFLECTIVE FILM
LEGEND, BORDERS AND SYMBOLS	ALL OTHER	TYPE B OR C SHEETING

REQUIREMENTS FOR WARNING SIGNS

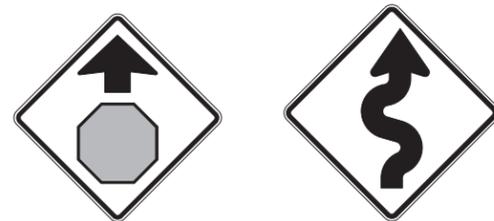

TYPICAL EXAMPLES

SHEETING REQUIREMENTS		
USAGE	COLOR	SIGN FACE MATERIAL
BACKGROUND	FLOURESCENT YELLOW	TYPE B _{FL} OR C _{FL} SHEETING
LEGEND & BORDERS	BLACK	ACRYLIC NON-REFLECTIVE FILM
LEGEND & SYMBOLS	ALL OTHER	TYPE B OR C SHEETING

REQUIREMENTS FOR SCHOOL SIGNS



TYPICAL EXAMPLES

SHEETING REQUIREMENTS		
USAGE	COLOR	SIGN FACE MATERIAL
BACKGROUND	WHITE	TYPE A SHEETING
BACKGROUND	FLOURESCENT YELLOW GREEN	TYPE B _{FL} OR C _{FL} SHEETING
LEGEND, BORDERS AND SYMBOLS	BLACK	ACRYLIC NON-REFLECTIVE FILM
SYMBOLS	RED	TYPE B OR C SHEETING

GENERAL NOTES:

- Signs to be furnished shall be as detailed elsewhere in the plans and/or as shown on sign tabulation sheet. Standard sign designs and arrow dimensions can be found in the "Standard Highway Sign Designs for Texas" (SHSD).
- Sign legend shall use the Federal Highway Administration (FHWA) Standard Highway Alphabets (B, C, D, E, Emod or F).
- Lateral spacing between letters and numerals shall conform with the SHSD, and any approved changes thereto. Lateral spacing of legend shall provide a balanced appearance when spacing is not shown.
- Black legend and borders shall be applied by screening process or cut-out acrylic non-reflective black film to background sheeting, or combination thereof.
- White legend and borders shall be applied by screening process with transparent colored ink, transparent colored overlay film to white background sheeting or cut-out white sheeting to colored background sheeting, or combination thereof.
- Colored legend shall be applied by screening process with transparent colored ink, transparent colored overlay film or colored sheeting to background sheeting, or combination thereof.
- Sign substrate shall be any material that meets the Departmental Material Specification requirements of DMS-7110 or approved alternative.
- Mounting details for roadside mounted signs are shown in the "SMD series" Standard Plan Sheets.

ALUMINUM SIGN BLANKS THICKNESS	
Square Feet	Minimum Thickness
Less than 7.5	0.080 0.100
7.5 to 15	0.100
7.5 or Greater Greater than 15	0.125

DEPARTMENTAL MATERIAL SPECIFICATIONS	
ALUMINUM SIGN BLANKS	DMS-7110
SIGN FACE MATERIALS	DMS-8300

The Standard Highway Sign Designs for Texas (SHSD) can be found at the following website:
<http://www.txdot.gov/>



US 60 TYPICAL SIGN REQUIREMENTS

TSR(4)-13 (MOD)



SHEET 1 OF 1

REVISED MINIMUM SIGN BLANK THICKNESS


DSN	CK	CONT	SECT	JOB	HIGHWAY
\$D1	\$C1	\$0169	07	053, ETC	US60
DRWN	CK	DIST	COUNTY	SHEET NO.	
\$D2	\$C2	AMA	GRAY	244	

DISCLAIMER: The use of this standard is governed by the "Texas Engineering Practice Act". No warranty of any kind is made by TxDOT for any purpose whatsoever. TxDOT assumes no responsibility for the conversion of units or for the use of this standard in any project.


DATE: 4/7/2021 7:28:33 AM
 FILE: F:\Projects\2019\11004.TxDOT_5x5_PS&E\03_US60_Amarillo\ENG\500-USTN\509-11004-035 Standard Signs.dwg

ARROW DETAILS


for Large Ground-Mounted and Overhead Guide Signs

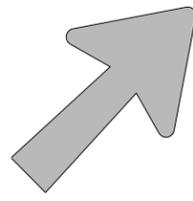


Type A

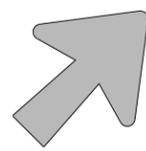


Type B

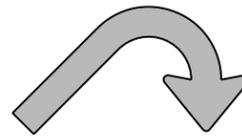

E-3

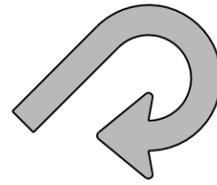

E-4

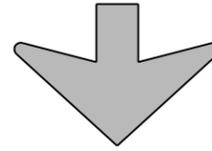

Down Arrow

TYPE	LETTER SIZE	USE
A-1	10.67" U/L and 10" Caps	Single Lane Exits
A-2	13.33" U/L and 12" Caps	
A-3	16" & 20" U/L	
B-1	10.67" U/L and 10" Caps	Multiple Lane Exits
B-2	13.33" U/L and 12" Caps	
B-3	16" & 20" U/L	


CODE	USED ON SIGN NO.
E-3	E5-1aT
E-4	E5-1bT

NOTE

Arrow dimensions are shown in the "Standard Highway Sign Designs for Texas" manual.


The Standard Highway Sign Designs for Texas (SHSD) can be found at the following website:
<http://www.txdot.gov/>

SIGN BLANK PUNCHING DETAILS FOR ATTACHMENTS WHEN SPECIFIED TO BE TYPE A ALUMINUM SIGNS (FOR MOUNTING TO GUIDE SIGN FACE)

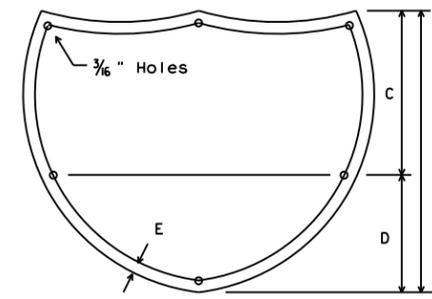


INTERSTATE ROUTE MARKERS

A	C	D	E
36	21	15	1 1/2
48	28	20	1 3/4

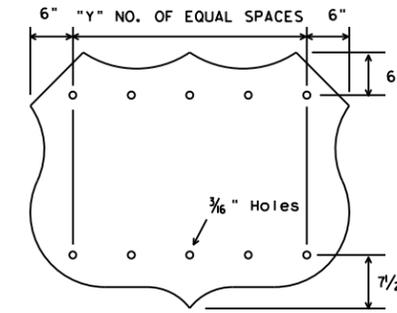


U.S. ROUTE MARKERS

Sign Size	"Y" NO. OF EQUAL SPACES
24x24	2
30x24	3
36x36	3
45x36	4
48x48	4
60x48	5

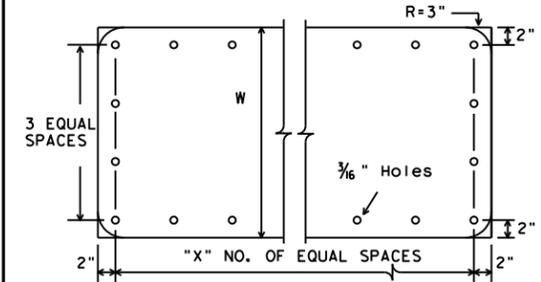


STATE ROUTE MARKERS

No. of Digits	W	X
4	24	4
4	36	5
4	48	6
3	24	3
3	36	4
3	48	5

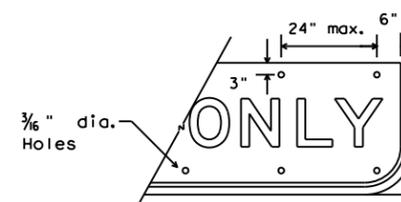


EXIT ONLY PANEL

MOUNTING DETAILS OF ATTACHMENTS TO GUIDE SIGN FACE ("EXIT ONLY" AND "LEFT EXIT" PANELS, ROUTE MARKERS AND OTHER ATTACHMENTS)

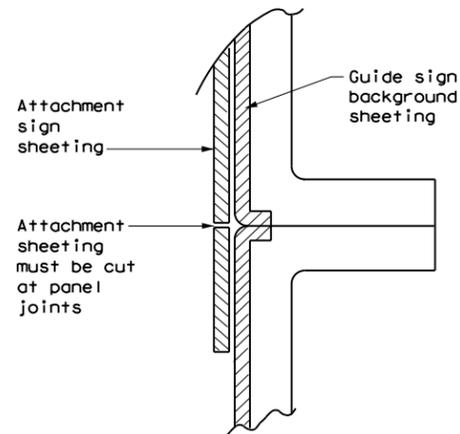


DIRECT APPLIED ATTACHMENT

- NOTE:**
- Sheeting for legend, symbols, and borders must be cut at panel joints.
 - Direct applied attachment signs will be subsidiary to "Aluminum Signs" or "Fiberglass Signs".

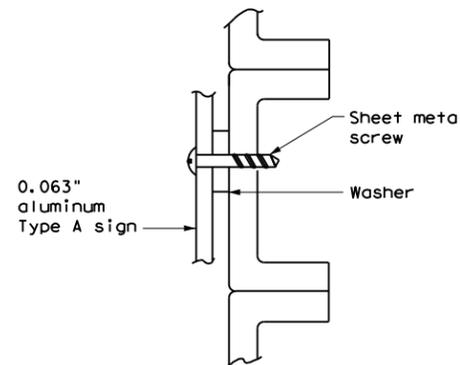


SCREW ATTACHMENT

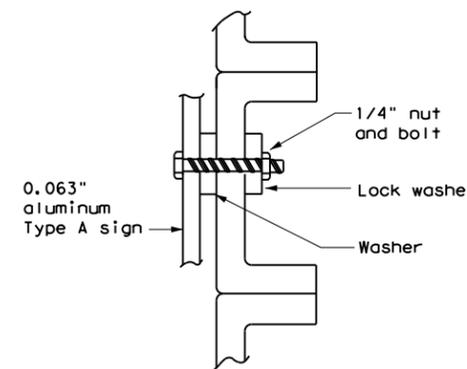


NUT/BOLT ATTACHMENT

- NOTE:**
- Furnish Type A aluminum sign attachments only when specified in the plans. These signs will be paid for under "Aluminum Signs".

ARROW DETAILS for Destination Signs (Type D)

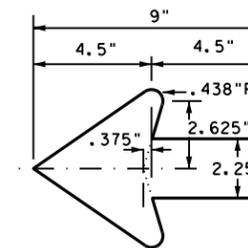

Standard arrow to be used with 6 inch letters.

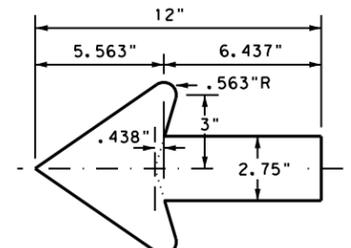

Standard arrow to be used with 8 inch letters.


TYPICAL SIGN REQUIREMENTS

TSR (5) - 13

FILE: tsr5-13.dgn	DN: TxDOT	CK: TxDOT	DW: TxDOT	CR: TxDOT
© TxDOT October 2003	CONT	SECT	JOB	HIGHWAY
REVISIONS	0169	07	053, ETC	US60
12-03 7-13	DIST	COUNTY	SHEET NO.	
9-08	AMA	GRAY	245	


DISCLAIMER: The use of this standard is governed by the "Texas Engineering Practice Act". No warranty of any kind is made by TxDOT for any purpose whatsoever. TxDOT assumes no responsibility for the conversion of units or the accuracy of the information contained herein. If you find any errors or omissions, please contact the Engineering Standards and Specifications Section at (512) 463-9999.

DATE: 4/7/2021 7:28:34 AM
 FILE: F:\Projects\2019\11004.TxDOT_5x5_PS&E\03_US60_Amarillo\ENG\500-USTN\509-11004-03-05.dwg

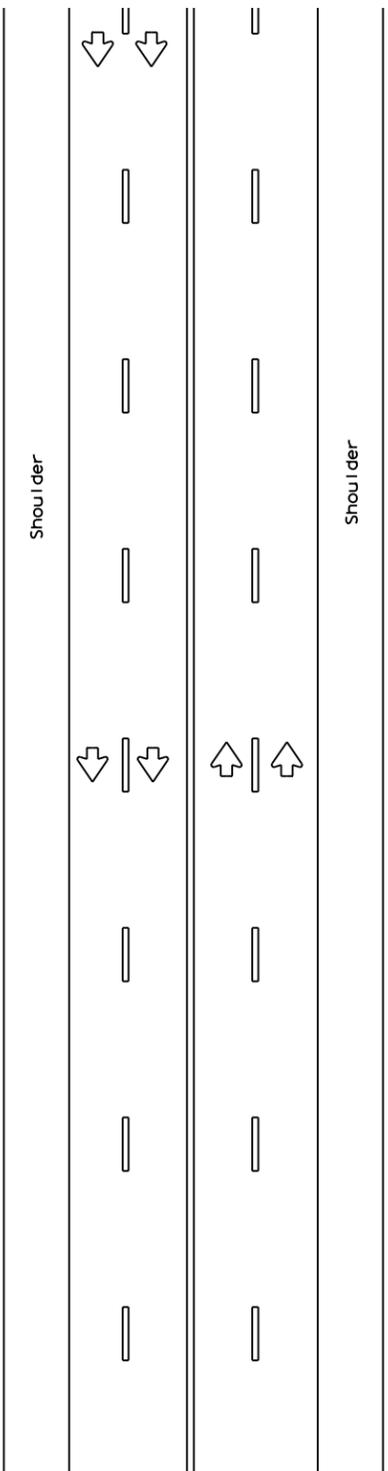


MULTILANE UNDIVIDED HIGHWAY WITH SHOULDER

CENTERLINE RUMBLE STRIPS

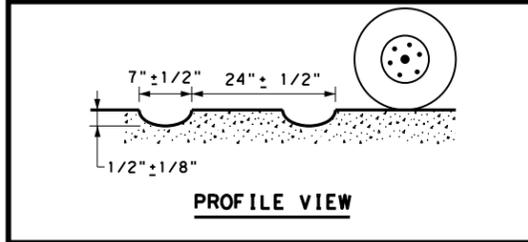


PROFILE VIEW

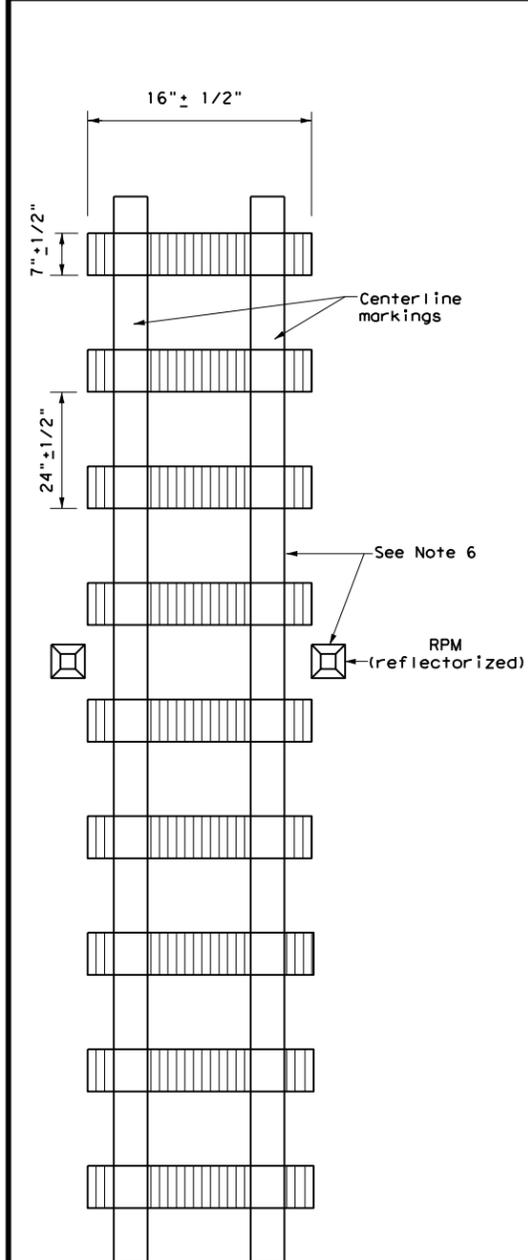


PLAN VIEW
OPTION 1

MILLED CENTERLINE RUMBLE STRIPS

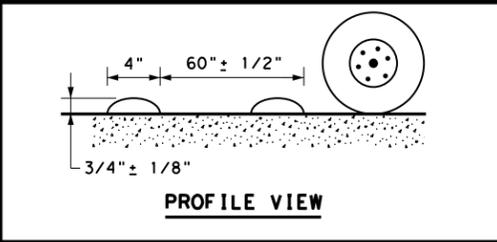


PROFILE VIEW

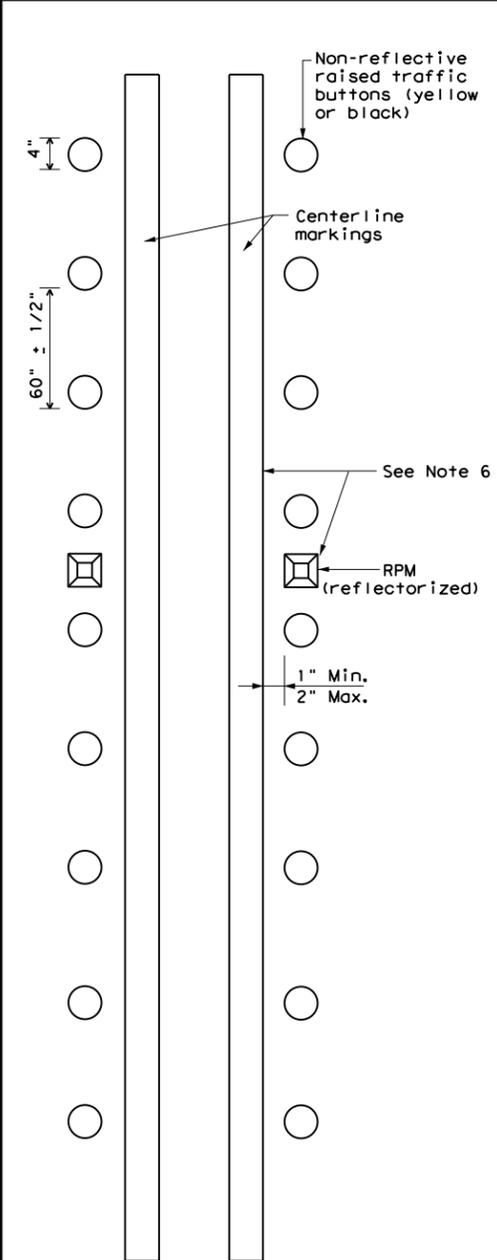


PLAN VIEW
OPTION 2

RAISED CENTERLINE RUMBLE STRIPS

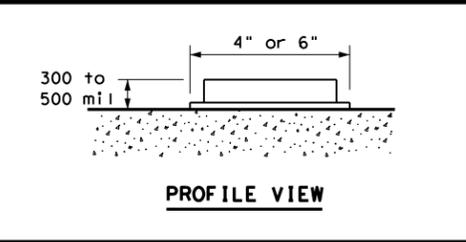

PROFILE VIEW

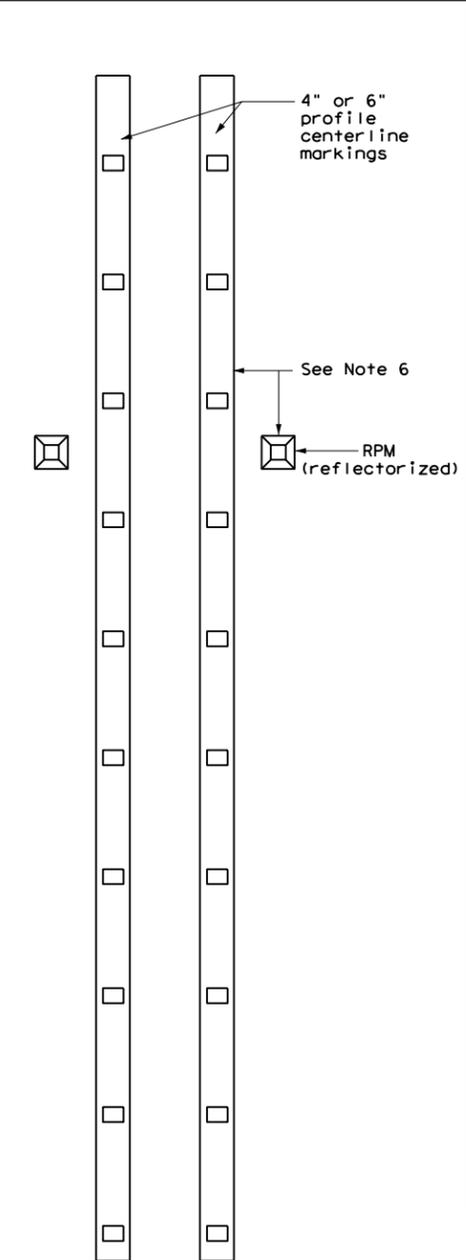

PLAN VIEW
OPTION 3

PROFILE CENTERLINE MARKINGS

GENERAL NOTES

1. This standard sheet provides guidelines for installing centerline rumble strips on multilane undivided highways.
2. Centerline and edgeline rumble strips or profile markings shall not be placed on roadways with a posted speed limit of 45 MPH or less.
3. Milled rumble strips are preferred when adequate pavement depth is available. If pavement thickness is less than 2 inches, milled rumble strips shall not be used. Rumble strips shall not be milled or depressed into bridge decks.
4. See dimensions for milled rumble strips. Other shapes and dimensions may be used if approved by the Traffic Operations Division.
5. Breaks in milled centerline rumble strips shall occur at least 50 feet and no more than 150 feet in advance of bridges, railroad crossing, intersections and driveways with high usage of large trucks.
6. Use Standard Sheet PM(2) for positioning, dimensioning, and spacing of all reflective raised pavement markers, pavement markings and profile markings.
7. Consideration should be given to noise levels when centerline rumble strips are installed near residential areas, schools, churches, etc. A minimum of 3/8 inch depth of milled rumble strip may be considered in these areas.
8. Pavement markings must be applied over milled centerline rumble strips for normal centerline spacing. For wider medians, specify in the plans the exact placement of the rumble strips. Place the rumble strips under each centerline marking or centered in the middle of the median.

WHEN INSTALLING CENTERLINE RUMBLE STRIPS:

9. Raised rumble strips consisting of non-reflective raised traffic buttons may be used. Non-reflective raised traffic buttons can be affixed to asphalt or concrete with bitumen or adhesives, as per manufacturer's recommendations.
10. When using non-reflective raised traffic buttons as a centerline rumble strip, the button shall be placed adjacent to the pavement marking delineating the centerline. The color of the button should be yellow for a continuous no passing roadway. The button will be paid for under Item 672, "Raised Pavement Markers." Non-reflective traffic buttons must meet the requirements of DMS-4300.

WHEN INSTALLING EDGELINE RUMBLE STRIPS WITH OR WITHOUT CENTERLINE RUMBLE STRIPS ON UNDIVIDED HIGHWAYS:

11. See standard sheet RS(4).




CENTERLINE RUMBLE STRIPS ON MULTILANE UNDIVIDED HIGHWAYS

RS(2) - 13


FILE:	rs(2)-13.dgn	DW:	TxDOT	CK:	TxDOT	DW:	TxDOT	CK:	TxDOT
© TxDOT	October 2013	CONT	SECT	JOB	HIGHWAY				
REVISIONS		0169	07	053, ETC	US60				
DIST	COUNTY	SHEET NO.							
AMA	GRAY	246							

DISCLAIMER: The use of this standard is governed by the "Texas Engineering Practice Act". No warranty of any kind is made by TxDOT for any purpose whatsoever. TxDOT assumes no responsibility for the conversion of units or for any errors or omissions in this standard or for any damages resulting from its use.

DATE: 4/7/2021 7:28:35 AM
 FILE: F:\Projects\2019\11004.TxDOT_5x5_PS&E\03_US60_Amarillo\ENG\500-USTN\509-11004-03-05-000.dwg

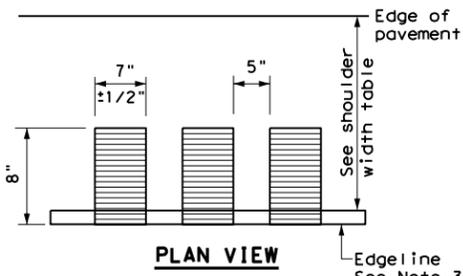


PLAN VIEW

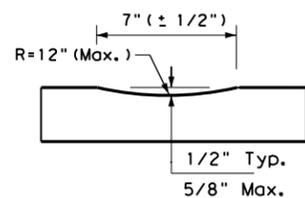


PROFILE VIEW
OPTION 1

CONTINUOUS MILLED DEPRESSIONS (Rumble Strips)

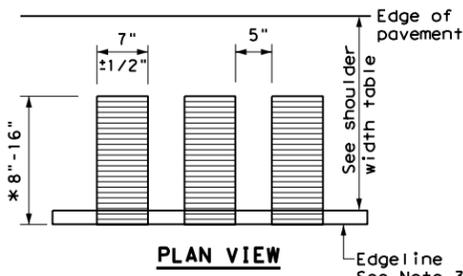


PLAN VIEW

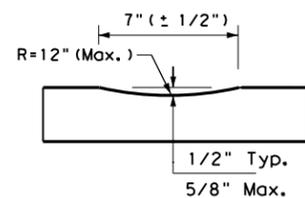


PROFILE VIEW
OPTION 2

CONTINUOUS MILLED DEPRESSIONS (Rumble Strips)

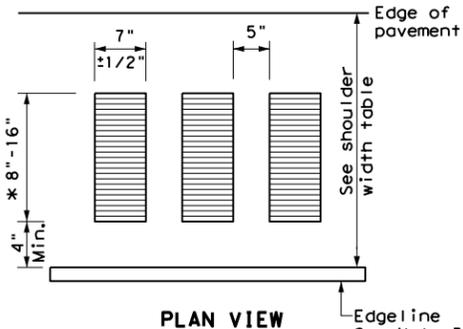


PLAN VIEW

* This distance may vary based on width of shoulder

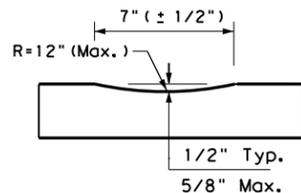


PROFILE VIEW
OPTION 3

CONTINUOUS MILLED DEPRESSIONS (Rumble Strips)

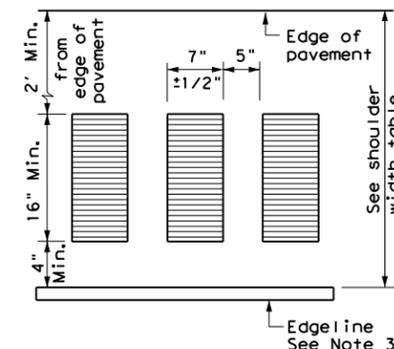


PLAN VIEW

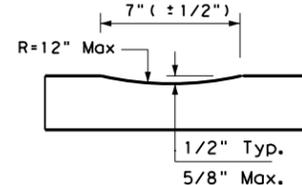


PROFILE VIEW
OPTION 4

CONTINUOUS MILLED DEPRESSIONS (Rumble Strips)

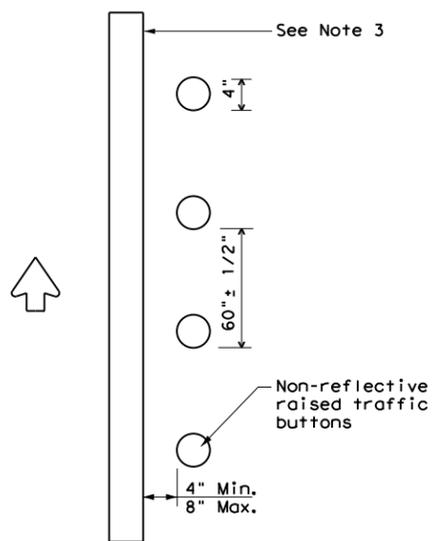

PLAN VIEW
OPTION 5

RAISED EDGELINE RUMBLE STRIPS

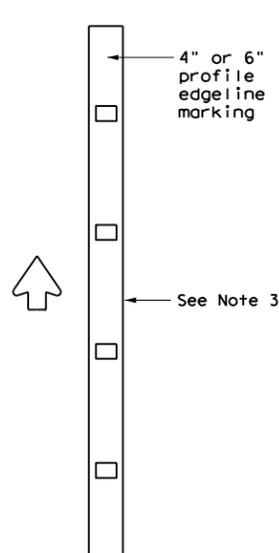

PLAN VIEW
OPTION 6

PROFILE EDGELINE MARKINGS

SHOULDER WIDTH TABLE		
EQUAL TO OR LESS THAN 2 FEET	GREATER THAN 2 FEET LESS THAN 4 FEET	EQUAL TO OR GREATER THAN 4 FEET
Option 1, 5 OR 6	Option 1, 2, 3 5 OR 6	Option 2, 4, 5 OR 6

GENERAL NOTES

- Rumble strips and profile markings shall not be placed on roadways with a posted speed limit of 45 MPH or less.
- Milled rumble strips are preferred when adequate pavement depth is available. If pavement thickness is less than 2 inches, milled rumble strips shall not be used. Rumble strips shall not be milled or depressed into bridge decks.
- Use Standard Sheet PM(2) for positioning, dimensioning, and spacing of all reflective raised pavement markers, pavement markings, and profile markings.
- See the table below for determining what options may be used for edgeline rumble strips.

WHEN INSTALLING MILLED DEPRESSION EDGELINE RUMBLE STRIPS:

- See dimensions for milled rumble strips. Other shapes and dimensions may be used if approved by the Traffic Operations Division.
- Pavement markings can be applied over milled shoulder rumble strips to create an edgeline rumble stripe.
- Breaks in edgeline rumble strips shall occur at least 50 feet and no more than 150 feet in advance of bridges, railroad crossings, intersections and driveways with high usage of large trucks when installed on conventional highways.
- Rumble strips shall not be placed across exit or entrance ramps, acceleration and deceleration lanes, crossovers, gore areas or intersections with other roadways.
- Consideration should be given to noise levels when edgeline rumble strips are installed near residential areas, schools, churches, etc. A minimum of 3/8 inches depth of milled rumble strip may be considered in these areas.

- On roadways with high bicycle activity, consideration should be given before the installation of edgeline rumble strips. Things to consider include size of rumble strips, rumble strip material and location of rumble strips on the shoulder. If the designer determines that gaps are needed in the rumble strips due to bicycle use of the road, then follow the requirement shown in FHWA Technical Advisory T5040.39, or latest version. A detail of the spacing shall be included in the plans.

WHEN INSTALLING RAISED OR PROFILE EDGELINE RUMBLE STRIPS:

- Raised rumble strips consisting of non-reflective raised traffic buttons may be used. Non-reflective raised traffic buttons can be affixed to asphalt or concrete with bitumen or adhesives, as per the manufacturer's recommendations.
- Non-reflective traffic buttons shall be placed adjacent to the pavement marking delineating the edgeline when used as a rumble strip. The color of the button should match the color of the adjacent edgeline marking (white or yellow). The buttons will be paid for under Item 672, "Raised Pavement Markers." Non-reflective traffic buttons must meet the requirements of DMS-4300.
- Non-reflective traffic buttons shall not be placed across exit or entrance ramps, acceleration and deceleration lanes, crossovers, gore areas or intersections with other roadways.
- Breaks in edgeline rumble strips using raised traffic buttons shall occur at least 50 feet and no more than 150 feet in advance of bridges, railroad crossing, intersections and driveways with high usage of large trucks when installed on conventional highways.
- The minimum distance between the edgeline and the buttons should be used if the shoulder is less than 8 feet in width.
- Raised profile thermoplastic markings used as edgelines may substitute for buttons.

<p>EDGELINE RUMBLE STRIPS ON UNDIVIDED OR TWO LANE HIGHWAYS RS(4)-13</p>			
FILE:	rs(4)-13.dgn	DN:	TxDOT
© TxDOT	October 2013	CONT:	0169 07
REVISIONS		SECT:	053, ETC
		JOB:	US60
		HIGHWAY:	
		DIST:	AMA
		COUNTY:	GRAY
		SHEET NO.:	248

SITE DESCRIPTION

PROJECT LIMITS: US 60 FROM TIGNOR ST IN PAMPA TO ROBERTS COUNTY LINE

PROJECT DESCRIPTION: WORK CONSISTS OF SUPER 2 ROADWAY WIDENING AND OVERLAY

MAJOR SOIL DISTURBING ACTIVITIES:

MAJOR SOIL DISTURBING ACTIVITIES MAY INCLUDE BUT ARE NOT LIMITED TO RIGHT-OF-WAY PREPARATION, EXCAVATION OF BASE MATERIALS, SOIL STABILIZATION EXTENSION OF EXISTING DRAINAGE STRUCTURES, DITCH GRADING, AND FINAL GRADING AND PLACEMENT OF TOPSOIL.

TOTAL PROJECT AREA: 173.9 ACRES

TOTAL AREA TO BE DISTURBED: 27.8 ACRES

WEIGHTED RUNOFF COEFFICIENT (BEFORE CONSTRUCTION): 0.52
(AFTER CONSTRUCTION): 0.60

EXPLANATION OF THE TECHNICAL BASIS USED TO SELECT THE PRACTICES TO CONTROL POLLUTION WHERE FLOWS EXCEED PRE-DEVELOPMENT LEVELS

EXISTING CONDITION OF SOIL & VEGETATIVE COVER AND % OF EXISTING VEGETATIVE COVER:

EXISTING SOIL IS PREDOMINANTLY PULLMAN CLAY LOAM
VEGETATION CONSISTS OF NATIVE GRASSES WITH APPROXIMATELY 70% COVER

NAME OF RECEIVING WATERS: RED DEER CREEK AND THUT CREEK

SOIL STABILIZATION PRACTICES:

- TEMPORARY SEEDING
- PERMANENT PLANTING, SODDING, OR SEEDING
- MULCHING
- SOIL RETENTION BLANKET
- BUFFER ZONES
- PRESERVATION OF NATURAL RESOURCES

OTHER:

EROSION AND SEDIMENT CONTROLS

STRUCTURAL PRACTICES:

Permanent Temporary

- SILT FENCES
- HAY BALES
- ROCK BERMS
- DIVERSION, INTERCEPTOR, OR PERIMETER DIKES
- DIVERSION, INTERCEPTOR, OR PERIMETER SWALES
- DIVERSION DIKE AND SWALE COMBINATIONS
- PIPE SLOPE DRAINS
- PAVED FLUMES
- ROCK BEDDING AT CONSTRUCTION EXIT
- TIMBER MATTING AT CONSTRUCTION EXIT
- CHANNEL LINERS
- SEDIMENT TRAPS
- SEDIMENT BASINS
- STORM INLET SEDIMENT TRAP
- STONE OUTLET STRUCTURES
- CURBS AND GUTTERS
- STORM SEWERS
- VELOCITY CONTROL DEVICES

OTHER: TEMPORARY EROSION CONTROL LOGS
TEMPORARY SOIL RETENTION BLANKETS

NARRATIVE - SEQUENCE OF CONSTRUCTION (STORM WATER MANAGEMENT) ACTIVITIES:

THE ORDER OF ACTIVITIES WILL BE AS FOLLOWS:

1. PLACE SW3P DEVICES NEEDED FOR EACH PHASE
2. MAINTAIN AND UPGRADE DEVICES AS NEEDED
3. REMOVE TEMPORARY SW3P DEVICES UPON COMPLETION OF CONSTRUCTION AND PERMANENT SEEDING HAS BEEN PLACED

STORM WATER MANAGEMENT:

CARE SHALL BE TAKEN TO DISTURB AS LITTLE OF THE NATURAL AREA AS POSSIBLE
STORM WATER DRAINAGE WILL BE PROVIDED BY EXISTING DITCHES. STORM WATER SHALL BE FILTERED THROUGH TEMPORARY EROSION CONTROL LOGS BEFORE LEAVING THE PROJECT SITE.

DESCRIPTION OF ANY MEASURES INSTALLED DURING THE CONSTRUCTION PROCESS TO CONTROL STORM WATER DISCHARGES AFTER CONSTRUCTION OPERATIONS HAVE BEEN COMPLETED:

DISTURBED AREAS WILL BE SEEDED UPON COMPLETION OF CONSTRUCTION

OTHER EROSION AND SEDIMENT CONTROLS:

MAINTENANCE: All erosion and sediment controls will be maintained in good working order. If a repair is necessary, it will be done at the earliest date possible, but no later than 7 calendar days after the surrounding exposed ground has dried sufficiently to prevent further damage from heavy equipment.

OTHER EROSION AND SEDIMENT CONTROLS CONTINUED:

INSPECTION: An inspection will be performed by a TxDOT Inspector of the construction site at least once every 7 calendar days regardless of rainfall. An inspection and Maintenance Report will be made per each inspection. Based on the inspection results, the controls shall be revised per the inspection report.

WASTE MATERIALS: All waste materials will be collected and stored in a securely lidded metal dumpster. The dumpster will meet all state and local city solid waste management regulations. All trash and construction debris from the site will be deposited in the dumpster. The dumpster will be emptied as necessary or as required by local regulation, and the trash will be hauled to a permitted landfill. No construction waste material will be buried on site.

HAZARDOUS WASTE (INCLUDING SPILL REPORTING): At a minimum, any products in the following categories are considered to be hazardous: Paints, Acids for cleaning masonry surfaces, Cleaning Solvents, Asphalt products, Chemical additives for soil stabilization, or Concrete curing compounds and additives. In the event of a spill which may be hazardous, the Spill Coordinator should be contacted immediately.

SANITARY WASTE: All sanitary waste will be collected from the portable units as necessary or as required by local regulation by a licensed sanitary waste management contractor.

OFF SITE VEHICLE TRACKING:

- HAUL ROADS DAMPENED FOR DUST CONTROL
- LOADED HAUL TRUCKS TO BE COVERED WITH TARPULIN
- EXCESS DIRT ON ROAD REMOVED DAILY
- STABILIZED CONSTRUCTION ENTRANCE

OTHER:

REMARKS: Disposal areas, stockpiles, and haul roads shall be constructed in a manner that will minimize and control the amount of sediment that may enter receiving waters. Disposal areas shall not be located in any wetland, waterbody or streambed. Construction staging areas and vehicle maintenance areas shall be constructed by the Contractor in a manner to minimize the runoff of pollutants. All waterways shall be cleared as soon as practicable of temporary embankment, temporary bridges, matting, falsework, piling, debris or other obstructions placed during construction operations that are not a part of the finished work.



04/07/2021

Bo L Ratto

TxDOT STORM WATER POLLUTION PREVENTION PLAN (SW3P)



FED. RD. DIV. NO.	PROJECT NO.		SHEET NO.
	SEE TITLE SHEET		249
STATE	DIST.	COUNTY	
TEXAS	AMA.	GRAY	
CONT.	SECT.	JOB	HIGHWAY NO.
0169	07	053, ETC	US 60

DISCLAIMER: The use of this standard is governed by the "Texas Engineering Practice Act". No warranty of any kind is made by TxDOT for any purpose whatsoever. TxDOT assumes no responsibility for the conversion of this standard to other formats or for incorrect results or damages resulting from its use.
 DATE: 4/7/2021
 FILE: F:\Projects\2019\11004.TxDOT_5x5_PS&E\03_US60_Amarillo\ENGL\500-USTN\511.4-Environmental\02-Sheets\US60-ENV-EPIC.dgn

I. STORMWATER POLLUTION PREVENTION-CLEAN WATER ACT SECTION 402

TPDES TXR 150000: Stormwater Discharge Permit or Construction General Permit required for projects with 1 or more acres disturbed soil. Projects with any disturbed soil must protect for erosion and sedimentation in accordance with Item 506.

List MS4 Operator(s) that may receive discharges from this project. They may need to be notified prior to construction activities.

No Action Required Required Action

Action No.

- Prevent stormwater pollution by controlling erosion and sedimentation in accordance with TPDES Permit TXR 150000
- Comply with the SW3P and revise when necessary to control pollution or required by the Engineer.
- Post Construction Site Notice (CSN) with SW3P information on or near the site, accessible to the public and TCEQ, EPA or other inspectors.
- Submit NOI to TCEQ.

II. WORK IN OR NEAR STREAMS, WATERBODIES AND WETLANDS CLEAN WATER ACT SECTIONS 401 AND 404

USACE Permit required for filling, dredging, excavating or other work in any water bodies, rivers, creeks, streams, wetlands or wet areas.

The Contractor must adhere to all of the terms and conditions associated with the following permit(s):

- No Permit Required
- Nationwide Permit 14 - PCN not Required (less than 1/10th acre waters or wetlands affected)
- Nationwide Permit 14 - PCN Required (1/10 to <1/2 acre, 1/3 in tidal waters)
- Individual 404 Permit Required
- Other Nationwide Permit Required: NWP# _____

Required Actions: List waters of the US permit applies to, location in project and check Best Management Practices planned to control erosion, sedimentation and post-project TSS.

1.

The elevation of the ordinary high water marks of any areas requiring work to be performed in the waters of the US requiring the use of a nationwide permit can be found on the Bridge Layouts.

Best Management Practices:

Erosion	Sedimentation	Post-Construction TSS
<input type="checkbox"/> Temporary Vegetation	<input type="checkbox"/> Silt Fence	<input type="checkbox"/> Vegetative Filter Strips
<input type="checkbox"/> Blankets/Matting	<input type="checkbox"/> Rock Berm	<input type="checkbox"/> Retention/Irrigation Systems
<input type="checkbox"/> Mulch	<input type="checkbox"/> Triangular Filter Dike	<input type="checkbox"/> Extended Detention Basin
<input type="checkbox"/> Sodding	<input type="checkbox"/> Sand Bag Berm	<input type="checkbox"/> Constructed Wetlands
<input type="checkbox"/> Interceptor Swale	<input type="checkbox"/> Straw Bale Dike	<input type="checkbox"/> Wet Basin
<input type="checkbox"/> Diversion Dike	<input type="checkbox"/> Brush Berms	<input type="checkbox"/> Erosion Control Compost
<input checked="" type="checkbox"/> Erosion Control Compost	<input checked="" type="checkbox"/> Erosion Control Compost	<input type="checkbox"/> Mulch Filter Berm and Socks
<input type="checkbox"/> Mulch Filter Berm and Socks	<input type="checkbox"/> Mulch Filter Berm and Socks	<input type="checkbox"/> Compost Filter Berm and Socks
<input type="checkbox"/> Compost Filter Berm and Socks	<input type="checkbox"/> Compost Filter Berm and Socks	<input checked="" type="checkbox"/> Vegetation Lined Ditches
	<input type="checkbox"/> Stone Outlet Sediment Traps	<input type="checkbox"/> Sand Filter Systems
	<input type="checkbox"/> Sediment Basins	<input type="checkbox"/> Grassy Swales
	<input type="checkbox"/>	

III. CULTURAL RESOURCES

Refer to TxDOT Standard Specifications in the event historical issues or archeological artifacts are found during construction. Upon discovery of archeological artifacts (bones, burnt rock, flint, pottery, etc.) cease work in the immediate area and contact the Engineer immediately.

No Action Required Required Action

Action No.

- In the event that unanticipated archeological deposits are encountered during construction, work in the immediate area will cease and TxDOT archeological staff will be contacted to initiate post-review discovery procedures.

IV. VEGETATION RESOURCES

Preserve native vegetation to the extent practical. Contractor must adhere to Construction Specification Requirements Specs 162, 164, 192, 193, 506, 730, 751, 752 in order to comply with requirements for invasive species, beneficial landscaping, and tree/brush removal commitments.

No Action Required Required Action

Action No.

- Comply with Executive Order 13112 on Invasive Species and the intent of the Executive Order Memorandum on Beneficial Landscapes for re-vegetating the project area. The proposed seed mixture (both grasses and forbs) would be in accordance with Item 164, Seeding for Erosion Control in TxDOT's Standard Specifications for the construction of Highways, Streets, and Bridges.

V. FEDERAL LISTED, PROPOSED THREATENED, ENDANGERED SPECIES, CRITICAL HABITAT, STATE LISTED SPECIES, CANDIDATE SPECIES AND MIGRATORY BIRDS.

No Action Required Required Action

Action No.

- If any species on the Gray County Threatened & Endangered Lists is sighted in the project area during construction, stop construction and notify the Area Engineer.

2. American Badger, Eastern Spotted Skunk, Thirteen-lined Ground Squirrel, Prairie Vole, Swift Fox: Contractors will be advised of potential occurrence in the project area, and to avoid harming the species if encountered, and to avoid unnecessary impacts to dens.

3. Texas Horned Lizard, Woodhouse Toad, Western Box Turtle, Prairie Rattlesnake, Western Hognose Snake: Contractors will be advised of potential occurrence in the project area, and to avoid harming the species if encountered. This should include avoiding harvester ant beds in the selection of Project Specific Locations (PSL's).

4. Bird BMP's: a) Do not disturb, destroy, or remove active nests, including ground nesting birds, during the nesting season; b) avoid the removal of unoccupied, inactive nests, as practicable; c) do not collect, capture, relocate, or transport birds, eggs, young, or active nests without a permit.

5. The Migratory Bird Treaty Act of 1918 states that it is unlawful to kill, capture, collect, possess, buy, sell, trade, or transport any migratory bird, nest, young, feather, egg in part or in whole, without a Federal permit issued in accordance within the Act's policies and regulations. Migratory birds (swallows) will likely be encountered on-site in the bridge culvert during bridge demolition. Adverse impacts on these protected birds, active nests, eggs, and/or young will be avoided. Swallow nests should be removed before April 1, when they are not occupied and preventative measures would be taken to prevent re-colonization in the bridge culvert prior to and during demolition. If active nests are established with eggs laid, bridge demolition work would not begin until the young have left the nest (August 1st).

6. Tree removal should be planned to take place outside the bird nesting season (April 1-Aug 31). If the tree removal occurs between April 1 and August 31, the contractor shall complete a survey of active bird nests and will coordinate with the TxDOT Amarillo District Environmental Coordinator to determine appropriate survey procedures in accordance with TxDOT requirements.

LIST OF ABBREVIATIONS

BMP: Best Management Practice	SPCC: Spill Prevention Control and Countermeasure
CGP: Construction General Permit	SW3P: Storm Water Pollution Prevention Plan
DSHS: Texas Department of State Health Services	PCN: Pre-Construction Notification
FHWA: Federal Highway Administration	PSL: Project Specific Location
MOA: Memorandum of Agreement	TCEQ: Texas Commission on Environmental Quality
MOU: Memorandum of Understanding	TPDES: Texas Pollutant Discharge Elimination System
MS4: Municipal Separate Stormwater Sewer System	TPWD: Texas Parks and Wildlife Department
MBTA: Migratory Bird Treaty Act	TxDOT: Texas Department of Transportation
NOT: Notice of Termination	T&E: Threatened and Endangered Species
NWP: Nationwide Permit	USACE: U.S. Army Corps of Engineers
NOI: Notice of Intent	USFWS: U.S. Fish and Wildlife Service

VI. HAZARDOUS MATERIALS OR CONTAMINATION ISSUES

General (applies to all projects):

Comply with the Hazard Communication Act (the Act) for personnel who will be working with hazardous materials by conducting safety meetings prior to beginning construction and making workers aware of potential hazards in the workplace. Ensure that all workers are provided with personal protective equipment appropriate for any hazardous materials used. Obtain and keep on-site Material Safety Data Sheets (MSDS) for all hazardous products used on the project, which may include, but are not limited to the following categories: Paints, acids, solvents, asphalt products, chemical additives, fuels and concrete curing compounds or additives. Provide protected storage, off bare ground and covered, for products which may be hazardous. Maintain product labelling as required by the Act. Maintain an adequate supply of on-site spill response materials, as indicated in the MSDS. In the event of a spill, take actions to mitigate the spill as indicated in the MSDS, in accordance with safe work practices, and contact the District Spill Coordinator immediately. The Contractor shall be responsible for the proper containment and cleanup of all product spills.

Contact the Engineer if any of the following are detected:

- * Dead or distressed vegetation (not identified as normal)
- * Trash piles, drums, canister, barrels, etc.
- * Undesirable smells or odors
- * Evidence of leaching or seepage of substances

Does the project involve any bridge class structure rehabilitation or replacements (bridge class structures not including box culverts)?

Yes No

If "No", then no further action is required.

If "Yes", then TxDOT is responsible for completing asbestos assessment/inspection.

Are the results of the asbestos inspection positive (is asbestos present)?

Yes No

If "Yes", then TxDOT must retain a DSHS licensed asbestos consultant to assist with the notification, develop abatement/mitigation procedures, and perform management activities as necessary. The notification form to DSHS must be postmarked at least 15 working days prior to scheduled demolition.

If "No", then TxDOT is still required to notify DSHS 15 working days prior to any scheduled demolition.

In either case, the Contractor is responsible for providing the date(s) for abatement activities and/or demolition with careful coordination between the Engineer and asbestos consultant in order to minimize construction delays and subsequent claims.

Any other evidence indicating possible hazardous materials or contamination discovered on site. Hazardous Materials or Contamination Issues Specific to this Project:

No Action Required Required Action

Action No.

1.

VII. OTHER ENVIRONMENTAL ISSUES


(includes regional issues such as Edwards Aquifer District, etc.)

No Action Required Required Action

Action No.

- Avoid direct impacts to playa lakes adjacent to the ROW during construction including selection of and access to project specific locations (PSLs). Ensure sediment and erosion controls near the playa lakes are adequate to prevent additional sedimentation into these ephemeral water bodies.

		Design Division Standard	
<p>ENVIRONMENTAL PERMITS, ISSUES AND COMMITMENTS EPIC</p>			
FILE: epic.dgn	DN: TxDOT	CK: RG	DW: CK:
©TxDOT: February 2015	CONT	SECT	JOB
12-12-2011 (DS) REVISIONS	0169 07	053, ETC	US60
05-07-14 ADDED NOTE SECTION IV.	DIST	COUNTY	SHEET NO.
01-23-2015 SECTION I (CHANGED ITEM 1122 TO ITEM 506, ADDED GRASSY SWALES.	AMA	GRAY	250

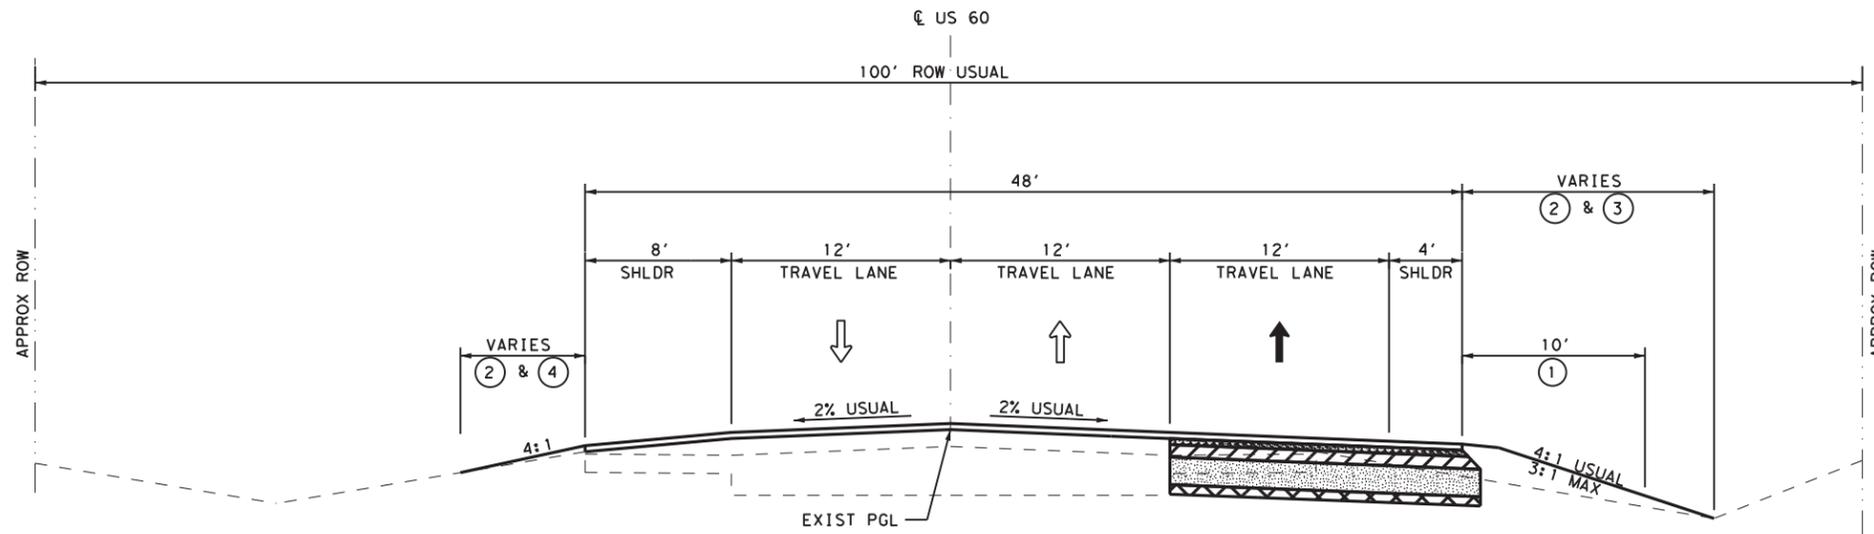


PROPOSED TYPICAL SECTION (SUPER 2) EASTBOUND

STA 485+00.00 TO STA 489+50.00 TRANS FROM 40' TO 48'
 STA 489+50.00 TO STA 535+00.00
 STA 685+00.00 TO STA 689+50.00 TRANS FROM 40' TO 48'
 STA 689+50.00 TO STA 749+00.00
 STA 749+00.00 TO STA 758+00.00 TRANS FROM 48' TO 40'

LOCATION	SUMMARY OF EROSION CONTROL ITEMS						
	134 6011	164 6036	164 6053	169 6003	314 6014	506 6040	506 6043
	BACKFILLING PAVEMENT EDGES	DRILL SEEDING (PERM) (RURAL) (CLAY)	DRILL SEEDING (TEMP) (WARM OR COOL)	SOIL RETENTION BLANKETS (CL 1) (TY C)	EMULS ASPH (EROSN CONT) (MS-2) 0.25 GAL/SY	BIODEG EROSN CONT LOGS (INSTL) (8")	BIODEG EROSN CONT LOGS (REMOVE)
	CY	AC	AC	SY	GAL	LF	LF
TYPICAL SECTION A	17	4.45	4.45	180	5169	520	520
TYPICAL SECTION B	16	3.81	3.80	346	6968	1440	1440
CSJ: 0169-07-053	33	8.27	8.25	526	12137	1960	1960
PROJECT TOTAL	33	8.27	8.25	526	12137	1960	1960

- LEGEND**
- ① EMULS ASPH (EROSN CONT) (MS-2)
 - ② DRILL SEEDING (TEMP) (WARM OR COLD)
 - ③ DRILL SEEDING (PERM) (RUAL) (CLAY)
 - ④ BACKFILLING PAVEMENT EDGES

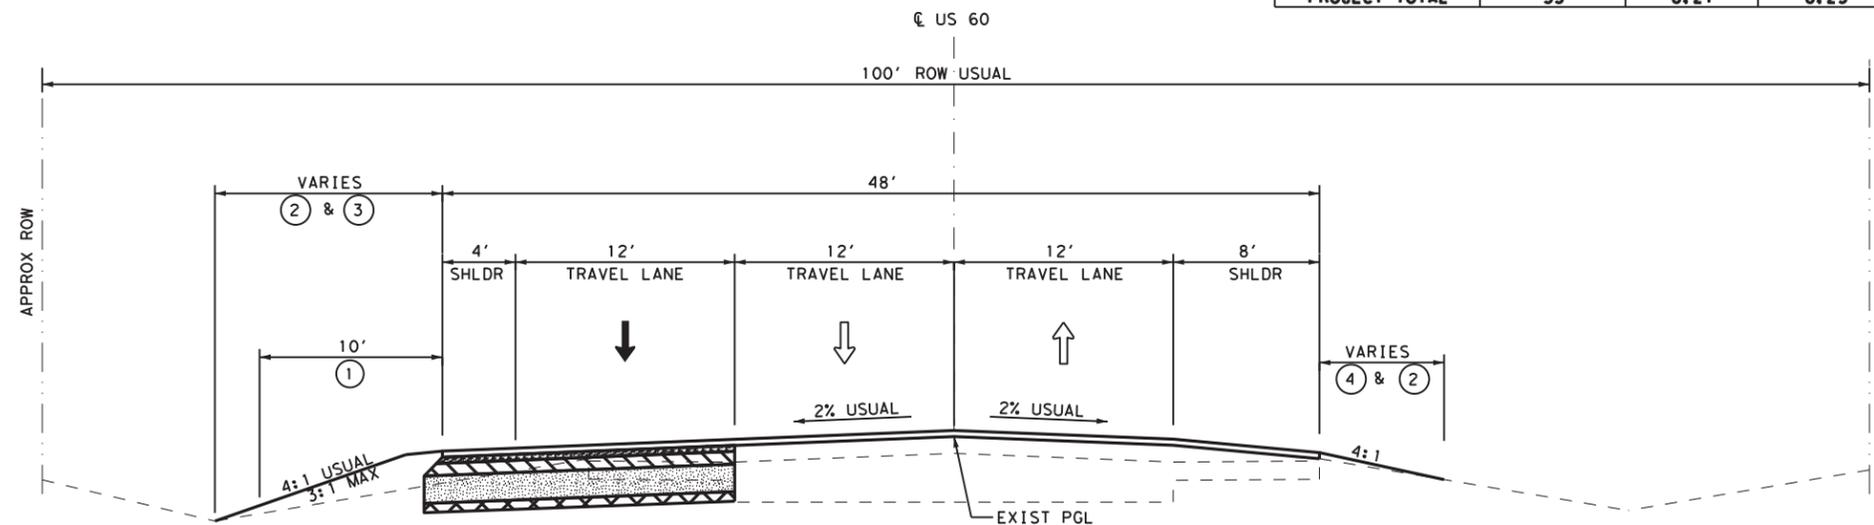

PROPOSED TYPICAL SECTION (SUPER TWO) WESTBOUND

STA 362+43.48 TO STA 369+36.00 TRANS FROM 30' LT TO 34' LT
 STA 369+36.00 TO STA 386+40.00
 STA 386+40.00 TO STA 390+00.00 TRANS FROM 34' LT TO 20' LT
 STA 564+20.00 TO STA 609+70.00
 STA 609+70.00 TO STA 614+20.00 TRANS FROM 48' TO 40'

04/07/2021

Bo L. Ratto

REV. NO.	DATE	DESCRIPTION	BY

CobbFendley 13430 Northwest Freeway, Ste. 1100
 Houston, Texas 77040
 TBPE Firm Registration No. 274 713.462.3242
 TBPLS Firm Registration No. 100467 www.cobbhendley.com


Texas Department of Transportation

SW3P DRILL SEEDING DETAIL

SHEET 1 OF 2

FED. RD. DIV. NO.	STATE	PROJECT NO.	HIGHWAY NO.		
6	TEXAS	(SEE TITLE SHEET)	US60		
STATE DISTRICT	COUNTY	CONTROL NO.	SECTION NO.	JOB NO.	SHEET NO.
AMA	GRAY	0169	07	053, ETC	251


4/7/2021 7:28:41 AM F:\Proj\1616\1616\US60-000\USTIN\11_4-E\1616\1616\02-Sheet\US60-ENV-DRILL-01.dgn

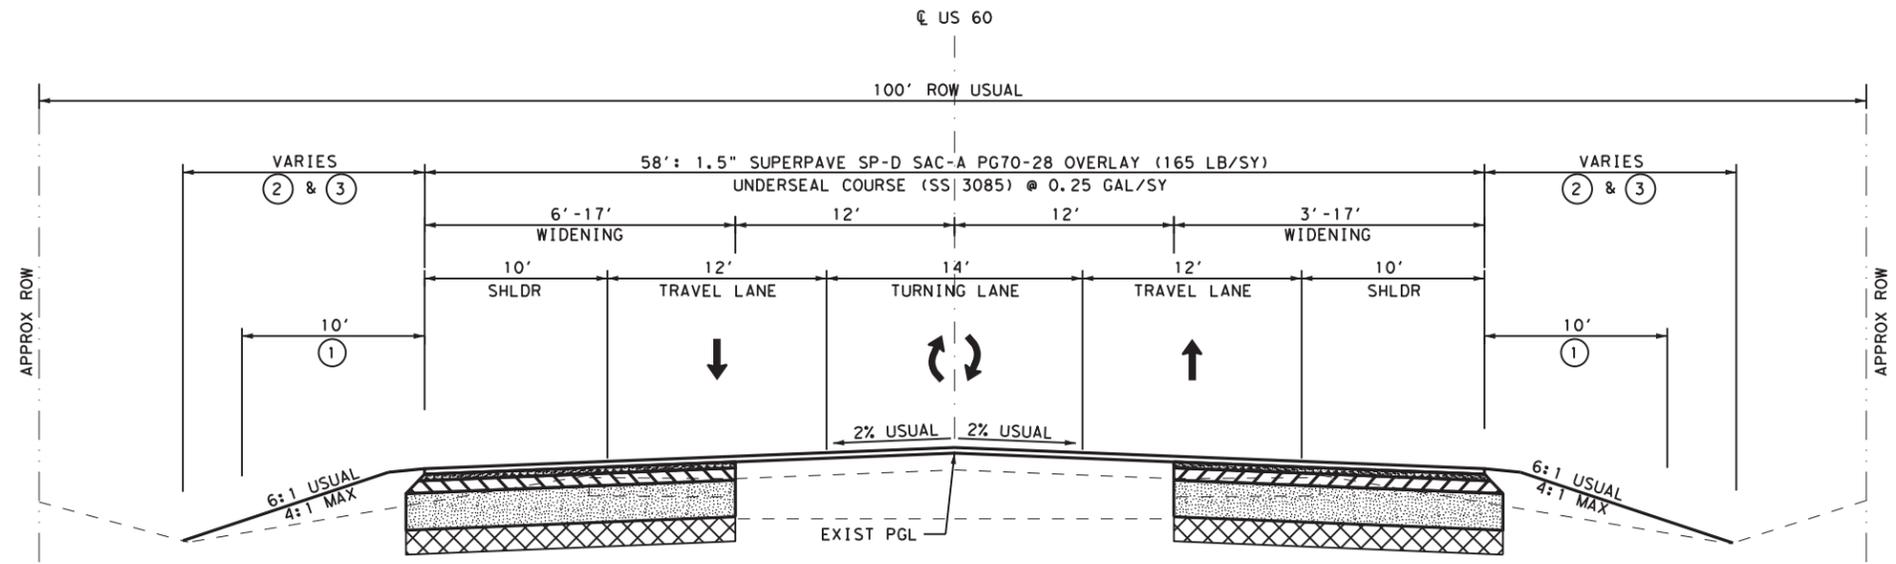

PROPOSED TYPICAL SECTION (WIDENING)
 US 60
 STA 87+75.00 TO STA 119+54.00

LOCATION	SUMMARY OF EROSION CONTROL ITEMS					
	134 6011	164 6036	164 6053	314 6014	506 6040	506 6043
	BACKFILLING PAVEMENT EDGES	DRILL SEEDING (PERM) (RURAL) (CLAY)	DRILL SEEDING (TEMP) (WARM OR COOL)	EMULS ASPH (EROSN CONT) (MS-2) 0.25 GAL/SY	BIODEG EROSN CONT LOGS (INSTL) (8")	BIODEG EROSN CONT LOGS (REMOVE)
	CY	AC	AC	SY	LF	LF
TYPICAL SECTION C		8.17	8.17	4944	420	420
PROJECT TOTAL		8.17	8.17	4944	420	420
TYPICAL SECTION D	375	2.14	13.96	14	20	20
CSJ# 0169-07-053	375	2.14	13.96	14	20	20
PROJECT TOTAL	375	10.31	22.13	4958	440	440

- LEGEND**
- ① EMULS ASPH (EROSN CONT) (MS-2)
 - ② DRILL SEEDING (TEMP) (WARM OR COLD)
 - ③ DRILL SEEDING (PERM) (RUAL) (CLAY)
 - ④ BACKFILLIG PAVEMENT EDGES

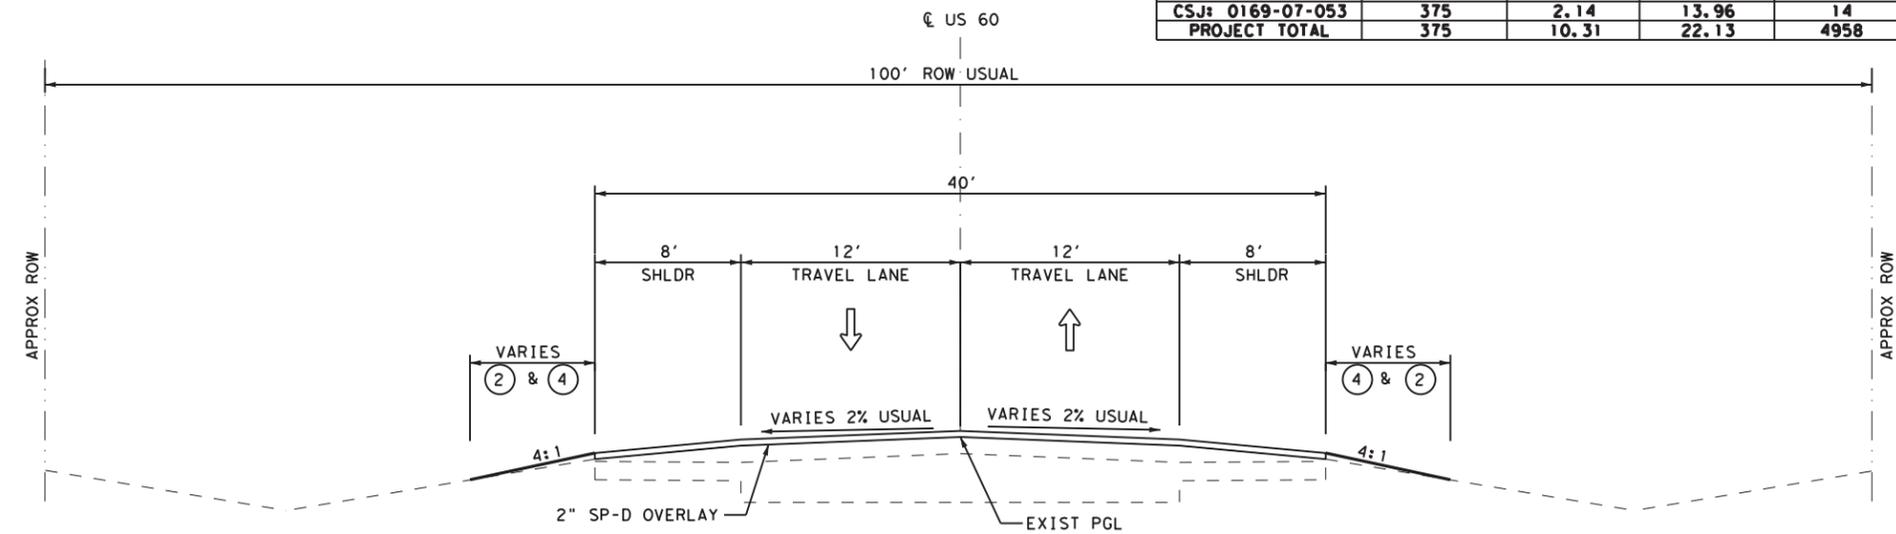


PROPOSED TYPICAL SECTION (OVERLAY)
 STA 139+18.00 TO STA 215+50.00
 STA 262+00.00 TO STA 275+00.00
 STA 390+00.00 TO STA 485+00.00
 STA 614+20.00 TO STA 685+00.00
 STA 758+00.00 TO END OF PROJECT

04/07/2021

Bo L. Ratto

REV. NO.	DATE	DESCRIPTION	BY

CobbFendley 13430 Northwest Freeway, Ste. 1100
 Houston, Texas 77040
 713.462.3242
 www.cobbhendley.com

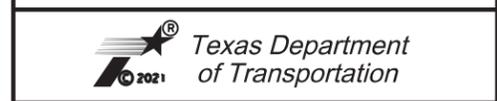





SW3P DRILL SEEDING DETAIL

SHEET 2 OF 2

FED. RD. DIV. NO.	STATE	PROJECT NO.	HIGHWAY NO.		
6	TEXAS	(SEE TITLE SHEET)	US60		
STATE DISTRICT	COUNTY	CONTROL NO.	SECTION NO.	JOB NO.	SHEET NO.
AMA	GRAY	0169	07	053, ETC	252

4/7/2021 7:28:41 AM F:\Proj\drill\2019\1004_Tx\DOT_5x3_P5&E\03_US60_Amar\116\EN\6000\UST\N\511_4-En\Ironment\02-Sheet\US60_ENV-DRILL-02.dgn

4/7/2021
 7:28:44 AM
 F:\Projects\2019\1004_TxDOT_5x5_P&E\03_US60_Amendment\16\16\500\UST\N\511_4-E\In\memoranda\02-Sheets\US60_ENW_SW3P-02.dgn

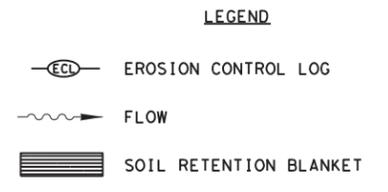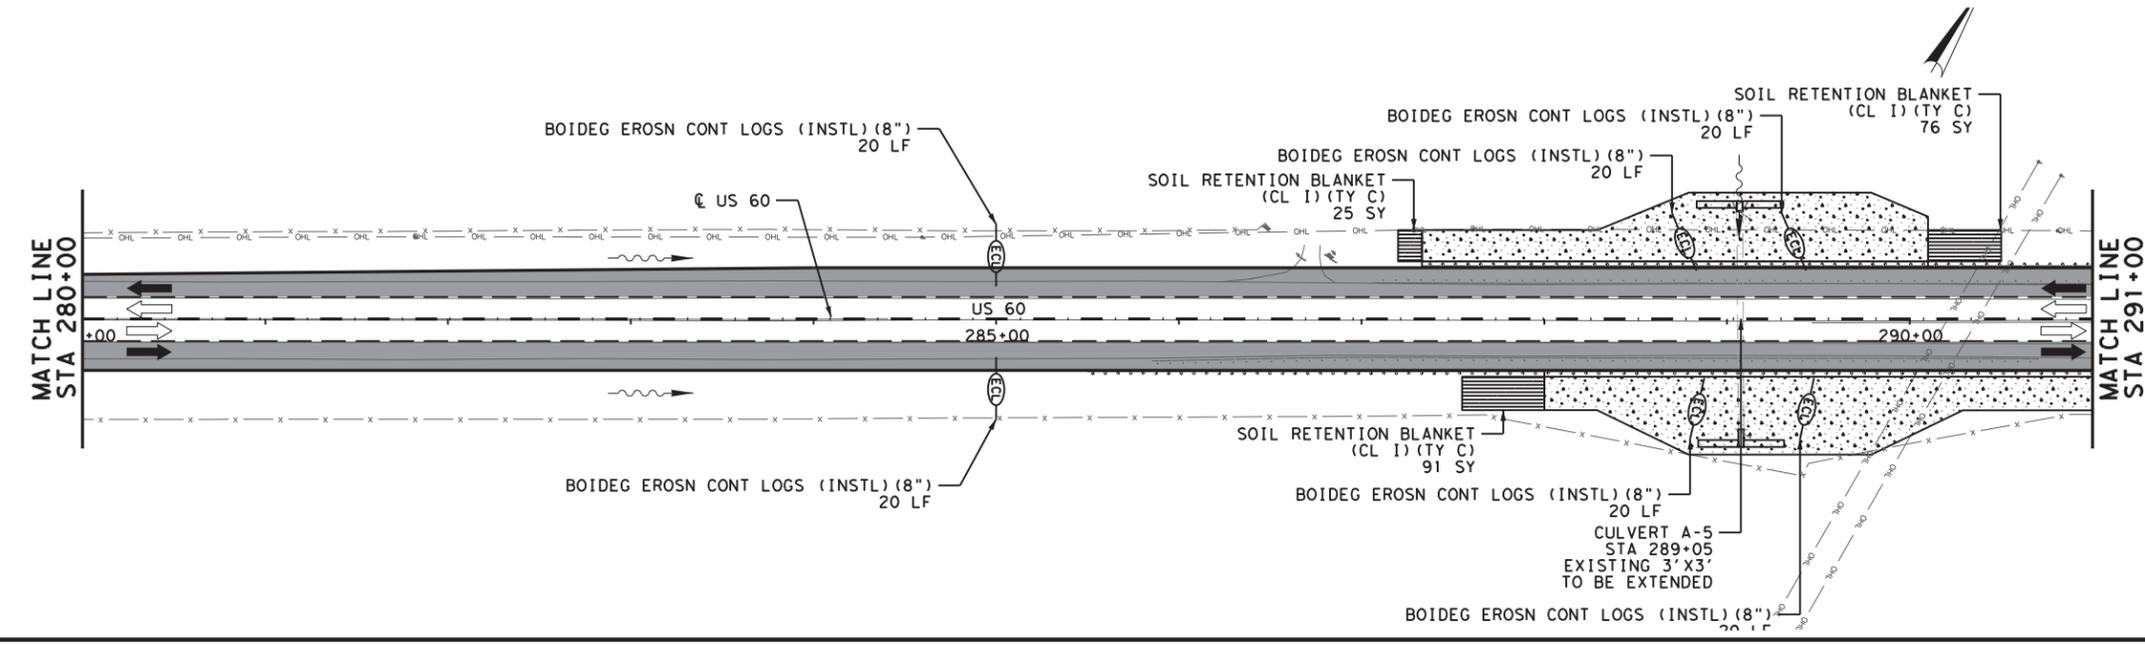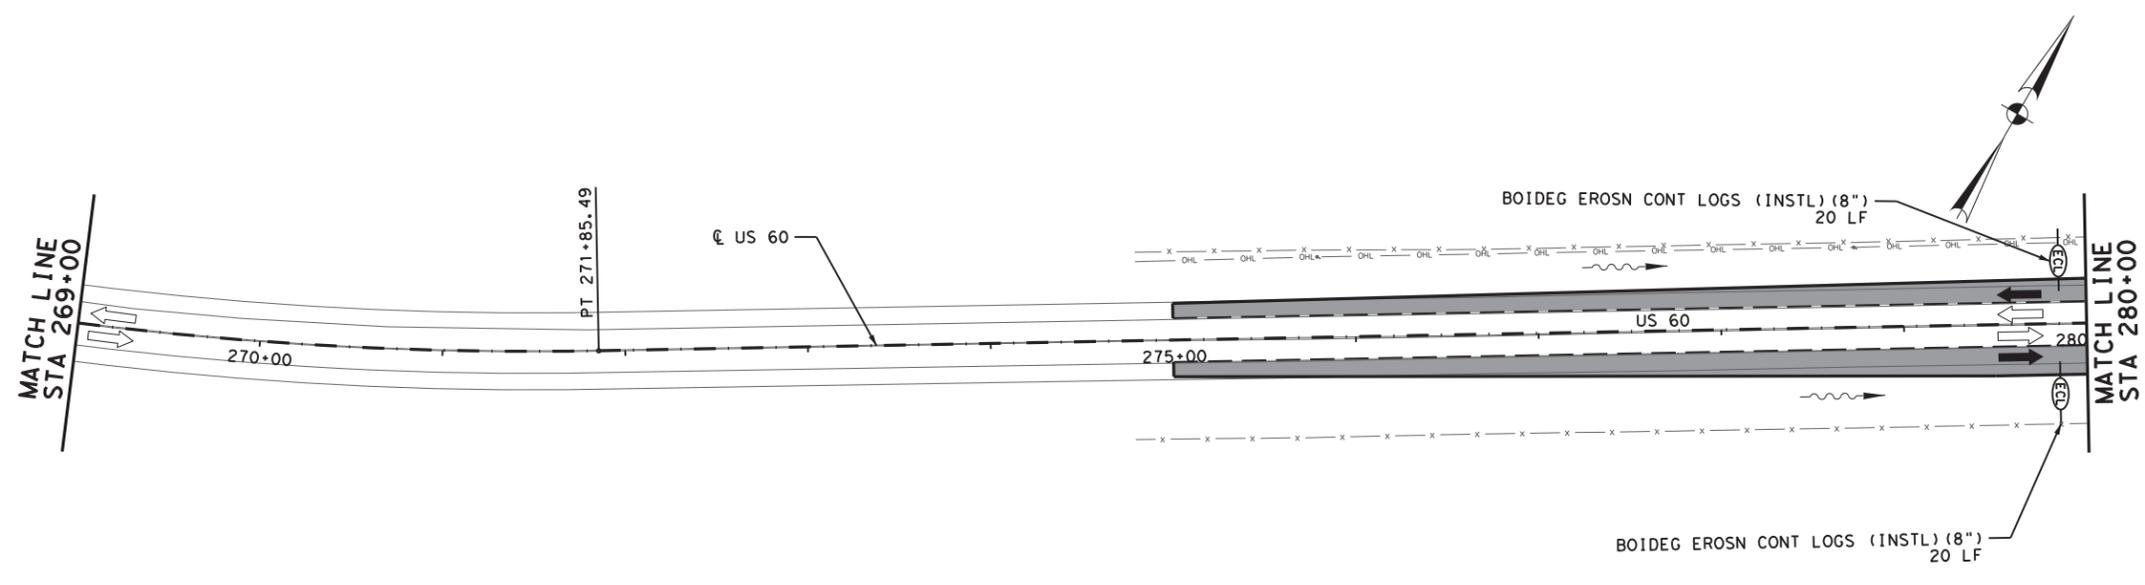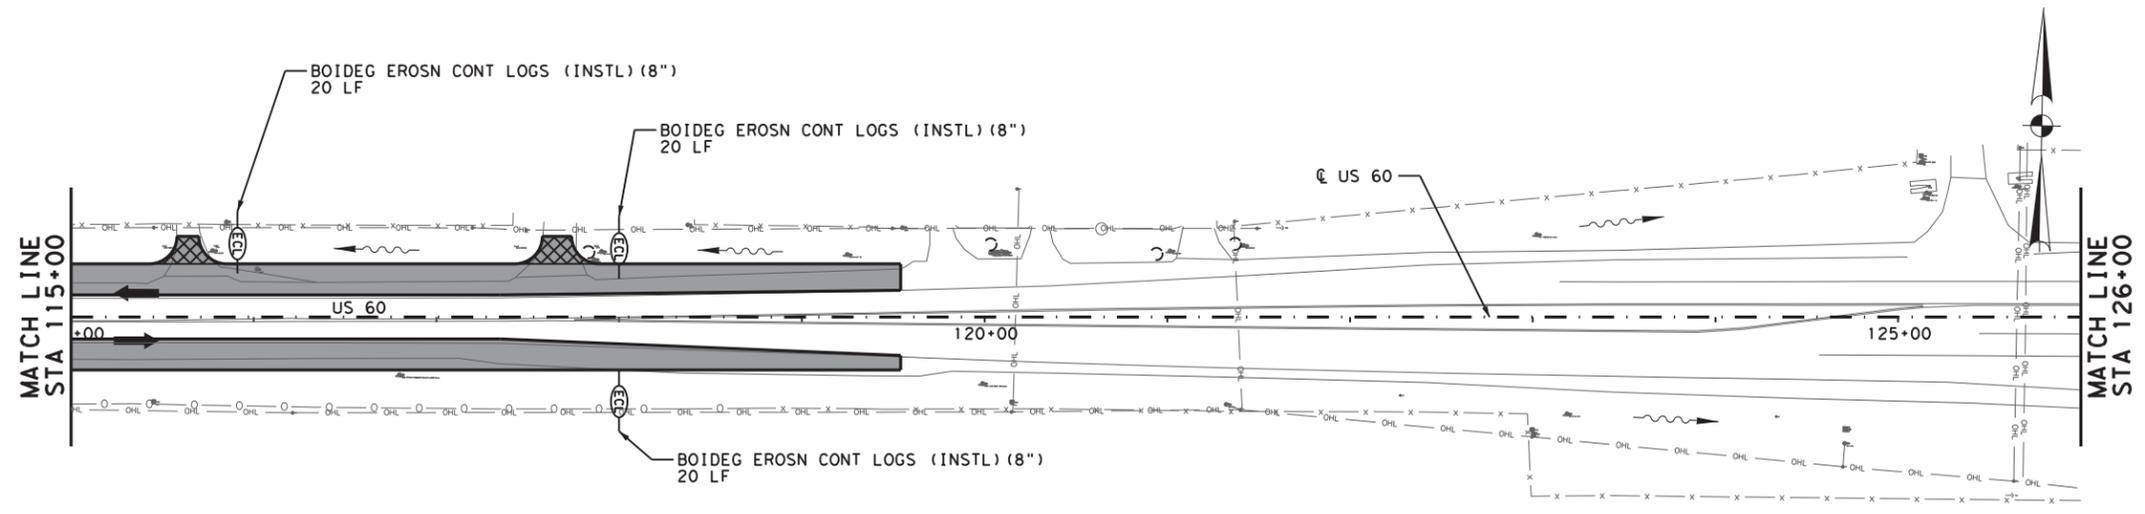

04/07/2021

Bo L. Ratto

0 25 50 100
1" = 100'

REV. NO.	DATE	DESCRIPTION	BY

CobbFendley 13430 Northwest Freeway, Ste. 1100
 Houston, Texas 77040
 TBPE Firm Registration No. 274 713.462.3242
 TBPLS Firm Registration No. 100467 www.cobbfendley.com




US 60
SW3P LAYOUT
 STA 115+00 TO STA 291+00
 SHEET 2 OF 12

FED. RD. DIV. NO.	STATE	PROJECT NO.	HIGHWAY NO.
6	TEXAS	(SEE TITLE SHEET)	US60
STATE DISTRICT	COUNTY	CONTROL NO.	SECTION NO.
AMA	GRAY	0169	07
		JOB NO.	SHEET NO.
		053, ETC	254

US60-ENW-SW3P-02.dgn

LEGEND

-  EROSION CONTROL LOG
-  FLOW
-  SOIL RETENTION BLANKET

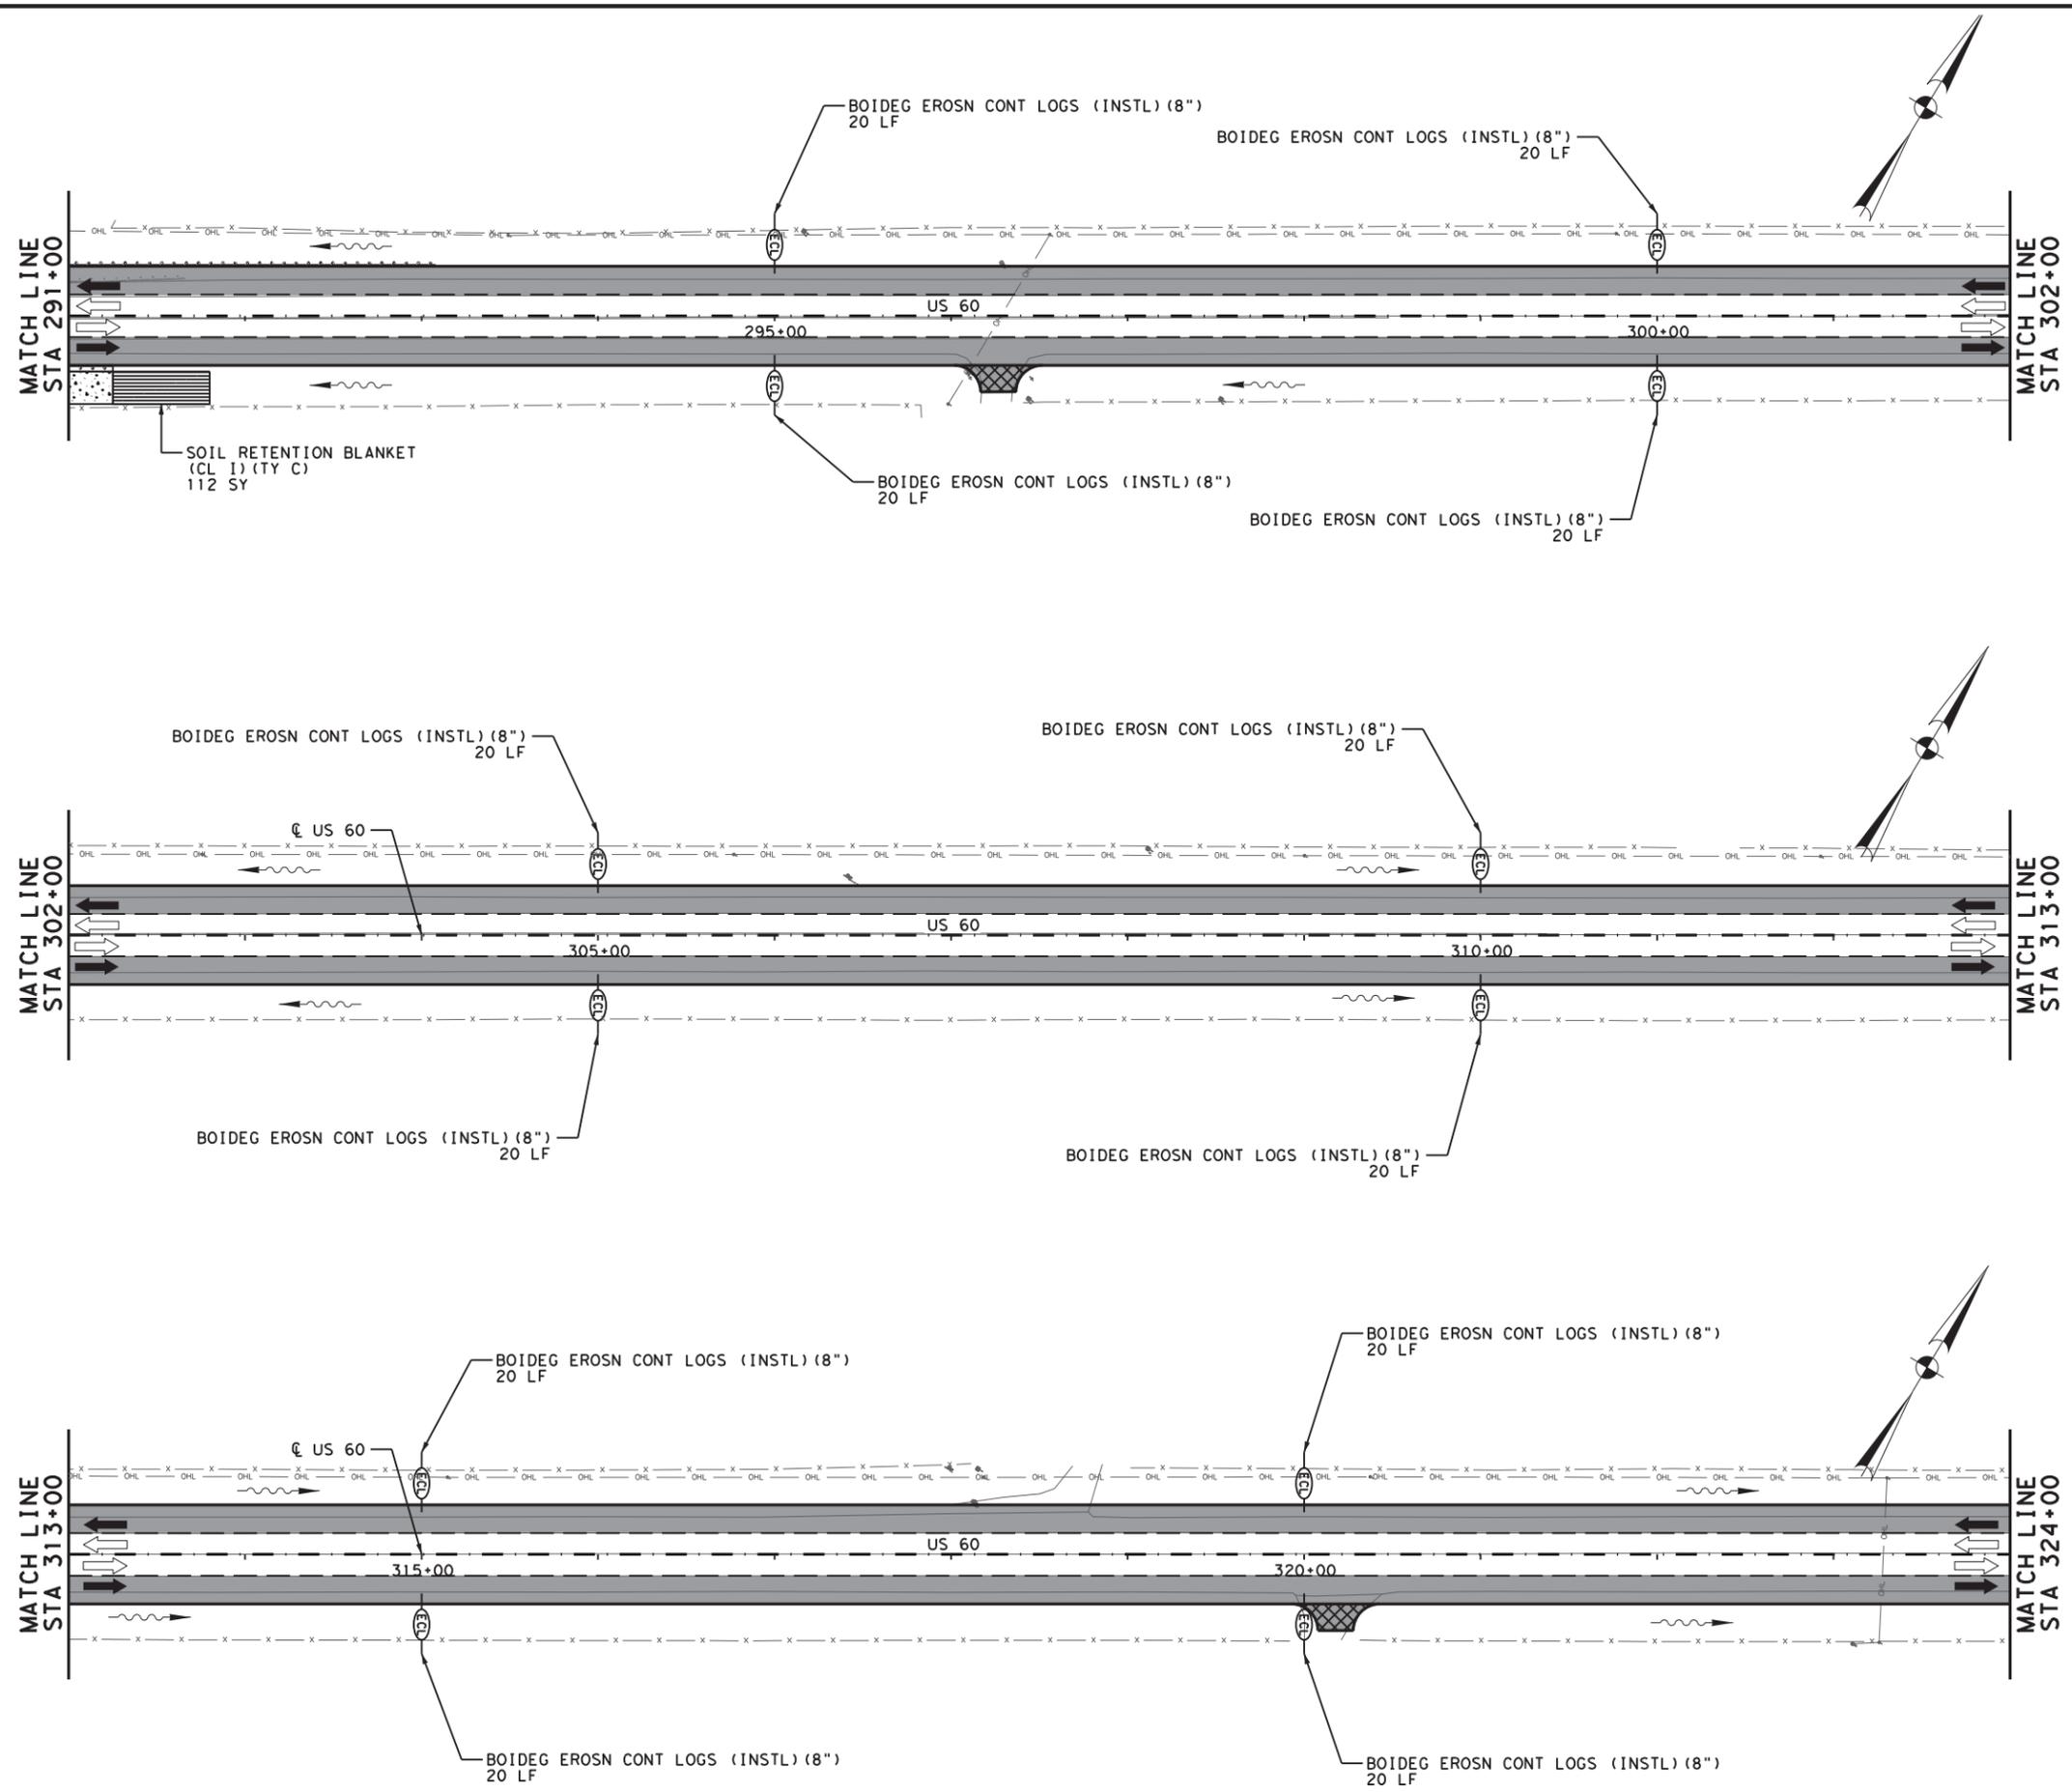

04/07/2021



Bo L. Ratto

0 25 50 100
1" = 100'

REV. NO.	DATE	DESCRIPTION	BY

CobbFendley 13430 Northwest Freeway, Ste. 1100
Houston, Texas 77040
713.462.3242
www.cobbfendley.com

 **Texas Department of Transportation**

**US 60
SW3P LAYOUT
STA 291+00 TO STA 324+00**


SHEET 3 OF 12

FED. RD. DIV. NO.	STATE	PROJECT NO.	HIGHWAY NO.
6	TEXAS	(SEE TITLE SHEET)	US60
STATE DISTRICT	COUNTY	CONTROL NO.	SECTION NO.
AMA	GRAY	0169	07
		JOB NO.	SHEET NO.
		053, ETC	255

4/7/2021 7:28:45 AM F:\P\Projects\2019\1004_TxDOT_Six_PSE\03_US60_Amendment\02_Sheets\US60_SW3P-03.dgn

US60-ENV-SW3P-03.dgn

4/7/2021 7:28:46 AM F:\Proj\2019\1004_TxDOT_5x5_PSE\03_US60_Amrt\116\EN\500\UST\N\511_4-En\Inventor\02-Sheet\US60-EN-SW3P-05.dgn

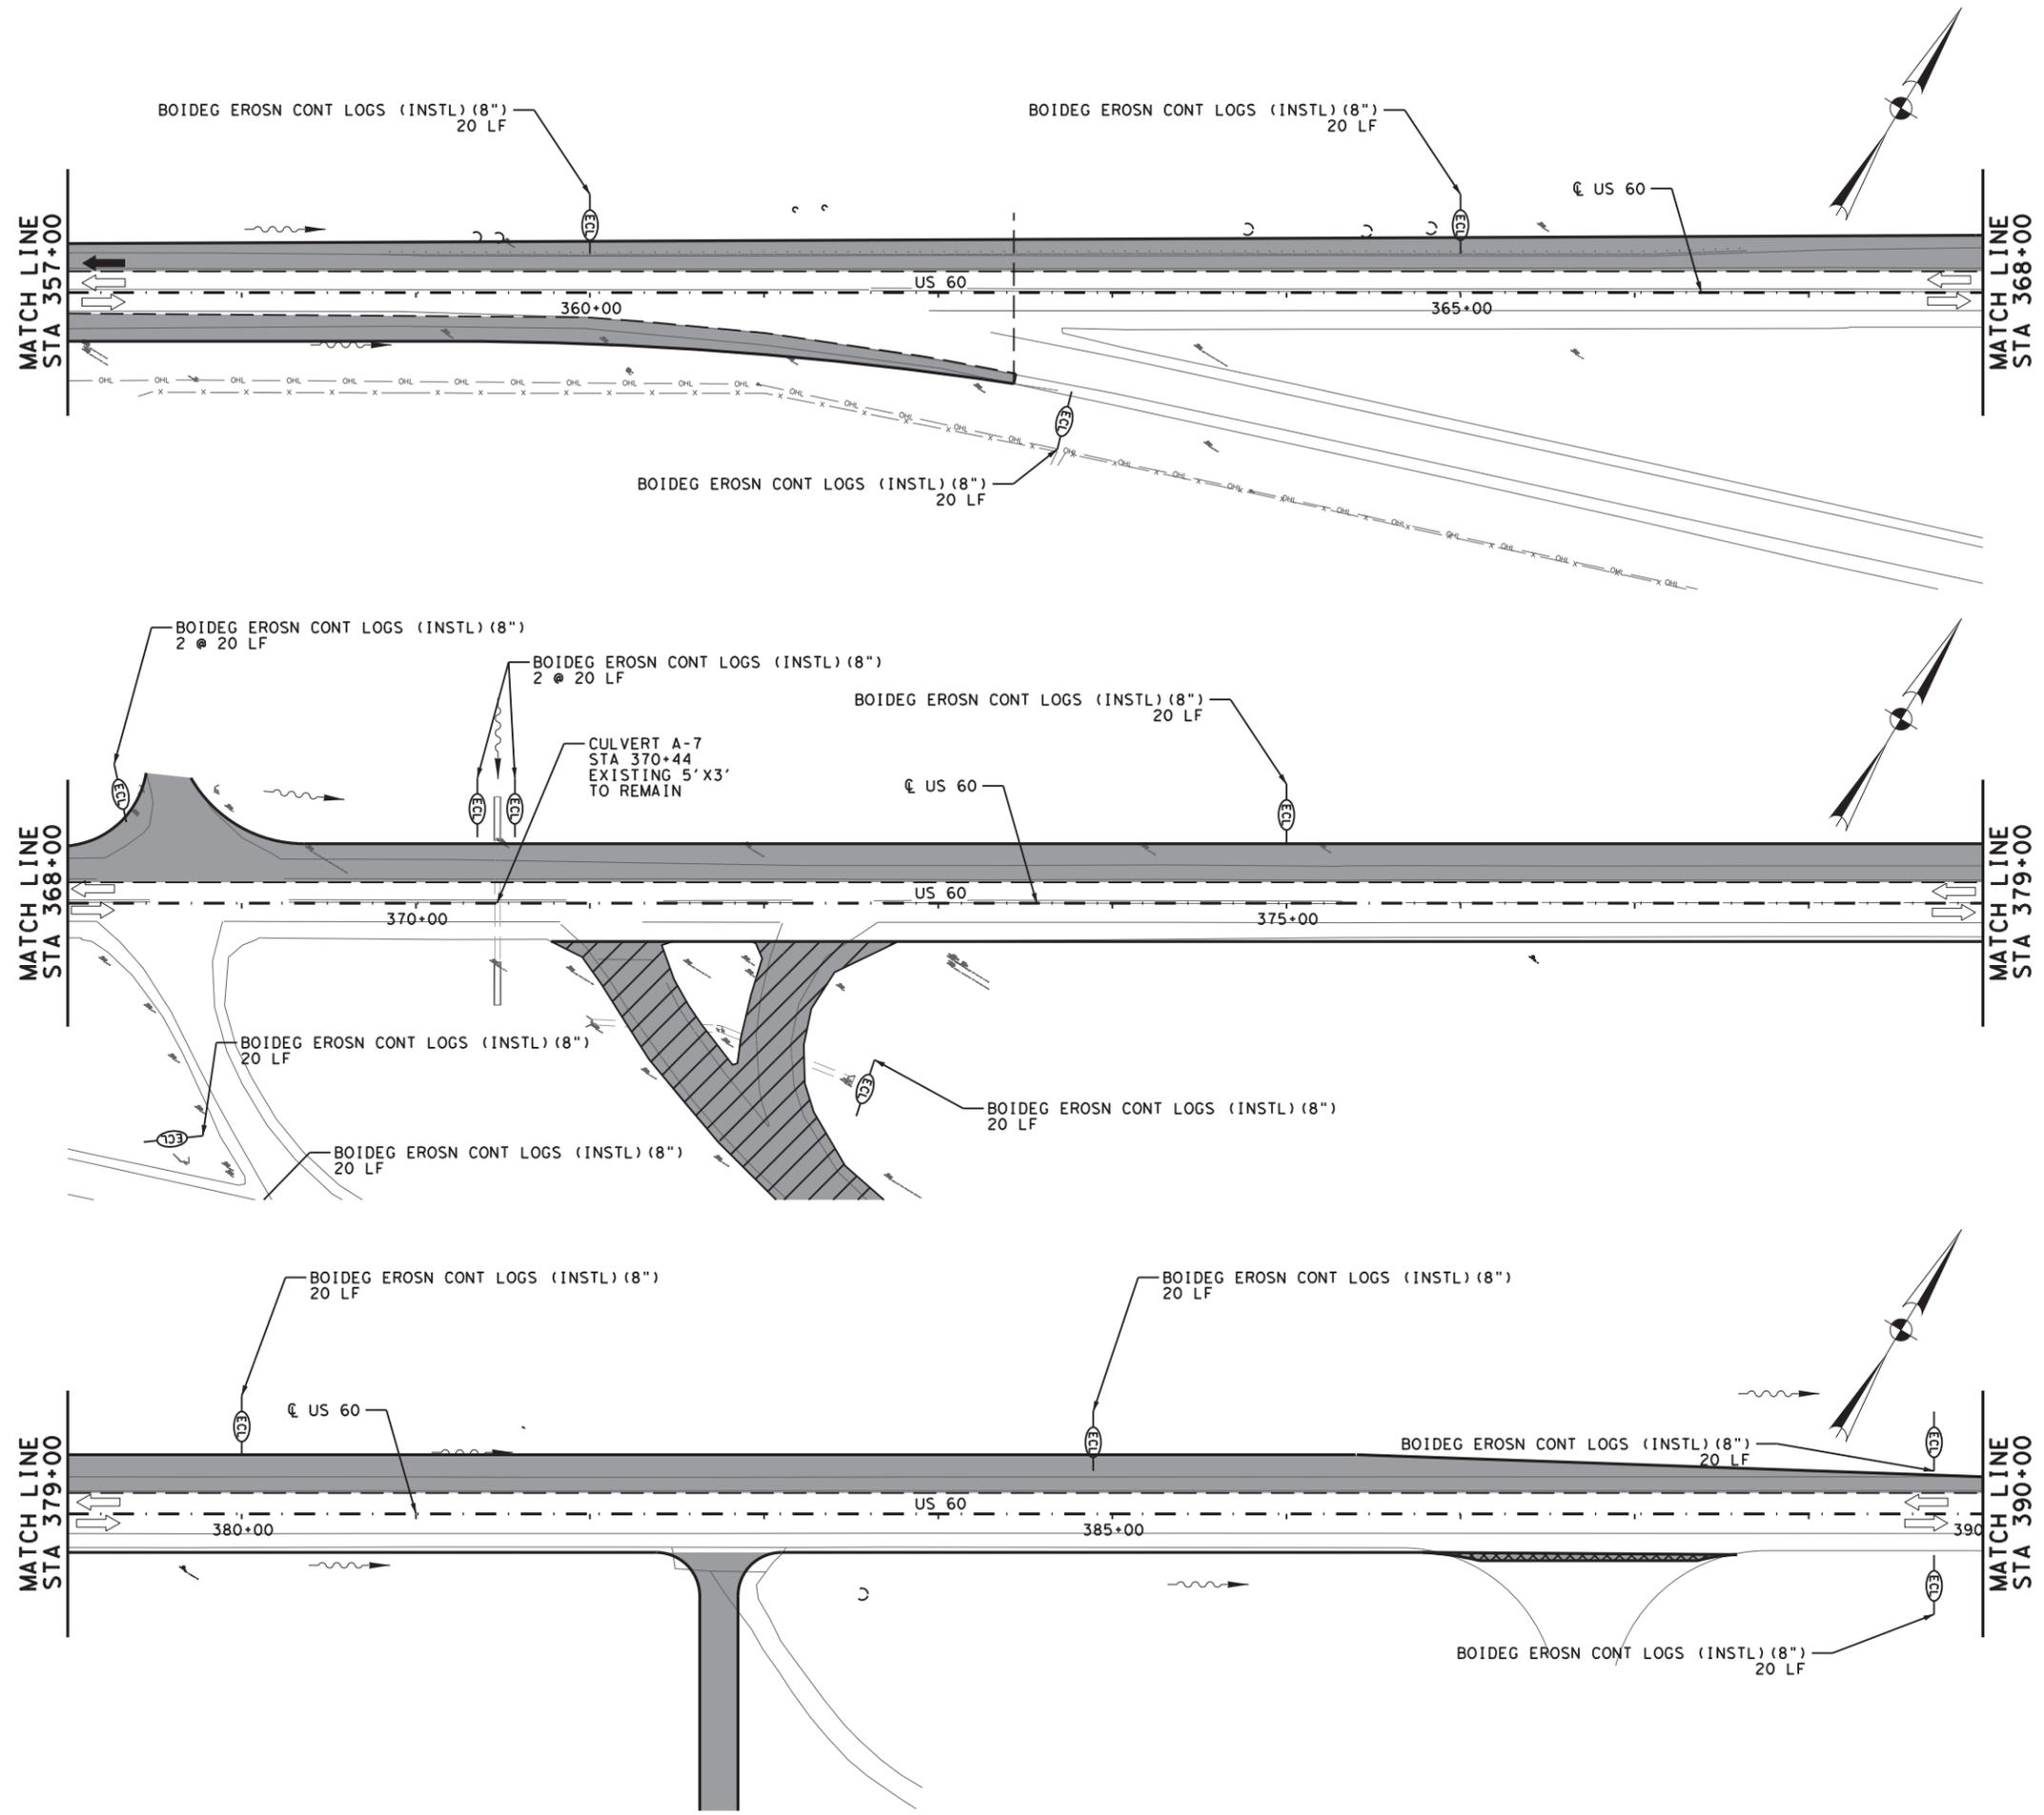

LEGEND

-  EROSION CONTROL LOG
-  FLOW
-  SOIL RETENTION BLANKET

04/07/2021



Bo L. Ratto

0 25 50 100
1" = 100'

REV. NO.	DATE	DESCRIPTION	BY

CobbFendley 13430 Northwest Freeway, Ste. 1100
Houston, Texas 77040
713.462.3242
www.cobbfendley.com


 **Texas Department of Transportation**

US 60
SW3P LAYOUT
STA 357+00 TO STA 390+00
SHEET 5 OF 12

FED. RD. DIV. NO.	STATE	PROJECT NO.		HIGHWAY NO.
6	TEXAS	(SEE TITLE SHEET)		US60
STATE DISTRICT	COUNTY	CONTROL NO.	SECTION NO.	JOB NO.
AMA	GRAY	0169	07	053, ETC
				SHEET NO.
				257

US60-EN-SW3P-05.dgn

4/7/2021 7:28:47 AM F:\P\0\jcd\2019\1004_Tx\DOT_3x5_PSS\03_US60_Am\1161616\US60\USTN\SII_4-En\Inventor\02-Sheet\US60_SW3P-06.dgn

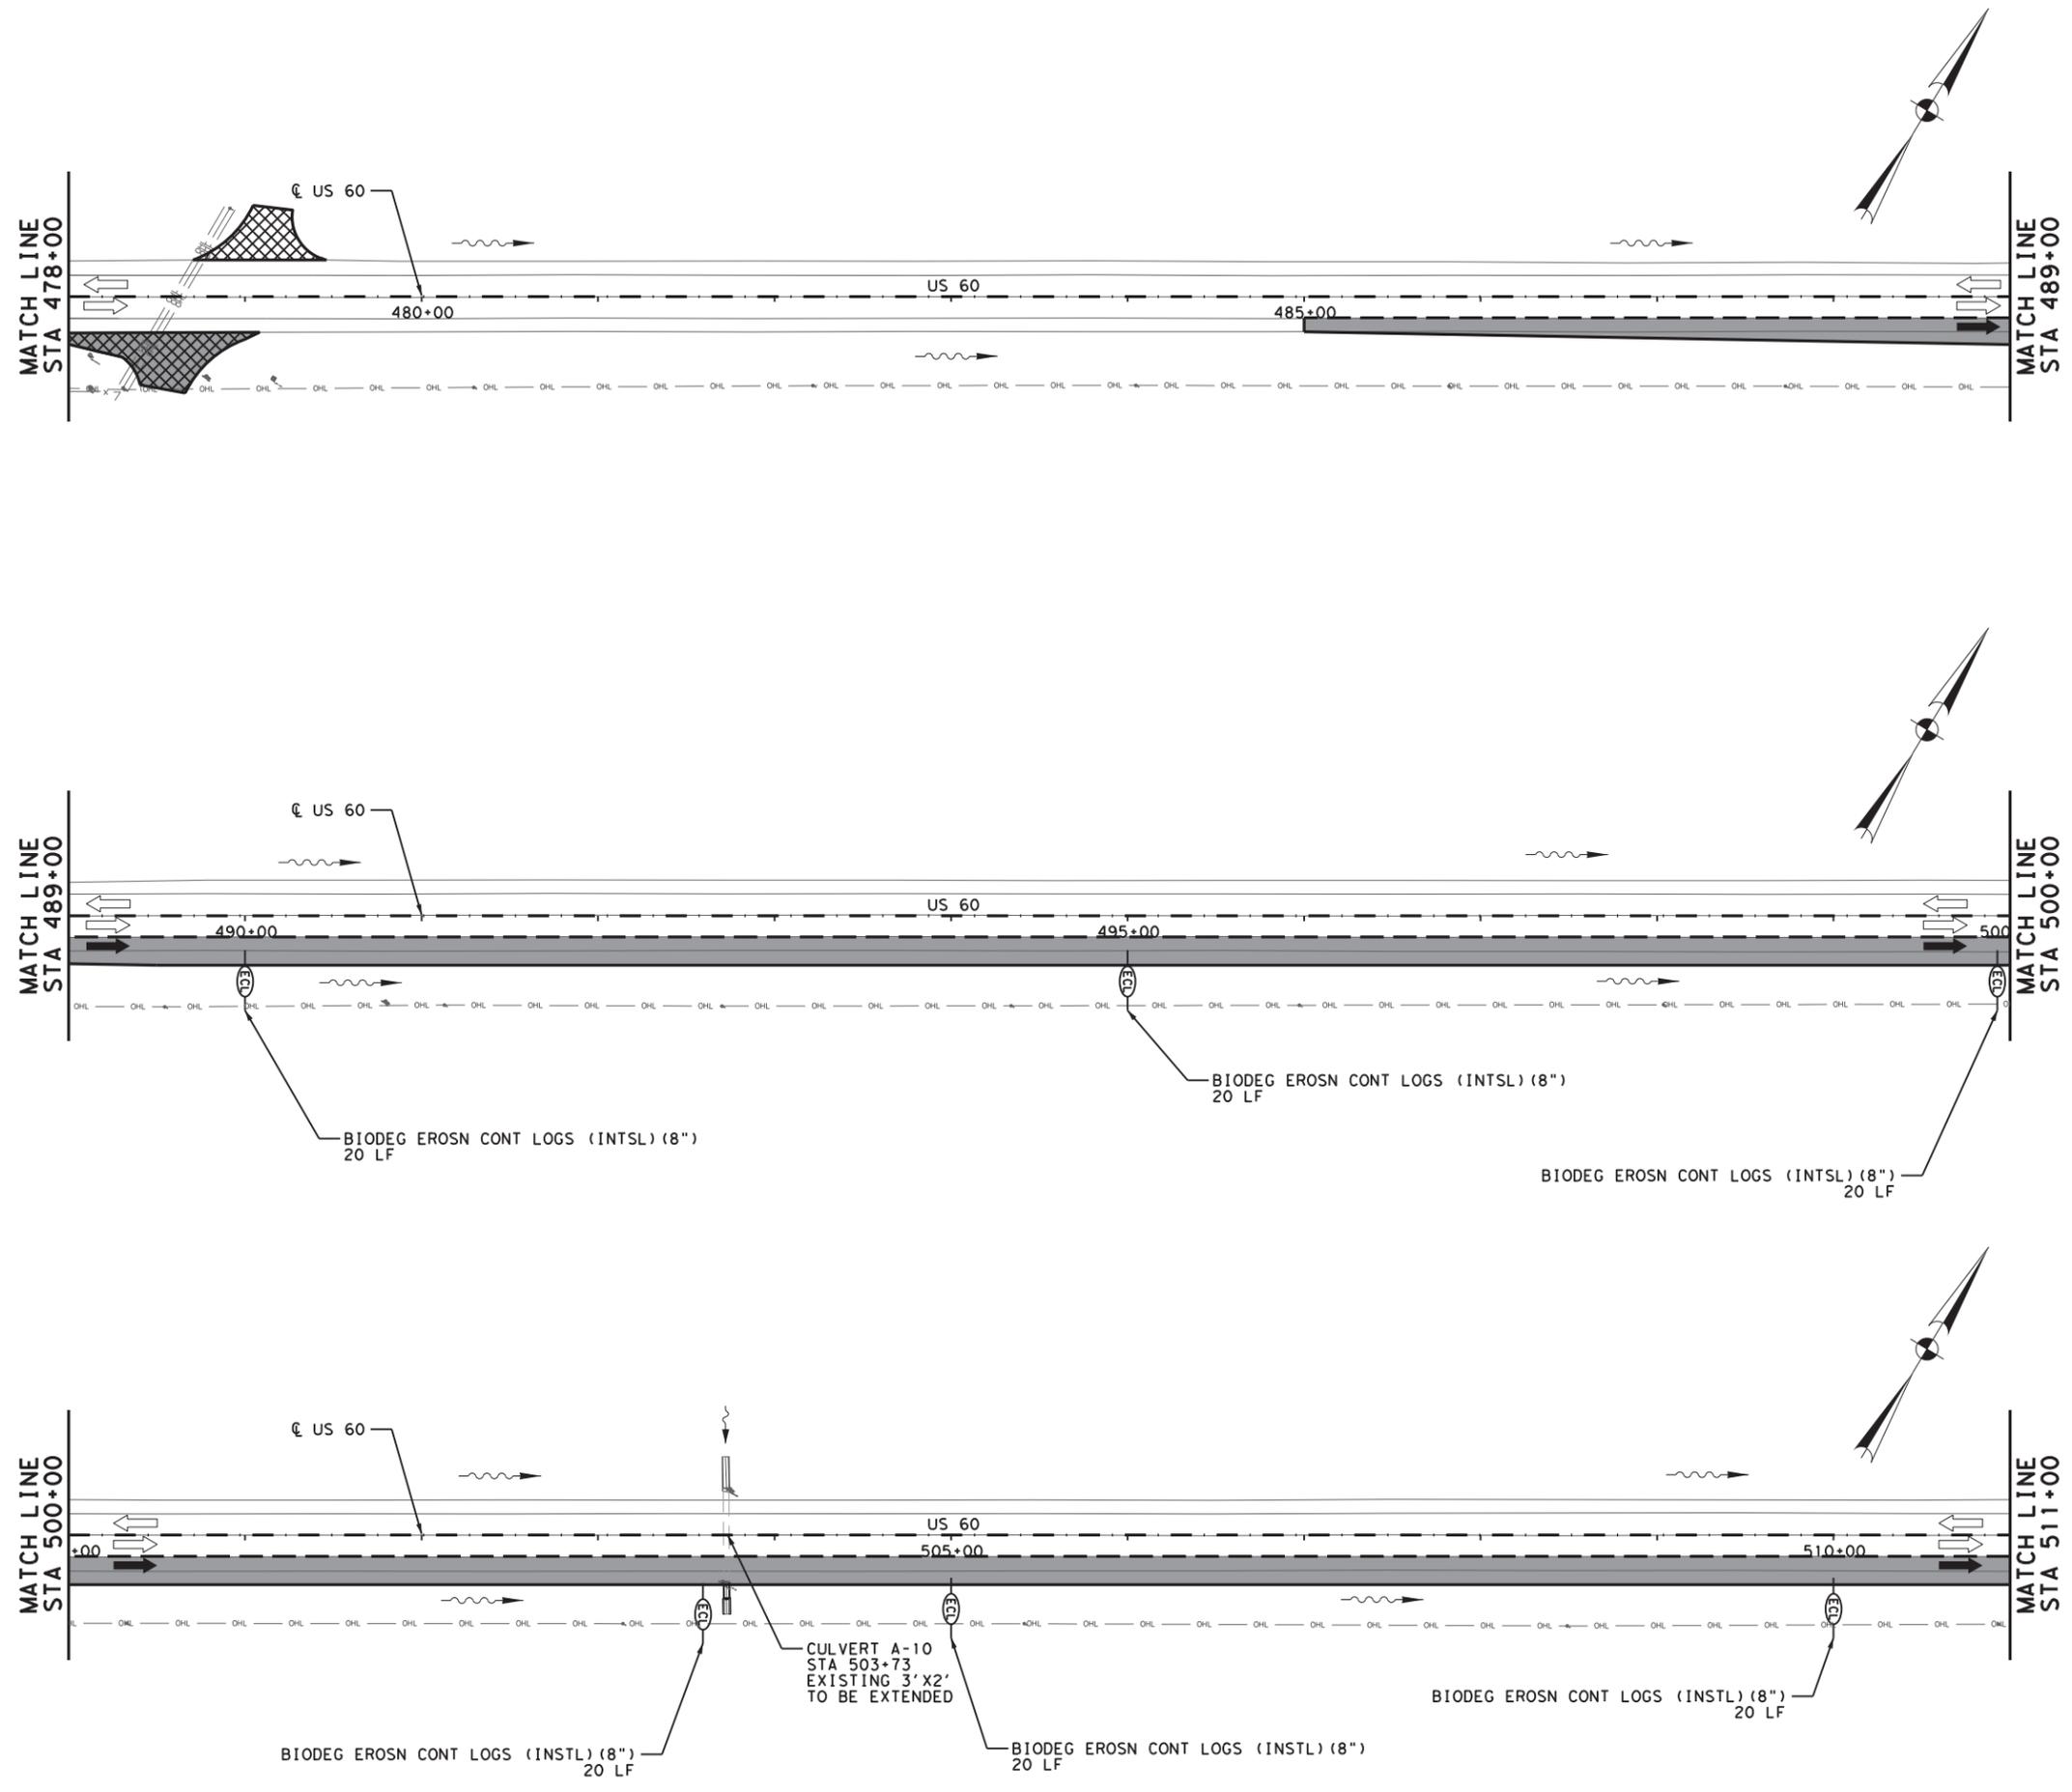

LEGEND

	EROSION CONTROL LOG
	FLOW
	SOIL RETENTION BLANKET

04/07/2021

Bo L. Ratto

0 25 50 100
1" = 100'

REV. NO.	DATE	DESCRIPTION	BY

CobbFendley 13430 Northwest Freeway, Ste. 1100
Houston, Texas 77040
713.462.3242
www.cobbfendley.com




US 60
SW3P LAYOUT
STA 478+00 TO STA 511+00
SHEET 6 OF 12

FED. RD. DIV. NO.	STATE	PROJECT NO.		HIGHWAY NO.	
6	TEXAS	(SEE TITLE SHEET)		US60	
STATE DISTRICT	COUNTY	CONTROL NO.	SECTION NO.	JOB NO.	SHEET NO.
AMA	GRAY	0169	07	053, ETC	258

US60-ENV-SW3P-06.dgn

4/7/2021 7:28:48 AM F:\P\Projects\2019\1004_TxDOT_SW3P_US60_Amendment\02_Sheets\US60_SW3P-07.dgn

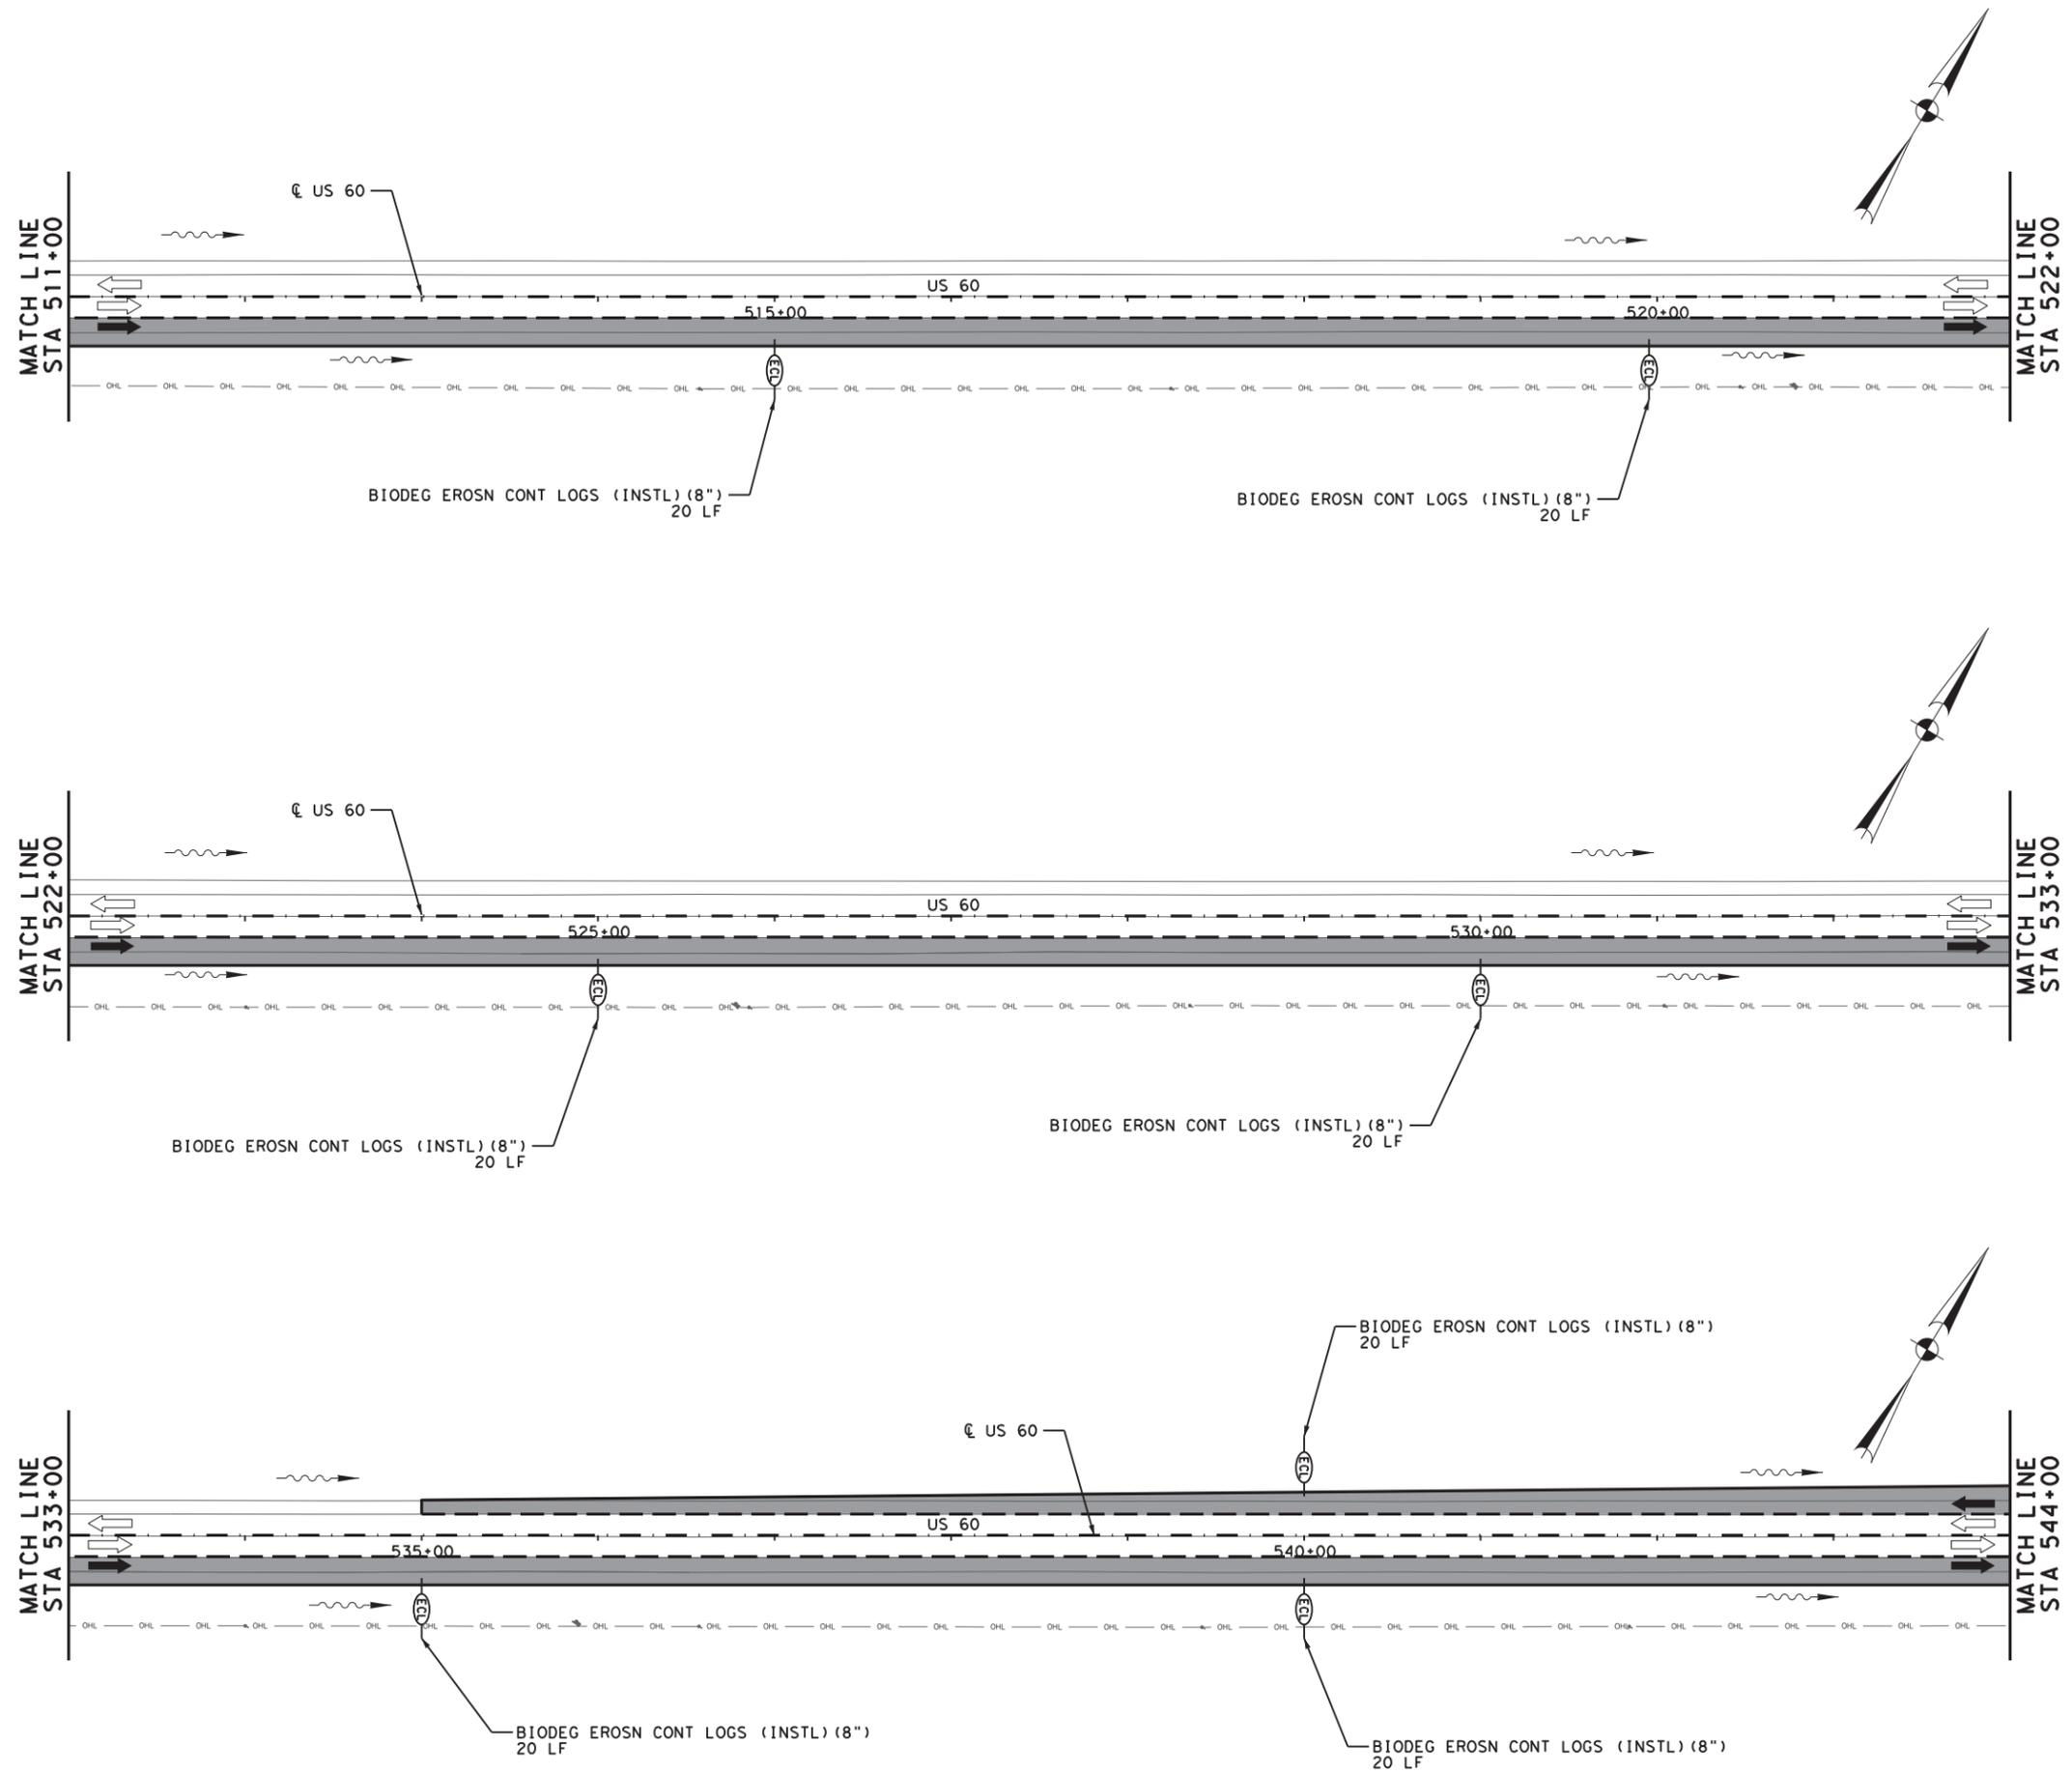

LEGEND

- EROSION CONTROL LOG
- FLOW
- SOIL RETENTION BLANKET

04/07/2021

Bo L. Ratto

0 25 50 100
1" = 100'

REV. NO.	DATE	DESCRIPTION	BY

CobbFendley 13430 Northwest Freeway, Ste. 1100
Houston, Texas 77040
713.462.3242
www.cobbfendley.com


Texas Department of Transportation

US 60
SW3P LAYOUT
STA 511+00 TO STA 544+00
SHEET 7 OF 12

FED. RD. DIV. NO.	STATE	PROJECT NO.	HIGHWAY NO.
6	TEXAS	(SEE TITLE SHEET)	US60
STATE DISTRICT	COUNTY	CONTROL NO.	SECTION NO.
AMA	GRAY	0169	07
			JOB SHEET NO.
			053, ETC 259

US60-ENV-SW3P-07.dgn

4/7/2021 7:28:49 AM F:\P\0\jcd\2019\1004_Tx\DOT_5x5_P5&E\03_US60_Am\1161616\6500\UST\N\511_4-E\in\tr\m\m\h\02-Sheet\US60_ENW_SW3P-08.dgn

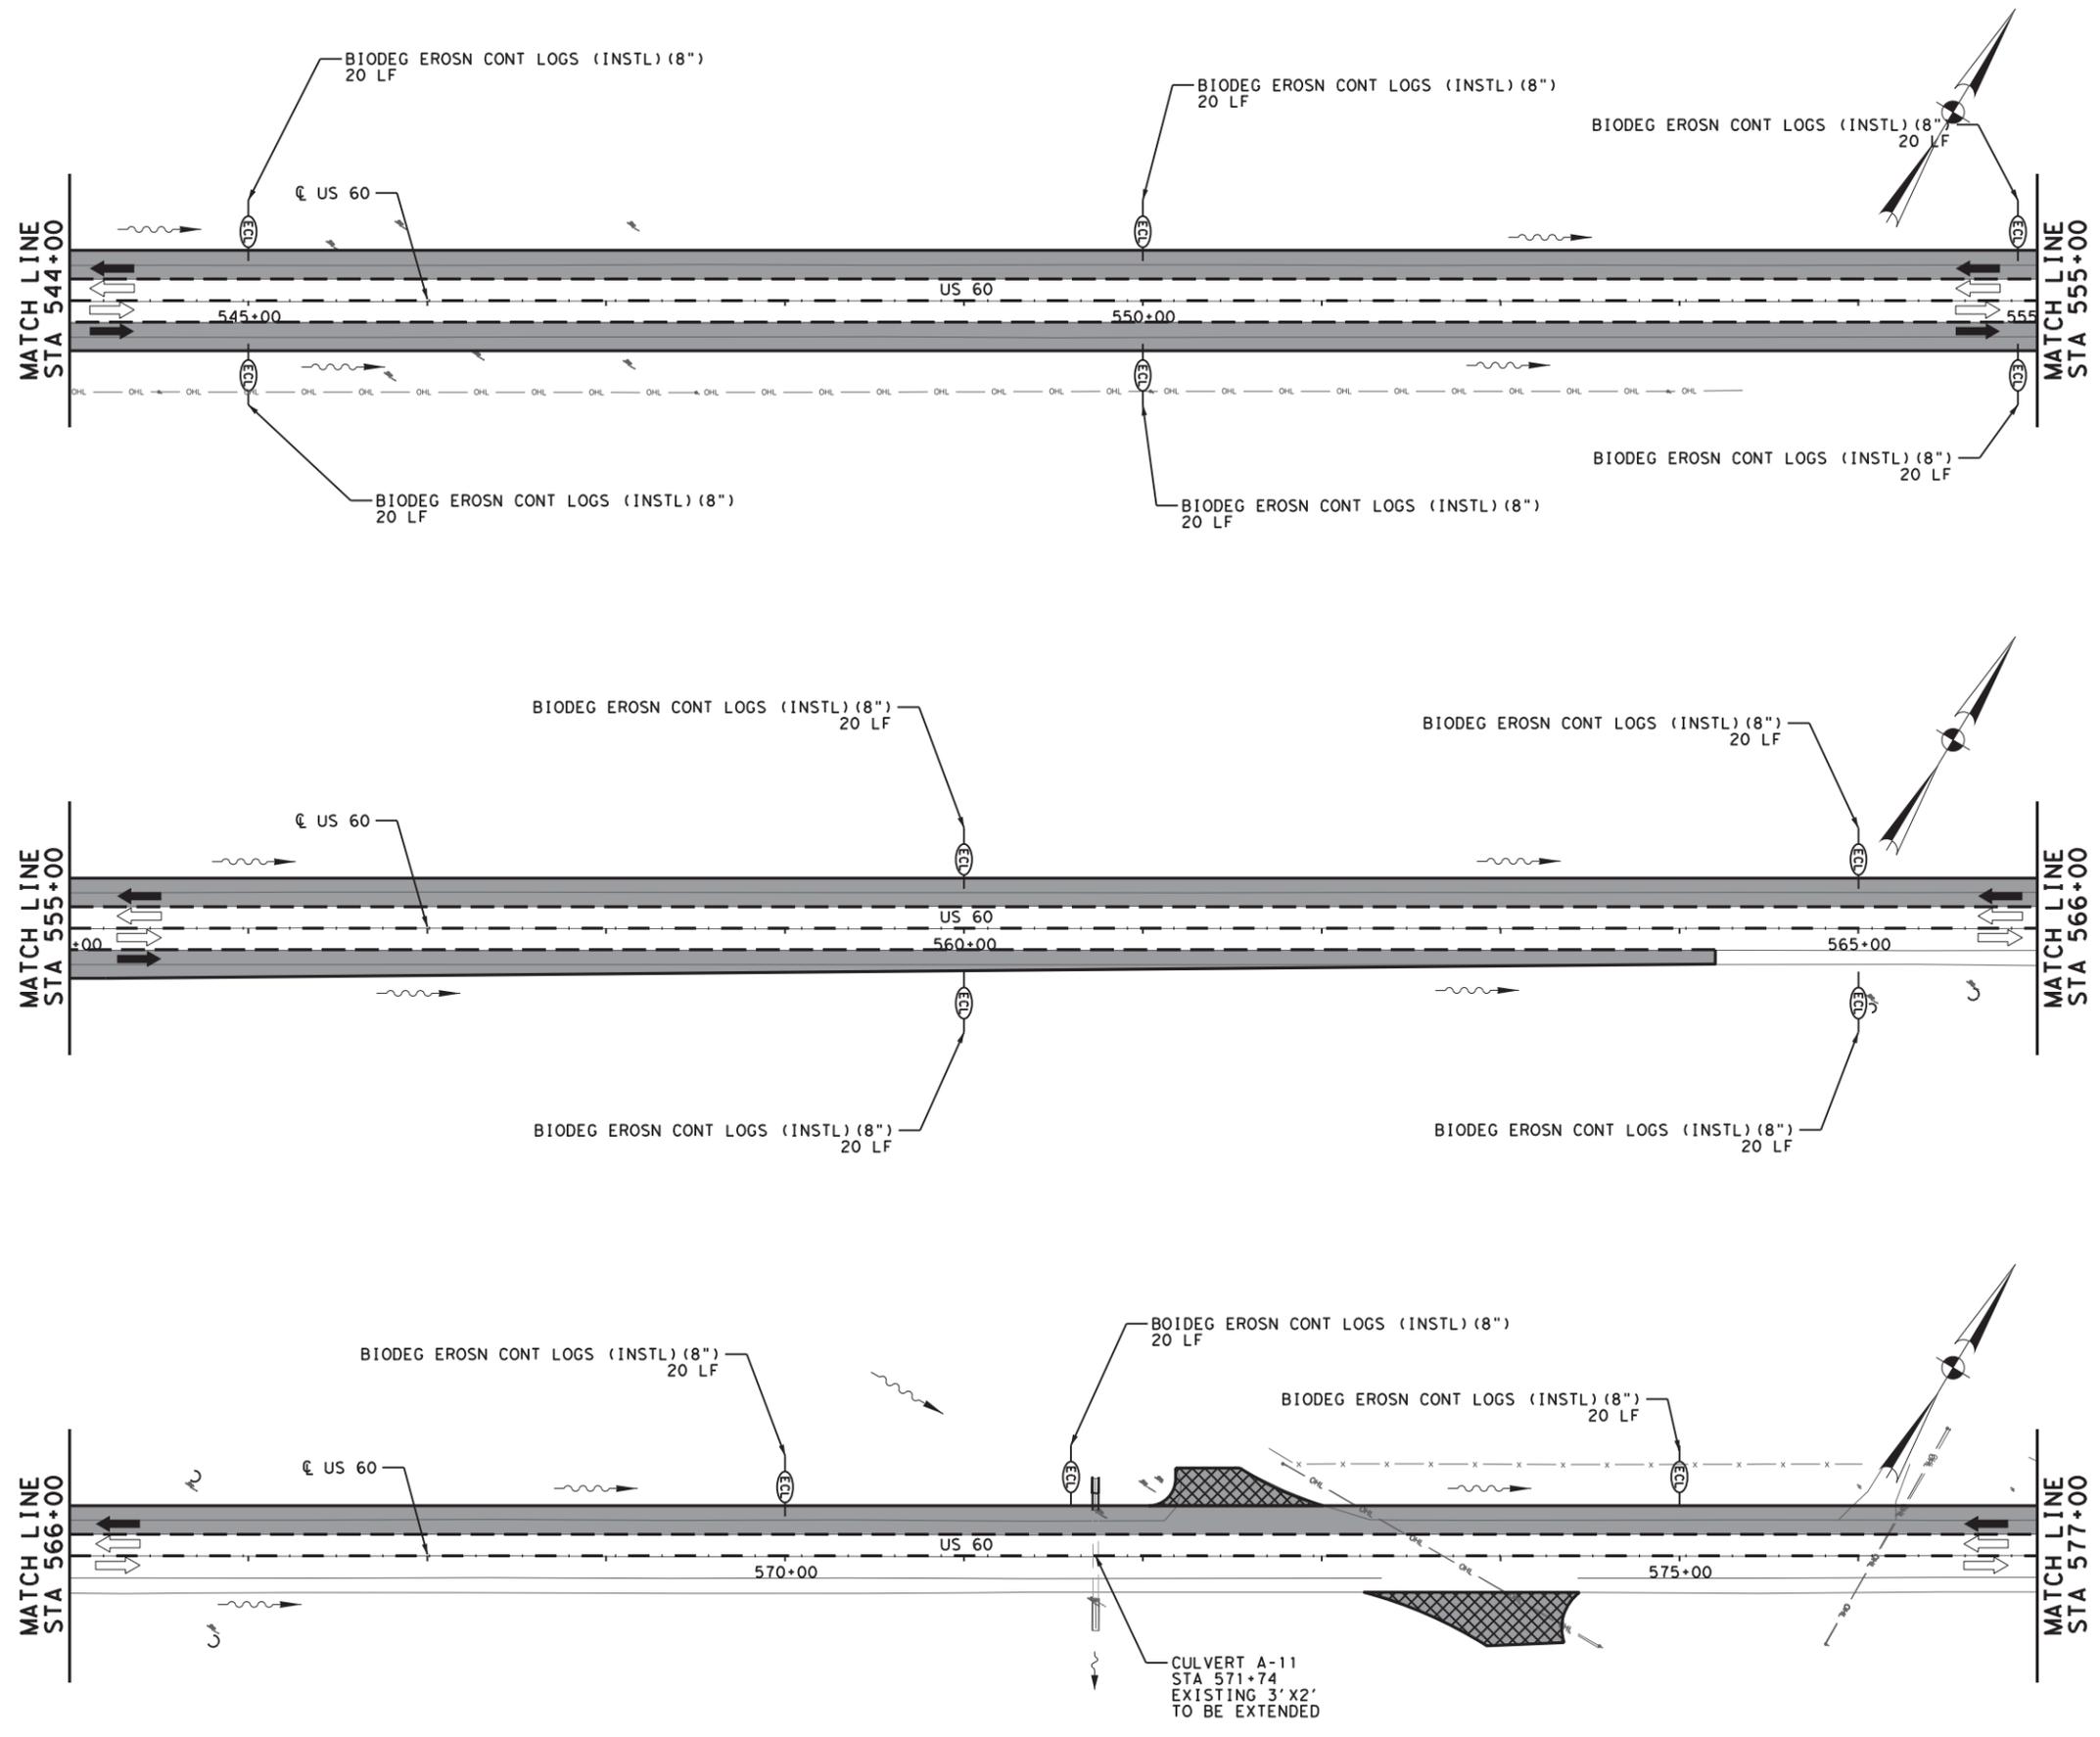

04/07/2021

Bo L. Ratto

0 25 50 100
1" = 100'

REV. NO.	DATE	DESCRIPTION	BY

CobbFendley 13430 Northwest Freeway, Ste. 1100
Houston, Texas 77040
713.462.3242
www.cobbfendley.com

Texas Department of Transportation


**US 60
SW3P LAYOUT
STA 544+00 TO STA 577+00**

SHEET 8 OF 12

FED. RD. DIV. NO.	STATE	PROJECT NO.	HIGHWAY NO.
6	TEXAS	(SEE TITLE SHEET)	US60
STATE DISTRICT	COUNTY	CONTROL NO.	SECTION NO.
AMA	GRAY	0169	07
		JOB NO.	SHEET NO.
		053, ETC	260

US60-ENW-SW3P-08.dgn

4/7/2021 7:28:50 AM F:\P\0\004\2019\1004_Tx\DOT_03_PSS&E\03_US60_Am\1161616\000\UST\N\11.4-En\1\161616\000\02-Sheet\US60_EN\SW3P-09.dgn

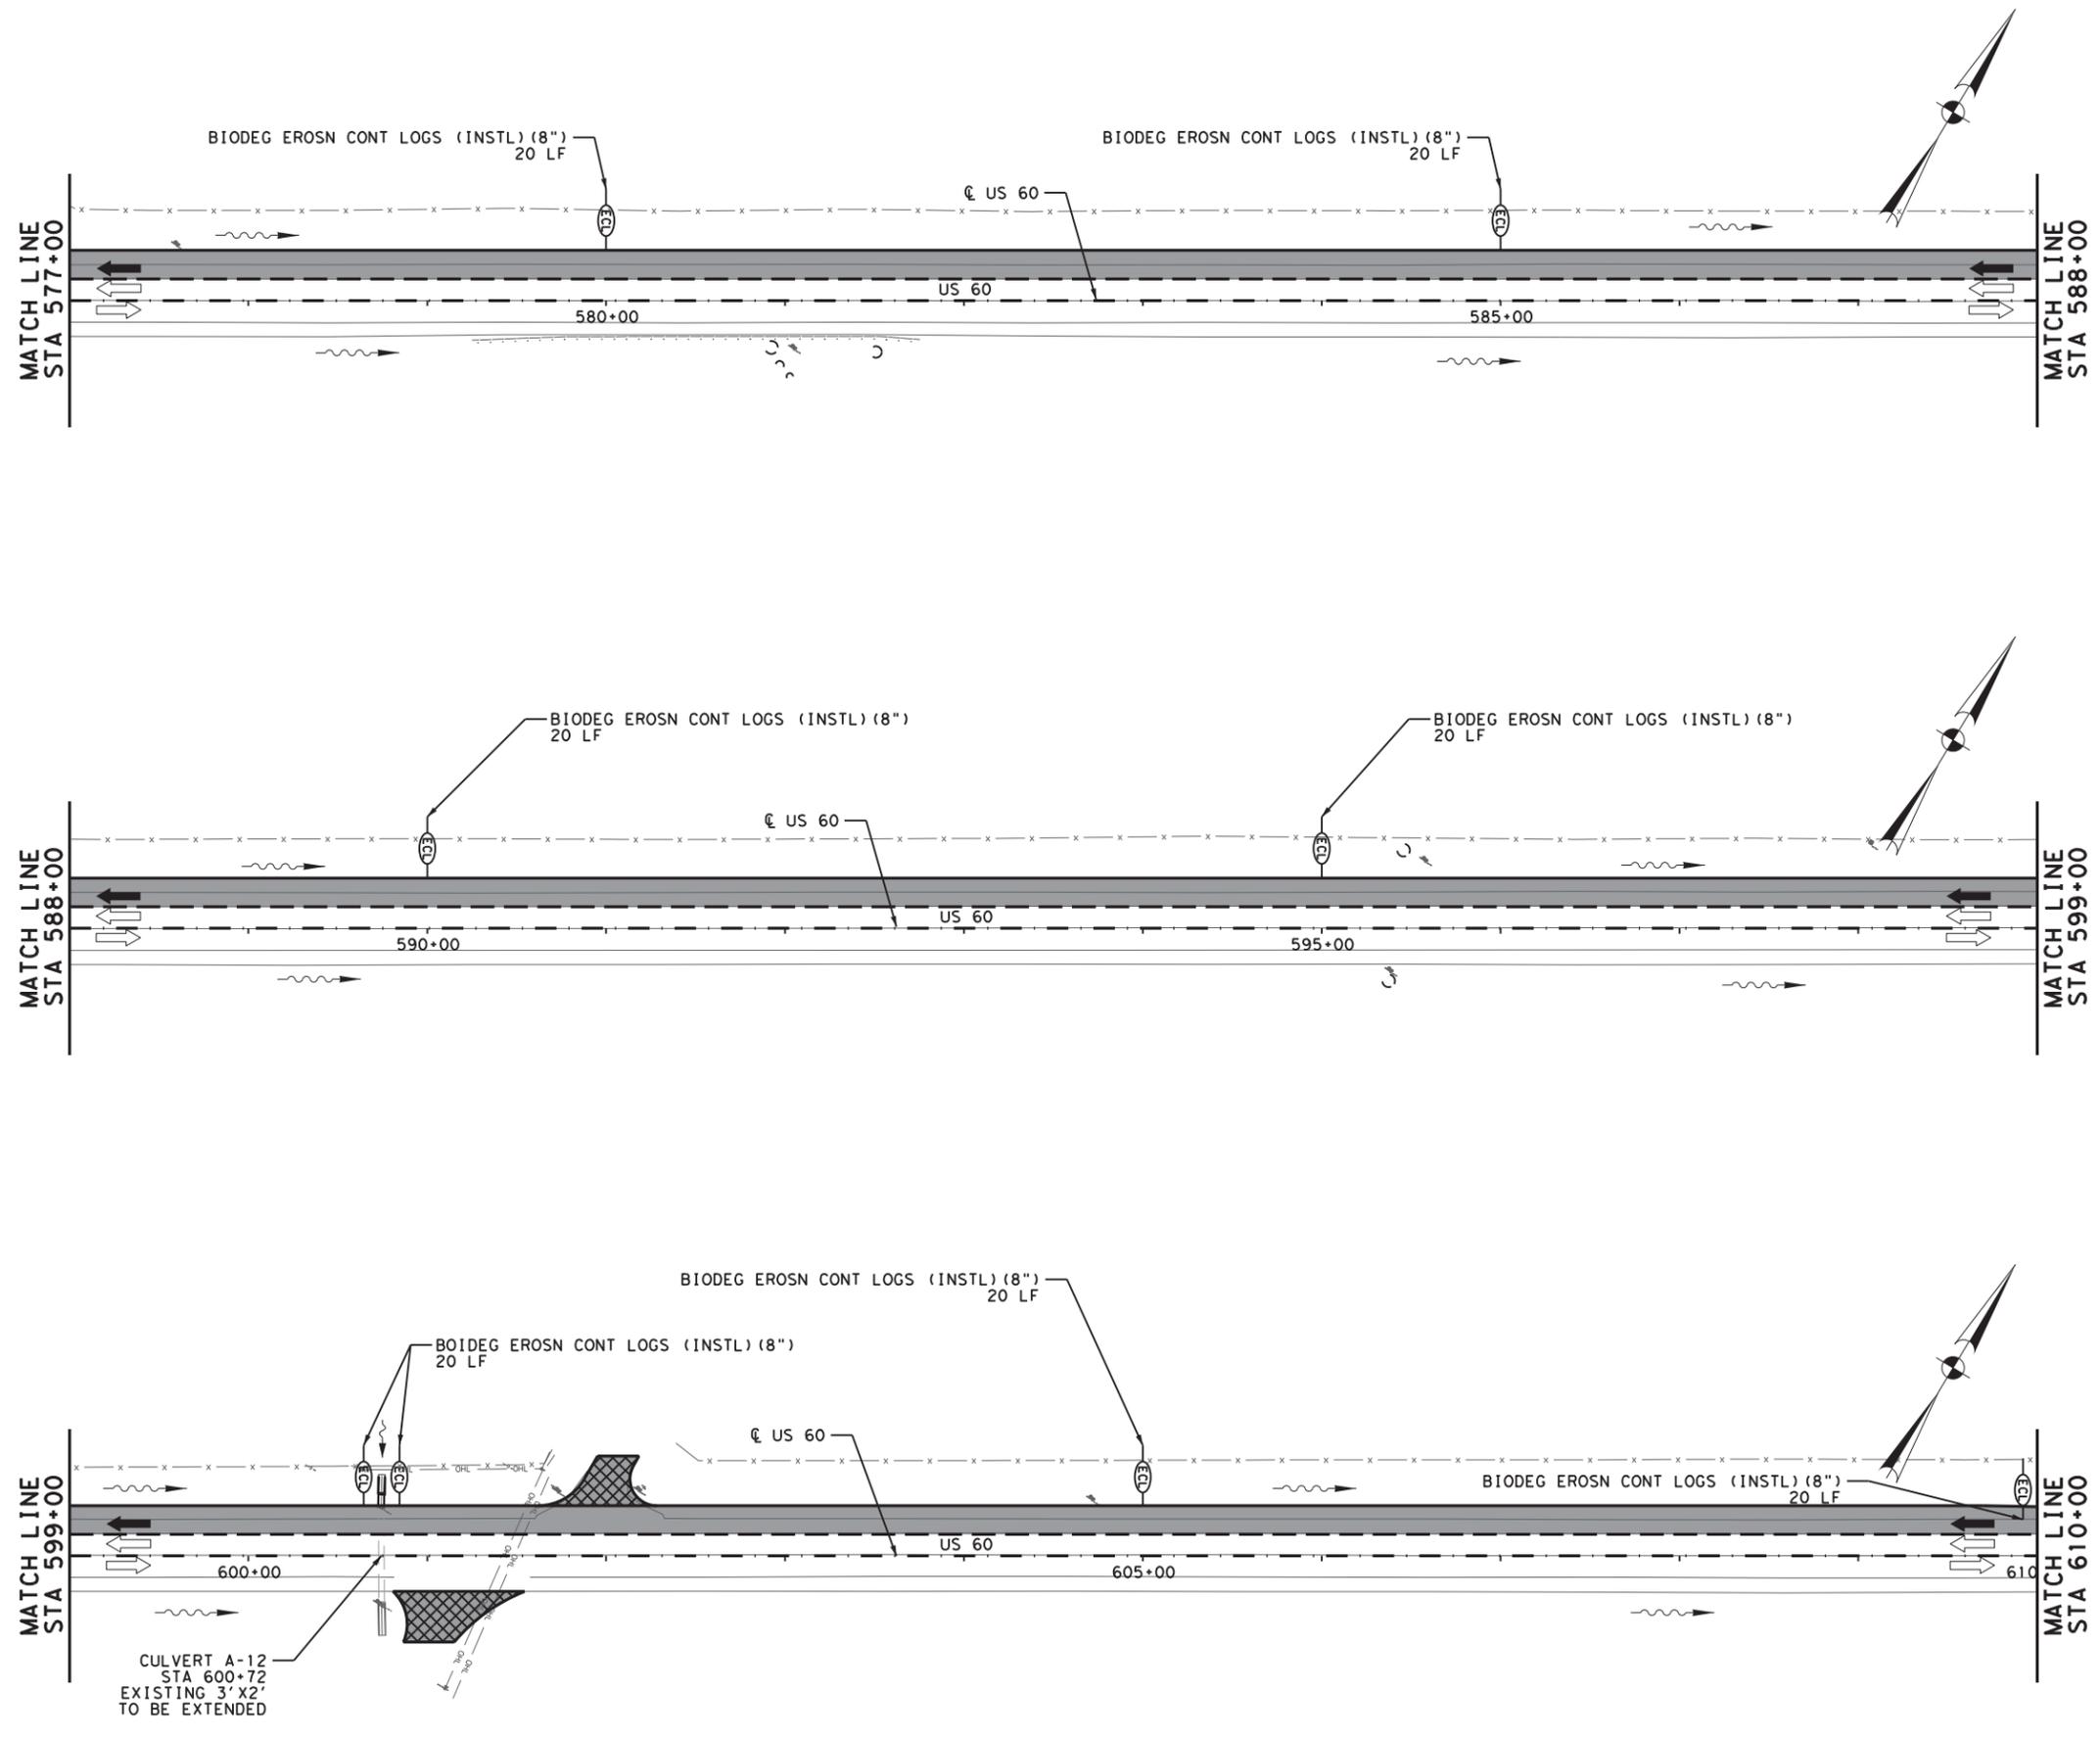

LEGEND

- EROSION CONTROL LOG
- FLOW
- SOIL RETENTION BLANKET

04/07/2021

Bo L. Ratto

0 25 50 100
1" = 100'

REV. NO.	DATE	DESCRIPTION	BY

CobbFendley 13430 Northwest Freeway, Ste. 1100
Houston, Texas 77040
713.462.3242
www.cobbfendley.com




US 60
SW3P LAYOUT
STA 577+00 TO STA 610+00

SHEET **9** OF **12**

FED. RD. DIV. NO.	STATE	PROJECT NO.		HIGHWAY NO.
6	TEXAS	(SEE TITLE SHEET)		US60
STATE DISTRICT	COUNTY	CONTROL NO.	SECTION NO.	JOB NO.
AMA	GRAY	0169	07	053, ETC
				SHEET NO.
				261

US60-EN-SW3P-09.dgn

4/7/2021 7:28:52 AM F:\Proj\689-731\689-731_SW3P\03_US60_Amendment\02_Sheets\US60_ENV_SW3P-11.dgn

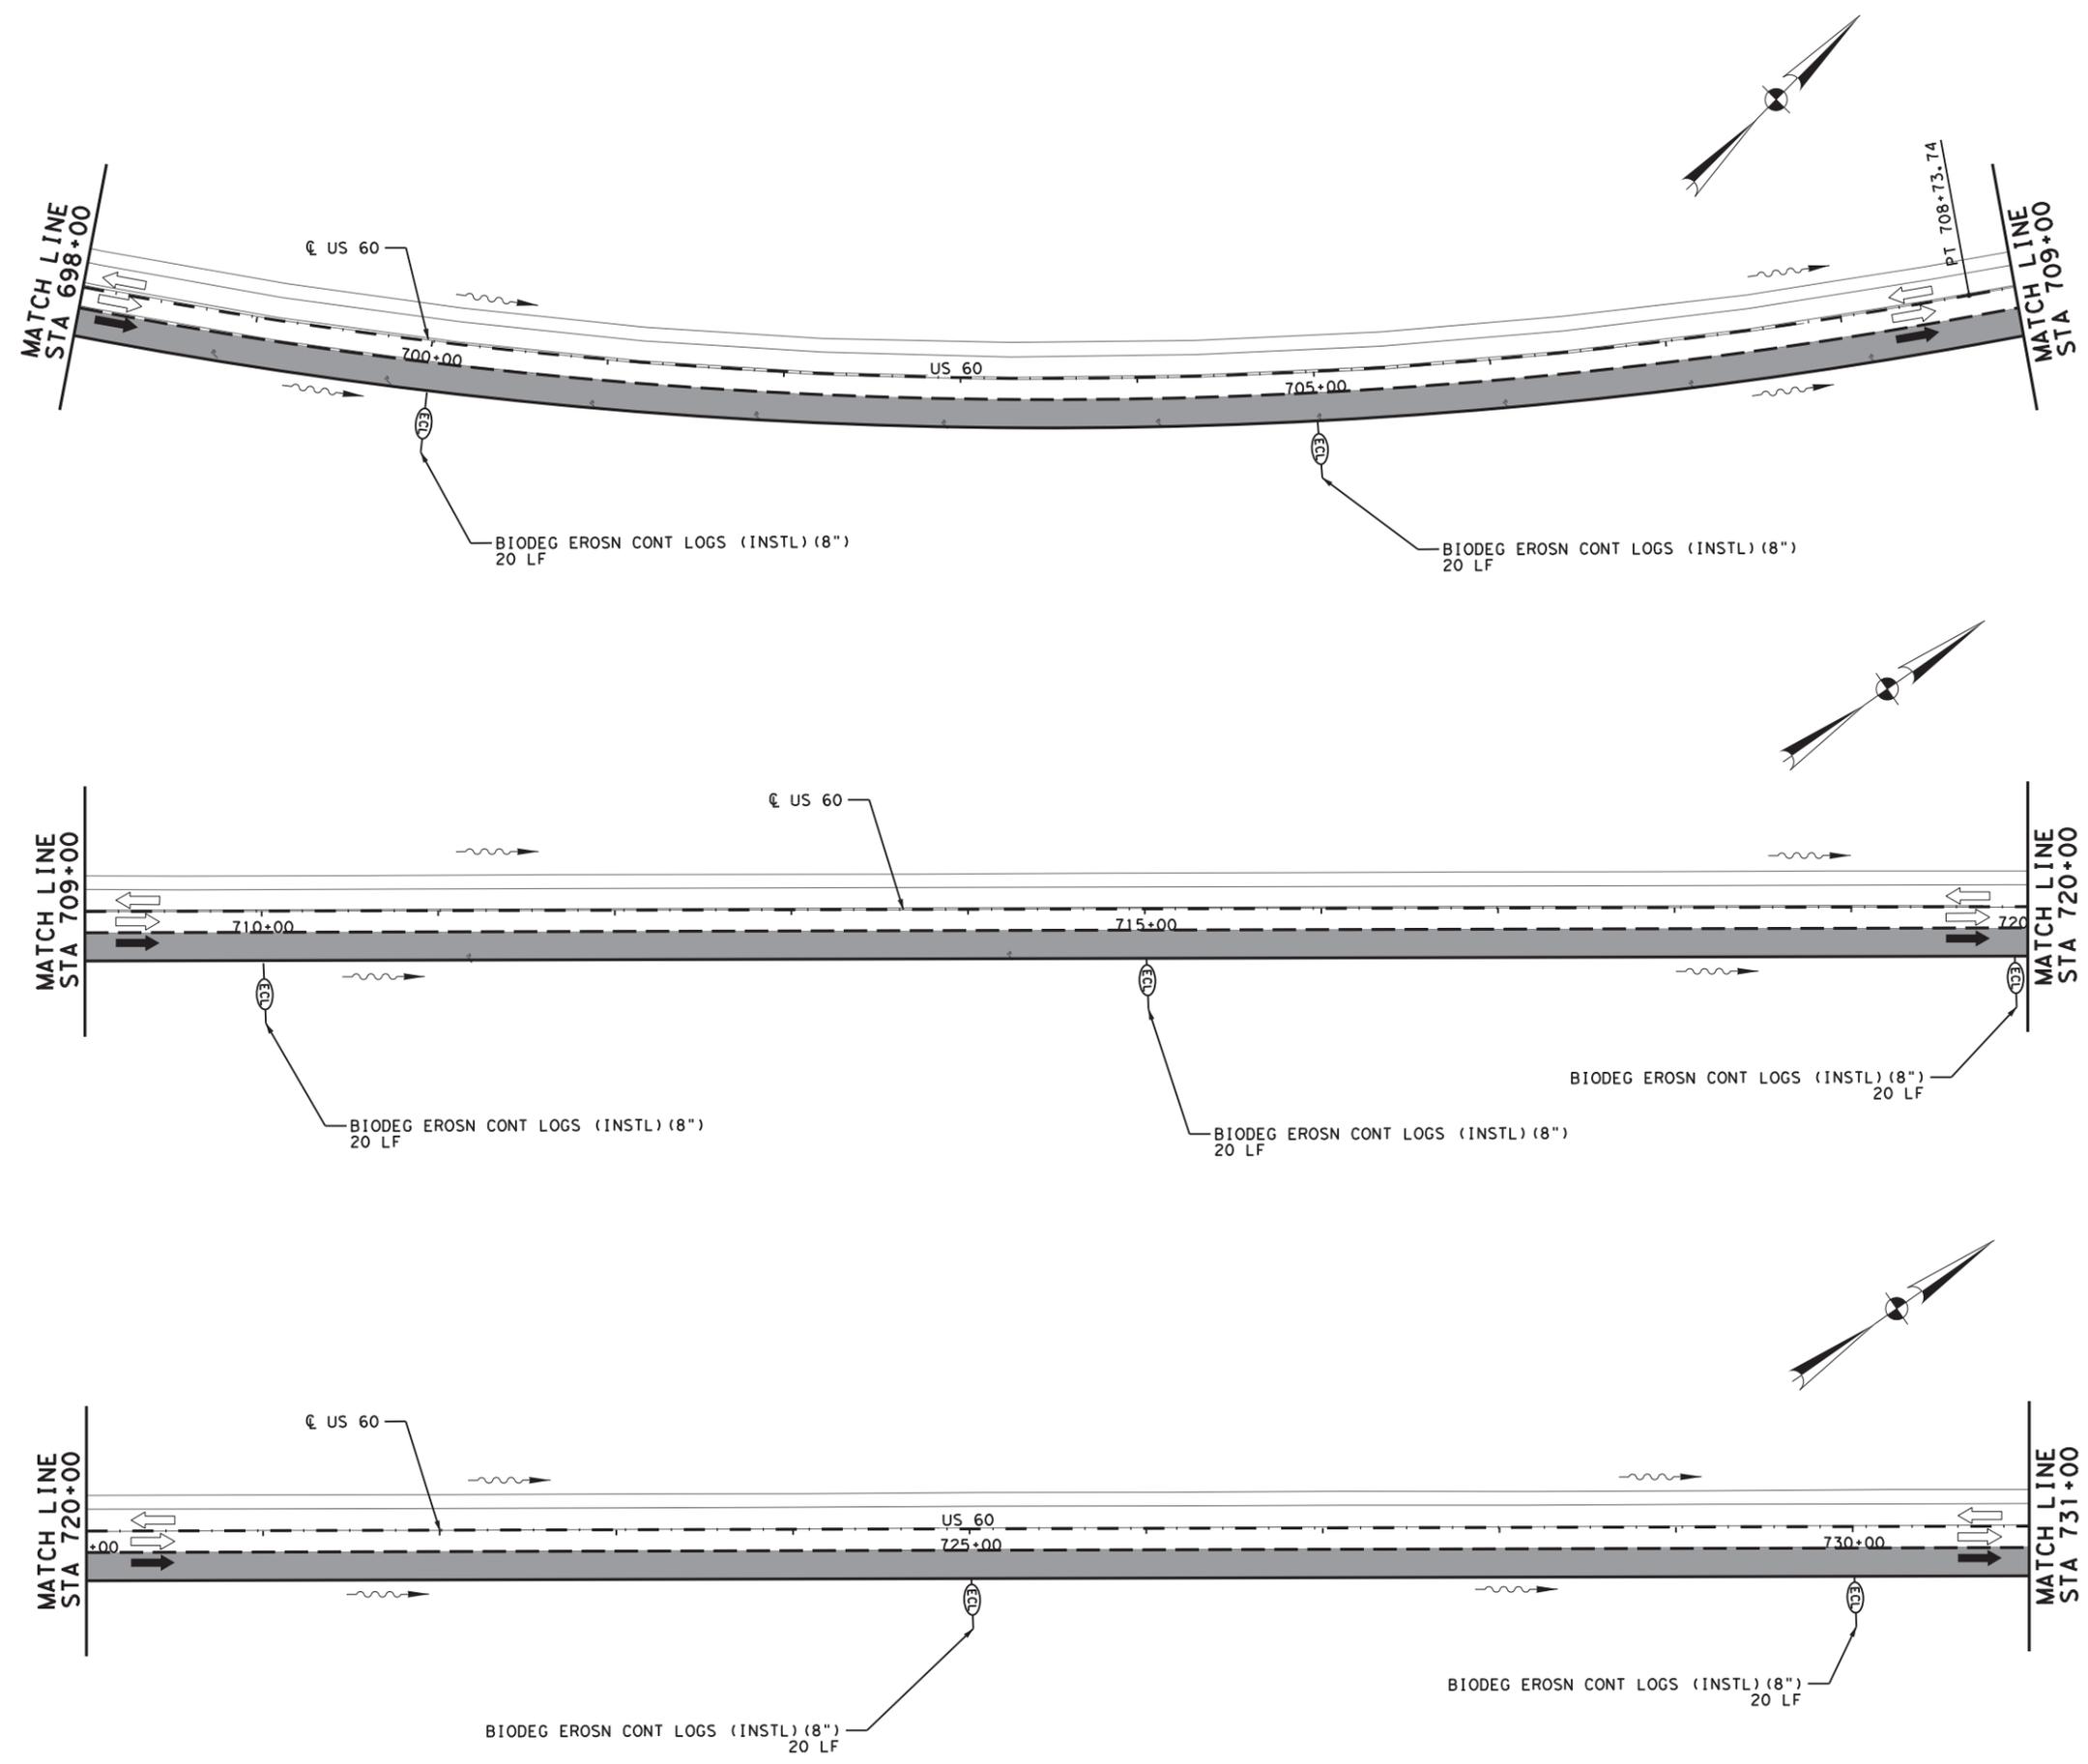

LEGEND

- EROSION CONTROL LOG
- FLOW
- SOIL RETENTION BLANKET

04/07/2021

Bo L. Ratto

0 25 50 100
1" = 100'

REV. NO.	DATE	DESCRIPTION	BY

CobbFendley 13430 Northwest Freeway, Ste. 1100
Houston, Texas 77040
713.462.3242
www.cobbhendley.com




US 60
SW3P LAYOUT
STA 689+00 TO STA 731+00
SHEET 11 OF 12

FED. RD. DIV. NO.	STATE	PROJECT NO.	HIGHWAY NO.
6	TEXAS	(SEE TITLE SHEET)	US60
STATE DISTRICT	COUNTY	CONTROL NO.	SECTION NO.
AMA	GRAY	0169	07
			JOB NO.
			053, ETC
			SHEET NO.
			263

US60-ENV-SW3P-11.dgn

4/7/2021 7:28:53 AM F:\Proj\162019\1004_TxDOT_DxL_P56E\03_US60_Amendment\162019\1004_US60_SW3P-12.dgn

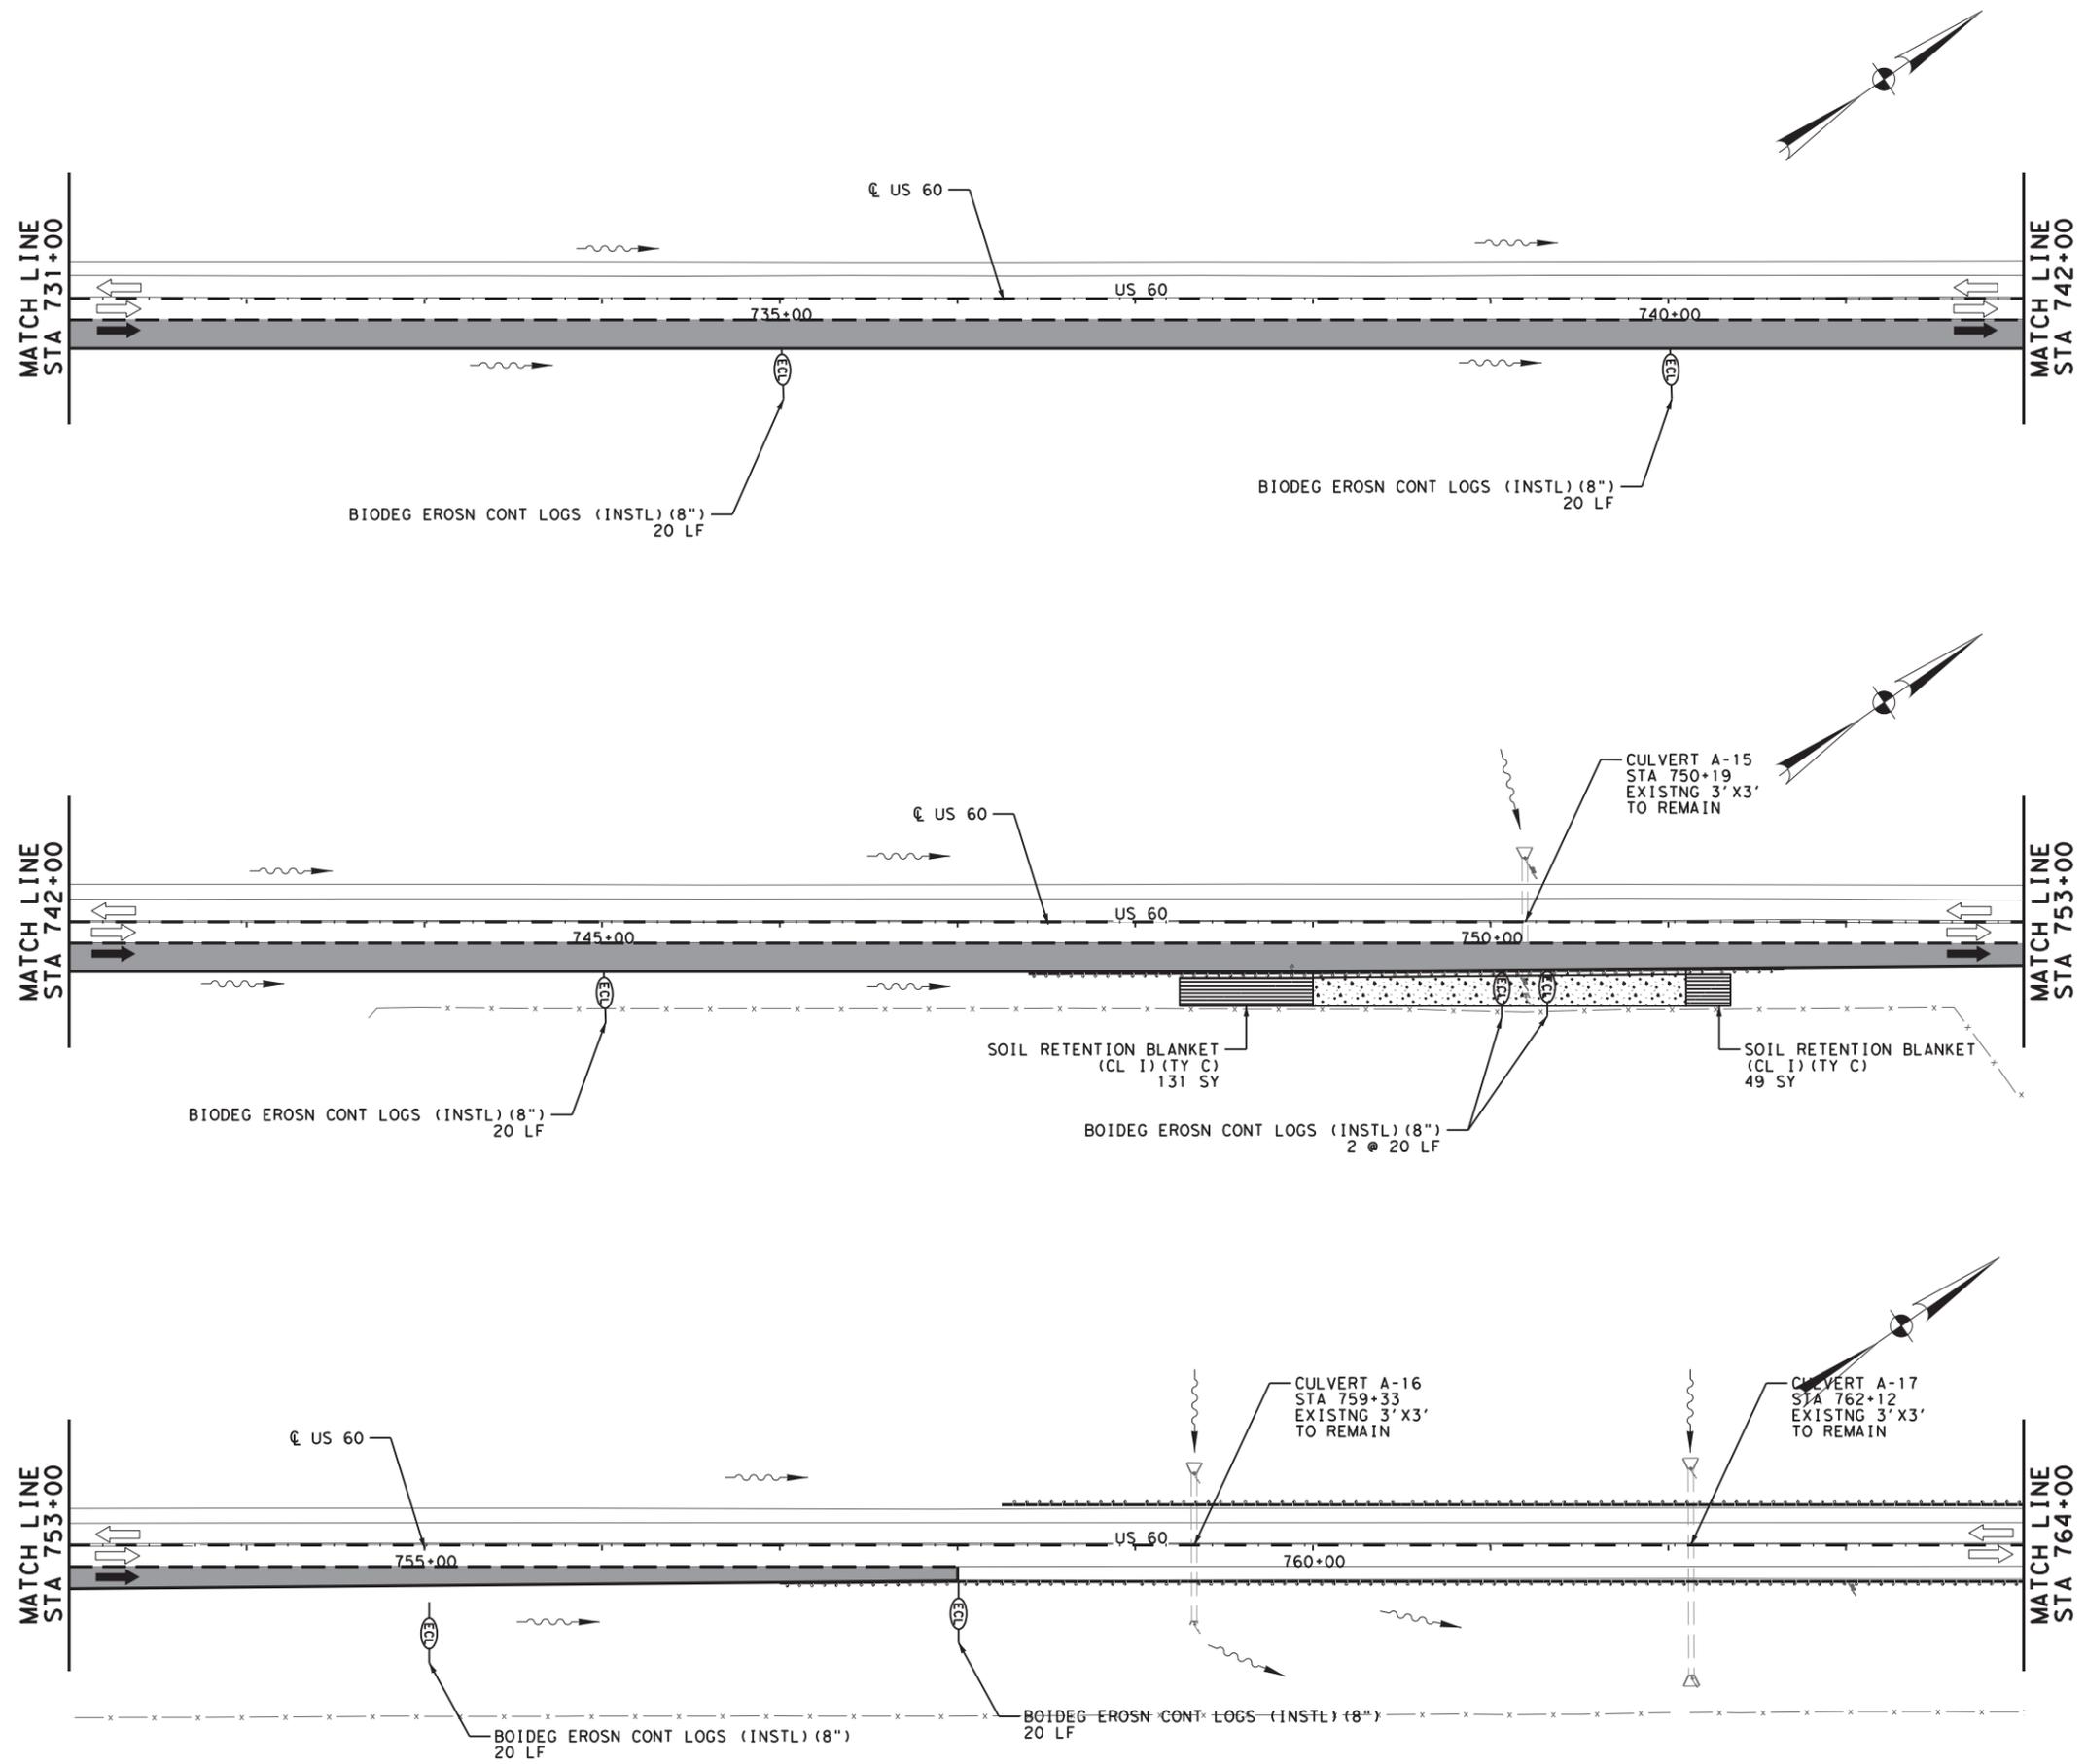

LEGEND

- EROSION CONTROL LOG
- FLOW
- SOIL RETENTION BLANKET

04/07/2021

Bo L. Ratto

0 25 50 100
1" = 100'

REV. NO.	DATE	DESCRIPTION	BY

CobbFendley 13430 Northwest Freeway, Ste. 1100
Houston, Texas 77040
713.462.3242
www.cobbfendley.com




US 60
SW3P LAYOUT
STA 731+00 TO STA 764+00
 SHEET 12 OF 12

FED. RD. DIV. NO.	STATE	PROJECT NO.		HIGHWAY NO.
6	TEXAS	(SEE TITLE SHEET)		US60
STATE DISTRICT	COUNTY	CONTROL NO.	SECTION NO.	JOB NO.
AMA	GRAY	0169	07	053, ETC
				SHEET NO. 264


US60-ENV-SW3P-12.dgn

40077021
 FF1PEobjects\2019\11004, TxDOT_5x5_PS&E\03, US60_Amarillo\ENG\500-USTN\511.4-Environmental\05-Standards\ec116.dgn
 DISCLAIMER: The use of this standard is governed by the "Texas Engineering Practice Act". No warranty of any kind is made by TxDOT for any purpose whatsoever. TxDOT assumes no responsibility for the conversion of this standard to other formats or for incorrect results or damages resulting from its use.

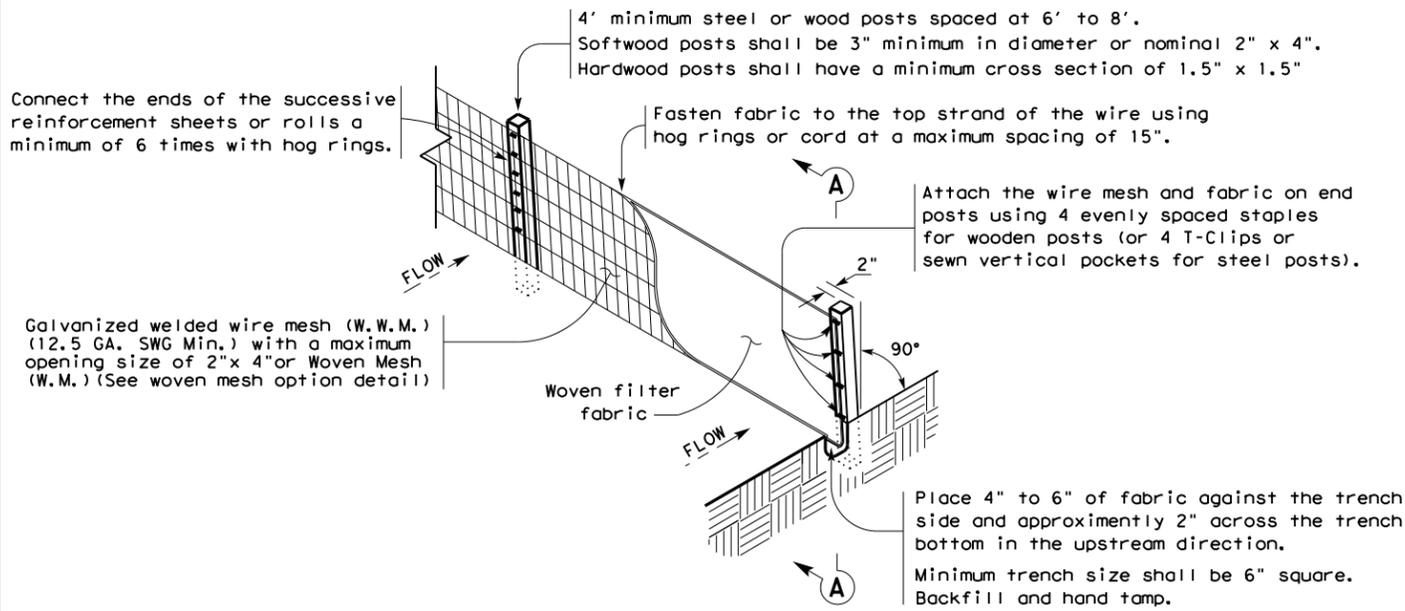

TEMPORARY SEDIMENT CONTROL FENCE

SCF

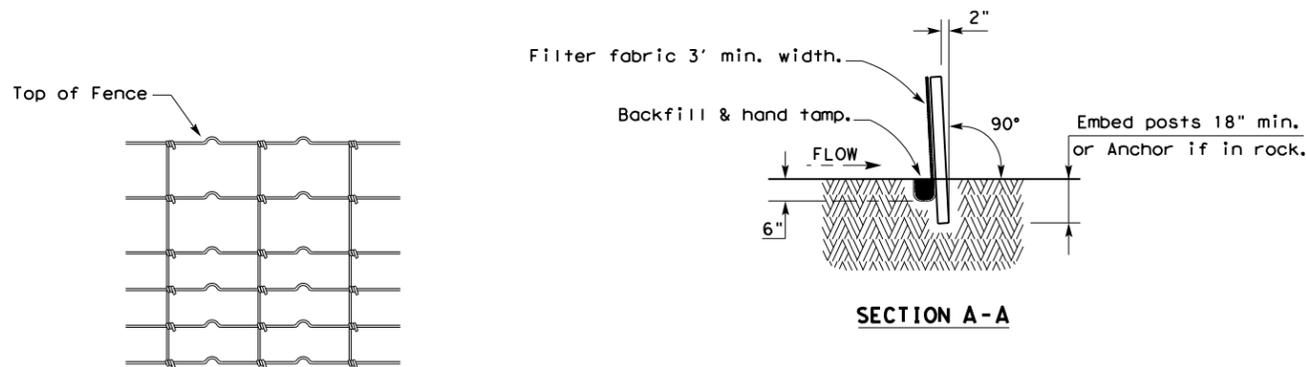

HINGE JOINT KNOT WOVEN MESH (OPTION) DETAIL

Galvanized hinge joint knot woven mesh (12.5 GA. SWG Min.) requires a minimum of five horizontal wires spaced at a maximum of 12 inches apart and all vertical wires spaced at a maximum of 12 inches apart.

SEDIMENT CONTROL FENCE USAGE GUIDELINES

A sediment control fence may be constructed near the downstream perimeter of a disturbed area along a contour to intercept sediment from overland runoff. A 2 year storm frequency may be used to calculate the flow rate to be filtered.

Sediment control fence should be sized to filter a maximum flow through rate of 100 GPM/FT². Sediment control fence is not recommended to control erosion from a drainage area larger than 2 acres.


LEGEND

Sediment Control Fence

SCF

GENERAL NOTES

1. Vertical tracking is required on projects where soil distributing activities have occurred unless otherwise approved.
2. Perform vertical tracking on slopes to temporarily stabilize soil.
3. Provide equipment with a track undercarriage capable of producing linear soil impressions measuring a minimum of 12" in length by 2" to 4" in width by 1/2" to 2" in depth.
4. Do not exceed 12" between track impressions.
5. Install continuous linear track impressions where the minimum 12" length impressions are perpendicular to the slope or direction of water flow.

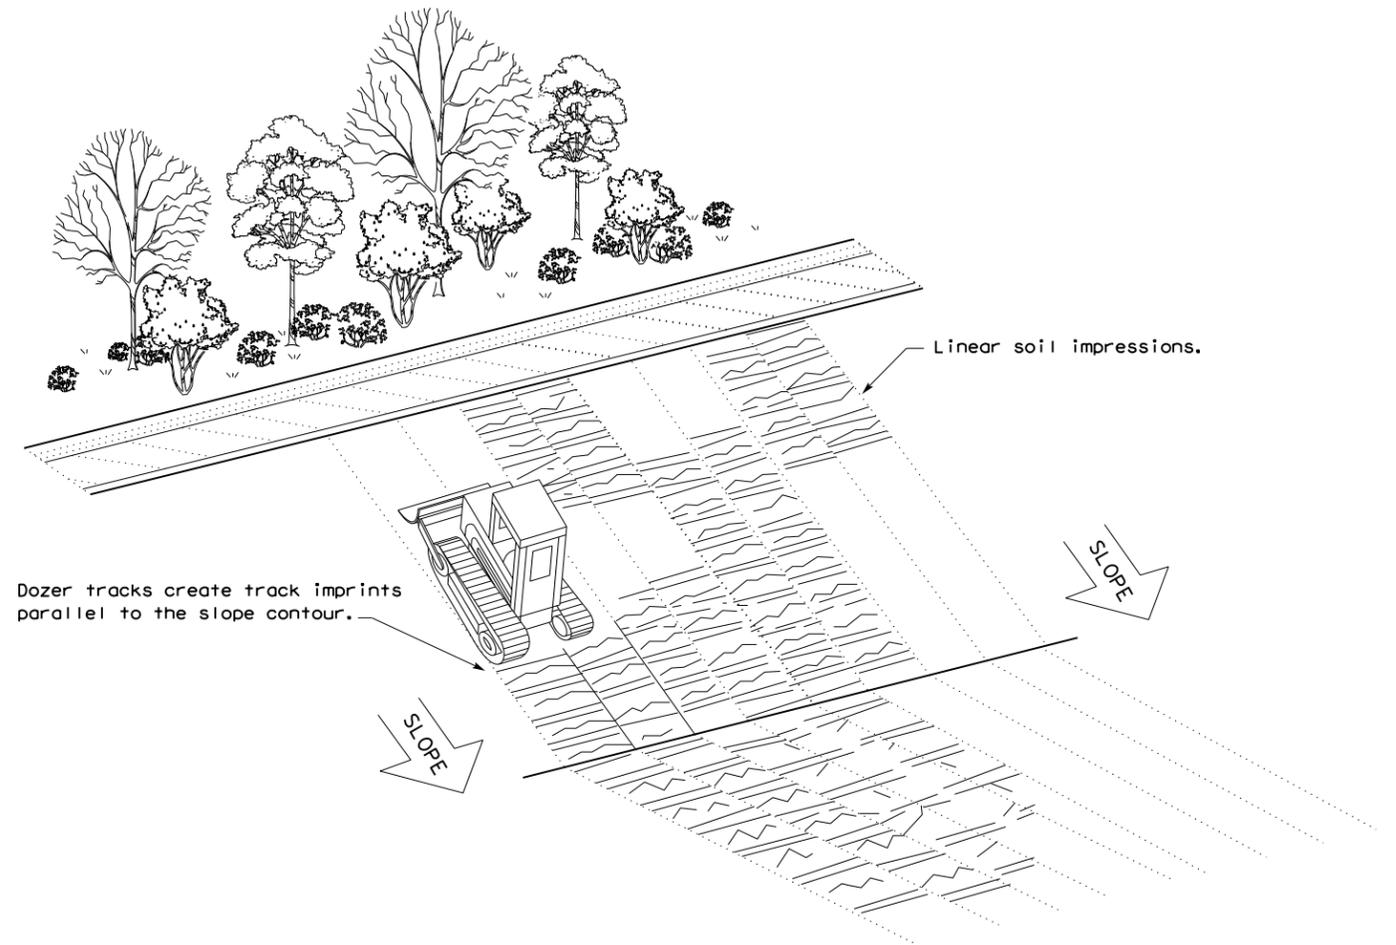


VERTICAL TRACKING


				Design Division Standard	
TEMPORARY EROSION, SEDIMENT AND WATER POLLUTION CONTROL MEASURES FENCE & VERTICAL TRACKING EC(1)-16					
FILE: ec116	DN: TxDOT	CK: KM	DW: VP	DN/CK: LS	
© TxDOT: JULY 2016	CONT	SECT	JOB	HIGHWAY	
REVISIONS		0169	07	053, ETC	US60
DIST	COUNTY	SHEET NO.			
AMA	GRAY			265	

DISCLAIMER: The use of this standard is governed by the "Texas Engineering Practice Act". No warranty of any kind is made by TxDOT for any purpose whatsoever. TxDOT assumes no responsibility for the conversion of this standard to other formats or for incorrect results or damages resulting from its use.


DATE: 4/7/2021
 FILE: F:\Projects\2019\11004.TxDOT_5x5_PS&E\03_US60_Amarillo\ENG\500-USTN\511.4-Environmental\05-Standards\ec916.dgn

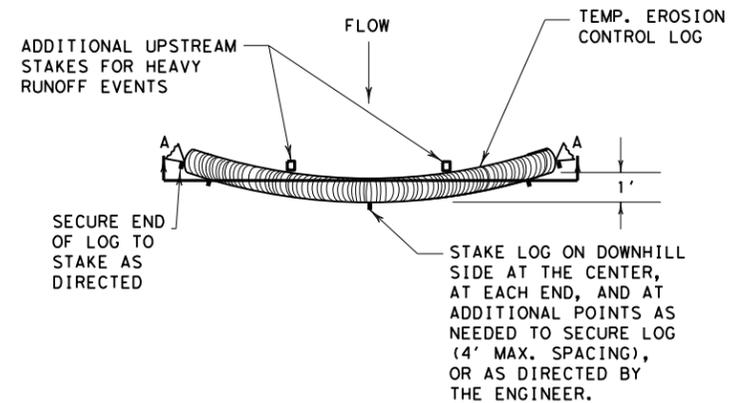


PLAN VIEW

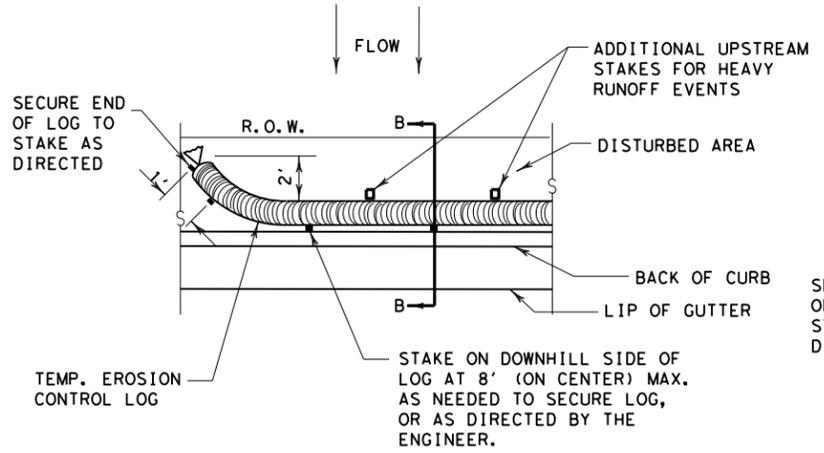

PLAN VIEW

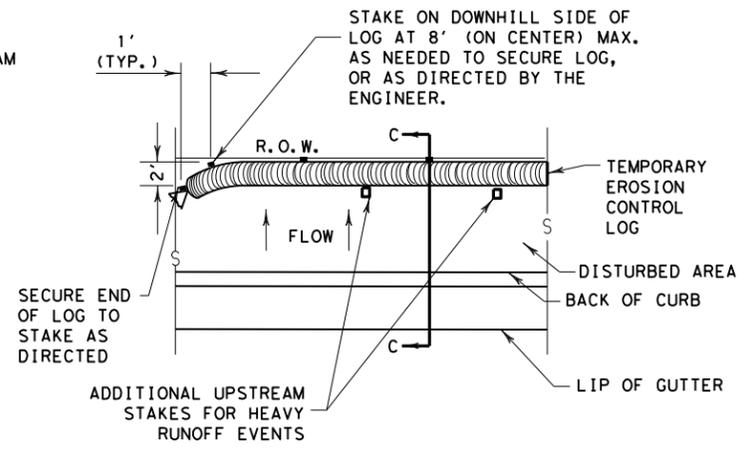


PLAN VIEW

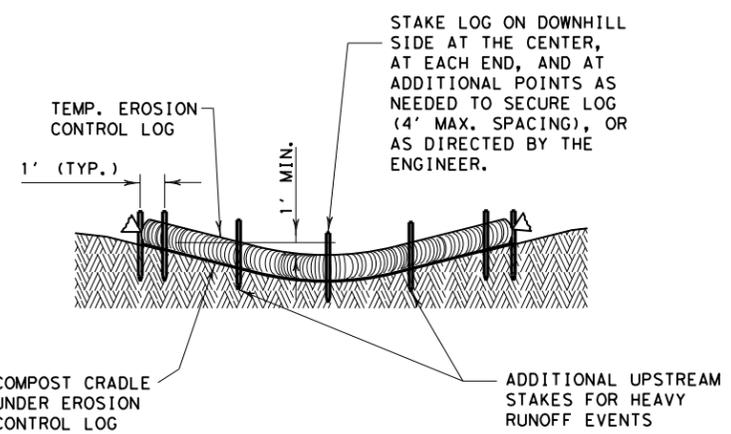

SECTION A-A
EROSION CONTROL LOG DAM


LEGEND

- CL-D EROSION CONTROL LOG DAM
- CL-BOC EROSION CONTROL LOG AT BACK OF CURB
- CL-ROW EROSION CONTROL LOG AT EDGE OF RIGHT-OF-WAY
- CL-SST EROSION CONTROL LOGS ON SLOPES STAKE AND TRENCHING ANCHORING
- CL-SSL EROSION CONTROL LOGS ON SLOPES STAKE AND LASHING ANCHORING
- CL-DI EROSION CONTROL LOG AT DROP INLET
- CL-CI EROSION CONTROL LOG AT CURB INLET
- CL-GI EROSION CONTROL LOG AT CURB & GRATE INLET

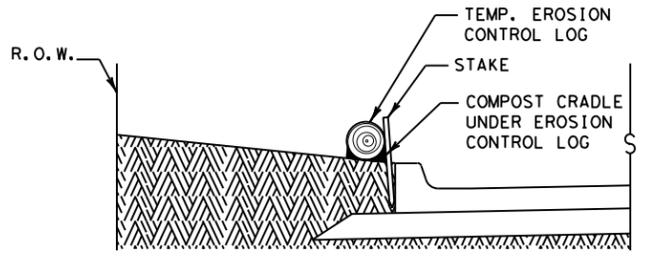


SECTION B-B
EROSION CONTROL LOG AT BACK OF CURB

CL-BOC

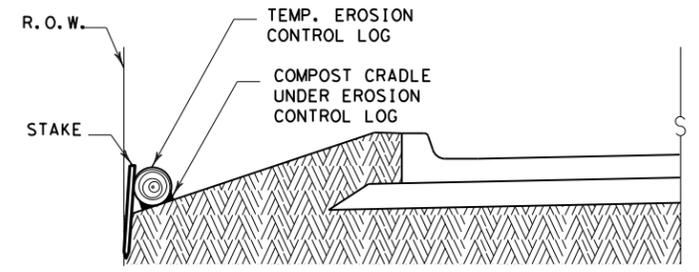

SECTION C-C
EROSION CONTROL LOG AT EDGE OF RIGHT-OF-WAY

CL-ROW

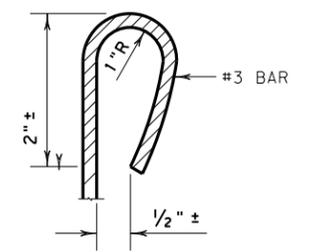

REBAR STAKE DETAIL

SEDIMENT BASIN & TRAP USAGE GUIDELINES

An erosion control log sediment trap may be used to filter sediment out of runoff draining from an unstabilized area.

Log Traps: The drainage area for a sediment trap should not exceed 5 acres. The trap capacity should be 1800 CF/Acre (0.5" over the drainage area).


Control logs should be placed in the following locations:

1. Within drainage ditches spaced as needed or min. 500' on center
2. Immediately preceding ditch inlets or drain inlets
3. Just before the drainage enters a water course
4. Just before the drainage leaves the right of way
5. Just before the drainage leaves the construction limits where drainage flows away from the project.

The logs should be cleaned when the sediment has accumulated to a depth of 1/2 the log diameter.

Cleaning and removal of accumulated sediment deposits is incidental and will not be paid for separately.

- GENERAL NOTES:**
1. EROSION CONTROL LOGS SHALL BE INSTALLED IN ACCORDANCE WITH MANUFACTURER'S RECOMMENDATIONS, OR AS DIRECTED BY THE ENGINEER.
 2. LENGTHS OF EROSION CONTROL LOGS SHALL BE IN ACCORDANCE WITH MANUFACTURER'S RECOMMENDATIONS AND AS REQUIRED FOR THE PURPOSE INTENDED.
 3. UNLESS OTHERWISE DIRECTED, USE BIODEGRADABLE OR PHOTODEGRADABLE CONTAINMENT MESH ONLY WHERE LOG WILL REMAIN IN PLACE AS PART OF A VEGETATIVE SYSTEM. FOR TEMPORARY INSTALLATIONS, USE RECYCLABLE CONTAINMENT MESH.
 4. FILL LOGS WITH SUFFICIENT FILTER MATERIAL TO ACHIEVE THE MINIMUM COMPACTED DIAMETER SPECIFIED IN THE PLANS WITHOUT EXCESSIVE DEFORMATION.
 5. STAKES SHALL BE 2" X 2" WOOD OR #3 REBAR, 2'-4' LONG, EMBEDDED SUCH THAT 2" PROTRUDES ABOVE LOG, OR AS DIRECTED BY THE ENGINEER.
 6. DO NOT PLACE STAKES THROUGH CONTAINMENT MESH.
 7. COMPOST CRADLE MATERIAL IS INCIDENTAL & WILL NOT BE PAID FOR SEPARATELY.
 8. SANDBAGS USED AS ANCHORS SHALL BE PLACED ON TOP OF LOGS & SHALL BE OF SUFFICIENT SIZE TO HOLD LOGS IN PLACE.
 9. TURN THE ENDS OF EACH ROW OF LOGS UPSLOPE TO PREVENT RUNOFF FROM FLOWING AROUND THE LOG.
 10. FOR HEAVY RUNOFF EVENTS, ADDITIONAL UPSTREAM STAKES MAY BE NECESSARY TO KEEP LOG FROM FOLDING IN ON ITSELF.

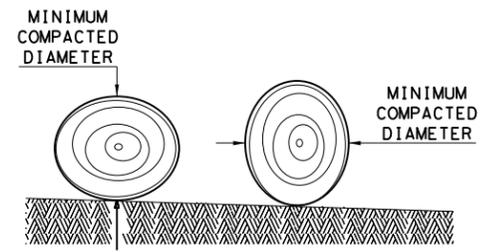


DIAMETER MEASUREMENTS OF EROSION CONTROL LOGS SPECIFIED IN PLANS

SHEET 1 OF 3


		<i>Design Division Standard</i>	
TEMPORARY EROSION, SEDIMENT AND WATER POLLUTION CONTROL MEASURES EROSION CONTROL LOG EC (9) - 16			
FILE: ec916	DN: TxDOT	CK: KM	DW: LS/PT
© TxDOT: JULY 2016	CONT SECT	JOB	HIGHWAY
REVISIONS	0169 07	053, ETC	US60
	DIST	COUNTY	SHEET NO.
	AMA	GRAY	266

DISCLAIMER: The use of this standard is governed by the "Texas Engineering Practice Act". No warranty of any kind is made by TxDOT for any purpose whatsoever. TxDOT assumes no responsibility for the conversion of this standard to other formats or for incorrect results or damages resulting from its use.
 DATE: 4/7/2021
 FILE: F:\Projects\2019\11004.TxDOT_5x5_PS&E\03_US60_Amarillo\ENG\500-USTN\511.4-Environmental\05-Standards\ec916.dgn

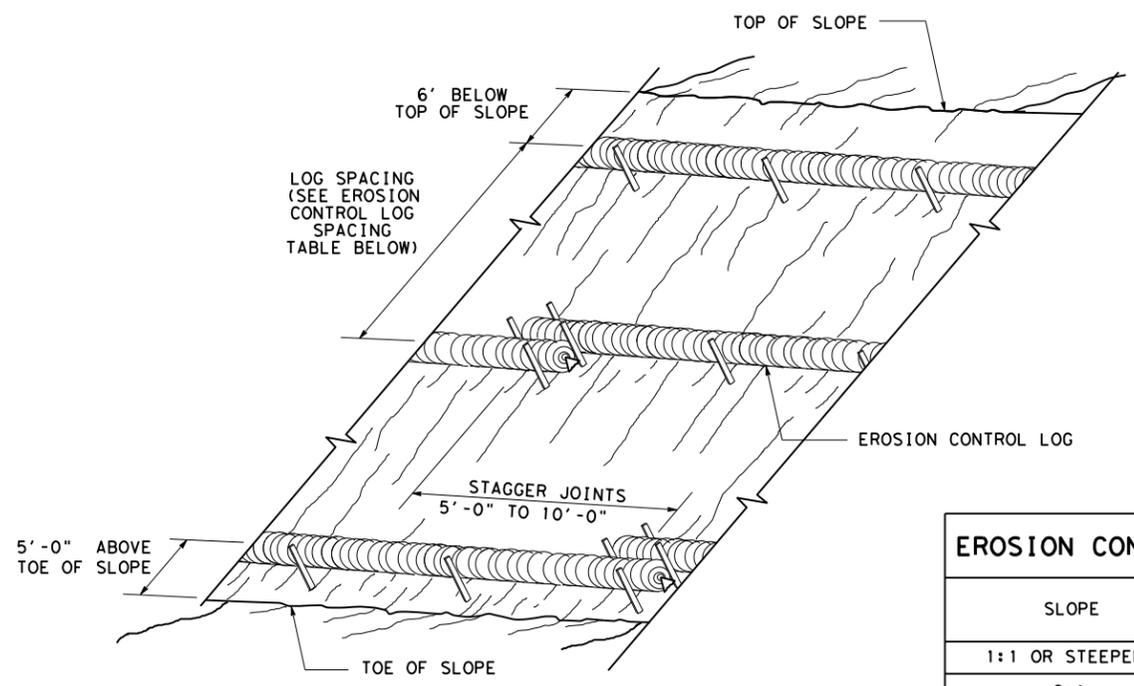

**EROSION CONTROL LOGS ON SLOPES
STAKE AND TRENCHING ANCHORING**


CL-SST

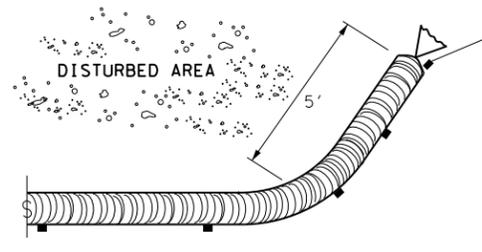

END SECTION RAP DETAIL


SLOPE	LOG DIAMETER			
	6"	8"	12"	18"
1:1 OR STEEPER	5'	10'	15'	20'
2:1	10'	20'	30'	40'
3:1	15'	30'	45'	60'
4:1 OR FLATTER	20'	40'	60'	80'

* ADJUSTMENTS CAN BE MADE FOR SOIL TYPE:
 SOFT, LOAMY SOILS-ADJUST ROWS CLOSER TOGETHER;
 HARD, ROCKY SOILS- ADJUST ROWS FARTHER APART

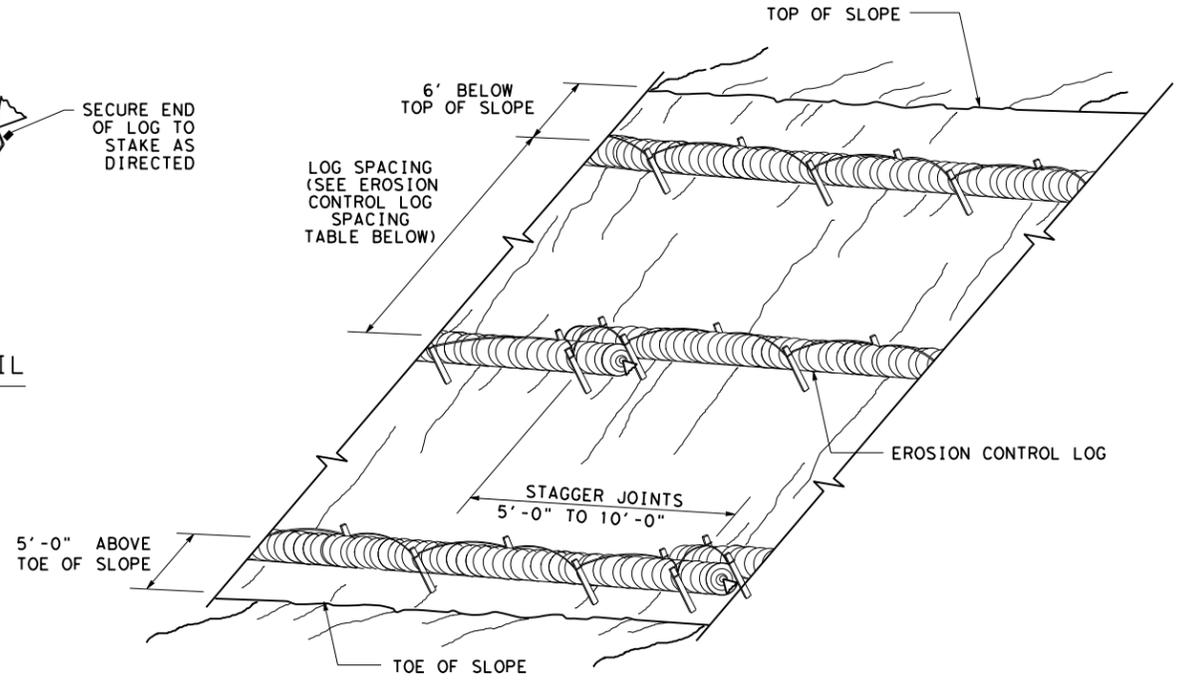


**EROSION CONTROL LOGS ON SLOPES
STAKE AND LASHING ANCHORING**

CL-SSL

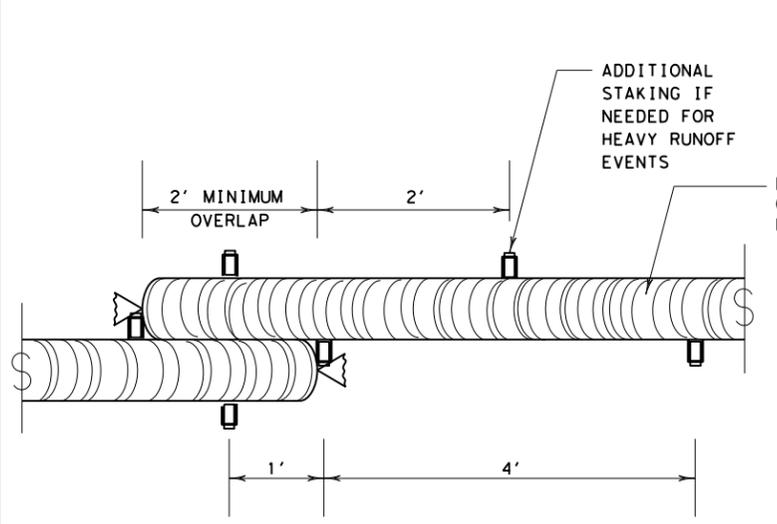


STAKE AND TRENCHING ANCHORING DETAIL

CL-SST

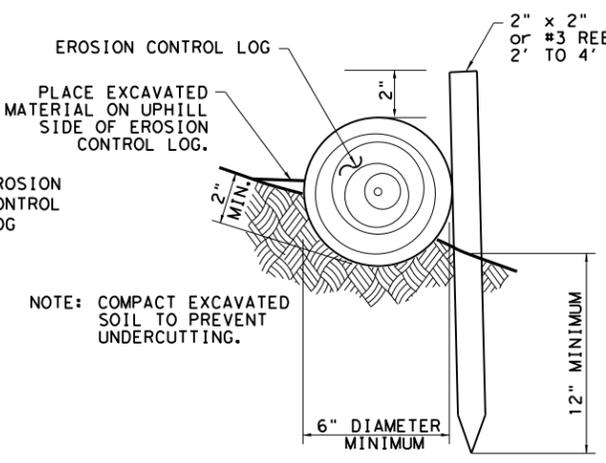


NOTE: COMPACT EXCAVATED SOIL TO PREVENT UNDERCUTTING.

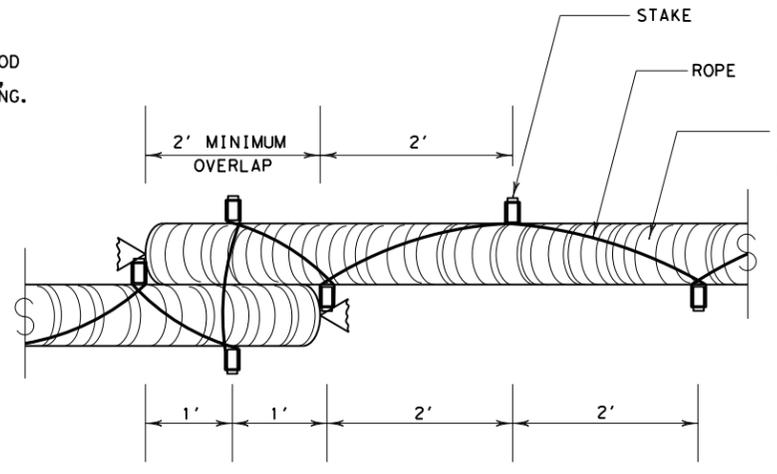


STAKE AND LASHING ANCHORING DETAIL

CL-SSL

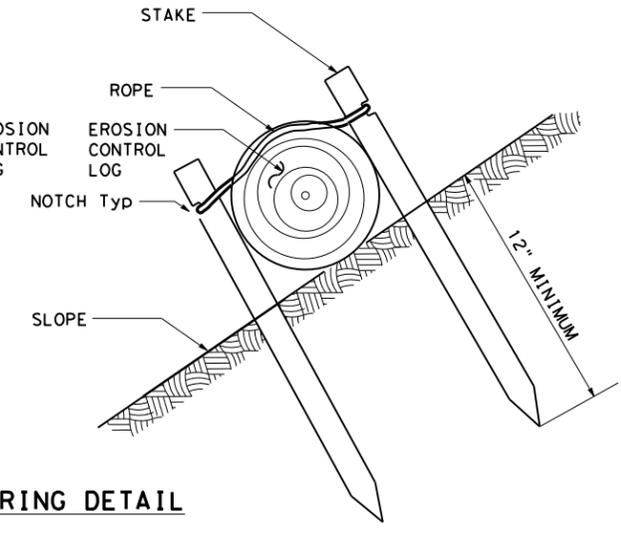

LOG DIAMETER	DEPTH
6"	2"
8"	3"
12"	4"
18"	5"

TRENCH DEPTH TABLE

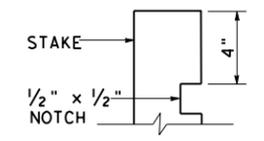


STAKE NOTCH DETAIL

SHEET 2 OF 3


		Design Division Standard	
TEMPORARY EROSION, SEDIMENT AND WATER POLLUTION CONTROL MEASURES EROSION CONTROL LOG EC (9) - 16			
FILE: ec116	DN: TxDOT	CK: KM	DW: LS/PT
© TxDOT: JULY 2016	CONT	SECT	JOB
REVISIONS	0169	07	053, ETC
DIST	COUNTY	SHEET NO.	
AMA	GRAY	267	

DATE: 4/7/2021
 FILE: F:\Projects\2019\11004.TxDOT_5x5_PS&E\03_US60_Amarillo\ENG\500-USTN\511.4-Environmental\05-Standards\ec916.dgn
 DISCLAIMER: The use of this standard is governed by the "Texas Engineering Practice Act". No warranty of any kind is made by TxDOT for any purpose whatsoever. TxDOT assumes no responsibility for the conversion of this standard to other formats or for incorrect results or damages resulting from its use.

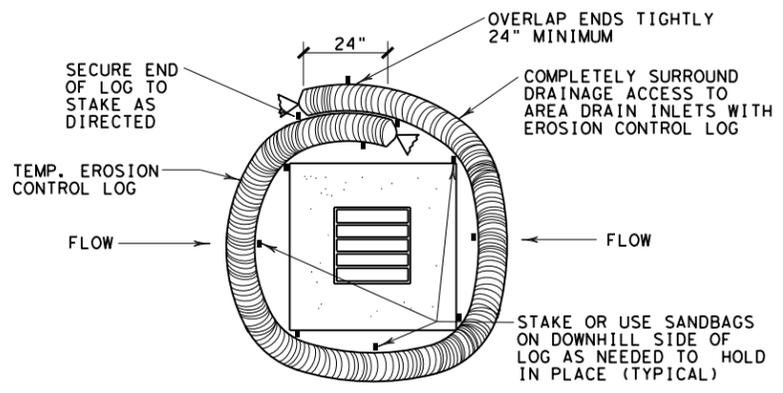


EROSION CONTROL LOG AT DROP INLET

CL-DI

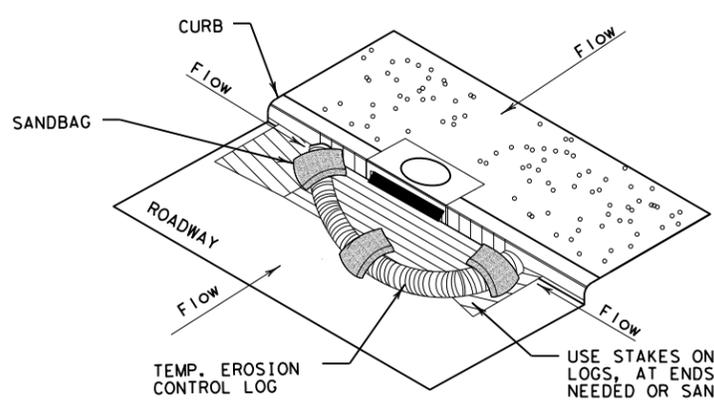

EROSION CONTROL LOG AT CURB INLET


CL-CI

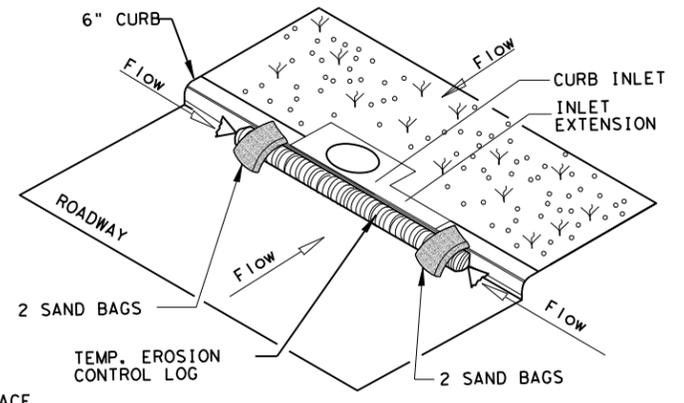

EROSION CONTROL LOG AT CURB INLET


CL-CI

NOTE:
 EROSION CONTROL LOGS USED AT CURB INLETS SHOULD ONLY BE USED IF THEY WILL NOT IMPEDE TRAFFIC OR FLOOD THE ROADWAY OR WHEN THE STORM SEWER SYSTEM IS NOT FULLY FUNCTIONAL.

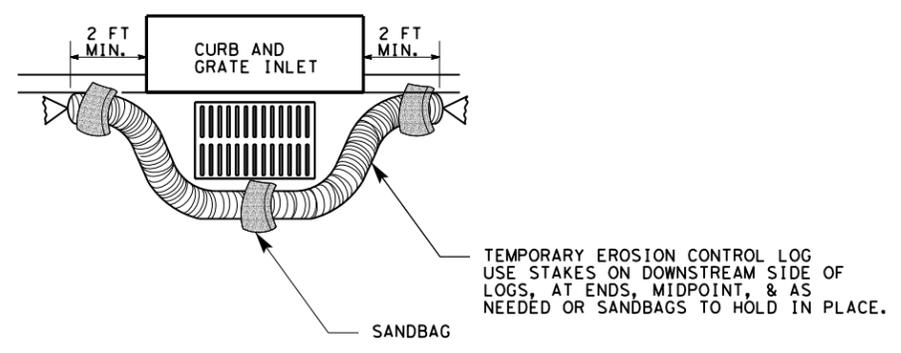

EROSION CONTROL LOG AT CURB & GRADE INLET

CL-GI

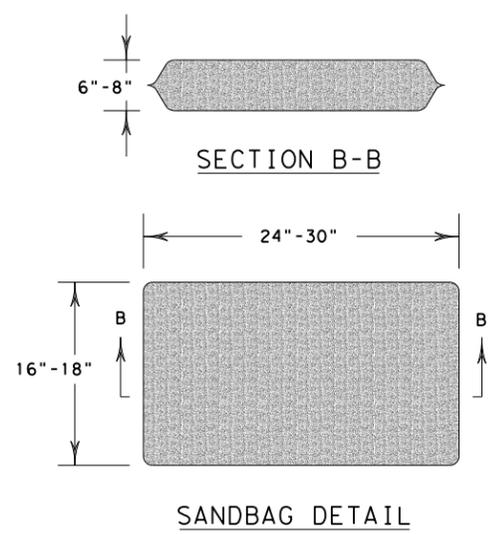

SHEET 3 OF 3

		<i>Design Division Standard</i>	
TEMPORARY EROSION, SEDIMENT AND WATER POLLUTION CONTROL MEASURES EROSION CONTROL LOG EC (9) - 16			
FILE: ec916	DN: TxDOT	CK: KM	DW: LS/PT
© TxDOT: JULY 2016	CONT	SECT	JOB
REVISIONS	0169	07	053, ETC
DIST	COUNTY	SHEET NO.	
AMA	GRAY	268	

DATE: 4/7/2021 7:28:57 AM
 FILE: F:\Projects\2019\11004_TxDOT_5x5_PS&E\03_US60_Amarillo\ENG\500-USTIN\5.1.4-Environmental\05-Standards\Vegetation_Specs.dgn

ITEM 164 SEEDING FOR EROSION CONTROL

SEED (PERM) (RURAL or URBAN) (SAND or CLAY)

"WARM SEASON" PLANTING DATES	SEED MIXTURE	PURE LIVE SEED RATE & PLANT DEPTH
PERMANENT: EARLY SPRING SEED FROM FEBRUARY 15 th THROUGH May 15 th . AS AREAS OF THE ROW ARE PREPARED AND DETERMINED READY FOR DRILL SEEDING.	NEW CROP SEED: TYPE: BUFFALO GRASS (Texoka) "Fluffy" WESTERN WHEATGRASS (ARRIBA) "Hard" BERMUDA GRASS (BLACK JACK) "Hard" Tiny Seed" 100% "Unhulled"	3.0 LBS PLS / ACRE 6.0 LBS PLS / ACRE 5.0 LBS PLS / ACRE @ 1/4" - 1/2" Soil Depth
PERMANENT and TEMP. LATE SPRING SEED FROM MAY 15 th THROUGH AUGUST 1 st AS AREAS OF THE ROW THAT ARE LAID BY BUT DETERMINED TO BE OUT OF SEASON FOR PERMANENT DRILL SEEDING.	TYPE: MILLET (BROWN TOP) "Hard Shell, Small Seed" - Nurse crop BERMUDA GRASS (BLACK JACK) "Hard" Tiny Seed" 100% "Unhulled"	30. LBS PLS / ACRE @ 1/4" Soil Depth 5.0 LBS PLS / ACRE

SOIL PREPARATION EQUIPMENT AND PRACTICES:
 RIPPER --- DISK --- HARROW --- CULTI-PACKER.

NOTES:

- ALL SEED MIXTURE TYPES SHALL BE PURCHASED IN PRE- MIXED BAGS, "BY TYPE" BLENDED BY THE GROWER SHIPPER.
- SOILS THAT ARE COMPACTED, HAVE CLODS, SHALL BE REWORKED UNTIL READY FOR SEEDING. AS DIRECTED.
- ALL SOIL SURFACES SHALL BE LEVEL WITH NATURAL FLOWING SMOOTH GRADES. NO TIRE RUTS OR FURTHER TRAFFIC ALLOWED.
- SOIL SURFACE SHALL BE FIRM BUT NOT COMPACTED, ALLOWING 1/4" DEPRESSION UNDER NORMAL FOOT TRAFFIC.
- SEED 100% OF THE BED AREA. NO SKIPS OR VOID AREAS ALLOWED. EXAMPLE: AREAS AROUND SIGN POSTS AND INLETS.
- SEED UP TO THE FIRST 6" OF THE EDGE OF PAVEMENT. AS DIRECTED, HAND RAKE ISOLATED SEEDED AREAS.
- WEIGH ALL CALIBRATED SEED SAMPLES FOR ACCURACY AND PRESENT DOCUMENTATION TO ENGINEER.

FOR DRILL SEEDING

- USE ONLY PROFESSIONAL NATIVE GRASS OR TURF GRASS (MULTI- 3 BIN) DRILL SEEDERS.
- CALIBRATE DRILL SEEDER FOR SPECIFIED (PLS) PER ACRE BEFORE DRILL SEEDING.
- DRILL SEEDER MUST BE EQUIPPED WITH THE LARGE FRONT CUTTING COULTERS DURING THE INSPECTION OF DRILL SEEDER.

FOR BROADCAST SEEDING

- USE ONLY COMMERCIAL TYPE CYCLONE TYPE SPREADERS.
- CALIBRATE CYCLONE SPREADER FOR 1000 Sq. Ft. (PLS) PER ACRE BEFORE SEEDING.
- TO PREVENT SEED SEPARATION IN SPREADERS, SPREAD ALL SEED TYPES INDEPENDENTLY IN A SEPARATE APPLICATION.
- IMMEDIATELY AFTER SEEDING, IN ONE OR TWO OPERATIONS, CULTI-PACK THE SEEDED SOILS AND FIRM SEED INTO SURFACE.
- DISCONTINUE SEEDING IF WIND EXCEEDS 10 MPH.

ITEM 164 SEEDING FOR EROSION CONTROL

SEED (TEMPORARY) COOL SEASON SEEDING

"COOL SEASON" PLANTING DATES	SEED MIXTURE	PURE LIVE SEED RATE & PLANT DEPTH
TEMPORARY: EARLY FALL SEED FROM AUGUST 1 st THROUGH DECEMBER 1 st . AS AREAS OF THE ROW ARE PREPARED AND DETERMINED READY FOR DRILL SEEDING.	NEW CROP SEED: TYPE: WESTERN WHEATGRASS "Hard Shell" RED WINTER WHEAT, VAR:TAM III "Hard Shell"	6.0 LBS PLS / ACRE 34. LBS PLS / ACRE @ 1" Soil Depth
TEMPORARY: LATE FALL SEED FROM DECEMBER 1 st THROUGH DECEMBER 31 st . AS AREAS OF THE ROW ARE PREPARED AND DETERMINED READY FOR DRILL SEEDING.	NEW CROP SEED: TYPE: RED WINTER WHEAT, VAR:TAM III "Hard Shell"	34. LBS ACRE / PLS @ 1" Soil Depth

SOIL PREPARATION EQUIPMENT AND PRACTICES:
 RIPPER --- DISK --- HARROW --- CULTI-PACKER.

ITEM 314 EMULSIFIED ASPHALT TREATMENT

TIME SCHEDULE:

IMMEDIATELY AFTER SOIL PREPARATION OR WITHIN 24 HOURS AFTER SEEDING, APPLY THE TACK COAT TO DESIGNATED SOIL SURFACES.

FUNCTIONAL USE:

SOIL EROSION CONTROL, OR MOISTURE RETENTION BARRIER.

NOTES:

- ALL TRUCK APPLICATIONS SHALL BE COMPLETED IN ONE PASS OF THE DISTRIBUTOR. ALL TOUCH UP WORK WILL BE FINISHED BY HAND AND HOSE PROCEDURES. APPLY FROM EDGE OF PAVEMENT THROUGH THE FULL SPECIFIED AREAS.
- ENGINEER WILL INSPECT FOR ACCURACY THE OVERALL DEPTH OF THE APPLIED TACK COAT MATERIALS.
- FURTHER VEHICULAR TRAFFIC IS NOT ALLOWED ON LAID BY TACK COAT SURFACES. AT THE CONTRACTORS EXPENSE ALL DAMAGES TO TACK COAT SURFACES WILL BE RE -SHOT AS DIRECTED BY THE ENGINEER.

ITEM 166 FERTILIZER

TIME SCHEDULE:

AFTER TOPSOIL PLOWING PREPARATIONS ARE COMPLETED, FERTILIZE R.O.W. SOIL SURFACES AND HARROW 2" TO 4" DEEP INTO PLACE.

FUNCTIONAL USE:

PLANT NUTRIENTS FOR PLANT AND ROOT DEVELOPMENT.

FERTILIZER SHALL BE EVENLY DISTRIBUTED AT A RATE OF 28 LBS OF NITROGEN PER ACRE. THE BREAK DOWN OF THE NITROGEN ELEMENT SHALL BE IN A 50% SLOW RELEASE FORM. ANALYSIS OF THE (NPK) IS: 1-5-0 A HIGH PHOSPHATE BLEND. AS DIRECTED BY THE VEGETATION MANAGER.

ITEM 166 NOTES:

- BROADCAST SPECIFIED FERTILIZER FROM THE EDGE OF PAVEMENT, THROUGH THE ENTIRE ROW SEED BED AREA. APPLICATIONS FOR EDGE OF PAVEMENT, CULVERTS, SIGN POST AREAS, GUARD RAILS AND ISOLATED AREAS SHALL BE APPLIED BY WALK BEHIND SPREADERS AND BY HAND. NO FERTILIZER ALLOWED ON PAVEMENT SURFACES.
- ALL SPREADERS SHALL BE CALIBRATED BY THE CONTRACTOR AND THE ENGINEER FOR ACCURACY AND PERFORMANCE. SHALL USE UNOPENED 50# BAGS OF SPECIFIED FERTILIZER FOR DAILY CALIBRATIONS. APPLICATION SHALL BE A EVEN DISTRIBUTION OF PRODUCT ON DESIGNATED SOIL SURFACES.
- FERTILIZER SHALL BE DELIVERED IN 50# BAGS UNLESS OTHERWISE SPECIFIED OR APPROVED PRIOR TO DELIVERY. BAGS SHALL BE CLEARLY LABELED SHOWING CONTENTS. IF BULK FERTILIZER IS APPROVED, DOCUMENTATION WILL BE REQUIRED FOR EACH LOAD OF MATERIAL DELIVERED VERIFYING AUTHENTICITY OF THE MATERIAL. CULTURAL PROCEDURES ARE UNDER THE DIRECTION OF THE TxDOT VEGETATION MANAGER.

04/07/2021

 Bo L Ratto

© 2021 Texas Department of Transportation

VEGETATION SPECIFICATION SHEET

FED. RD. DIV. NO.	CONT	SECT	JOB	HIGHWAY
6	0169	07	053, ETC	US60
FEDERAL AID PROJECT NO.	DIST	COUNTY	SHEET NO.	
SEE TITLE SHEET	AMA	GRAY	269	