

FED. RD. DIV. NO.	FEDERAL AID PROJECT NO.	SHEET NO.	
6	F 2022 (626)	001	
STATE	STATE DIST.	COUNTY	
TEXAS	AMA	POTTER	
CONT	SECT.	JOB	HIGHWAY NO.
0904	02	047	VARIOUS

INDEX OF SHEETS

SHEET NO.	DESCRIPTION
1	TITLE SHEET
2	INDEX OF SHEETS

STATE OF TEXAS
DEPARTMENT OF TRANSPORTATION

PLANS OF PROPOSED
STATE HIGHWAY IMPROVEMENT
FEDERAL PROJECT: F 2022(626)
HIGHWAY - VARIOUS
POTTER COUNTY

CONTROL: 0904 - 02 - 047

BI-40D PEDESTRIAN IMPROVEMENTS PHASE III
FOR THE CONSTRUCTION OF: PEDESTRIAN IMPROVEMENT
CONSISTING OF: ADA CURB RAMPS AND SIDEWALK

LIMITS: FROM US 87 (N BUCHANAN ST) TO N GRAND ST
NET LENGTH OF PROJECT: 10,047.78 FEET = 1.90 MILES

FUNCTIONAL CLASSIFICATION = MAJOR ARTERIAL

DESIGN SPEED = 40 MPH
ADT (2022) = 22,262
ADT (2042) = 31,968

FINAL PLANS AND QUANTITIES
AS CONSTRUCTED


CONTRACTOR NAME: _____
CONTRACTOR ADDRESS: _____
LETTING DATE: _____
DATE TIME CHARGES BEGAN: _____
DATE WORK BEGAN: _____
DATE WORK COMPLETED: _____
DATE OF ACCEPTANCE: _____
FINAL CONTRACT COST: \$ _____

PLANS PREPARED BY:
GLOBAL CIVIL SOLUTIONS, LLC
F-12801


REGISTERED ACCESSIBILITY SPECIALIST (RAS) INSPECTION REQD.
TDL # NO. TABS2022011004

BEGIN PROJECT STA 100+00
US 87 (N BUCHANAN ST) @ BI 40D

END PROJECT STA 200+47.78
N GRAND ST @ BI 40D

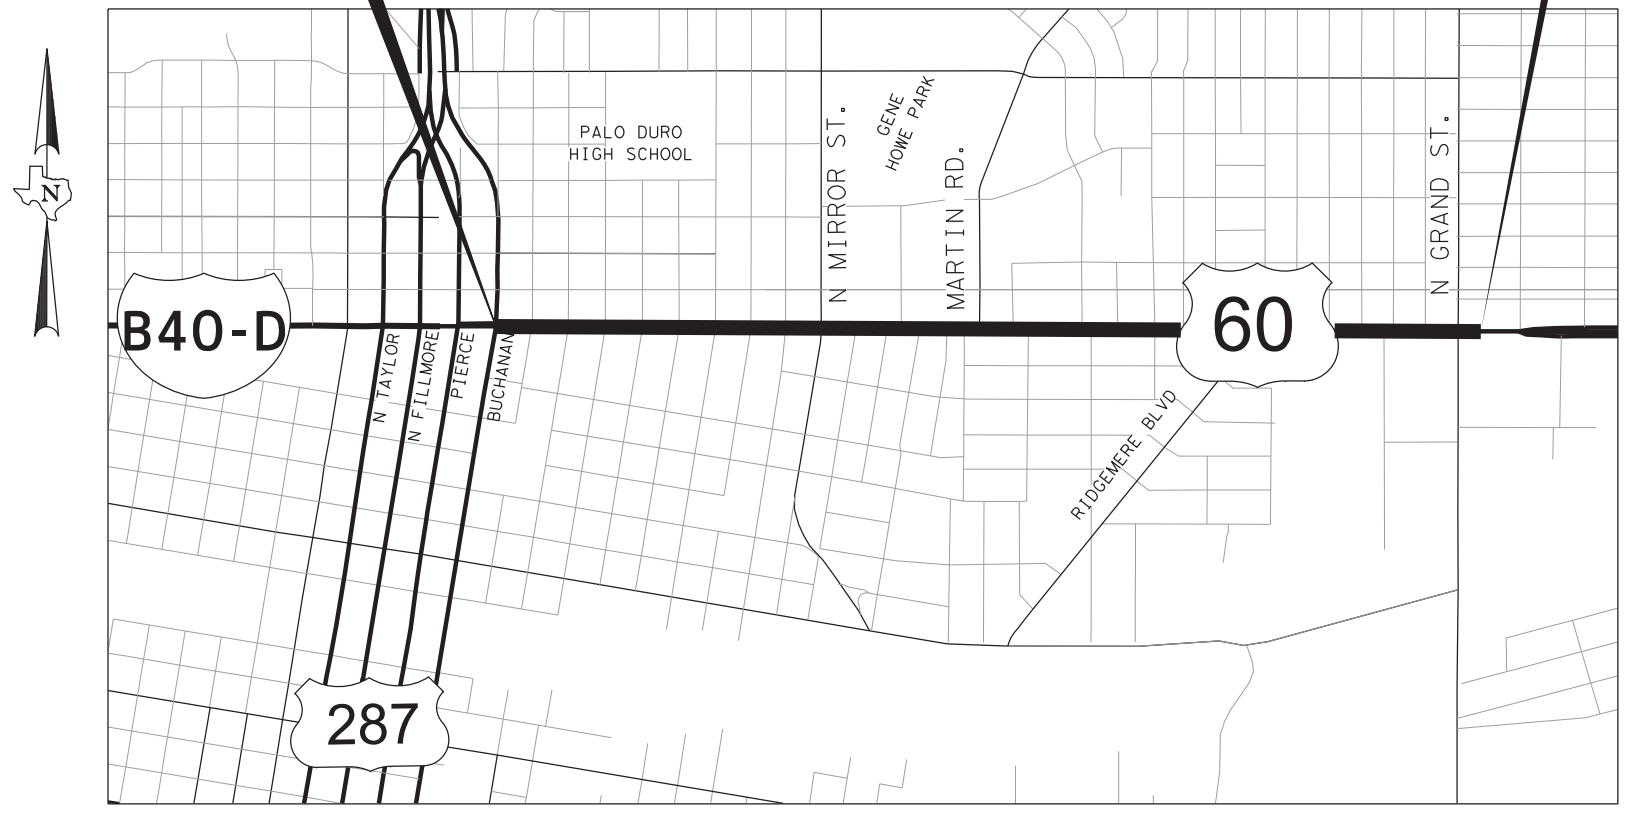

EQUATIONS: NONE
EXCEPTIONS: NONE
RAILROAD CROSSING: NONE

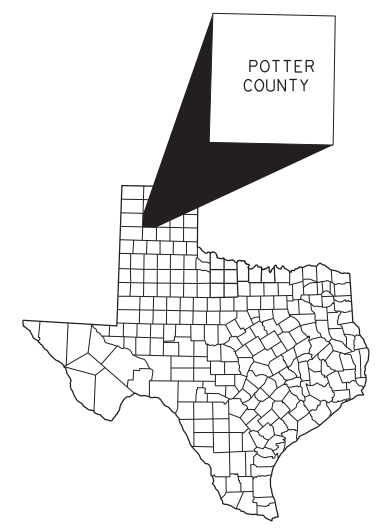

NOTE:
SPECIFICATIONS ADOPTED BY THE TEXAS DEPARTMENT OF TRANSPORTATION NOVEMBER 1, 2014, AND SPECIFICATION ITEMS LISTED AS FOLLOWS SHALL GOVERN ON THIS PROJECT: REQUIRED CONTRACT PROVISIONS FOR ALL FEDERAL-AID CONSTRUCTION CONTRACTS (FORM FHWA 1273, MAY 2012).

2022 Texas Department of Transportation
©2022 by Texas Department of Transportation
all rights reserved.

RECOMMENDED FOR LETTING: DATE 3/30/2022
DocuSigned by: *Syravath Syrombath*

FOR, AREA ENGINEER

DocuSigned by: DATE 3/30/2022
Kit Black

DISTRICT DIRECTOR OF TRANSPORTATION
PLANNING AND DEVELOPMENT

APPROVED FOR LETTING: DATE 3/31/2022
DocuSigned by: *Blair Johnson*

DISTRICT ENGINEER

P:\Jobs\2020007-Pedestrian\TXDOT_Amor\110\CA00\P3-SHEETS\1- GENERAL\001-AMA-P3-TITLE-SHEET.dgn
5/15/2022 2:03:45 PM

P:\Jobs\2020007-Pedestrian\TXDOT_Amor\110\CA00\P3-SHEETS\1- GENERAL\001-AMA-P3-TITLE-SHEET.dgn
5/15/2022 2:03:45 PM

SHEET

DESCRIPTION

001 TITLE SHEET
 002 INDEX OF SHEETS
 003, 003A GENERAL NOTES
 004, 004A ESTIMATE & QUANTITY SHEETS
 005 QUANTITY SUMMARY
 006 DRIVEWAY SUMMARY

II. TRAFFIC CONTROL PLAN STANDARDS

007-018 #BC (1)-21 TO BC (12)-21
 019-022 #TCP (1-1)-18 TO TCP (1-4)-18
 023-026 #TCP (2-1)-18 TO TCP (2-4)-18
 027 #WZ (BTS-1)-13
 028 #WZ (RS)-22
 028A #WZ (RS)-22

III. ROADWAY

029 SIDEWALK PLAN (BEGIN PROJECT TO STA 102+25)
 030 SIDEWALK PLAN (STA 102+25 TO STA 104+00)
 031 SIDEWALK PLAN (STA 104+00 TO STA 106+50)
 032 SIDEWALK PLAN (STA 106+50 TO STA 109+00)
 033 SIDEWALK PLAN (STA 109+00 TO STA 111+50)
 034 SIDEWALK PLAN (STA 111+50 TO STA 114+00)
 035 SIDEWALK PLAN (STA 114+00 TO STA 116+50)
 036 SIDEWALK PLAN (STA 116+50 TO STA 119+00)
 037 SIDEWALK PLAN (STA 119+00 TO STA 121+50)
 038 SIDEWALK PLAN (STA 121+50 TO STA 124+00)
 039 SIDEWALK PLAN (STA 124+00 TO STA 126+50)
 040 SIDEWALK PLAN (STA 126+50 TO STA 129+00)
 041 SIDEWALK PLAN (STA 129+00 TO STA 130+50)
 042 SIDEWALK PLAN (STA 130+50 TO STA 133+00)
 043 SIDEWALK PLAN (STA 133+00 TO STA 135+50)
 044 SIDEWALK PLAN (STA 135+50 TO STA 137+50)
 045 SIDEWALK PLAN (STA 137+50 TO STA 140+00)
 046 SIDEWALK PLAN (STA 140+00 TO STA 142+50)
 047 SIDEWALK PLAN (STA 142+50 TO STA 144+25)
 048 SIDEWALK PLAN (STA 144+25 TO STA 146+75)
 049 SIDEWALK PLAN (STA 146+75 TO STA 149+25)
 050 SIDEWALK PLAN (STA 149+25 TO STA 151+75)
 051 SIDEWALK PLAN (STA 151+75 TO STA 154+25)
 052 SIDEWALK PLAN (STA 154+25 TO STA 156+75)
 053 SIDEWALK PLAN (STA 156+75 TO STA 159+25)
 054 SIDEWALK PLAN (STA 159+25 TO STA 161+50)
 055 SIDEWALK PLAN (STA 161+50 TO STA 164+00)
 056 SIDEWALK PLAN (STA 164+00 TO STA 166+50)
 057 SIDEWALK PLAN (STA 166+50 TO STA 168+50)
 058 SIDEWALK PLAN (STA 168+50 TO STA 171+00)
 059 SIDEWALK PLAN (STA 171+00 TO STA 173+50)
 060 SIDEWALK PLAN (STA 173+50 TO STA 175+25)
 061 SIDEWALK PLAN (STA 175+25 TO STA 177+75)
 062 SIDEWALK PLAN (STA 177+75 TO STA 179+00)
 063 SIDEWALK PLAN (STA 179+00 TO STA 181+50)
 064 SIDEWALK PLAN (STA 181+50 TO STA 183+50)
 065 SIDEWALK PLAN (STA 183+50 TO STA 186+00)
 066 SIDEWALK PLAN (STA 186+00 TO STA 188+50)
 067 SIDEWALK PLAN (STA 188+50 TO STA 190+50)
 068 SIDEWALK PLAN (STA 190+50 TO STA 192+75)
 069 SIDEWALK PLAN (STA 192+75 TO STA 195+25)
 070 SIDEWALK PLAN (STA 195+25 TO STA 197+25)
 071 SIDEWALK PLAN (STA 197+25 TO STA 199+75)
 072 SIDEWALK PLAN (STA 199+75 TO END OF PROJECT)

073-078 MISCELLANEOUS DETAILS

SHEET

DESCRIPTION


079 #CCCG-21
 080-083 #PED-18
 084-087 #PM(1)-20 TO PM(4)-20
 088 #SMD (GEN)-08
 089-091 #SMD (SLIP-1)-08 THRU SMD (SLIP-3)-08

V. ENVIRONMENTAL ISSUES

092 # (EPIC) ENVIRONMENTAL PERMITS, ISSUES, AND COMMITMENTS
 093 TXDOT STORM WATER POLLUTION PREVENTION PLAN (SW3P)
 094 SW3P GENERAL LAYOUT

VI. ENVIRONMENTAL STANDARDS


095 #EC (1)-16
 096-098 #EC (9)-16

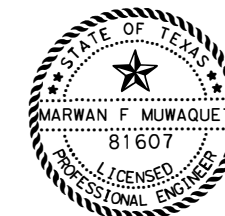

* DENOTES TXDOT STANDARD DETAIL SHEET

THE STANDARD SHEETS (#) SPECIFICALLY IDENTIFIED HAVE BEEN SELECTED BY ME OR UNDER MY RESPONSIBLE SUPERVISION AS BEING APPLICABLE TO THIS PROJECT

 M.F. Muwaquet, P.E. 3/15/2022
 DATE



GLOBAL CIVIL SOLUTIONS, LLC
 11551 FOREST CENTRAL DRIVE
 SUITE 220
 DALLAS, TX 75243
 F-12801

Texas Department of Transportation
 ©2022 TXDOT

INDEX OF SHEETS

				SHEET 1 OF 1
DESIGN	FED. RD. DIV. NO.	FEDERAL AID PROJECT NO.	HIGHWAY NO.	
MI	6	(SEE TITLE SHEET)	VARIOUS	
GRAPHICS	STATE	DISTRICT	COUNTY	SHEET NO.
PS	TEXAS	AMA	POTTER	002
CHECK	CONTROL	SECTION	JOB	
MF				
CHECK	FS	0904	02	047

GENERAL NOTES

General

Contractor questions on this project are to be addressed to the following individual(s):

TO: Amarillo Area Engineer	Kit.Black@txdot.gov (interim)
CC: Assistant Area Engineer	CC.Sysombath@txdot.gov
Director of Construction	Kenneth.Petr@txdot.gov
Construction Manager	Thomas.Nagel@txdot.gov

Contractor questions will be accepted through email, phone, or in person by the above individuals.

All Contractor questions will be reviewed by the Engineer. Once a response is developed, it will be posted to TxDOT's Public FTP at the following Address.

<https://ftp.dot.state.tx.us/pub/txdot-info/Pre-Letting%20Responses/>

All questions submitted that generate responses will be posted through this site. The site is organized by District, Project Type (Construction or Maintenance), Letting Date, CCSJ/Project Name.

There are approximately 1 reference marker within the project limits. If a marker needs to be moved for any reason during construction operations, the Contractor is to remove it, install it in a temporary location and then reinstall it in its correct permanent location. Both the temporary and permanent locations are to be on a line that is perpendicular to the original "station" along the roadway. The temporary location is to be at or near the right-of-way. The permanent location is to be directed by the Engineer.

If Contractor damages any sprinkler heads, risers or water lines that are not to be relocated, he or she is required to replace or repair all damage at his or her own expense and to the Engineer's satisfaction.

Contractor will notify the Engineer 10 working days prior to working in area of monument near STA 102+50 at the Will Rogers Park. TxDOT to coordinate with City of Amarillo for relocating the monument.

Item 7 Legal Relations and Responsibilities

No significant traffic generator events identified.

The total area disturbed for this project is approximately 3.78 acres. The disturbed area in this project, all project locations in the Contract, and the Contractor Project Specific Locations (PSLs), within 1 mile of the project limits, for the Contract will further establish the authorization requirements for storm water discharges. The Department will obtain an authorization to discharge storm water from the Texas Commission on Environmental Quality (TCEQ) for the construction activities shown on the plans. The Contractor is to obtain required

authorization from the TCEQ for Contractor PSLs for construction support activities on or off the ROW. When the total area disturbed in the Contract and PSLs within 1 mile of the project limits exceeds 5 acres, provide a copy of the Contractor NOI for PSLs on the ROW to the Engineer and to the local government that operates a separate storm sewer system.

Item 8 Prosecution and Progress

Create, maintain, and submit for approval, a Critical Path Method (CPM) project schedule and a Project Schedule Summary Report (PSSR) using computer software that is fully compatible with the latest version of Primavera Systems, Inc. or Primavera P6.

Item 100 Preparing Right Of Way

All tree removal activities are to take place outside nesting season. See EPIC for nesting season.

Remove trees of various diameters as shown on the plans, or as directed. Remove tree stumps to at least 12 in. below the surrounding terrain. Before backfilling holes treat the remainder of the stump with the following herbicide: Manufacture - Dow AgroScience; Product - Remedy or other as approved by the Engineer. Follow manufacture recommendations for herbicide. Backfill holes with acceptable material and compact flush with surrounding areas.

Identify each individual tree proposed to be removed. Obtain approval from the Engineer in the field for each individual tree proposed to be removed prior to any tree being removed.

Item 162 Sodding for Erosion Control

Furnish and place sod to match existing type.

Item 168 Vegetative Watering

Vegetative watering is estimated at 0.25" per week placed over the sodded area to keep the soil in a moist state that promotes growth. Begin application of the watering following a rain that presoaks the soil and continue for approximately 3 months, or as directed by the Engineer. If rains occur that keep the soil moist, delay the watering. Provide the appropriate type and amount of equipment to necessary watering.

Item 432 Riprap

24" tie bars (#3 bars at 18" c-c) are to be used across all construction joints. Tie bars should be 12" into each side of the construction joint. When tying new riprap into existing riprap drill and epoxy grout 8" minimum into existing concrete. This is to be considered subsidiary to the payment for riprap.

Provide Class B Concrete for riprap.

Item 502 Barricades, Signs, and Traffic Handling

The Contractor Force Account "Safety Contingency" that has been established for this project is intended to be utilized for work zone enhancements, to improve the effectiveness of the Traffic Control Plan, that could not be foreseen in the project planning and design stage. These enhancements will be mutually agreed upon by the Engineer and the Contractor's Responsible Person based on weekly or more frequent traffic management reviews on the project. The Engineer may choose to use existing bid items if it does not slow the implementation of enhancement.

Temporary rumble strips will be required as shown on WZ(RS)-22 regardless of loose gravel, and/or soft or bleeding asphalt. Adjust the traffic control setup such that rumble strips are not placed in areas of heavily rutted pavements, unpaved surfaces, or horizontal curves. Temporary rumble strips will not be allowed on interstate highway.

The Contractor is to have the option of using either plastic drums, vertical panels, grabber cones or a combination where drums are shown as channelizing devices, as approved by the Engineer. Plastic drums are to be used in all transition areas in accordance with BC(8)-21.

Item 506 Temporary Erosion, Sedimentation, and Environmental Controls

Erosion control devices are to be installed as needed in coordination with the work progress, or as directed by the Engineer.

Item 529 Concrete Curb, Gutter, and Combined Curb and Gutter

Expansion joints are to be at least one-half inch thick and spaced at maximum intervals of 40 feet. Planes of weakness are to be spaced at approximately ten feet intervals. Joint material will comply with ASTM-D 1751.

Item 531 Sidewalks

Sidewalks will be constructed using: 1" compacted sand cushion, reinforcing steel to be 6"x6" W1.4 x W1.4 welded wire mesh (1 1/2" above sand) or No.3 bar 18" O.C. with grooved joint every 10' and 1/2" fiber board expansion joint every 40'. Between back of curb and sidewalk 1/2" fiber board expansion joint will be used.

Item 644 Small Roadside Sign Supports and Assemblies

All slip base signs will have a triangular slip base with a 2-bolt clamp to prevent rotation of signpost. Set screw type slip base will not be allowed.

A 7" x 1/2" diameter galvanized rod or #4 rebar is to be installed in the sign stub as shown on SMD(SLIP-1)-08 to prevent rotation of the sign stub in the concrete footing.

The exact locations of the large and small roadside signs are to be as designated by the Engineer.

The existing riprap aprons are to be removed and disposed of as approved by the Engineer. This work is not to be paid for directly, but will be considered subsidiary to the removal of foundations under this item.

Probe before drilling for foundations to determine the location of all utilities and structures. This work will not be paid for directly, but will be considered subsidiary to bid items involved.

Details for standard signs not shown on the signing standards of the signing detail plan sheets are to be in conformance with the department's "Standard Highway Sign Designs for Texas" Manual, Latest Edition.

Install a wrap of retroreflective sheeting conforming to DMS-8300 on all posts for small road sign assemblies. Sign post wraps will not be paid for directly, but are considered subsidiary to Item 644.

Install red sheeting on the posts containing the following signs:
Stop, Yield, Wrong Way & Do Not Enter

Install yellow sheeting on all other small sign posts.

Install all retroreflective wraps at a height of 4 ft. from bottom of the wrap to the edge of the travel lane surface. All retroreflective wraps will cover the full circumference of the sign post for a vertical width of 12 inches.

Item 6001 Portable Changeable Message Sign

Supply 2 Portable Changeable Message Signs (Type II – Lamp Matrix) for this project. This work will be paid at the unit price bid for each unit, which will include any moving, maintenance, and removing of the PCMS. No payment will be made for removing and replacing damaged PCMS. The Portable Changeable Message Signs will become property of the Contractor at the completion of the project.

If the Contractor chooses to have more than one lane closure set-up at a time, provide additional PCMS in accordance with TCP at no additional charge to the department.

Item 6185 Truck Mounted Attenuator (TMA) and Trailer Attenuator (TA)

In addition to the shadow vehicles with truck mounted attenuator (TMA) that are specified as being required on the traffic control plan for this project, provide 0 additional shadow vehicle(s) with TMA for TCP (1-1)-18, (1-2)-18, (1-3)-18, (1-4)-18, (2-1)-18, (2-2)-18, (2-3)-18 and (2-4)-18 as detailed on the General Notes of this standard sheets.

Therefore, 2 total shadow vehicles with TMA will be required for this type of work. The Contractor will be responsible for determining if one or more of these operations will be ongoing at the same time to determine the total number of TMAs needed for the project.



Estimate & Quantity Sheet

CONTROLLING PROJECT ID 0904-02-047

DISTRICT Amarillo

COUNTY Potter

HIGHWAY Various

CONTROL SECTION JOB				0904-02-047		TOTAL EST.	TOTAL FINAL
PROJECT ID				A00133252			
COUNTY				Potter			
HIGHWAY				Various			
ALT	BID CODE	DESCRIPTION	UNIT	EST.	FINAL		
	100-6008	PREPARING ROW (TREE) (0" TO 6" DIA)	EA	4.000		4.000	
	104-6013	REMOVING CONC (FOUNDATIONS)	SY	2.800		2.800	
	104-6015	REMOVING CONC (SIDEWALKS)	SY	3,071.000		3,071.000	
	104-6017	REMOVING CONC (DRIVEWAYS)	SY	4,199.000		4,199.000	
	104-6029	REMOVING CONC (CURB OR CURB & GUTTER)	LF	1,398.000		1,398.000	
	105-6070	REMOVING STAB BASE & ASPH PAV (6" - 8")	SY	4,698.000		4,698.000	
	160-6003	FURNISHING AND PLACING TOPSOIL (4")	SY	608.000		608.000	
	162-6002	BLOCK SODDING	SY	608.000		608.000	
	168-6001	VEGETATIVE WATERING	MG	23.800		23.800	
	432-6001	RIPRAP (CONC)(4 IN)	CY	63.100		63.100	
	479-6001	ADJUSTING MANHOLES	EA	4.000		4.000	
	479-6005	ADJUSTING MANHOLES (WATER VALVE BOX)	EA	4.000		4.000	
	479-6008	ADJUSTING MANHOLES (WATER METER)	EA	7.000		7.000	
	496-6030	REMOVE STR (BOLLARD)	EA	3.000		3.000	
	500-6001	MOBILIZATION	LS	1.000		1.000	
	502-6001	BARRICADES, SIGNS AND TRAFFIC HANDLING	MO	11.000		11.000	
	506-6038	TEMP SEDMT CONT FENCE (INSTALL)	LF	2,500.000		2,500.000	
	506-6039	TEMP SEDMT CONT FENCE (REMOVE)	LF	2,500.000		2,500.000	
	506-6040	BIODEG EROSN CONT LOGS (INSTL) (8")	LF	1,000.000		1,000.000	
	506-6043	BIODEG EROSN CONT LOGS (REMOVE)	LF	1,000.000		1,000.000	
	529-6008	CONC CURB & GUTTER (TY II)	LF	3,042.000		3,042.000	
	530-6004	DRIVEWAYS (CONC)	SY	6,318.000		6,318.000	
	531-6001	CONC SIDEWALKS (4")	SY	6,282.000		6,282.000	
	531-6004	CURB RAMPS (TY 1)	EA	22.000		22.000	
	531-6005	CURB RAMPS (TY 2)	EA	7.000		7.000	
	531-6006	CURB RAMPS (TY 3)	EA	2.000		2.000	
	531-6008	CURB RAMPS (TY 5)	EA	2.000		2.000	
	531-6010	CURB RAMPS (TY 7)	EA	5.000		5.000	
	531-6013	CURB RAMPS (TY 10)	EA	30.000		30.000	
	531-6033	CONC SIDEWALKS (SPECIAL) (TYPE B)	SY	139.000		139.000	
	644-6068	RELOCATE SM RD SN SUP&AM TY 10BWG	EA	14.000		14.000	
	644-6076	REMOVE SM RD SN SUP&AM	EA	3.000		3.000	
	5057-6002	MOVE AND RESET PRECAST CONC WHEEL STOPS	EA	28.000		28.000	
	6001-6002	PORTABLE CHANGEABLE MESSAGE SIGN	EA	2.000		2.000	
	6027-6009	GROUND BOX (ADJUST)	EA	5.000		5.000	
	6185-6002	TMA (STATIONARY)	DAY	194.000		194.000	



Estimate & Quantity Sheet

CONTROLLING PROJECT ID 0904-02-047

DISTRICT Amarillo

COUNTY Potter

HIGHWAY Various

CONTROL SECTION JOB				0904-02-047		TOTAL EST.	TOTAL FINAL
PROJECT ID				A00133252			
COUNTY				Potter			
HIGHWAY				Various			
ALT	BID CODE	DESCRIPTION	UNIT	EST.	FINAL		
	18	EROSION CONTROL MAINTENANCE: CONTRACTOR FORCE ACCOUNT WORK (PART)	LS	1.000		1.000	
		SAFETY CONTINGENCY: CONTRACTOR FORCE ACCOUNT WORK (PARTICIPATING)	LS	1.000		1.000	

P:\Jobs\202007-Pedestrian\DOT\Annot\110\CADD\PS\SHEETS\1 - GENERAL\05 AMA P3 QUANTITY SUMMARY.dgn 8:17:32 PM 1/27/2022

SHT NO	100	104	104	104	104	105	160	162	168	432	479	479	479	496	529	530	531	531	531	531	531	531	531	531	644	644	5057	6027
	6008	6013	6015	6017	6029	6070	6003	6002	6001	6001	6001	6005	6008	6030	6008	6004	6001	6004	6005	6006	6008	6010	6013	6033	6068	6076	6002	6009
	PREPARING ROW (TREE) (0" TO 6" DIA)	REMOVING CONC (FOUNDATIONS)	REMOVING CONC (SIDEWALKS)	REMOVING CONC (DRIVEWAYS)	REMOVING CONC (CURB OR CURB & GUTTER)	REMOVING STAB BASE & ASPH PAV (6" - 8")	FURNISHING AND PLACING TOP SOIL (4")	BLOCK SODDING	VEGETATIVE WATERING	RIPRAP (CONC) (4 IN)	ADJUSTING MANHOLE	ADJUSTING MANHOLES (WATER VALVE BOX)	ADJUSTING MANHOLES (WATER METER)	REMOVE STR (BOLLARD)	CONC CURB & GUTTER (TY II)	DRIVEWAYS (CONC)	CONC SIDEWALK (4")	CURB RAMPS (TY 1)	CURB RAMPS (TY 2)	CURB RAMPS (TY 3)	CURB RAMPS (TY 5)	CURB RAMPS (TY 7)	CURB RAMPS (TY 10)	CONC SIDEWALK (SPECIAL) (TY B)	RELOCATE SM RD SN SUP&AM TY 10BWG	REMOVE SM RD SN SUP&AM	MOVE AND RESET PRECAST CONC WHEEL STOPS	GROUND BOX (ADJUST)
	EA	SY	SY	SY	LF	SY	SY	SY	MG	CY	EA	EA	EA	EA	LF	SY	SY	EA	EA	EA	EA	EA	EA	SY	EA	EA	EA	EA
SHEET 1 of 44			54	8			28	28	1.1						8	8	87											
SHEET 2 of 44			106	54	8		43	43	1.6						40	103	135								1			1
SHEET 3 of 44	4		115	96	153		6	6	0.3	3.6				1	162	89	158	1										1
SHEET 4 of 44			27	88	57		33	33	1.3	4.2					163	94	135					2			1			1
SHEET 5 of 44			166	119	59	124	52	52	2.0	2.4	1				95	266	192											
SHEET 6 of 44			97	152	58	19	29	29	1.1	0.4			1		58	171	110		2					1				
SHEET 7 of 44			80	139	12	55				1.4	1				98	161	142	2				1	1					
SHEET 8 of 44			18	163	47	294									156	308	173											
SHEET 9 of 44			71	170	22	90	26	26	1.0	0.2					54	220	142	1					3					
SHEET 10 of 44			134	156	42	14	30	30	1.2	0.9					73	158	161	1	2				2		1			
SHEET 11 of 44			132	193	50	99									78	226	180											
SHEET 12 of 44			69	128	43	76	36	36	1.4	0.7					43	128	140	1	1				2					
SHEET 13 of 44			50	59	45	65	14	14	0.6						45	111	63											
SHEET 14 of 44			110	127	38	20	24	24	0.9	0.5					105	92	165	2					2		1			
SHEET 15 of 44			49	84	10		6	6	0.3						68	52	81											
SHEET 16 of 44			18	46	8										16	46	18											
SHEET 17 of 44			56	216	24		12	12	0.5	0.9					50	216	56											
SHEET 18 of 44			97	88	55										55	88	97	1					1					
SHEET 19 of 44			71	117	16	72	16	16	0.6						16	165	95	1					1		1			
SHEET 20 of 44			99	148	48	43	26	26	1.0						71	148	142		1									
SHEET 21 of 44			119	128	23	176	29	29	1.1	1.9					174	192	213								2	2		
SHEET 22 of 44			25	96	32	19				2.2					94	91	58						2		1	1		
SHEET 23 of 44			121	199	48	69				2.0				1	48	272	134											
SHEET 24 of 44			49	171	37	208				4.8					45	241	146	2				1	1					
SHEET 25 of 44			31	129	24	303	15	15	0.6	2.2					62	246	204											
SHEET 26 of 44			49	127	40	203				2.0					67	198	185								1			
SHEET 27 of 44			33	76	16	242					2				116	165	208	1	1				2				6	1
SHEET 28 of 44			30	117	16	260				0.6					121	210	170	2										
SHEET 29 of 44		0.8			8	381				1.3				1	125	216	153											6
SHEET 30 of 44			19		27	280	3	3	0.2	2.4					175	115	159	1				1	2					
SHEET 31 of 44			83	106	32	51				2.3					50	106	114	1				1						
SHEET 32 of 44			17	47	32	165	4	4	0.2						43	147	111											
SHEET 33 of 44		2.0	91	170	40	67	26	26	1.0	2.5					67	212	182	1					1					
SHEET 34 of 44			10	48	16	149	5	5	0.2						16	122	83								1			
SHEET 35 of 44			70		24	191	15	15	0.6				2		48	117	148											1
SHEET 36 of 44			21	55	40	217				3.6					40	139	210								2			
SHEET 37 of 44			125	93	40	88				4.3					46	121	206	1		1								
SHEET 38 of 44			155	74	16	42				5.5					33	94	253	2										
SHEET 39 of 44			79	12	16	149									88	68	206											
SHEET 40 of 44			96		22	39	44	44	1.7						46	33	129	1					1	130				
SHEET 41 of 44			35	51	30	72	28	28	1.1	2.5					30	120	73					1	1		2			
SHEET 42 of 44			12	84	16	173				6.2					38	138	126								1			
SHEET 43 of 44			133	65	8	135	42	42	1.6	1.6			1		16	105	242											9
SHEET 44 of 44			49			48	16	16	0.6								97											7
PROJECT TOTAL	4	2.8	3071	4199	1398	4698	608	608	23.8	63.1	4	4	7	3	3042	6318	6282	22	7	2	2	5	30	139	14	3	28	5

LOCATION	506	506	506	506
	6038	6039	6040	6043
	TEMP SEDMT CONT FENCE (INSTALL)	TEMP SEDMT CONT FENCE (REMOVE)	BIODEG EROSN CONT LOGS (INSTR) (8")	BIODEG EROSN CONT LOGS (REMOVE)
	LF	LF	LF	LF
PROJECT TOTAL	2500	2500	1000	1000



GLOBAL CIVIL SOLUTIONS, LLC
 11551 FOREST CENTRAL DRIVE
 SUITE 220
 DALLAS, TX 75243
 F-12801



QUANTITY SUMMARY

SHEET 1 OF 1			
DESIGN	FED. RD. DIV. NO.	FEDERAL AID PROJECT NO.	HIGHWAY NO.
MI1	6	(SEE TITLE SHEET)	VARIOUS
GRAPHICS	STATE	DISTRICT	COUNTY
PS	TEXAS	AMA	POTTER
CHECK	CONTROL	SECTION	JOB
MF	0904	02	047
CHECK			SHEET NO.
FS			005

P:\Jobs\2020007-Pedestrian\TXDOT\Amor\110\CA00\PS\SHEETS\1. GENERAL\006 AMA P3 DRIVEWAY SUMMARY.dgn
 5:17:37 PM
 1/27/2022


DRWY ID	LENGTH 1 FT	LENGTH 2 FT	LENGTH 3 FT	WIDTH(W1) FT	WIDTH(W2) FT
1	0.0	5.0	4.0	32.0	32.0
2	0.0	5.0	4.0	13.0	24.0
3	0.0	5.0	8.0	26.0	32.0
4	0.0	5.0	4.0	12.0	21.0
5	0.0	5.0	3.0	26.0	35.0
6	0.0	5.0	3.0	25.0	38.0
7	0.0	5.0	4.0	24.0	30.0
8	13.0	6.0	5.0	16.0	27.0
9	6.5	5.0	0.0	32.0	49.0
10	6.5	5.0	0.0	30.0	50.0
11	5.0	4.0	0.0	25.0	33.0
12	0.0	5.0	4.0	16.0	25.0
13	0.0	6.0	4.0	26.0	33.0
14	0.0	6.0	4.0	35.0	47.0
15	0.0	5.0	4.0	25.0	33.0
16	0.0	5.0	4.0	25.0	33.0
17	5.5	4.0	0.0	41.0	50.0
18	0.0	5.0	5.0	19.0	30.0
19	8.0	4.0	0.0	25.0	40.0
20	0.0	5.0	4.0	92.0	92.0
21	0.0	5.0	3.0	55.0	55.0
22	0.0	5.0	3.0	24.0	24.0
23	0.0	5.0	3.0	24.0	24.0
24	0.0	5.0	5.0	75.0	75.0
25	0.0	5.0	4.0	40.0	40.0
26	5.0	5.0	0.0	25.0	40.0
27	5.0	5.0	0.0	24.0	45.0
28	5.0	5.0	0.0	24.0	40.0
29	0.0	5.0	4.0	34.0	34.0
30	0.0	5.0	3.0	33.0	39.0
31	0.0	5.0	3.0	30.0	39.0
32	7.5	5.0	0.0	23.0	35.0
33	8.5	5.0	0.0	24.0	36.0
34	0.0	5.0	4.0	18.0	18.0
35	3.0	4.0	2.0	28.0	36.0
36	2.0	5.0	1.0	32.0	42.0
37	0.0	5.0	3.0	33.0	33.0
38	4.5	5.0	0.0	23.0	34.0
39	0.0	5.0	4.0	24.0	28.0
40	0.0	5.0	4.0	34.0	44.0
41	0.0	5.0	4.0	18.0	18.0
42	0.0	5.0	4.5	40.0	46.0
43	8.0	5.0	0.0	34.0	56.0
44	0.0	5.0	4.0	18.0	18.0
45	0.0	5.0	4.0	26.0	26.0
46	0.0	5.0	4.0	20.0	20.0
47	0.0	5.0	4.0	15.0	22.0
48	0.0	5.0	5.0	23.0	30.0

DRWY ID	LENGTH 1 FT	LENGTH 2 FT	LENGTH 2 FT	WIDTH(W1) FT	WIDTH(W2) FT
49	8.0	5.0	0.0	30.0	51.0
50	0.0	5.0	4.0	14.0	24.0
51	0.0	5.0	4.0	34.0	44.0
52	0.0	6.0	1.5	36.0	42.0
53	0.0	5.0	5.5	35.0	53.0
54	0.0	5.0	5.0	36.0	52.0
55	5.0	4.0	0.0	25.0	37.0
56	0.0	6.0	4.0	30.0	40.0
57	0.0	6.0	4.0	35.0	45.0
58	0.0	5.0	3.0	17.0	30.0
59	0.0	6.0	2.5	40.0	40.0
60	0.0	5.0	3.0	24.0	36.0
61	5.0	4.0	0.0	28.0	40.0
62	5.0	4.0	0.0	28.0	40.0
63	5.0	5.0	0.0	25.0	37.0
64	0.0	5.0	4.0	26.0	32.0
65	0.0	5.0	4.0	36.0	42.0
66	0.0	6.0	4.0	24.0	38.0
67	0.0	5.0	3.5	32.0	40.0
68	4.5	5.0	0.0	34.0	46.0
69	0.0	6.0	3.0	49.0	50.0
70	0.0	5.0	4.0	20.0	34.0
71	0.0	6.0	4.0	24.0	30.0
72	3.0	5.0	3.0	32.0	40.0
73	3.0	5.0	3.0	32.0	40.0
74	3.0	5.0	3.0	24.0	32.0
75	0.0	6.0	4.0	24.0	32.0
76	0.0	6.0	4.0	32.0	40.0
77	0.0	6.0	4.0	22.0	30.0
78	3.0	5.0	2.0	28.0	36.0
79	3.0	5.0	2.0	36.0	44.0
80	3.0	5.0	2.0	24.0	32.0
81	3.0	5.0	2.0	36.0	44.0
82	0.0	6.0	4.0	24.0	28.0
83	0.0	6.0	4.0	16.0	16.0
84	0.0	6.0	4.0	24.0	24.0
85	3.0	5.0	2.0	34.0	42.0
86	3.0	5.0	3.0	15.0	23.0
87	3.0	5.0	3.0	15.0	23.0
88	3.0	5.0	3.0	15.0	23.0
89	0.0	6.0	4.0	32.0	32.0
90	0.0	6.0	4.0	24.0	24.0
91	3.0	5.0	3.0	15.0	23.0
92	3.0	5.0	3.0	15.0	23.0
93	3.0	5.0	3.0	26.0	34.0
94	0.0	6.0	4.0	24.0	24.0
95	0.0	6.0	4.0	18.0	18.0
96	0.0	6.0	4.0	32.0	32.0

DRWY ID	LENGTH 1 FT	LENGTH 2 FT	LENGTH 2 FT	WIDTH(W1) FT	WIDTH(W2) FT
97	3.0	5.0	3.0	24.0	32.0
98	3.0	5.0	3.0	43.0	51.0
99	0.0	6.0	4.0	38.0	46.0
100	6.0	4.0	0.0	29.0	37.0
101	3.0	5.0	3.0	29.0	37.0
102	3.0	5.0	0.0	36.0	44.0
103	8.0	5.0	0.0	24.0	37.0
104	0.0	6.0	4.0	18.0	18.0
105	3.0	5.0	0.0	55.0	63.0
106	3.0	5.0	0.0	44.0	52.0
107	3.0	5.0	0.0	24.0	32.0
108	0.0	6.0	4.0	24.0	32.0
109	0.0	6.0	4.0	24.0	32.0
110	3.0	5.0	0.0	24.0	32.0
111	3.0	5.0	0.0	24.0	32.0
112	0.0	6.0	4.0	24.0	32.0
113	3.0	5.0	3.0	34.0	42.0
114	3.0	5.0	3.0	34.0	42.0
115	0.0	6.0	4.0	36.0	44.0
116	0.0	6.0	4.0	26.0	34.0
117	4.0	4.0	0.0	38.0	46.0
118	5.0	5.0	0.0	30.0	38.0
119	5.0	5.0	0.0	39.0	47.0
120	5.0	5.0	0.0	26.0	38.0
121	4.0	4.0	0.0	42.0	50.0
122	0.0	6.0	2.0	14.0	14.0
123	0.0	6.0	2.0	14.0	14.0
124	0.0	6.0	4.0	30.0	38.0
125	0.0	6.0	4.0	36.0	44.0
126	0.0	6.0	4.0	44.0	52.0
127	0.0	6.0	4.0	36.0	36.0
128	5.0	5.0	0.0	36.0	48.0
129	0.0	6.0	5.5	18.0	26.0
130	0.0	6.0	4.0	24.0	24.0
131	0.0	6.0	4.0	24.0	24.0
132	0.0	6.0	4.0	24.0	32.0
133	0.0	6.0	4.0	40.0	48.0
134	0.0	5.0	5.0	36.0	44.0
135	0.0	6.0	4.0	24.0	32.0
136	0.0	6.0	4.0	24.0	32.0
137	0.0	5.0	2.5	20.0	28.0
138	0.0	6.0	2.5	24.0	32.0
139	0.0	6.0	4.0	25.0	42.0
140	0.0	6.0	4.0	45.0	49.0
141	0.0	6.0	4.0	34.0	42.0
142	3.0	5.0	2.0	55.0	66.0
143	7.0	4.0	0.0	38.0	52.0
144	0.0	6.0	4.0	24.0	32.0

NOTES:

- FOR DRIVEWAY DETAILS, REFER TO MISCELLANEOUS DETAILS SHEET 6 OF 6.

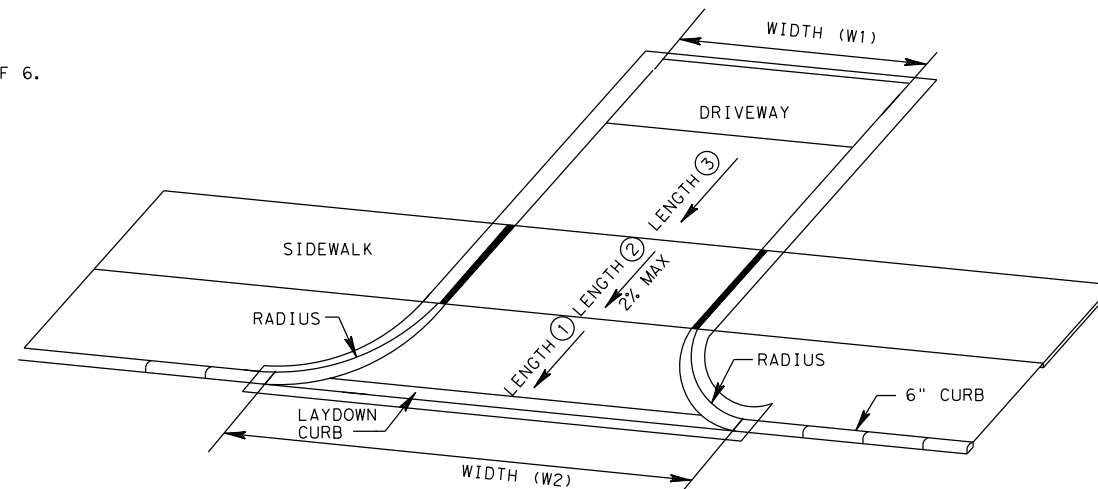

SIDEWALK OFFSET FROM CURB DETAILS



GLOBAL CIVIL SOLUTIONS, LLC
 11551 FOREST CENTRAL DRIVE
 SUITE 220
 DALLAS, TX 75243
 F-12801



DRIVEWAY SUMMARY

SHEET 1 OF 1

DESIGN MI	FED. RD. DIV. NO. 6	FEDERAL AID PROJECT NO. (SEE TITLE SHEET)	HIGHWAY NO. VARIOUS
GRAPHICS PS	STATE TEXAS	DISTRICT AMA	COUNTY POTTER
CHECK MF	CONTROL 0904	SECTION 02	JOB 047
CHECK FS			SHEET NO. 006

DISCLAIMER: This standard is governed by the "Texas Engineering Practice Act". No warranty of any kind is made by TxDOT for any purpose whatsoever. TxDOT assumes no responsibility for the conversion of this standard to other formats or for incorrect results or damages resulting from its use.

DATE:
 FILE:

BARRICADE AND CONSTRUCTION (BC) STANDARD SHEETS GENERAL NOTES:

1. The Barricade and Construction Standard Sheets (BC sheets) are intended to show typical examples for placement of temporary traffic control devices, construction pavement markings, and typical work zone signs. The information contained in these sheets meet or exceed the requirements shown in the "Texas Manual on Uniform Traffic Control Devices" (TMUTCD).
2. The development and design of the Traffic Control Plan (TCP) is the responsibility of the Engineer.
3. The Contractor may propose changes to the TCP that are signed and sealed by a licensed professional engineer for approval. The Engineer may develop, sign and seal Contractor proposed changes.
4. The Contractor is responsible for installing and maintaining the traffic control devices as shown in the plans. The Contractor may not move or change the approximate location of any device without the approval of the Engineer.
5. Geometric design of lane shifts and detours should, when possible, meet the applicable design criteria contained in manuals such as the American Association of State Highway and Transportation Officials (AASHTO), "A Policy on Geometric Design of Highways and Streets," the TxDOT "Roadway Design Manual" or engineering judgment.
6. When projects abut, the Engineer(s) may omit the END ROAD WORK, TRAFFIC FINES DOUBLE, and other advance warning signs if the signing would be redundant and the work areas appear continuous to the motorists. If the adjacent project is completed first, the Contractor shall erect the necessary warning signs as shown on these sheets, the TCP sheets or as directed by the Engineer. The BEGIN ROAD WORK NEXT X MILES sign shall be revised to show appropriate work zone distance.
7. The Engineer may require duplicate warning signs on the median side of divided highways where median width will permit and traffic volumes justify the signing.
8. All signs shall be constructed in accordance with the details found in the "Standard Highway Sign Designs for Texas," latest edition. Sign details not shown in this manual shall be shown in the plans or the Engineer shall provide a detail to the Contractor before the sign is manufactured.
9. The temporary traffic control devices shown in the illustrations of the BC sheets are examples. As necessary, the Engineer will determine the most appropriate traffic control devices to be used.
10. Where highway construction or maintenance work is being undertaken, other than mobile operations as defined by the Texas Manual on Uniform Traffic Control Devices, CSJ limit signs are required. CSJ limit signs are shown on BC(2). The OBEY WARNING SIGNS STATE LAW sign, STAY ALERT TALK OR TEXT LATER and the WORK ZONE TRAFFIC FINES DOUBLE sign with plaque shall be erected in advance of the CSJ limits. The BEGIN ROAD WORK NEXT X MILES, CONTRACTOR and END ROAD WORK signs shall be erected at or near the CSJ limits. For mobile operations, CSJ limit signs are not required.
11. Traffic control devices should be in place only while work is actually in progress or a definite need exists.
12. The Engineer has the final decision on the location of all traffic control devices.
13. Inactive equipment and work vehicles, including workers' private vehicles must be parked away from travel lanes. They should be as close to the right-of-way line as possible, or located behind a barrier or guardrail, or as approved by the Engineer.

WORKER SAFETY NOTES:


1. Workers on foot who are exposed to traffic or to construction equipment within the right-of-way shall wear high-visibility safety apparel meeting the requirements of ISEA "American National Standard for High-Visibility Apparel," or equivalent revisions, and labeled as ANSI 107-2004 standard performance for Class 2 or 3 risk exposure. Class 3 garments should be considered for high traffic volume work areas or night time work.
2. Except in emergency situations, flagger stations shall be illuminated when flagging is used at night.

COMPLIANT WORKZONE TRAFFIC CONTROL DEVICES

1. Only pre-qualified products shall be used. The "Compliant Work Zone Traffic Control Devices List" (CWZTCD) describes pre-qualified products and their sources.
2. Work zone traffic control devices shall be compliant with the Manual for Assessing safety Hardware (MASH).


<p>THE DOCUMENTS BELOW CAN BE FOUND ON-LINE AT http://www.txdot.gov</p>
COMPLIANT WORK ZONE TRAFFIC CONTROL DEVICES LIST (CWZTCD)
DEPARTMENTAL MATERIAL SPECIFICATIONS (DMS)
MATERIAL PRODUCER LIST (MPL)
ROADWAY DESIGN MANUAL - SEE "MANUALS (ONLINE MANUALS)"
STANDARD HIGHWAY SIGN DESIGNS FOR TEXAS (SHSD)
TEXAS MANUAL ON UNIFORM TRAFFIC CONTROL DEVICES (TMUTCD)
TRAFFIC ENGINEERING STANDARD SHEETS

SHEET 1 OF 12

		<i>Texas Department of Transportation</i>	<i>Traffic Safety Division Standard</i>
<p>BARRICADE AND CONSTRUCTION GENERAL NOTES AND REQUIREMENTS</p> <p>BC (1) - 21</p>			
FILE:	bc-21.dgn	DN: TxDOT	ck: TxDOT
© TxDOT	November 2002	CONT	SECT
4-03	7-13	0904	02
9-07	8-14	JOB	HIGHWAY
5-10	5-21	047	VARIOUS
REVISIONS	DIST	COUNTY	SHEET NO.
AMA	POTTER	007	007


DISCLAIMER: The use of this standard is governed by the "Texas Engineering Practice Act". No warranty of any kind is made by TxDOT for any purpose whatsoever. TxDOT assumes no responsibility for the conversion of this standard to other formats or for incorrect results or damages resulting from its use.

TYPICAL LOCATION OF CROSSROAD SIGNS

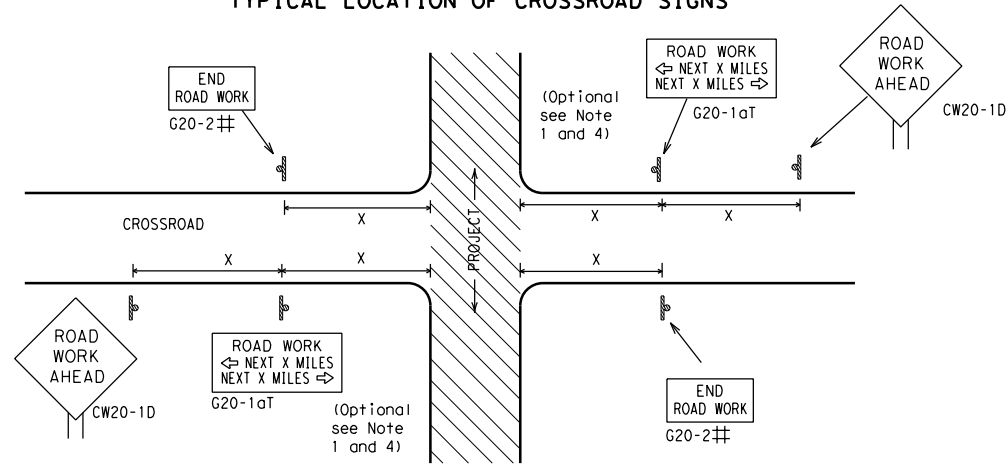

- ## May be mounted on back of "ROAD WORK AHEAD" (CW20-1D) sign with approval of Engineer. (See note 2 below)
- The typical minimum signing on a crossroad approach should be a "ROAD WORK AHEAD" (CW20-1D) sign and a (G20-2) "END ROAD WORK" sign, unless noted otherwise in plans.
 - The Engineer may use the reduced size 36" x 36" ROAD WORK AHEAD (CW20-1D) sign mounted back to back with the reduced size 36" x 18" "END ROAD WORK" (G20-2) sign on low volume crossroads (see Note 4 under "Typical Construction Warning Sign Size and Spacing"). See the "Standard Highway Sign Designs for Texas" manual for sign details. The Engineer may omit the advance warning signs on low volume crossroads. The Engineer will determine whether a road is low volume as per TMUTCD Part 5. This information shall be shown in the plans.
 - Based on existing field conditions, the Engineer/Inspector may require additional signs such as FLAGGER AHEAD, LOOSE GRAVEL, or other appropriate signs. When additional signs are required, these signs will be considered part of the minimum requirements. The Engineer/Inspector will determine the proper location and spacing of any sign not shown on the BC sheets, Traffic Control Plan sheets or the Work Zone Standard Sheets.
 - The "ROAD WORK NEXT X MILES" (G20-1aT) sign shall be required at high volume crossroads to advise motorists of the length of construction in either direction from the intersection. The Engineer will determine whether a roadway is considered high volume.
 - Additional traffic control devices may be shown elsewhere in the plans for higher volume crossroads.
 - When work occurs in the intersection area, appropriate traffic control devices, as shown elsewhere in the plans or as determined by the Engineer/Inspector, shall be in place.

T-INTERSECTION

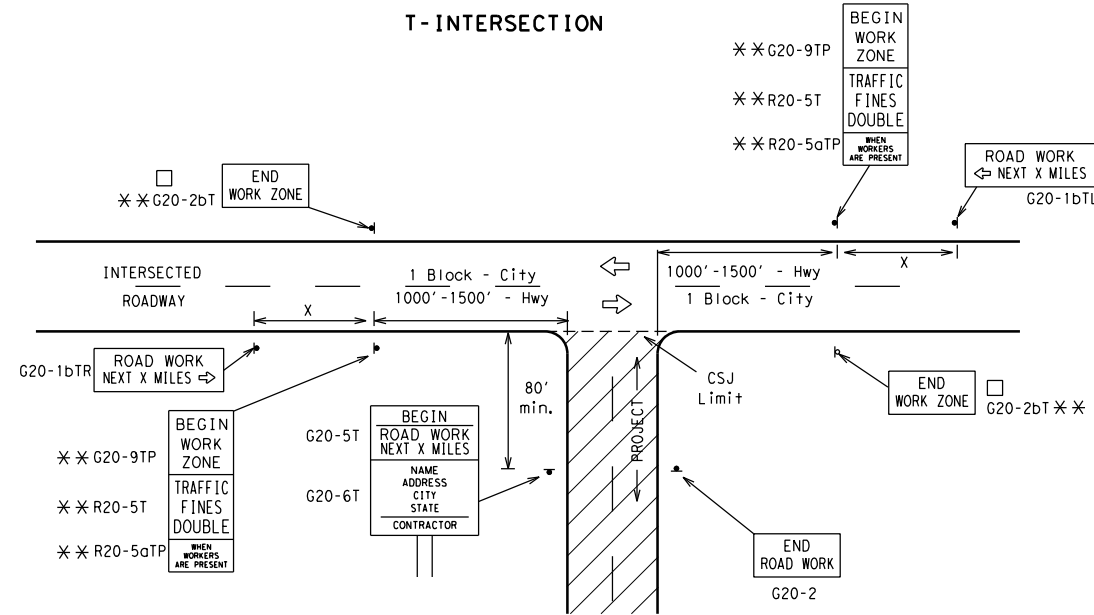

CSJ LIMITS AT T-INTERSECTION

- The Engineer will determine the types and location of any additional traffic control devices, such as a flagger and accompanying signs, or other signs, that should be used when work is being performed at or near an intersection.
- If construction closes the road at a T-intersection, the Contractor shall place the "CONTRACTOR NAME" (G20-6T) sign behind the Type 3 Barricades for the road closure (see BC(10) also). The "ROAD WORK NEXT X MILES" left arrow (G20-1bTL) and "ROAD WORK NEXT X MILES" right arrow (G20-1bTR) signs shall be replaced by the detour signing called for in the plans.

TYPICAL CONSTRUCTION WARNING SIGN SIZE AND SPACING^{1,5,6}

Sign Number or Series	SIZE		SPACING	
	Conventional Road	Expressway/Freeway	Posted Speed MPH	Sign Δ Spacing "x" Feet (Apprx.)
CW20 ⁴	48" x 48"	48" x 48"	30	120
CW21			35	160
CW22			40	240
CW23			45	320
CW25			50	400
CW1, CW2, CW7, CW8, CW9, CW11, CW14	48" x 48"	48" x 48"	55	500 ²
CW3, CW4, CW5, CW6, CW8-3, CW10, CW12			60	600 ²
			65	700 ²
			70	800 ²
			75	900 ²
	80	1000 ²		
	*	*	*	* ³


* For typical sign spacings on divided highways, expressways and freeways, see Part 6 of the "Texas Manual on Uniform Traffic Control Devices" (TMUTCD) typical application diagrams or TCP Standard Sheets.

Δ Minimum distance from work area to first Advance Warning sign nearest the work area and/or distance between each additional sign.

GENERAL NOTES


- Special or larger size signs may be used as necessary.
- Distance between signs should be increased as required to have 1500 feet advance warning.
- Distance between signs should be increased as required to have 1/2 mile or more advance warning.
- 36" x 36" "ROAD WORK AHEAD" (CW20-1D) signs may be used on low volume crossroads at the discretion of the Engineer as per TMUTCD Part 5. See Note 2 under "Typical Location of Crossroad Signs".
- Only diamond shaped warning sign sizes are indicated.
- See sign size listing in "TMUTCD", Sign Appendix or the "Standard Highway Sign Designs for Texas" manual for complete list of available sign design sizes.

WORK AREAS IN MULTIPLE LOCATIONS WITHIN CSJ LIMITS

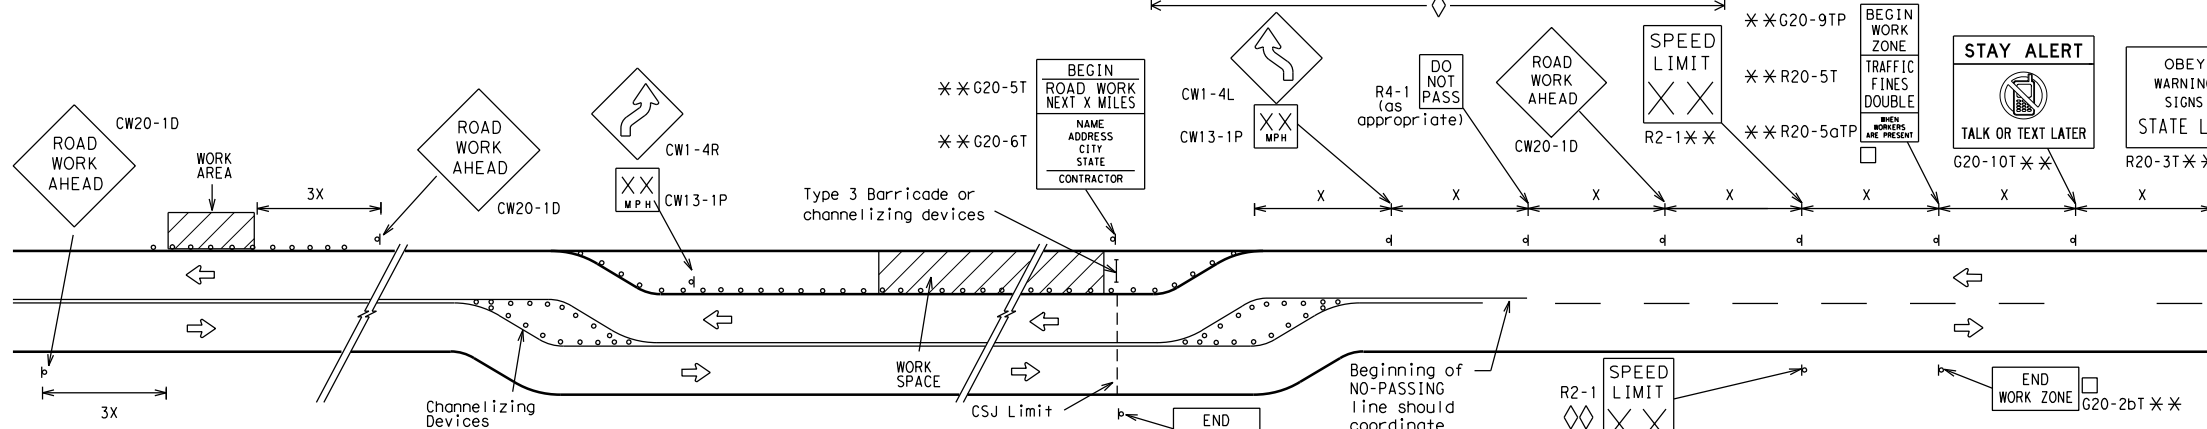

When extended distances occur between minimal work spaces, the Engineer/Inspector should ensure additional "ROAD WORK AHEAD" (CW20-1D) signs are placed in advance of these work areas to remind drivers they are still within the project limits. See the applicable TCP sheets for exact location and spacing of signs and channelizing devices.

SAMPLE LAYOUT OF SIGNING FOR WORK BEGINNING DOWNSTREAM OF THE CSJ LIMITS

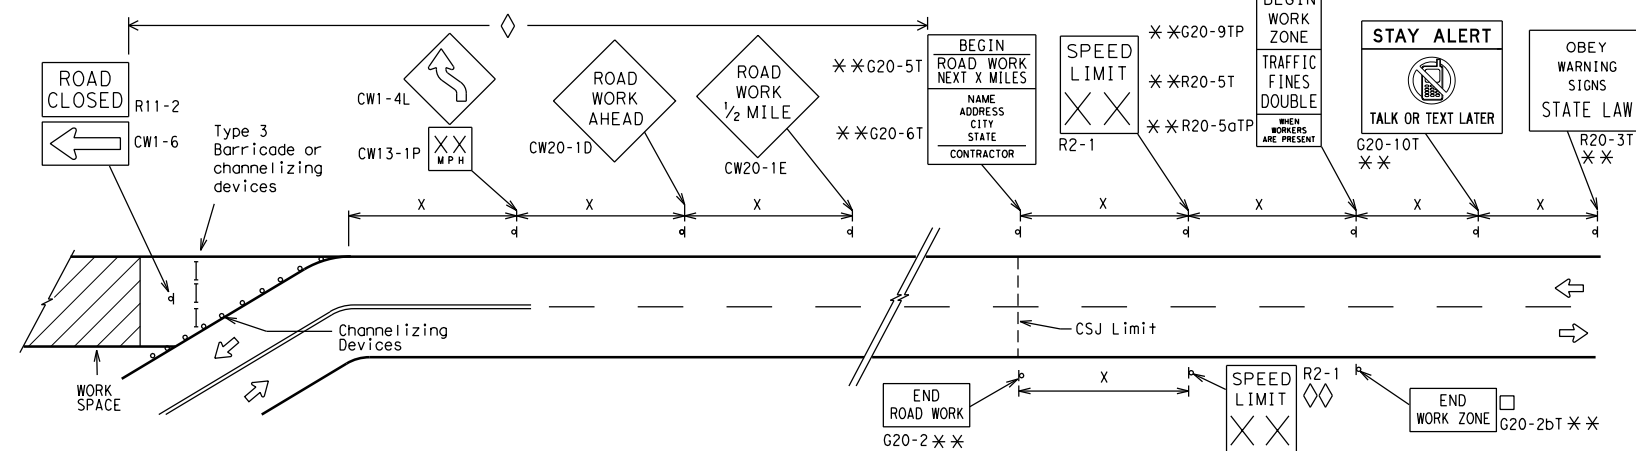

NOTES

- The Contractor shall determine the appropriate distance to be placed on the G20-1 series signs and "BEGIN ROAD WORK NEXT X MILES" (G20-5T) sign for each specific project. This distance shall replace the "x" and shall be rounded to the nearest whole mile with the approval of the Engineer. No decimals shall be used.
- The "BEGIN WORK ZONE" (G20-9TP) and "END WORK ZONE" (G20-2bT) shall be used as shown on the sample layout when advance signs are required outside the CSJ Limits. They inform the motorist of entering or leaving a part of the work zone lying outside the CSJ Limits where traffic fines may double if workers are present.
 - CSJ limit signing is required for highway construction and maintenance work, with the exception of mobile operations.
 - Area for placement of "ROAD WORK AHEAD" (CW20-1D) sign and other signs or devices as called for on the Traffic Control Plan.
 - Contractor will install a regulatory speed limit sign at the end of the work zone.

LEGEND	
—	Type 3 Barricade
○ ○ ○	Channelizing Devices
■	Sign
X	See Typical Construction Warning Sign Size and Spacing chart or the TMUTCD for sign spacing requirements.

SHEET 2 OF 12



BARRICADE AND CONSTRUCTION PROJECT LIMIT

BC (2) - 21


FILE: bc-21.dgn	DN: TxDOT	CK: TxDOT	DW: TxDOT	CK: TxDOT
© TxDOT November 2002	CONT	SECT	JOB	HIGHWAY
REVISIONS	0904	02	047	VARIOUS
9-07 8-14	DIST	COUNTY	SHEET NO.	
7-13 5-21	AMA	POTTER	008	

DATE: FILE:

TYPICAL APPLICATION OF WORK ZONE SPEED LIMIT SIGNS

Work zone speed limits shall be regulatory, established in accordance with the "Procedures for Establishing Speed Zones," and approved by the Texas Transportation Commission, or by City Ordinance when within Incorporated City Limits.

Reduced speeds should only be posted in the vicinity of work activity and not throughout the entire project. Regulatory work zone speed signs (R2-1) shall be removed or covered during periods when they are not needed.

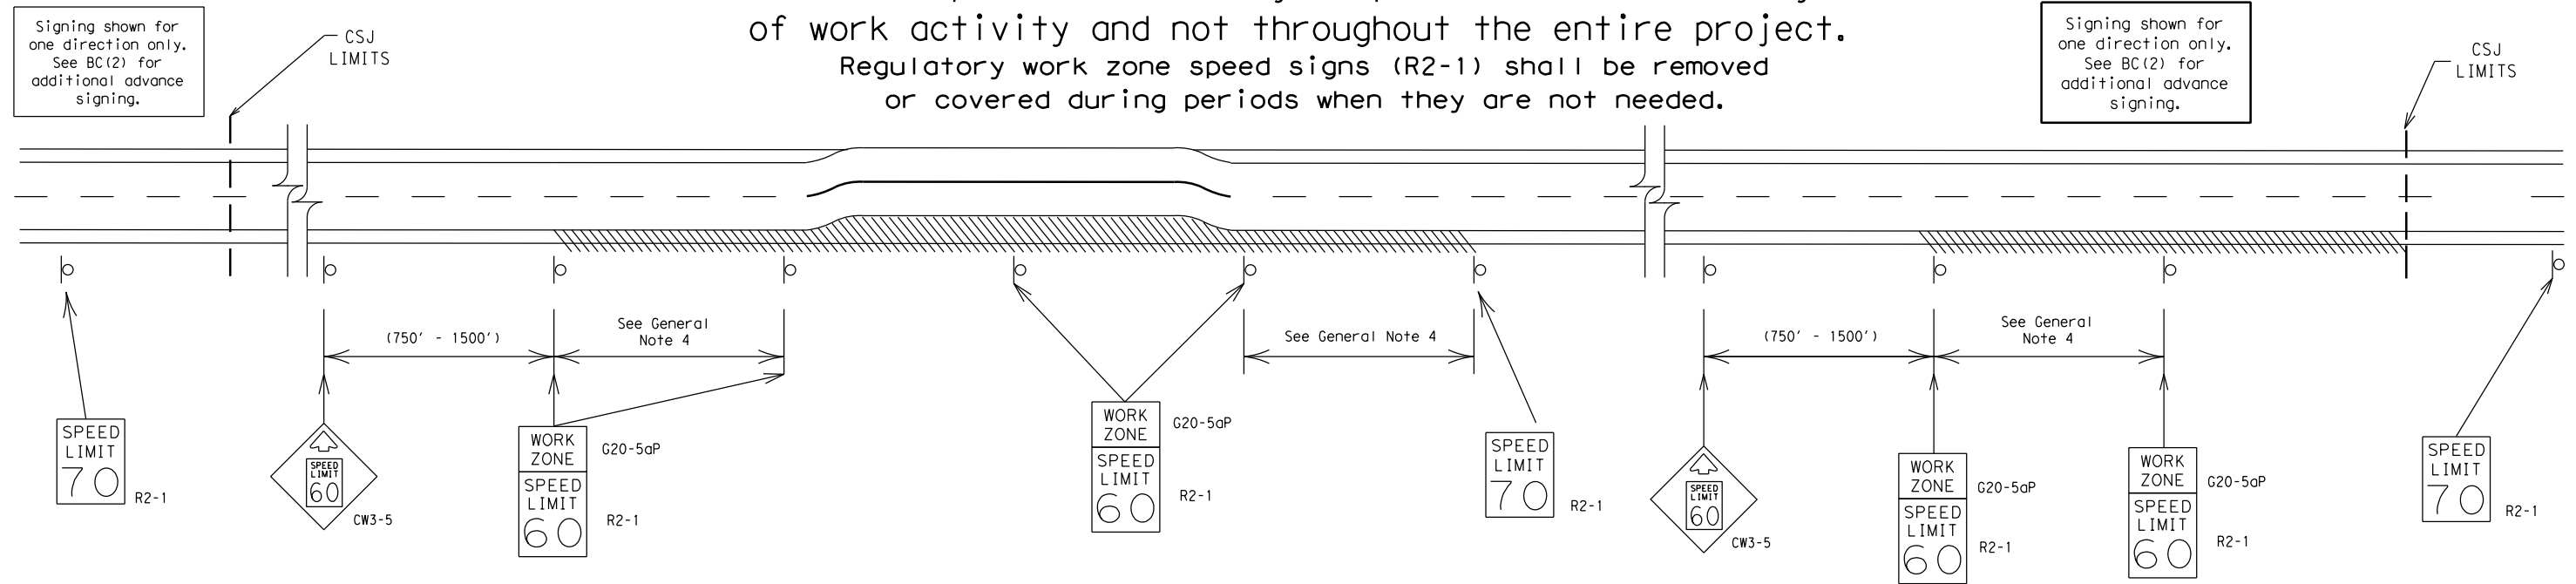

GUIDANCE FOR USE:

LONG/INTERMEDIATE TERM WORK ZONE SPEED LIMITS

This type of work zone speed limit should be included on the design of the traffic control plans when restricted geometrics with a lower design speed are present in the work zone and modification of the geometrics to a higher design speed is not feasible.

Long/Intermediate Term Work Zone Speed Limit signs, when approved as described above, should be posted and visible to the motorist when work activity is present. Work activity may also be defined as a change in the roadway that requires a reduced speed for motorists to safely negotiate the work area, including:

- rough road or damaged pavement surface
- substantial alteration of roadway geometrics (diversions)
- construction detours
- grade
- width
- other conditions readily apparent to the driver

As long as any of these conditions exist, the work zone speed limit signs should remain in place.

SHORT TERM WORK ZONE SPEED LIMITS

This type of work zone speed limit may be included on the design of the traffic control plans when workers or equipment are not behind concrete barrier, when work activity is within 10 feet of the traveled way or actually in the traveled way.

Short Term Work Zone Speed Limit signs should be posted and visible to the motorists only when work activity is present. When work activity is not present, signs shall be removed or covered. (See Removing or Covering on BC(4)).

GENERAL NOTES

- Regulatory work zone speed limits should be used only for sections of construction projects where speed control is of major importance.
- Regulatory work zone speed limit signs shall be placed on supports at a 7 foot minimum mounting height.
- Speed zone signs are illustrated for one direction of travel and are normally posted for each direction of travel.
- Frequency of work zone speed limit signs should be:

40 mph and greater	0.2 to 2 miles
35 mph and less	0.2 to 1 mile
- Regulatory speed limit signs shall have black legend and border on a white reflective background (See "Reflective Sheeting" on BC(4)).
- Fabrication, erection and maintenance of the "ADVANCE SPEED LIMIT" (CW3-5) sign, "WORK ZONE" (G20-5aP) plaque and the "SPEED LIMIT" (R2-1) signs shall not be paid for directly, but shall be considered subsidiary to Item 502.
- Turning signs from view, laying signs over or down will not be allowed, unless as otherwise noted under "REMOVING OR COVERING" on BC(4).
- Techniques that may help reduce traffic speeds include but are not limited to:
 - Law enforcement.
 - Flagger stationed next to sign.
 - Portable changeable message sign (PCMS).
 - Low-power (drone) radar transmitter.
 - Speed monitor trailers or signs.
- Speeds shown on details above are for illustration only. Work Zone Speed Limits should only be posted as approved for each project.
- For more specific guidance concerning the type of work, work zone conditions and factors impacting allowable regulatory construction speed zone reduction see TxDOT form #1204 in the TxDOT e-form system.

DISCLAIMER: The use of this standard is governed by the "Texas Engineering Practice Act." No warranty of any kind is made by TxDOT for any purpose whatsoever. TxDOT assumes no responsibility for the conversion of this standard to other formats or for incorrect results or damages resulting from its use.

DATE:
FILE:

SHEET 3 OF 12




BARRICADE AND CONSTRUCTION WORK ZONE SPEED LIMIT

BC (3) - 21

FILE:	bc-21.dgn	DN: TxDOT	CK: TxDOT	DW: TxDOT	CK: TxDOT
© TxDOT	November 2002	CONT	SECT	JOB	HIGHWAY
REVISIONS		0904	02	047	VARIOUS
9-07	8-14	DIST	COUNTY	SHEET NO.	
7-13	5-21	AMA	POTTER	009	

DISCLAIMER: The use of this standard is governed by the "Texas Engineering Practice Act". No warranty of any kind is made by TxDOT for any purpose whatsoever. TxDOT assumes no responsibility for the conversion of this standard to other formats or for incorrect results or damages resulting from its use.


TYPICAL MINIMUM CLEARANCES FOR LONG TERM AND INTERMEDIATE TERM SIGNS

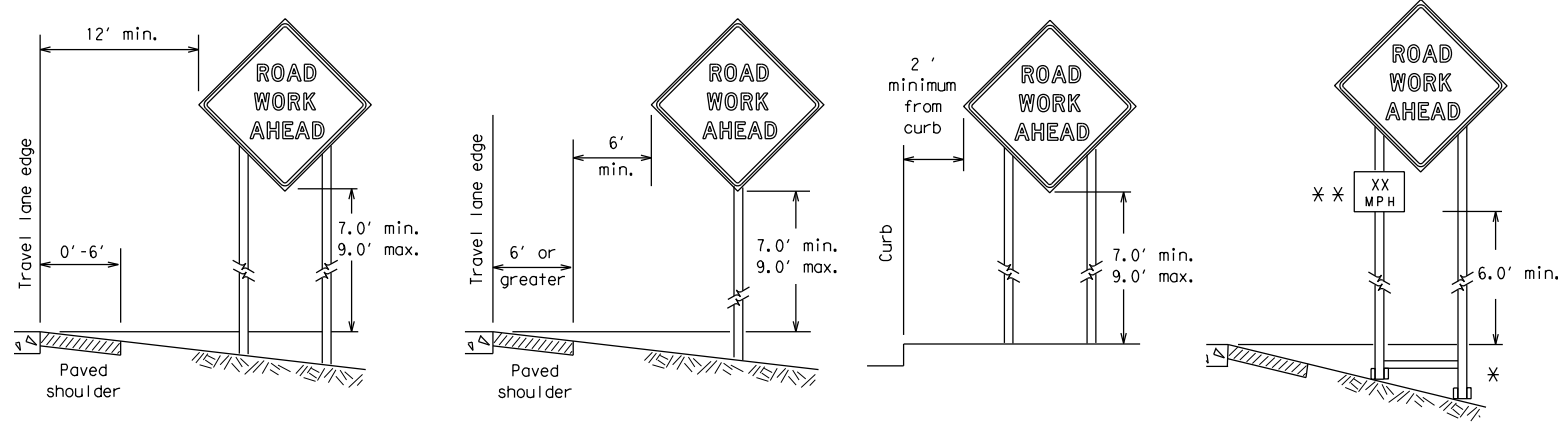

* When placing skid supports on unlevel ground, the leg post lengths must be adjusted so the sign appears straight and plumb. Objects shall NOT be placed under skids as a means of leveling.

** When plaques are placed on dual-leg supports, they should be attached to the upright nearest the travel lane. Supplemental plaques (advisory or distance) should not cover the surface of the parent sign.

ATTACHMENT FOR SIGN SUPPORTS

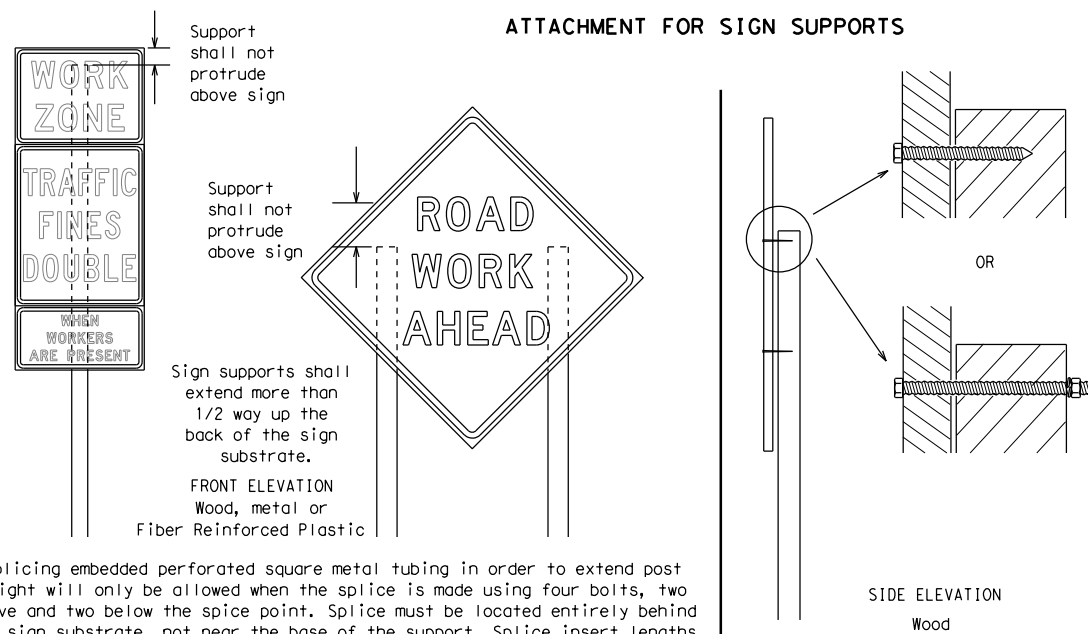


Nails shall NOT be allowed. Each sign shall be attached directly to the sign support. Multiple signs shall not be joined or spliced by any means. Wood supports shall not be extended or repaired by splicing or other means.

Splicing embedded perforated square metal tubing in order to extend post height will only be allowed when the splice is made using four bolts, two above and two below the splice point. Splice must be located entirely behind the sign substrate, not near the base of the support. Splice insert lengths should be at least 5 times nominal post size, centered on the splice and of at least the same gauge material.

STOP/SLOW PADDLES

1. STOP/SLOW paddles are the primary method to control traffic by flaggers. The STOP/SLOW paddle size should be 24" x 24".
2. STOP/SLOW paddles shall be retroreflectORIZED when used at night.
3. STOP/SLOW paddles may be attached to a staff with a minimum length of 6' to the bottom of the sign.
4. Any lights incorporated into the STOP or SLOW paddle faces shall only be as specifically described in Section 6E.03 Hand Signaling Devices in the TMUTCD.

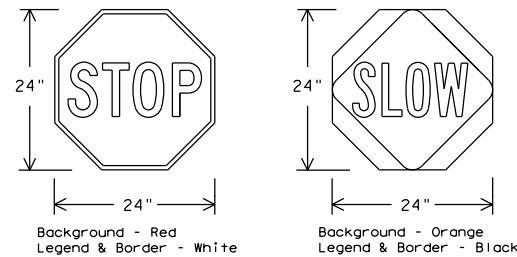

SHEETING REQUIREMENTS (WHEN USED AT NIGHT)		
USAGE	COLOR	SIGN FACE MATERIAL
BACKGROUND	RED	TYPE B OR C SHEETING
BACKGROUND	ORANGE	TYPE B _{FL} OR C _{FL} SHEETING
LEGEND & BORDER	WHITE	TYPE B OR C SHEETING
LEGEND & BORDER	BLACK	ACRYLIC NON-REFLECTIVE FILM

CONTRACTOR REQUIREMENTS FOR MAINTAINING PERMANENT SIGNS WITHIN THE PROJECT LIMITS

1. Permanent signs are used to give notice of traffic laws or regulations, call attention to conditions that are potentially hazardous to traffic operations, show route designations, destinations, directions, distances, services, points of interest, and other geographical, recreational, specific service (LOGO), or cultural information. Drivers proceeding through a work zone need the same, if not better route guidance as normally installed on a roadway without construction.
2. When permanent regulatory or warning signs conflict with work zone conditions, remove or cover the permanent signs until the permanent sign message matches the roadway condition. For details for covering large guide signs see the TS-CD standard.
3. When existing permanent signs are moved and relocated due to construction purposes, they shall be visible to motorists at all times.
4. If existing signs are to be relocated on their original supports, they shall be installed on crashworthy bases as shown on the SMD Standard sheets. The signs shall meet the required mounting heights shown on the BC Sheets or the SMD Standards. This work should be paid for under the appropriate pay item for relocating existing signs.
5. If permanent signs are to be removed and relocated using temporary supports, the Contractor shall use crashworthy supports as shown on the BC standard sheets, TLRs standard sheets or the CWZTCD list. The signs shall meet the required mounting heights shown on the BC, or the SMD standard sheets during construction. This work should be paid for under the appropriate pay item for relocating existing signs.
6. Any sign or traffic control device that is struck or damaged by the Contractor or his/her construction equipment shall be replaced as soon as possible by the Contractor to ensure proper guidance for the motorists. This will be subsidiary to Item 502.

GENERAL NOTES FOR WORK ZONE SIGNS

1. Contractor shall install and maintain signs in a straight and plumb condition and/or as directed by the Engineer.
2. Wooden sign posts shall be painted white.
3. Barricades shall NOT be used as sign supports.
4. All signs shall be installed in accordance with the plans or as directed by the Engineer. Signs shall be used to regulate, warn, and guide the traveling public safely through the work zone.
5. The Contractor may furnish either the sign design shown in the plans or in the "Standard Highway Sign Designs for Texas" (SHSD). The Engineer/Inspector may require the Contractor to furnish other work zone signs that are shown in the TMUTCD but may have been omitted from the plans. Any variation in the plans shall be documented by written agreement between the Engineer and the Contractor's Responsible Person. All changes must be documented in writing before being implemented. This can include documenting the changes in the Inspector's TxDOT diary and having both the Inspector and Contractor initial and date the agreed upon changes.
6. The Contractor shall furnish sign supports listed in the "Compliant Work Zone Traffic Control Device List" (CWZTCD) for small roadside signs. Supports for temporary large roadside signs shall meet the requirements detailed on the Temporary Large Roadside Signs (TLRS) standard sheets. The Contractor shall install the sign support in accordance with the manufacturer's recommendations. If there is a question regarding installation procedures, the Contractor shall furnish the Engineer a copy of the manufacturer's installation recommendations so the Engineer can verify the correct procedures are being followed.
7. The Contractor is responsible for installing signs on approved supports and replacing signs with damaged or cracked substrates and/or damaged or marred reflective sheeting as directed by the Engineer/Inspector.
8. Identification markings may be shown only on the back of the sign substrate. The maximum height of letters and/or company logos used for identification shall be 1 inch.
9. The Contractor shall replace damaged wood posts. New or damaged wood sign posts shall not be spliced.

DURATION OF WORK (as defined by the "Texas Manual on Uniform Traffic Control Devices" Part 6)

1. The types of sign supports, sign mounting height, the size of signs, and the type of sign substrates can vary based on the type of work being performed. The Engineer is responsible for selecting the appropriate size sign for the type of work being performed. The Contractor is responsible for ensuring the sign support, sign mounting height and substrate meets manufacturer's recommendations in regard to crashworthiness and duration of work requirements.
 - a. Long-term stationary - work that occupies a location more than 3 days.
 - b. Intermediate-term stationary - work that occupies a location more than one daylight period up to 3 days, or nighttime work lasting more than one hour.
 - c. Short-term stationary - daytime work that occupies a location for more than 1 hour in a single daylight period.
 - d. Short, duration - work that occupies a location up to 1 hour.
 - e. Mobile - work that moves continuously or intermittently (stopping for up to approximately 15 minutes.)

SIGN MOUNTING HEIGHT

1. The bottom of Long-term/Intermediate-term signs shall be at least 7 feet, but not more than 9 feet, above the paved surface, except as shown for supplemental plaques mounted below other signs.
2. The bottom of Short-term/Short Duration signs shall be a minimum of 1 foot above the pavement surface but no more than 2 feet above the ground.
3. Long-term/Intermediate-term Signs may be used in lieu of Short-term/Short Duration signing.
4. Short-term/Short Duration signs shall be used only during daylight and shall be removed at the end of the workday or raised to appropriate Long-term/Intermediate sign height.
5. Regulatory signs shall be mounted at least 7 feet, but not more than 9 feet, above the paved surface regardless of work duration.

SIZE OF SIGNS

1. The Contractor shall furnish the sign sizes shown on BC (2) unless otherwise shown in the plans or as directed by the Engineer.

SIGN SUBSTRATES

1. The Contractor shall ensure the sign substrate is installed in accordance with the manufacturer's recommendations for the type of sign support that is being used. The CWZTCD lists each substrate that can be used on the different types and models of sign supports.
2. "Mesh" type materials are NOT an approved sign substrate, regardless of the tightness of the weave.
3. All wooden individual sign panels fabricated from 2 or more pieces shall have one or more plywood cleat, 1/2" thick by 6" wide, fastened to the back of the sign and extending fully across the sign. The cleat shall be attached to the back of the sign using wood screws that do not penetrate the face of the sign panel. The screws shall be placed on both sides of the splice and spaced at 6" centers. The Engineer may approve other methods of splicing the sign face.

REFLECTIVE SHEETING

1. All signs shall be retroreflective and constructed of sheeting meeting the color and retro-reflectivity requirements of DMS-8300 for rigid signs or DMS-8310 for roll-up signs. The web address for DMS specifications is shown on BC(1).
2. White sheeting, meeting the requirements of DMS-8300 Type A, shall be used for signs with a white background.
3. Orange sheeting, meeting the requirements of DMS-8300 Type B_{FL} or Type C_{FL}, shall be used for rigid signs with orange backgrounds.

SIGN LETTERS

1. All sign letters and numbers shall be clear, and open rounded type uppercase alphabet letters as approved by the Federal Highway Administration (FHWA) and as published in the "Standard Highway Sign Design for Texas" manual. Signs, letters and numbers shall be of first class workmanship in accordance with Department Standards and Specifications.

REMOVING OR COVERING

1. When sign messages may be confusing or do not apply, the signs shall be removed or completely covered.
2. Long-term stationary or intermediate stationary signs installed on square metal tubing may be turned away from traffic 90 degrees when the sign message is not applicable. This technique may not be used for signs installed in the median of divided highways or near any intersections where the sign may be seen from approaching traffic.
3. Signs installed on wooden skids shall not be turned at 90 degree angles to the roadway. These signs should be removed or completely covered when not required.
4. When signs are covered, the material used shall be opaque, such as heavy mil black plastic, or other materials which will cover the entire sign face and maintain their opaque properties under automobile headlights at night, without damaging the sign sheeting.
5. Burlap shall NOT be used to cover signs.
6. Duct tape or other adhesive material shall NOT be affixed to a sign face.
7. Signs and anchor stubs shall be removed and holes backfilled upon completion of work.

SIGN SUPPORT WEIGHTS

1. Where sign supports require the use of weights to keep from turning over, the use of sandbags with dry, cohesionless sand should be used.
2. The sandbags will be tied shut to keep the sand from spilling and to maintain a constant weight.
3. Rock, concrete, iron, steel or other solid objects shall not be permitted for use as sign support weights.
4. Sandbags should weigh a minimum of 35 lbs and a maximum of 50 lbs.
5. Sandbags shall be made of a durable material that tears upon vehicular impact. Rubber (such as tire inner tubes) shall NOT be used.
6. Rubber ballasts designed for channelizing devices should not be used for ballast on portable sign supports. Sign supports designed and manufactured with rubber bases may be used when shown on the CWZTCD list.
7. Sandbags shall only be placed along or laid over the base supports of the traffic control device and shall not be suspended above ground level or hung with rope, wire, chains or other fasteners. Sandbags shall be placed along the length of the skids to weigh down the sign support.
8. Sandbags shall NOT be placed under the skid and shall not be used to level sign supports placed on slopes.

FLAGS ON SIGNS

1. Flags may be used to draw attention to warning signs. When used, the flag shall be 16 inches square or larger and shall be orange or fluorescent red-orange in color. Flags shall not be allowed to cover any portion of the sign face.

SHEET 4 OF 12





BARRICADE AND CONSTRUCTION TEMPORARY SIGN NOTES

BC (4) - 21

FILE: bc-21.dgn	DN: TxDOT	CK: TxDOT	DW: TxDOT	CK: TxDOT
© TxDOT November 2002	CONT	SECT	JOB	HIGHWAY
REVISIONS	0904	02	047	VARIOUS
9-07 8-14	DIST	COUNTY	SHEET NO.	
7-13 5-21	AMA	POTTER	010	


DATE: FILE:

DISCLAIMER: The use of this standard is governed by the "Texas Engineering Practice Act". No warranty of any kind is made by TxDOT for any purpose whatsoever. TxDOT assumes no responsibility for the conversion of this standard to other formats or for incorrect results or damages resulting from its use.

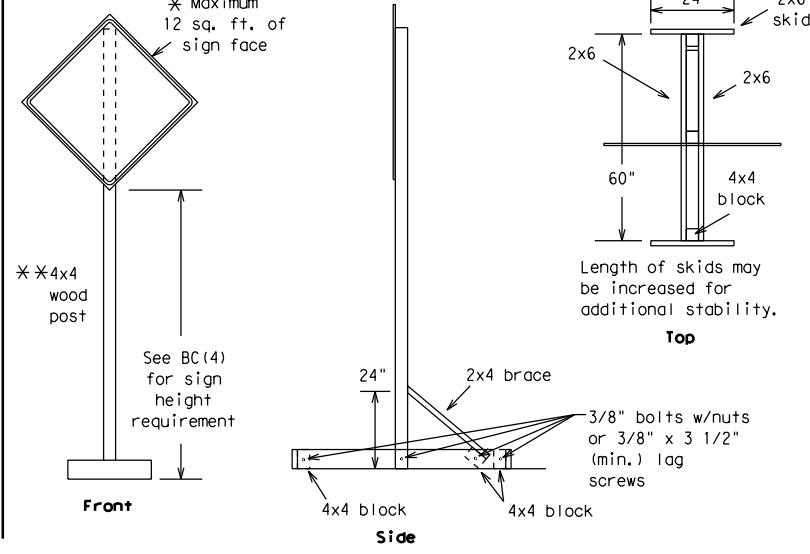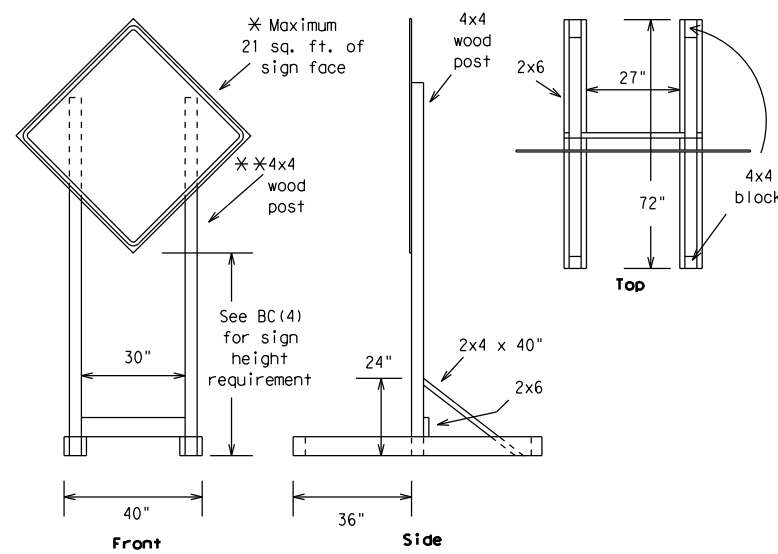



SKID MOUNTED WOOD SIGN SUPPORTS

* LONG/INTERMEDIATE TERM STATIONARY - PORTABLE SKID MOUNTED SIGN SUPPORTS

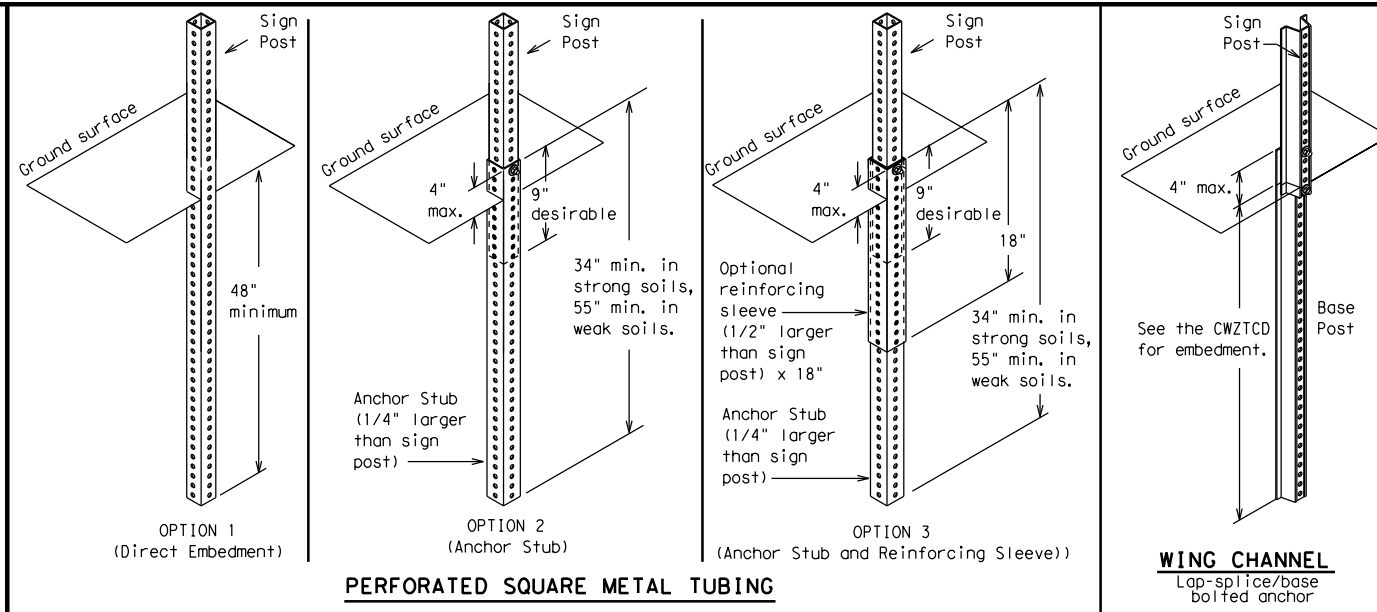

GROUND MOUNTED SIGN SUPPORTS

Refer to the CWZTCD and the manufacturer's installation procedure for each type sign support. The maximum sign square footage shall adhere to the manufacturer's recommendation. Two post installations can be used for larger signs.

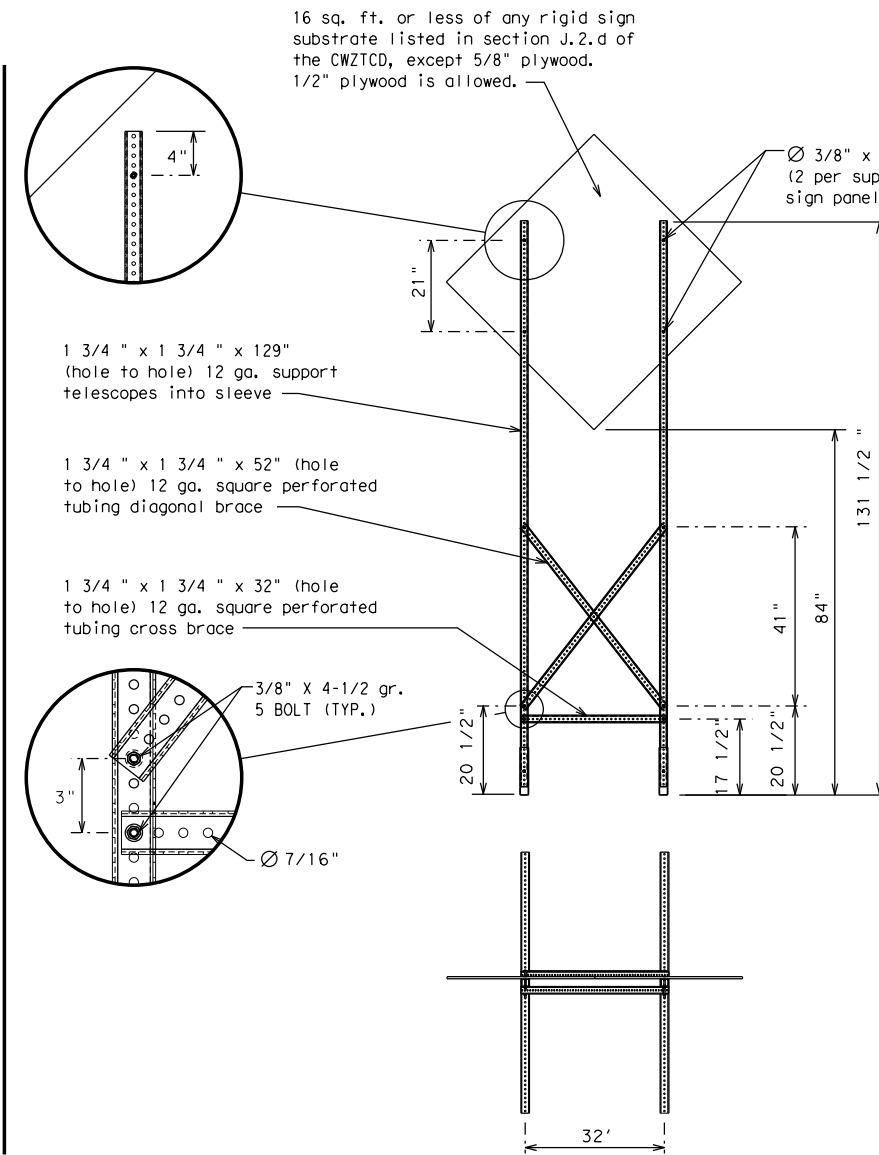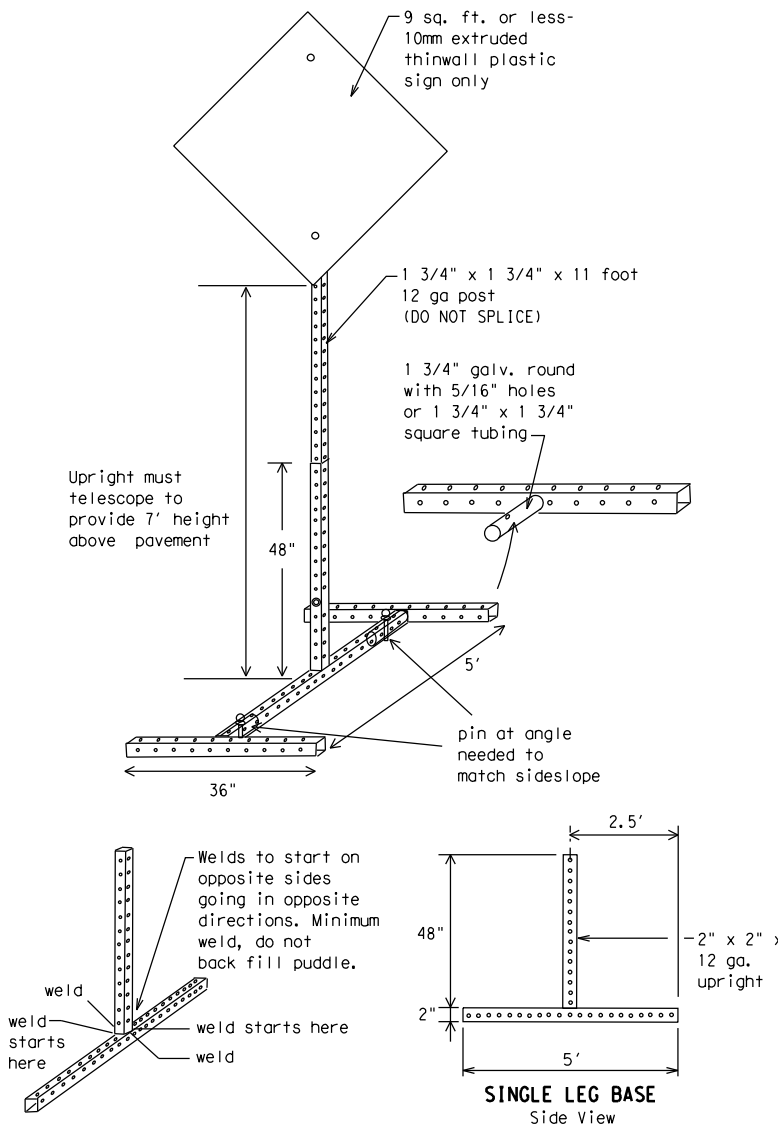

SKID MOUNTED PERFORATED SQUARE STEEL TUBING SIGN SUPPORTS

* LONG/INTERMEDIATE TERM STATIONARY - PORTABLE SKID MOUNTED SIGN SUPPORTS

WEDGE ANCHORS

Both steel and plastic Wedge Anchor Systems as shown on the SMD Standard Sheets may be used as temporary sign supports for signs up to 10 square feet of sign face. They may be set in concrete or in sturdy soils if approved by the Engineer. (See web address for "Traffic Engineering Standard Sheets" on BC(1)).

OTHER DESIGNS

MORE DETAILS OF APPROVED LONG/INTERMEDIATE AND SHORT TERM SUPPORTS CAN BE FOUND ON THE CWZTCD LIST. SEE BC(1) FOR WEBSITE LOCATION.

GENERAL NOTES

1. Nails may be used in the assembly of wooden sign supports, but 3/8" bolts with nuts or 3/8" x 3 1/2" lag screws must be used on every joint for final connection.
2. No more than 2 sign posts shall be placed within a 7 ft. circle, except for specific materials noted on the CWZTCD List.
3. When project is completed, all sign supports and foundations shall be removed from the project site. This will be considered subsidiary to Item 502.

- * See BC(4) for definition of "Work Duration."
- ** Wood sign posts MUST be one piece. Splicing will NOT be allowed. Posts shall be painted white.
- See the CWZTCD for the type of sign substrate that can be used for each approved sign support.

SHEET 5 OF 12



BARRICADE AND CONSTRUCTION TYPICAL SIGN SUPPORT

BC(5) - 21

FILE: bc-21.dgn	DN: TxDOT	CK: TxDOT	DW: TxDOT	CK: TxDOT
© TxDOT November 2002	CONT	SECT	JOB	HIGHWAY
REVISIONS	0904	02	047	VARIOUS
9-07 8-14	DIST	COUNTY	SHEET NO.	
7-13 5-21	AMA	POTTER	011	

DATE:
FILE:

WHEN NOT IN USE, REMOVE THE PCMS FROM THE RIGHT-OF-WAY OR PLACE THE PCMS BEHIND BARRIER OR GUARDRAIL WITH SIGN PANEL TURNED PARALLEL TO TRAFFIC

RECOMMENDED PHASES AND FORMATS FOR PCMS MESSAGES DURING ROADWORK ACTIVITIES

(The Engineer may approve other messages not specifically covered here.)

PORTABLE CHANGEABLE MESSAGE SIGNS

- The Engineer/Inspector shall approve all messages used on portable changeable message signs (PCMS).
- Messages on PCMS should contain no more than 8 words (about four to eight characters per word), not including simple words such as "TO," "FOR," "AT," etc.
- Messages should consist of a single phase, or two phases that alternate. Three-phase messages are not allowed. Each phase of the message should convey a single thought, and must be understood by itself.
- Use the word "EXIT" to refer to an exit ramp on a freeway; i.e., "EXIT CLOSED." Do not use the term "RAMP."
- Always use the route or interstate designation (IH, US, SH, FM) along with the number when referring to a roadway.
- When in use, the bottom of a stationary PCMS message panel should be a minimum 7 feet above the roadway, where possible.
- The message term "WEEKEND" should be used only if the work is to start on Saturday morning and end by Sunday evening at midnight. Actual days and hours of work should be displayed on the PCMS if work is to begin on Friday evening and/or continue into Monday morning.
- The Engineer/Inspector may select one of two options which are available for displaying a two-phase message on a PCMS. Each phase may be displayed for either four seconds each or for three seconds each.
- Do not "flash" messages or words included in a message. The message should be steady burn or continuous while displayed.
- Do not present redundant information on a two-phase message; i.e., keeping two lines of the message the same and changing the third line.
- Do not use the word "Danger" in message.
- Do not display the message "LANES SHIFT LEFT" or "LANES SHIFT RIGHT" on a PCMS. Drivers do not understand the message.
- Do not display messages that scroll horizontally or vertically across the face of the sign.
- The following table lists abbreviated words and two-word phrases that are acceptable for use on a PCMS. Both words in a phrase must be displayed together. Words or phrases not on this list should not be abbreviated, unless shown in the TMUTCD.
- PCMS character height should be at least 18 inches for trailer mounted units. They should be visible from at least 1/2 (.5) mile and the text should be legible from at least 600 feet at night and 800 feet in daylight. Truck mounted units must have a character height of 10 inches and must be legible from at least 400 feet.
- Each line of text should be centered on the message board rather than left or right justified.
- If disabled, the PCMS should default to an illegible display that will not alarm motorists and will only be used to alert workers that the PCMS has malfunctioned. A pattern such as a series of horizontal solid bars is appropriate.

Phase 1: Condition Lists

Road/Lane/Ramp Closure List

FREEWAY CLOSED X MILE
ROAD CLOSED AT SH XXX
ROAD CLSD AT FM XXXX
RIGHT X LANES CLOSED
CENTER LANE CLOSED
NIGHT LANE CLOSURES
VARIOUS LANES CLOSED
EXIT CLOSED
MALL DRIVEWAY CLOSED
XXXXXXXX BLVD CLOSED

Other Condition List

FRONTAGE ROAD CLOSED
SHOULDER CLOSED XXX FT
RIGHT LN CLOSED XXX FT
RIGHT X LANES OPEN
DAYTIME LANE CLOSURES
I-XX SOUTH EXIT CLOSED
EXIT XXX CLOSED X MILE
RIGHT LN TO BE CLOSED
X LANES CLOSED TUE - FRI
ROADWORK XXX FT
FLAGGER XXXX FT
RIGHT LN NARROWS XXXX FT
MERGING TRAFFIC XXXX FT
LOOSE GRAVEL XXXX FT
DETOUR X MILE
ROADWORK PAST SH XXXX
BUMP XXXX FT
TRAFFIC SIGNAL XXXX FT
ROAD REPAIRS XXXX FT
LANE NARROWS XXXX FT
TWO-WAY TRAFFIC XX MILE
CONST TRAFFIC XXX FT
UNEVEN LANES XXXX FT
ROUGH ROAD XXXX FT
ROADWORK NEXT FRI-SUN
US XXX EXIT X MILES
LANES SHIFT *

* LANES SHIFT in Phase 1 must be used with STAY IN LANE in Phase 2.

Phase 2: Possible Component Lists

Action to Take/Effect on Travel List

MERGE RIGHT
DETOUR NEXT X EXITS
USE EXIT XXX
STAY ON US XXX SOUTH
TRUCKS USE US XXX N
WATCH FOR TRUCKS
EXPECT DELAYS
REDUCE SPEED XXX FT
USE OTHER ROUTES
STAY IN LANE *

Location List

AT FM XXXX
BEFORE RAILROAD CROSSING
NEXT X MILES
PAST US XXX EXIT
XXXXXXXX TO XXXXXXX
US XXX TO FM XXXX

Warning List

SPEED LIMIT XX MPH
MAXIMUM SPEED XX MPH
MINIMUM SPEED XX MPH
ADVISORY SPEED XX MPH
RIGHT LANE EXIT
USE CAUTION
DRIVE SAFELY
DRIVE WITH CARE

** Advance Notice List

TUE-FRI XX AM-X PM
APR XX-XX X PM-X AM
BEGINS MONDAY
BEGINS MAY XX
MAY X-X XX PM - XX AM
NEXT FRI-SUN
XX AM TO XX PM
NEXT TUE AUG XX
TONIGHT XX PM-XX AM

** See Application Guidelines Note 6.

APPLICATION GUIDELINES

- Only 1 or 2 phases are to be used on a PCMS.
- The 1st phase (or both) should be selected from the "Road/Lane/Ramp Closure List" and the "Other Condition List".
- A 2nd phase can be selected from the "Action to Take/Effect on Travel, Location, General Warning, or Advance Notice Phase Lists".
- A Location Phase is necessary only if a distance or location is not included in the first phase selected.
- If two PCMS are used in sequence, they must be separated by a minimum of 1000 ft. Each PCMS shall be limited to two phases, and should be understandable by themselves.
- For advance notice, when the current date is within seven days of the actual work date, calendar days should be replaced with days of the week. Advance notification should typically be for no more than one week prior to the work.

WORDING ALTERNATIVES

- The words RIGHT, LEFT and ALL can be interchanged as appropriate.
- Roadway designations IH, US, SH, FM and LP can be interchanged as appropriate.
- EAST, WEST, NORTH and SOUTH (or abbreviations E, W, N and S) can be interchanged as appropriate.
- Highway names and numbers replaced as appropriate.
- ROAD, HIGHWAY and FREEWAY can be interchanged as needed.
- AHEAD may be used instead of distances if necessary.
- FT and MI, MILE and MILES interchanged as appropriate.
- AT, BEFORE and PAST interchanged as needed.
- Distances or AHEAD can be eliminated from the message if a location phase is used.

PCMS SIGNS WITHIN THE R.O.W. SHALL BE BEHIND GUARDRAIL OR CONCRETE BARRIER OR SHALL HAVE A MINIMUM OF FOUR (4) PLASTIC DRUMS PLACED PERPENDICULAR TO TRAFFIC ON THE UPSTREAM SIDE OF THE PCMS, WHEN EXPOSED TO ONE DIRECTION OF TRAFFIC. WHEN EXPOSED TO TWO WAY TRAFFIC, THE FOUR DRUMS SHOULD BE PLACED WITH ONE DRUM AT EACH OF THE FOUR CORNERS OF THE UNIT.

FULL MATRIX PCMS SIGNS

- When Full Matrix PCMS signs are used, the character height and legibility/visibility requirements shall be maintained as listed in Note 15 under "PORTABLE CHANGEABLE MESSAGE SIGNS" above.
- When symbol signs, such as the "Flagger Symbol" (CW20-7) are represented graphically on the Full Matrix PCMS sign and, with the approval of the Engineer, it shall maintain the legibility/visibility requirement listed above.
- When symbol signs are represented graphically on the Full Matrix PCMS, they shall only supplement the use of the static sign represented, and shall not substitute for, or replace that sign.
- A full matrix PCMS may be used to simulate a flashing arrow board provided it meets the visibility, flash rate and dimming requirements on BC(7), for the same size arrow.

DISCLAIMER: The use of this standard is governed by the "Texas Engineering Practice Act". No warranty of any kind is made by TxDOT for any purpose whatsoever. TxDOT assumes no responsibility for the conversion of this standard to other formats or for incorrect results or damages resulting from its use.

DATE: FILE:

WORD OR PHRASE	ABBREVIATION	WORD OR PHRASE	ABBREVIATION
Access Road	ACCS RD	Major	MAJ
Alternate	ALT	Miles	MI
Avenue	AVE	Miles Per Hour	MPH
Best Route	BEST RTE	Minor	MNR
Boulevard	BLVD	Monday	MON
Bridge	BRDG	Normal	NORM
Canal	CANT	North	N
Center	CTR	Northbound	(route) N
Construction Ahead	CONST AHD	Parking	PKING
CROSSING	XING	Road	RD
Detour Route	DETOUR RTE	Right Lane	RT LN
Do Not	DONT	Saturday	SAT
East	E	Service Road	SERV RD
Eastbound	(route) E	Shoulder	SHLDR
Emergency	EMER	Slippery	SLIP
Emergency Vehicle	EMER VEH	South	S
Entrance, Enter	ENT	Southbound	(route) S
Express Lane	EXP LN	Speed	SPD
Expressway	EXPWY	Street	ST
XXXX Feet	XXXX FT	Sunday	SUN
Fog Ahead	FOG AHD	Telephone	PHONE
Freeway	FRWY, FWY	Temporary	TEMP
Freeway Blocked	FWY BLKD	Thursday	THURS
Friday	FRI	To Downtown	TO DWNTN
Hazardous Driving	HAZ DRIVING	Traffic	TRAF
Hazardous Material	HAZMAT	Travelers	TRVLR
High-Occupancy Vehicle	HOV	Tuesday	TUES
Highway	HWY	Time Minutes	TIME MIN
Hour(s)	HR, HRS	Upper Level	UPR LEVEL
Information	INFO	Vehicles (s)	VEH, VEHS
It Is	ITS	Warning	WARN
Junction	JCT	Wednesday	WED
Left	LFT	Weight Limit	WT LIMIT
Left Lane	LFT LN	West	W
Lane Closed	LN CLOSED	Westbound	(route) W
Lower Level	LWR LEVEL	Wet Pavement	WET PVMT
Maintenance	MAINT	Will Not	WONT

Roadway designation # IH-number, US-number, SH-number, FM-number




BARRICADE AND CONSTRUCTION PORTABLE CHANGEABLE MESSAGE SIGN (PCMS)

BC (6) - 21

FILE: bc-21.dgn	DN: TxDOT	CK: TxDOT	DW: TxDOT	CK: TxDOT
© TxDOT November 2002	CONT	SECT	JOB	HIGHWAY
REVISIONS	0904	02	047	VARIOUS
9-07 8-14	DIST	COUNTY	SHEET NO.	
7-13 5-21	AMA	POTTER	012	


DISCLAIMER: The use of this standard is governed by the "Texas Engineering Practice Act". No warranty of any kind is made by TxDOT for any purpose whatsoever. TxDOT assumes no responsibility for the conversion of this standard to other formats or for incorrect results or damages resulting from its use.

- Barrier Reflectors shall be pre-qualified, and conform to the color and reflectivity requirements of DMS-8600. A list of prequalified Barrier Reflectors can be found at the Material Producer List web address shown on BC(1).
- Color of Barrier Reflectors shall be as specified in the TMUTCD. The cost of the reflectors shall be considered subsidiary to Item 512.

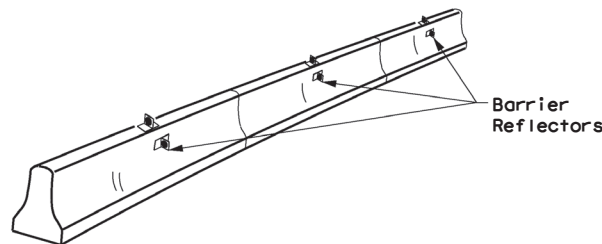

CONCRETE TRAFFIC BARRIER (CTB)

- Where traffic is on one side of the CTB, two (2) Barrier Reflectors shall be mounted in approximately the midsection of each section of CTB. An alternate mounting location is uniformly spaced at one end of each CTB. This will allow for attachment of a barrier grapple without damaging the reflector. The Barrier Reflector mounted on the side of the CTB shall be located directly below the reflector mounted on top of the barrier, as shown in the detail above.
- Where CTB separates two-way traffic, three barrier reflectors shall be mounted on each section of CTB. The reflector unit on top shall have two yellow reflective faces (Bi-Directional) while the reflectors on each side of the barrier shall have one yellow reflective face, as shown in the detail above.
- When CTB separates traffic traveling in the same direction, no barrier reflectors will be required on top of the CTB.
- Barrier Reflector units shall be yellow or white in color to match the edgeline being supplemented.
- Maximum spacing of Barrier Reflectors is forty (40) feet.
- Pavement markers or temporary flexible-reflective roadway marker tabs shall NOT be used as CTB delineation.
- Attachment of Barrier Reflectors to CTB shall be per manufacturer's recommendations.
- Missing or damaged Barrier Reflectors shall be replaced as directed by the Engineer.
- Single slope barriers shall be delineated as shown on the above detail.

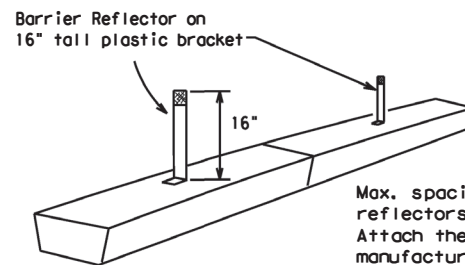


LOW PROFILE CONCRETE BARRIER (LPCB)

LOW PROFILE CONCRETE BARRIER (LPCB) USED IN WORK ZONES

LPCB is approved for use in work zone locations, where the posted speed is 45mph, or less. See Roadway Standard Sheet LPCB.

Max. spacing of barrier reflectors is 20 feet. Attach the delineators as per manufacturer's recommendations.

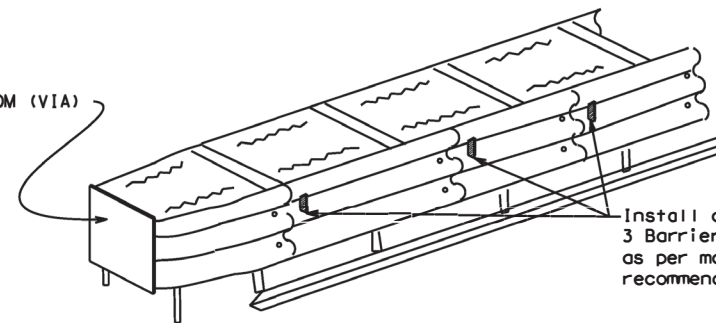

DELINEATION OF END TREATMENTS

END TREATMENTS FOR CTB'S USED IN WORK ZONES

End treatments used on CTB's in work zones shall meet the appropriate crashworthy standards as defined in the Manual for Assessing Safety Hardware (MASH). Refer to the CWZTCD List for approved end treatments and manufacturers.

BARRIER REFLECTORS FOR CONCRETE TRAFFIC BARRIER AND ATTENUATORS

WARNING LIGHTS


- Warning lights shall meet the requirements of the TMUTCD.
- Warning lights shall NOT be installed on barricades.
- Type A-Low Intensity Flashing Warning Lights are commonly used with drums. They are intended to warn of or mark a potentially hazardous area. Their use shall be as indicated on this sheet and/or other sheets of the plans by the designation "FL". The Type A Warning Lights shall not be used with signs manufactured with Type B_{FL} or C_{FL} Sheeting meeting the requirements of Departmental Material Specification DMS-8300.
- Type-C and Type D 360 degree Steady Burn Lights are intended to be used in a series for delineation to supplement other traffic control devices. Their use shall be as indicated on this sheet and/or other sheets of the plans by the designation "SB".
- The Engineer/Inspector or the plans shall specify the location and type of warning lights to be installed on the traffic control devices.
- When required by the Engineer, the Contractor shall furnish a copy of the warning lights certification. The warning light manufacturer will certify the warning lights meet the requirements of the latest ITE Purchase Specifications for Flashing and Steady-Burn Warning Lights.
- When used to delineate curves, Type-C and Type D Steady Burn Lights should only be placed on the outside of the curve, not the inside.
- The location of warning lights and warning reflectors on drums shall be as shown elsewhere in the plans.

WARNING LIGHTS MOUNTED ON PLASTIC DRUMS


- Type A flashing warning lights are intended to warn drivers that they are approaching or are in a potentially hazardous area.
- Type A random flashing warning lights are not intended for delineation and shall not be used in a series.
- A series of sequential flashing warning lights placed on channelizing devices to form a merging taper may be used for delineation. If used, the successive flashing of the sequential warning lights should occur from the beginning of the taper to the end of the merging taper in order to identify the desired vehicle path. The rate of flashing for each light shall be 65 flashes per minute, plus or minus 10 flashes.
- Type C and D steady-burn warning lights are intended to be used in a series to delineate the edge of the travel lane on detours, on lane changes, on lane closures, and on other similar conditions.
- Type A, Type C and Type D warning lights shall be installed at locations as detailed on other sheets in the plans.
- Warning lights shall not be installed on a drum that has a sign, chevron or vertical panel.
- The maximum spacing for warning lights on drums should be identical to the channelizing device spacing.

WARNING REFLECTORS MOUNTED ON PLASTIC DRUMS AS A SUBSTITUTE FOR TYPE C (STEADY BURN) WARNING LIGHTS

- A warning reflector or approved substitute may be mounted on a plastic drum as a substitute for a Type C, steady burn warning light at the discretion of the Contractor unless otherwise noted in the plans.
- The warning reflector shall be yellow in color and shall be manufactured using a sign substrate approved for use with plastic drums listed on the CWZTCD.
- The warning reflector shall have a minimum retroreflective surface area (one-side) of 30 square inches.
- Round reflectors shall be fully reflectorized, including the area where attached to the drum.
- Square substrates must have a minimum of 30 square inches of reflectorized sheeting. They do not have to be reflectorized where it attaches to the drum.
- The side of the warning reflector facing approaching traffic shall have sheeting meeting the color and retroreflectivity requirements for DMS 8300-Type B or Type C.
- When used near two-way traffic, both sides of the warning reflector shall be reflectorized.
- The warning reflector should be mounted on the side of the handle nearest approaching traffic.
- The maximum spacing for warning reflectors should be identical to the channelizing device spacing requirements.

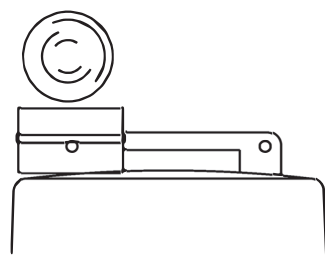

Type C Warning Light or approved substitute mounted on a drum adjacent to the travel way.

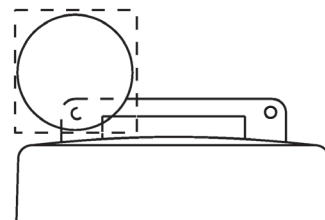


Warning reflector may be round or square. Must have a yellow reflective surface area of at least 30 square inches

DATE:
FILE:

Arrow Boards may be located behind channelizing devices in place for a shoulder taper or merging taper, otherwise they shall be delineated with four (4) channelizing devices placed perpendicular to traffic on the upstream side of traffic.

- The Flashing Arrow Board should be used for all lane closures on multi-lane roadways, or slow moving maintenance or construction activities on the travel lanes.
- Flashing Arrow Boards should not be used on two-lane, two-way roadways, detours, diversions or work on shoulders unless the "CAUTION" display (see detail below) is used.
- The Engineer/Inspector shall choose all appropriate signs, barricades and/or other traffic control devices that should be used in conjunction with the Flashing Arrow Board.
- The Flashing Arrow Board should be able to display the following symbols:

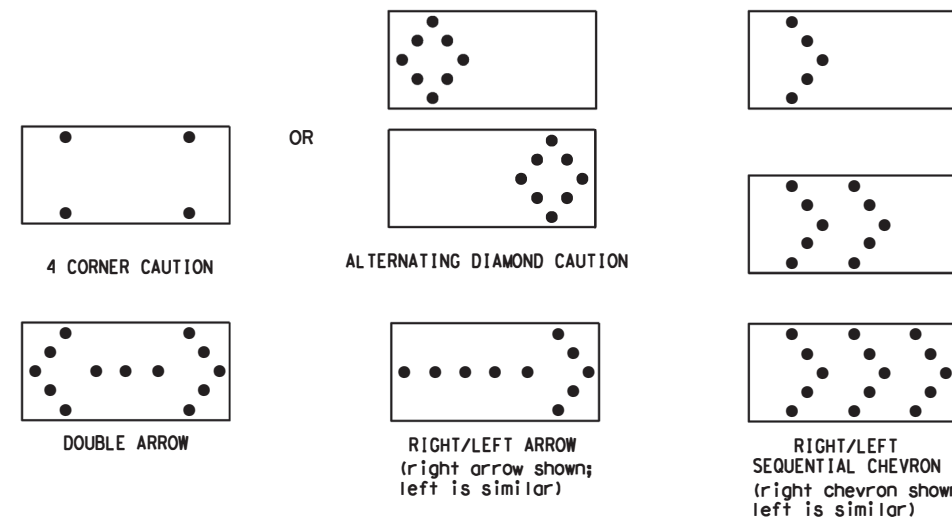

- The "CAUTION" display consists of four corner lamps flashing simultaneously, or the Alternating Diamond Caution mode as shown.
- The straight line caution display is NOT ALLOWED.
- The Flashing Arrow Board shall be capable of minimum 50 percent dimming from rated lamp voltage. The flashing rate of the lamps shall not be less than 25 nor more than 40 flashes per minute.
- Minimum lamp "on time" shall be approximately 50 percent for the flashing arrow and equal intervals of 25 percent for each sequential phase of the flashing chevron.
- The sequential arrow display is NOT ALLOWED.
- The flashing arrow display is the TxDOT standard; however, the sequential chevron display may be used during daylight operations.
- The Flashing Arrow Board shall be mounted on a vehicle, trailer or other suitable support.
- A Flashing Arrow Board SHALL NOT BE USED to laterally shift traffic.
- A full matrix PCMS may be used to simulate a Flashing Arrow Board provided it meets visibility, flash rate and dimming requirements on this sheet for the same size arrow.
- Minimum mounting height of trailer mounted Arrow Boards should be 7 feet from roadway to bottom of panel.

REQUIREMENTS			
TYPE	MINIMUM SIZE	MINIMUM NUMBER OF PANEL LAMPS	MINIMUM VISIBILITY DISTANCE
B	30 x 60	13	3/4 mile
C	48 x 96	15	1 mile

ATTENTION
Flashing Arrow Boards shall be equipped with automatic dimming devices.

WHEN NOT IN USE, REMOVE THE ARROW BOARD FROM THE RIGHT-OF-WAY OR PLACE THE ARROW BOARD BEHIND CONCRETE TRAFFIC BARRIER OR GUARDRAIL.

FLASHING ARROW BOARDS

SHEET 7 OF 12

TRUCK-MOUNTED ATTENUATORS

- Truck-mounted attenuators (TMA) used on TxDOT facilities must meet the requirements outlined in the Manual for Assessing Safety Hardware (MASH).
- Refer to the CWZTCD for the requirements of Level 2 or Level 3 TMAs.
- Refer to the CWZTCD for a list of approved TMAs.
- TMAs are required on freeways unless otherwise noted in the plans.
- A TMA should be used anytime that it can be positioned 30 to 100 feet in advance of the area of crew exposure without adversely affecting the work performance.
- The only reason a TMA should not be required is when a work area is spread down the roadway and the work crew is an extended distance from the TMA.



BARRICADE AND CONSTRUCTION ARROW PANEL, REFLECTORS, WARNING LIGHTS & ATTENUATOR

BC(7)-21

FILE: bc-21.dgn	DN: TxDOT	CR: TxDOT	DW: TxDOT	CK: TxDOT
© TxDOT November 2002	CONT	SECT	JOB	HIGHWAY
REVISIONS	0904	02	047	VARIOUS
9-07 8-14	DIST	COUNTY	SHEET NO.	
7-13 5-21	AMA	POTTER	013	

DISCLAIMER: The use of this standard is governed by the "Texas Engineering Practice Act". No warranty of any kind is made by TxDOT for any purpose whatsoever. TxDOT assumes no responsibility for the conversion of this standard to other formats or for incorrect results or damages resulting from its use.

DATE: FILE:

GENERAL NOTES

- For long term stationary work zones on freeways, drums shall be used as the primary channelizing device.
- For intermediate term stationary work zones on freeways, drums should be used as the primary channelizing device but may be replaced in tangent sections by vertical panels, or 42" two-piece cones. In tangent sections, one-piece cones may be used with the approval of the Engineer but only if personnel are present on the project at all times to maintain the cones in proper position and location.
- For short term stationary work zones on freeways, drums are the preferred channelizing device but may be replaced in tapers, transitions and tangent sections by vertical panels, two-piece cones or one-piece cones as approved by the Engineer.
- Drums and all related items shall comply with the requirements of the current version of the "Texas Manual on Uniform Traffic Control Devices" (TMUTCD) and the "Compliant Work Zone Traffic Control Devices List" (CWZTCD).
- Drums, bases, and related materials shall exhibit good workmanship and shall be free from objectionable marks or defects that would adversely affect their appearance or serviceability.
- The Contractor shall have a maximum of 24 hours to replace any plastic drums identified for replacement by the Engineer/Inspector. The replacement device must be an approved device.

GENERAL DESIGN REQUIREMENTS

Pre-qualified plastic drums shall meet the following requirements:




- Plastic drums shall be a two-piece design; the "body" of the drum shall be the top portion and the "base" shall be the bottom.
- The body and base shall lock together in such a manner that the body separates from the base when impacted by a vehicle traveling at a speed of 20 MPH or greater but prevents accidental separation due to normal handling and/or air turbulence created by passing vehicles.
- Plastic drums shall be constructed of lightweight flexible, and deformable materials. The Contractor shall NOT use metal drums or single piece plastic drums as channelization devices or sign supports.
- Drums shall present a profile that is a minimum of 18 inches in width at the 36 inch height when viewed from any direction. The height of drum unit (body installed on base) shall be a minimum of 36 inches and a maximum of 42 inches.
- The top of the drum shall have a built-in handle for easy pickup and shall be designed to drain water and not collect debris. The handle shall have a minimum of two widely spaced 9/16 inch diameter holes to allow attachment of a warning light, warning reflector unit or approved compliant sign.
- The exterior of the drum body shall have a minimum of four alternating orange and white retroreflective circumferential stripes not less than 4 inches nor greater than 8 inches in width. Any non-reflectorized space between any two adjacent stripes shall not exceed 2 inches in width.
- Bases shall have a maximum width of 36 inches, a maximum height of 4 inches, and a minimum of two footholds of sufficient size to allow base to be held down while separating the drum body from the base.
- Plastic drums shall be constructed of ultra-violet stabilized, orange, high-density polyethylene (HDPE) or other approved material.
- Drum body shall have a maximum unballasted weight of 11 lbs.
- Drum and base shall be marked with manufacturer's name and model number.

RETROREFLECTIVE SHEETING

- The stripes used on drums shall be constructed of sheeting meeting the color and retroreflectivity requirements of Departmental Materials Specification DMS-8300, "Sign Face Materials." Type A or Type B reflective sheeting shall be supplied unless otherwise specified in the plans.
- The sheeting shall be suitable for use on and shall adhere to the drum surface such that, upon vehicular impact, the sheeting shall remain adhered in-place and exhibit no delaminating, cracking, or loss of retroreflectivity other than that loss due to abrasion of the sheeting surface.


BALLAST

- Unballasted bases shall be large enough to hold up to 50 lbs. of sand. This base, when filled with the ballast material, should weigh between 35 lbs (minimum) and 50 lbs (maximum). The ballast may be sand in one to three sandbags separate from the base, sand in a sand-filled plastic base, or other ballasting devices as approved by the Engineer. Stacking of sandbags will be allowed, however height of sandbags above pavement surface may not exceed 12 inches.
- Bases with built-in ballast shall weigh between 40 lbs. and 50 lbs. Built-in ballast can be constructed of an integral crumb rubber base or a solid rubber base.
- Recycled truck tire sidewalls may be used for ballast on drums approved for this type of ballast on the CWZTCD list.
- The ballast shall not be heavy objects, water, or any material that would become hazardous to motorists, pedestrians, or workers when the drum is struck by a vehicle.
- When used in regions susceptible to freezing, drums shall have drainage holes in the bottoms so that water will not collect and freeze becoming a hazard when struck by a vehicle.
- Ballast shall not be placed on top of drums.
- Adhesives may be used to secure base of drums to pavement.

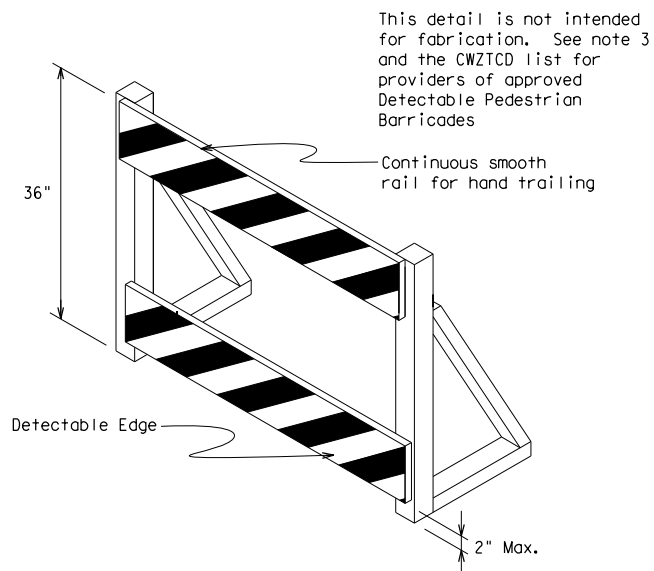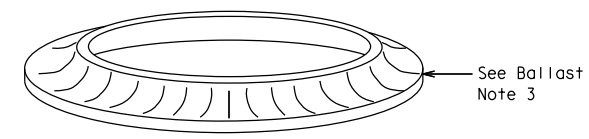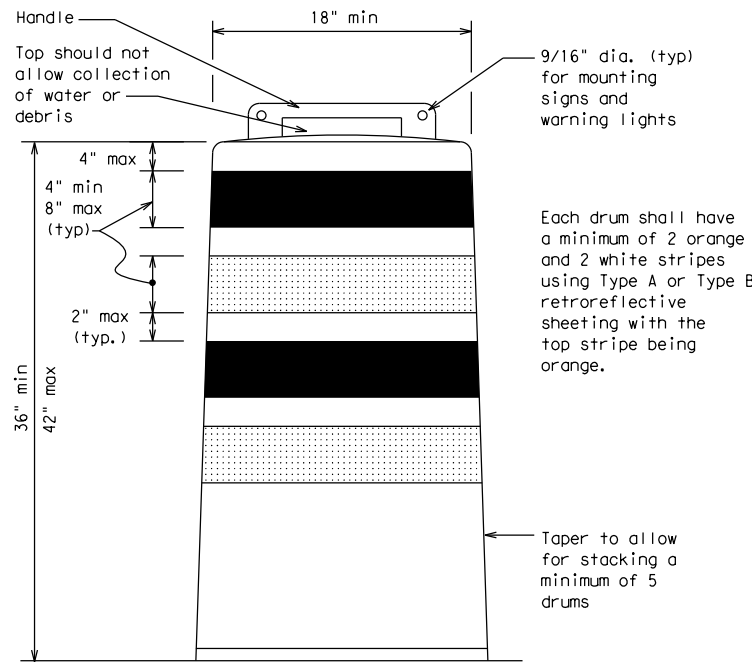

DETECTABLE PEDESTRIAN BARRICADES

- When existing pedestrian facilities are disrupted, closed, or relocated in a TTC zone, the temporary facilities shall be detectable and include accessibility features consistent with the features present in the existing pedestrian facility. Refer to WZ(BTS-2) for Pedestrian Control requirements for Sidewalk Diversions, Sidewalk Detours and Crosswalk Closures.
- Where pedestrians with visual disabilities normally use the closed sidewalk, a Detectable Pedestrian Barricade shall be placed across the full width of the closed sidewalk instead of a Type 3 Barricade.
- Detectable pedestrian barricades similar to the one pictured above, longitudinal channelizing devices, some concrete barriers, and wood or chain link fencing with a continuous detectable edging can satisfactorily delineate a pedestrian path.
- Tape, rope, or plastic chain strung between devices are not detectable, do not comply with the design standards in the "Americans with Disabilities Act Accessibility Guidelines (ADAAG)" and should not be used as a control for pedestrian movements.
- Warning lights shall not be attached to detectable pedestrian barricades.
- Detectable pedestrian barricades should use 8" nominal barricade rails as shown on BC(10) provided that the top rail provides a smooth continuous rail suitable for hand trailing with no splinters, burrs, or sharp edges.

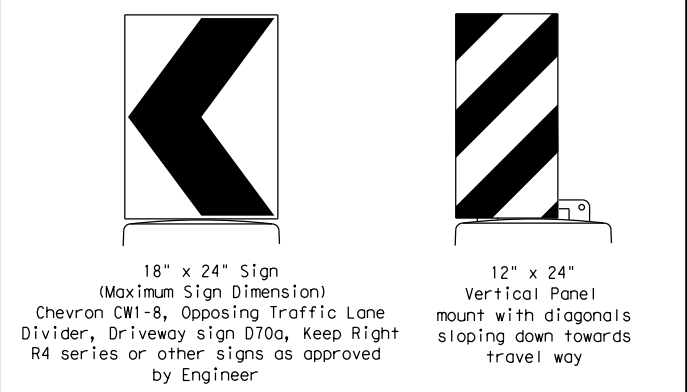

18" x 24" Sign (Maximum Sign Dimension)
 Chevron CW1-8, Opposing Traffic Lane Divider, Driveway sign D70a, Keep Right R4 series or other signs as approved by Engineer
 12" x 24" Vertical Panel
 mount with diagonals sloping down towards travel way

SIGNS, CHEVRONS, AND VERTICAL PANELS MOUNTED ON PLASTIC DRUMS

- Signs used on plastic drums shall be manufactured using substrates listed on the CWZTCD.
- Chevrons and other work zone signs with an orange background shall be manufactured with Type B_{FL} or Type C_{FL} Orange sheeting meeting the color and retroreflectivity requirements of DMS-8300, "Sign Face Material," unless otherwise specified in the plans.
- Vertical Panels shall be manufactured with orange and white sheeting meeting the requirements of DMS-8300 Type A or Type B. Diagonal stripes on Vertical Panels shall slope down toward the intended traveled lane.
- Other sign messages (text or symbolic) may be used as approved by the Engineer. Sign dimensions shall not exceed 18 inches in width or 24 inches in height, except for the R9 series signs discussed in note 8 below.
- Signs shall be installed using a 1/2 inch bolt (nominal) and nut, two washers, and one locking washer for each connection.
- Mounting bolts and nuts shall be fully engaged and adequately torqued. Bolts should not extend more than 1/2 inch beyond nuts.
- Chevrons may be placed on drums on the outside of curves, on merging tapers or on shifting tapers. When used in these locations, they may be placed on every drum or spaced not more than on every third drum. A minimum of three (3) should be used at each location called for in the plans.
- R9-9, R9-10, R9-11 and R9-11a Sidewalk Closed signs which are 24 inches wide may be mounted on plastic drums, with approval of the Engineer.


SHEET 8 OF 12

BARRICADE AND CONSTRUCTION CHANNELIZING DEVICES

BC (8) - 21

FILE: bc-21.dgn	DN: TxDOT	CK: TxDOT	DW: TxDOT	CK: TxDOT
© TxDOT November 2002	CONT	SECT	JOB	HIGHWAY
REVISIONS	0904	02	047	VARIOUS
4-03 8-14	DIST	COUNTY	SHEET NO.	
9-07 5-21	AMA	POTTER	014	
7-13				


DISCLAIMER: The use of this standard is governed by the "Texas Engineering Practice Act". No warranty of any kind is made by TxDOT for any purpose whatsoever. TxDOT assumes no responsibility for the conversion of this standard to other formats or for incorrect results or damages resulting from its use.

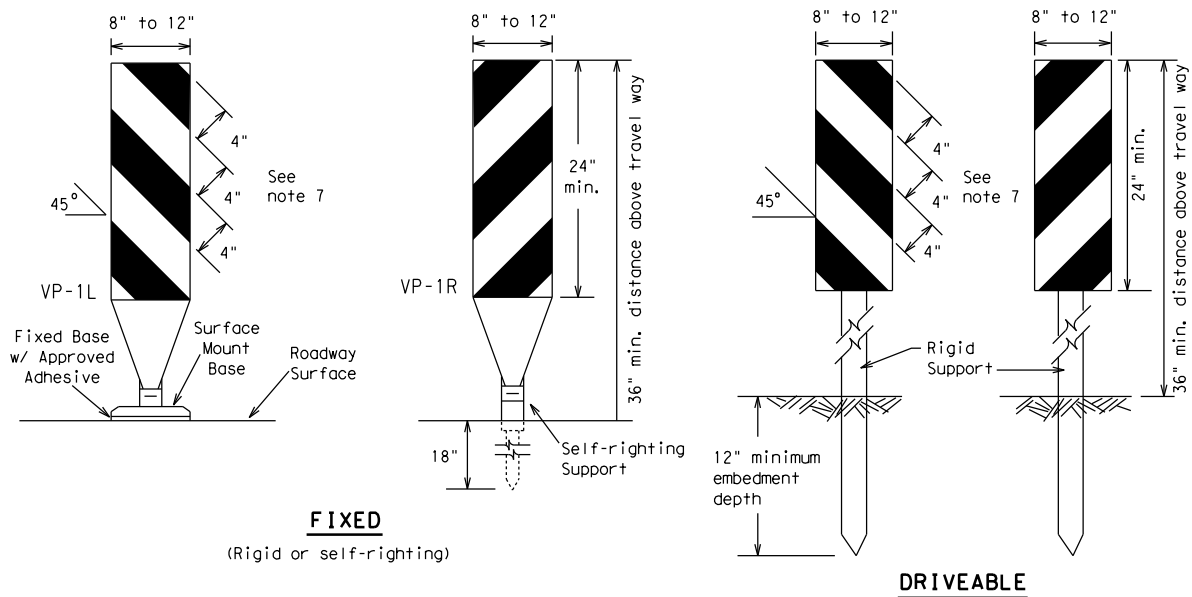

FIXED

(Rigid or self-righting)


DRIVEABLE

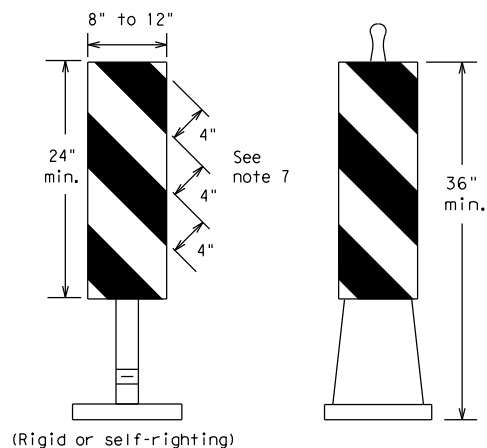

PORTABLE


VERTICAL PANELS (VPs)

- Vertical Panels (VP's) are normally used to channelize traffic or divide opposing lanes of traffic.
- VP's may be used in daytime or nighttime situations. They may be used at the edge of shoulder drop-offs and other areas such as lane transitions where positive daytime and nighttime delineation is required. The Engineer/Inspector shall refer to the Roadway Design Manual for additional requirements on the use VP's for drop-offs.
- VP's should be mounted back to back if used at the edge of cuts adjacent to two-way two lane roadways. Stripes are to be reflective orange and reflective white and should always slope downward toward the travel lane.
- VP's used on expressways and freeways or other high speed roadways, may have more than 270 square inches of retroreflective area facing traffic.
- Self-righting supports are available with portable base. See "Compliant Work Zone Traffic Control Devices List" (CWZTCD).
- Sheeting for the VP's shall be retroreflective Type A or Type B conforming to Departmental Material Specification DMS-8300, unless noted otherwise.
- Where the height of reflective material on the vertical panel is 36 inches or greater, a panel stripe of 6 inches shall be used.

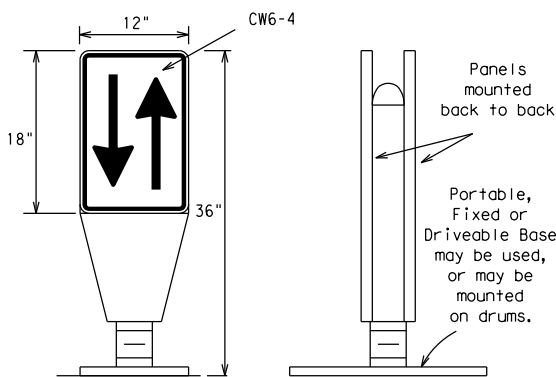


OPPOSING TRAFFIC LANE DIVIDERS (OTLD)

- Opposing Traffic Lane Dividers (OTLD) are delineation devices designed to convert a normal one-way roadway section to two-way operation. OTLD's are used on temporary centerlines. The upward and downward arrows on the sign's face indicate the direction of traffic on either side of the divider. The base is secured to the pavement with an adhesive or rubber weight to minimize movement caused by a vehicle impact or wind gust.
- The OTLD may be used in combination with 42" cones or VPs.
- Spacing between the OTLD shall not exceed 500 feet. 42" cones or VPs placed between the OTLD's should not exceed 100 foot spacing.
- The OTLD shall be orange with a black non-reflective legend. Sheeting for the OTLD shall be retroreflective Type B_{FL} or Type C_{FL} conforming to Departmental Material Specification DMS-8300, unless noted otherwise. The legend shall meet the requirements of DMS-8300.

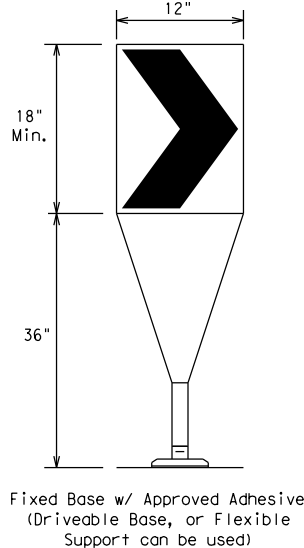

- The chevron shall be a vertical rectangle with a minimum size of 12 by 18 inches.
- Chevrons are intended to give notice of a sharp change of alignment with the direction of travel and provide additional emphasis and guidance for vehicle operators with regard to changes in horizontal alignment of the roadway.
- Chevrons, when used, shall be erected on the outside of a sharp curve or turn, or on the far side of an intersection. They shall be in line with and at right angles to approaching traffic. Spacing should be such that the motorist always has three in view, until the change in alignment eliminates its need.
- To be effective, the chevron should be visible for at least 500 feet.
- Chevrons shall be orange with a black nonreflective legend. Sheeting for the chevron shall be retroreflective Type B_{FL} or Type C_{FL} conforming to Departmental Material Specification DMS-8300, unless noted otherwise. The legend shall meet the requirements of DMS-8300.
- For Long Term Stationary use on tapers or transitions on freeways and divided highways, self-righting chevrons may be used to supplement plastic drums but not to replace plastic drums.

CHEVRONS

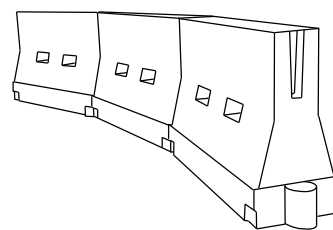

LONGITUDINAL CHANNELIZING DEVICES (LCD)

- LCDs are crashworthy, lightweight, deformable devices that are highly visible, have good target value and can be connected together. They are not designed to contain or redirect a vehicle on impact.
- LCDs may be used instead of a line of cones or drums.
- LCDs shall be placed in accordance to application and installation requirements specific to the device, and used only when shown on the CWZTCD list.
- LCDs should not be used to provide positive protection for obstacles, pedestrians or workers.
- LCDs shall be supplemented with retroreflective delineation as required for temporary barriers on BC(7) when placed roughly parallel to the travel lanes.
- LCDs used as barricades placed perpendicular to traffic should have at least one row of reflective sheeting meeting the requirements for barricade rails as shown on BC(10). Place reflective sheeting near the top of the LCD along the full length of the device.

WATER BALLASTED SYSTEMS USED AS BARRIERS

- Water ballasted systems used as barriers shall not be used solely to channelize road users, but also to protect the work space per the appropriate Manual for Assessing Safety Hardware (MASH) crashworthiness requirements based on roadway speed and barrier application.
- Water ballasted systems used to channelize vehicular traffic shall be supplemented with retroreflective delineation or channelizing devices to improve daytime/nighttime visibility. They may also be supplemented with pavement markings.
- Water ballasted systems used as barriers shall be placed in accordance to application and installation requirements specific to the device, and used only when shown on the CWZTCD list.
- Water ballasted systems used as barriers should not be used for a merging taper except in low speed (less than 45 MPH) urban areas. When used on a taper in a low speed urban area, the taper shall be delineated and the taper length should be designed to optimize road user operations considering the available geometric conditions.
- When water ballasted systems used as barriers have blunt ends exposed to traffic, they should be attenuated as per manufacturer recommendations or flared to a point outside the clear zone.

If used to channelize pedestrians, longitudinal channelizing devices or water ballasted systems must have a continuous detectable bottom for users of long canes and the top of the unit shall not be less than 32 inches in height.

HOLLOW OR WATER BALLASTED SYSTEMS USED AS LONGITUDINAL CHANNELIZING DEVICES OR BARRIERS

GENERAL NOTES

- Work Zone channelizing devices illustrated on this sheet may be installed in close proximity to traffic and are suitable for use on high or low speed roadways. The Engineer/Inspector shall ensure that spacing and placement is uniform and in accordance with the "Texas Manual on Uniform Traffic Control Devices" (TMUTCD).
- Channelizing devices shown on this sheet may have a driveable, fixed or portable base. The requirement for self-righting channelizing devices must be specified in the General Notes or other plan sheets.
- Channelizing devices on self-righting supports should be used in work zone areas where channelizing devices are frequently impacted by errant vehicles or vehicle related wind gusts making alignment of the channelizing devices difficult to maintain. Locations of these devices shall be detailed elsewhere in the plans. These devices shall conform to the TMUTCD and the "Compliant Work Zone Traffic Control Devices List" (CWZTCD).
- The Contractor shall maintain devices in a clean condition and replace damaged, nonreflective, faded, or broken devices and bases as required by the Engineer/Inspector. The Contractor shall be required to maintain proper device spacing and alignment.
- Portable bases shall be fabricated from virgin and/or recycled rubber. The portable bases shall weigh a minimum of 30 lbs.
- Pavement surfaces shall be prepared in a manner that ensures proper bonding between the adhesives, the fixed mount bases and the pavement surface. Adhesives shall be prepared and applied according to the manufacturer's recommendations.
- The installation and removal of channelizing devices shall not cause detrimental effects to the final pavement surfaces, including pavement surface discoloration or surface integrity. Driveable bases shall not be permitted on final pavement surfaces. The Engineer/Inspector shall approve all application and removal procedures of fixed bases.

Posted Speed	Formula	Minimum Desirable Taper Lengths * X			Suggested Maximum Spacing of Channelizing Devices	
		10' Offset	11' Offset	12' Offset	On a Taper	On a Tangent
30	L = WS ² / 60	150'	165'	180'	30'	60'
35		205'	225'	245'	35'	70'
40		265'	295'	320'	40'	80'
45	L = WS	450'	495'	540'	45'	90'
50		500'	550'	600'	50'	100'
55		550'	605'	660'	55'	110'
60		600'	660'	720'	60'	120'
65		650'	715'	780'	65'	130'
70		700'	770'	840'	70'	140'
75		750'	825'	900'	75'	150'
80	800'	880'	960'	80'	160'	

*X Taper lengths have been rounded off.
L=Length of Taper (FT.) W=Width of Offset (FT.)
S=Posted Speed (MPH)

SUGGESTED MAXIMUM SPACING OF CHANNELIZING DEVICES AND MINIMUM DESIRABLE TAPER LENGTHS

SHEET 9 OF 12



BARRICADE AND CONSTRUCTION CHANNELIZING DEVICES

BC (9) - 21

FILE:	bc-21.dgn	DN:	TxDOT	CK:	TxDOT	DW:	TxDOT	CK:	TxDOT
© TxDOT	November 2002	CONT	SECT	JOB	HIGHWAY				
REVISIONS		0904	02	047	VARIOUS				
9-07	8-14	DIST	COUNTY	SHEET NO.					
7-13	5-21	AMA	POTTER	015					


DATE: FILE:

DISCLAIMER: The use of this standard is governed by the "Texas Engineering Practice Act". No warranty of any kind is made by TxDOT for any purpose whatsoever. TxDOT assumes no responsibility for the conversion of this standard to other formats or for incorrect results or damages resulting from its use.


TYPE 3 BARRICADES

1. Refer to the Compliant Work Zone Traffic Control Devices List (CWZTCD) for details of the Type 3 Barricades and a list of all materials used in the construction of Type 3 Barricades.
2. Type 3 Barricades shall be used at each end of construction projects closed to all traffic.
3. Barricades extending across a roadway should have stripes that slope downward in the direction toward which traffic must turn in detouring. When both right and left turns are provided, the chevron striping may slope downward in both directions from the center of the barricade. Where no turns are provided at a closed road, striping should slope downward in both directions toward the center of roadway.
4. Striping of rails, for the right side of the roadway, should slope downward to the left. For the left side of the roadway, striping should slope downward to the right.
5. Identification markings may be shown only on the back of the barricade rails. The maximum height of letters and/or company logos used for identification shall be 1".
6. Barricades shall not be placed parallel to traffic unless an adequate clear zone is provided.
7. Warning lights shall NOT be installed on barricades.
8. Where barricades require the use of weights to keep from turning over, the use of sandbags with dry, cohesionless sand is recommended. The sandbags will be tied shut to keep the sand from spilling and to maintain a constant weight. Sand bags shall not be stacked in a manner that covers any portion of a barricade rails reflective sheeting. Rock, concrete, iron, steel or other solid objects will NOT be permitted. Sandbags should weigh a minimum of 35 lbs and a maximum of 50 lbs. Sandbags shall be made of a durable material that tears upon vehicular impact. Rubber (such as tire inner tubes) shall not be used for sandbags. Sandbags shall only be placed along or upon the base supports of the device and shall not be suspended above ground level or hung with rope, wire, chains or other fasteners.
9. Sheeting for barricades shall be retroreflective Type A or Type B conforming to Departmental Material Specification DMS-8300 unless otherwise noted.

Barricades shall NOT be used as a sign support.

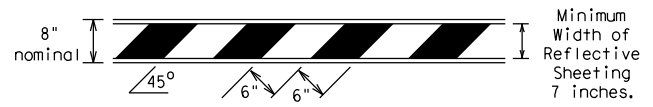


TYPICAL STRIPING DETAIL FOR BARRICADE RAIL

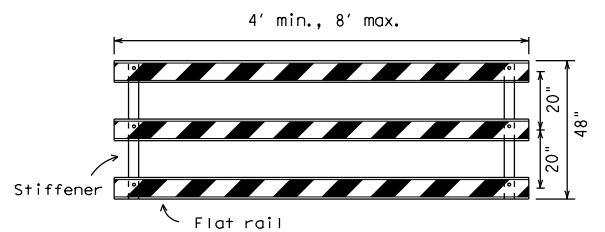

Stiffener may be inside or outside of support, but no more than 2 stiffeners shall be allowed on one barricade.


TYPICAL PANEL DETAIL FOR SKID OR POST TYPE BARRICADES

Each roadway of a divided highway shall be barricaded in the same manner.

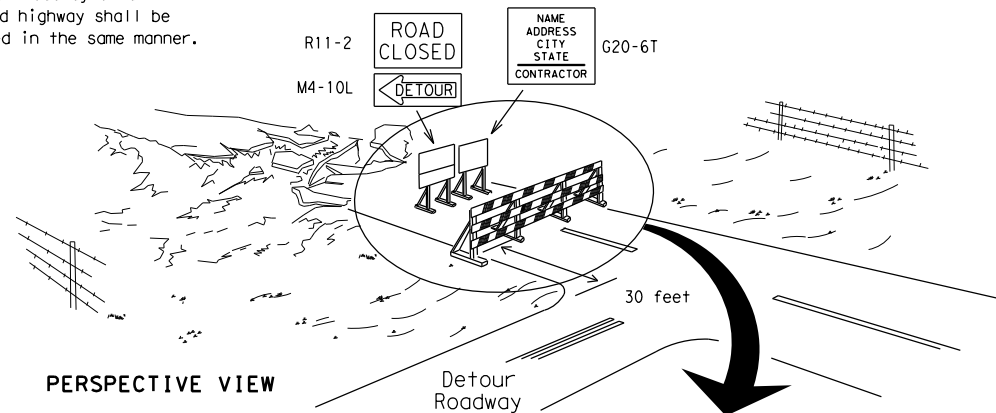

PERSPECTIVE VIEW


The three rails on Type 3 barricades shall be reflectorized orange and reflective white stripes on one side facing one-way traffic and both sides for two-way traffic. Barricade striping should slant downward in the direction of detour.

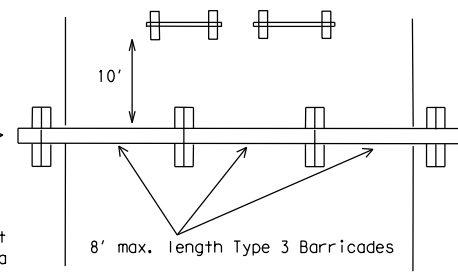


PLAN VIEW

1. Signs should be mounted on independent supports at a 7 foot mounting height in center of roadway. The signs should be a minimum of 10 feet behind Type 3 Barricades.
2. Advance signing shall be as specified elsewhere in the plans.

TYPE 3 BARRICADE (POST AND SKID) TYPICAL APPLICATION

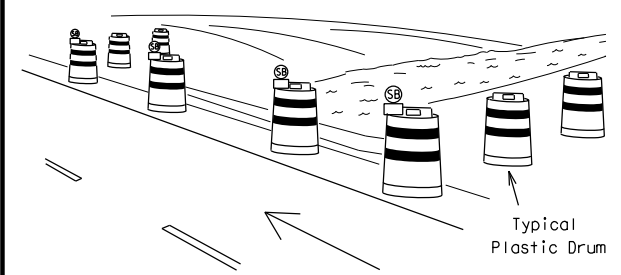

PERSPECTIVE VIEW

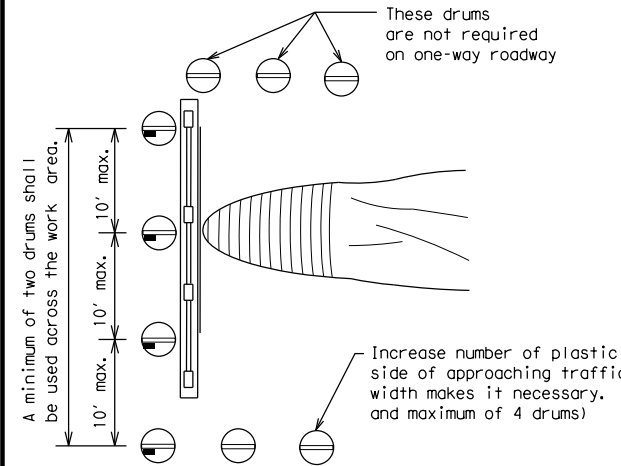


PLAN VIEW

LEGEND	
	Plastic drum
	Plastic drum with steady burn light or yellow warning reflector
	Steady burn warning light or yellow warning reflector

1. Where positive redirection capability is provided, drums may be omitted.
2. Plastic construction fencing may be used with drums for safety as required in the plans.
3. Vertical Panels on flexible support may be substituted for drums when the shoulder width is less than 4 feet.
4. When the shoulder width is greater than 12 feet, steady-burn lights may be omitted if drums are used.
5. Drums must extend the length of the culvert widening.

CULVERT WIDENING OR OTHER ISOLATED WORK WITHIN THE PROJECT LIMITS

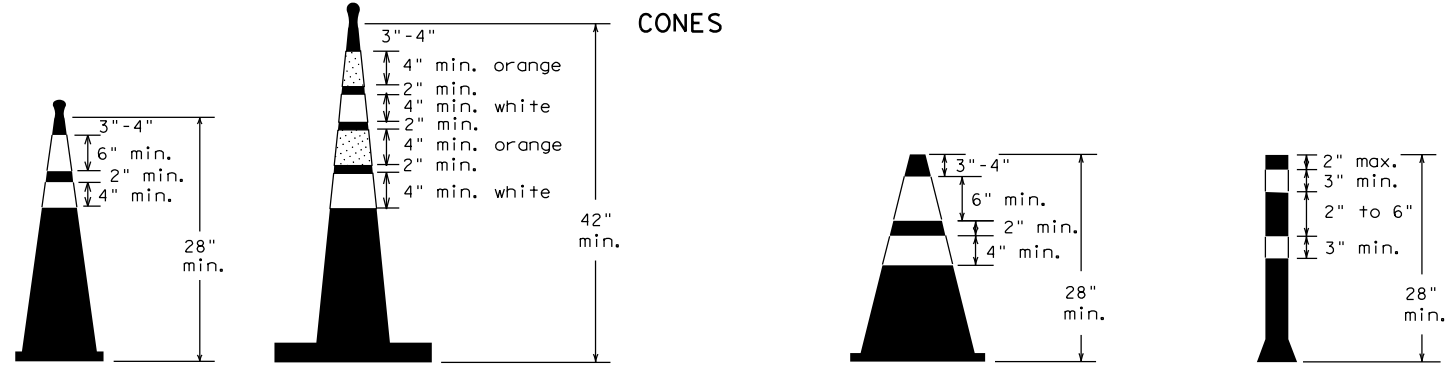


Two-Piece cones

One-Piece cones

Tubular Marker

28" Cones shall have a minimum weight of 9 1/2 lbs.
42" 2-piece cones shall have a minimum weight of 30 lbs. including base.

1. Traffic cones and tubular markers shall be predominantly orange, and meet the height and weight requirements shown above.
2. One-piece cones have the body and base of the cone molded in one consolidated unit. Two-piece cones have a cone shaped body and a separate rubber base, or ballast, that is added to keep the device upright and in place.
3. Two-piece cones may have a handle or loop extending up to 8" above the minimum height shown, in order to aid in retrieving the device.
4. Cones or tubular markers shall have white or white and orange reflective bands as shown above. The reflective bands shall have a smooth, sealed outer surface and meet the requirements of Departmental Material Specification DMS-8300 Type A or Type B.
5. 28" cones and tubular markers are generally suitable for short duration and short-term stationary work as defined on BC(4). These should not be used for intermediate-term or long-term stationary work unless personnel is on-site to maintain them in their proper upright position.
6. 42" two-piece cones, vertical panels or drums are suitable for all work zone durations.
7. Cones or tubular markers used on each project should be of the same size and shape.

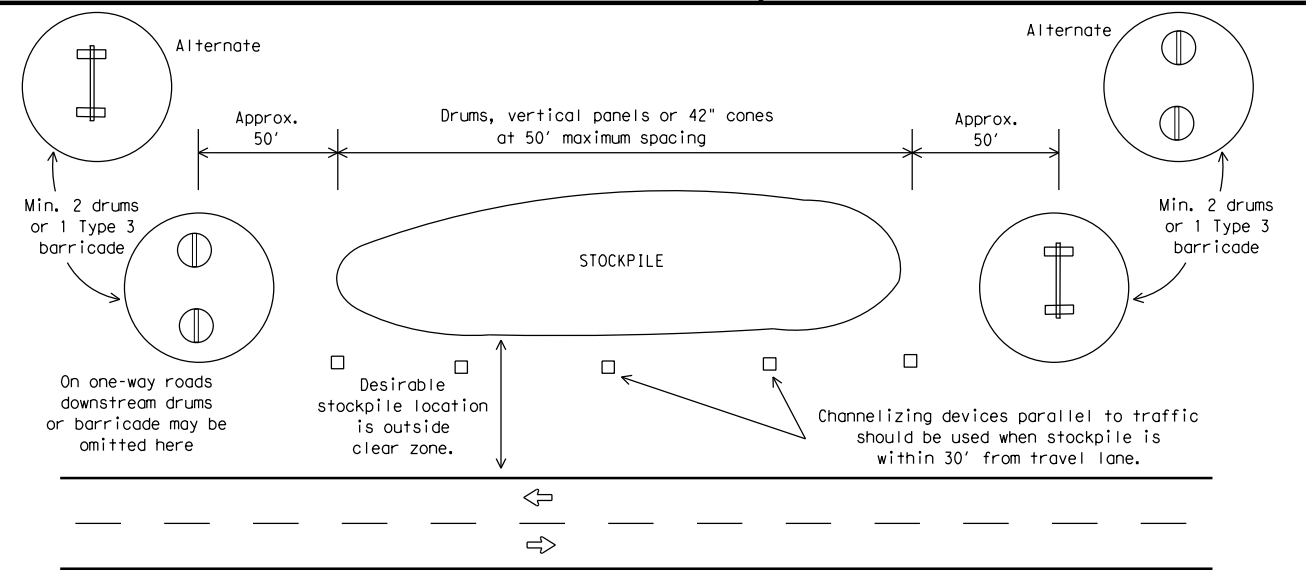

TRAFFIC CONTROL FOR MATERIAL STOCKPILES



BARRICADE AND CONSTRUCTION CHANNELIZING DEVICES

BC (10) - 21

FILE: bc-21.dgn	DN: TxDOT	CK: TxDOT	DW: TxDOT	CK: TxDOT
© TxDOT November 2002	CONT	SECT	JOB	HIGHWAY
REVISIONS	0904	02	047	VARIOUS
9-07 8-14	DIST	COUNTY	SHEET NO.	
7-13 5-21	AMA	POTTER	016	

DATE: FILE:

WORK ZONE PAVEMENT MARKINGS

GENERAL

- The Contractor shall be responsible for maintaining work zone and existing pavement markings, in accordance with the standard specifications and special provisions, on all roadways open to traffic within the CSJ limits unless otherwise stated in the plans.
- Color, patterns and dimensions shall be in conformance with the "Texas Manual on Uniform Traffic Control Devices" (TMUTCD).
- Additional supplemental pavement marking details may be found in the plans or specifications.
- Pavement markings shall be installed in accordance with the TMUTCD and as shown on the plans.
- When short term markings are required on the plans, short term markings shall conform with the TMUTCD, the plans and details as shown on the Standard Plan Sheet WZ(STPM).
- When standard pavement markings are not in place and the roadway is opened to traffic, DO NOT PASS signs shall be erected to mark the beginning of the sections where passing is prohibited and PASS WITH CARE signs at the beginning of sections where passing is permitted.
- All work zone pavement markings shall be installed in accordance with Item 662, "Work Zone Pavement Markings."

RAISED PAVEMENT MARKERS

- Raised pavement markers are to be placed according to the patterns on BC(12).
- All raised pavement markers used for work zone markings shall meet the requirements of Item 672, "RAISED PAVEMENT MARKERS" and Departmental Material Specification DMS-4200 or DMS-4300.

PREFABRICATED PAVEMENT MARKINGS

- Removable prefabricated pavement markings shall meet the requirements of DMS-8241.
- Non-removable prefabricated pavement markings (foil back) shall meet the requirements of DMS-8240.


MAINTAINING WORK ZONE PAVEMENT MARKINGS

- The Contractor will be responsible for maintaining work zone pavement markings within the work limits.
- Work zone pavement markings shall be inspected in accordance with the frequency and reporting requirements of work zone traffic control device inspections as required by Form 599.
- The markings should provide a visible reference for a minimum distance of 300 feet during normal daylight hours and 160 feet when illuminated by automobile low-beam headlights at night, unless sight distance is restricted by roadway geometrics.
- Markings failing to meet this criteria within the first 30 days after placement shall be replaced at the expense of the Contractor as per Specification Item 662.

REMOVAL OF PAVEMENT MARKINGS

- Pavement markings that are no longer applicable, could create confusion or direct a motorist toward or into the closed portion of the roadway shall be removed or obliterated before the roadway is opened to traffic.
- The above shall not apply to detours in place for less than three days, where flaggers and/or sufficient channelizing devices are used in lieu of markings to outline the detour route.
- Pavement markings shall be removed to the fullest extent possible, so as not to leave a discernable marking. This shall be by any method approved by TxDOT Specification Item 677 for "Eliminating Existing Pavement Markings and Markers".
- The removal of pavement markings may require resurfacing or seal coating portions of the roadway as described in Item 677.
- Subject to the approval of the Engineer, any method that proves to be successful on a particular type pavement may be used.
- Blast cleaning may be used but will not be required unless specifically shown in the plans.
- Over-painting of the markings SHALL NOT BE permitted.
- Removal of raised pavement markers shall be as directed by the Engineer.
- Removal of existing pavement markings and markers will be paid for directly in accordance with Item 677, "ELIMINATING EXISTING PAVEMENT MARKINGS AND MARKERS," unless otherwise stated in the plans.
- Black-out marking tape may be used to cover conflicting existing markings for periods less than two weeks when approved by the Engineer.

Temporary Flexible-Reflective Roadway Marker Tabs

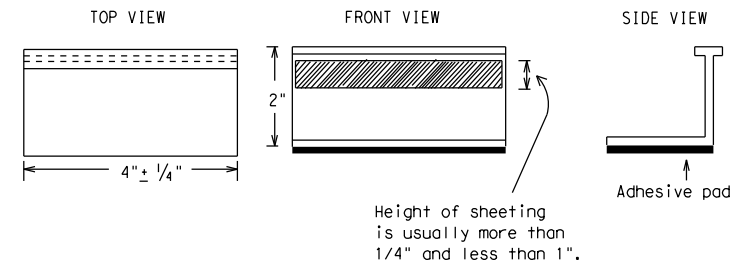

**STAPLES OR NAILS SHALL NOT BE USED TO SECURE
TEMPORARY FLEXIBLE-REFLECTIVE ROADWAY MARKER
TABS TO THE PAVEMENT SURFACE**

- Temporary flexible-reflective roadway marker tabs used as guidemarks shall meet the requirements of DMS-8242.
- Tabs detailed on this sheet are to be inspected and accepted by the Engineer or designated representative. Sampling and testing is not normally required, however at the option of the Engineer, either "A" or "B" below may be imposed to assure quality before placement on the roadway.
 - Select five (5) or more tabs at random from each lot or shipment and submit to the Construction Division, Materials and Pavement Section to determine specification compliance.
 - Select five (5) tabs and perform the following test. Affix five (5) tabs at 24 inch intervals on an asphaltic pavement in a straight line. Using a medium size passenger vehicle or pickup, run over the markers with the front and rear tires at a speed of 35 to 40 miles per hour, four (4) times in each direction. No more than one (1) out of the five (5) reflective surfaces shall be lost or displaced as a result of this test.
- Small design variances may be noted between tab manufacturers.
- See Standard Sheet WZ(STPM) for tab placement on new pavements. See Standard Sheet TCP(7-1) for tab placement on seal coat work.

RAISED PAVEMENT MARKERS USED AS GUIDEMARKS

- Raised pavement markers used as guidemarks shall be from the approved product list, and meet the requirements of DMS-4200.
- All temporary construction raised pavement markers provided on a project shall be of the same manufacturer.
- Adhesive for guidemarks shall be bituminous material hot applied or butyl rubber pad for all surfaces, or thermoplastic for concrete surfaces.

Guidemarks shall be designated as:
 YELLOW - (two amber reflective surfaces with yellow body).
 WHITE - (one silver reflective surface with white body).

DEPARTMENTAL MATERIAL SPECIFICATIONS	
PAVEMENT MARKERS (REFLECTORIZED)	DMS-4200
TRAFFIC BUTTONS	DMS-4300
EPOXY AND ADHESIVES	DMS-6100
BITUMINOUS ADHESIVE FOR PAVEMENT MARKERS	DMS-6130
PERMANENT PREFABRICATED PAVEMENT MARKINGS	DMS-8240
TEMPORARY REMOVABLE, PREFABRICATED PAVEMENT MARKINGS	DMS-8241
TEMPORARY FLEXIBLE, REFLECTIVE ROADWAY MARKER TABS	DMS-8242

A list of prequalified reflective raised pavement markers, non-reflective traffic buttons, roadway marker tabs and other pavement markings can be found at the Material Producer List web address shown on BC(1).

SHEET 11 OF 12



BARRICADE AND CONSTRUCTION PAVEMENT MARKINGS

BC(11)-21

FILE: bc-21.dgn	DN: TxDOT	CK: TxDOT	DW: TxDOT	CK: TxDOT
© TxDOT February 1998	CONT	SECT	JOB	HIGHWAY
	0904	02	047	VARIOUS
REVISIONS	DIST	COUNTY	SHEET NO.	
2-98 9-07 5-21	AMA	POTTER	017	
1-02 7-13				
11-02 8-14				


DISCLAIMER: The use of this standard is governed by the "Texas Engineering Practice Act". No warranty of any kind is made by TxDOT for any purpose whatsoever. TxDOT assumes no responsibility for the conversion of this standard to other formats or for incorrect results or damages resulting from its use.

DATE:
FILE:

PAVEMENT MARKING PATTERNS




REFLECTORIZED PAVEMENT MARKINGS - PATTERN A

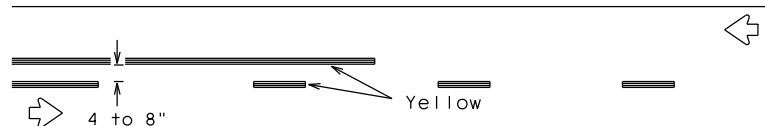


REFLECTORIZED PAVEMENT MARKINGS - PATTERN B

Pattern A is the TXDOT Standard, however Pattern B may be used if approved by the Engineer. Prefabricated markings may be substituted for reflectORIZED pavement markings.

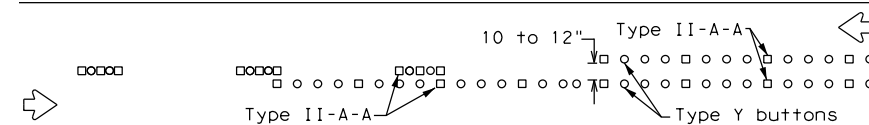


RAISED PAVEMENT MARKERS - PATTERN A

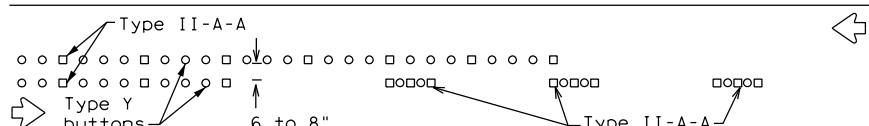


RAISED PAVEMENT MARKERS - PATTERN B

CENTER LINE & NO-PASSING ZONE BARRIER LINES FOR TWO-LANE, TWO-WAY HIGHWAYS

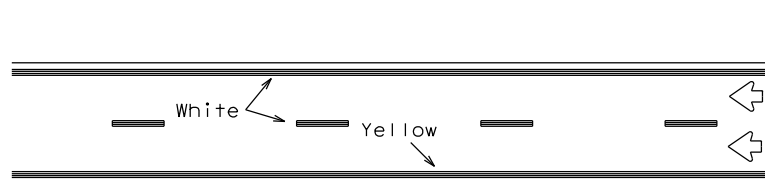


REFLECTORIZED PAVEMENT MARKINGS

Prefabricated markings may be substituted for reflectORIZED pavement markings.

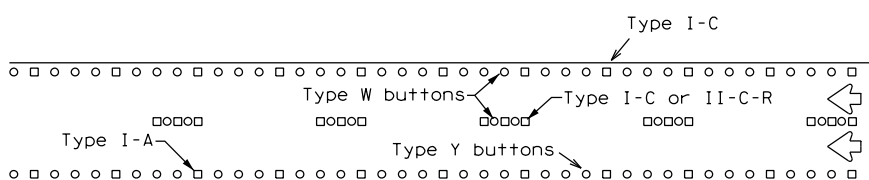


RAISED PAVEMENT MARKERS

EDGE & LANE LINES FOR DIVIDED HIGHWAY

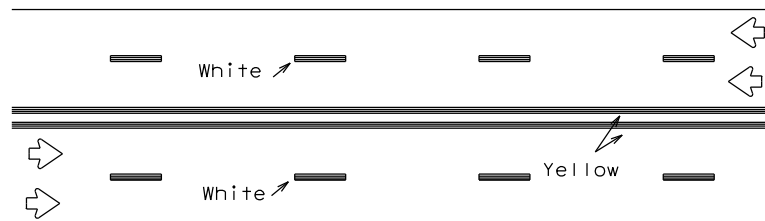


REFLECTORIZED PAVEMENT MARKINGS

Prefabricated markings may be substituted for reflectORIZED pavement markings.

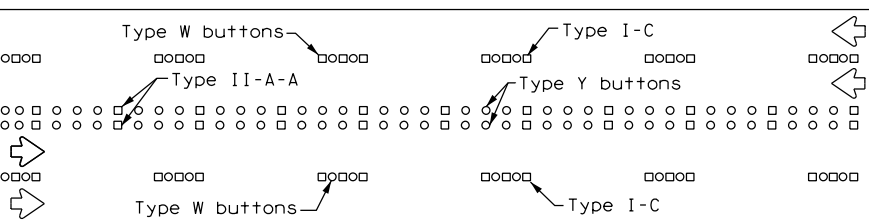


RAISED PAVEMENT MARKERS

LANE & CENTER LINES FOR MULTILANE UNDIVIDED HIGHWAYS

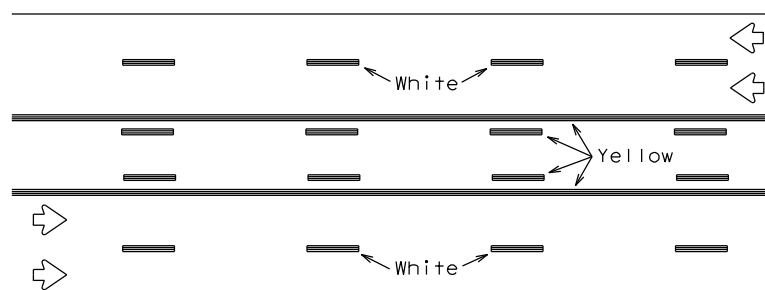

REFLECTORIZED PAVEMENT MARKINGS


Prefabricated markings may be substituted for reflectORIZED pavement markings.

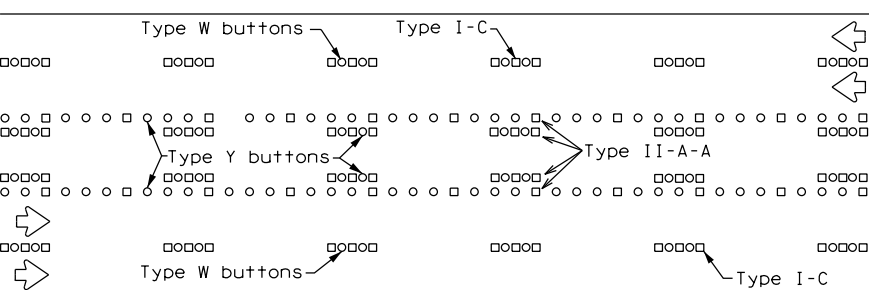



RAISED PAVEMENT MARKERS

TWO-WAY LEFT TURN LANE


STANDARD WORK ZONE PAVEMENT MARKINGS DETAILS

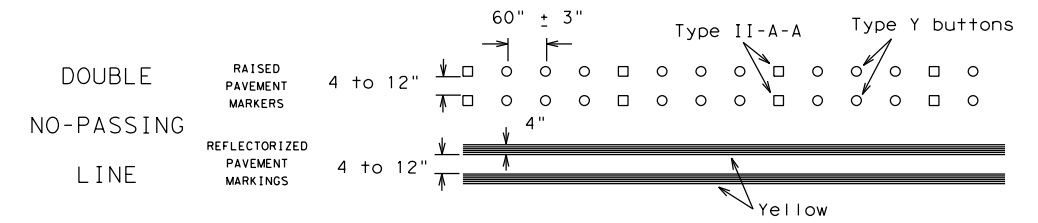


SOLID LINES

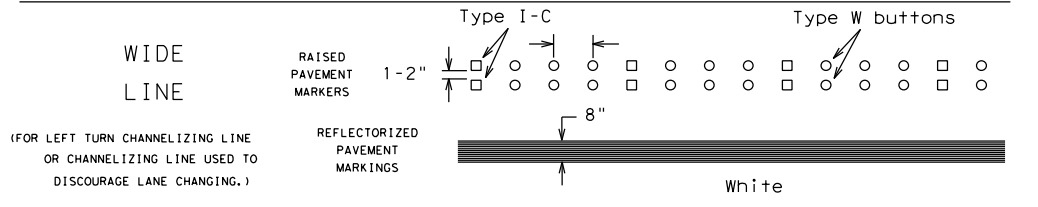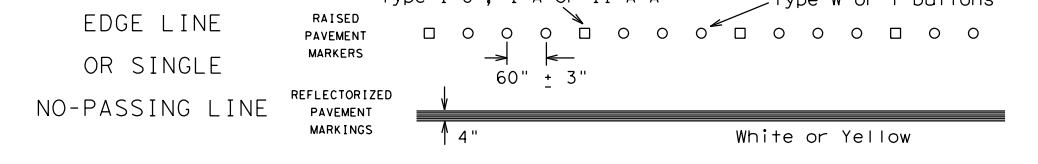

BROKEN LINES

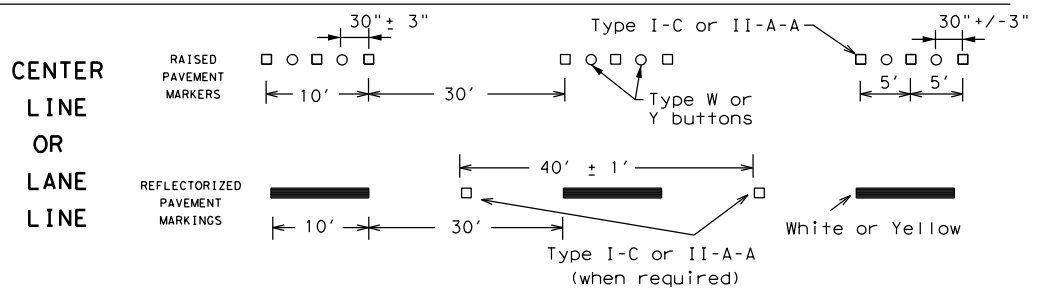


AUXILIARY OR LANEDROP LINE

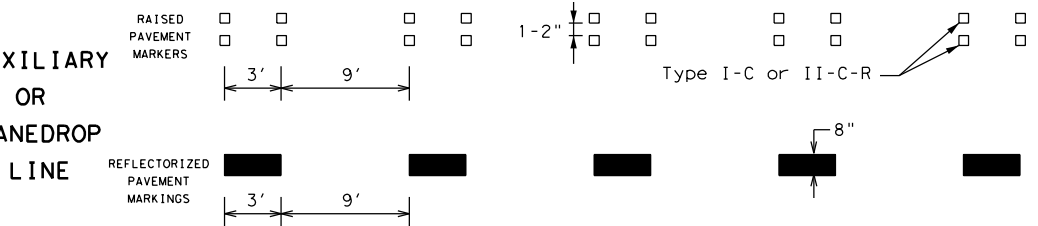

REMOVABLE MARKINGS WITH RAISED PAVEMENT MARKERS

If raised pavement markers are used to supplement REMOVABLE markings, the markers shall be applied to the top of the tape at the approximate mid length of tape used for broken lines or at 20 foot spacing for solid lines. This allows an easier removal of raised pavement markers and tape.

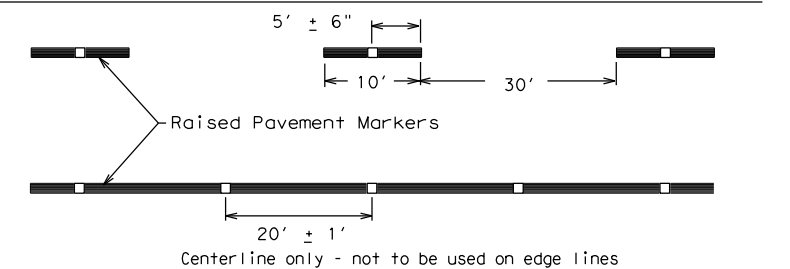

SHEET 12 OF 12



BARRICADE AND CONSTRUCTION PAVEMENT MARKING PATTERNS


BC(12)-21

FILE: bc-21.dgn	DN: TxDOT	CK: TxDOT	DW: TxDOT	CK: TxDOT
©TxDOT February 1998	CONT	SECT	JOB	HIGHWAY
REVISIONS	0904	02	047	VARIOUS
1-97 9-07 5-21	DIST	COUNTY	SHEET NO.	
2-98 7-13	AMA	POTTER	018	
11-02 8-14				

DISCLAIMER: The use of this standard is governed by the "Texas Engineering Practice Act". No warranty of any kind is made by TXDOT for any purpose whatsoever. TXDOT assumes no responsibility for the conversion of this standard to other formats or for incorrect results or damages resulting from its use.


DATE:
FILE:

DISCLAIMER: The use of this standard is governed by the "Texas Engineering Practice Act". No warranty of any kind is made by TxDOT for any purpose whatsoever. TxDOT assumes no responsibility for the conversion of this standard to other formats or for incorrect results or damages resulting from its use.

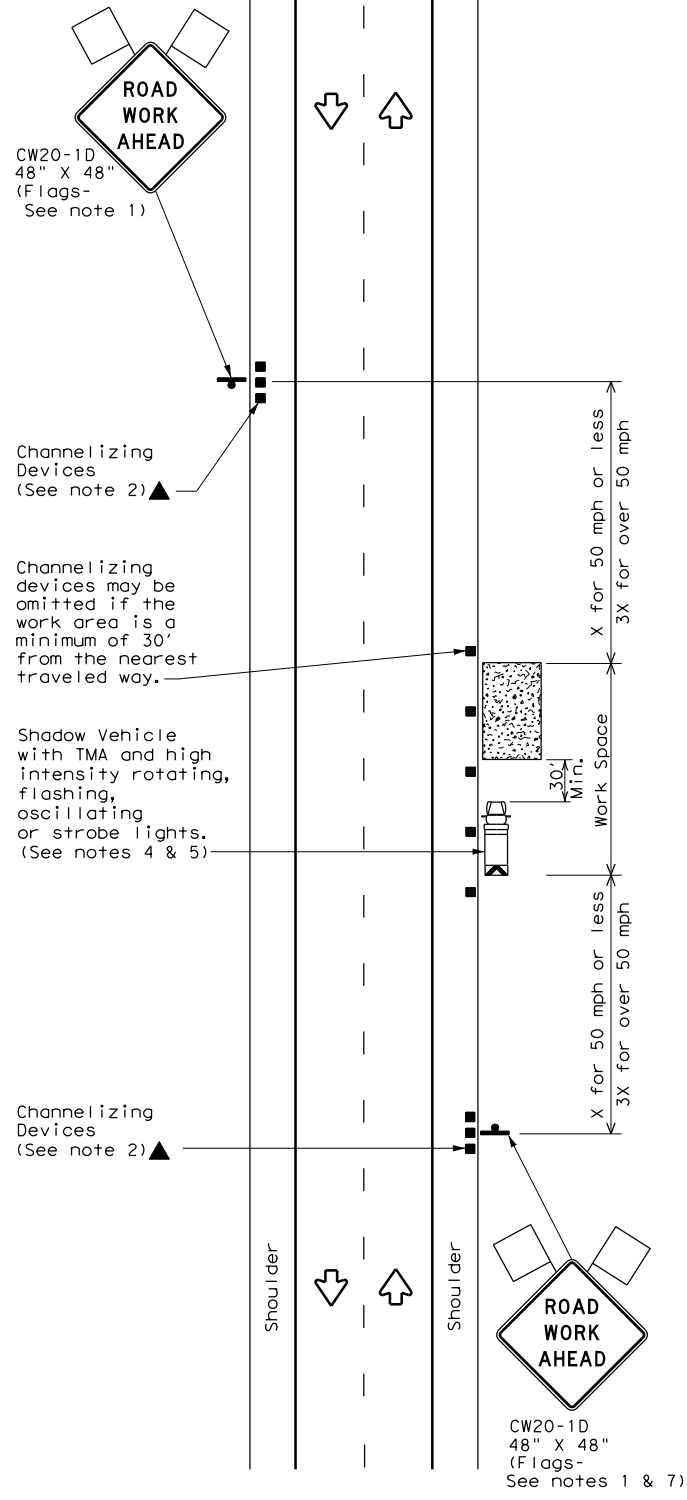


TCP (1-1a)

WORK SPACE NEAR SHOULDER
Conventional Roads

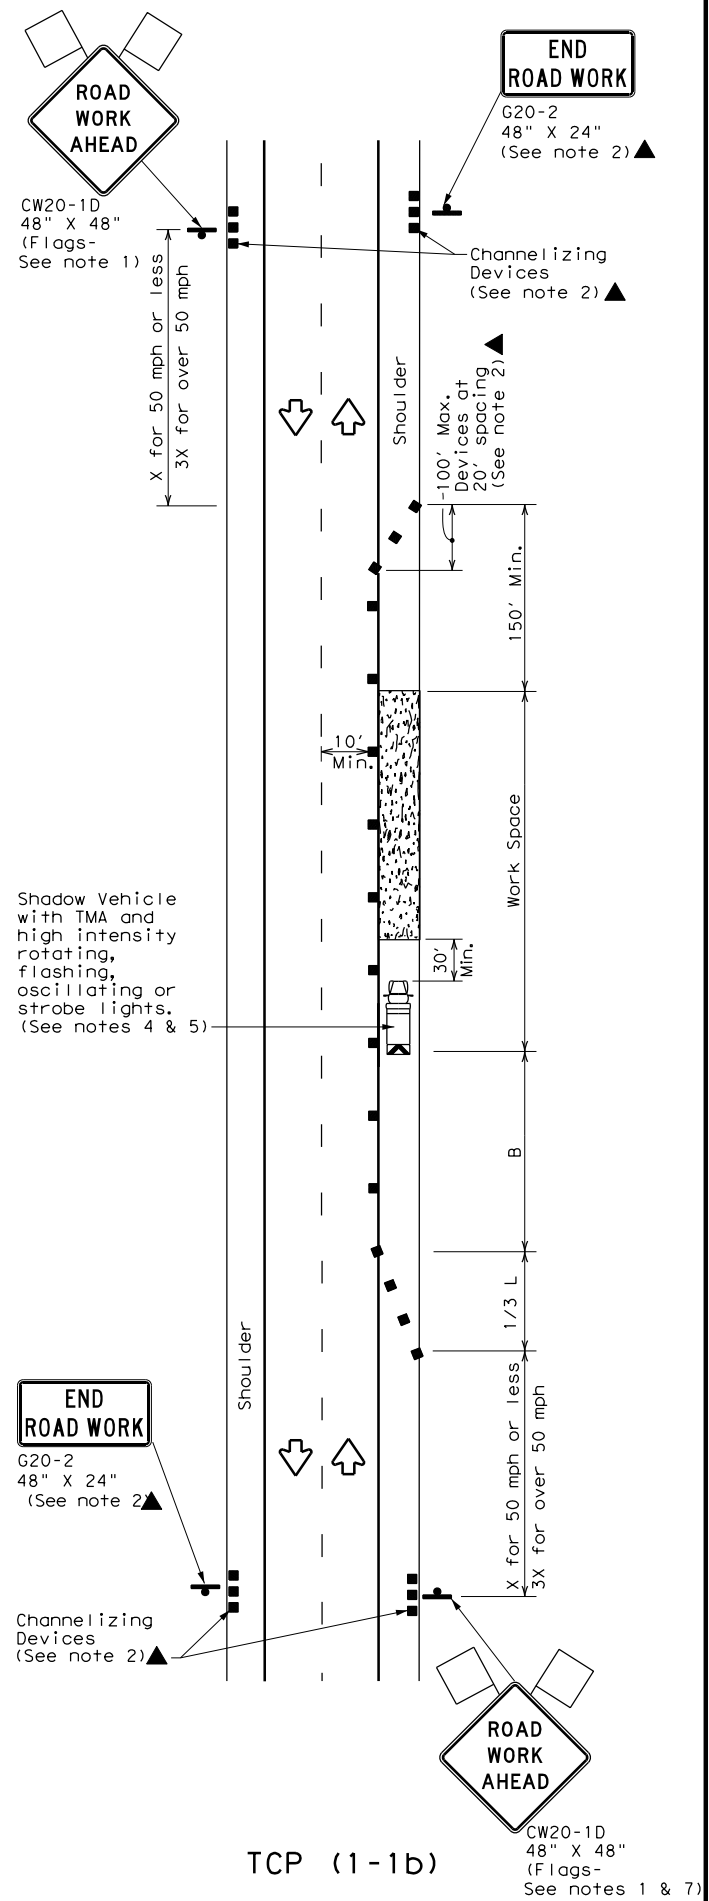

TCP (1-1b)

WORK SPACE ON SHOULDER
Conventional Roads

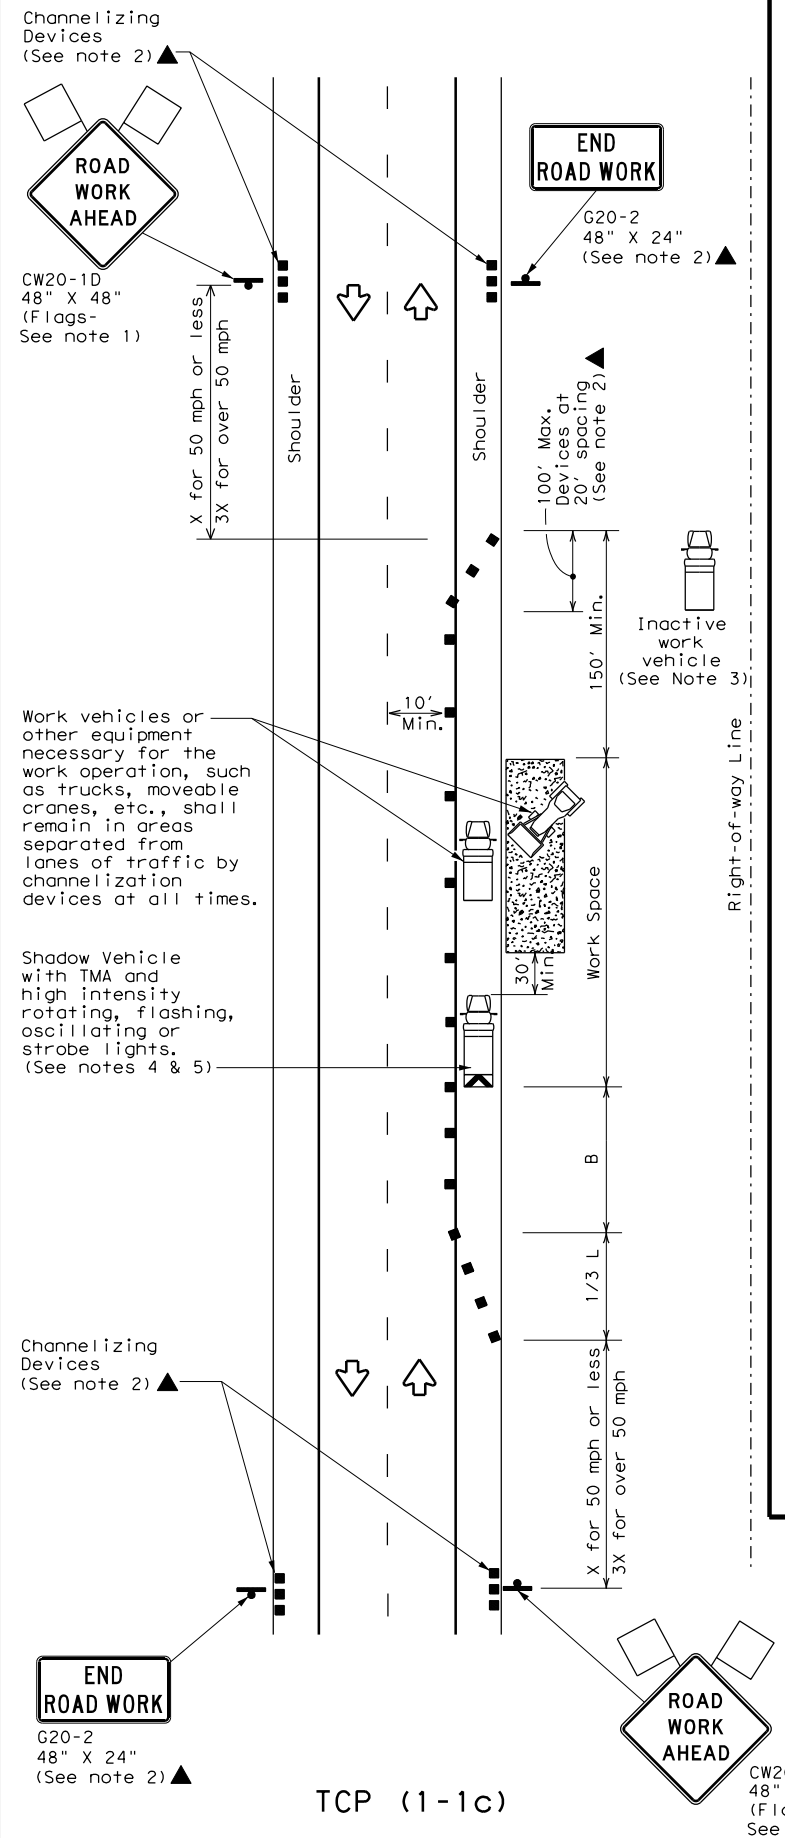

TCP (1-1c)

WORK VEHICLES ON SHOULDER
Conventional Roads

LEGEND			
	Type 3 Barricade		Channelizing Devices
	Heavy Work Vehicle		Truck Mounted Attenuator (TMA)
	Trailer Mounted Flashing Arrow Board		Portable Changeable Message Sign (PCMS)
	Sign		Traffic Flow
	Flag		Flagger

Posted Speed *	Formula	Minimum Desirable Taper Lengths **			Suggested Maximum Spacing of Channelizing Devices		Minimum Sign Spacing "X" Distance	Suggested Longitudinal Buffer Space "B"
		10' Offset	11' Offset	12' Offset	On a Taper	On a Tangent		
30	L = WS ² / 60	150'	165'	180'	30'	60'	120'	90'
35		205'	225'	245'	35'	70'	160'	120'
40		265'	295'	320'	40'	80'	240'	155'
45	L = WS	450'	495'	540'	45'	90'	320'	195'
50		500'	550'	600'	50'	100'	400'	240'
55		550'	605'	660'	55'	110'	500'	295'
60		600'	660'	720'	60'	120'	600'	350'
65		650'	715'	780'	65'	130'	700'	410'
70		700'	770'	840'	70'	140'	800'	475'
75		750'	825'	900'	75'	150'	900'	540'

* Conventional Roads Only
** Taper lengths have been rounded off.
L=Length of Taper (FT) W=Width of Offset (FT) S=Posted Speed (MPH)

TYPICAL USAGE				
MOBILE	SHORT DURATION	SHORT TERM STATIONARY	INTERMEDIATE TERM STATIONARY	LONG TERM STATIONARY
	✓	✓		

- GENERAL NOTES**
- Flags attached to signs where shown are REQUIRED.
 - All traffic control devices illustrated are REQUIRED, except those denoted with the triangle symbol may be omitted when stated elsewhere in the plans, or for routine maintenance work, when approved by the Engineer.
 - Inactive work vehicles or other equipment should be parked near the right-of-way line and not parked on the paved shoulder.
 - A Shadow Vehicle with a TMA should be used anytime it can be positioned 30 to 100 feet in advance of the area of crew exposure without adversely affecting the performance or quality of the work. If workers are no longer present but road or work conditions require the traffic control to remain in place, Type 3 Barricades or other channelizing devices may be substituted for the Shadow Vehicle and TMA.
 - Additional Shadow Vehicles with TMAs may be positioned off the paved surface, next to those shown in order to protect wider work spaces.
 - See TCP(5-1) for shoulder work on divided highways, expressways and freeways.
 - CW21-5 "SHOULDER WORK" signs may be used in place of CW20-1D "ROAD WORK AHEAD" signs for shoulder work on conventional roadways.



TRAFFIC CONTROL PLAN
CONVENTIONAL ROAD
SHOULDER WORK


TCP (1-1) - 18

FILE: tcp1-1-18.dgn	DN:	CK:	DW:	CK:
© TxDOT December 1985	CON:	SECT:	JOB:	HIGHWAY:
REVISIONS	0904	02	047	VARIOUS
2-94 4-98	DIST:	COUNTY:	SHEET NO.:	
8-95 2-12	AMA	POTTER	019	
1-97 2-18				

DATE:
FILE:

DISCLAIMER: The use of this standard is governed by the "Texas Engineering Practice Act". No warranty of any kind is made by TxDOT for any purpose whatsoever. TxDOT assumes no responsibility for the conversion of this standard to other formats or for incorrect results or damages resulting from its use.

DATE: FILE:

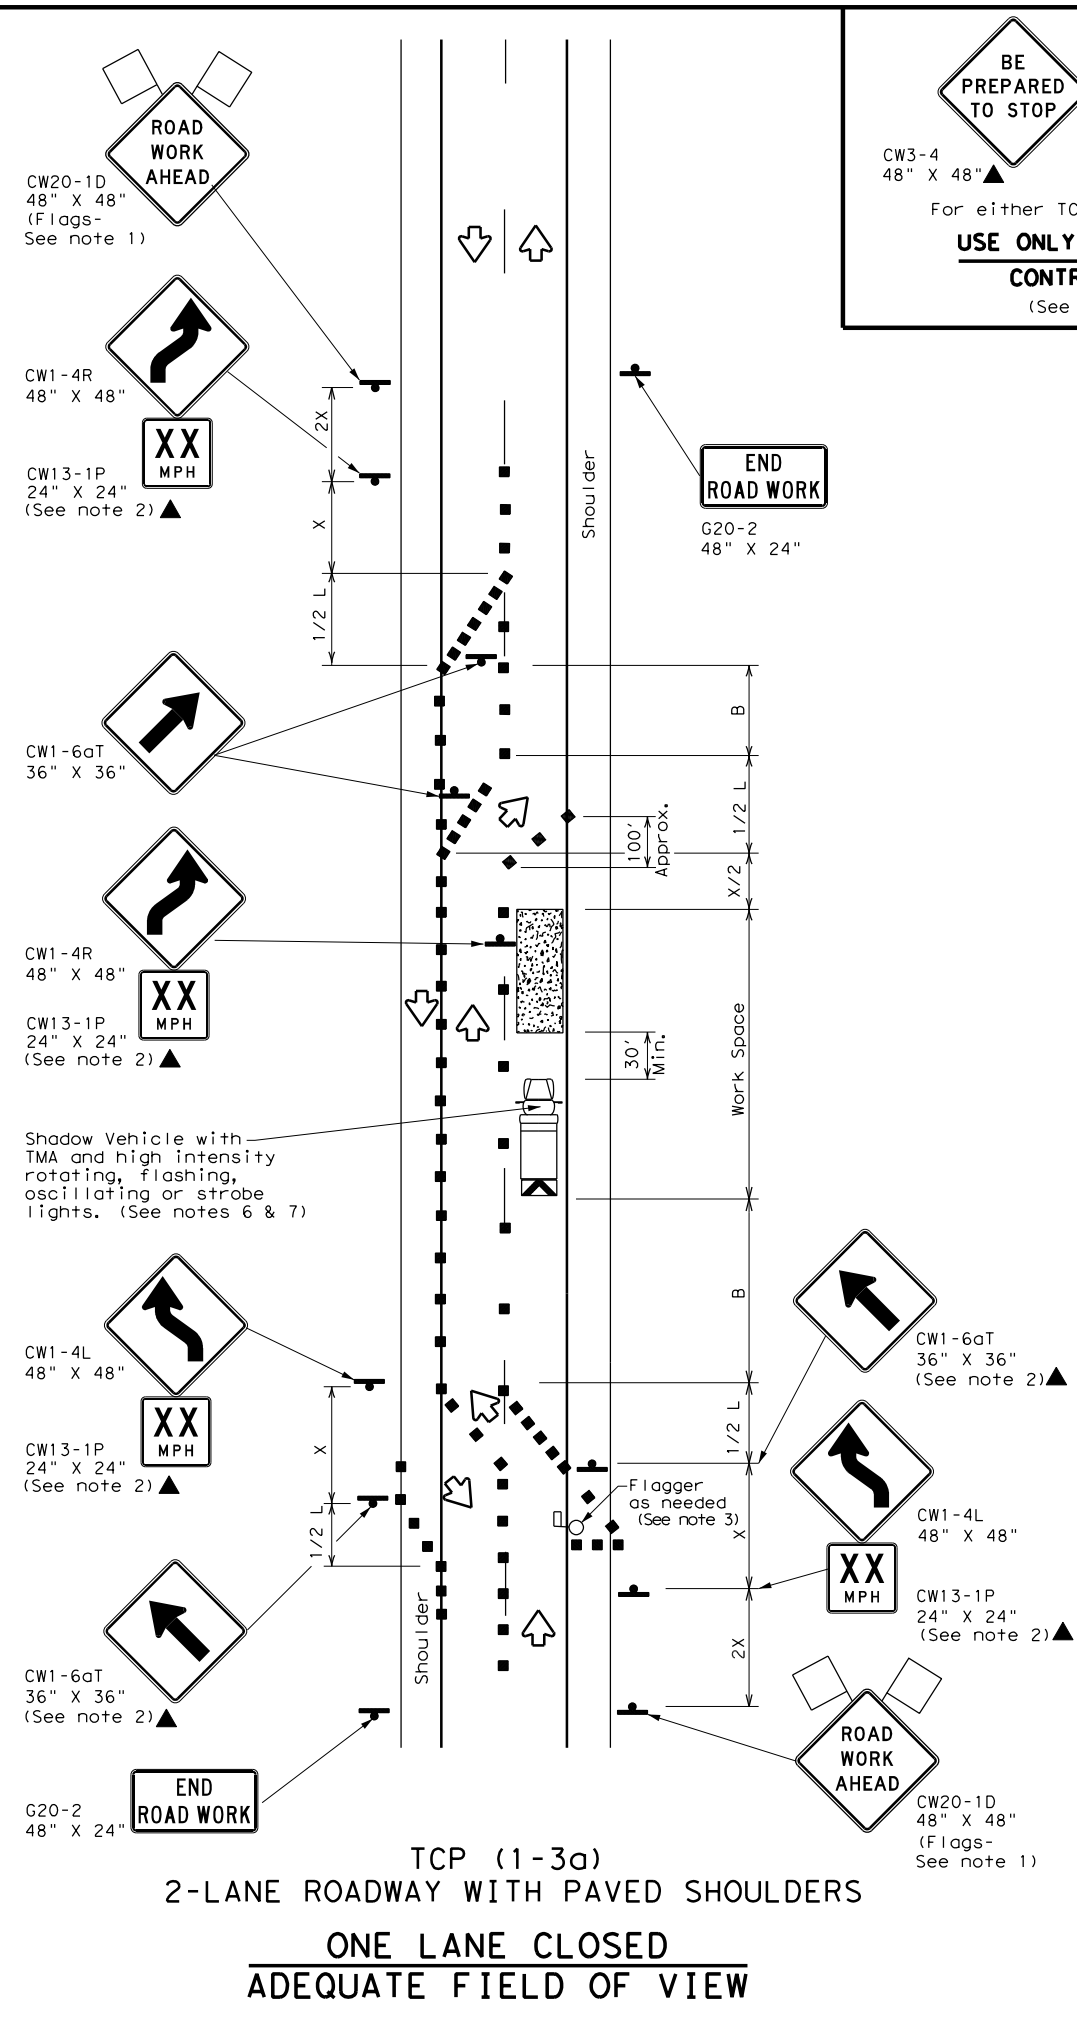


BE PREPARED TO STOP

CW3-4 48" X 48" ▲ CW20-7 48" X 48" ▲

For either TCP(1-3a) or TCP(1-3b)

USE ONLY WHEN FLAGGERS CONTROL TRAFFIC

(See Notes 2 & 3)

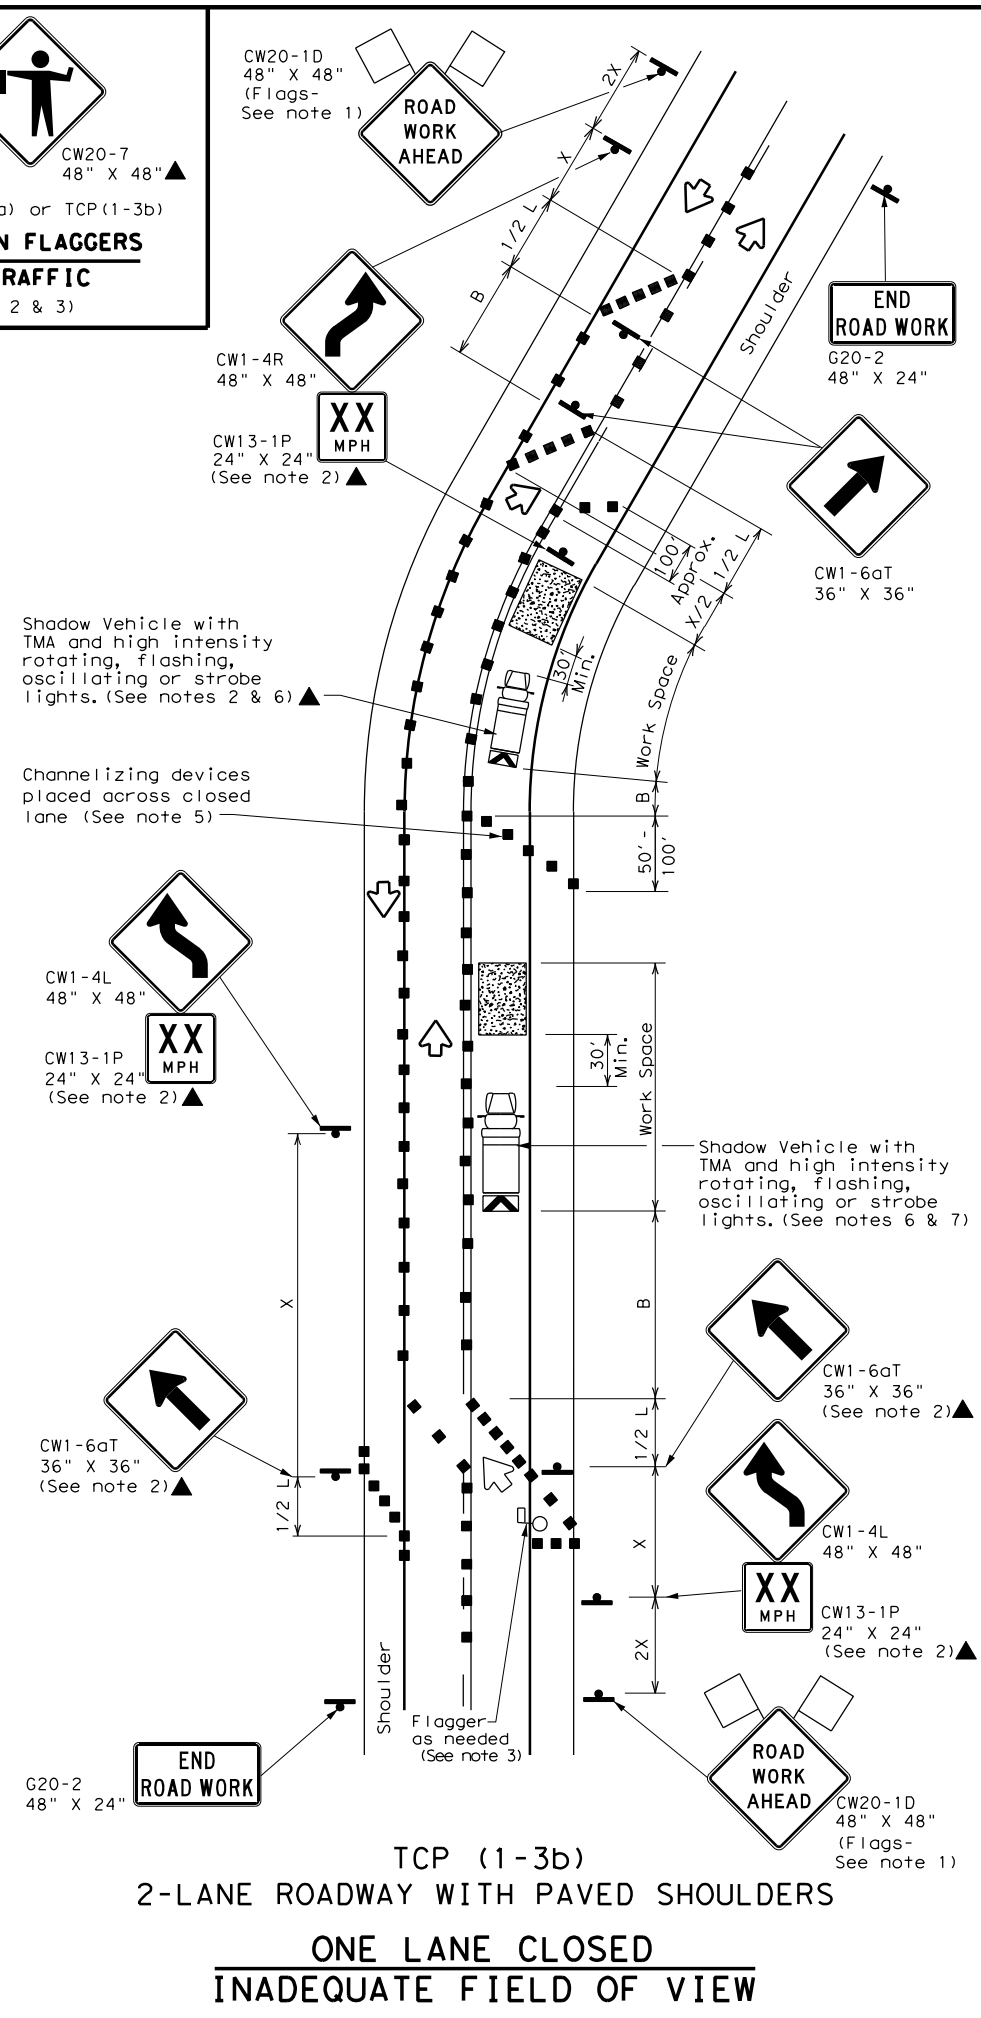

LEGEND

	Type 3 Barricade		Channelizing Devices
	Heavy Work Vehicle		Truck Mounted Attenuator (TMA)
	Trailer Mounted Flashing Arrow Board		Portable Changeable Message Sign (PCMS)
	Sign		Traffic Flow
	Flag		Flagger

Posted Speed *	Formula	Minimum Desirable Taper Lengths **			Suggested Maximum Spacing of Channelizing Devices		Minimum Sign Spacing "x" Distance	Suggested Longitudinal Buffer Space "B"
		10' Offset	11' Offset	12' Offset	On a Taper	On a Tangent		
30	L = WS/60	150'	165'	180'	30'	60'	120'	90'
35		205'	225'	245'	35'	70'	160'	120'
40		265'	295'	320'	40'	80'	240'	155'
45	L = WS	450'	495'	540'	45'	90'	320'	195'
50		500'	550'	600'	50'	100'	400'	240'
55		550'	605'	660'	55'	110'	500'	295'
60		600'	660'	720'	60'	120'	600'	350'
65		650'	715'	780'	65'	130'	700'	410'
70		700'	770'	840'	70'	140'	800'	475'
75		750'	825'	900'	75'	150'	900'	540'

* Conventional Roads Only
 ** Taper lengths have been rounded off.
 L=Length of Taper (FT) W=Width of Offset (FT) S=Posted Speed (MPH)

TYPICAL USAGE

MOBILE	SHORT DURATION	SHORT TERM STATIONARY	INTERMEDIATE TERM STATIONARY	LONG TERM STATIONARY
	✓	✓		

- GENERAL NOTES**
- Flags attached to signs where shown are REQUIRED.
 - All traffic control devices illustrated are REQUIRED, except those denoted with the triangle symbol may be omitted when stated elsewhere in the plans, or for routine maintenance work, when approved by the Engineer.
 - Flagger control should NOT be used unless roadway conditions or heavy traffic volume require additional emphasis to safely control traffic. Additional flaggers may be positioned in advance of traffic queues to alert traffic to reduce speed.
 - DO NOT PASS, PASS WITH CARE and construction regulatory speed zone signs may be installed downstream of the ROAD WORK AHEAD signs.
 - When the work zone is made up of several work spaces, channelizing devices should be placed laterally across the closed lane to re-emphasize closure. Laterally placed channelizing devices should be repeated every 500 to 1000 feet in urban areas and every 1/4 to 1/2 mile in rural areas.
 - A Shadow Vehicle with a TMA should be used anytime it can be positioned 30 to 100 feet in advance of the area of crew exposure without adversely affecting the performance or quality of the work. If workers are no longer present but road or work conditions require the traffic control to remain in place, Type 3 Barricades or other channelizing devices may be substituted for the Shadow Vehicle and TMA.
 - Additional Shadow Vehicles with TMAs may be positioned off the paved surface, next to those shown in order to protect wider work spaces.
 - Where traffic is directed over a yellow centerline, channelizing devices which separate two-way traffic should be spaced on tapers at 20', or 15' if posted speed are 35 mph or slower, and for tangent sections, at 1/2S where S is the speed in mph. This tighter device spacing is intended for the area of conflicting markings not the entire work zone.



Texas Department of Transportation Traffic Operations Division Standard

TRAFFIC CONTROL PLAN
TRAFFIC SHIFTS ON
TWO LANE ROADS
TCP (1-3) - 18

FILE: tcp1-3-18.dgn	DN:	CK:	DW:	CK:
© TxDOT December 1985	CONT	SECT	JOB	HIGHWAY
REVISIONS	0904	02	047	VARIOUS
2-94 4-98	DIST	COUNTY	SHEET NO.	
8-95 2-12	AMA	POTTER	021	
1-97 2-18				

DISCLAIMER: The use of this standard is governed by the "Texas Engineering Practice Act". No warranty of any kind is made by TxDOT for any purpose whatsoever. TxDOT assumes no responsibility for the conversion of this standard to other formats or for incorrect results or damages resulting from its use.

DATE: FILE:

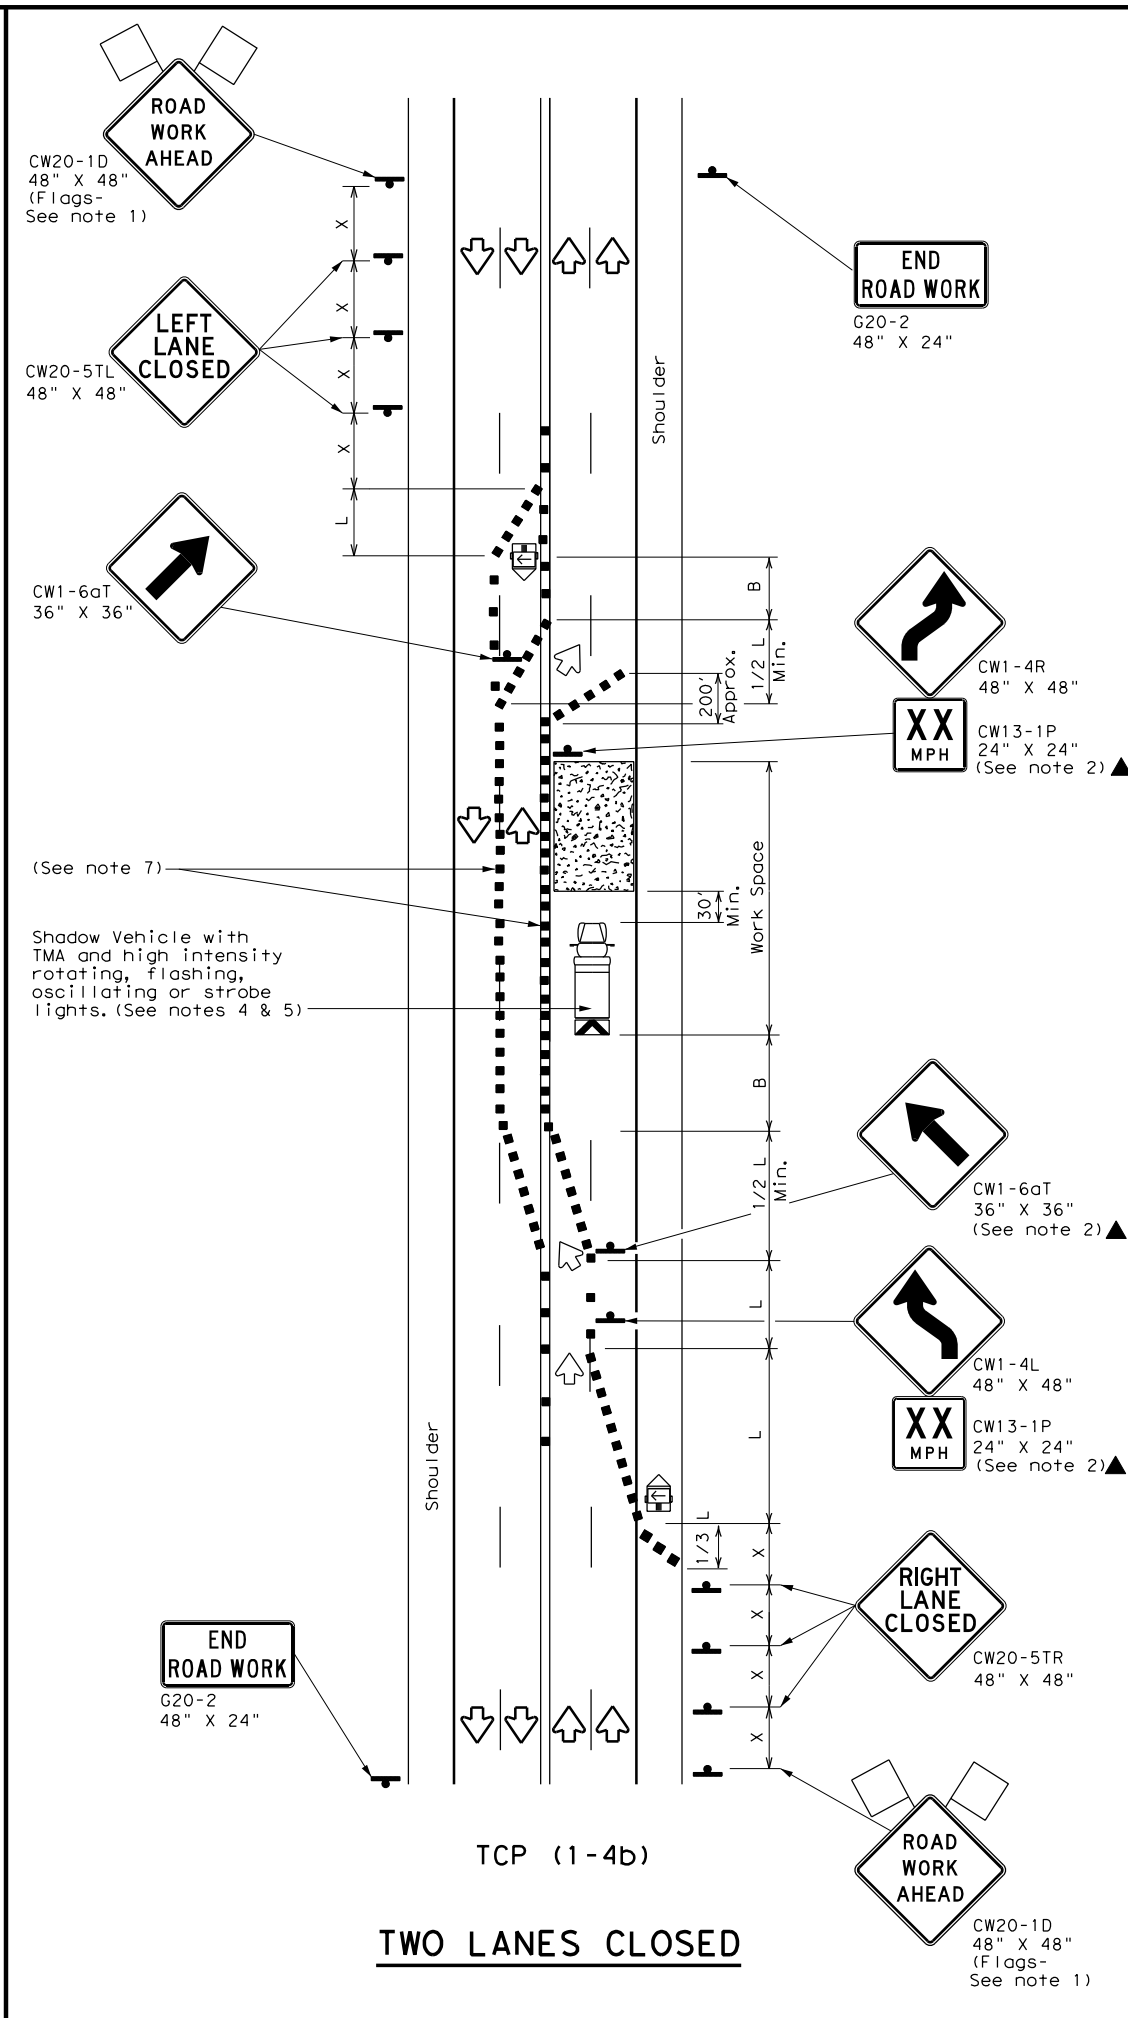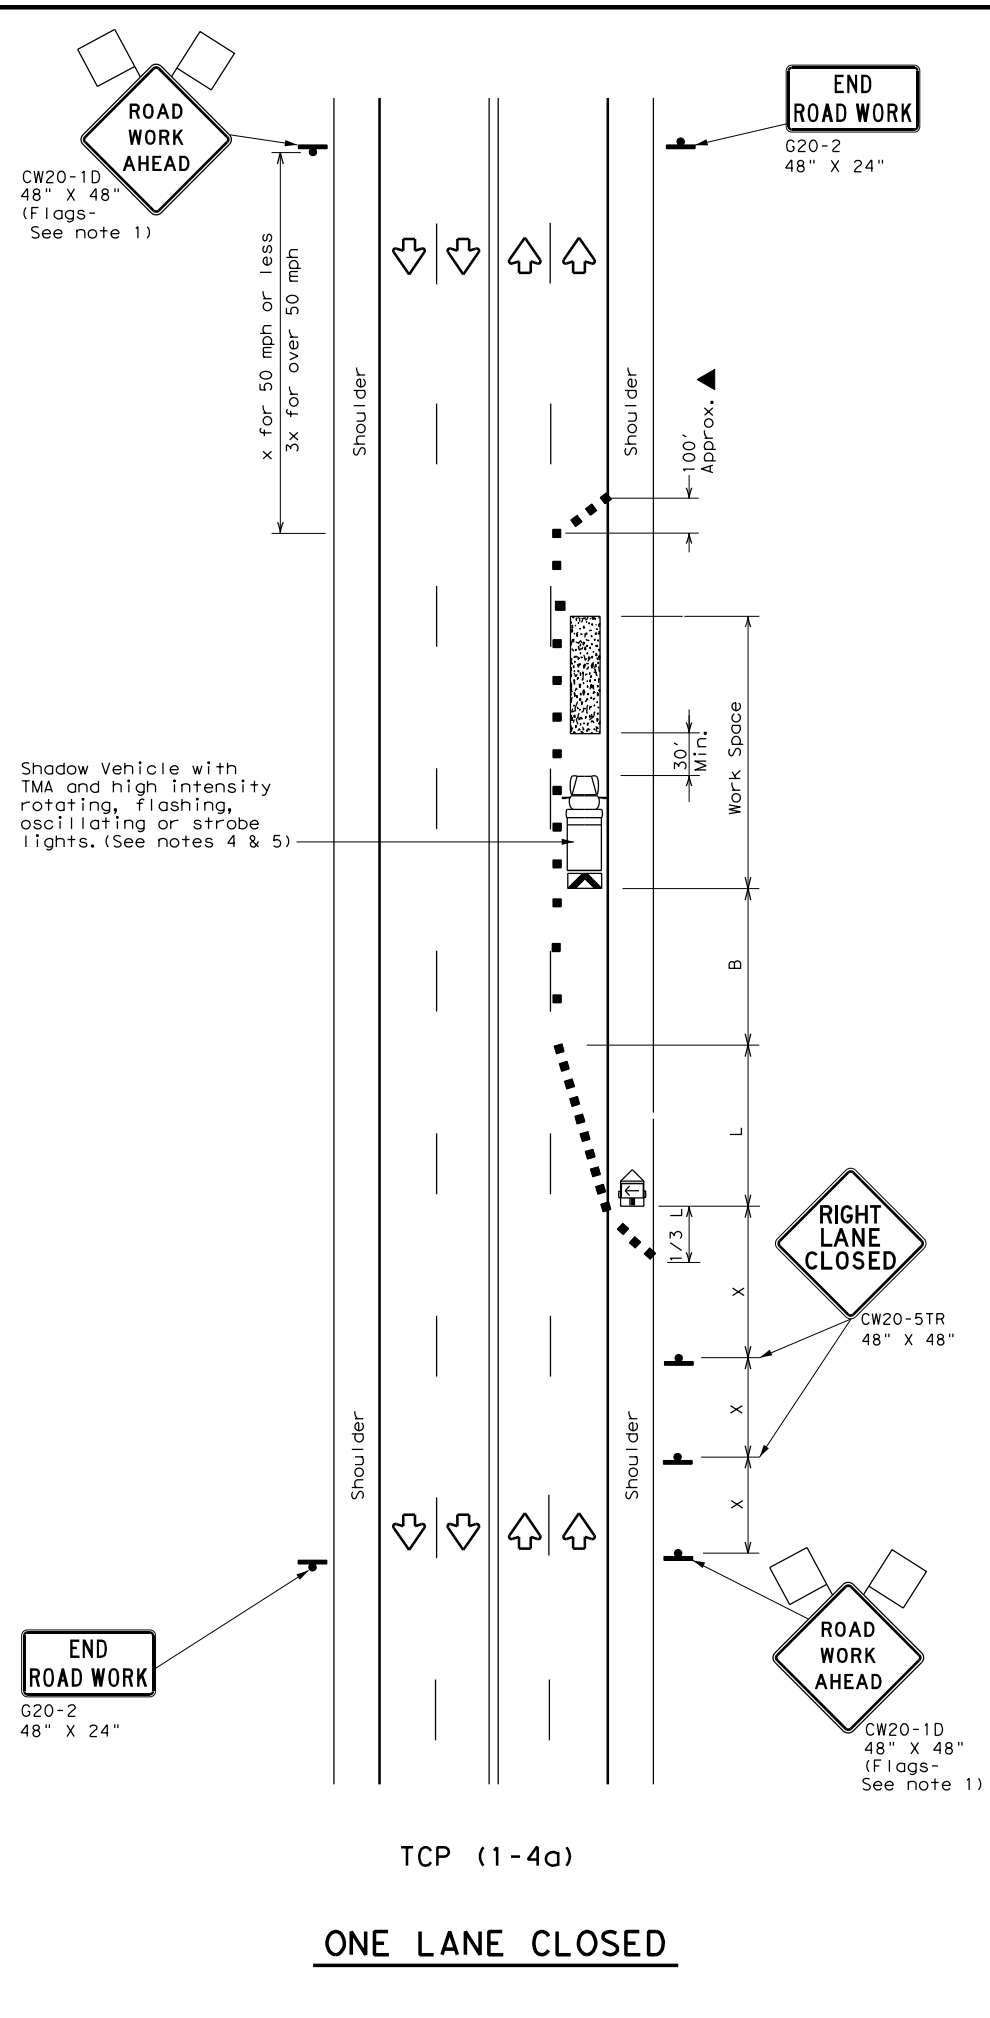

LEGEND			
	Type 3 Barricade		Channelizing Devices
	Heavy Work Vehicle		Truck Mounted Attenuator (TMA)
	Trailer Mounted Flashing Arrow Board		Portable Changeable Message Sign (PCMS)
	Sign		Traffic Flow
	Flag		Flagger

Posted Speed *	Formula	Minimum Desirable Taper Lengths **			Suggested Maximum Spacing of Channelizing Devices		Minimum Sign Spacing "X" Distance	Suggested Longitudinal Buffer Space "B"
		10' Offset	11' Offset	12' Offset	On a Taper	On a Tangent		
30	$L = \frac{WS^2}{60}$	150'	165'	180'	30'	60'	120'	90'
35		205'	225'	245'	35'	70'	160'	120'
40		265'	295'	320'	40'	80'	240'	155'
45	L = WS	450'	495'	540'	45'	90'	320'	195'
50		500'	550'	600'	50'	100'	400'	240'
55		550'	605'	660'	55'	110'	500'	295'
60		600'	660'	720'	60'	120'	600'	350'
65		650'	715'	780'	65'	130'	700'	410'
70		700'	770'	840'	70'	140'	800'	475'
75		750'	825'	900'	75'	150'	900'	540'

* Conventional Roads Only
 ** Taper lengths have been rounded off.
 L=Length of Taper (FT) W=Width of Offset (FT) S=Posted Speed (MPH)

TYPICAL USAGE				
MOBILE	SHORT DURATION	SHORT TERM STATIONARY	INTERMEDIATE TERM STATIONARY	LONG TERM STATIONARY
	✓	✓		

- GENERAL NOTES**
- Flags attached to signs where shown are REQUIRED.
 - All traffic control devices illustrated are REQUIRED, except those denoted with the triangle symbol may be omitted when stated elsewhere in the plans, or for routine maintenance work, when approved by the Engineer.
 - The CW20-1D "ROAD WORK AHEAD" sign may be repeated if the visibility of the work zone is less than 1500 feet.
 - A Shadow Vehicle with a TMA should be used anytime it can be positioned 30 to 100 feet in advance of the area of crew exposure without adversely affecting the performance or quality of the work. If workers are no longer present but road or work conditions require the traffic control to remain in place, Type 3 Barricades or other channelizing devices may be substituted for the Shadow Vehicle and TMA.
 - Additional Shadow Vehicles with TMAs may be positioned off the paved surface, next to those shown in order to protect wider work spaces.

TCP (1-4a)

6. If this TCP is used for a left lane closure, CW20-5TL "LEFT LANE CLOSED" signs shall be used and channelizing devices shall be placed on the centerline where needed to protect the work space from opposing traffic with the arrow panel placed in the closed lane near the end of the merging taper.

TCP (1-4b)

7. Where traffic is directed over a yellow centerline, channelizing devices which separate two-way traffic should be spaced on tapers at 20' or 15' if posted speeds are 35 mph or slower, and for tangent sections, at 1/2S where S is the speed in mph. This tighter device spacing is intended for the areas of conflicting markings, not the entire work zone.

Texas Department of Transportation
Traffic Operations Division Standard

TRAFFIC CONTROL PLAN LANE CLOSURES ON MULTILANE CONVENTIONAL ROADS


TCP (1-4) - 18

FILE: tcp1-4-18.dgn	DN:	CK:	DW:	CK:
© TxDOT December 1985	CONT	SECT	JOB	HIGHWAY
REVISIONS		0904	02	047
2-94 4-98	DIST		COUNTY	SHEET NO.
8-95 2-12	AMA		POTTER	022
1-97 2-18				

154


DISCLAIMER: The use of this standard is governed by the "Texas Engineering Practice Act". No warranty of any kind is made by TxDOT for any purpose whatsoever. TxDOT assumes no responsibility for the conversion of this standard to other formats or for incorrect results or damages resulting from its use.

DATE:
FILE:

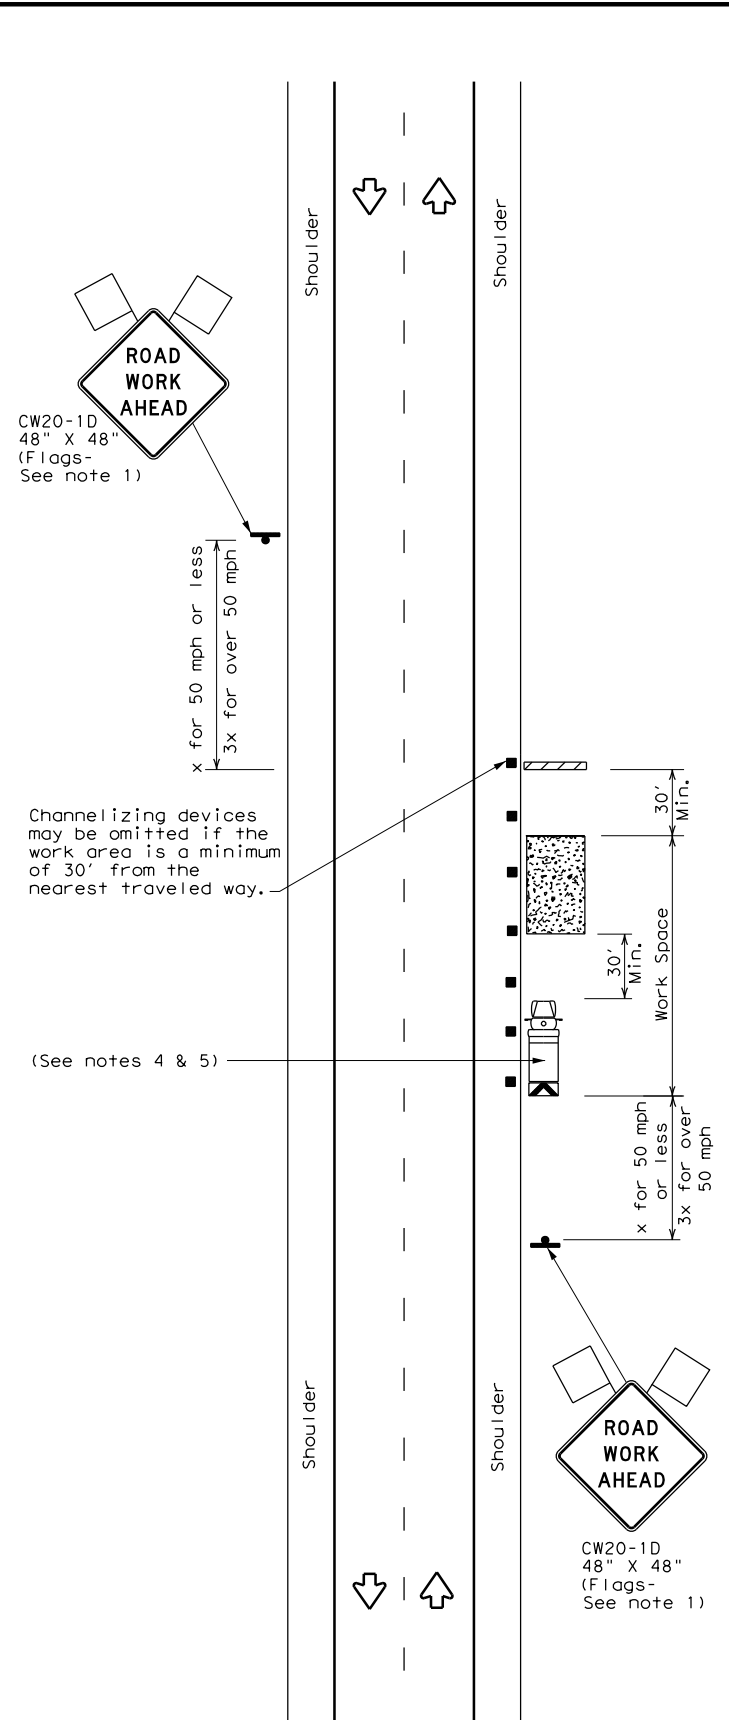


TCP (2-1a)

WORK SPACE NEAR SHOULDER
Conventional Roads

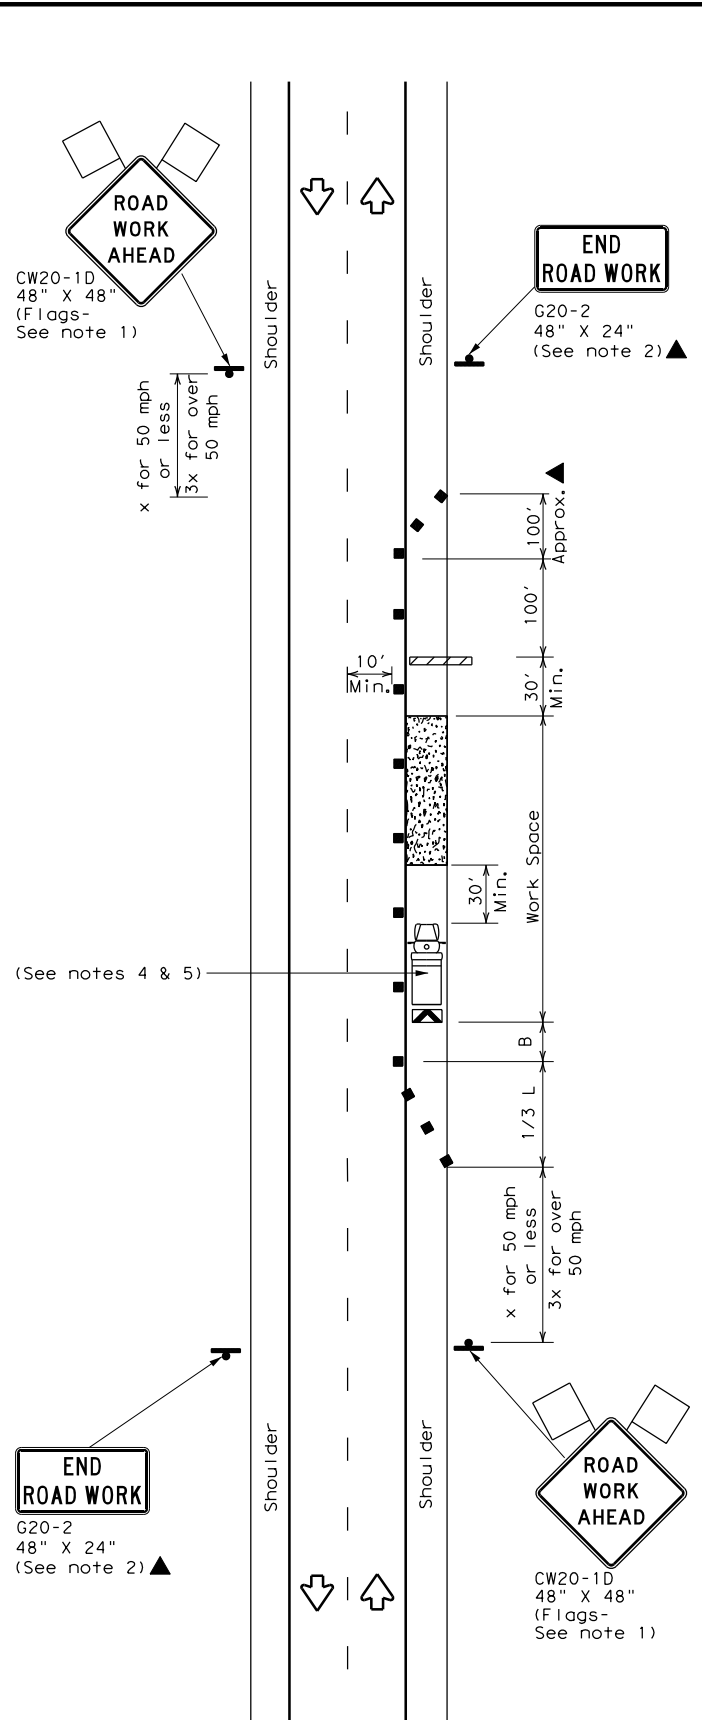

TCP (2-1b)

WORK SPACE ON SHOULDER
Conventional Roads

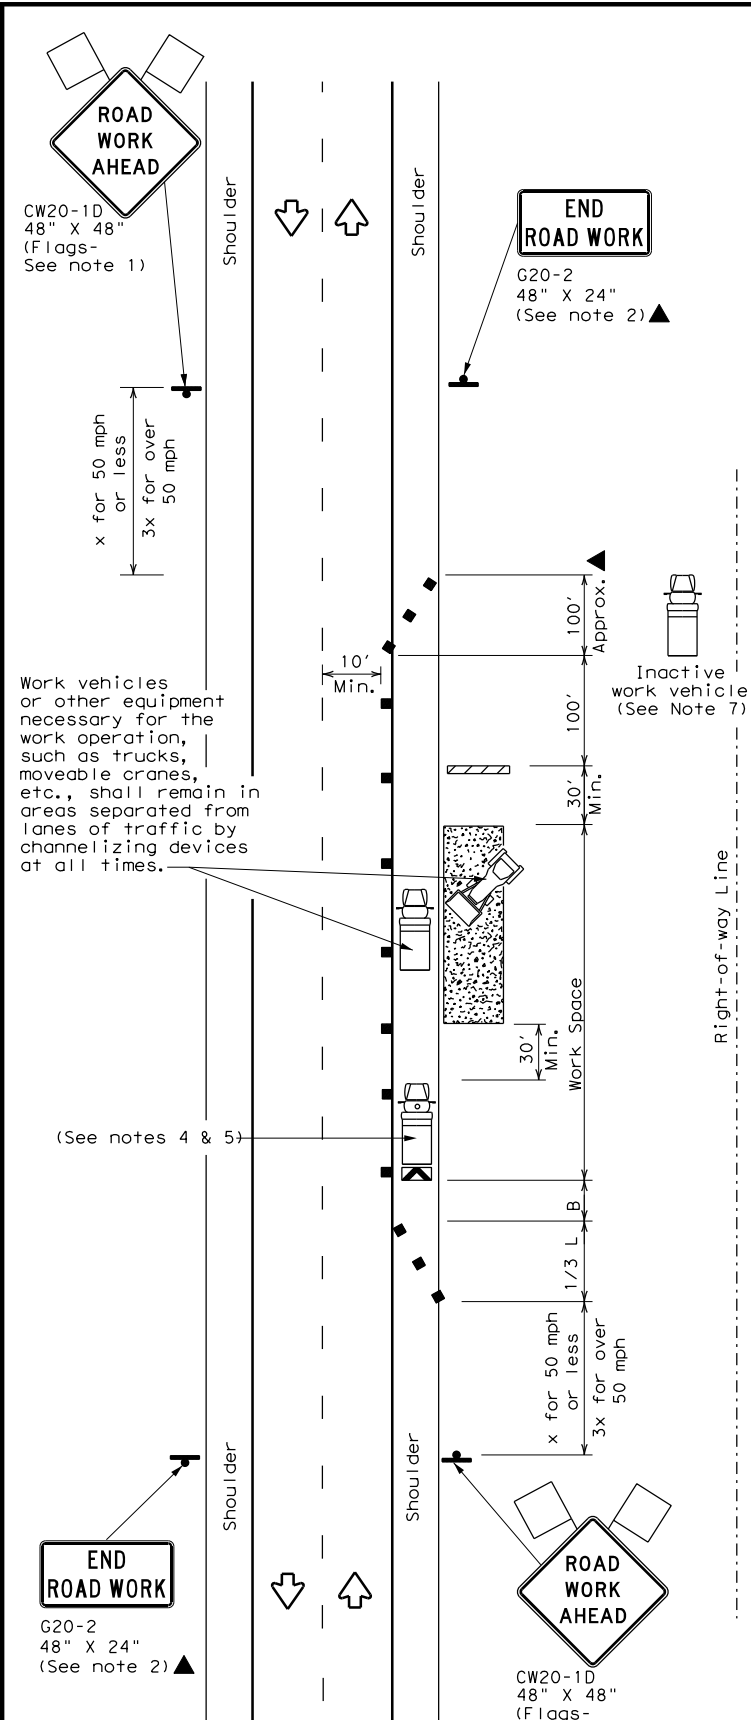

TCP (2-1c)

WORK VEHICLES ON SHOULDER
Conventional Roads

LEGEND			
	Type 3 Barricade		Channelizing Devices
	Heavy Work Vehicle		Truck Mounted Attenuator (TMA)
	Trailer Mounted Flashing Arrow Board		Portable Changeable Message Sign (PCMS)
	Sign		Traffic Flow
	Flag		Flagger

Posted Speed *	Formula	Minimum Desirable Taper Lengths **			Suggested Maximum Spacing of Channelizing Devices		Minimum Sign Spacing "X" Distance	Suggested Longitudinal Buffer Space "B"
		10' Offset	11' Offset	12' Offset	On a Taper	On a Tangent		
30	$L = \frac{WS^2}{60}$	150'	165'	180'	30'	60'	120'	90'
35		205'	225'	245'	35'	70'	160'	120'
40		265'	295'	320'	40'	80'	240'	155'
45	L = WS	450'	495'	540'	45'	90'	320'	195'
50		500'	550'	600'	50'	100'	400'	240'
55		550'	605'	660'	55'	110'	500'	295'
60		600'	660'	720'	60'	120'	600'	350'
65		650'	715'	780'	65'	130'	700'	410'
70		700'	770'	840'	70'	140'	800'	475'
75		750'	825'	900'	75'	150'	900'	540'

* Conventional Roads Only
** Taper lengths have been rounded off.
L=Length of Taper (FT) W=Width of Offset (FT) S=Posted Speed (MPH)

TYPICAL USAGE				
MOBILE	SHORT DURATION	SHORT TERM STATIONARY	INTERMEDIATE TERM STATIONARY	LONG TERM STATIONARY
	✓	✓	✓	✓

GENERAL NOTES

- Flags attached to signs where shown, are REQUIRED.
- All traffic control devices illustrated are REQUIRED, except those denoted with the triangle symbol may be omitted when stated in the plans, or for routine maintenance work, when approved by the Engineer.
- Stockpiled material should be placed a minimum of 30 feet from nearest traveled way.
- Shadow Vehicle with TMA and high intensity rotating, flashing, oscillating or strobe lights. A Shadow Vehicle with a TMA should be used anytime it can be positioned 30 to 100 feet in advance of the area of crew exposure without adversely affecting the performance or quality of the work. If workers are no longer present but road or work conditions require the traffic control to remain in place, Type 3 Barricades or other channelizing devices may be substituted for the Shadow Vehicle and TMA.
- Additional Shadow Vehicles with TMAs may be positioned off the paved surface, next to those shown in order to protect a wider work space.
- See TCP(5-1) for shoulder work on divided highways, expressways and freeways.
- Inactive work vehicles or other equipment should be parked near the right-of-way line and not parked on the paved shoulder.
- CW21-5 "SHOULDER WORK" signs may be used in place of CW20-1D "ROAD WORK AHEAD" signs for shoulder work on conventional roadways.




TRAFFIC CONTROL PLAN
CONVENTIONAL ROAD
SHOULDER WORK


TCP (2-1) - 18

FILE: tcp2-1-18.dgn	DN:	CK:	DW:	CK:
© TxDOT December 1985	CON:	SECT:	JOB:	HIGHWAY:
REVISIONS	0904	02	047	VARIOUS
2-94 4-98	DIST:	COUNTY:	SHEET NO.:	
8-95 2-12	AMA	POTTER	023	
1-97 2-18				

DISCLAIMER: The use of this standard is governed by the "Texas Engineering Practice Act". No warranty of any kind is made by TxDOT for any purpose whatsoever. TxDOT assumes no responsibility for the conversion of this standard to other formats or for incorrect results or damages resulting from its use.

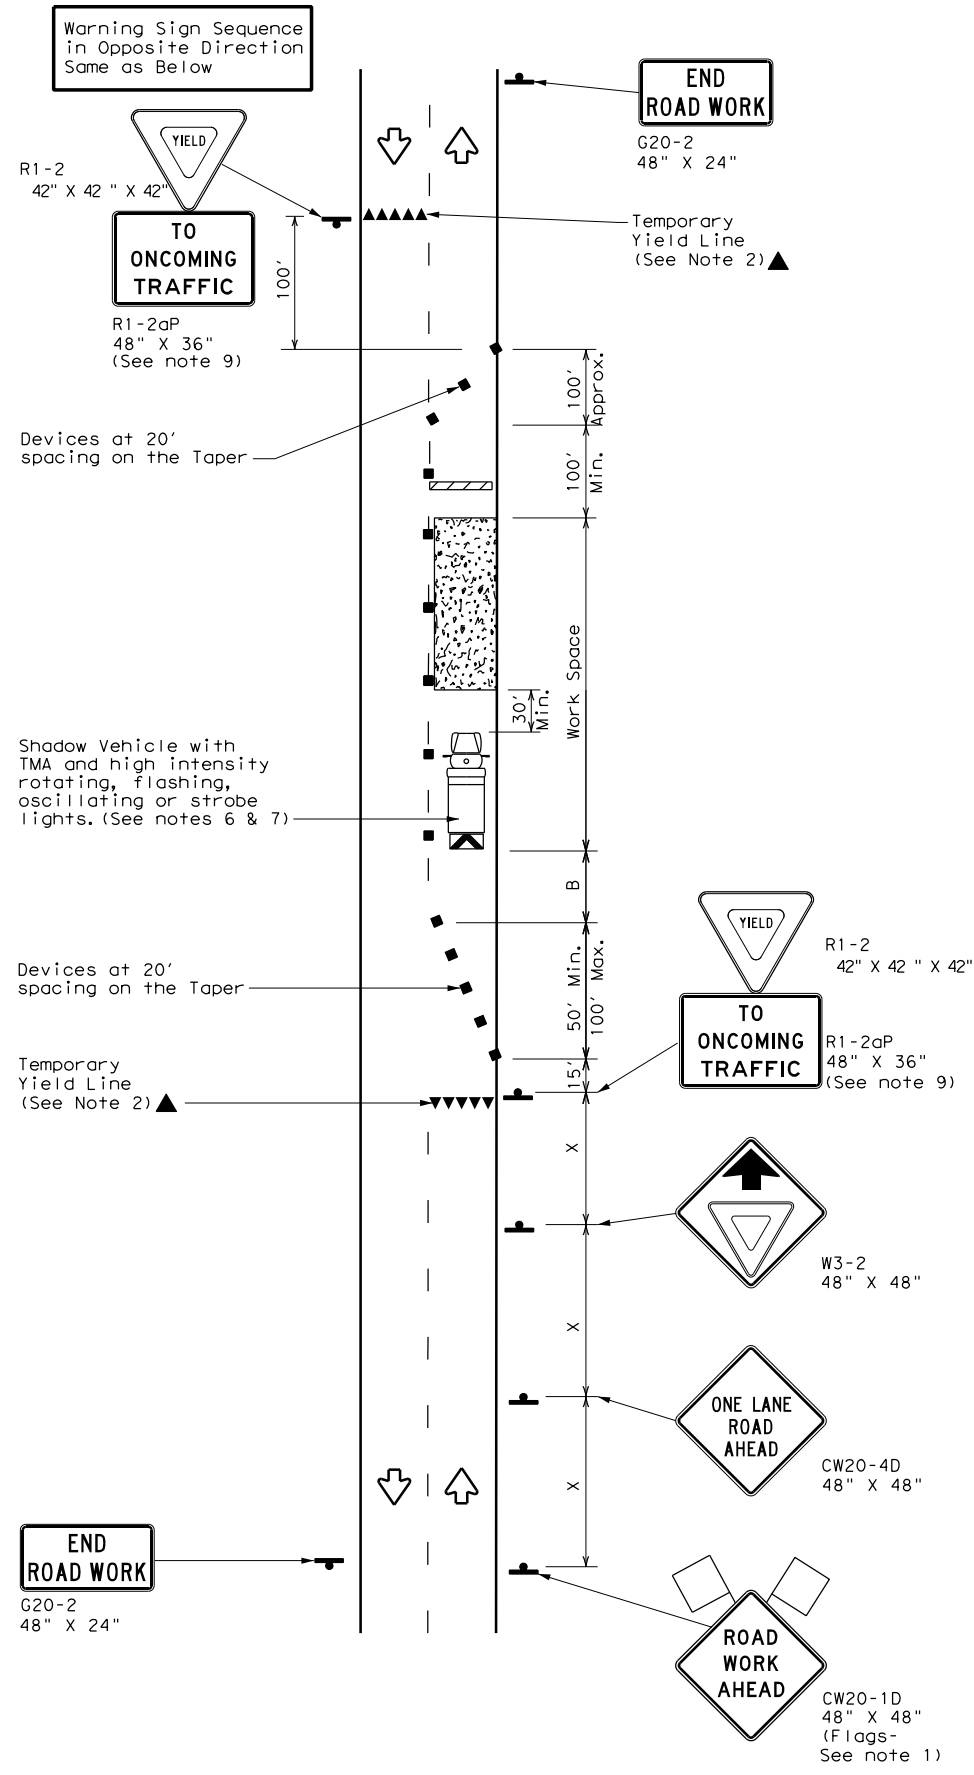

TCP (2-2a)
2-LANE ROADWAY WITHOUT PAVED SHOULDERS
ONE LANE TWO-WAY
CONTROL WITH YIELD SIGNS
(Less than 2000 ADT - See Note 9)

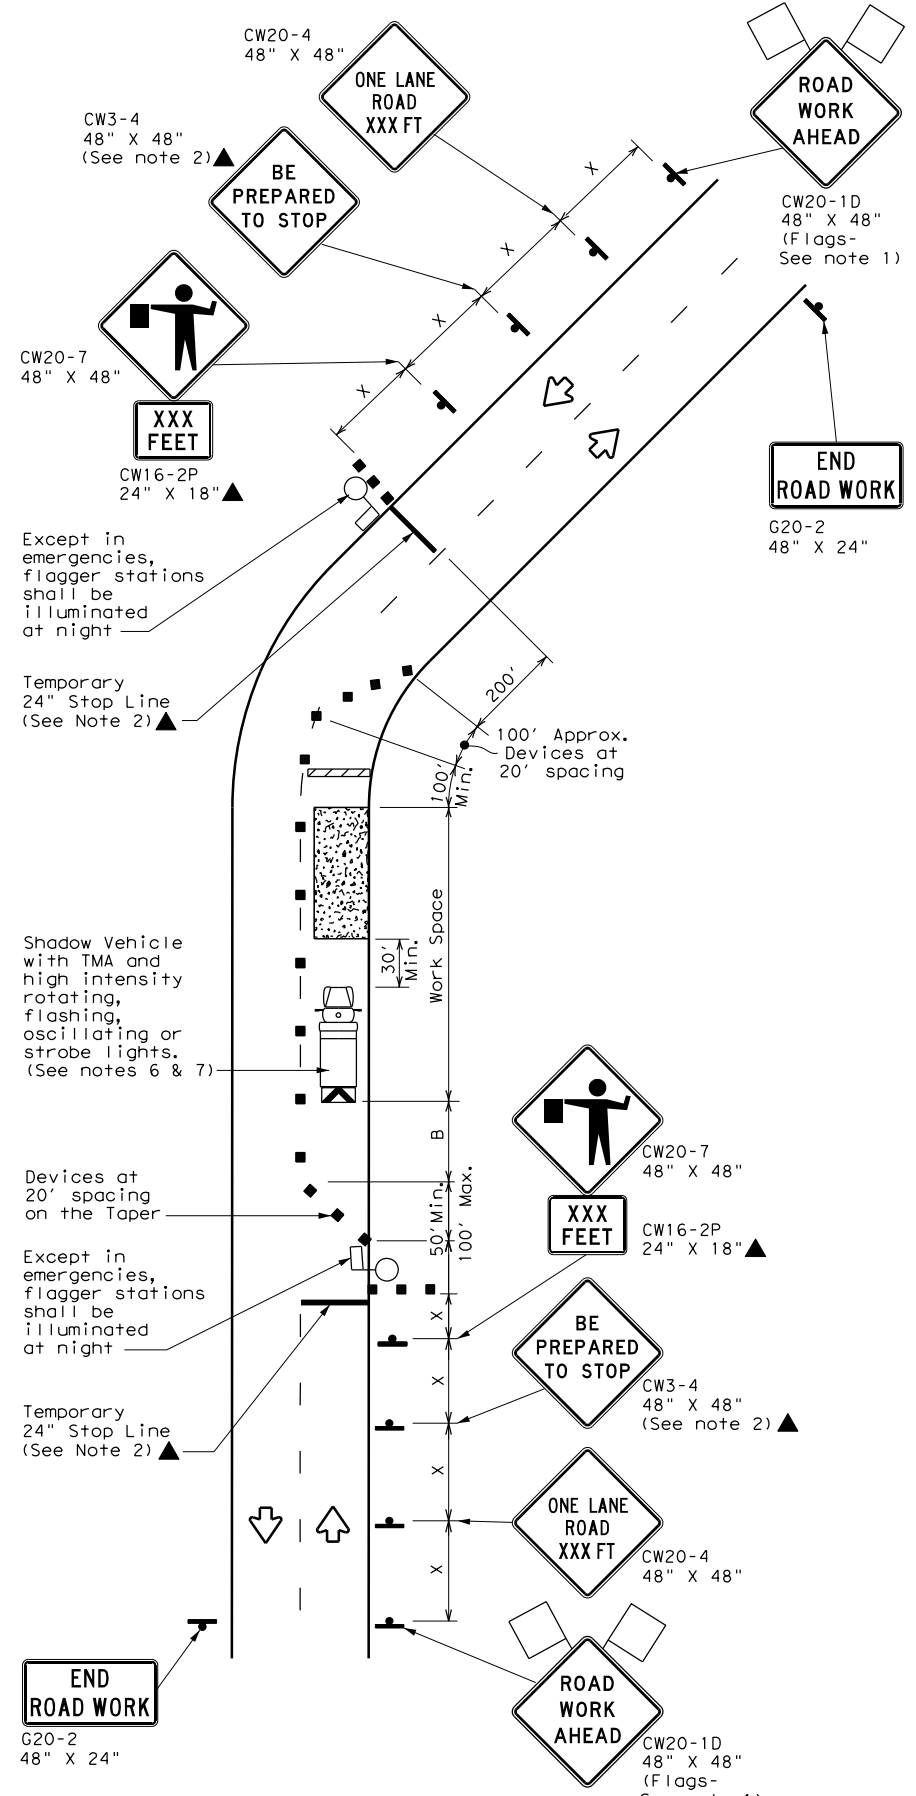

TCP (2-2b)
2-LANE ROADWAY WITHOUT PAVED SHOULDERS
ONE LANE TWO-WAY
CONTROL WITH FLAGGERS

LEGEND

	Type 3 Barricade		Channelizing Devices
	Heavy Work Vehicle		Truck Mounted Attenuator (TMA)
	Trailer Mounted Flashing Arrow Board		Portable Changeable Message Sign (PCMS)
	Sign		Traffic Flow
	Flag		Flagger

Posted Speed *	Formula	Minimum Desirable Taper Lengths **			Suggested Maximum Spacing of Channelizing Devices		Minimum Sign Spacing "x" Distance	Suggested Longitudinal Buffer Space "B"	Stopping Sight Distance
		10' Offset	11' Offset	12' Offset	On a Taper	On a Tangent			
30	L = WS ² / 60	150'	165'	180'	30'	60'	120'	90'	200'
35		205'	225'	245'	35'	70'	160'	120'	250'
40		265'	295'	320'	40'	80'	240'	155'	305'
45	L = WS	450'	495'	540'	45'	90'	320'	195'	360'
50		500'	550'	600'	50'	100'	400'	240'	425'
55		550'	605'	660'	55'	110'	500'	295'	495'
60		600'	660'	720'	60'	120'	600'	350'	575'
65		650'	715'	780'	65'	130'	700'	410'	645'
70		700'	770'	840'	70'	140'	800'	475'	730'
75		750'	825'	900'	75'	150'	900'	540'	820'

* Conventional Roads Only
 ** Taper lengths have been rounded off.
 L=Length of Taper (FT) W=Width of Offset (FT) S=Posted Speed (MPH)

TYPICAL USAGE

	MOBILE	SHORT DURATION	SHORT TERM STATIONARY	INTERMEDIATE TERM STATIONARY	LONG TERM STATIONARY
		✓	✓	✓	

GENERAL NOTES

- Flags attached to signs where shown, are REQUIRED.
 - All traffic control devices illustrated are REQUIRED, except those denoted with the triangle symbol may be omitted when stated elsewhere in the plans, or for routine maintenance work, when approved by the Engineer.
 - The CW3-4 "BE PREPARED TO STOP" sign may be installed after the CW20-4 "ONE LANE ROAD XXX FT" sign, but proper sign spacing shall be maintained.
 - Flaggers should use two-way radios or other methods of communication to control traffic.
 - Length of work space should be based on the ability of flaggers to communicate.
 - A Shadow Vehicle with a TMA should be used anytime it can be positioned 30 to 100 feet in advance of the area of crew exposure without adversely affecting the performance or quality of the work. If workers are no longer present but road or work conditions require the traffic control to remain in place, Type 3 Barricades or other channelizing devices may be substituted for the Shadow Vehicle and TMA.
 - Additional Shadow Vehicles with TMAs may be positioned off the paved surface, next to those shown in order to protect a wider work space.
- TCP (2-2a)**
- The R1-2 "YIELD" sign traffic control may be used on projects with approaches that have adequate sight distance. For projects in urban areas, work space should be no longer than one half city block. In rural areas, roadways with less than 2000 ADT, work space should be no longer than 400 feet.
 - The R1-2aP "YIELD TO ONCOMING TRAFFIC" sign shall be placed on a support at a 7 foot minimum mounting height.
- TCP (2-2b)**
- Channelizing devices on the center line may be omitted when a pilot car is leading traffic and approved by the Engineer.
 - If the work space is located near a horizontal or vertical curve, the buffer distances should be increased in order to maintain stopping sight distance to the flagger and a queue of stopped vehicles. (See table above).
 - Flaggers should use 24" STOP/SLOW paddles to control traffic. Flags should be limited to emergency situations.



**TRAFFIC CONTROL PLAN
ONE-LANE TWO-WAY
TRAFFIC CONTROL**



TCP (2-2) - 18

FILE:	tcp2-2-18.dgn	DN:	CK:	DW:	CK:
© TxDOT	December 1985	CON:	SECT:	JOB:	HIGHWAY:
REVISIONS		0904	02	047	VARIOUS
8-95	3-03	DIST:	COUNTY:	SHEET NO.:	
1-97	2-12	AMA	POTTER	024	
4-98	2-18				

DATE:
FILE:

DISCLAIMER: The use of this standard is governed by the "Texas Engineering Practice Act". No warranty of any kind is made by TxDOT for any purpose whatsoever. TxDOT assumes no responsibility for the conversion of this standard to other formats or for incorrect results or damages resulting from its use.

DATE: FILE:

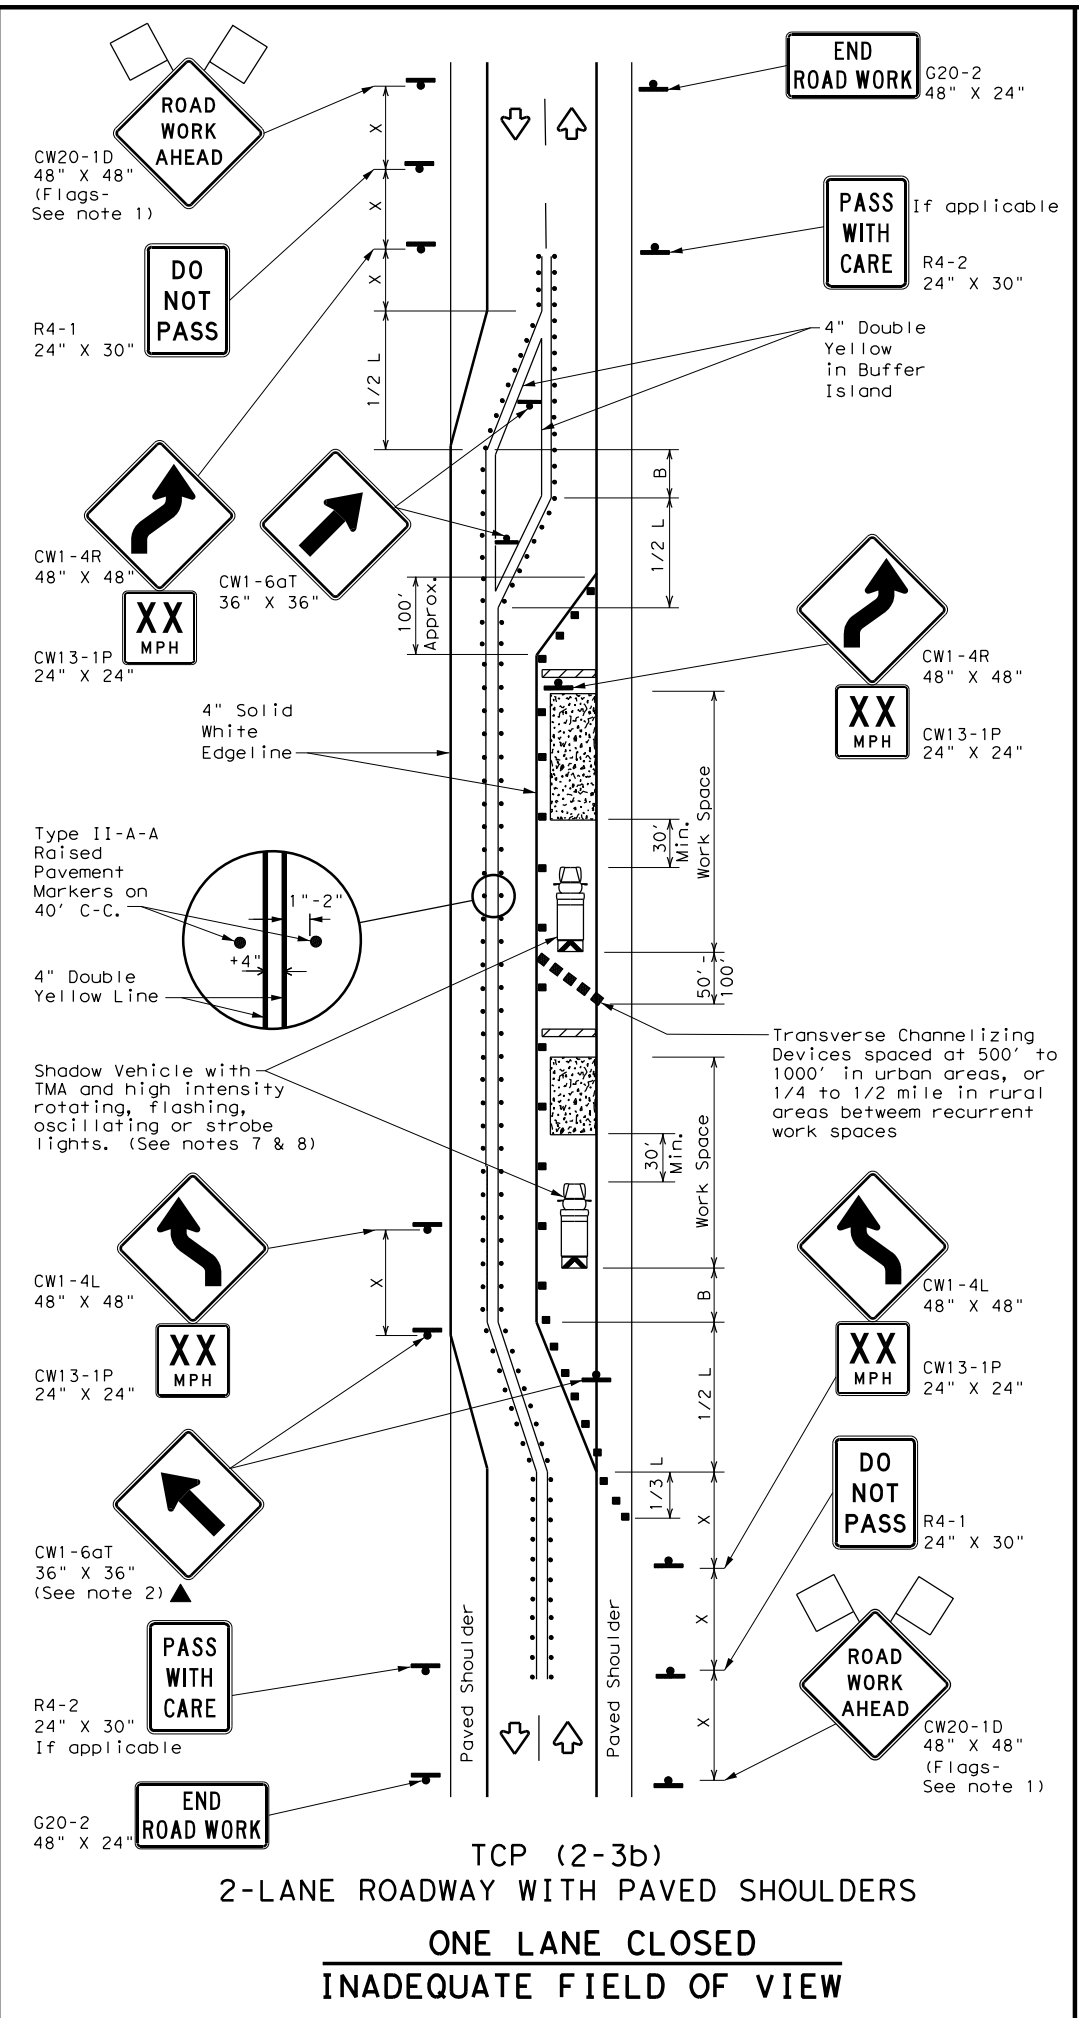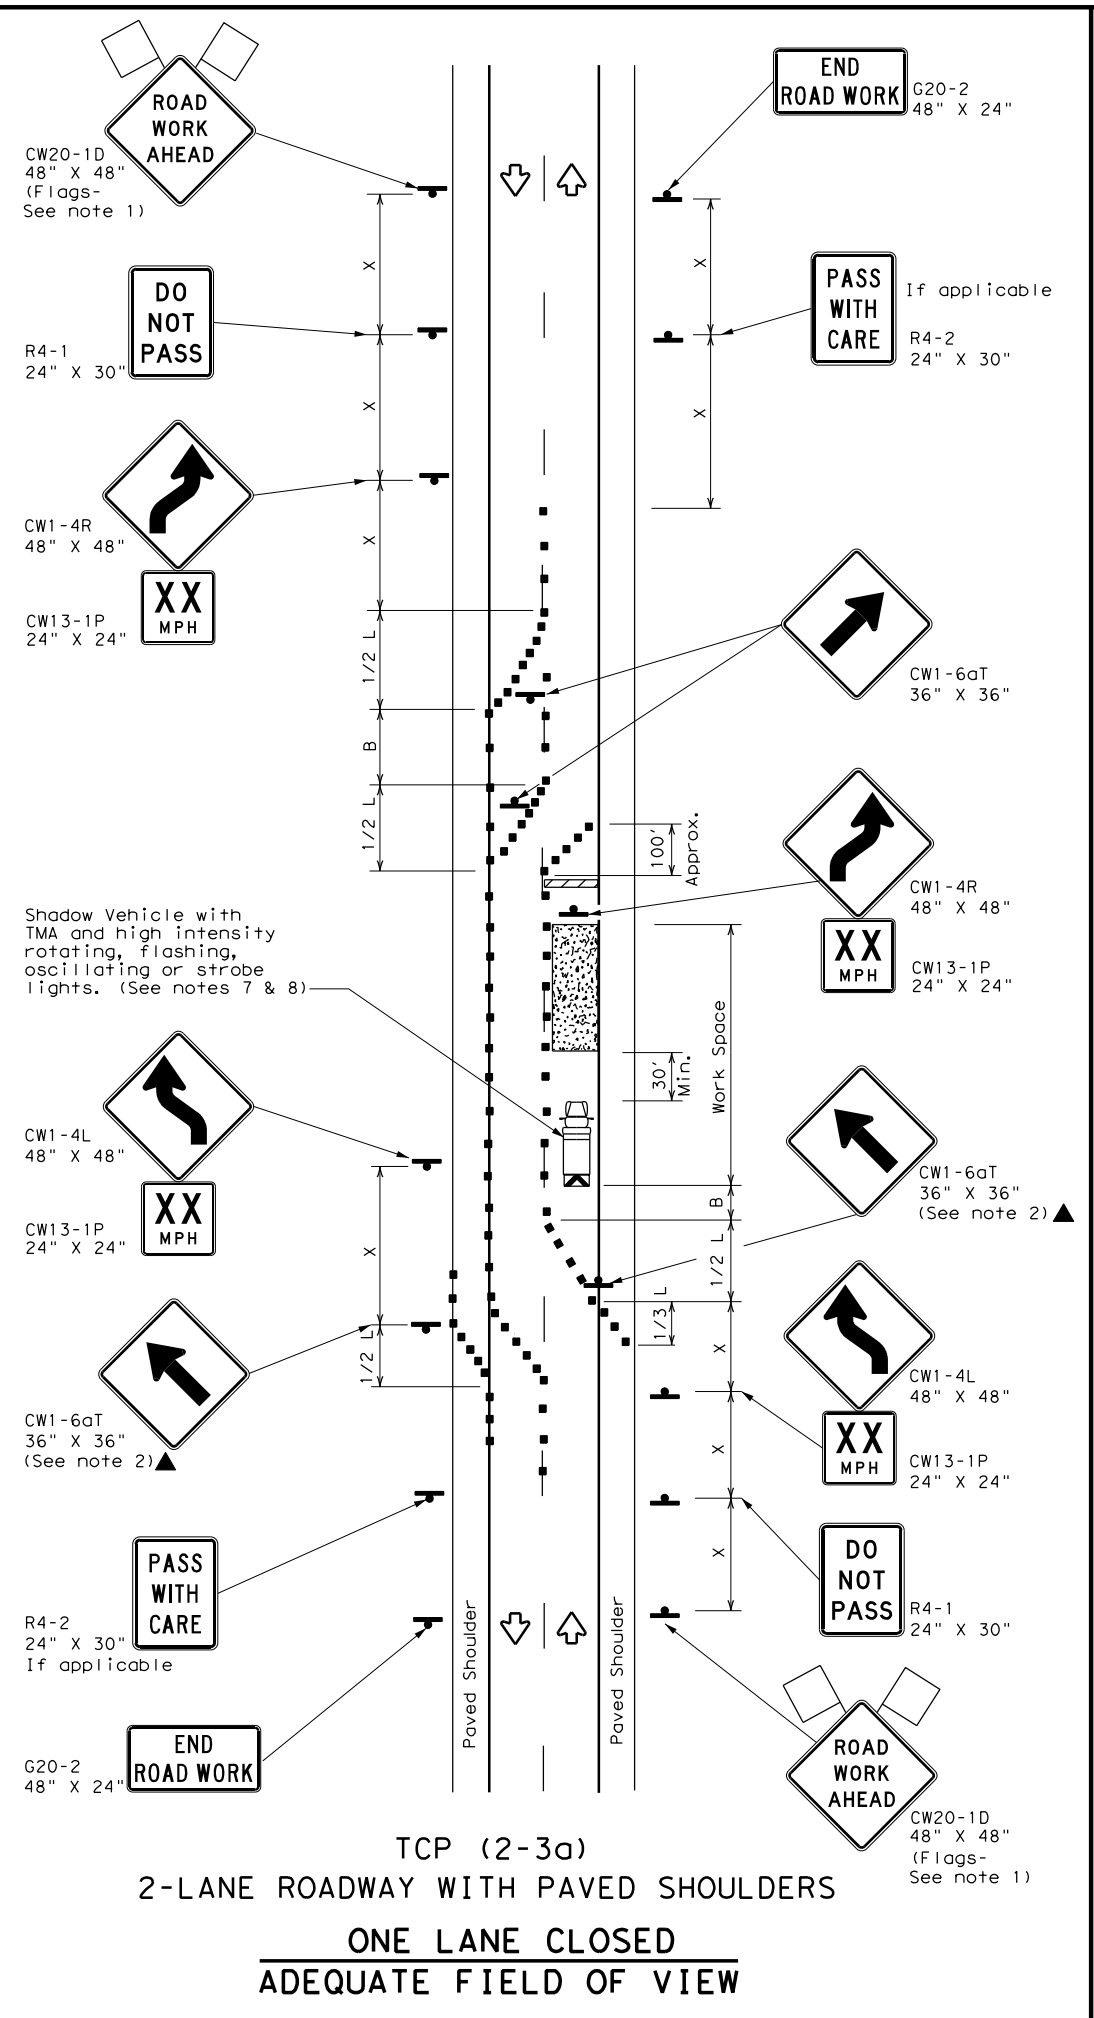

LEGEND			
	Type 3 Barricade		Channelizing Devices
	Heavy Work Vehicle		Truck Mounted Attenuator (TMA)
	Trailer Mounted Flashing Arrow Board		Raised Pavement Markers Ty II-AA
	Sign		Traffic Flow
	Flag		Flagger

Posted Speed *	Formula	Minimum Desirable Taper Lengths **			Suggested Maximum Spacing of Channelizing Devices		Minimum Sign Spacing "x" Distance	Suggested Longitudinal Buffer Space "B"
		10' Offset	11' Offset	12' Offset	On a Taper	On a Tangent		
30	$L = \frac{WS^2}{60}$	150'	165'	180'	30'	60'	120'	90'
35		205'	225'	245'	35'	70'	160'	120'
40		265'	295'	320'	40'	80'	240'	155'
45	$L = WS$	450'	495'	540'	45'	90'	320'	195'
50		500'	550'	600'	50'	100'	400'	240'
55		550'	605'	660'	55'	110'	500'	295'
60		600'	660'	720'	60'	120'	600'	350'
65		650'	715'	780'	65'	130'	700'	410'
70		700'	770'	840'	70'	140'	800'	475'
75		750'	825'	900'	75'	150'	900'	540'

* Conventional Roads Only
 ** Taper lengths have been rounded off.
 L=Length of Taper (FT) W=Width of Offset (FT) S=Posted Speed (MPH)

TYPICAL USAGE				
MOBILE	SHORT DURATION	SHORT TERM STATIONARY	INTERMEDIATE TERM STATIONARY	LONG TERM STATIONARY
			✓	✓
				TCP (2-3b) ONLY

- GENERAL NOTES**
- Flags attached to signs where shown, are REQUIRED.
 - All traffic control devices illustrated are REQUIRED, except those denoted with the triangle symbol may be omitted when stated elsewhere in the plans, or for routine maintenance work, when approved by the Engineer.
 - When work space will be in place less than three days existing pavement markings may remain in place. Channelizing devices shall be used to separate traffic.
 - Flagger control should NOT be used unless roadway conditions or heavy traffic volume require additional emphasis to safely control traffic. Flagger should be positioned at end of traffic queue.
 - The R4-1 "DO NOT PASS," R4-2 "PASS WITH CARE" and construction regulatory speed zone signs may be installed within CW20-1D "ROAD WORK AHEAD" signs. Proper spacing of signs shall be maintained.
 - Conflicting pavement marking shall be removed for long term projects.
 - A Shadow Vehicle with a TMA should be used anytime it can be positioned 30 to 100 feet in advance of the area of crew exposure without adversely affecting the performance or quality of the work. If workers are no longer present but road or work conditions require the traffic control to remain in place, Type 3 Barricades or other channelizing devices may be substituted.
 - Additional Shadow Vehicles with TMAs may be positioned off the paved surface, next to those shown in order to protect a wider work space.
- TCP (2-3a)**
- Conflicting pavement markings shall be removed for long-term projects. For shorter durations where traffic is directed over a yellow centerline, channelizing devices which separate two-way traffic should be spaced on tapers at 20' or 15' if posted speeds are 35 mph or slower, and for tangent sections, at 1/2(S) where S is the speed in mph. This tighter device spacing is intended for the area of the conflicting markings, not the entire work zone.

Traffic Operations Division Standard

TRAFFIC CONTROL PLAN
TRAFFIC SHIFTS ON
TWO-LANE ROADS


TCP (2-3) - 18

FILE:	tcp(2-3)-18.dgn	DN:	CK:	DW:	CK:
© TxDOT	December 1985	CONT	SECT	JOB	HIGHWAY
REVISIONS		0904	02	047	VARIOUS
8-95	3-03	DIST	COUNTY	SHEET NO.	
1-97	2-12	AMA	POTTER	025	
4-98	2-18				


163

DISCLAIMER: The use of this standard is governed by the "Texas Engineering Practice Act". No warranty of any kind is made by TxDOT for any purpose whatsoever. TxDOT assumes no responsibility for the conversion of this standard to other formats or for incorrect results or damages resulting from its use.

DATE: FILE:

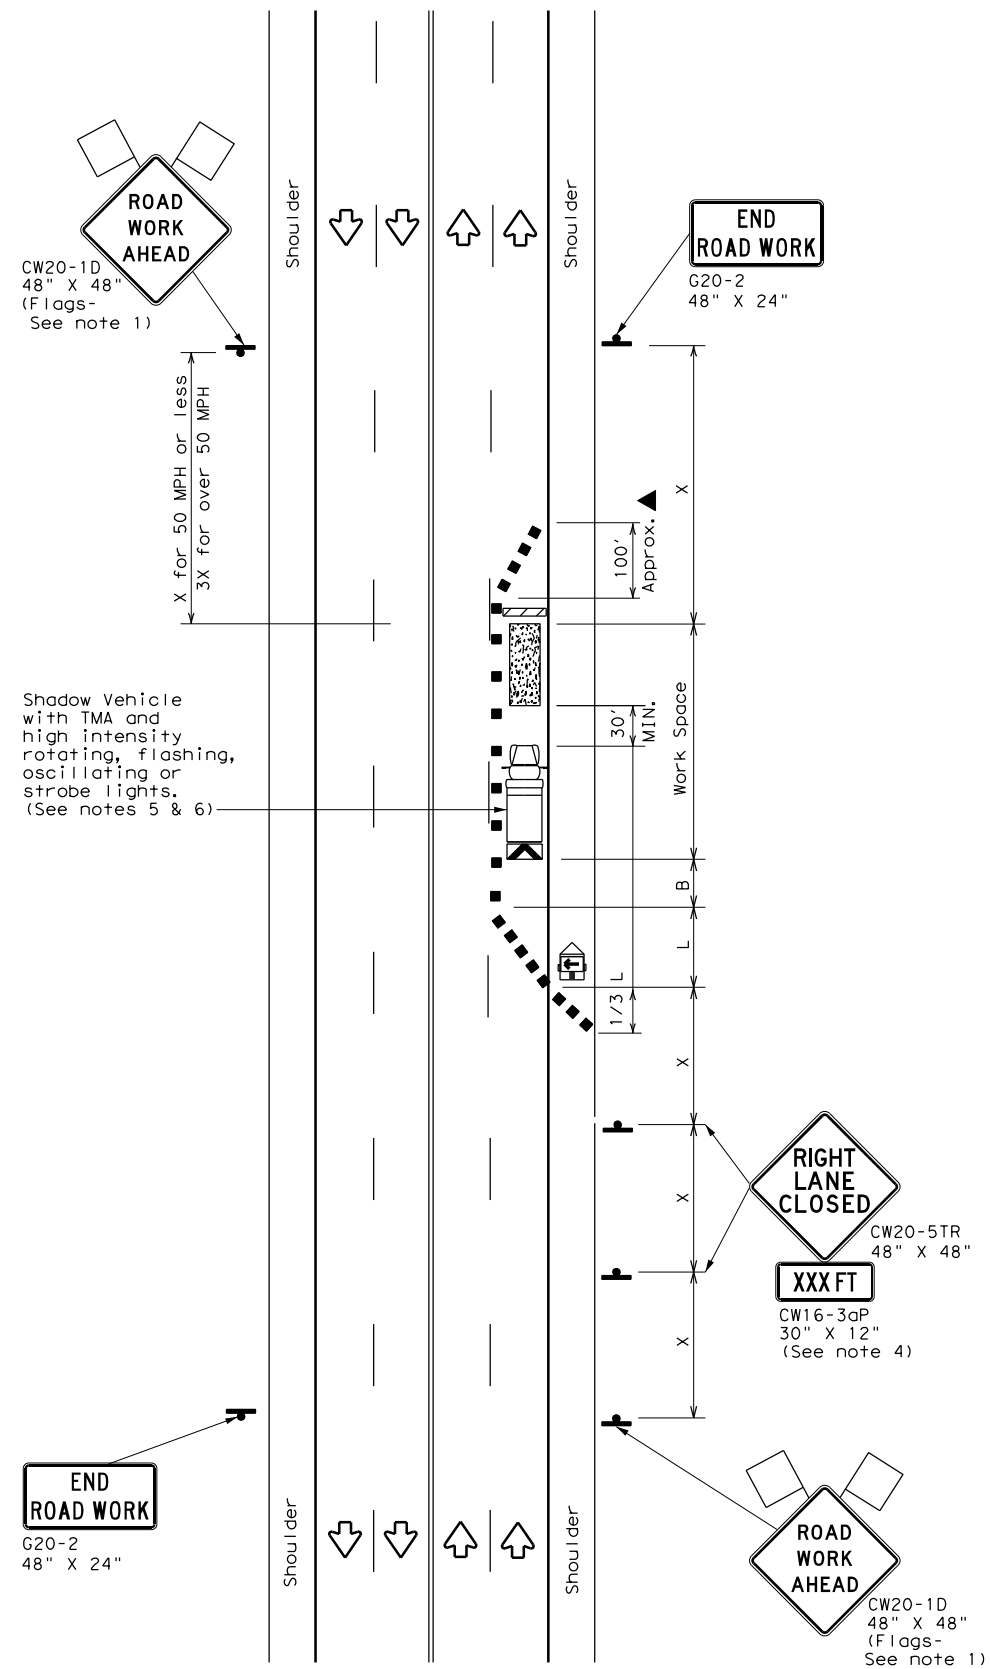

TCP (2-4a)
ONE LANE CLOSED

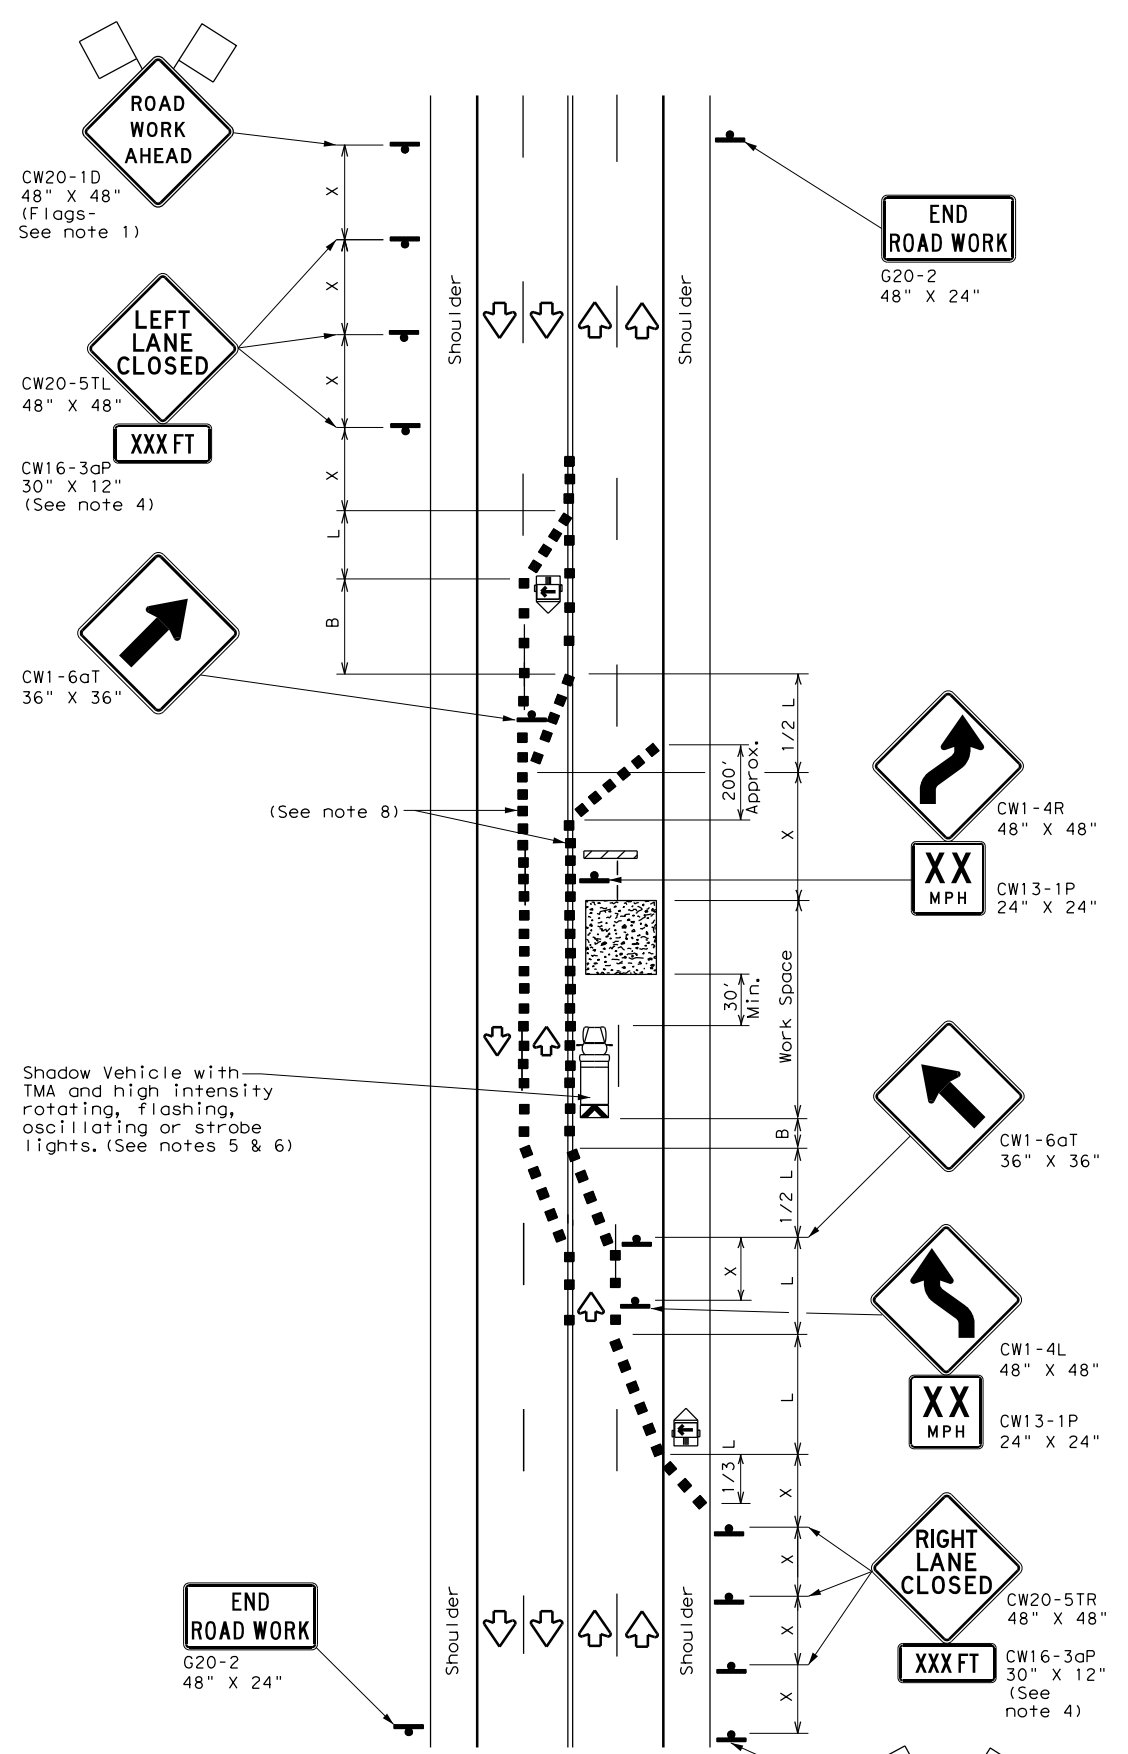

TCP (2-4b)
TWO LANES CLOSED

LEGEND			
	Type 3 Barricade		Channelizing Devices
	Heavy Work Vehicle		Truck Mounted Attenuator (TMA)
	Trailer Mounted Flashing Arrow Board		Portable Changeable Message Sign (PCMS)
	Sign		Traffic Flow
	Flag		Flagger

Posted Speed *	Formula	Minimum Desirable Taper Lengths **			Suggested Maximum Spacing of Channelizing Devices		Minimum Sign Spacing "x" Distance	Suggested Longitudinal Buffer Space "B"
		10' Offset	11' Offset	12' Offset	On a Taper	On a Tangent		
30	$L = \frac{WS^2}{60}$	150'	165'	180'	30'	60'	120'	90'
35		205'	225'	245'	35'	70'	160'	120'
40		265'	295'	320'	40'	80'	240'	155'
45	L = WS	450'	495'	540'	45'	90'	320'	195'
50		500'	550'	600'	50'	100'	400'	240'
55		550'	605'	660'	55'	110'	500'	295'
60		600'	660'	720'	60'	120'	600'	350'
65		650'	715'	780'	65'	130'	700'	410'
70		700'	770'	840'	70'	140'	800'	475'
75		750'	825'	900'	75'	150'	900'	540'

* Conventional Roads Only
 ** Taper lengths have been rounded off.
 L=Length of Taper (FT) W=Width of Offset (FT) S=Posted Speed (MPH)

TYPICAL USAGE				
MOBILE	SHORT DURATION	SHORT TERM STATIONARY	INTERMEDIATE TERM STATIONARY	LONG TERM STATIONARY
		✓	✓	

- GENERAL NOTES**
- Flags attached to signs where shown, are REQUIRED.
 - All traffic control devices illustrated are REQUIRED, except those denoted with the triangle symbol may be omitted when stated elsewhere in the plans, or for routine maintenance work, when approved by the Engineer.
 - The downstream taper is optional. When used, it should be 100 feet minimum length per lane.
 - For short term applications, when post mounted signs are not used, the distance legend may be shown on the sign face rather than on a CW16-3aP supplemental plaque.
 - A Shadow Vehicle with a TMA should be used anytime it can be positioned 30 to 100 feet in advance of the area of crew exposure without adversely affecting the performance or quality of the work. If workers are no longer present but road or work conditions require the traffic control to remain in place, Type 3 Barricades or other channelizing devices may be substituted for the Shadow Vehicle and TMA.
 - Additional Shadow Vehicles with TMAs may be positioned in each closed lane, on the shoulder or off the paved surface, next to those shown in order to protect a wider work space.
- TCP (2-4a)**
- If this TCP is used for a left lane closure, CW20-5TL "LEFT LANE CLOSED" signs shall be used and channelizing devices shall be placed on the centerline to protect the work space from opposing traffic with the arrow board placed in the closed lane near the end of the merging taper.
- TCP (2-4b)**
- For shorter durations where traffic is directed over a yellow centerline, channelizing devices which separate two-way traffic should be spaced on tapers at 20' or 15' if posted speeds are 35 mph or slower, and for tangent sections, at 1/2(S) where S is the speed in mph. This tighter devices spacing is intended for the area of conflicting markings, not the entire work zone.

Texas Department of Transportation
 Traffic Operations Division Standard

**TRAFFIC CONTROL PLAN
 LANE CLOSURES ON MULTILANE
 CONVENTIONAL ROADS**


TCP (2-4) - 18

FILE: tcp2-4-18.dgn	DN:	CK:	DW:	CK:
© TxDOT December 1985	CON:	SECT:	JOB:	HIGHWAY:
REVISIONS	0904	02	047	VARIOUS
8-95 3-03	DIST:	COUNTY:	SHEET NO.:	
1-97 2-12	AMA	POTTER	026	
4-98 2-18				


164

DISCLAIMER: The use of this standard is governed by the "Texas Engineering Practice Act". No warranty of any kind is made by TxDOT for any purpose whatsoever. TxDOT assumes no responsibility for the conversion of this standard to other formats or for incorrect results or damages resulting from its use.


DATE: FILE:

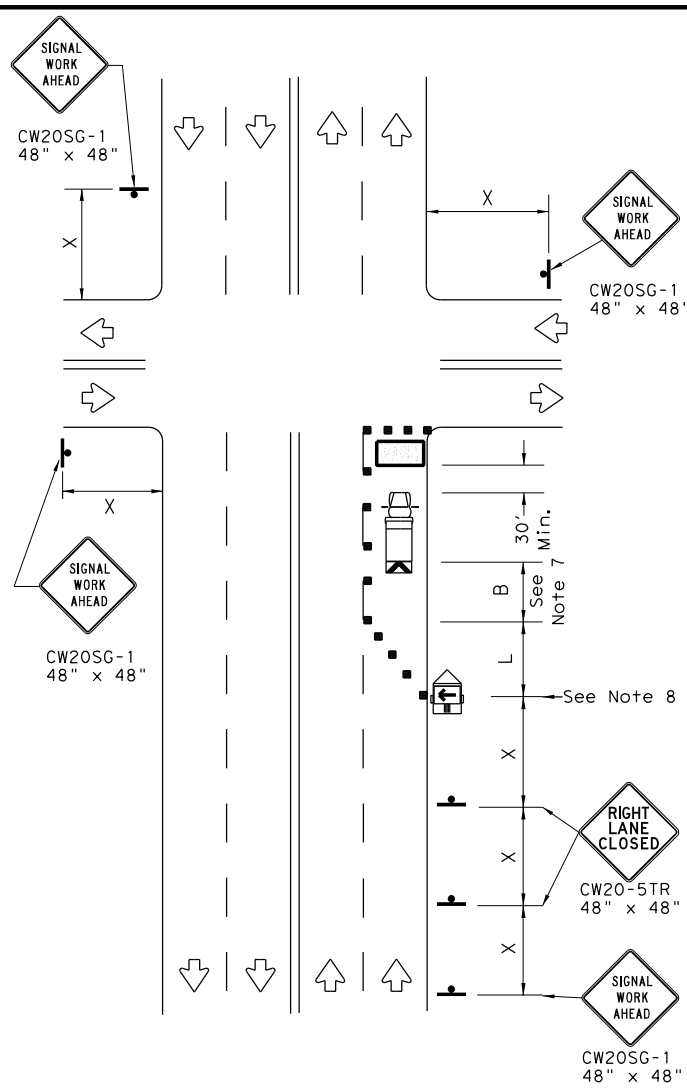

NEAR SIDE LANE CLOSURE
SHORT DURATION OR SHORT TERM STATIONARY

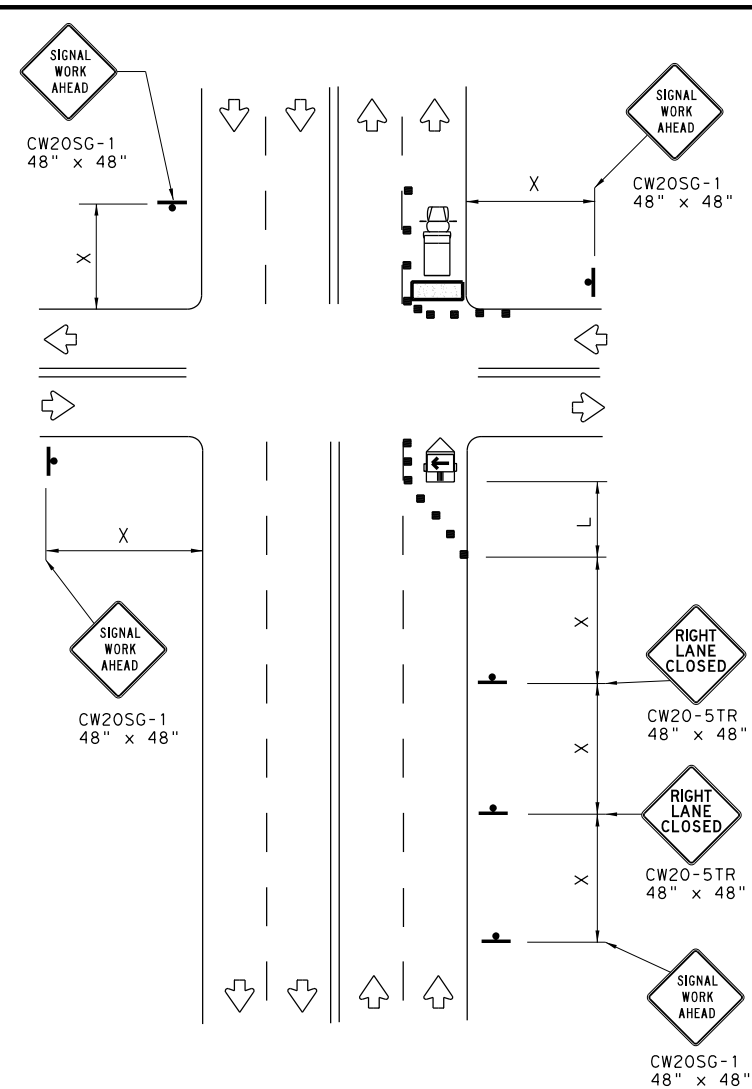

FAR SIDE RIGHT LANE CLOSURE
SHORT DURATION OR SHORT TERM STATIONARY

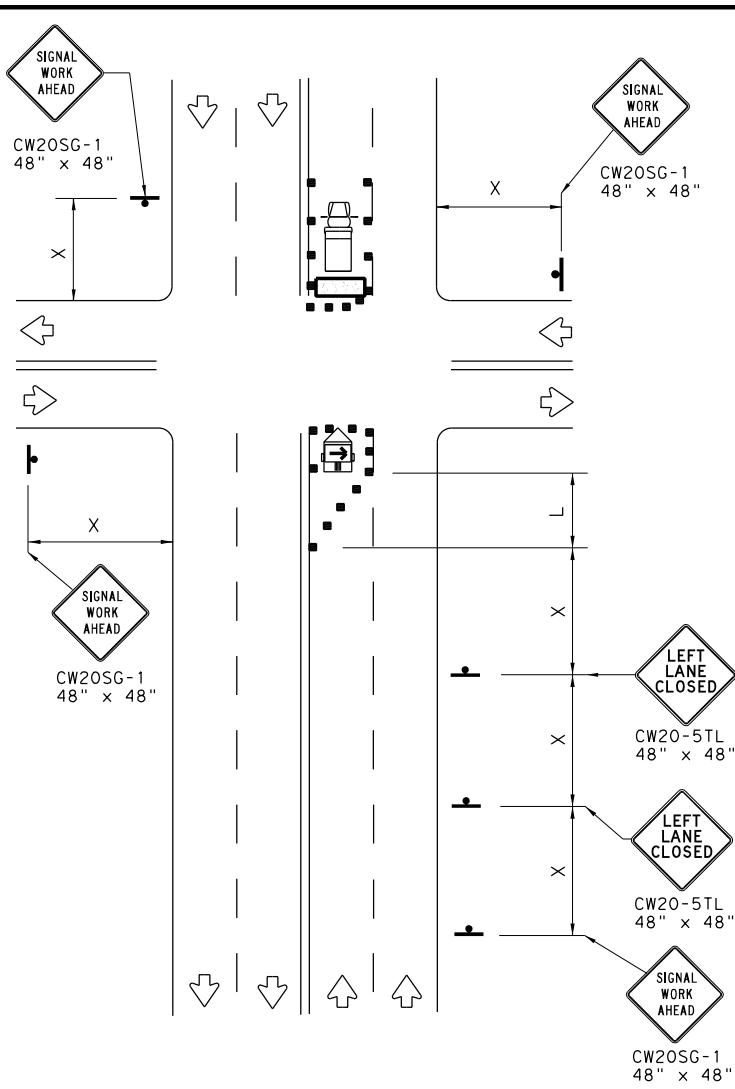


FAR SIDE LEFT LANE CLOSURE
SHORT DURATION OR SHORT TERM STATIONARY

LEGEND			
	Type 3 Barricade		Channelizing Devices
	Heavy Work Vehicle		Truck Mounted Attenuator (TMA)
	Trailer Mounted Flashing Arrow Board		Portable Changeable Message Sign (PCMS)
	Sign		Traffic Flow
	Flag		Flagger


Posted Speed *	Formula	Minimum Desirable Taper Lengths **			Suggested Maximum Spacing of Channelizing Devices		Minimum Sign Spacing "X" Distance	Suggested Longitudinal Buffer Space "B"
		10' Offset	11' Offset	12' Offset	On a Taper	On a Tangent		
30	$L = \frac{WS^2}{60}$	150'	165'	180'	30'	60'	120'	90'
35		205'	225'	245'	35'	70'	160'	120'
40		265'	295'	320'	40'	80'	240'	155'
45	L = WS	450'	495'	540'	45'	90'	320'	195'
50		500'	550'	600'	50'	100'	400'	240'
55		550'	605'	660'	55'	110'	500'	295'
60		600'	660'	720'	60'	120'	600'	350'
65		650'	715'	780'	65'	130'	700'	410'
70		700'	770'	840'	70'	140'	800'	475'
75		750'	825'	900'	75'	150'	900'	540'

* Conventional Roads Only
** Taper lengths have been rounded off.
L=Length of Taper (FT) W=Width of Offset (FT) S=Posted Speed (MPH)

WORKERS IN BUCKET TRUCKS SHALL NOT WORK ABOVE OPEN LANES OF TRAFFIC.

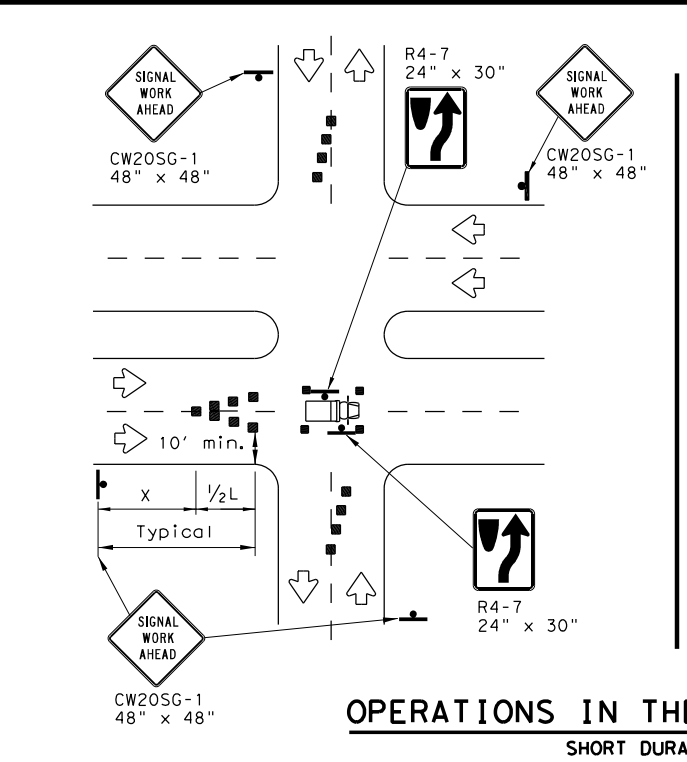

OPERATIONS IN THE INTERSECTION
SHORT DURATION

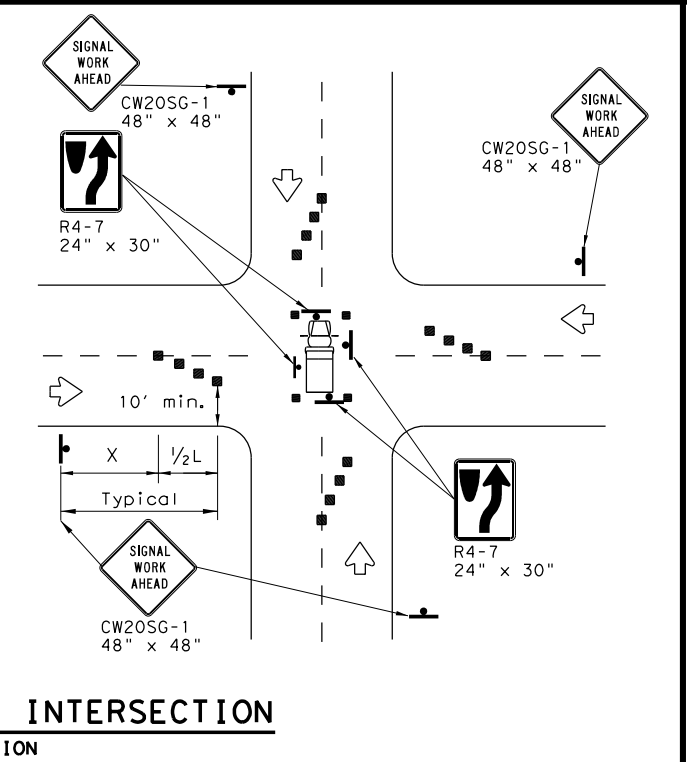

GENERAL NOTES

- The minimum size channelizing device is the 28" cone. 42" Two-piece cones, drums, vertical panels or barricades will be required when the device must be left unattended at night.
- Obstructions or hazards at the work area shall be clearly marked and delineated at all times.
- Flaggers and Flagger Symbol (CW20-7) signs may be required according to field conditions.
- Vehicles parked in roadway shall be equipped with at least two high intensity rotating, flashing, oscillating or strobe type lights.
- High level warning devices (flag trees) may be used at corners of the vehicle.
- When work operations are performed on existing signals, the signals may be placed in flashing red mode when approved by the engineer. If existing signals do not have power, All-Way Stop (R1-1 and R1-3P) signs may be implemented when approved by the engineer.
- For Short-Term Stationary work the buffer space "B" from the above table should be used if field conditions permit. For Short Duration (less than 1 hour) any buffer space provided will enhance the safety of the setup.
- The arrow board at this location may be omitted for Short Duration work if the work vehicle has an arrow board in operation. As an option, the arrow board may be placed at the end of the taper in the closed lane if space is not available at the beginning of the taper.
- Signs and devices for the NEAR SIDE LANE CLOSURE may be altered for a left lane closure by using a LEFT LANE CLOSED (CW20-5TL) and adding channelizing devices on the centerline to protect the work space from opposing traffic.




TRAFFIC SIGNAL WORK TYPICAL DETAILS

WZ(BTS-1)-13

FILE: wzbtts-13.dgn	DN: TxDOT	CK: TxDOT	DW: TxDOT	CK: TxDOT
© TxDOT April 1992	CONT	SECT	JOB	HIGHWAY
REVISIONS	0904	02	047	VARIOUS
2-98 10-99 7-13	DIST	COUNTY	SHEET NO.	
4-98 3-03	AMA	POTTER	027	

DISCLAIMER: The use of this standard is governed by the "Texas Engineering Practice Act". No warranty of any kind is made by TxDOT for any purpose whatsoever. TxDOT assumes no responsibility for the conversion of this standard to other formats or for incorrect results resulting from its use.

DATE: FILE:

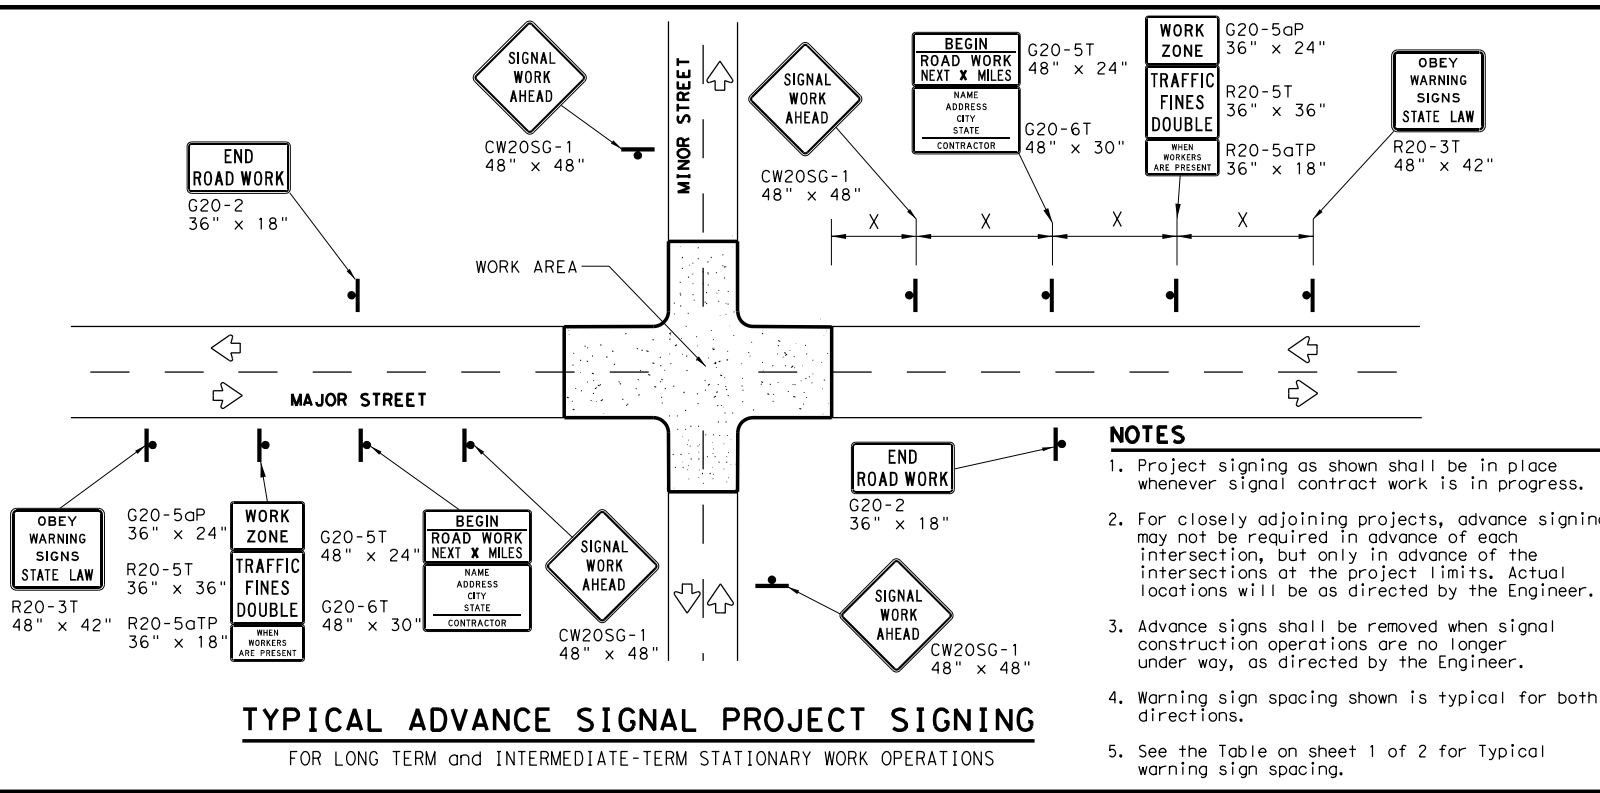

TYPICAL ADVANCE SIGNAL PROJECT SIGNING
FOR LONG TERM and INTERMEDIATE-TERM STATIONARY WORK OPERATIONS

- NOTES**
1. Project signing as shown shall be in place whenever signal contract work is in progress.
 2. For closely adjoining projects, advance signing may not be required in advance of each intersection, but only in advance of the intersections at the project limits. Actual locations will be as directed by the Engineer.
 3. Advance signs shall be removed when signal construction operations are no longer under way, as directed by the Engineer.
 4. Warning sign spacing shown is typical for both directions.
 5. See the Table on sheet 1 of 2 for Typical warning sign spacing.

GENERAL NOTES FOR WORK ZONE SIGNS

1. Signs shall be installed and maintained in a straight and plumb condition.
2. Wooden sign posts shall be painted white.
3. Barricades shall NOT be used as sign supports.
4. Nails shall NOT be used to attach signs to any support.
5. All signs shall be installed in accordance with the plans or as directed by the Engineer.
6. The Contractor shall furnish the sign design shown in the plans or in the "Standard Highway Sign Designs for Texas" (SHSD).
7. The Contractor shall furnish sign supports and substrates listed in the "Compliant Work Zone Traffic Control Device List" (CWZTCD), installed as per the manufacturer's recommendations.
8. Temporary signs that have damaged or cracked substrates and/or damaged or marred reflective sheeting shall be replaced as directed by the Engineer.
9. Identification markings may be shown only on the back of the sign substrate. The maximum height of letters and/or company logos used for identification shall be 1".
10. Damaged wood posts shall be replaced. Splicing wood posts will not be allowed.

DURATION OF WORK

1. Work zone durations are defined in Part 6, Section 66.02 of the Texas Manual on Uniform Traffic Control Devices (TMUTCD).

SIGN MOUNTING HEIGHT

1. Sign height of Long-term/Intermediate-term warning signs shall be as shown on Figure 6F-1 of the TMUTCD.
2. Sign height of Short-term/Short Duration warning signs shall be as shown on Figure 6F-2 of the TMUTCD.
3. Regulatory signs shall be mounted at least 7 feet, but not more than 9 feet, above the paved surface regardless of work duration.

REMOVING OR COVERING

1. When sign messages may be confusing or do not apply, the signs shall be removed or completely covered, unless otherwise approved by the Engineer.
2. When signs are covered, the material used shall be opaque, such as heavy mil black plastic, or other materials which will cover the entire sign face and maintain their opaque properties under automobile headlights at night without damaging the sign sheeting. Burlap, or heavy materials such as plywood or aluminum shall not be used to cover signs.
3. Duct tape or other adhesive material shall NOT be affixed to a sign face.
4. Signs and anchor stubs shall be removed and holes back filled upon completion of the work.

REFLECTIVE SHEETING

1. All signs shall be retroreflective and constructed of sheeting meeting the requirements of the DMS and color usage table shown on this sheet.

SIGN SUPPORT WEIGHTS


1. Weights used to keep signs from turning over should be sandbags filled with dry, cohesionless material.
2. The sandbags will be tied shut to keep the sand from spilling and to maintain a constant weight.
3. Rock, concrete, iron, steel or other solid objects will not be permitted for use as sign support weights.
4. Sandbags should weigh a minimum of 35 lbs and a maximum of 50 lbs.
5. Sandbags shall be made of a durable material that tears upon vehicular impact. Rubber, such as tire inner tubes, shall not be used.
6. Rubber ballasts designed for channelizing devices should not be used for ballast on portable sign supports. Sign supports designed and manufactured with rubber bases may be used when shown on the CWZTCD list.
7. Sandbags shall only be placed along or laid over the base supports of the traffic control device and shall not be suspended above ground level or hung with rope, wire, chains or other fasteners. Sandbags shall be placed along the length of the skids to weigh down the sign support.
8. Sandbags shall NOT be placed under the skid and shall not be used to level sign supports placed on slopes.

LEGEND	
	Sign
	Channelizing Devices
	Type 3 Barricade


DEPARTMENTAL MATERIAL SPECIFICATIONS	
SIGN FACE MATERIALS	DMS-8300
FLEXIBLE ROLL-UP REFLECTIVE SIGNS	DMS-8310

COLOR	USAGE	SHEETING MATERIAL
ORANGE	BACKGROUND	TYPE B _{FL} OR TYPE C _{FL} SHEETING
WHITE	BACKGROUND	TYPE A SHEETING
BLACK	LEGEND & BORDERS	ACRYLIC NON-REFLECTIVE SHEETING


Only pre-qualified products shall be used. A copy of the "Compliant Work Zone Traffic Control Devices List" (CWZTCD) describes pre-qualified products and their sources and may be found at the following web address:
http://www.txdot.gov/txdot_library/publications/construction.htm

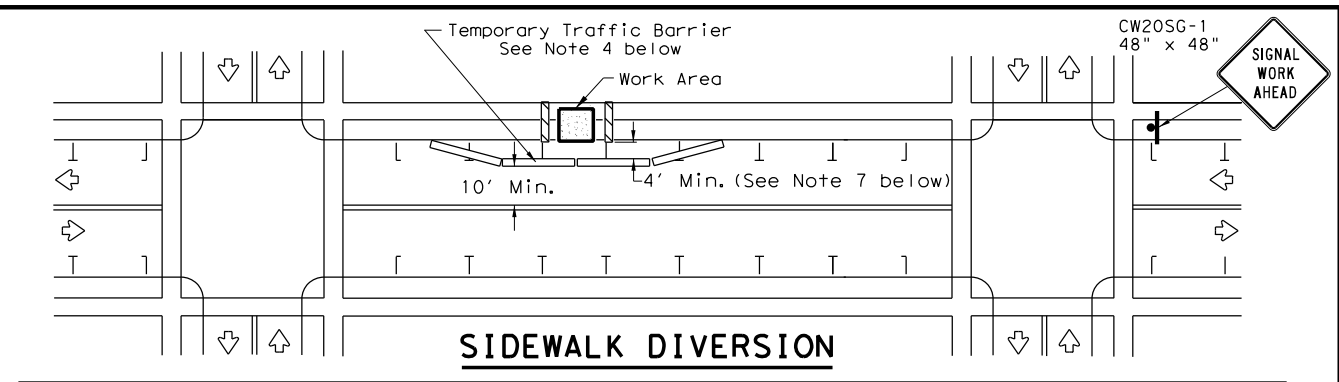

SIDEWALK DIVERSION

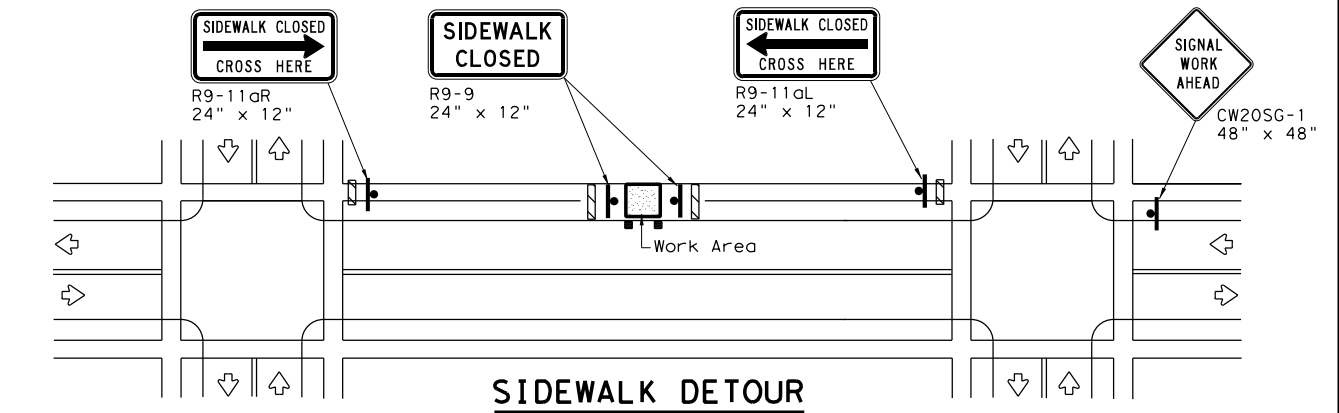

SIDEWALK DETOUR

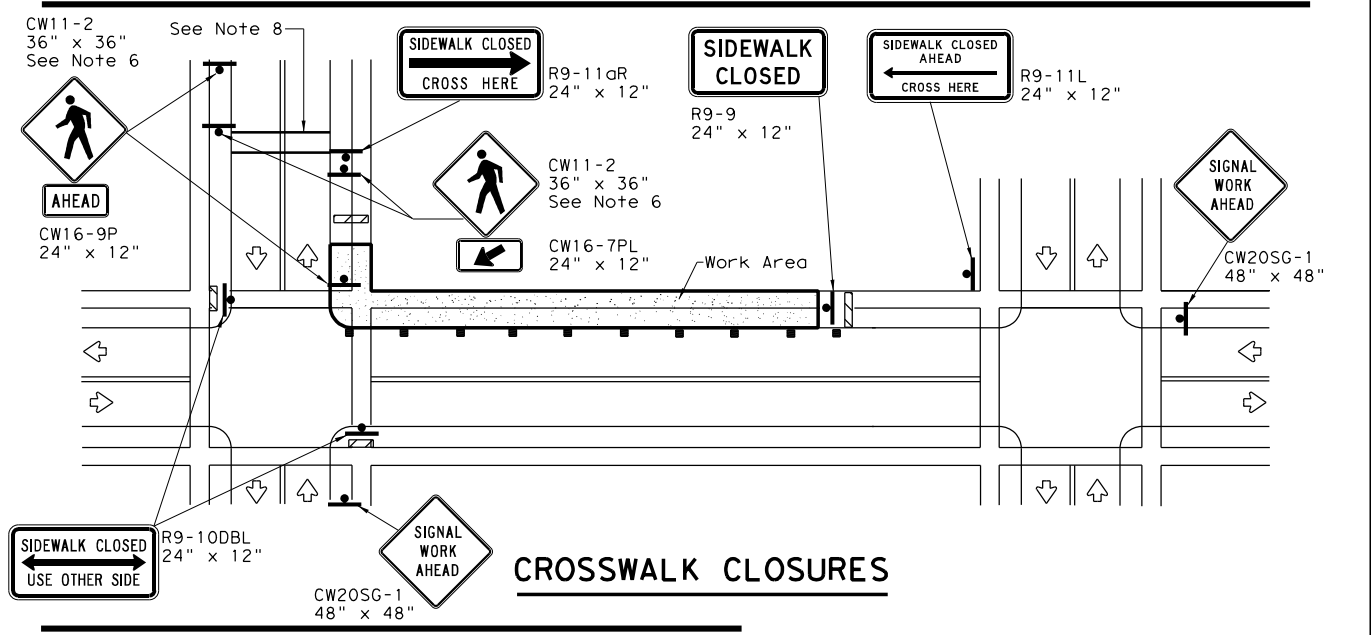

CROSSWALK CLOSURES

PEDESTRIAN CONTROL

1. Holes, trenches or other hazards shall be adequately protected by covering, delineating or surrounding the hazard with orange plastic pedestrian fencing or longitudinal channelizing devices, or as directed by the Engineer.
2. "CROSSWALK CLOSURES" as detailed above will require the Engineer's approval prior to installation.
3. R9 series signs shown may be placed on supports detailed on the BC standards or CWZTCD list, or when fabricated from approved lightweight plastic substrates, they may be mounted on top of a plastic drum at or near the location shown.
4. For speeds less than 45 mph longitudinal channelizing devices may be used instead of traffic barriers when approved by the Engineer. Attenuation of blunt ends and installation of water filled devices shall be as per BC(9) and manufacturer's recommendations.
5. Location of devices are for general guidance. Actual device spacing and location must be field adjusted to meet actual conditions.
6. Where pedestrians with visual disabilities normally use the closed sidewalk Detectable Pedestrian Barricades should be used instead of the Type 3 Barricades shown.
7. The width of existing sidewalk should be maintained if practical.
8. Pavement markings for mid-block crosswalks shall be paid for under the appropriate bid items.
9. When crosswalks or other pedestrian facilities are closed or relocated, temporary facilities shall be detectable and shall include accessibility features consistent with the features present in the existing pedestrian facility.

SHEET 2 OF 2

Texas Department of Transportation
 Traffic Operations Division Standard

TRAFFIC SIGNAL WORK BARRICADES AND SIGNS


WZ (BTS-2) - 13

FILE: wzbts-13.dgn	DN: TxDOT	CK: TxDOT	DW: TxDOT	CK: TxDOT
© TxDOT April 1992	CONT	SECT	JOB	HIGHWAY
REVISIONS	0904	02	047	VARIOUS
2-98 10-99 7-13	DIST	COUNTY	SHEET NO.	
4-98 3-03	AMA	POTTER	028	


DISCLAIMER: The use of this standard is governed by the "Texas Engineering Practice Act". No warranty of any kind is made by TxDOT for any purpose whatsoever. TxDOT assumes no responsibility for the conversion of this standard to other formats or for incorrect results or damages resulting from its use.

Warning sign and rumble strip sequence in opposite direction is same as below.

Flagger to Flagger (Length of Work Area)	ADT	# of Rumble Strip Arrays
1/8 Mile	< 4,500	1
	≥ 4,500	2
1/4 Mile	< 3,500	1
	≥ 3,500	2
1/2 Mile	< 2,600	1
	≥ 2,600	2
1 Mile	< 1,600	1
	≥ 1,600	2
> 1 Mile	N/A	2

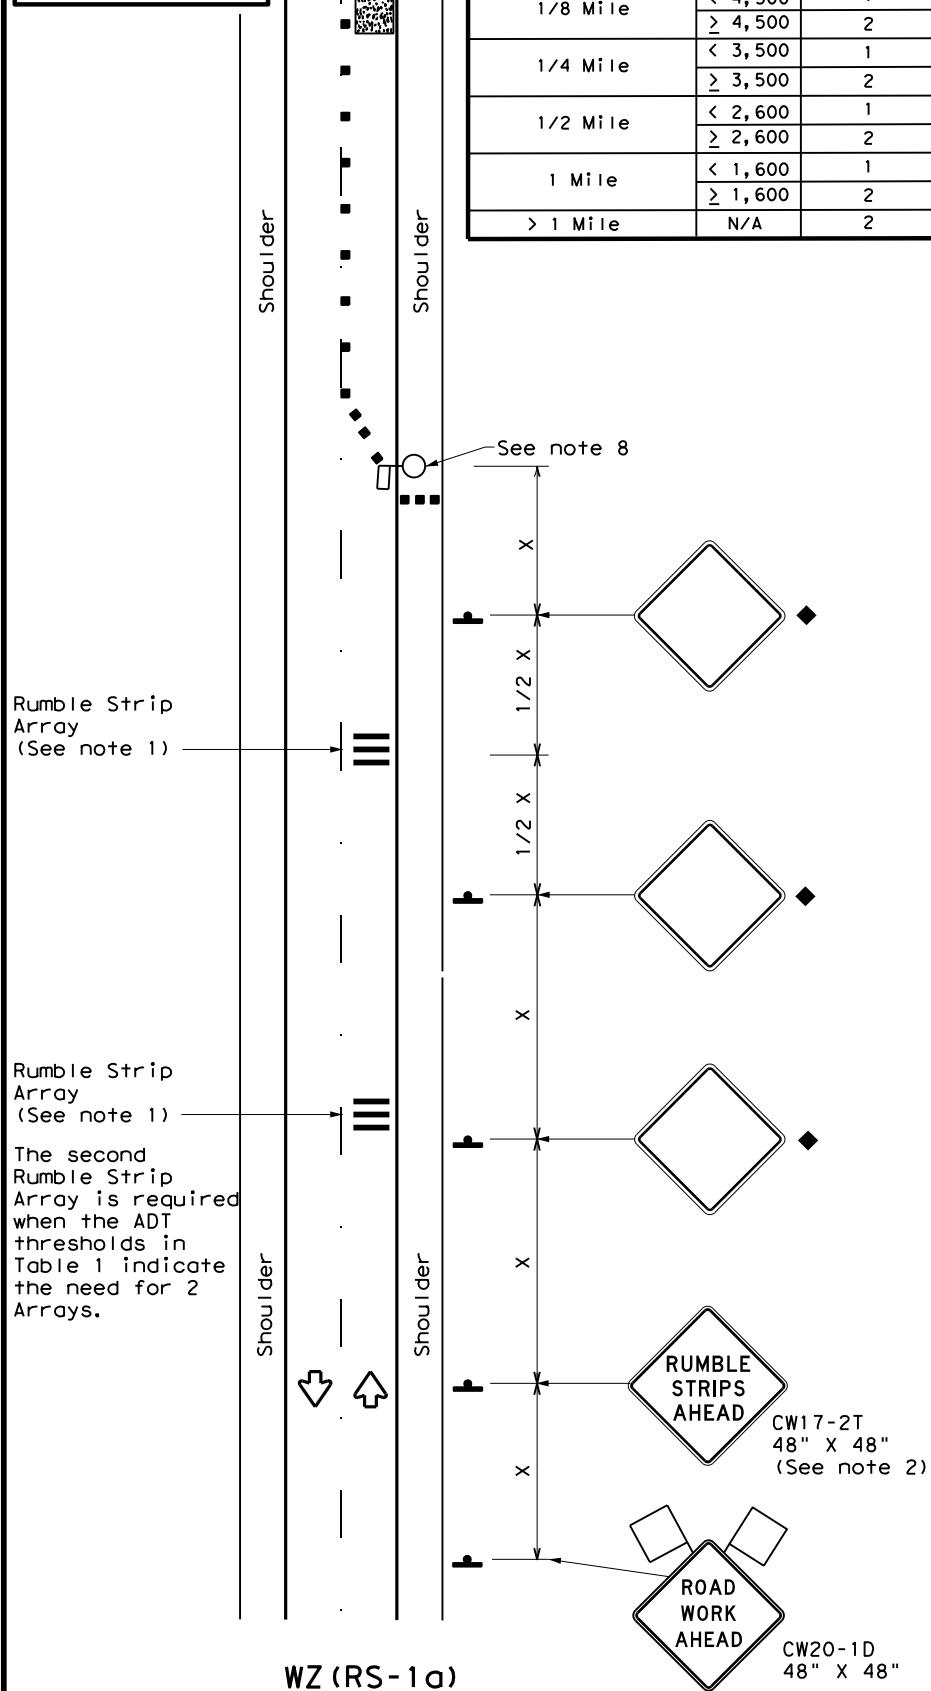

RUMBLE STRIPS ON ONE-LANE TWO-WAY APPLICATION

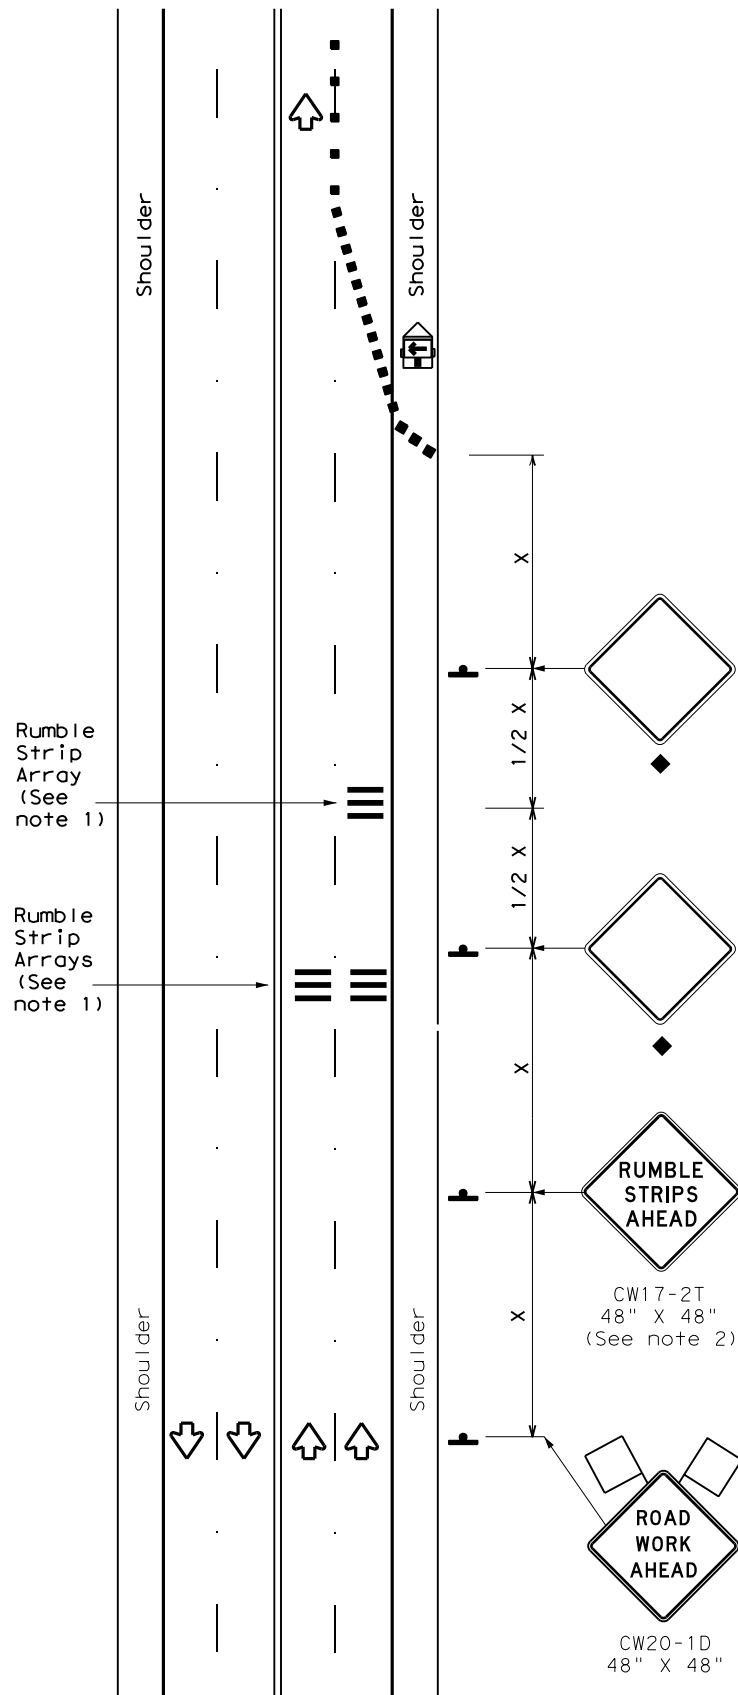

RUMBLE STRIPS FOR LANE CLOSURE ON CONVENTIONAL ROADWAY

GENERAL NOTES

- Each Rumble Strip Array should consist of three rumble strips spaced center to center at the spacing shown in Table 2, placed transverse across the lane at locations shown.
- The CW17-2T "RUMBLE STRIPS AHEAD" sign should be located after the CW20-1D "ROAD WORK AHEAD" sign and spaced as shown. If traffic is observed to be queuing, or is expected to queue beyond the Rumble Strips, the CW17-2T sign and the first Rumble Strip Array may be located upstream of the CW20-1D sign as necessary to provide needed warning.
- Temporary Rumble Strips will be considered subsidiary to Item 502, and shall be a product listed on the Compliant Work Zone Traffic Control Devices.
- Remove Temporary Rumble Strips before removing the advanced warning signs.
- Temporary Rumble Strips should not be used on horizontal curves, loose gravel, soft or bleeding asphalt, heavily rutted pavements or unpaved surfaces.
- Temporary Rumble Strips shall be installed and maintained as per manufacturer's recommendations.
- This standard sheet shall be used in conjunction with other appropriate TCP standard, TMUTCD typical application or project specific detail for the project.
- The one-lane two-way application may utilize a flagger, an Automated Flagger Assistance Device (AFAD) or a Portable Traffic Signal (PTS).
- Replace defective Temporary Rumble Strips as directed by the Engineer.
- Temporary Rumble Strips may be used on freeways or expressways based on engineering judgment and written direction from the Engineer.

Speed	Approximate distance between strips in an array
≤ 40 MPH	10'
> 40 MPH & ≤ 55 MPH	15'
= 60 MPH	20'
≥ 65 MPH	* 35' +

	Type 3 Barricade		Channelizing Devices
	Heavy Work Vehicle		Truck Mounted Attenuator (TMA)
	Trailer Mounted Flashing Arrow Panel		Portable Changeable Message Sign (PCMS)
	Sign		Traffic Flow
	Flag		Flagger

Posted Speed *	Formula	Minimum Desirable Taper Lengths **			Suggested Maximum Spacing of Channelizing Devices		Minimum Sign Spacing "x" Distance	Suggested Longitudinal Buffer Space "B"
		10' Offset	11' Offset	12' Offset	On a Taper	On a Tangent		
30	L = WS ² / 60	150'	165'	180'	30'	60'	120'	90'
35		205'	225'	245'	35'	70'	160'	120'
40		265'	295'	320'	40'	80'	240'	155'
45	L = WS	450'	495'	540'	45'	90'	320'	195'
50		500'	550'	600'	50'	100'	400'	240'
55		550'	605'	660'	55'	110'	500'	295'
60		600'	660'	720'	60'	120'	600'	350'
65		650'	715'	780'	65'	130'	700'	410'
70		700'	770'	840'	70'	140'	800'	475'
75		750'	825'	900'	75'	150'	900'	540'

* Conventional Roads Only
 ** Taper lengths have been rounded off.
 L=Length of Taper (FT) W=Width of Offset (FT)
 S=Posted Speed (MPH)

MOBILE	SHORT DURATION	SHORT TERM STATIONARY	INTERMEDIATE TERM STATIONARY	LONG TERM STATIONARY
	✓	✓		

◆ Signs are for illustrative purposes only. Signs required may vary depending on the TCP, TMUTCD Typical Application, or project specific details for the project.
 * For posted speeds in excess of 65 MPH, it is recommended that spacing is increased as speed limits increase. Increasing space between rumble strips will improve effectiveness.



Texas Department of Transportation Traffic Safety Division Standard

TEMPORARY RUMBLE STRIPS

WZ (RS) - 22

FILE: wzrs22.dgn	DN: TxDOT	CK: TxDOT	DW: TxDOT	CK: TxDOT
© TxDOT November 2012	CONT	SECT	JOB	HIGHWAY
REVISIONS	0904	02	047	VARIOUS
2-14 1-22	DIST	COUNTY	SHEET NO.	
4-16	AMA	POTTER	28A	

DATE: FILE:

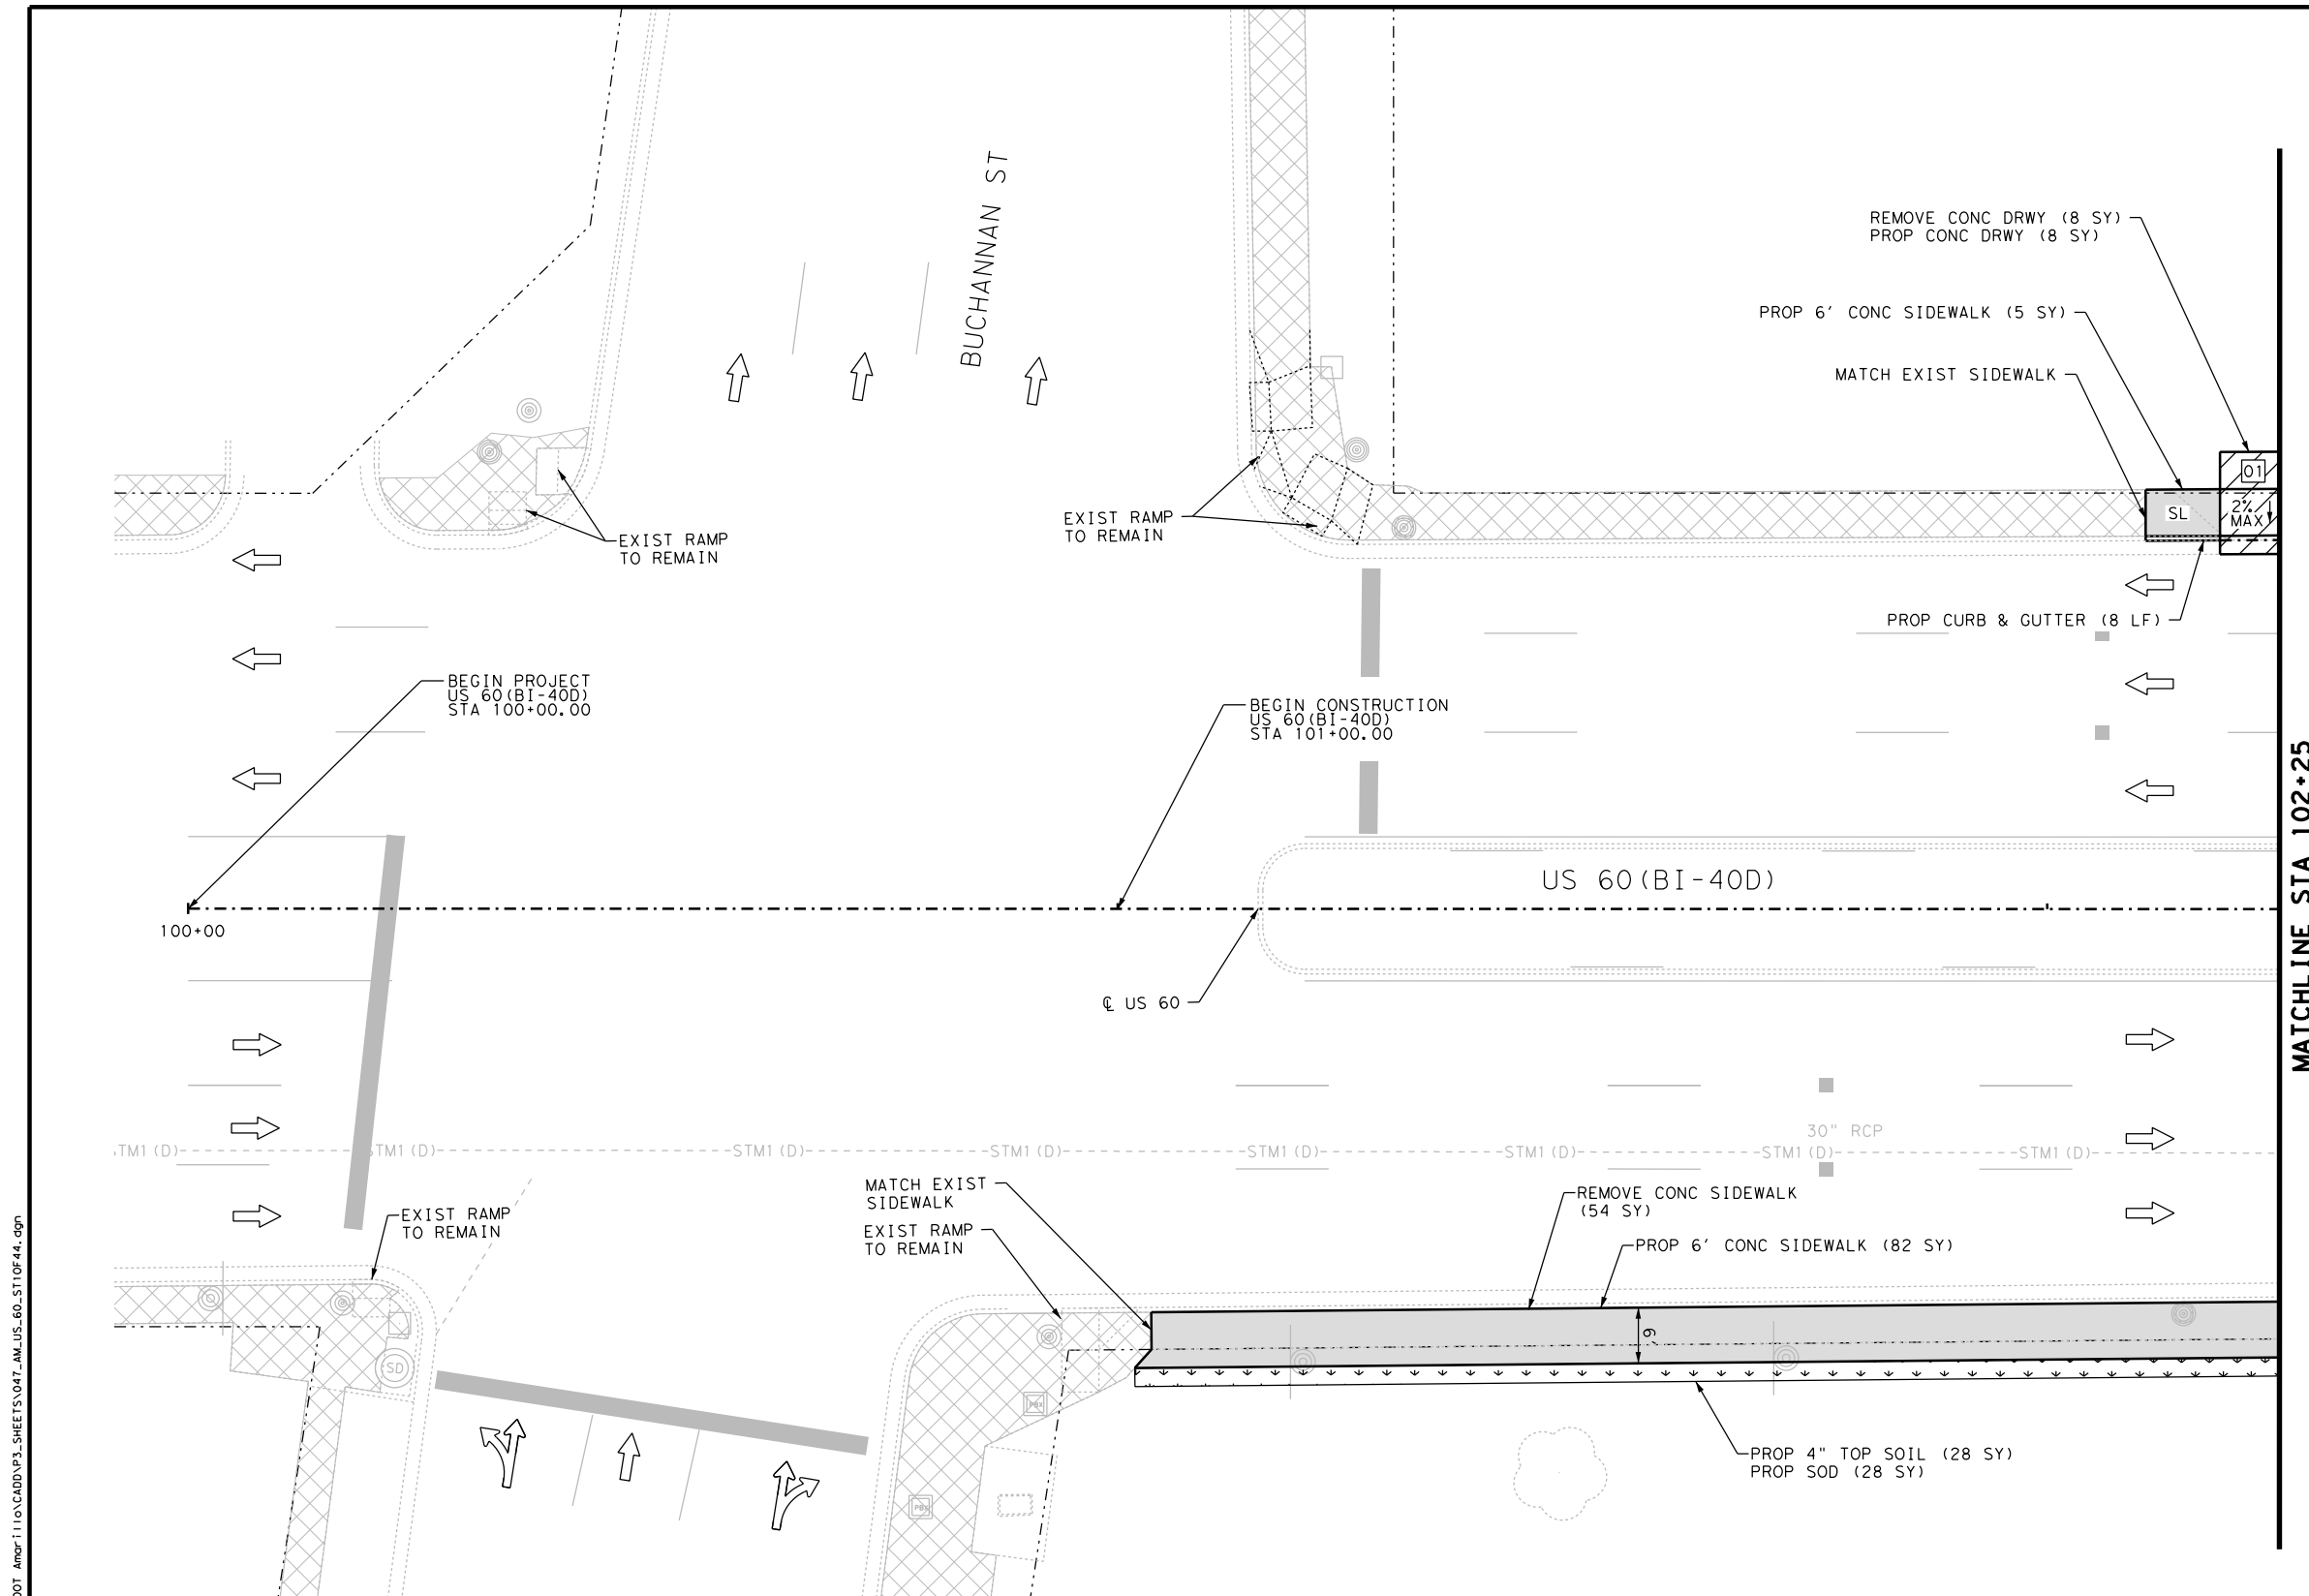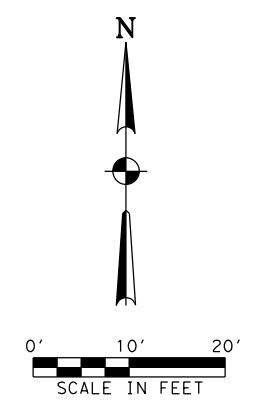


NOTES:
 * FOR CONTRACTOR INFORMATION ONLY
 1. THE EXISTENCE AND LOCATION OF ALL UTILITIES AND DRAINAGE STRUCTURES INDICATED IN THE PLANS ARE TAKEN FROM THE BEST RECORDS AVAILABLE AND ARE NOT GUARANTEED TO BE ACCURATE. CONTRACTOR SHALL COORDINATE WITH ALL UTILITY COMPANIES TO FIELD VERIFY UTILITIES PRIOR TO BEGINNING CONSTRUCTION.

NO.	DATE	REVISION	BY



GLOBAL CIVIL SOLUTIONS, LLC
 11551 FOREST CENTRAL DRIVE
 SUITE 220
 DALLAS, TX 75243
 F-12801

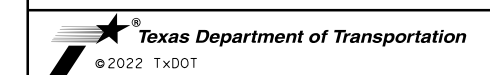

P:\Jobs\2020007-Pedestrian\110-CA00\PS3-SHEETS\047_AM_US_60_ST10F44.dgn

LEGEND	
	PROP SODDING
	PROP CONC DRWY
	PROP CONC RIPRAP
	PROP RETAINING WALL
	PROP CONC SIDEWALK
	EXISTING SIDEWALK/DRWY TO REMAIN
R	RAMP
L	LANDING PAD
F	FLARE
SL	LONG. SLOPE MAY NOT EXCEED 5% OR ADJACENT ROAD SLOPE
T	TRANSITION
LS	LEVEL SIDEWALK (2% MAX)
	TRAFFIC FLOW
	EXISTING SIGN
	PROPOSED SIGN
	MANHOLE
	POWER POLE
	TRAFFIC SIGNAL POLE
	LIGHT POLE
	WATER METER
	FIRE HYDRANT
	GUY WIRE
	TREE/SHRUB
	FENCE
	WATER VALVE
	TRAFFIC SIGNAL BOX
	IRRIGATION CONTROL VALVE
	ELECTRICAL PULL BOX
	DRIVEWAY ID
	PEDESTRIAN SIGNAL
	GAS METER
	SPRINKLER HEAD
	UTILITY MARKER POST
	OVERHEAD ELECTRIC LINE

ITEM	DESCRIPTION	UNIT	QTY
0104 6015	REMOVING CONC (SIDEWALKS)	SY	54
0104 6017	REMOVING CONC (DRIVEWAYS)	SY	88
0160 6003	FURNISHING AND PLACING TOP SOIL (4")	SY	28
0162 6002	BLOCK SODDING	SY	28
0168 6001	VEGETATIVE WATERING	MG	1.1
0529 6008	CONC CURB & GUTTER (TY II)	LF	8
0530 6004	DRIVEWAYS (CONC)	SY	8
0531 6001	CONC SIDEWALK (4")	SY	87



**US 60 (BI 40-D)
 SIDEWALK PLAN**

BEGIN PROJECT TO STA 102+25

SHEET 1 OF 44

DESIGN	FED. RD. DIV. NO.	FEDERAL AID PROJECT NO.	HIGHWAY NO.
MI	6	(SEE TITLE SHEET)	VARIOUS
GRAPHICS	STATE	DISTRICT	COUNTY
PS	TEXAS	AMA	POTTER
CHECK	CONTROL	SECTION	JOB
MFM			
CHECK	NO.	NO.	NO.
FS	0904	02	047

SHEET NO. 029

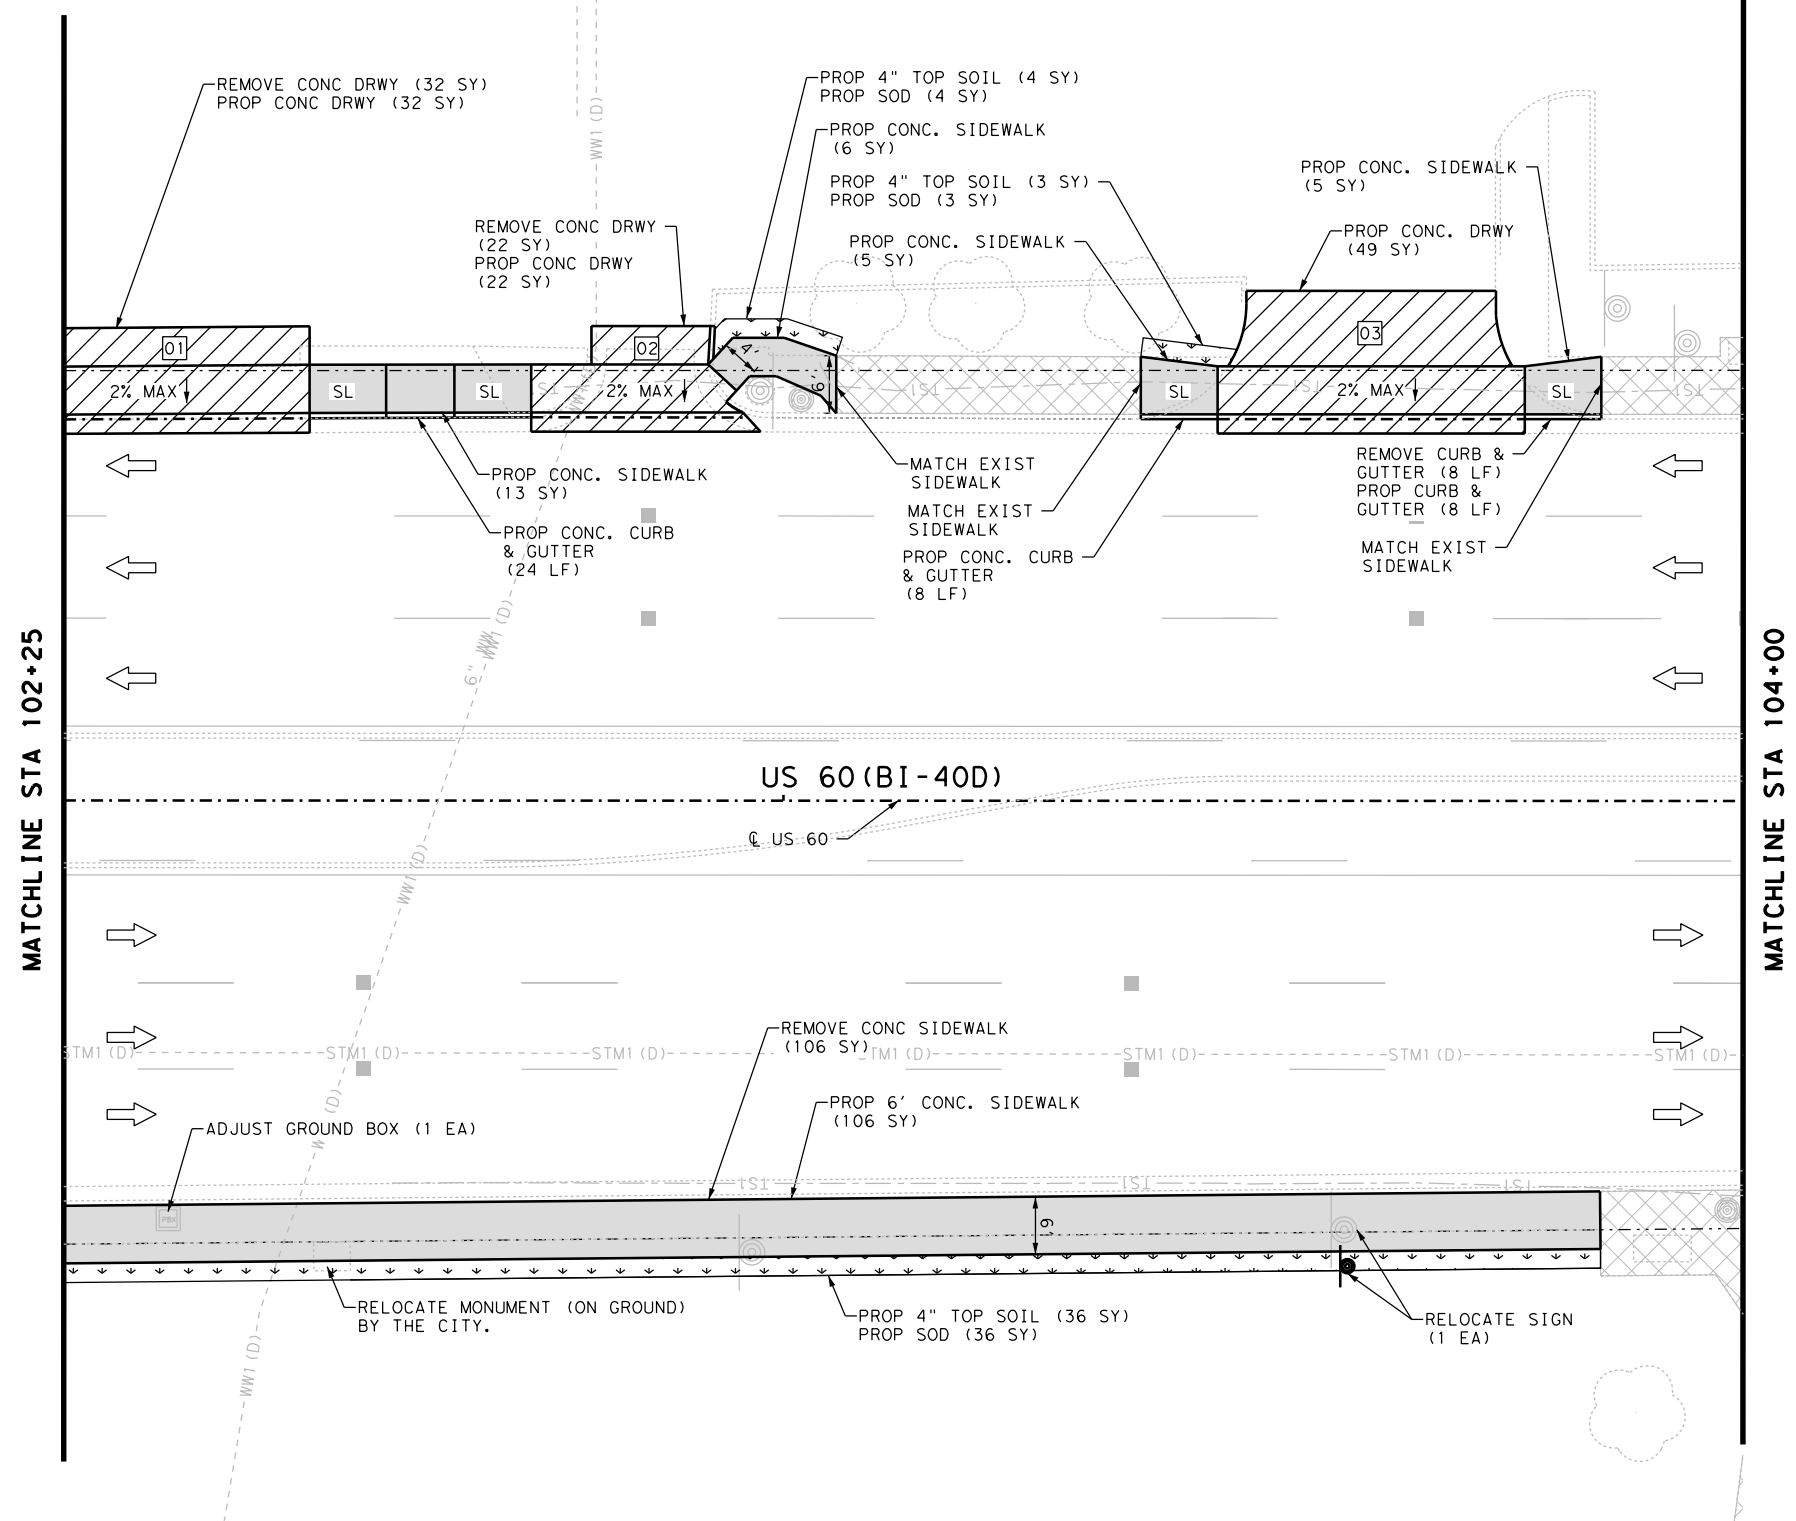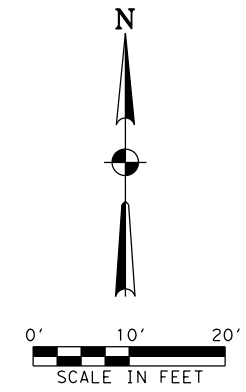

NOTES:

- * FOR CONTRACTOR INFORMATION ONLY
- 1. THE EXISTENCE AND LOCATION OF ALL UTILITIES AND DRAINAGE STRUCTURES INDICATED IN THE PLANS ARE TAKEN FROM THE BEST RECORDS AVAILABLE AND ARE NOT GUARANTEED TO BE ACCURATE. CONTRACTOR SHALL COORDINATE WITH ALL UTILITY COMPANIES TO FIELD VERIFY UTILITIES PRIOR TO BEGINNING CONSTRUCTION.

NO.	DATE	REVISION	BY



GLOBAL CIVIL SOLUTIONS, LLC
 11551 FOREST CENTRAL DRIVE
 SUITE 220
 DALLAS, TX 75243
 F-12801



**US 60 (BI 40-D)
 SIDEWALK PLAN**

STA 102+25 TO STA 104+00



SHEET 2 OF 44

DESIGN MI	FED. RD. DIV. NO. 6	FEDERAL AID PROJECT NO. (SEE TITLE SHEET)	HIGHWAY NO. VARIOUS
GRAPHICS PS	STATE TEXAS	DISTRICT AMA	COUNTY POTTER
CHECK MF	CONTROL 0904	SECTION 02	JOB 047
CHECK FS			030

P:\Jobs\2020007-Pedestrian\110-CA00-V3-SHEETS\047_AM_US_60_ST20F44.dgn
 5:17:51 PM
 1/27/2022


LEGEND			
	PROP SODDING	R	RAMP
	PROP CONC DRWY	L	LANDING PAD
	PROP CONC RIPRAP	F	FLARE
	PROP RETAINING WALL	SL	LONG. SLOPE MAY NOT EXCEED 5% OR ADJACENT ROAD SLOPE
	PROP CONC SIDEWALK	T	TRANSITION
	EXISTING SIDEWALK/DRWY TO REMAIN	LS	LEVEL SIDEWALK (2% MAX)
	PROP SODDING	↑	TRAFFIC FLOW
	PROP CONC DRWY	⊙	EXISTING SIGN
	PROP CONC RIPRAP	⊙	PROPOSED SIGN
	PROP RETAINING WALL	⊙	MANHOLE
	PROP CONC SIDEWALK	⊙	
	EXISTING SIDEWALK/DRWY TO REMAIN	⊙	
	POWER POLE	⊙	TRAFFIC SIGNAL POLE
	TRAFFIC SIGNAL POLE	⊙	LIGHT POLE
	WATER METER	⊙	FIRE HYDRANT
	GUY WIRE	⊙	TREE/SHRUB
	FENCE	⊙	WATER VALVE
	TRAFFIC SIGNAL BOX	⊙	
	IRRIGATION CONTROL VALVE	⊙	
	ELECTRICAL PULL BOX	⊙	
	DRIVEWAY ID	⊙	
	PEDESTRIAN SIGNAL	⊙	
	GAS METER	⊙	
	SPRINKLER HEAD	⊙	
	UTILITY MARKER POST	⊙	
	OVERHEAD ELECTRIC LINE	⊙	

ITEM	DESCRIPTION	UNIT	QTY
0104 6015	REMOVING CONC (SIDEWALKS)	SY	106
0104 6017	REMOVING CONC (DRIVEWAYS)	SY	54
0104 6029	REMOVING CONC (CURB OR CURB & GUTTER)	LF	8
0160 6003	FURNISHING AND PLACING TOP SOIL (4")	SY	43
0162 6002	BLOCK SODDING	SY	43
0168 6001	VEGETATIVE WATERING	MG	1.6
0529 6008	CONC CURB & GUTTER (TY II)	LF	40
0530 6004	DRIVEWAYS (CONC)	SY	103
0531 6001	CONC SIDEWALK (4")	SY	135
0644 6068	RELOCATE SM RD SN SUP&AM TY 10BWG	EA	1
6027 6009	GROUND BOX (ADJUST)	EA	1

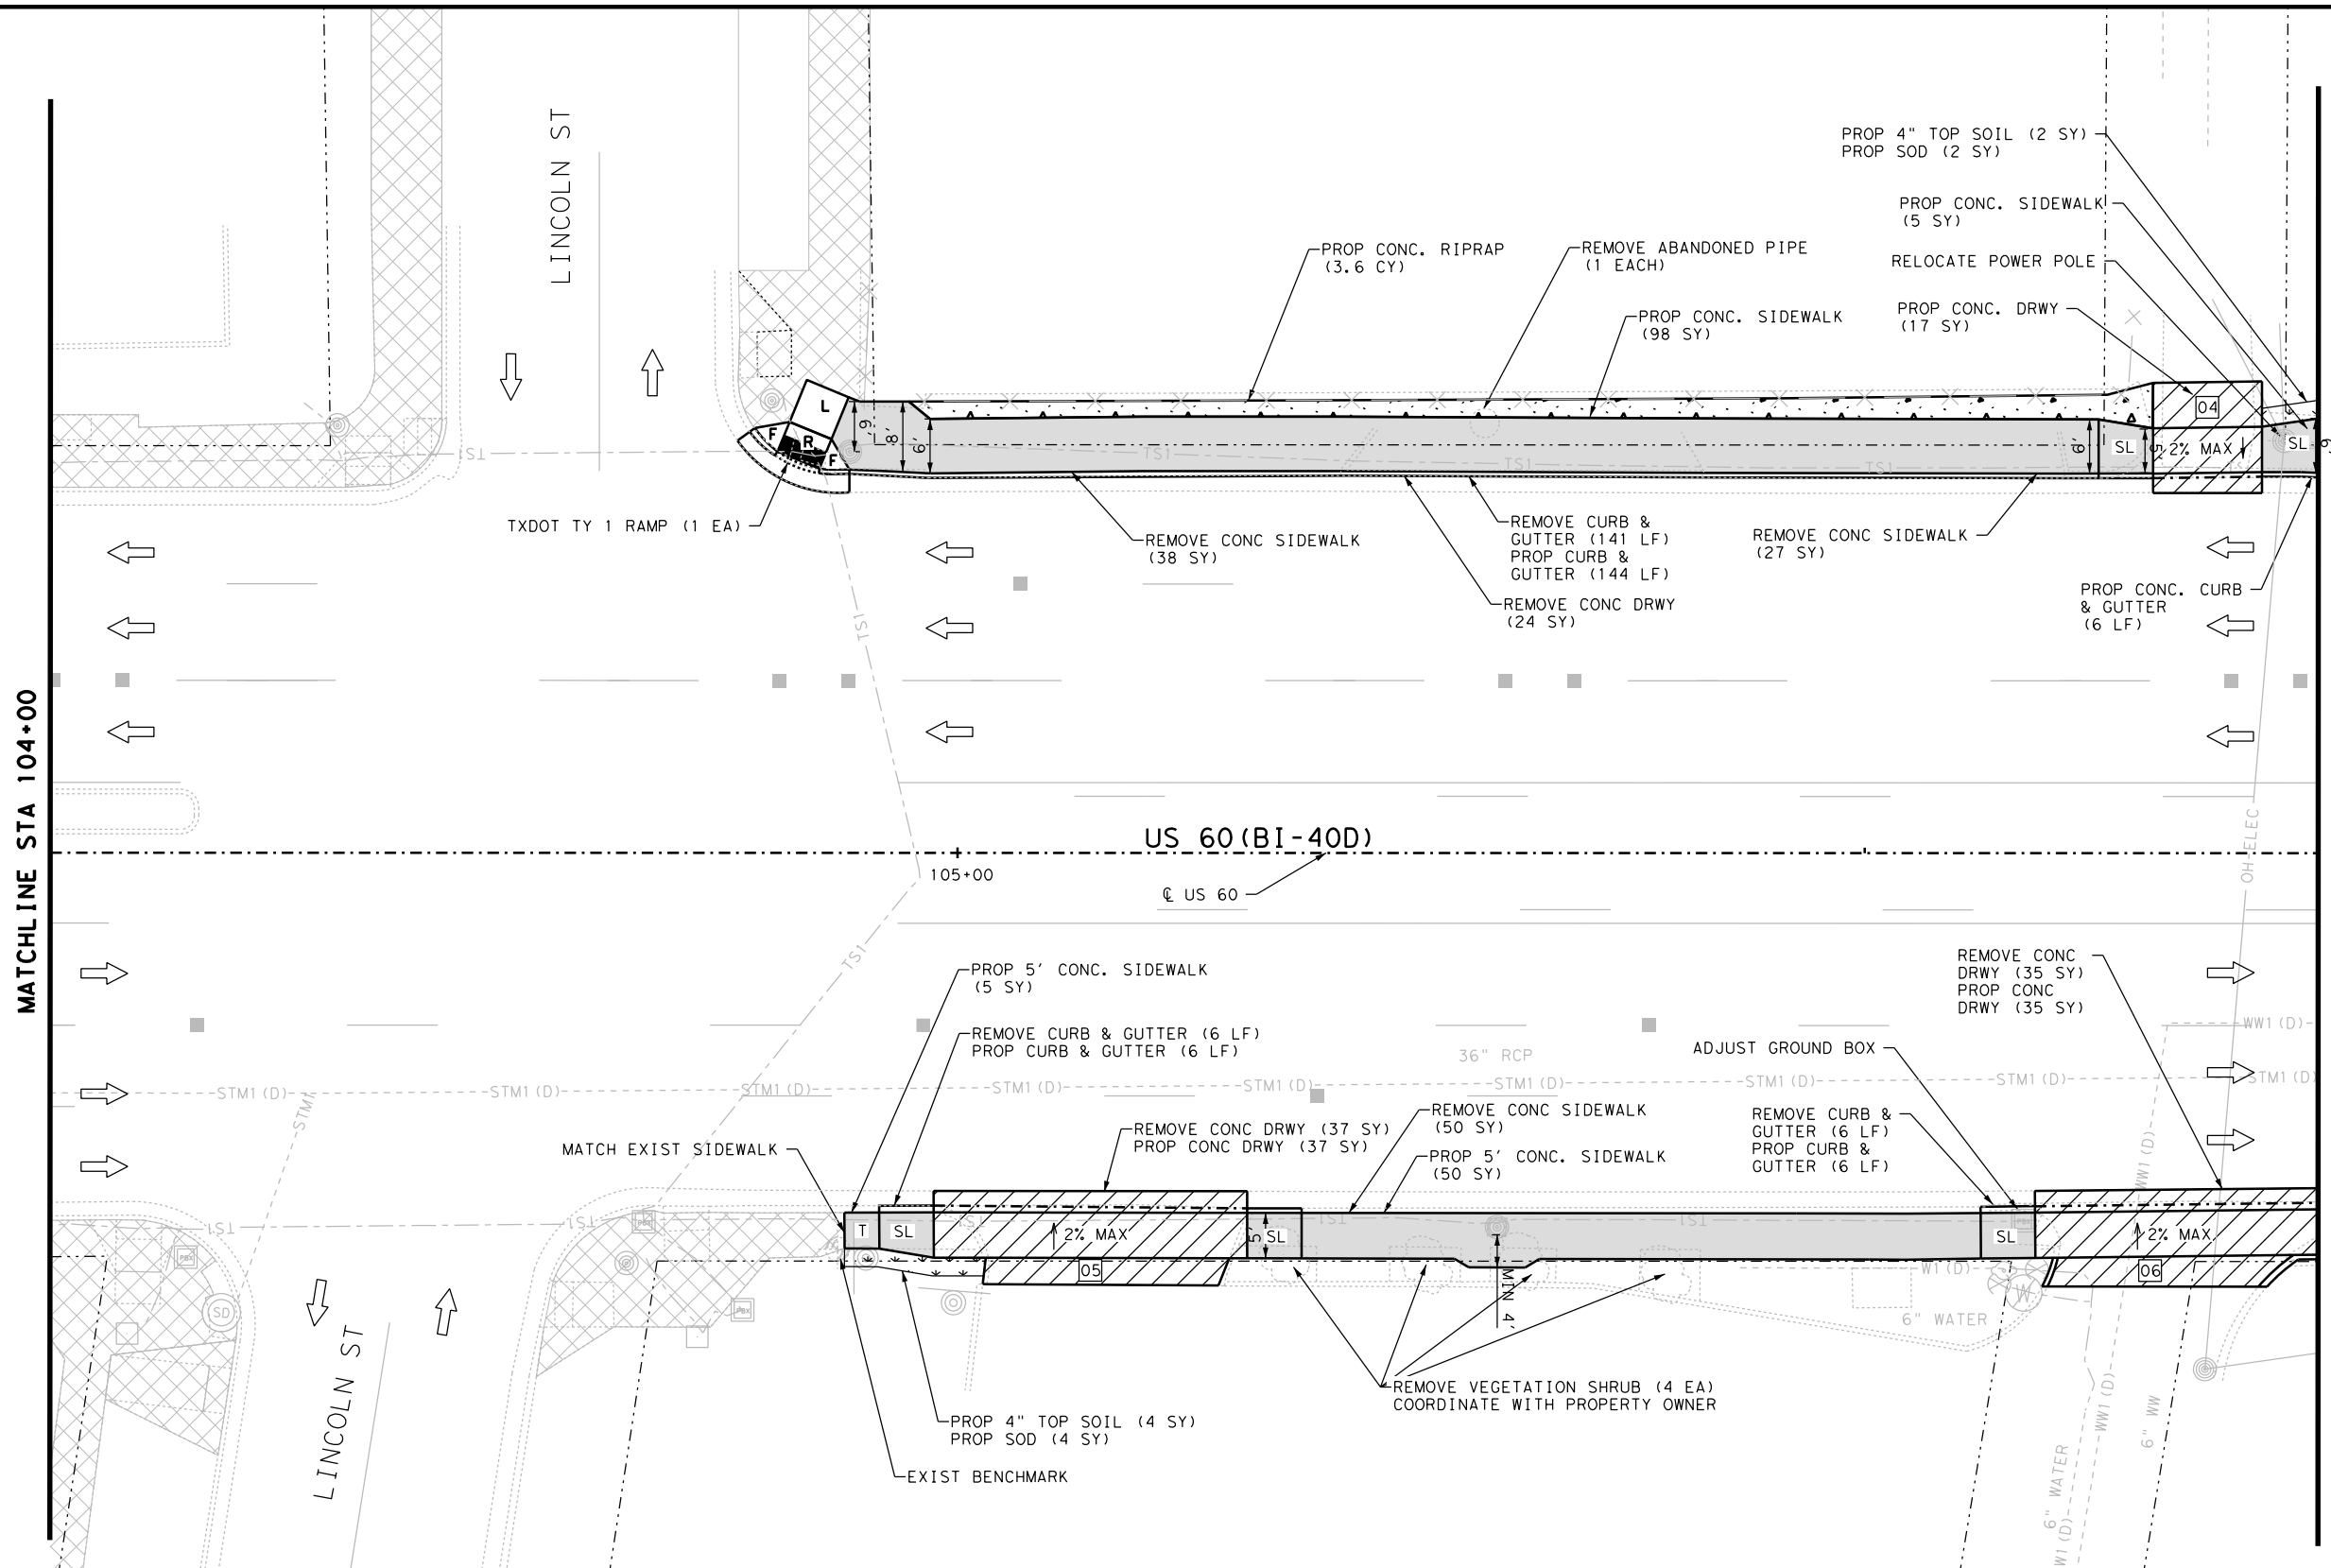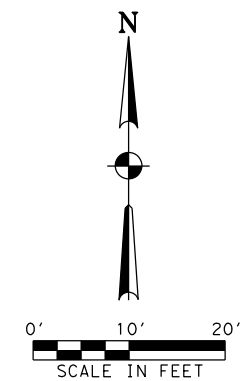

NOTES:
 * FOR CONTRACTOR INFORMATION ONLY
 1. THE EXISTENCE AND LOCATION OF ALL UTILITIES AND DRAINAGE STRUCTURES INDICATED IN THE PLANS ARE TAKEN FROM THE BEST RECORDS AVAILABLE AND ARE NOT GUARANTEED TO BE ACCURATE. CONTRACTOR SHALL COORDINATE WITH ALL UTILITY COMPANIES TO FIELD VERIFY UTILITIES PRIOR TO BEGINNING CONSTRUCTION.

NO.	DATE	REVISION	BY

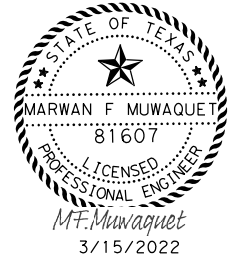

GLOBAL CIVIL SOLUTIONS, LLC
 11551 FOREST CENTRAL DRIVE
 SUITE 220
 DALLAS, TX 75243
 F-12801



**US 60 (BI 40-D)
 SIDEWALK PLAN**

STA 104+00 TO STA 106+50



SHEET 3 OF 44

DESIGN MI	FED. RD. DIV. NO. 6	FEDERAL AID PROJECT NO. (SEE TITLE SHEET)	HIGHWAY NO. VARIOUS
GRAPHICS PS	STATE TEXAS	DISTRICT AMA	COUNTY POTTER
CHECK MF	CONTROL 0904	SECTION 02	JOB 047
CHECK FS			031

LEGEND	
	PROP SODDING
	PROP CONC DRWY
	PROP CONC RIPRAP
	PROP RETAINING WALL
	PROP CONC SIDEWALK
	EXISTING SIDEWALK/DRWY TO REMAIN
	R RAMP
	L LANDING PAD
	F FLARE
	SL LONG. SLOPE MAY NOT EXCEED 5% OR ADJACENT ROAD SLOPE
	T TRANSITION
	LS LEVEL SIDEWALK (2% MAX)
	TRAFFIC FLOW
	EXISTING SIGN
	PROPOSED SIGN
	MANHOLE
	POWER POLE
	TRAFFIC SIGNAL POLE
	LIGHT POLE
	WATER METER
	FIRE HYDRANT
	GUY WIRE
	TREE/SHRUB
	FENCE
	WATER VALVE
	TRAFFIC SIGNAL BOX
	IRRIGATION CONTROL VALVE
	ELECTRICAL PULL BOX
	DRIVEWAY ID
	PEDESTRIAN SIGNAL
	GAS METER
	SPRINKLER HEAD
	UTILITY MARKER POST
	OVERHEAD ELECTRIC LINE

ITEM	DESCRIPTION	UNIT	QTY
0100 6008	PREPARING ROW (TREE) (0" TO 6" DIA)	EA	4
0104 6015	REMOVING CONC (SIDEWALKS)	SY	115
0104 6017	REMOVING CONC (DRIVEWAYS)	SY	96
0104 6029	REMOVING CONC (CURB OR CURB & GUTTER)	LF	153
0160 6003	FURNISHING AND PLACING TOP SOIL (4")	SY	6
0162 6002	BLOCK SODDING	SY	6
0168 6001	VEGETATIVE WATERING	MG	0.3
0432 6001	RIPRAP (CONC) (4 IN)	CY	3.6
0496 6030	REMOVE STR (BOLLARD)	EA	1
0529 6008	CONC CURB & GUTTER (TY II)	LF	162
0530 6004	DRIVEWAYS (CONC)	SY	89
0531 6001	CONC SIDEWALK (4")	SY	158
0531 6004	CURB RAMPS (TY 1)	EA	1
6027 6009	GROUND BOX (ADJUST)	EA	1

P:\Jobs\2020007-Pedestr\on TxDOT Amort\1110\CA00\VP3-SHEETS\047_AM_US_60_S130F44.dgn
 3:07:13 PM
 5/15/2022

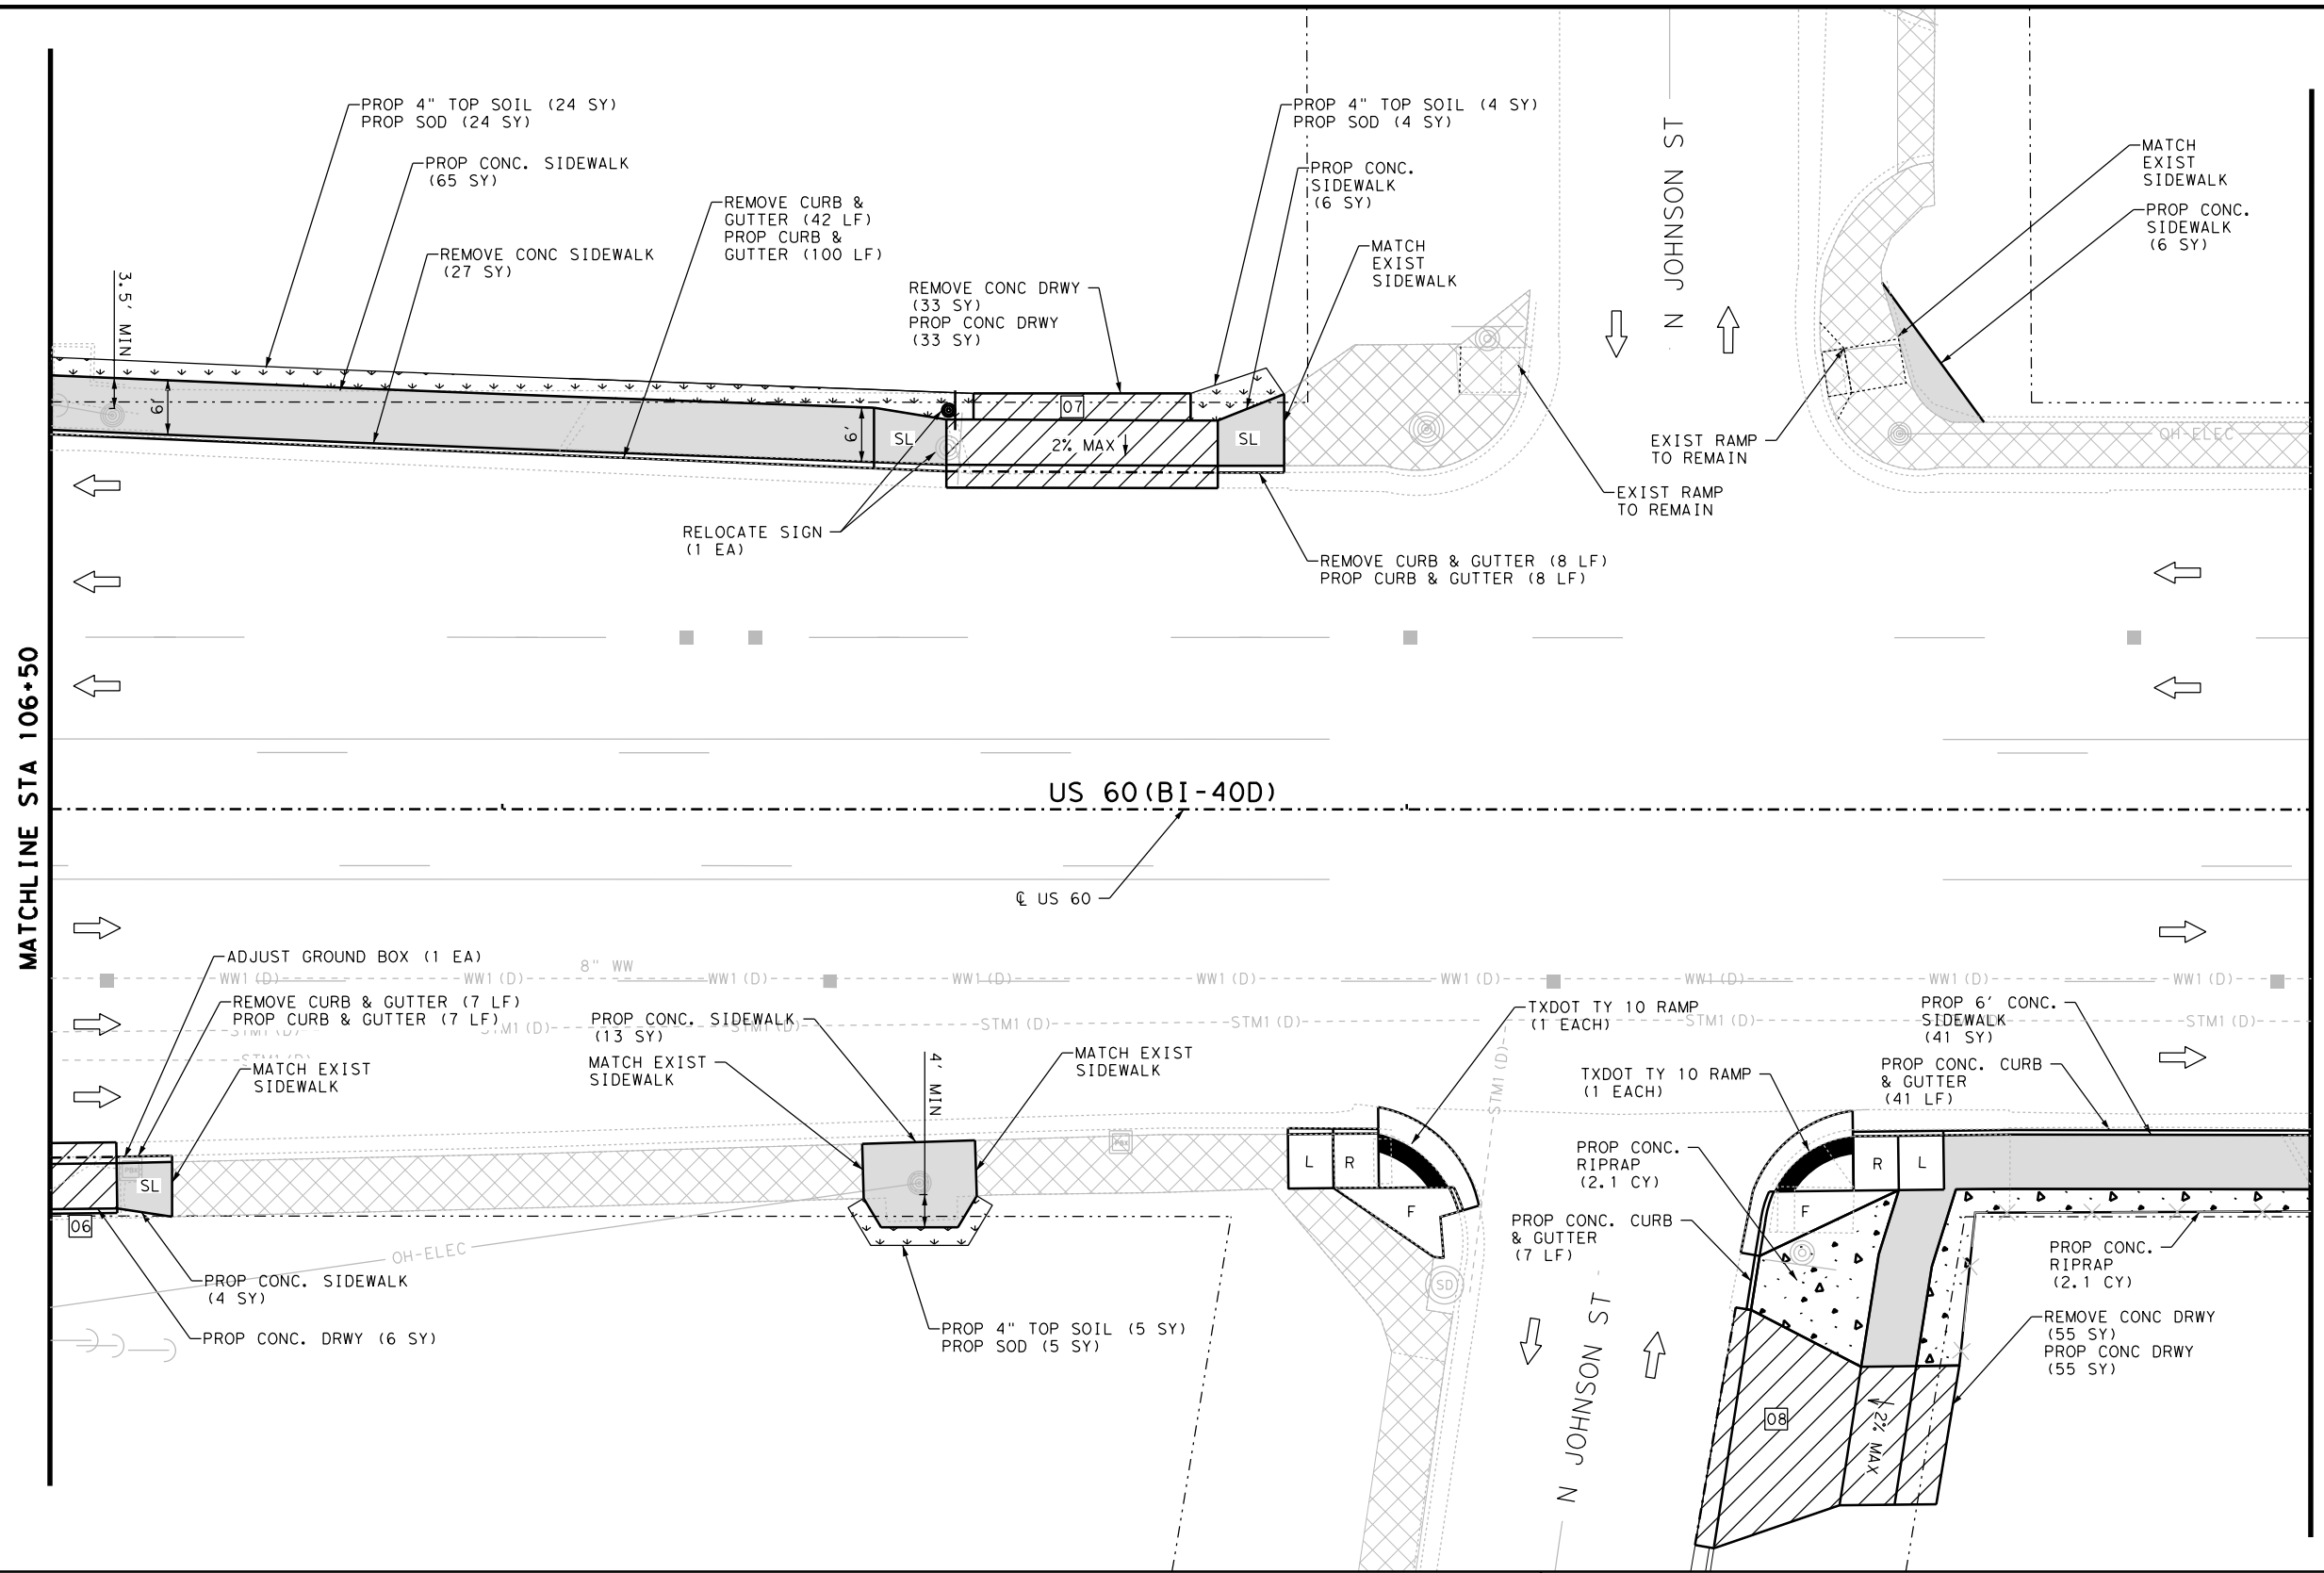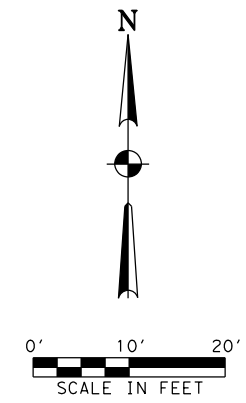

NOTES:
 * FOR CONTRACTOR INFORMATION ONLY
 1. THE EXISTENCE AND LOCATION OF ALL UTILITIES AND DRAINAGE STRUCTURES INDICATED IN THE PLANS ARE TAKEN FROM THE BEST RECORDS AVAILABLE AND ARE NOT GUARANTEED TO BE ACCURATE. CONTRACTOR SHALL COORDINATE WITH ALL UTILITY COMPANIES TO FIELD VERIFY UTILITIES PRIOR TO BEGINNING CONSTRUCTION.

NO.	DATE	REVISION	BY



GLOBAL CIVIL SOLUTIONS, LLC
 11551 FOREST CENTRAL DRIVE
 SUITE 220
 DALLAS, TX 75243
 F-12801



**US 60 (BI 40-D)
 SIDEWALK PLAN**

STA 106+50 TO STA 109+50



SHEET 4 OF 44

DESIGN MI	FED. RD. DIV. NO. 6	FEDERAL AID PROJECT NO. (SEE TITLE SHEET)	HIGHWAY NO. VARIOUS
GRAPHICS PS	STATE TEXAS	DISTRICT AMA	COUNTY POTTER
CHECK MFM	CONTROL 0904	SECTION 02	JOB 047
CHECK FS			032

P:\Jobs\202007-Pedestr\on TxDOT Amor\1110-CA00-V3-SHEETS\047_AM_US_60_STA106+50.dgn
 5:17:54 PM 1/27/2022

LEGEND			
	PROP SODDING	R	RAMP
	PROP CONC DRWY	L	LANDING PAD
	PROP CONC RIPRAP	F	FLARE
	PROP RETAINING WALL	SL	LONG. SLOPE MAY NOT EXCEED 5% OR ADJACENT ROAD SLOPE
	PROP CONC SIDEWALK	T	TRANSITION
	EXISTING SIDEWALK/DRWY TO REMAIN	LS	LEVEL SIDEWALK (2% MAX)
	PROP SODDING	←	TRAFFIC FLOW
	PROP CONC SIDEWALK	⊙	EXISTING SIGN
	EXISTING SIDEWALK/DRWY TO REMAIN	⊙	PROPOSED SIGN
	PROP SODDING	⊙	MANHOLE
	POWER POLE	⊙	TRAFFIC SIGNAL POLE
	TRAFFIC SIGNAL POLE	⊙	LIGHT POLE
	WATER METER	⊙	FIRE HYDRANT
	FIRE HYDRANT	⊙	GUY WIRE
	TREE/SHRUB	⊙	TREE/SHRUB
	FENCE	⊙	WATER VALVE
	WATER VALVE	⊙	TRAFFIC SIGNAL BOX
	TRAFFIC SIGNAL BOX	⊙	IRRIGATION CONTROL VALVE
	IRRIGATION CONTROL VALVE	⊙	ELECTRICAL PULL BOX
	ELECTRICAL PULL BOX	⊙	DRIVEWAY ID
	DRIVEWAY ID	⊙	PEDESTRIAN SIGNAL
	PEDESTRIAN SIGNAL	⊙	GAS METER
	GAS METER	⊙	SPRINKLER HEAD
	SPRINKLER HEAD	⊙	UTILITY MARKER POST
	UTILITY MARKER POST	⊙	OVERHEAD ELECTRIC LINE
	OVERHEAD ELECTRIC LINE		

ITEM	DESCRIPTION	UNIT	QTY
0104 6015	REMOVING CONC (SIDEWALKS)	SY	27
0104 6017	REMOVING CONC (DRIVEWAYS)	SY	88
0104 6029	REMOVING CONC (CURB OR CURB & GUTTER)	LF	57
0160 6003	FURNISHING AND PLACING TOP SOIL (4")	SY	33
0162 6002	BLOCK SODDING	SY	33
0168 6001	VEGETATIVE WATERING	MG	1.3
0432 6001	RIPRAP (CONC) (4 IN)	CY	4.2
0529 6008	CONC CURB & GUTTER (TY II)	LF	163
0530 6004	DRIVEWAYS (CONC)	SY	94
0531 6001	CONC SIDEWALK (4")	SY	135
0531 6013	CURB RAMPS (TY 10)	EA	2
0644 6068	RELOCATE SM RD SN SUP&AM TY 10BWG	EA	1
6027 6009	GROUND BOX (ADJUST)	EA	1

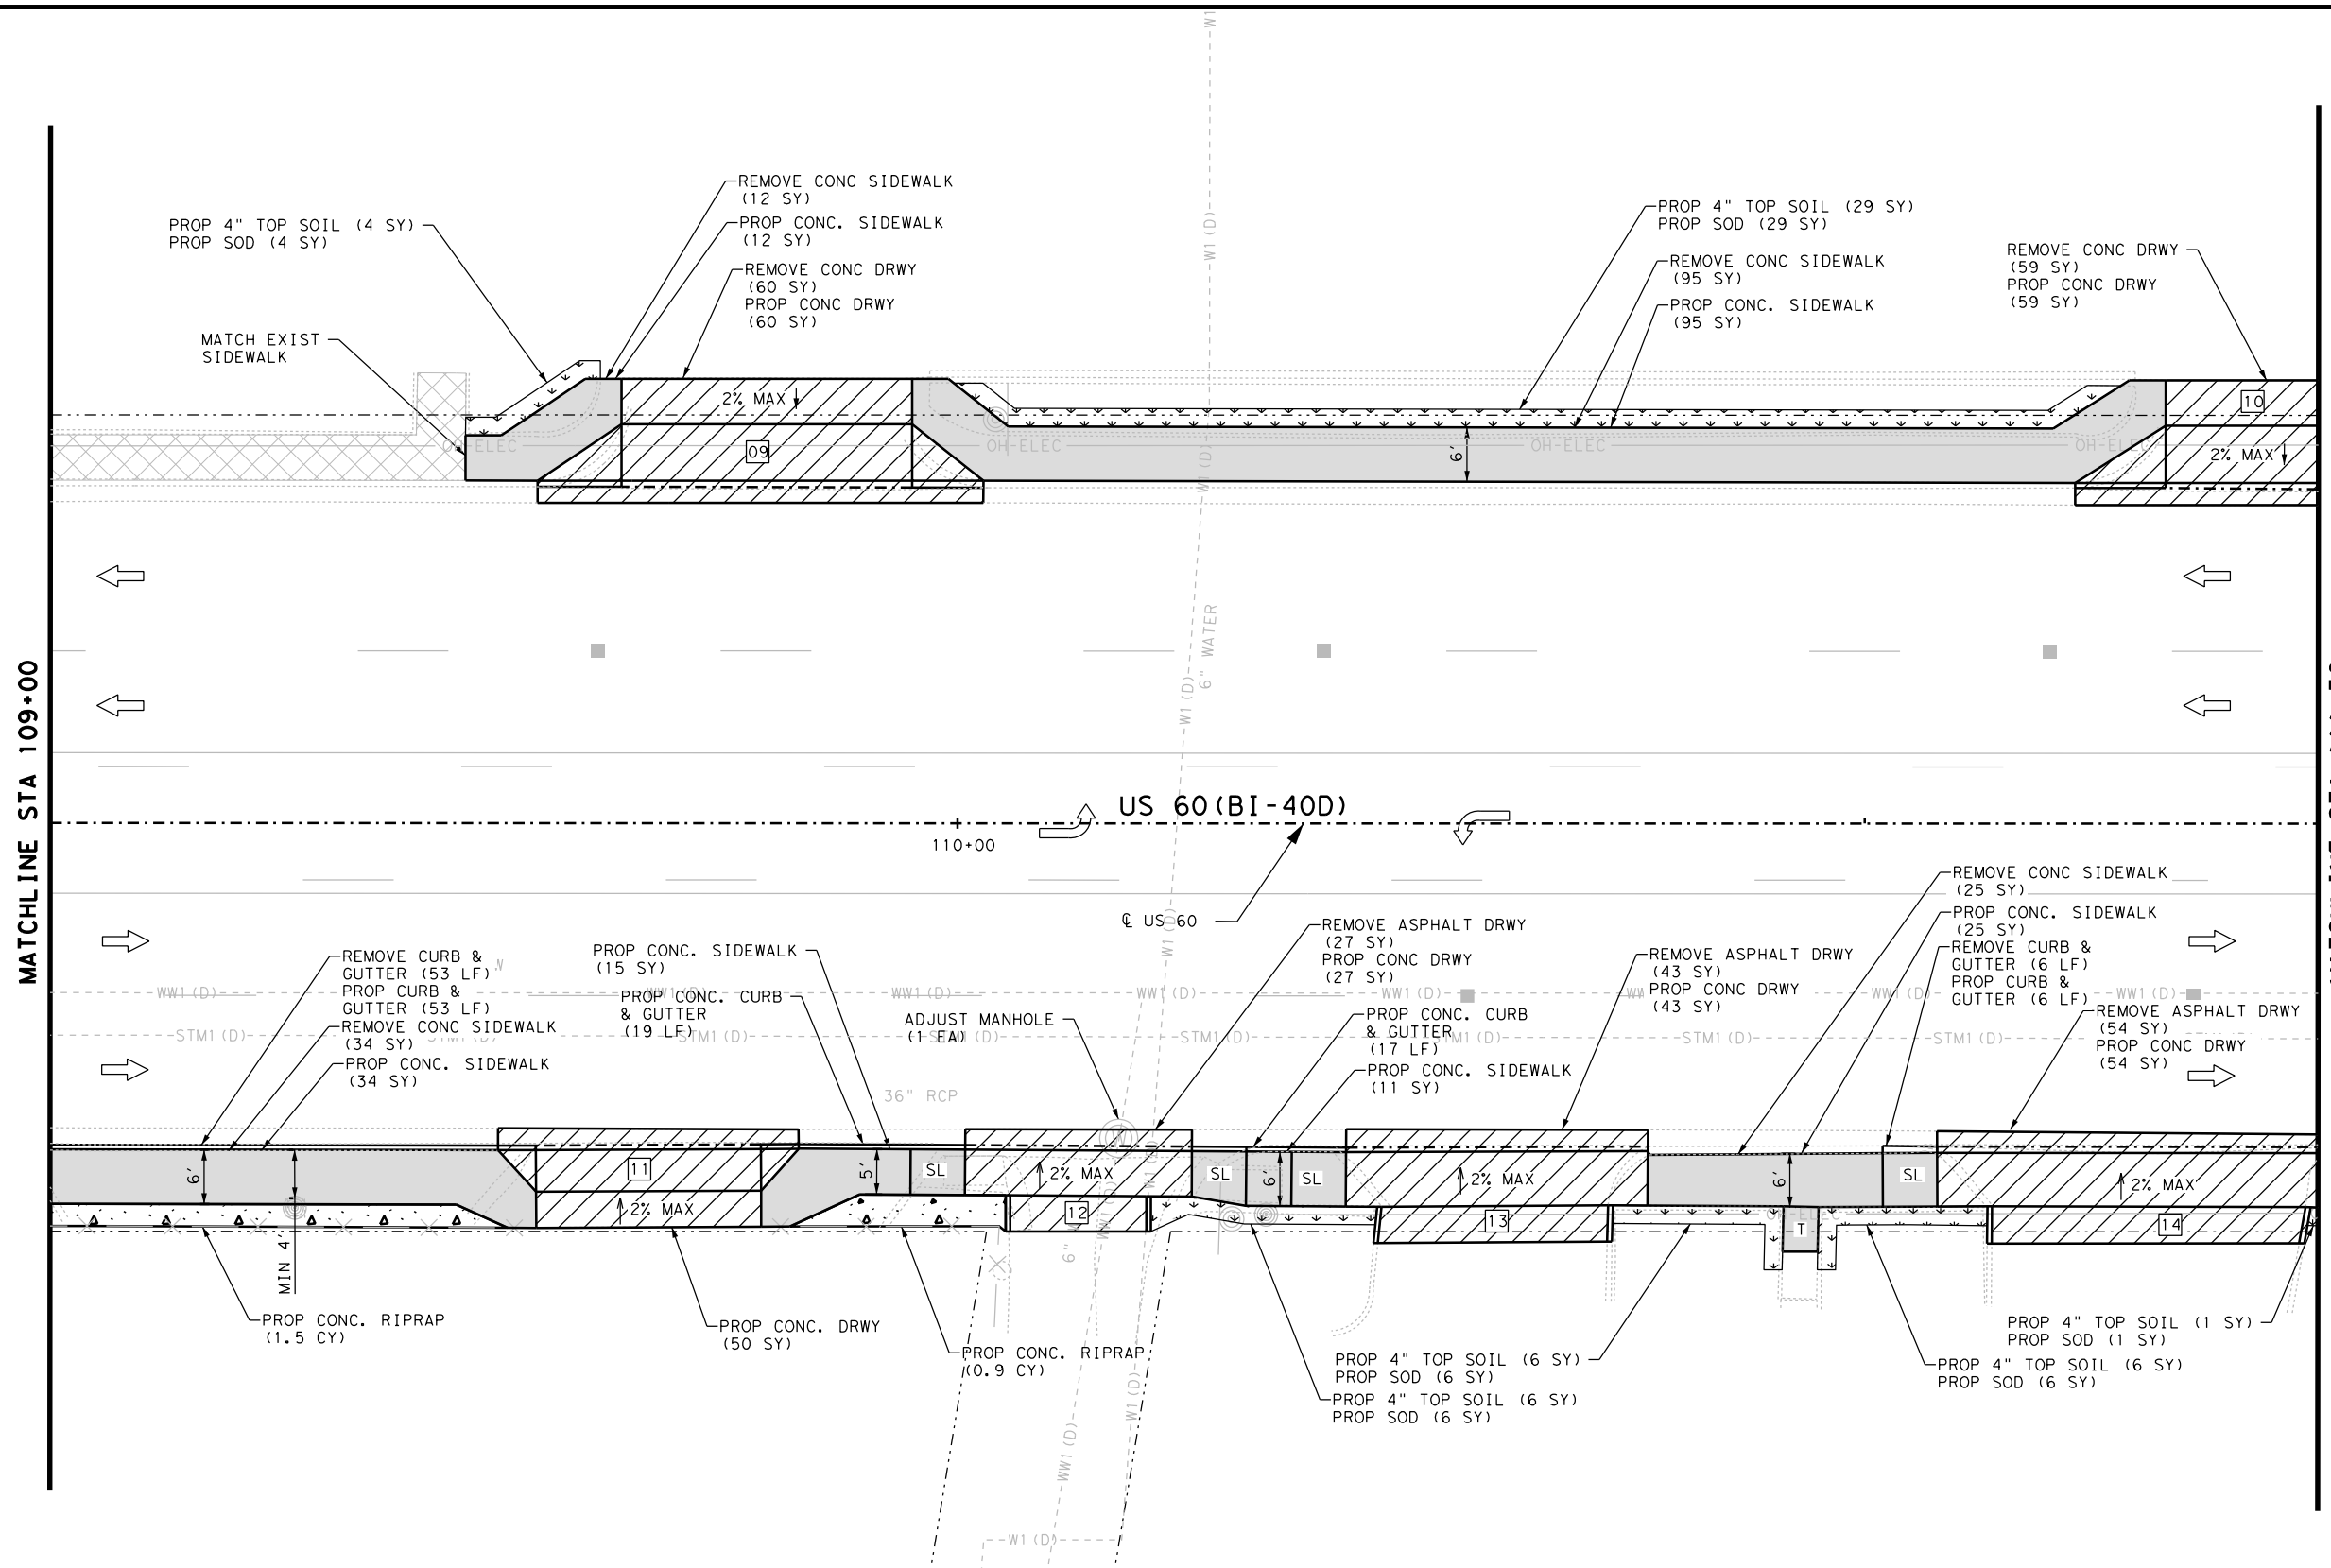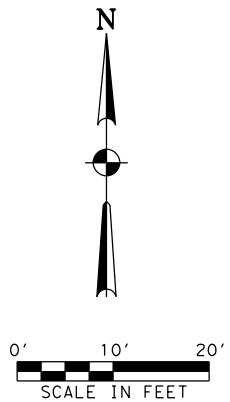

NOTES:
 * FOR CONTRACTOR INFORMATION ONLY
 1. THE EXISTENCE AND LOCATION OF ALL UTILITIES AND DRAINAGE STRUCTURES INDICATED IN THE PLANS ARE TAKEN FROM THE BEST RECORDS AVAILABLE AND ARE NOT GUARANTEED TO BE ACCURATE. CONTRACTOR SHALL COORDINATE WITH ALL UTILITY COMPANIES TO FIELD VERIFY UTILITIES PRIOR TO BEGINNING CONSTRUCTION.

NO.	DATE	REVISION	BY



GLOBAL CIVIL SOLUTIONS, LLC
 1151 FOREST CENTRAL DRIVE
 SUITE 220
 DALLAS, TX 75243
 F-12801



**US 60 (BI 40-D)
 SIDEWALK PLAN**

STA 109+00 TO STA 111+50



SHEET 5 OF 44

DESIGN MI	FED. RD. DIV. NO. 6	FEDERAL AID PROJECT NO. (SEE TITLE SHEET)	HIGHWAY NO. VARIOUS
GRAPHICS PS	STATE TEXAS	DISTRICT AMA	COUNTY POTTER
CHECK MF	CONTROL 0904	SECTION 02	JOB 047
CHECK FS			SHEET NO. 033

P:\Jobs\202007-Pedestr\1110-CA00\PS3-SHEETS\047_AM_US_60_ST150F44.dgn
 5:17:55 PM
 1/27/2022

LEGEND	
	PROP SODDING
	PROP CONC DRWY
	PROP CONC RIPRAP
	PROP RETAINING WALL
	PROP CONC SIDEWALK
	EXISTING SIDEWALK/DRWY TO REMAIN
R	RAMP
L	LANDING PAD
F	FLARE
SL	LONG. SLOPE MAY NOT EXCEED 5% OR ADJACENT ROAD SLOPE
T	TRANSITION
LS	LEVEL SIDEWALK (2% MAX)
	TRAFFIC FLOW
	EXISTING SIGN
	PROPOSED SIGN
	MANHOLE
	POWER POLE
	TRAFFIC SIGNAL POLE
	LIGHT POLE
	WATER METER
	FIRE HYDRANT
	GUY WIRE
	TREE/SHRUB
	FENCE
	WATER VALVE
	TRAFFIC SIGNAL BOX
	IRRIGATION CONTROL VALVE
	ELECTRICAL PULL BOX
	DRIVEWAY ID
	PEDESTRIAN SIGNAL
	GAS METER
	SPRINKLER HEAD
	UTILITY MARKER POST
	OVERHEAD ELECTRIC LINE

ITEM	DESCRIPTION	UNIT	QTY
0104 6015	REMOVING CONC (SIDEWALKS)	SY	166
0104 6017	REMOVING CONC (DRIVEWAYS)	SY	119
0104 6029	REMOVING CONC (CURB OR CURB & GUTTER)	LF	59
0105 6070	REMOVING STAB BASE & ASPH PAV (6" - 8")	SY	124
0160 6003	FURNISHING AND PLACING TOP SOIL (4")	SY	52
0162 6002	BLOCK SODDING	SY	52
0168 6001	VEGETATIVE WATERING	MG	2.0
0432 6001	RIPRAP (CONC) (4 IN)	CY	2.4
0479 6001	ADJUSTING MANHOLES	EA	1
0529 6008	CONC CURB & GUTTER (TY II)	LF	95
0530 6004	DRIVEWAYS (CONC)	SY	266
0531 6001	CONC SIDEWALK (4")	SY	192

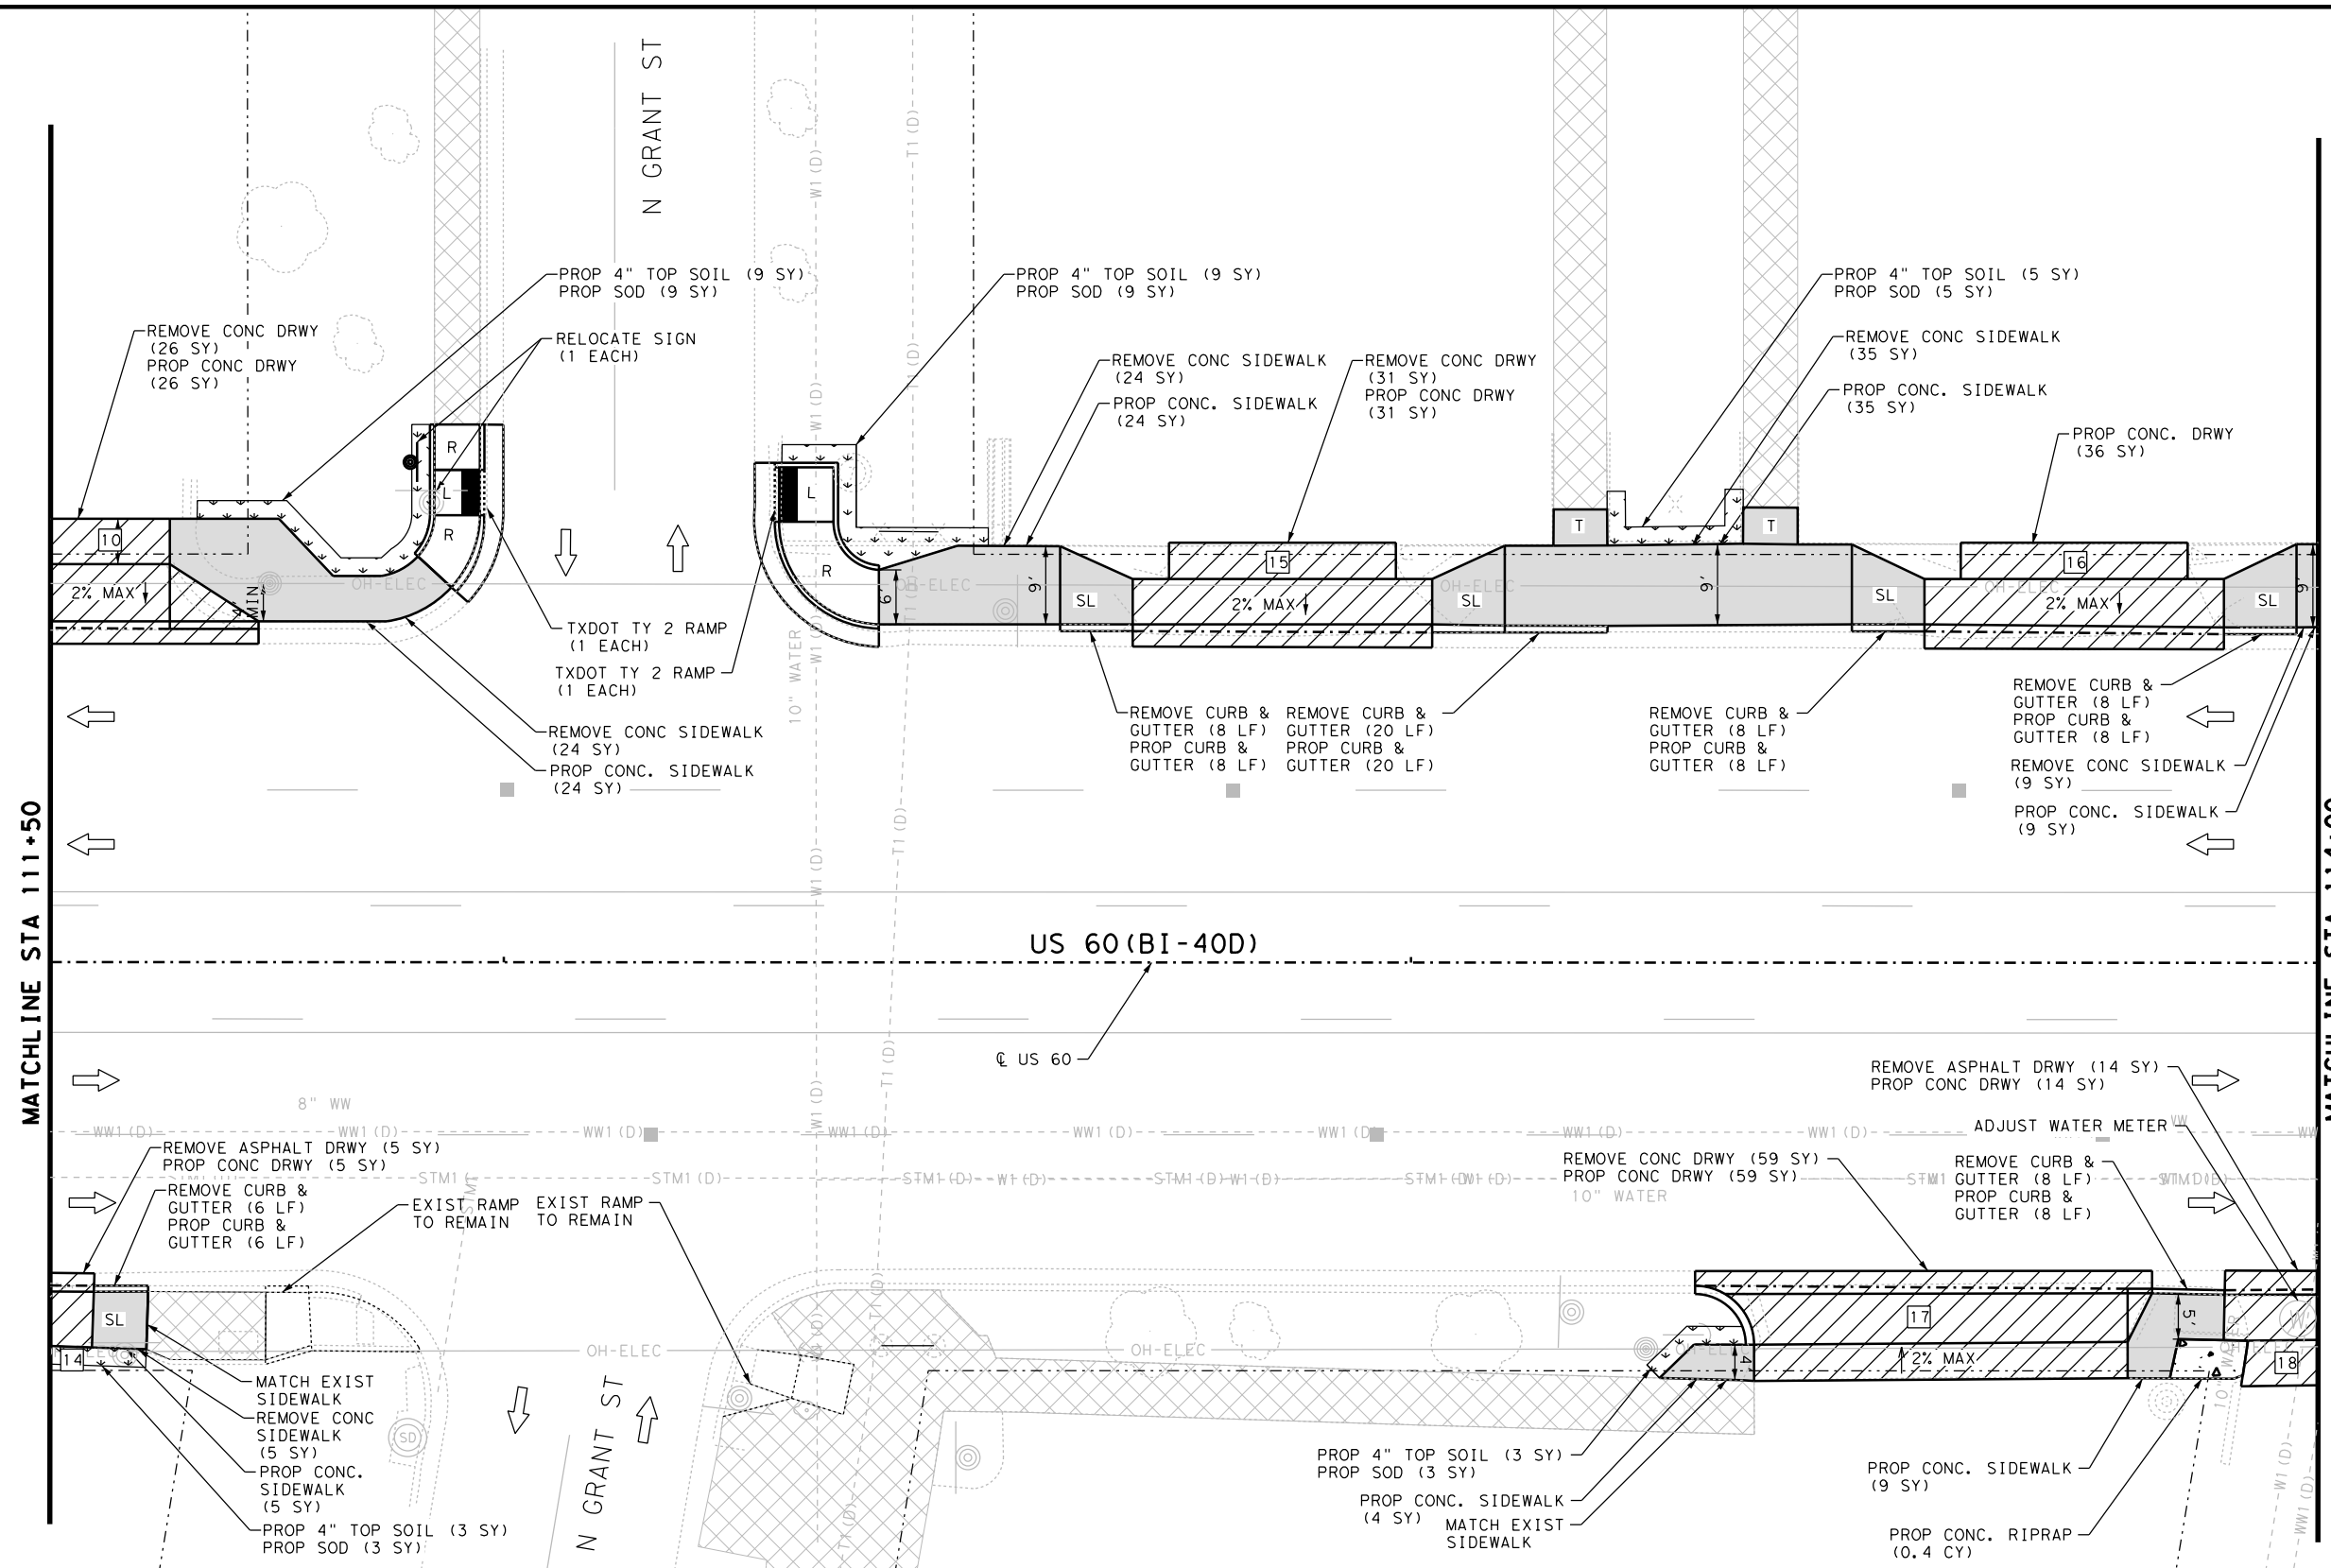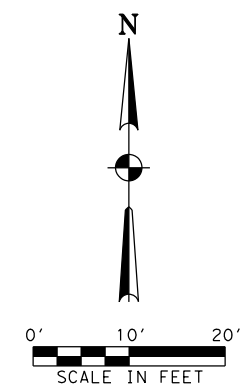

- NOTES:
- * FOR CONTRACTOR INFORMATION ONLY
 - 1. THE EXISTENCE AND LOCATION OF ALL UTILITIES AND DRAINAGE STRUCTURES INDICATED IN THE PLANS ARE TAKEN FROM THE BEST RECORDS AVAILABLE AND ARE NOT GUARANTEED TO BE ACCURATE. CONTRACTOR SHALL COORDINATE WITH ALL UTILITY COMPANIES TO FIELD VERIFY UTILITIES PRIOR TO BEGINNING CONSTRUCTION.

NO.	DATE	REVISION	BY



GLOBAL CIVIL SOLUTIONS, LLC
 11551 FOREST CENTRAL DRIVE
 SUITE 220
 DALLAS, TX 75243
 F-12801



US 60 (BI 40-D)
SIDEWALK PLAN

STA 111+50 TO STA 114+00

SHEET 6 OF 44



DESIGN	FED. RD. DIV. NO.	FEDERAL AID PROJECT NO.	HIGHWAY NO.
MI	6	(SEE TITLE SHEET)	VARIOUS
GRAPHICS	STATE	DISTRICT	COUNTY
PS	TEXAS	AMA	POTTER
CHECK	CONTROL	SECTION	JOB
MF			
CHECK	FS	0904	02 047

ITEM	DESCRIPTION	UNIT	QTY
0104 6015	REMOVING CONC (SIDEWALKS)	SY	97
0104 6017	REMOVING CONC (DRIVEWAYS)	SY	152
0104 6029	REMOVING CONC (CURB OR CURB & GUTTER)	LF	58
0105 6070	REMOVING STAB BASE & ASPH PAV (6" - 8")	SY	19
0160 6003	FURNISHING AND PLACING TOP SOIL (4")	SY	29
0162 6002	BLOCK SODDING	SY	29
0168 6001	VEGETATIVE WATERING	MG	1.1
0432 6001	RIPRAP (CONC) (4 IN)	CY	0.4
0479 6008	ADJUSTING MANHOLES (WATER METER)	EA	1
0529 6008	CONC CURB & GUTTER (TY II)	LF	58
0530 6004	DRIVEWAYS (CONC)	SY	171
0531 6001	CONC SIDEWALK (4")	SY	110
0531 6005	CURB RAMPS (TY 2)	EA	2
0644 6068	RELOCATE SM RD SN SUP&AM TY 10BWG	EA	1

LEGEND

	PROP SODDING	R	RAMP		POWER POLE		IRRIGATION CONTROL VALVE
	PROP CONC DRWY	L	LANDING PAD		TRAFFIC SIGNAL POLE		ELECTRICAL PULL BOX
	PROP CONC RIPRAP	F	FLARE		LIGHT POLE		DRIVEWAY ID
	PROP RETAINING WALL	SL	LONG. SLOPE MAY NOT EXCEED 5% OR ADJACENT ROAD SLOPE		WATER METER		PEDESTRIAN SIGNAL
	PROP CONC SIDEWALK	T	TRANSITION		FIRE HYDRANT		GAS METER
	EXISTING SIDEWALK/DRWY TO REMAIN	LS	LEVEL SIDEWALK (2% MAX)		GUY WIRE		SPRINKLER HEAD
			TRAFFIC FLOW		TREE/SHRUB		UTILITY MARKER POST
			EXISTING SIGN		FENCE		OVERHEAD ELECTRIC LINE
			PROPOSED SIGN		WATER VALVE		
			MANHOLE		TRAFFIC SIGNAL BOX		

P:\Jobs\2020007-TxDOT\Amor\1110\CA00\VP3-SHEETS\047_AM_US_60_ST160F44.dgn
 5:17:57 PM 1/27/2022

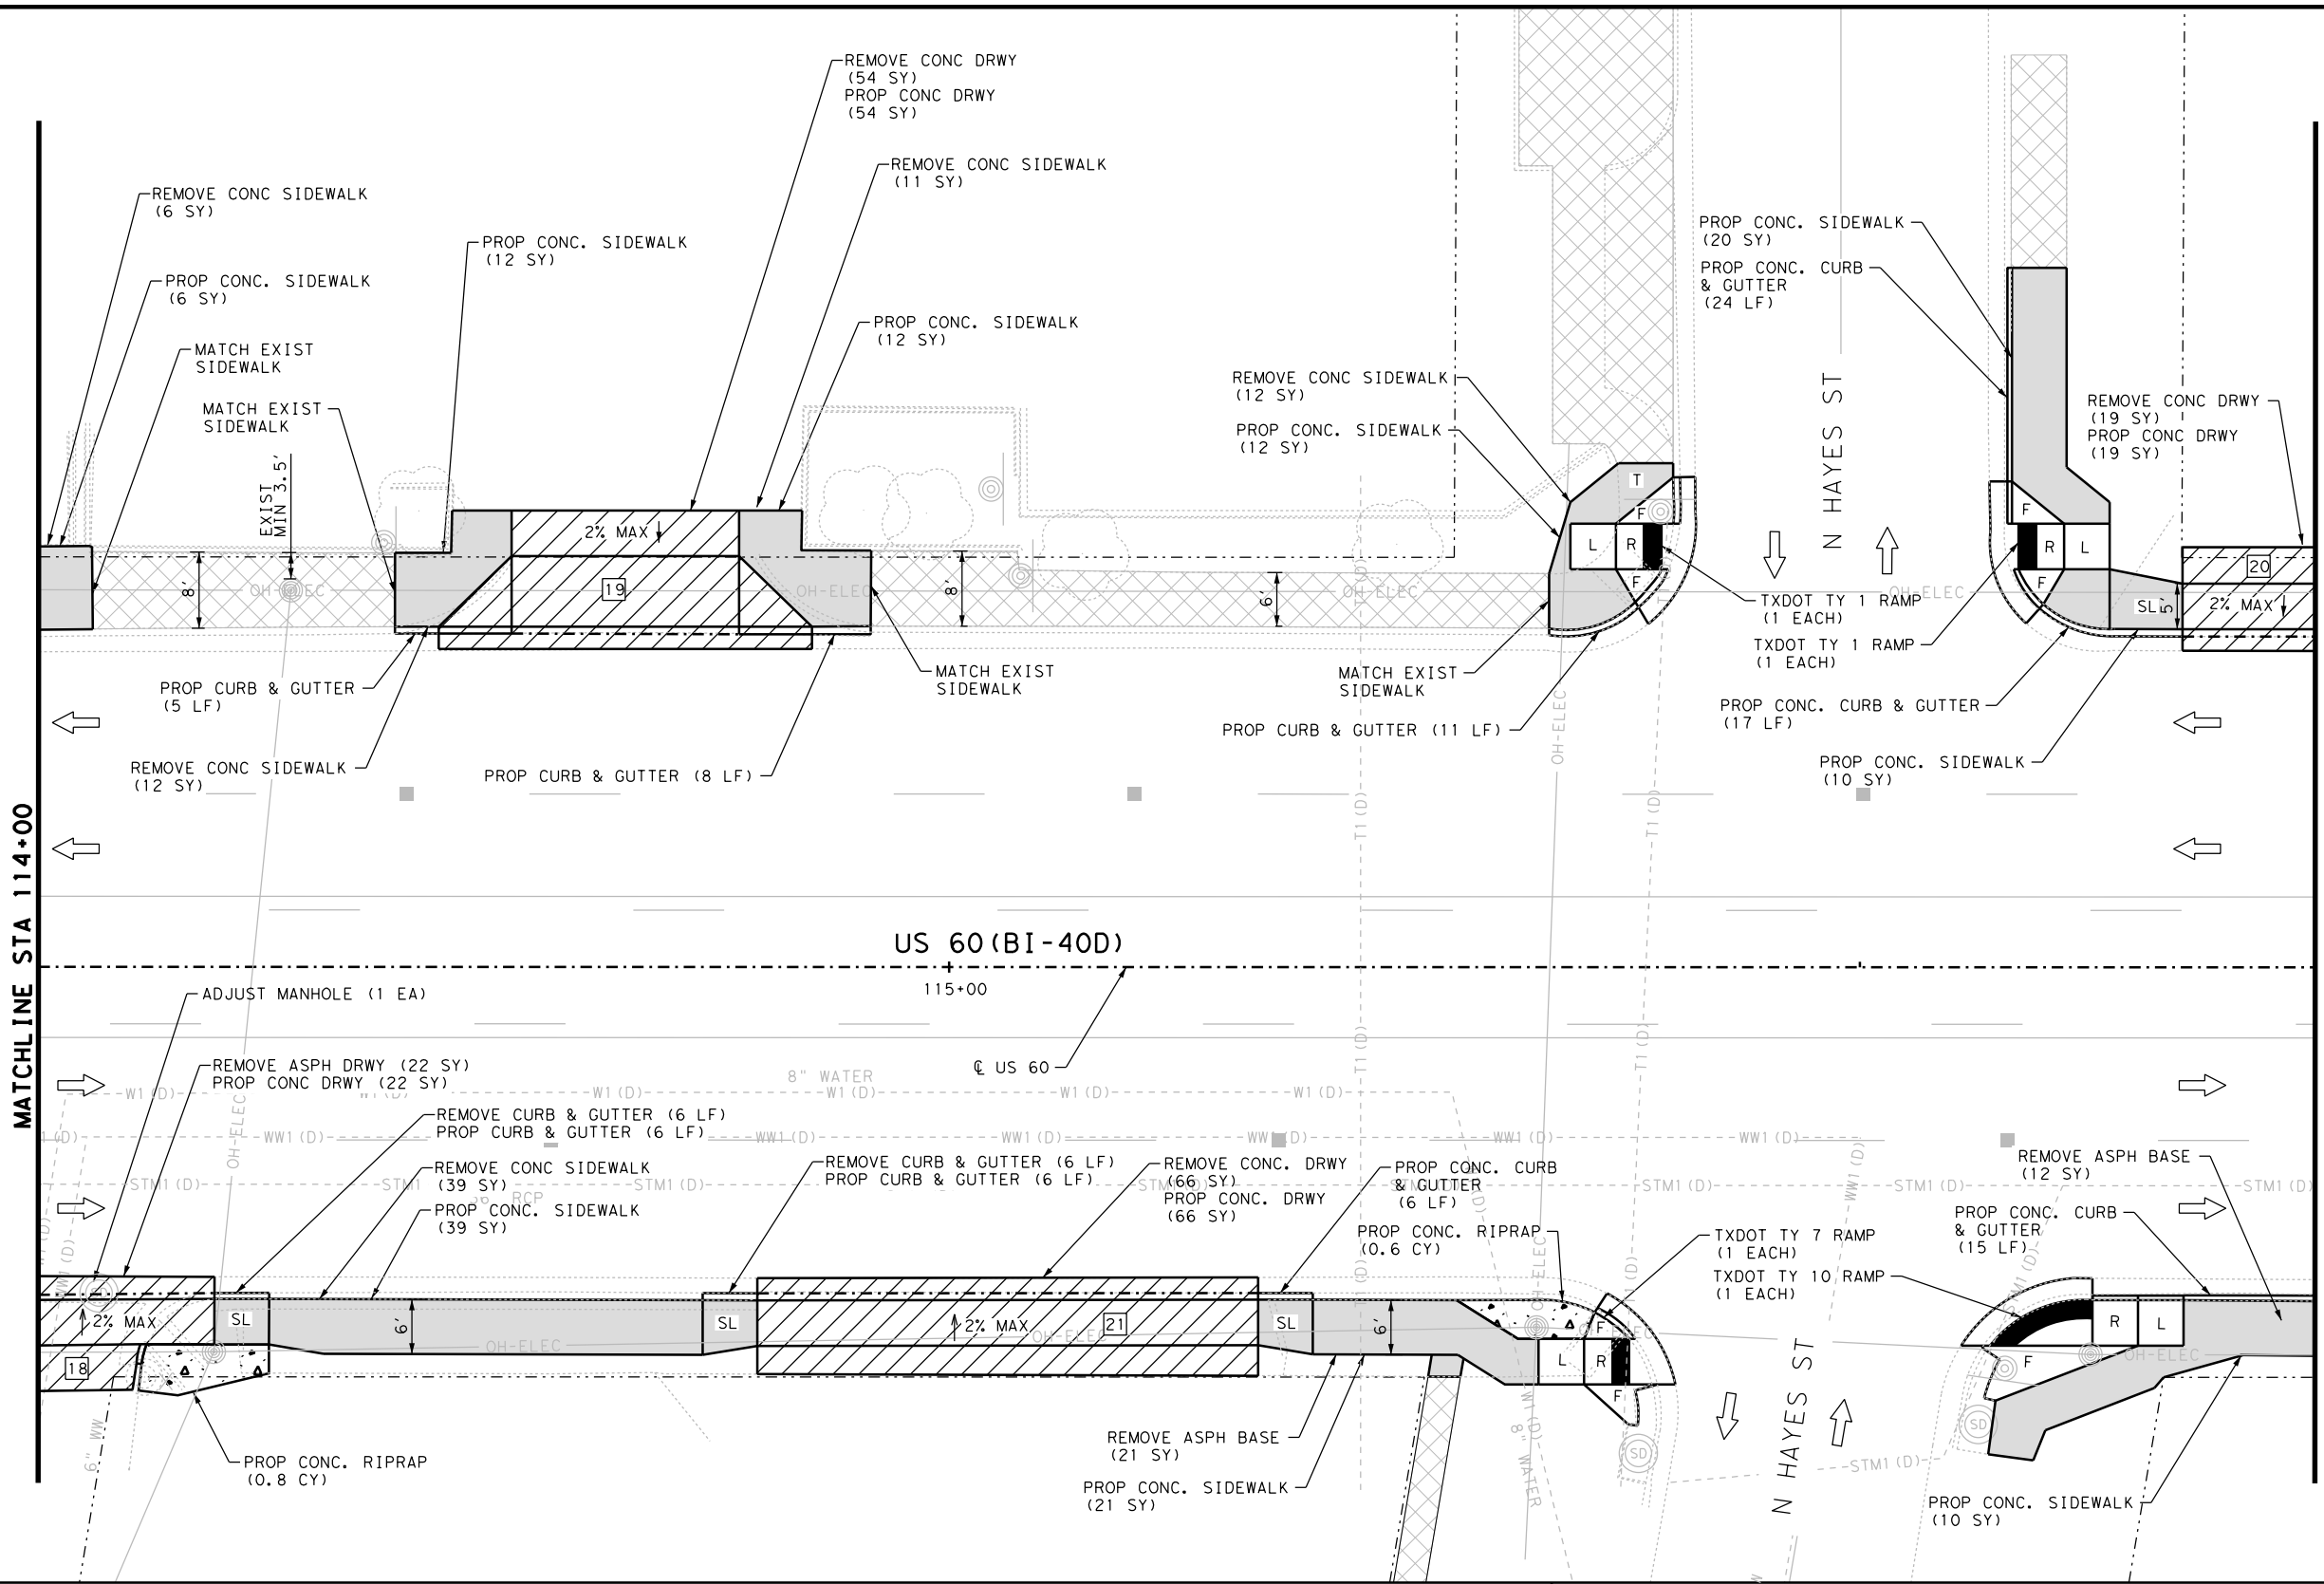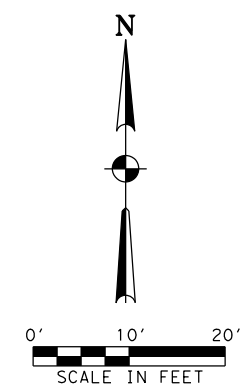

NOTES:
 * FOR CONTRACTOR INFORMATION ONLY
 1. THE EXISTENCE AND LOCATION OF ALL UTILITIES AND DRAINAGE STRUCTURES INDICATED IN THE PLANS ARE TAKEN FROM THE BEST RECORDS AVAILABLE AND ARE NOT GUARANTEED TO BE ACCURATE. CONTRACTOR SHALL COORDINATE WITH ALL UTILITY COMPANIES TO FIELD VERIFY UTILITIES PRIOR TO BEGINNING CONSTRUCTION.

NO.	DATE	REVISION	BY



GLOBAL CIVIL SOLUTIONS, LLC
 11551 FOREST CENTRAL DRIVE
 SUITE 220
 DALLAS, TX 75243
 F-12801



**US 60 (BI 40-D)
 SIDEWALK PLAN**

STA 114+00 TO STA 116+50



SHEET 7 OF 44

DESIGN MI	FED. RD. DIV. NO. 6	FEDERAL AID PROJECT NO. (SEE TITLE SHEET)	HIGHWAY NO. VARIOUS
GRAPHICS PS	STATE TEXAS	DISTRICT AMA	COUNTY POTTER
CHECK MF	CONTROL 0904	SECTION 02	JOB 047
CHECK FS			SHEET NO. 035

LEGEND			
	PROP SODDING	R	RAMP
	PROP CONC DRWY	L	LANDING PAD
	PROP CONC RIPRAP	F	FLARE
	PROP RETAINING WALL	SL	LONG. SLOPE MAY NOT EXCEED 5% OR ADJACENT ROAD SLOPE
	PROP CONC SIDEWALK	T	TRANSITION
	EXISTING SIDEWALK/DRWY TO REMAIN	LS	LEVEL SIDEWALK (2% MAX)
	POWER POLE	←	TRAFFIC FLOW
	TRAFFIC SIGNAL POLE	⊙	EXISTING SIGN
	LIGHT POLE	⊙	PROPOSED SIGN
	WATER METER	⊙	MANHOLE
	FIRE HYDRANT	⊙	
	GUY WIRE	⊙	
	TREE/SHRUB	⊙	
	FENCE	⊙	
	WATER VALVE	⊙	
	TRAFFIC SIGNAL BOX	⊙	
	IRRIGATION CONTROL VALVE	⊙	
	ELECTRICAL PULL BOX	⊙	
	DRIVEWAY ID	⊙	
	PEDESTRIAN SIGNAL	⊙	
	GAS METER	⊙	
	SPRINKLER HEAD	⊙	
	UTILITY MARKER POST	⊙	
	OVERHEAD ELECTRIC LINE	⊙	

ITEM	DESCRIPTION	UNIT	QTY
0104 6015	REMOVING CONC (SIDEWALKS)	SY	80
0104 6017	REMOVING CONC (DRIVEWAYS)	SY	139
0104 6029	REMOVING CONC (CURB OR CURB & GUTTER)	LF	12
0105 6070	REMOVING STAB BASE & ASPH PAV (6" - 8")	SY	55
0432 6001	RIPRAP (CONC) (4 IN)	CY	1.4
0479 6001	ADJUSTING MANHOLES	EA	1
0529 6008	CONC CURB & GUTTER (TY II)	LF	98
0530 6004	DRIVEWAYS (CONC)	SY	161
0531 6001	CONC SIDEWALK (4")	SY	142
0531 6004	CURB RAMPS (TY 1)	EA	2
0531 6010	CURB RAMPS (TY 7)	EA	1
0531 6013	CURB RAMPS (TY 10)	EA	1

P:\Jobs\2020007-Pedestrian\110-CA00\VP3-SHEETS\047_AM_US_60_SITOF44.dgn
 5:18:06 PM
 1/27/2022

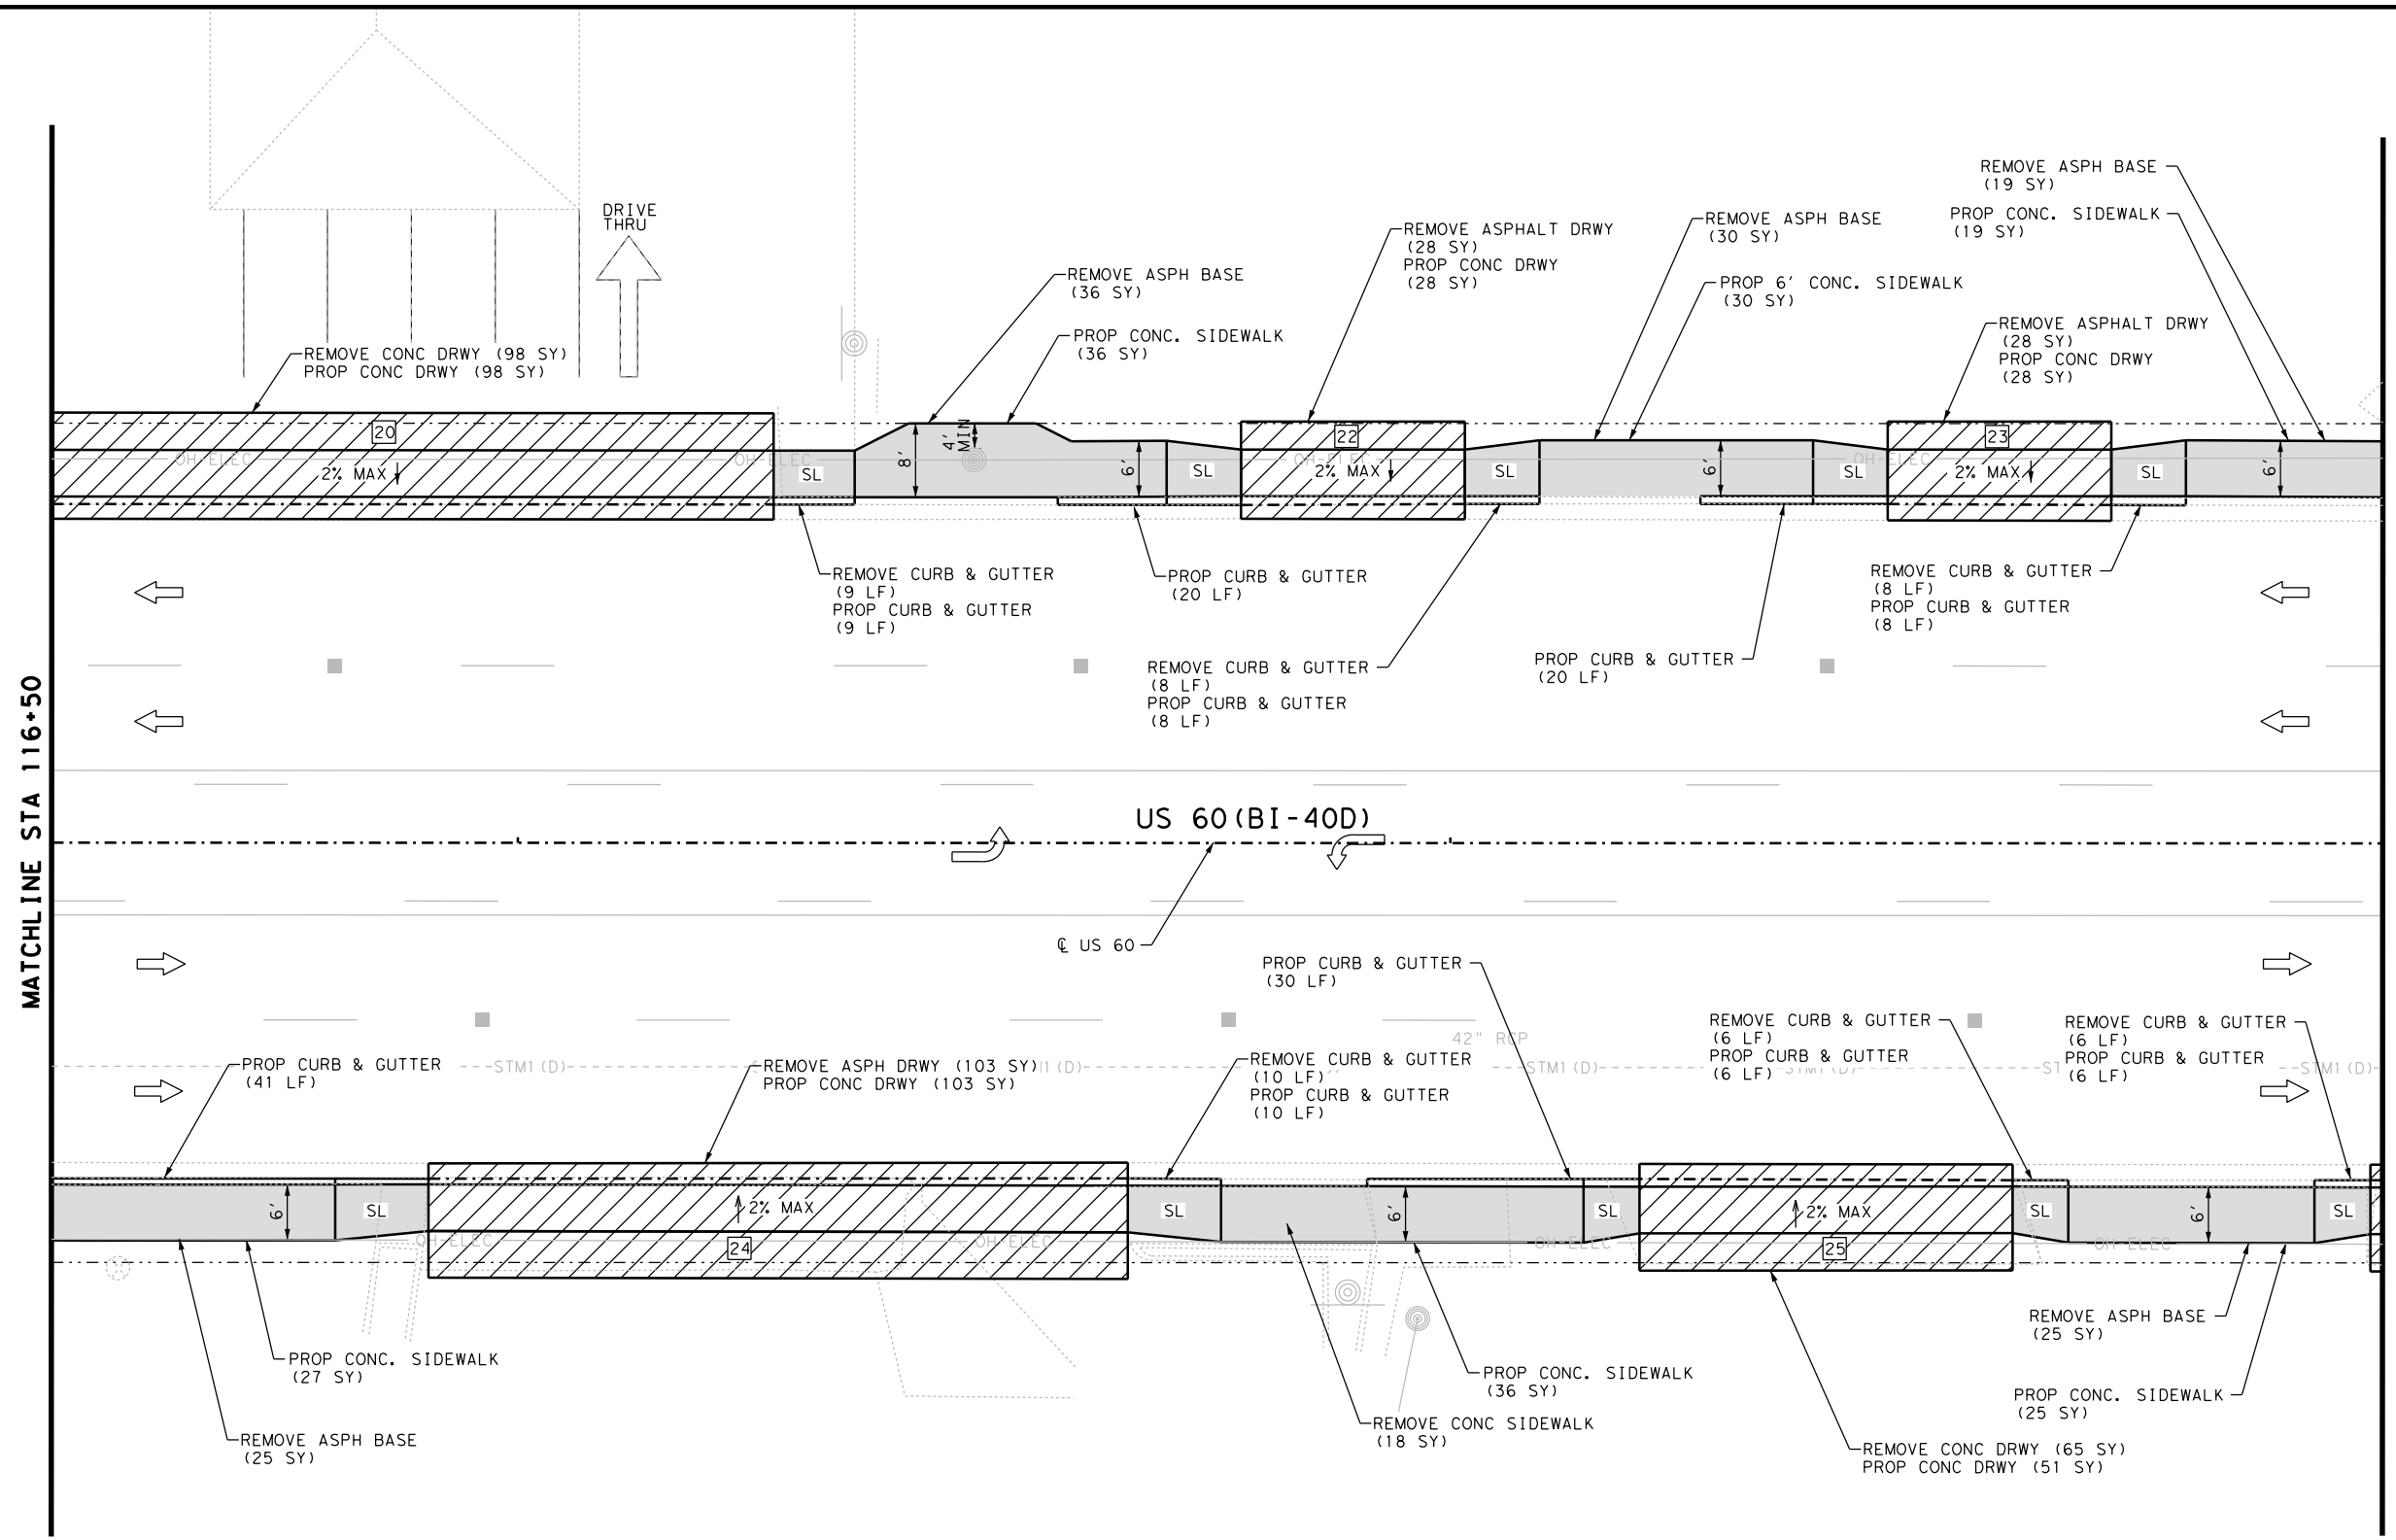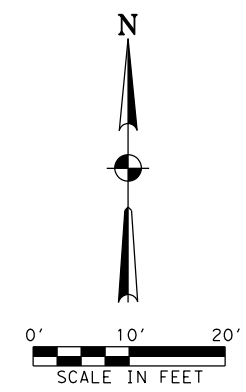

NOTES:
 * FOR CONTRACTOR INFORMATION ONLY
 1. THE EXISTENCE AND LOCATION OF ALL UTILITIES AND DRAINAGE STRUCTURES INDICATED IN THE PLANS ARE TAKEN FROM THE BEST RECORDS AVAILABLE AND ARE NOT GUARANTEED TO BE ACCURATE. CONTRACTOR SHALL COORDINATE WITH ALL UTILITY COMPANIES TO FIELD VERIFY UTILITIES PRIOR TO BEGINNING CONSTRUCTION.

NO.	DATE	REVISION	BY



GLOBAL CIVIL SOLUTIONS, LLC
 11551 FOREST CENTRAL DRIVE
 SUITE 220
 DALLAS, TX 75243
 F-12801



ITEM	DESCRIPTION	UNIT	QTY
0104 6015	REMOVING CONC (SIDEWALKS)	SY	18
0104 6017	REMOVING CONC (DRIVEWAYS)	SY	163
0104 6029	REMOVING CONC (CURB OR CURB & GUTTER)	LF	47
0105 6070	REMOVING STAB BASE & ASPH PAV (6" - 8")	SY	294
0529 6008	CONC CURB & GUTTER (TY II)	LF	156
0530 6004	DRIVEWAYS (CONC)	SY	308
0531 6001	CONC SIDEWALK (4")	SY	173

US 60 (BI 40-D)
SIDEWALK PLAN

STA 116+50 TO STA 119+00

SHEET 8 OF 44



DESIGN	FED. RD. DIV. NO.	FEDERAL AID PROJECT NO.	HIGHWAY NO.
MI	6	(SEE TITLE SHEET)	VARIOUS
GRAPHICS	STATE	DISTRICT	COUNTY
PS	TEXAS	AMA	POTTER
CHECK	CONTROL	SECTION	JOB
MF			
CHECK	CONTROL	SECTION	JOB
FS	0904	02	047

SHEET NO. **036**

LEGEND

- | | | | |
|----------------------------------|---|---------------------|--------------------------|
| PROP SODDING | R RAMP | POWER POLE | IRRIGATION CONTROL VALVE |
| PROP CONC DRWY | L LANDING PAD | TRAFFIC SIGNAL POLE | ELECTRICAL PULL BOX |
| PROP CONC RIPRAP | F FLARE | LIGHT POLE | DRIVEWAY ID |
| PROP RETAINING WALL | SL LONG. SLOPE MAY NOT EXCEED 5% OR ADJACENT ROAD SLOPE | WATER METER | PEDESTRIAN SIGNAL |
| PROP CONC SIDEWALK | T TRANSITION | FIRE HYDRANT | GAS METER |
| EXISTING SIDEWALK/DRWY TO REMAIN | LS LEVEL SIDEWALK (2% MAX) | GUY WIRE | SPRINKLER HEAD |
| | TRAFFIC FLOW | TREE/SHRUB | UTILITY MARKER POST |
| | EXISTING SIGN | FENCE | OVERHEAD ELECTRIC LINE |
| | PROPOSED SIGN | WATER VALVE | |
| | MANHOLE | TRAFFIC SIGNAL BOX | |

P:\Jobs\2020007-Pedestr\110-CA00-V3-SHEETS\047_AM_US_60_ST180F44.dgn 5:18:10 PM 1/27/2022

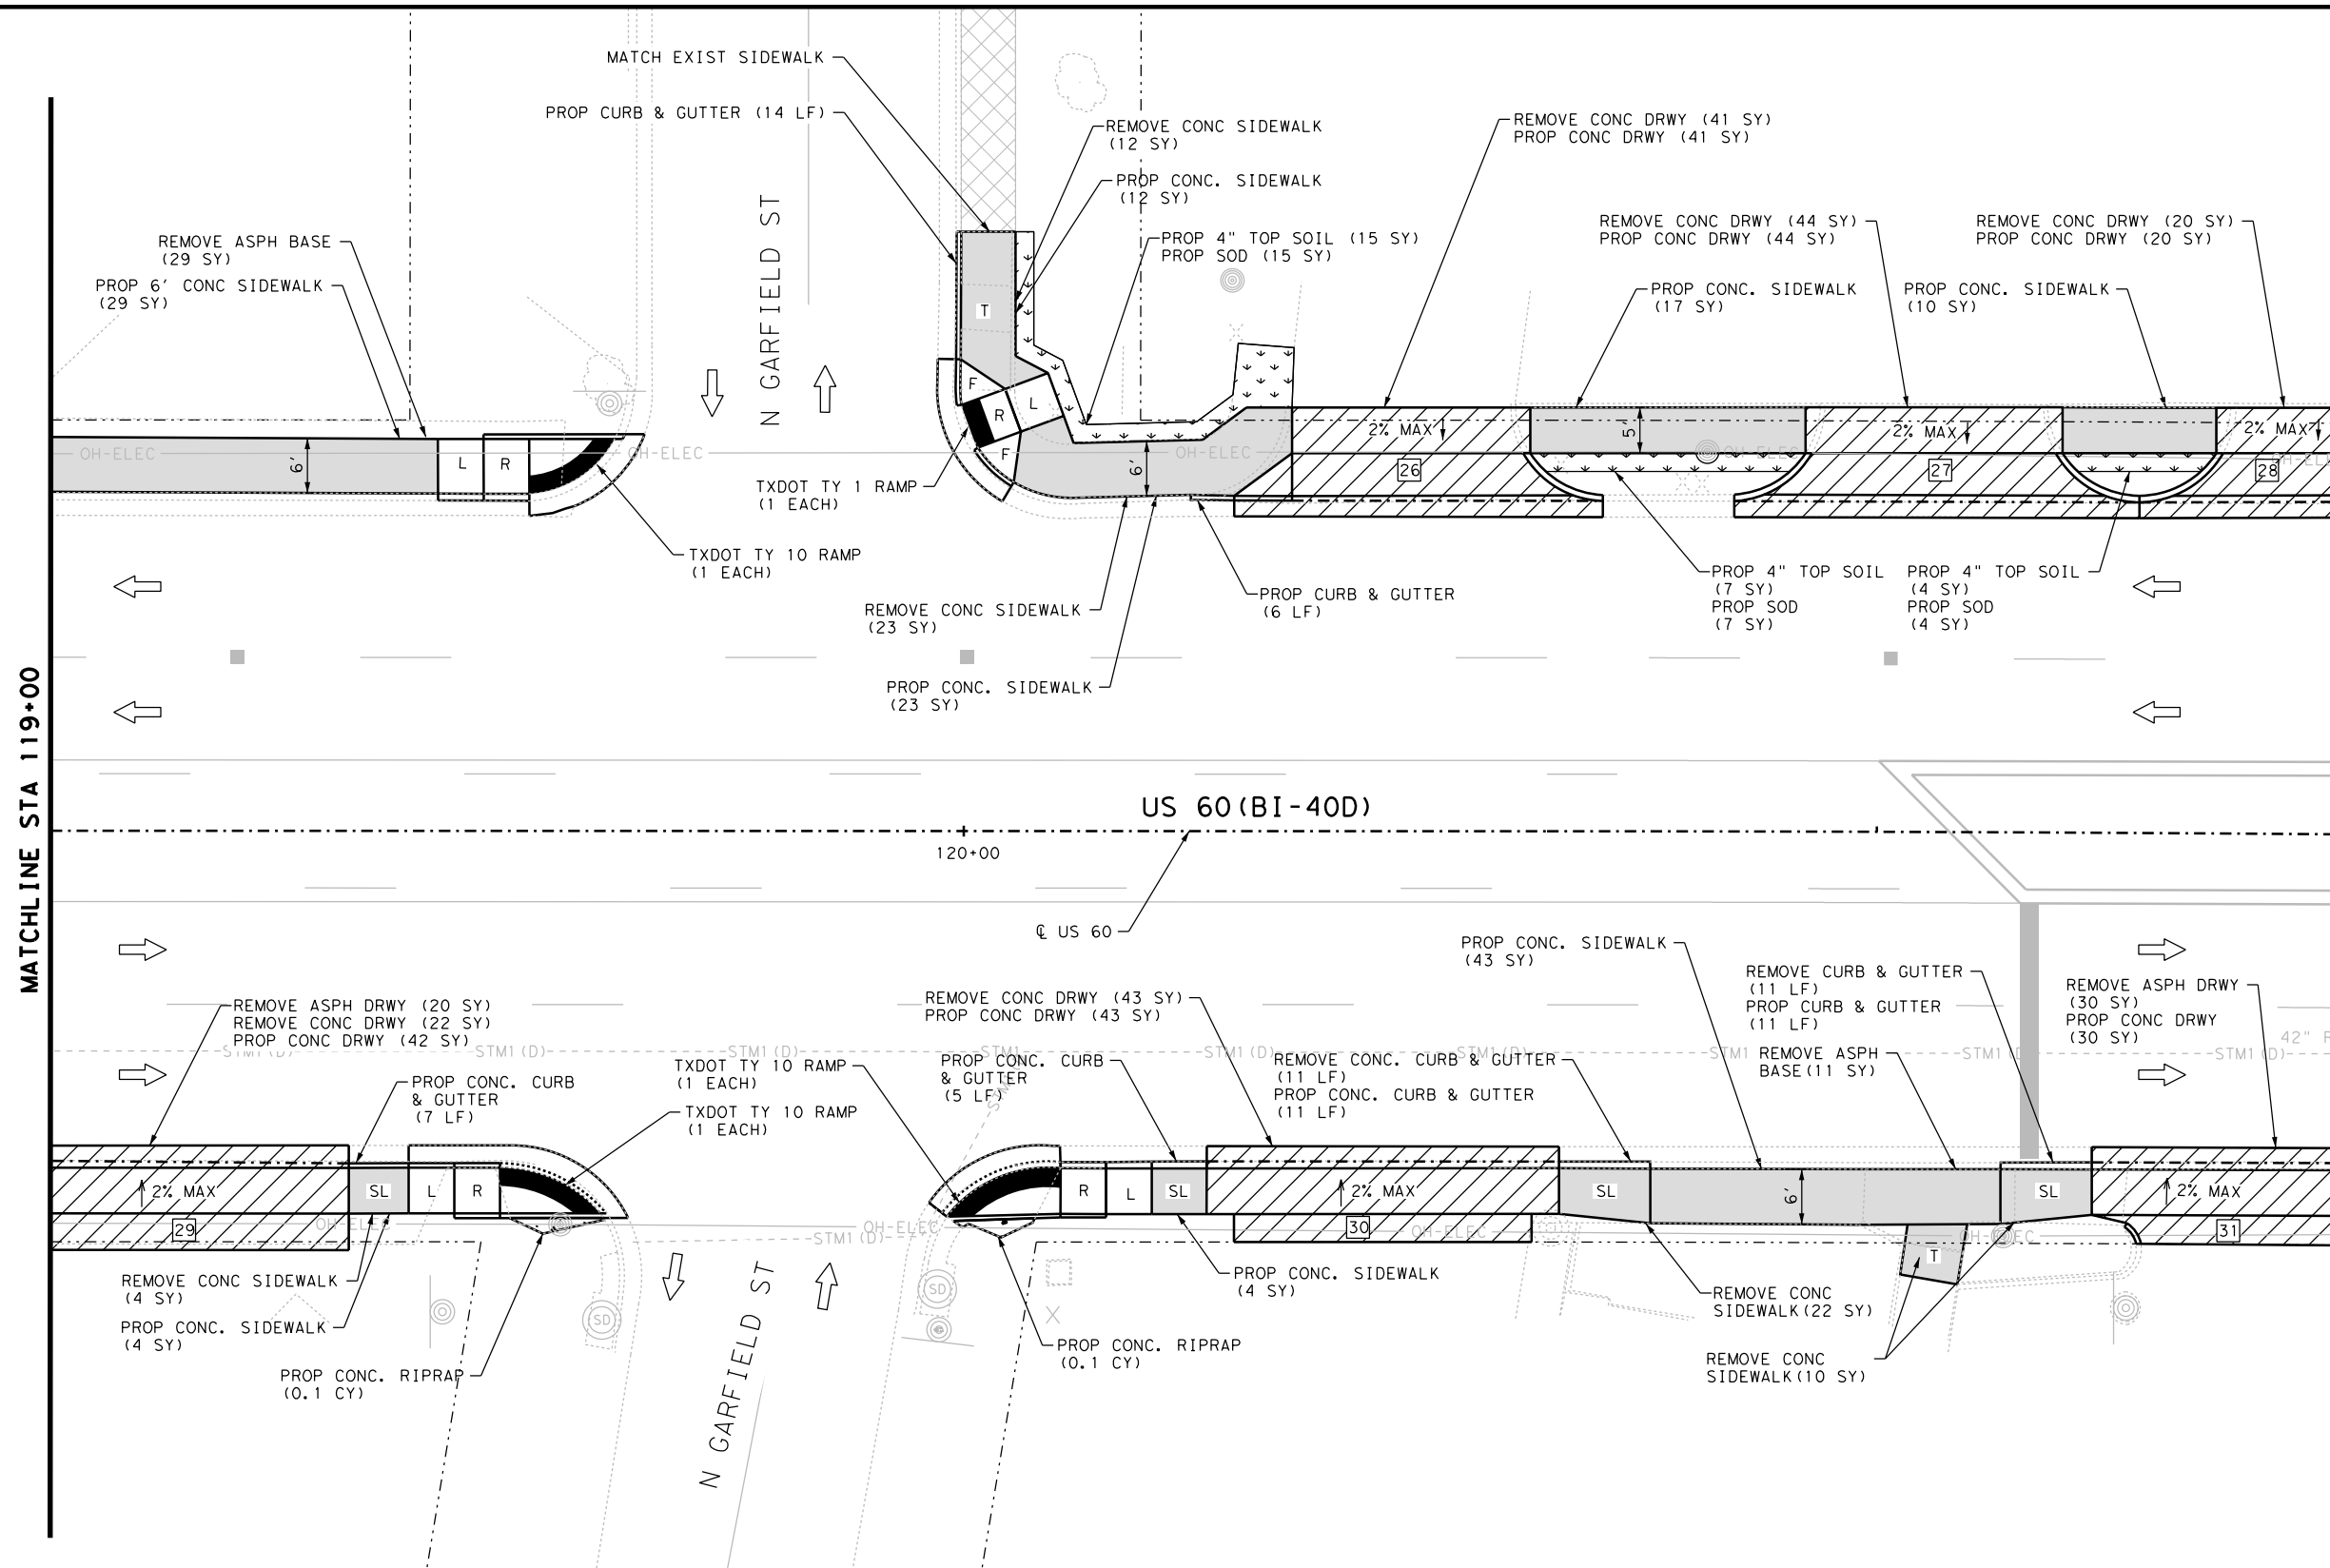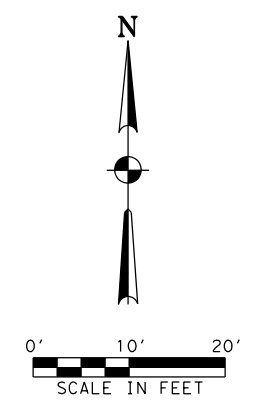


NOTES:
 * FOR CONTRACTOR INFORMATION ONLY
 1. THE EXISTENCE AND LOCATION OF ALL UTILITIES AND DRAINAGE STRUCTURES INDICATED IN THE PLANS ARE TAKEN FROM THE BEST RECORDS AVAILABLE AND ARE NOT GUARANTEED TO BE ACCURATE. CONTRACTOR SHALL COORDINATE WITH ALL UTILITY COMPANIES TO FIELD VERIFY UTILITIES PRIOR TO BEGINNING CONSTRUCTION.

NO.	DATE	REVISION	BY



GLOBAL CIVIL SOLUTIONS, LLC
 11551 FOREST CENTRAL DRIVE
 SUITE 220
 DALLAS, TX 75243
 F-12801

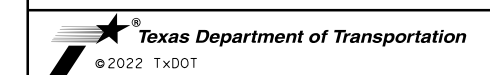

**US 60 (BI 40-D)
 SIDEWALK PLAN**



STA 119+00 TO STA 121+50

SHEET 9 OF 44

LEGEND					
	PROP SODDING	R	RAMP		POWER POLE
	PROP CONC DRWY	L	LANDING PAD		TRAFFIC SIGNAL POLE
	PROP CONC RIPRAP	F	FLARE		LIGHT POLE
	PROP RETAINING WALL	SL	LONG. SLOPE MAY NOT EXCEED 5% OR ADJACENT ROAD SLOPE		WATER METER
	PROP CONC SIDEWALK	T	TRANSITION		FIRE HYDRANT
	EXISTING SIDEWALK/DRWY TO REMAIN	LS	LEVEL SIDEWALK (2% MAX)		GUY WIRE
			TRAFFIC FLOW		TREE/SHRUB
			EXISTING SIGN		FENCE
			PROPOSED SIGN		WATER VALVE
			MANHOLE		TRAFFIC SIGNAL BOX
					IRRIGATION CONTROL VALVE
					ELECTRICAL PULL BOX
					DRIVEWAY ID
					PEDESTRIAN SIGNAL
					GAS METER
					SPRINKLER HEAD
					UTILITY MARKER POST
					OVERHEAD ELECTRIC LINE

ITEM	DESCRIPTION	UNIT	QTY
0104 6015	REMOVING CONC (SIDEWALKS)	SY	71
0104 6017	REMOVING CONC (DRIVEWAYS)	SY	170
0104 6029	REMOVING CONC (CURB OR CURB & GUTTER)	LF	22
0105 6070	REMOVING STAB BASE & ASPH PAV (6" - 8")	SY	90
0160 6003	FURNISHING AND PLACING TOP SOIL (4")	SY	26
0162 6002	BLOCK SODDING	SY	26
0168 6001	VEGETATIVE WATERING	MG	1.0
0432 6001	RIPRAP (CONC) (4 IN)	CY	0.2
0529 6008	CONC CURB & GUTTER (TY II)	LF	54
0530 6004	DRIVEWAYS (CONC)	SY	220
0531 6001	CONC SIDEWALK (4")	SY	142
0531 6004	CURB RAMPS (TY 1)	EA	1
0531 6013	CURB RAMPS (TY 10)	EA	3

P:\Jobs\2020007-Pedestrian-TxDOT\mop1110\CA00\VP3-SHEETS\047_AM_US_60_S190F44.dgn
 5:18:12 PM 1/27/2022

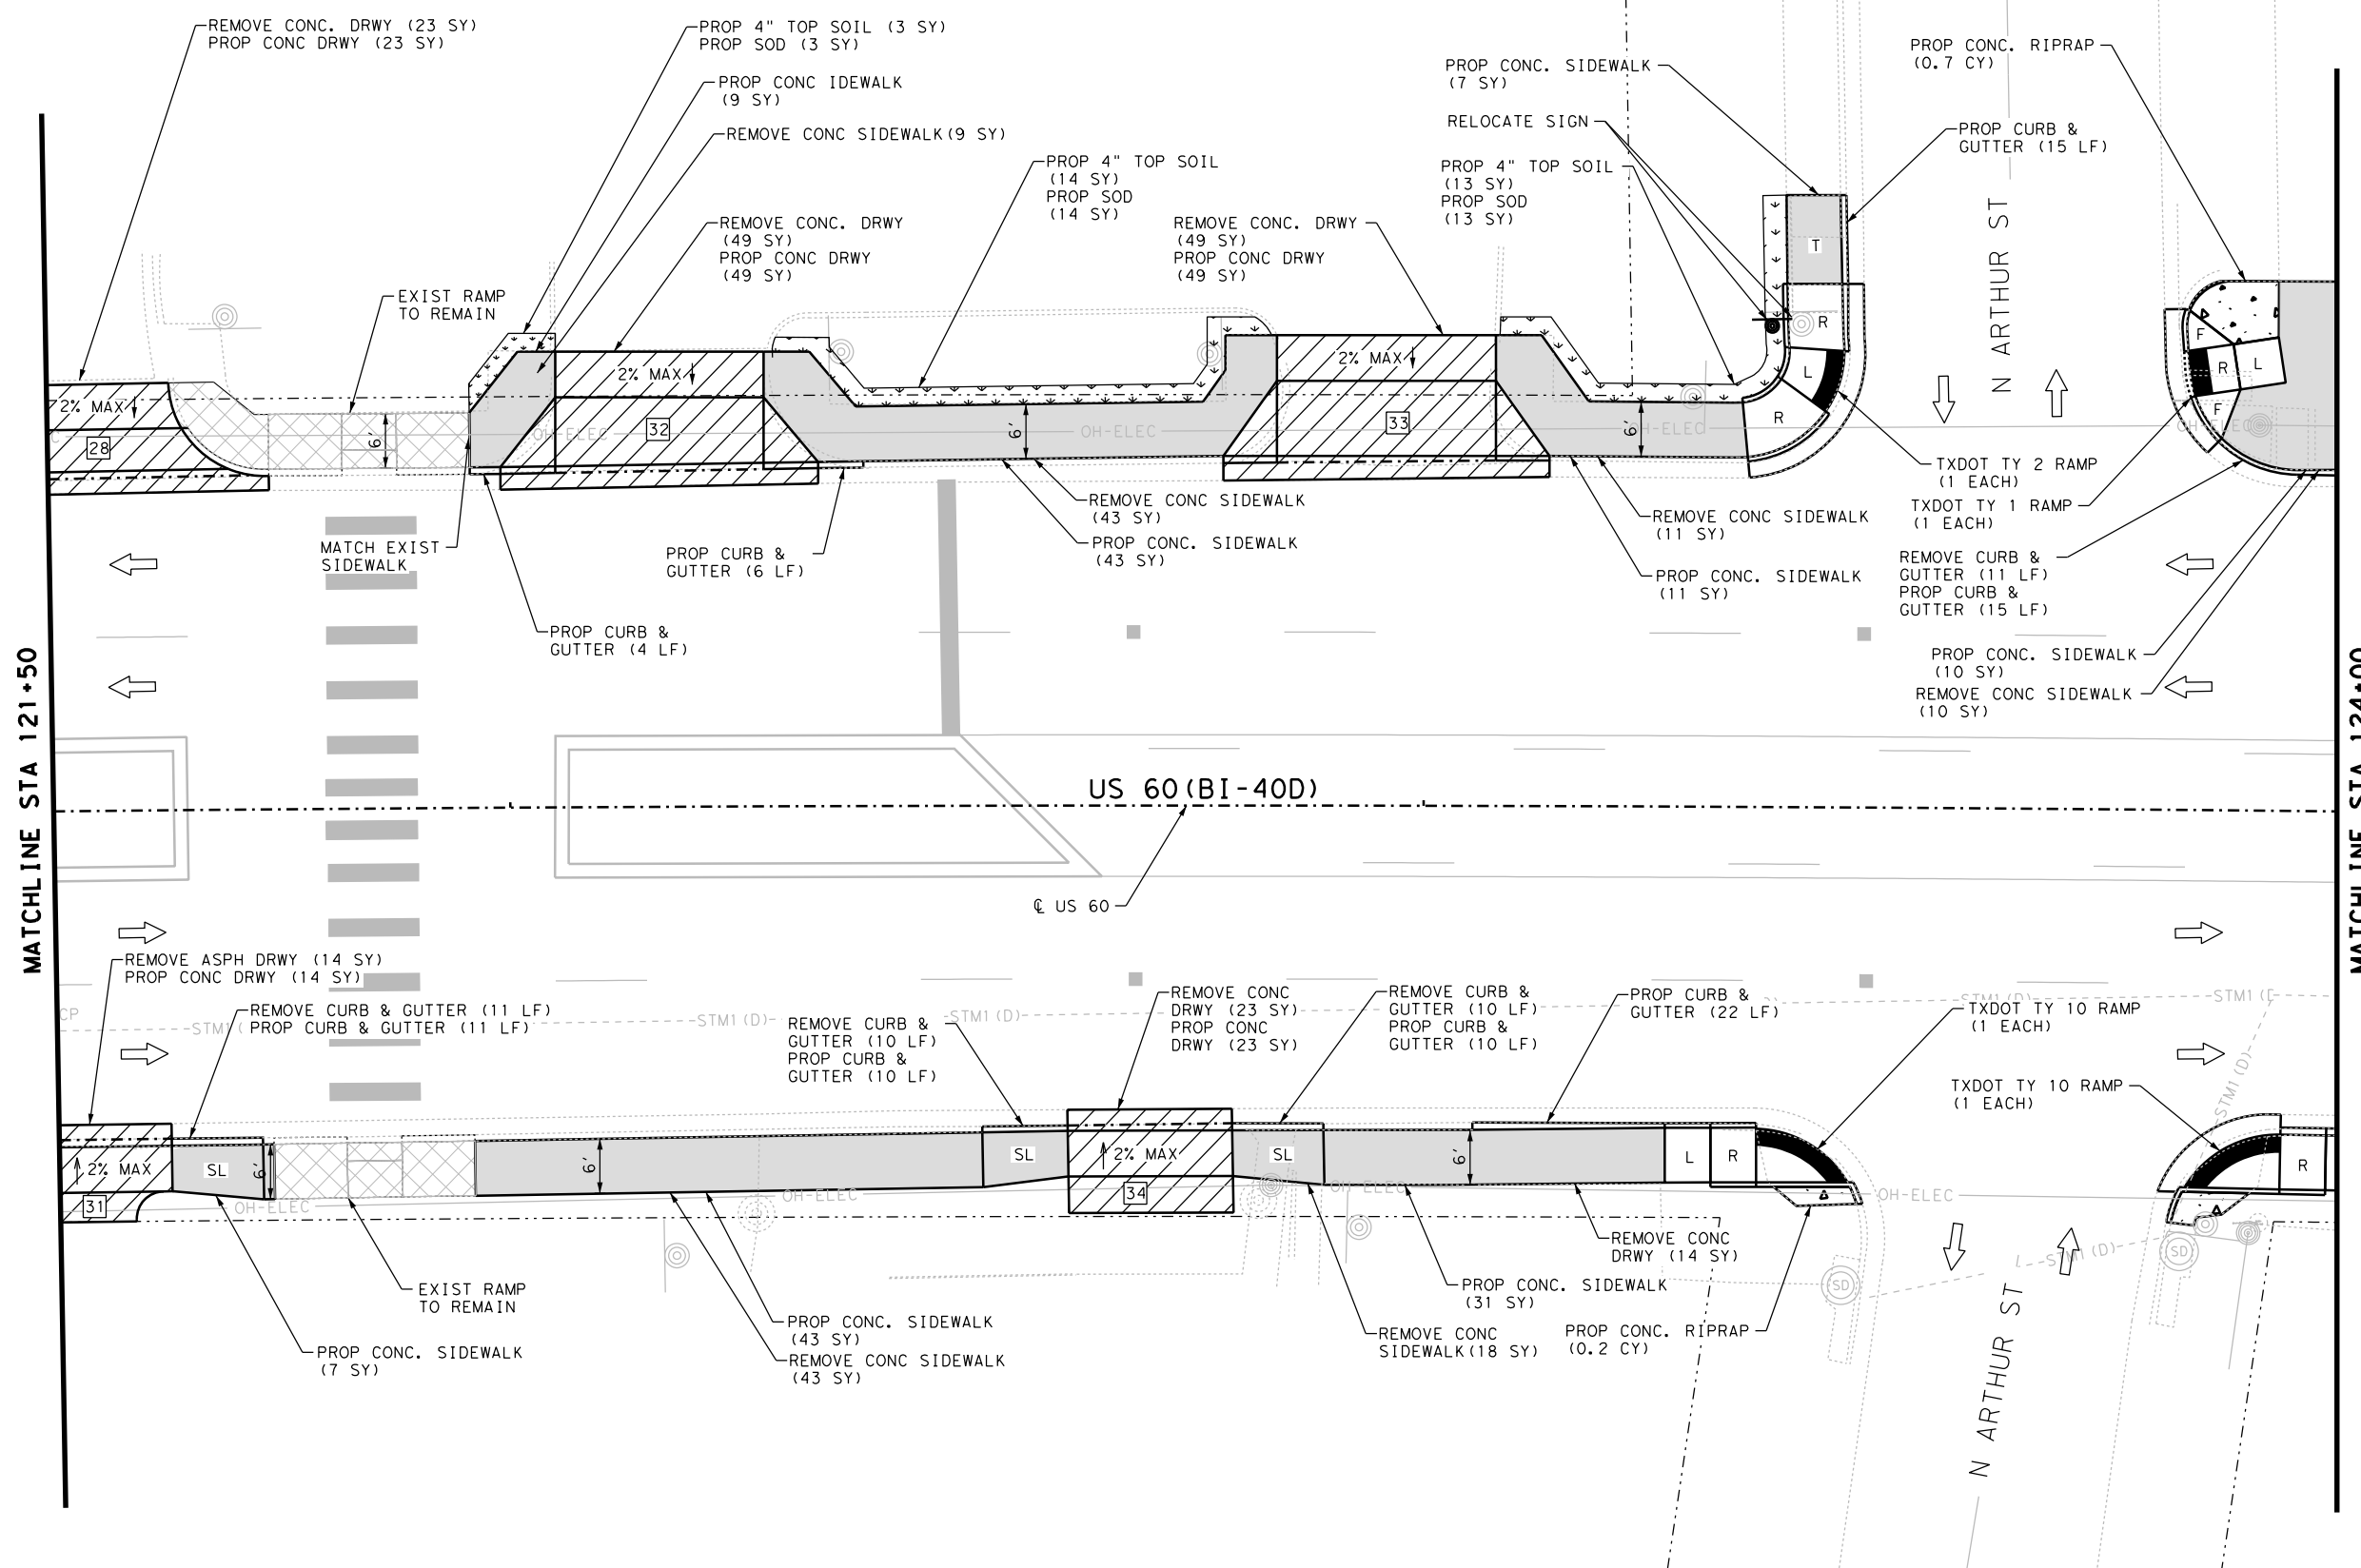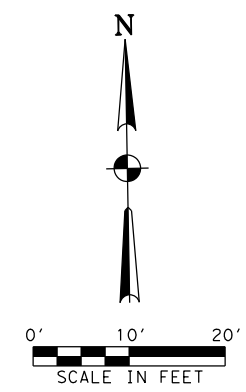

NOTES:
 * FOR CONTRACTOR INFORMATION ONLY
 1. THE EXISTENCE AND LOCATION OF ALL UTILITIES AND DRAINAGE STRUCTURES INDICATED IN THE PLANS ARE TAKEN FROM THE BEST RECORDS AVAILABLE AND ARE NOT GUARANTEED TO BE ACCURATE. CONTRACTOR SHALL COORDINATE WITH ALL UTILITY COMPANIES TO FIELD VERIFY UTILITIES PRIOR TO BEGINNING CONSTRUCTION.

NO.	DATE	REVISION	BY



GLOBAL CIVIL SOLUTIONS, LLC
 11551 FOREST CENTRAL DRIVE
 SUITE 220
 DALLAS, TX 75243
 F-12801



**US 60 (BI 40-D)
 SIDEWALK PLAN**

STA 121+50 TO STA 124+00

SHEET 10 OF 44

DESIGN	FED. RD. DIV. NO.	FEDERAL AID PROJECT NO.	HIGHWAY NO.
MI	6	(SEE TITLE SHEET)	VARIOUS
GRAPHICS	STATE	DISTRICT	COUNTY
PS	TEXAS	AMA	POTTER
CHECK	CONTROL	SECTION	JOB
MF			
CHECK	FS	0904	02 047



038

LEGEND

- | | | | |
|----------------------------------|---|---------------------|--------------------------|
| PROP SODDING | R RAMP | POWER POLE | IRRIGATION CONTROL VALVE |
| PROP CONC DRWY | L LANDING PAD | TRAFFIC SIGNAL POLE | ELECTRICAL PULL BOX |
| PROP CONC RIPRAP | F FLARE | LIGHT POLE | DRIVEWAY ID |
| PROP CONC SIDEWALK | SL LONG. SLOPE MAY NOT EXCEED 5% OR ADJACENT ROAD SLOPE | WATER METER | PEDESTRIAN SIGNAL |
| EXISTING SIDEWALK/DRWY TO REMAIN | T TRANSITION | FIRE HYDRANT | GAS METER |
| | LS LEVEL SIDEWALK (2% MAX) | GUY WIRE | SPRINKLER HEAD |
| | ← TRAFFIC FLOW | TREE/SHRUB | UTILITY MARKER POST |
| | ⊙ EXISTING SIGN | FENCE | OVERHEAD ELECTRIC LINE |
| | ⊙ PROPOSED SIGN | WATER VALVE | |
| | ⊙ MANHOLE | TRAFFIC SIGNAL BOX | |

ITEM	DESCRIPTION	UNIT	QTY
0104 6015	REMOVING CONC (SIDEWALKS)	SY	134
0104 6017	REMOVING CONC (DRIVEWAYS)	SY	156
0104 6029	REMOVING CONC (CURB OR CURB & GUTTER)	LF	42
0105 6070	REMOVING STAB BASE & ASPH PAV (6" - 8")	SY	14
0160 6003	FURNISHING AND PLACING TOP SOIL (4")	SY	30
0162 6002	BLOCK SODDING	SY	30
0168 6001	VEGETATIVE WATERING	MG	1.2
0432 6001	RIPRAP (CONC) (4 IN)	CY	0.9
0529 6008	CONC CURB & GUTTER (TY II)	LF	73
0530 6004	DRIVEWAYS (CONC)	SY	158
0531 6001	CONC SIDEWALK (4")	SY	161
0531 6004	CURB RAMPS (TY 1)	EA	1
0531 6005	CURB RAMPS (TY 2)	EA	2
0531 6013	CURB RAMPS (TY 10)	EA	2
0644 6068	RELOCATE SM RD SN SUP&M TY 10BWG	EA	1

P:\Jobs\2020007-Pedestrian\TXDOT_Amp\1110-CA00\VP3-SHEETS\047_AM_US_60_ST100F44.dgn 5:18:13 PM 1/27/2022

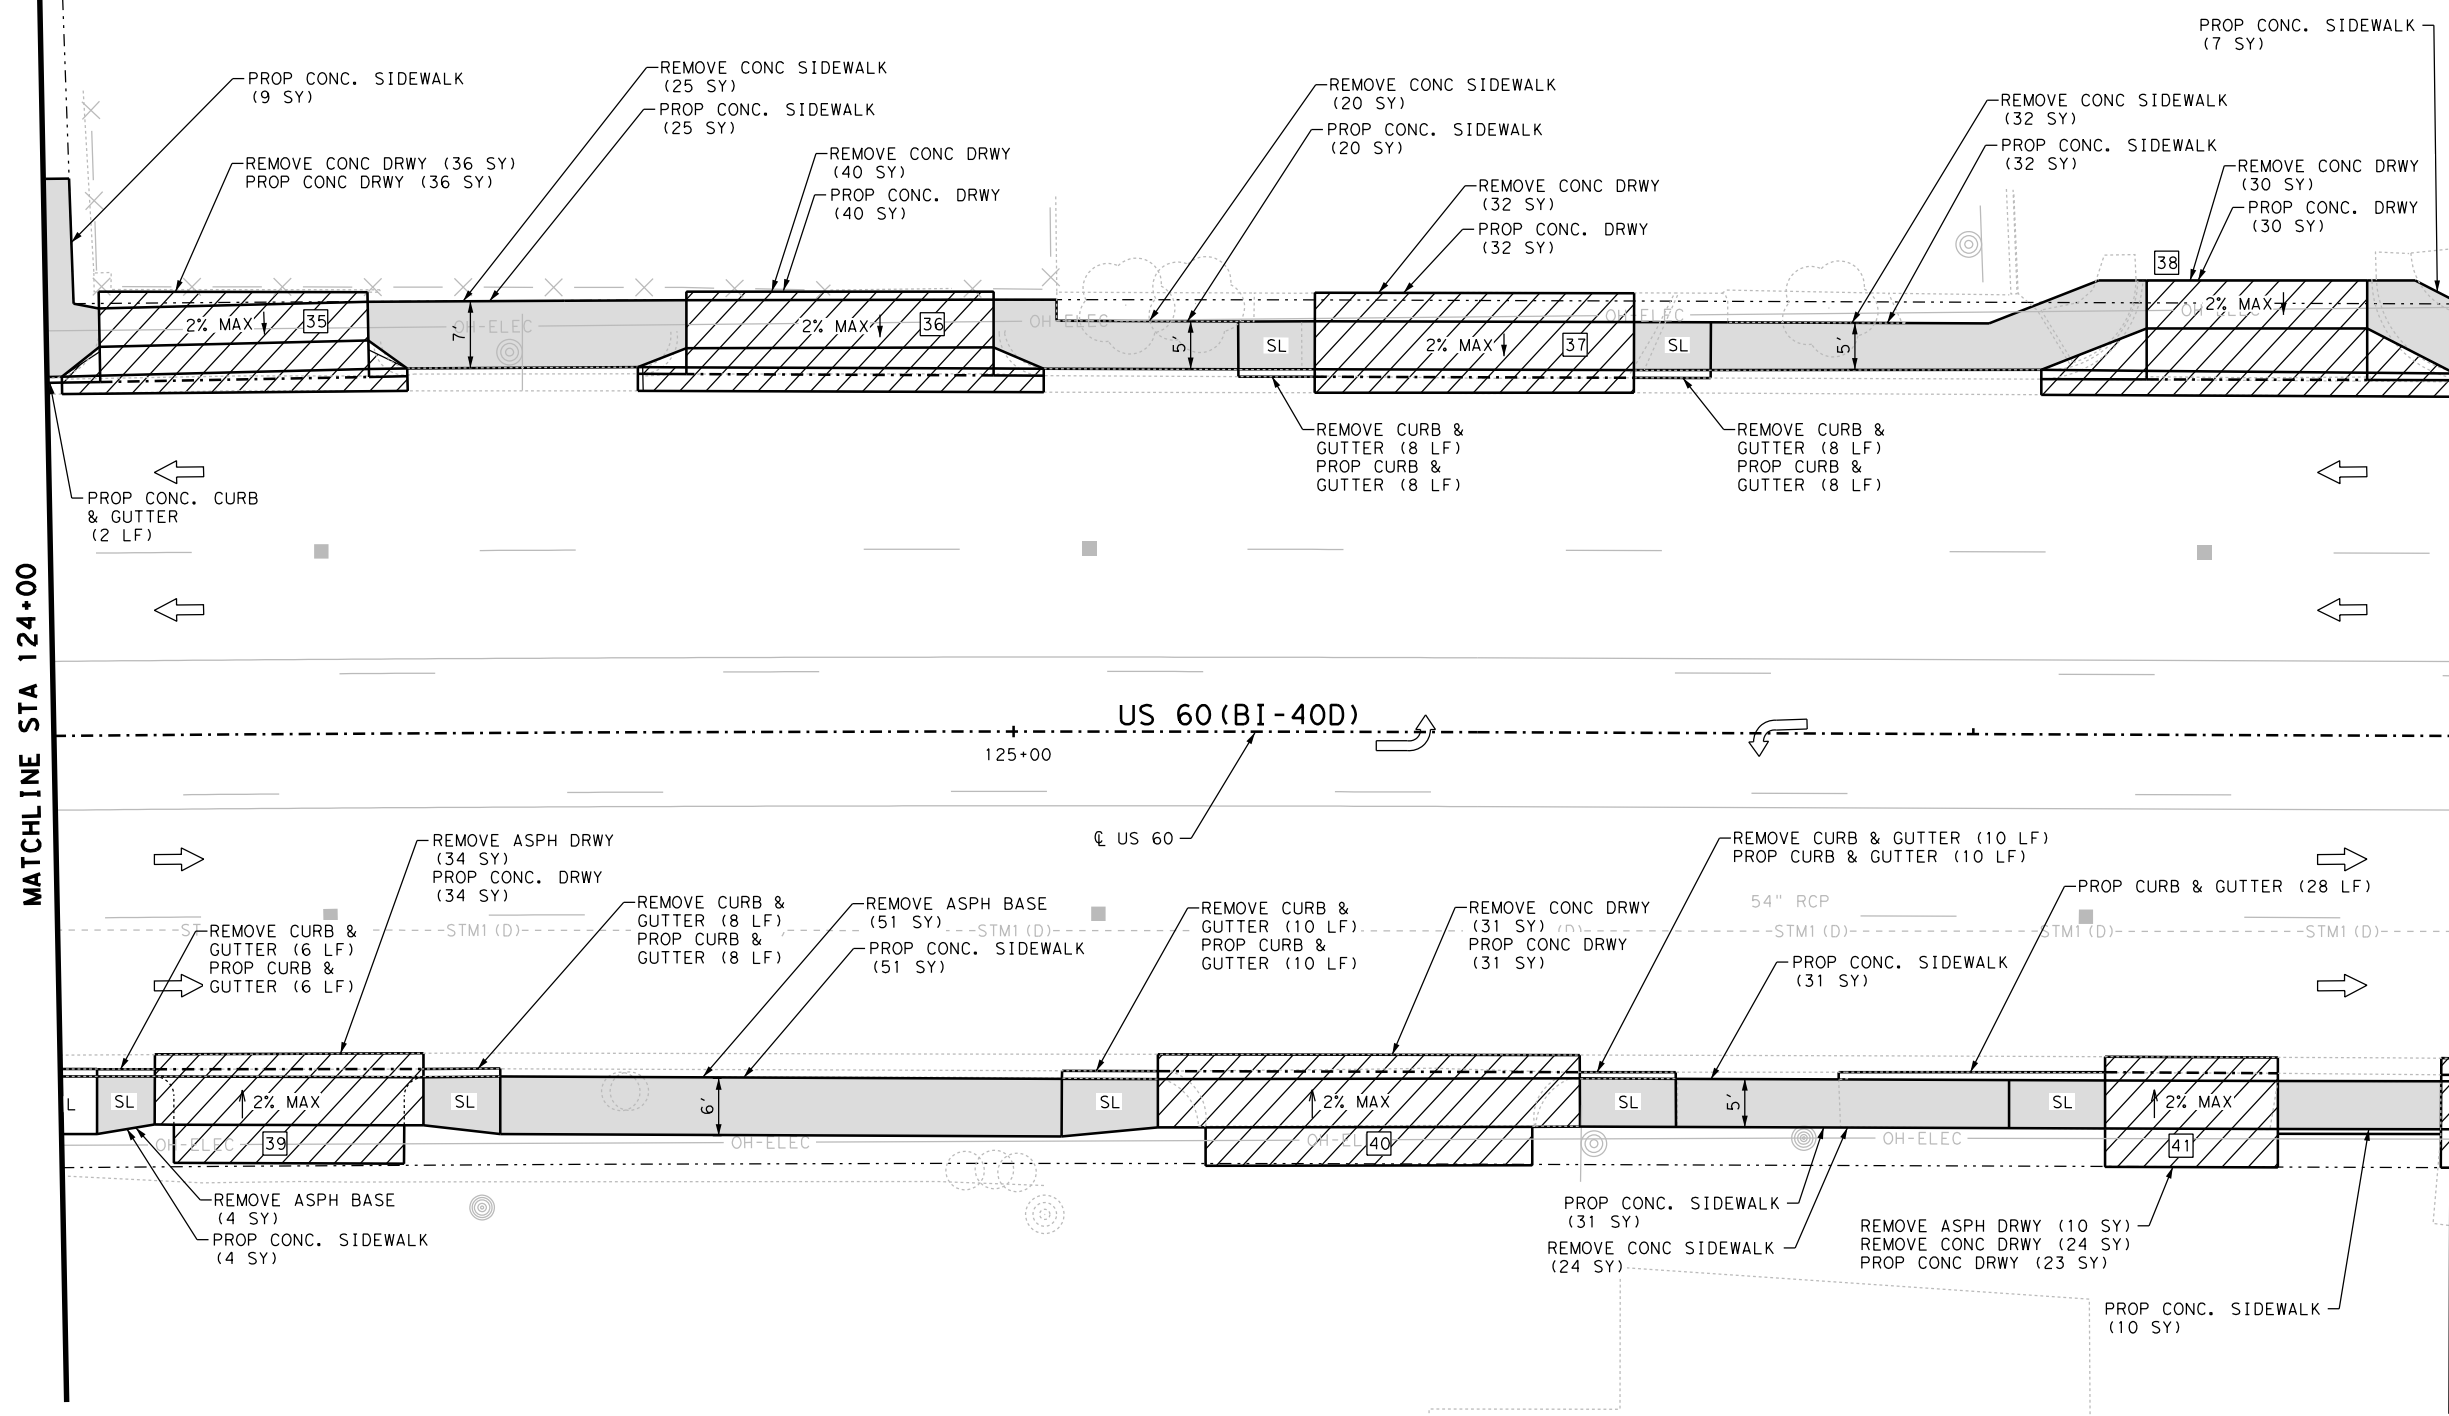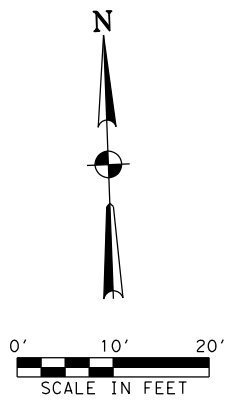

NOTES:
 * FOR CONTRACTOR INFORMATION ONLY
 1. THE EXISTENCE AND LOCATION OF ALL UTILITIES AND DRAINAGE STRUCTURES INDICATED IN THE PLANS ARE TAKEN FROM THE BEST RECORDS AVAILABLE AND ARE NOT GUARANTEED TO BE ACCURATE. CONTRACTOR SHALL COORDINATE WITH ALL UTILITY COMPANIES TO FIELD VERIFY UTILITIES PRIOR TO BEGINNING CONSTRUCTION.

NO.	DATE	REVISION	BY



GLOBAL CIVIL SOLUTIONS, LLC
 11551 FOREST CENTRAL DRIVE
 SUITE 220
 DALLAS, TX 75243
 F-12801



ITEM	DESCRIPTION	UNIT	QTY
0104 6015	REMOVING CONC (SIDEWALKS)	SY	132
0104 6017	REMOVING CONC (DRIVEWAYS)	SY	193
0104 6029	REMOVING CONC (CURB OR CURB & GUTTER)	LF	50
0105 6070	REMOVING STAB BASE & ASPH PAV (6" - 8")	SY	99
0529 6008	CONC CURB & GUTTER (TY II)	LF	78
0530 6004	DRIVEWAYS (CONC)	SY	226
0531 6001	CONC SIDEWALK (4")	SY	180

LEGEND	
	PROP SODDING
	PROP CONC DRWY
	PROP CONC RIPRAP
	PROP RETAINING WALL
	PROP CONC SIDEWALK
	EXISTING SIDEWALK/DRWY TO REMAIN
R	RAMP
L	LANDING PAD
F	FLARE
SL	LONG. SLOPE MAY NOT EXCEED 5% OR ADJACENT ROAD SLOPE
T	TRANSITION
LS	LEVEL SIDEWALK (2% MAX)
	TRAFFIC FLOW
	EXISTING SIGN
	PROPOSED SIGN
	MANHOLE
	POWER POLE
	TRAFFIC SIGNAL POLE
	LIGHT POLE
	WATER METER
	FIRE HYDRANT
	GUY WIRE
	TREE/SHRUB
	FENCE
	WATER VALVE
	TRAFFIC SIGNAL BOX
	IRRIGATION CONTROL VALVE
	ELECTRICAL PULL BOX
	DRIVEWAY ID
	PEDESTRIAN SIGNAL
	GAS METER
	SPRINKLER HEAD
	UTILITY MARKER POST
	OVERHEAD ELECTRIC LINE

US 60 (BI 40-D)
SIDEWALK PLAN



STA 124+00 TO STA 126+50

SHEET 11 OF 44

DESIGN	FED. RD. DIV. NO.	FEDERAL AID PROJECT NO.	HIGHWAY NO.
MI	6	(SEE TITLE SHEET)	VARIOUS
GRAPHICS	STATE	DISTRICT	COUNTY
PS	TEXAS	AMA	POTTER
CHECK	CONTROL	SECTION	JOB
MFM			
CHECK	FS	0904	02 047

SHEET NO. 039

P:\Jobs\202007-Pedestrian\TXDOT_Amor\1110-CA00\VP3-SHEETS\047_AM_US_60_ST110F44.dgn
 5:18:14 PM
 1/27/2022

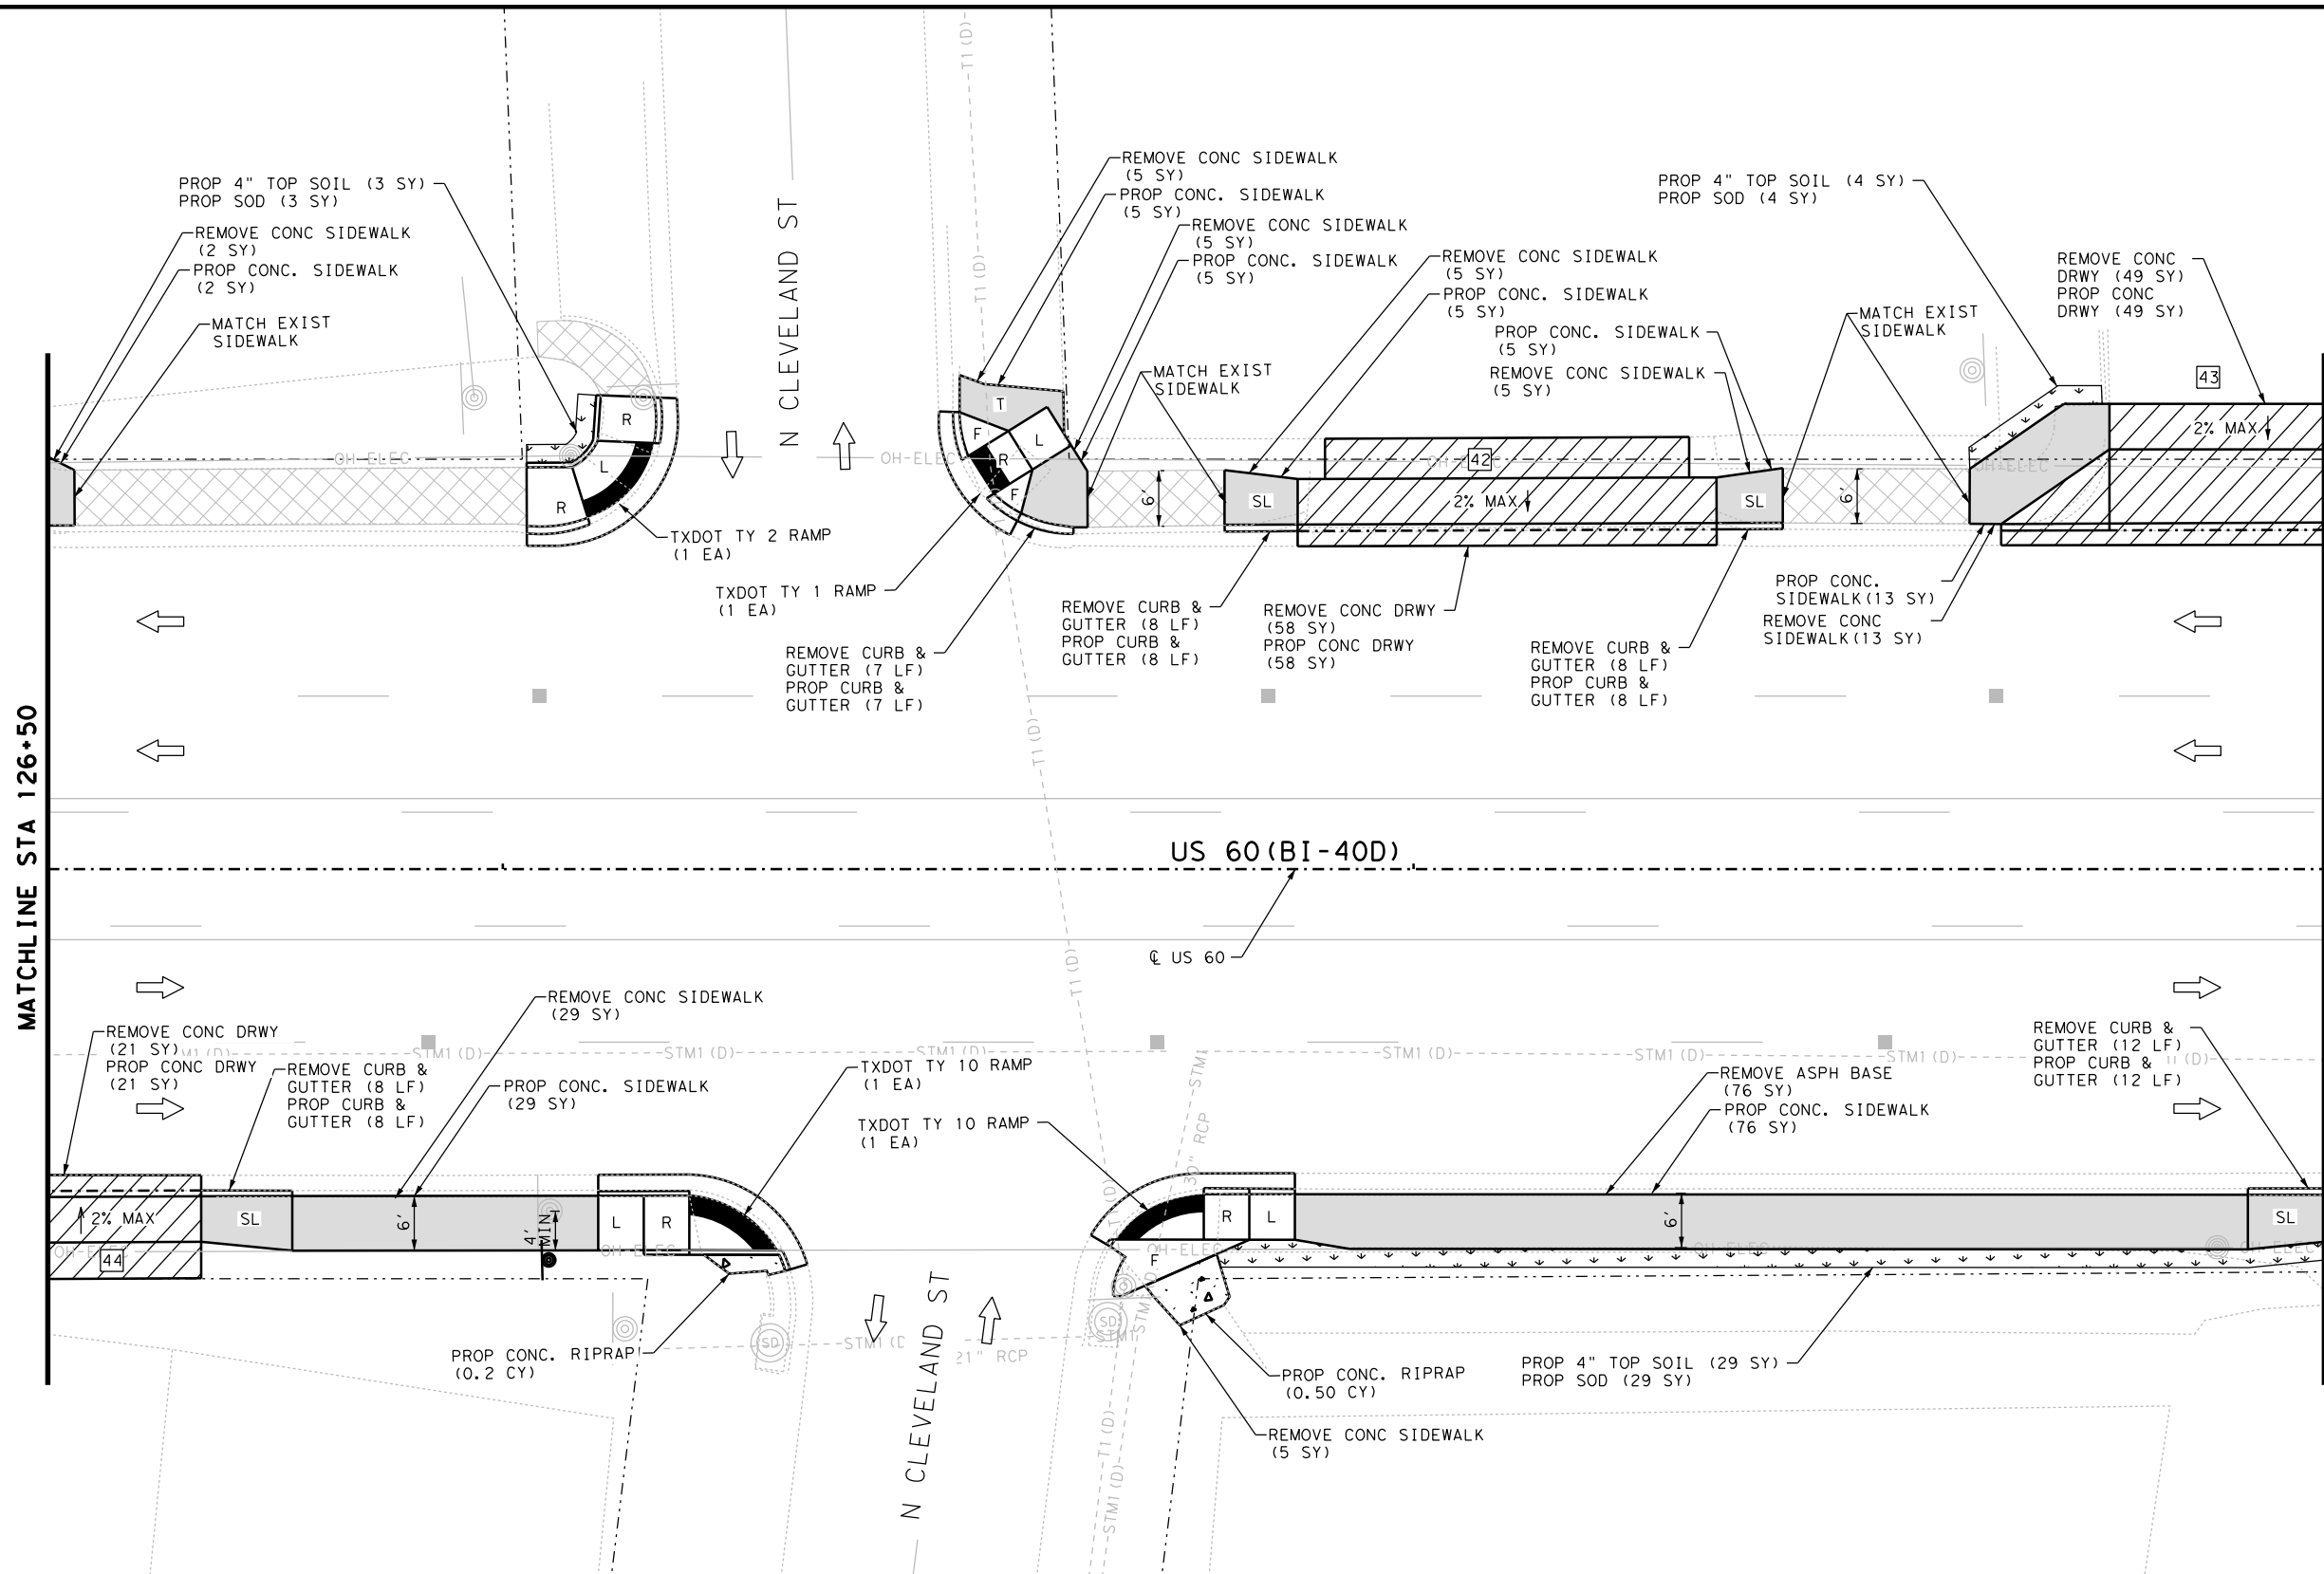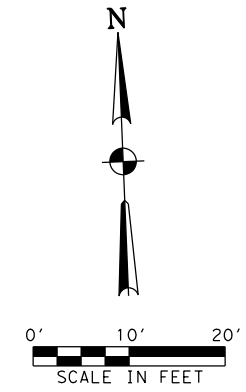

NOTES:

* FOR CONTRACTOR INFORMATION ONLY

1. THE EXISTENCE AND LOCATION OF ALL UTILITIES AND DRAINAGE STRUCTURES INDICATED IN THE PLANS ARE TAKEN FROM THE BEST RECORDS AVAILABLE AND ARE NOT GUARANTEED TO BE ACCURATE. CONTRACTOR SHALL COORDINATE WITH ALL UTILITY COMPANIES TO FIELD VERIFY UTILITIES PRIOR TO BEGINNING CONSTRUCTION.

NO.	DATE	REVISION	BY



GLOBAL CIVIL SOLUTIONS, LLC
 11551 FOREST CENTRAL DRIVE
 SUITE 220
 DALLAS, TX 75243
 F-12801



US 60 (BI 40-D)
SIDEWALK PLAN

STA 126+50 TO STA 129+00

SHEET 12 OF 44

DESIGN	FED. RD. DIV. NO.	FEDERAL AID PROJECT NO.	HIGHWAY NO.
MI	6	(SEE TITLE SHEET)	VARIOUS
GRAPHICS	STATE	DISTRICT	COUNTY
PS	TEXAS	AMA	POTTER
CHECK	CONTROL	SECTION	JOB
MF	0904	02	047
CHECK	FS		



040

LEGEND

- | | | | |
|----------------------------------|---|---------------------|--------------------------|
| PROP SODDING | R RAMP | POWER POLE | IRRIGATION CONTROL VALVE |
| PROP CONC DRWY | L LANDING PAD | TRAFFIC SIGNAL POLE | ELECTRICAL PULL BOX |
| PROP CONC RIPRAP | F FLARE | LIGHT POLE | DRIVEWAY ID |
| PROP RETAINING WALL | SL LONG. SLOPE MAY NOT EXCEED 5% OR ADJACENT ROAD SLOPE | WATER METER | PEDESTRIAN SIGNAL |
| PROP CONC SIDEWALK | T TRANSITION | FIRE HYDRANT | GAS METER |
| EXISTING SIDEWALK/DRWY TO REMAIN | LS LEVEL SIDEWALK (2% MAX) | GUY WIRE | SPRINKLER HEAD |
| | TRAFFIC FLOW | TREE/SHRUB | UTILITY MARKER POST |
| | EXISTING SIGN | FENCE | OVERHEAD ELECTRIC LINE |
| | PROPOSED SIGN | WATER VALVE | |
| | MANHOLE | TRAFFIC SIGNAL BOX | |

ITEM	DESCRIPTION	UNIT	QTY
0104 6015	REMOVING CONC (SIDEWALKS)	SY	69
0104 6017	REMOVING CONC (DRIVEWAYS)	SY	128
0104 6029	REMOVING CONC (CURB OR CURB & GUTTER)	LF	43
0105 6070	REMOVING STAB BASE & ASPH PAV (6" - 8")	SY	76
0160 6003	FURNISHING AND PLACING TOP SOIL (4")	SY	36
0162 6002	BLOCK SODDING	SY	36
0168 6001	VEGETATIVE WATERING	MG	1.4
0432 6001	RIPRAP (CONC) (4 IN)	CY	0.7
0529 6008	CONC CURB & GUTTER (TY II)	LF	43
0530 6004	DRIVEWAYS (CONC)	SY	128
0531 6001	CONC SIDEWALK (4")	SY	140
0531 6004	CURB RAMPS (TY 1)	EA	1
0531 6005	CURB RAMPS (TY 2)	EA	1
0531 6013	CURB RAMPS (TY 10)	EA	2

P:\Jobs\2020007-Pedestrian\TXDOT\Amor\1110\CA00\VP3\SHEETS\047_AM_US_60_ST120F44.dgn
 5:18:16 PM 1/27/2022

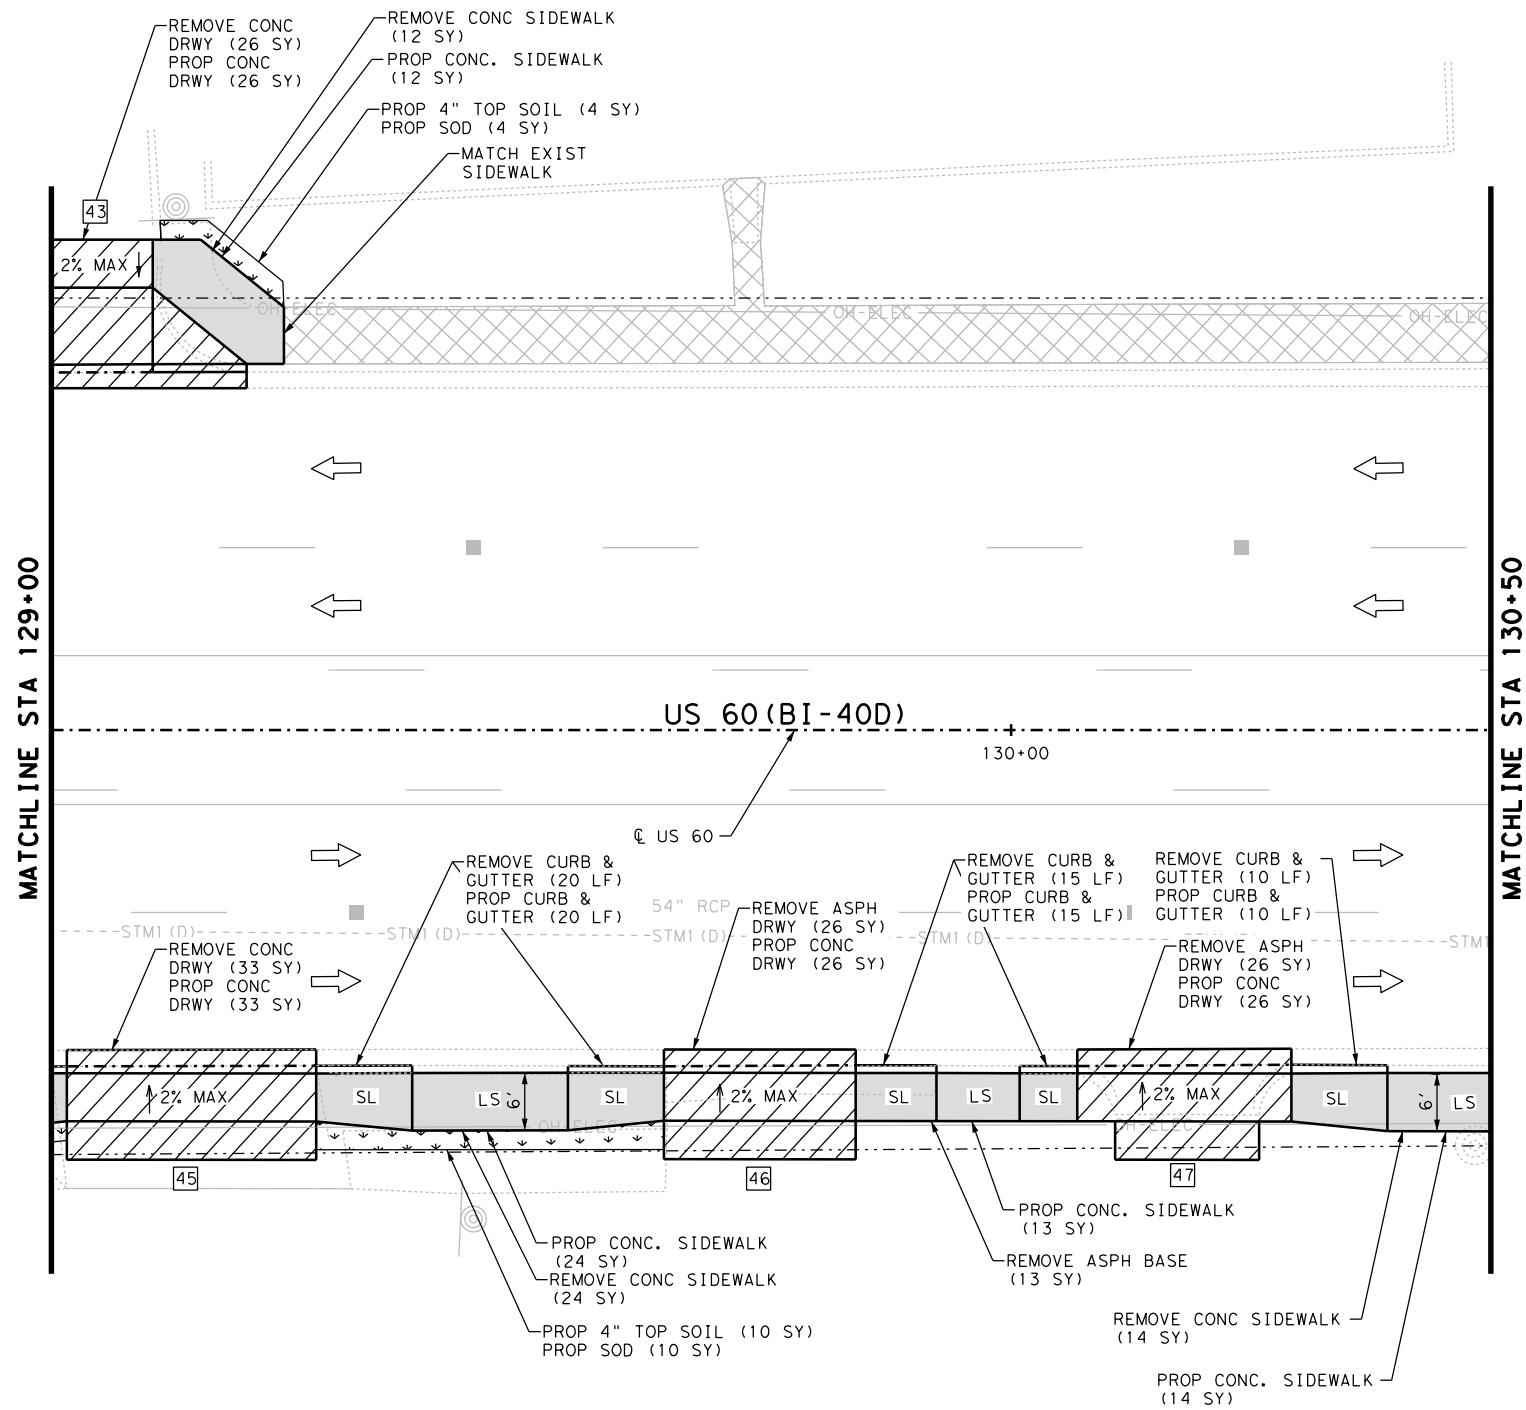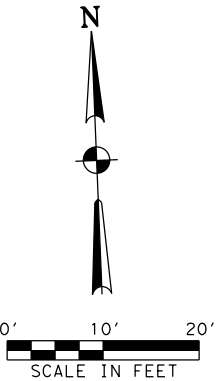

NOTES:

* FOR CONTRACTOR INFORMATION ONLY

1. THE EXISTENCE AND LOCATION OF ALL UTILITIES AND DRAINAGE STRUCTURES INDICATED IN THE PLANS ARE TAKEN FROM THE BEST RECORDS AVAILABLE AND ARE NOT GUARANTEED TO BE ACCURATE. CONTRACTOR SHALL COORDINATE WITH ALL UTILITY COMPANIES TO FIELD VERIFY UTILITIES PRIOR TO BEGINNING CONSTRUCTION.

NO.	DATE	REVISION	BY



GLOBAL CIVIL SOLUTIONS, LLC
 11551 FOREST CENTRAL DRIVE
 SUITE 220
 DALLAS, TX 75243
 F-12801



ITEM	DESCRIPTION	UNIT	QTY
0104 6015	REMOVING CONC (SIDEWALKS)	SY	50
0104 6017	REMOVING CONC (DRIVEWAYS)	SY	59
0104 6029	REMOVING CONC (CURB OR CURB & GUTTER)	LF	45
0105 6070	REMOVING STAB BASE & ASPH PAV (6" - 8")	SY	65
0160 6003	FURNISHING AND PLACING TOP SOIL (4")	SY	14
0162 6002	BLOCK SODDING	SY	14
0168 6001	VEGETATIVE WATERING	MG	0.6
0529 6008	CONC CURB & GUTTER (TY II)	LF	45
0530 6004	DRIVEWAYS (CONC)	SY	111
0531 6001	CONC SIDEWALK (4")	SY	63

US 60 (BI 40-D)
SIDEWALK PLAN

STA 129+00 TO STA 130+50



SHEET 13 OF 44

DESIGN	FED. RD. DIV. NO.	FEDERAL AID PROJECT NO.	HIGHWAY NO.
MI	6	(SEE TITLE SHEET)	VARIOUS
GRAPHICS	STATE	DISTRICT	COUNTY
PS	TEXAS	AMA	POTTER
CHECK	CONTROL	SECTION	JOB
MF			
CHECK	CONTROL	SECTION	JOB
FS	0904	02	047

SHEET NO. 041

LEGEND			
	PROP SODDING	R	RAMP
	PROP CONC DRWY	L	LANDING PAD
	PROP CONC RIPRAP	F	FLARE
	PROP RETAINING WALL	SL	LONG. SLOPE MAY NOT EXCEED 5% OR ADJACENT ROAD SLOPE
	PROP CONC SIDEWALK	T	TRANSITION
	EXISTING SIDEWALK/DRWY TO REMAIN	LS	LEVEL SIDEWALK (2% MAX)
			TRAFFIC FLOW
			EXISTING SIGN
			PROPOSED SIGN
			MANHOLE
	POWER POLE		TRAFFIC SIGNAL POLE
	TRAFFIC SIGNAL POLE		LIGHT POLE
	WATER METER		FIRE HYDRANT
	GUY WIRE		TREE/SHRUB
	FENCE		WATER VALVE
	TRAFFIC SIGNAL BOX		IRRIGATION CONTROL VALVE
			ELECTRICAL PULL BOX
			DRIVEWAY ID
			PEDESTRIAN SIGNAL
			GAS METER
			SPRINKLER HEAD
			UTILITY MARKER POST
			OVERHEAD ELECTRIC LINE

P:\Jobs\202007-Pedestrian\TxDOT\Amor\1110\CA00\PS\SHEETS\047_AM_US_60_ST130F44.dgn
 5:18:17 PM
 1/27/2022

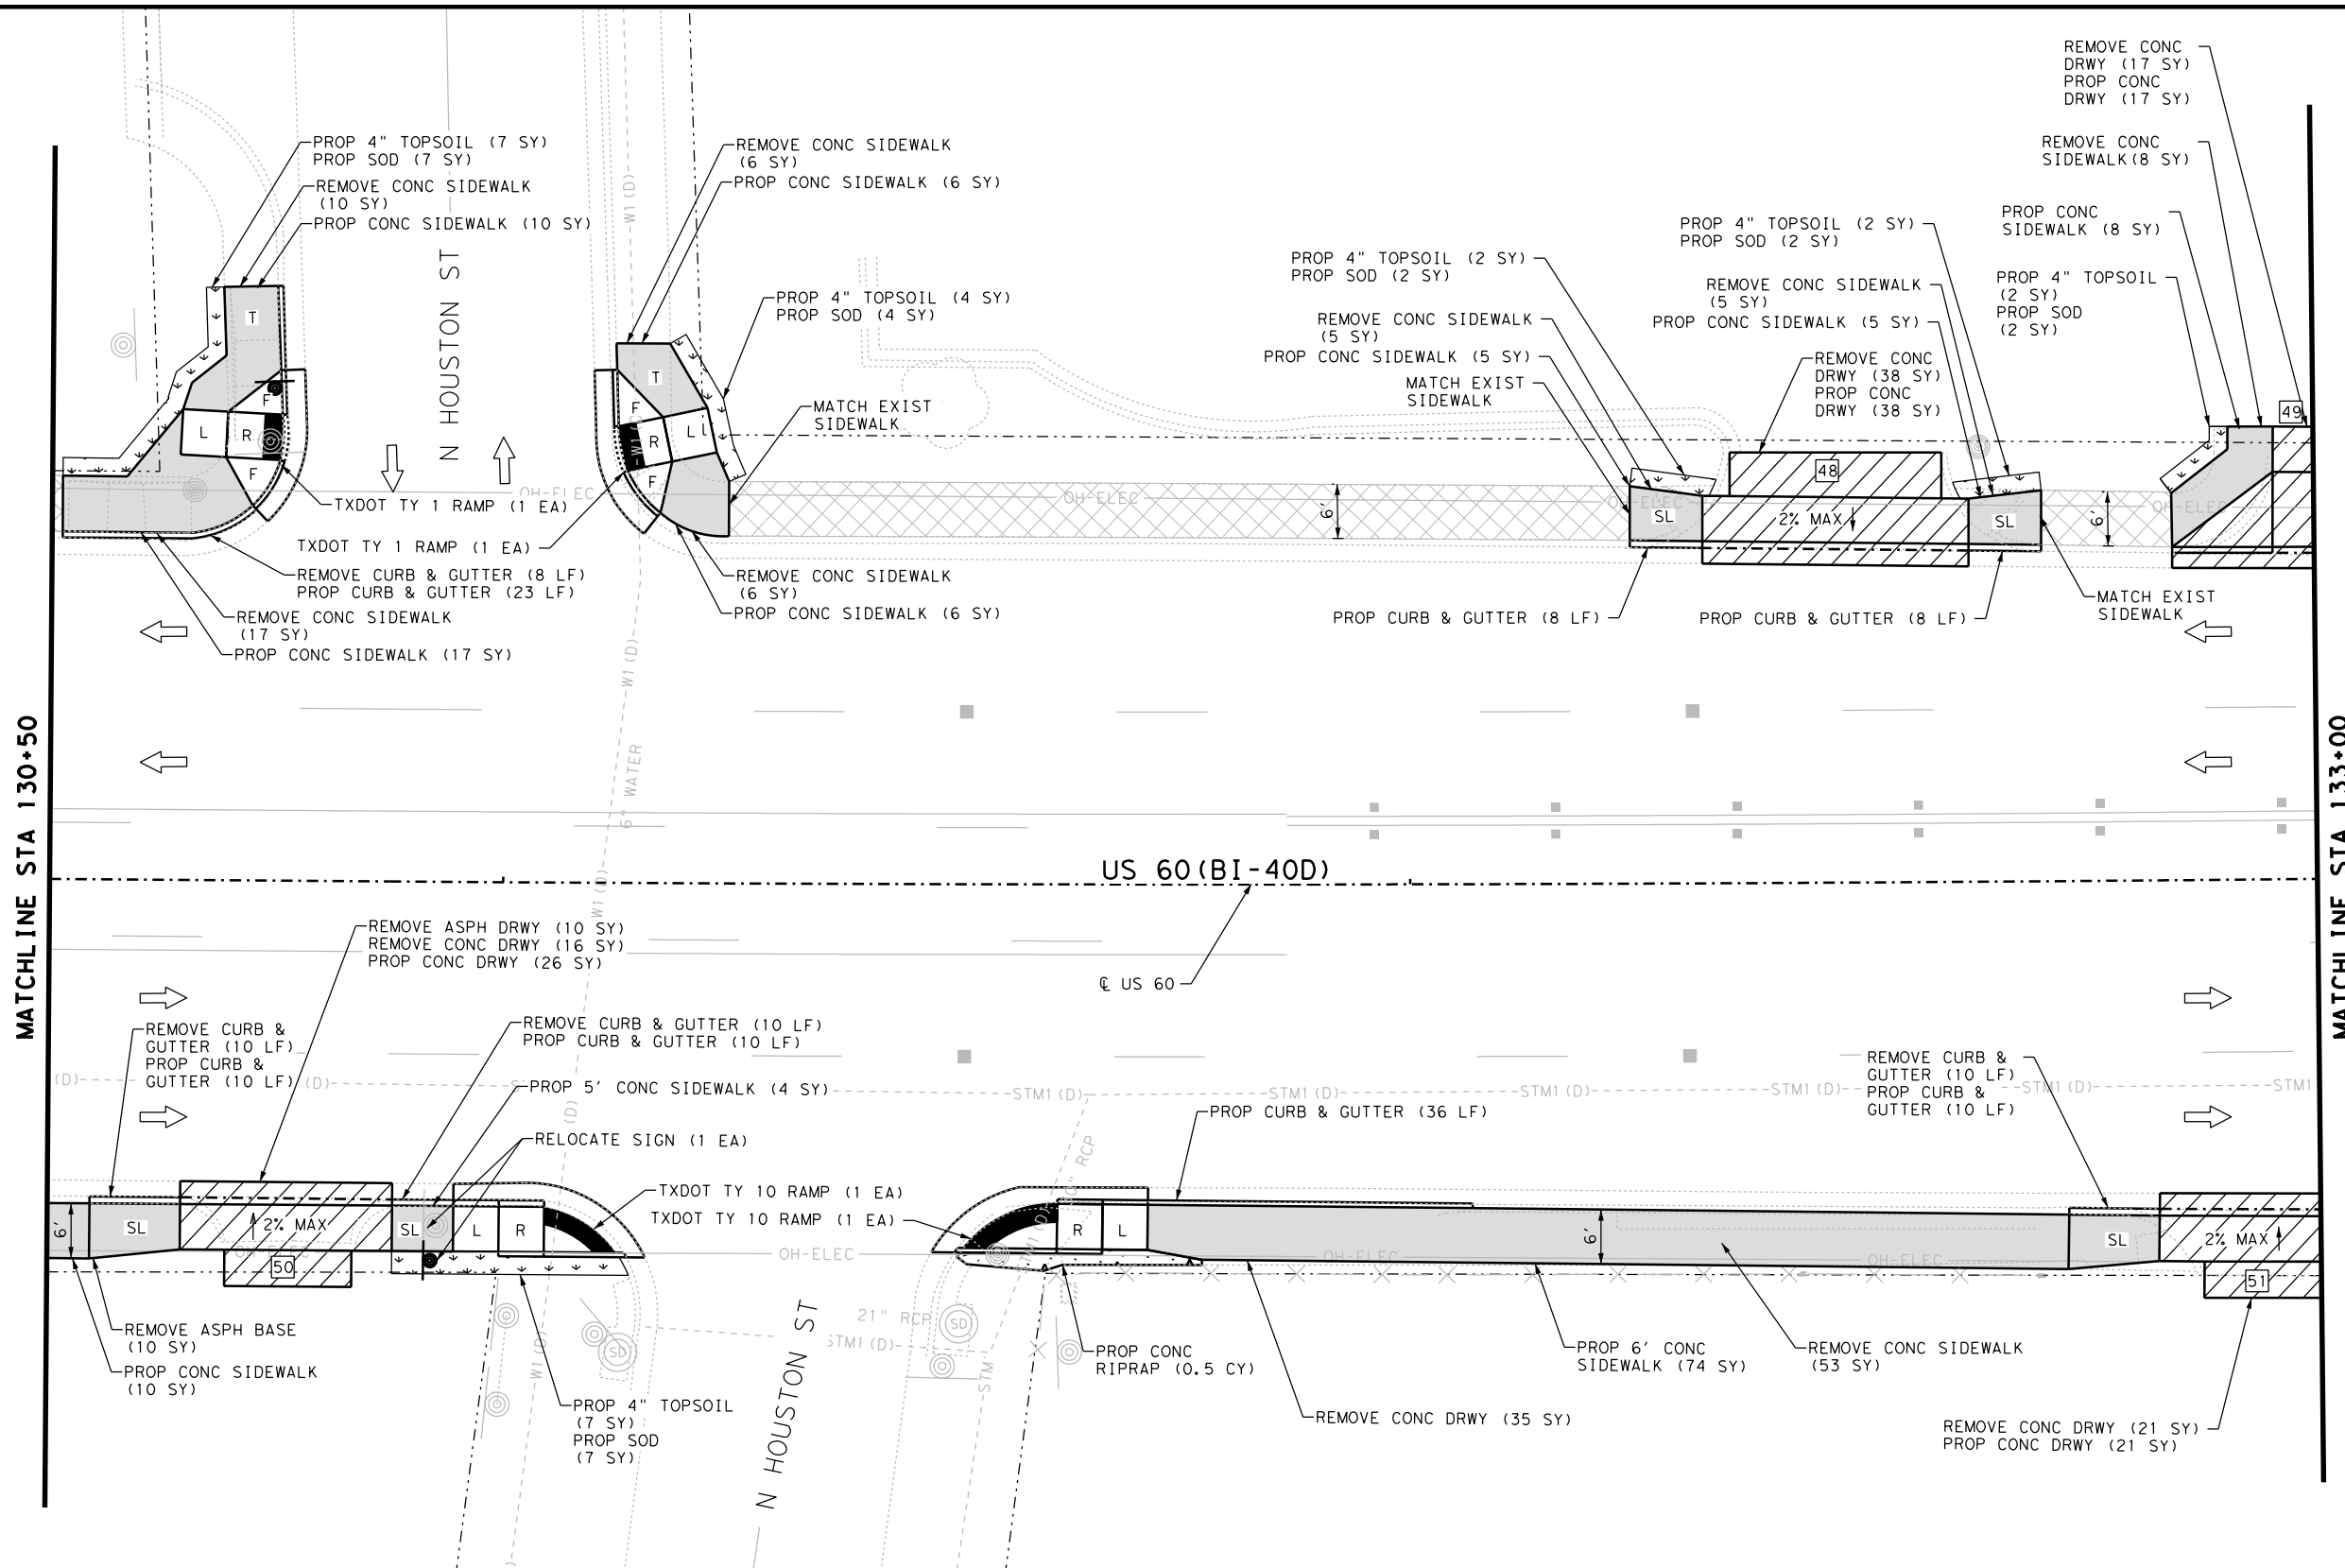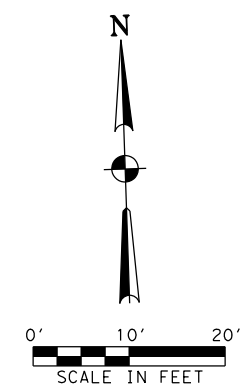

NOTES:
 * FOR CONTRACTOR INFORMATION ONLY
 1. THE EXISTENCE AND LOCATION OF ALL UTILITIES AND DRAINAGE STRUCTURES INDICATED IN THE PLANS ARE TAKEN FROM THE BEST RECORDS AVAILABLE AND ARE NOT GUARANTEED TO BE ACCURATE. CONTRACTOR SHALL COORDINATE WITH ALL UTILITY COMPANIES TO FIELD VERIFY UTILITIES PRIOR TO BEGINNING CONSTRUCTION.

NO.	DATE	REVISION	BY



GLOBAL CIVIL SOLUTIONS, LLC
 11551 FOREST CENTRAL DRIVE
 SUITE 220
 DALLAS, TX 75243
 F-12801



**US 60 (BI 40-D)
 SIDEWALK PLAN**

STA 130+50 TO STA 133+00

SHEET 14 OF 44



DESIGN	FED. RD. DIV. NO.	FEDERAL AID PROJECT NO.	HIGHWAY NO.
MI	6	(SEE TITLE SHEET)	VARIOUS
GRAPHICS	STATE	DISTRICT	COUNTY
PS	TEXAS	AMA	POTTER
CHECK	CONTROL	SECTION	JOB
MF			
CHECK	FS	0904	02 047

ITEM	DESCRIPTION	UNIT	QTY
0104 6015	REMOVING CONC (SIDEWALKS)	SY	110
0104 6017	REMOVING CONC (DRIVEWAYS)	SY	127
0104 6029	REMOVING CONC (CURB OR CURB & GUTTER)	LF	38
0105 6070	REMOVING STAB BASE & ASPH PAV (6" - 8")	SY	20
0160 6003	FURNISHING AND PLACING TOP SOIL (4")	SY	24
0162 6002	BLOCK SODDING	SY	24
0168 6001	VEGETATIVE WATERING	MG	0.9
0432 6001	RIPRAP (CONC) (4 IN)	CY	0.5
0529 6008	CONC CURB & GUTTER (TY II)	LF	105
0530 6004	DRIVEWAYS (CONC)	SY	92
0531 6001	CONC SIDEWALK (4")	SY	165
0531 6004	CURB RAMPS (TY 1)	EA	2
0531 6013	CURB RAMPS (TY 10)	EA	2
0644 6068	RELOCATE SM RD SN SUP&M TY 10BWG	EA	1

LEGEND

	PROP SODDING	R	RAMP		POWER POLE		IRRIGATION CONTROL VALVE
	PROP CONC DRWY	L	LANDING PAD		TRAFFIC SIGNAL POLE		ELECTRICAL PULL BOX
	PROP CONC RIPRAP	F	FLARE		LIGHT POLE		DRIVEWAY ID
	PROP RETAINING WALL	SL	LONG. SLOPE MAY NOT EXCEED 5% OR ADJACENT ROAD SLOPE		WATER METER		PEDESTRIAN SIGNAL
	PROP CONC SIDEWALK	T	TRANSITION		FIRE HYDRANT		GAS METER
	EXISTING SIDEWALK/DRWY TO REMAIN	LS	LEVEL SIDEWALK (2% MAX)		GUY WIRE		SPRINKLER HEAD
			TRAFFIC FLOW		TREE/SHRUB		UTILITY MARKER POST
			EXISTING SIGN		FENCE		OVERHEAD ELECTRIC LINE
			PROPOSED SIGN		WATER VALVE		
			MANHOLE		TRAFFIC SIGNAL BOX		

P:\Jobs\2020007-Pedestrian\1110-CA00\VP3-SHEETS\047-AM_US_60-ST1-40F-44.dgn
 5:18:19 PM
 1/27/2022

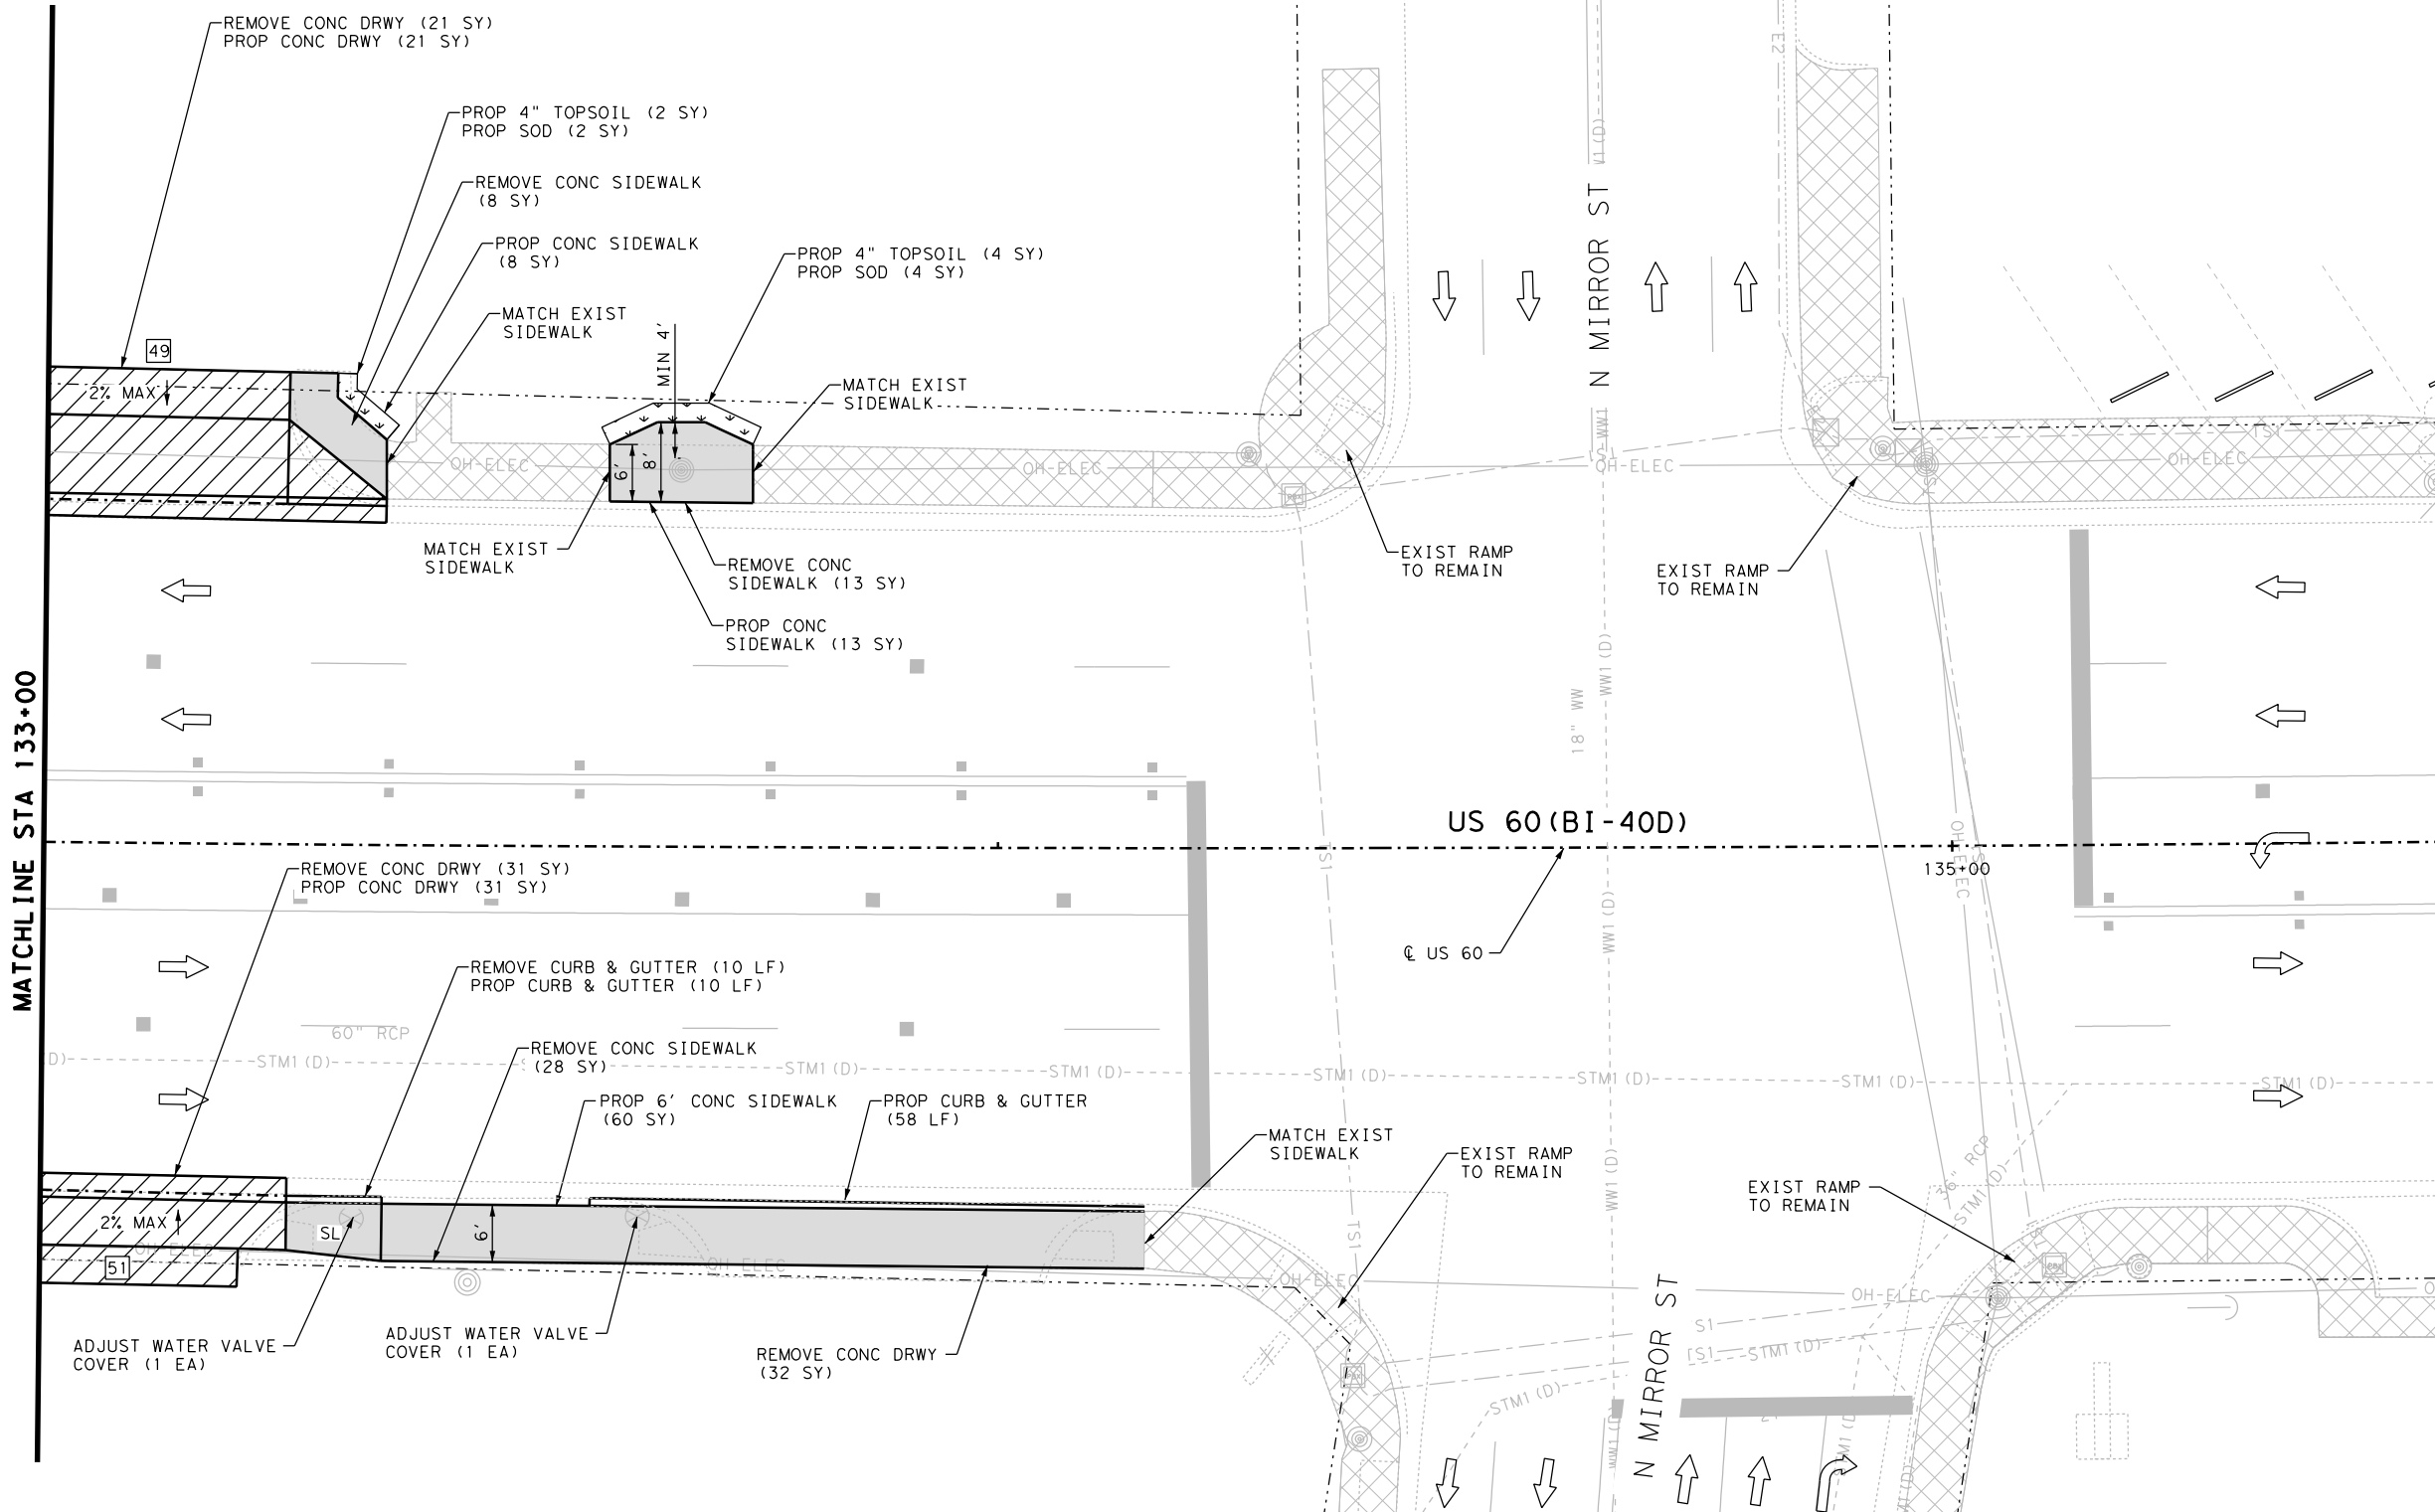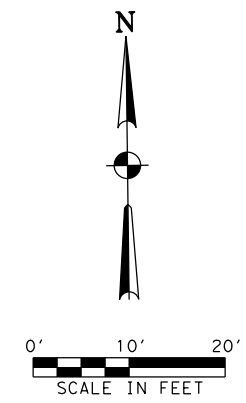

NOTES:
 * FOR CONTRACTOR INFORMATION ONLY
 1. THE EXISTENCE AND LOCATION OF ALL UTILITIES AND DRAINAGE STRUCTURES INDICATED IN THE PLANS ARE TAKEN FROM THE BEST RECORDS AVAILABLE AND ARE NOT GUARANTEED TO BE ACCURATE. CONTRACTOR SHALL COORDINATE WITH ALL UTILITY COMPANIES TO FIELD VERIFY UTILITIES PRIOR TO BEGINNING CONSTRUCTION.

NO.	DATE	REVISION	BY



GLOBAL CIVIL SOLUTIONS, LLC
 1151 FOREST CENTRAL DRIVE
 SUITE 220
 DALLAS, TX 75243
 F-12801



**US 60 (BI 40-D)
 SIDEWALK PLAN**

STA 133+00 TO STA 135+50

SHEET 15 OF 44



DESIGN	FED. RD. DIV. NO.	FEDERAL AID PROJECT NO.	HIGHWAY NO.
MI	6	(SEE TITLE SHEET)	VARIOUS
GRAPHICS	STATE	DISTRICT	COUNTY
PS	TEXAS	AMA	POTTER
CHECK	CONTROL	SECTION	JOB
MFM			
CHECK	CONTROL	SECTION	JOB
FS	0904	02	047

043

LEGEND			
	PROP SODDING	R	RAMP
	PROP CONC DRWY	L	LANDING PAD
	PROP CONC RIPRAP	F	FLARE
	PROP RETAINING WALL	SL	LONG. SLOPE MAY NOT EXCEED 5% OR ADJACENT ROAD SLOPE
	PROP CONC SIDEWALK	T	TRANSITION
	EXISTING SIDEWALK/DRWY TO REMAIN	LS	LEVEL SIDEWALK (2% MAX)
	PROP SODDING		TRAFFIC FLOW
	PROP CONC DRWY		EXISTING SIGN
	PROP CONC RIPRAP		PROPOSED SIGN
	PROP RETAINING WALL		MANHOLE
	PROP CONC SIDEWALK		POWER POLE
	EXISTING SIDEWALK/DRWY TO REMAIN		TRAFFIC SIGNAL POLE
	PROP SODDING		LIGHT POLE
	PROP CONC DRWY		WATER METER
	PROP CONC RIPRAP		FIRE HYDRANT
	PROP RETAINING WALL		GUY WIRE
	PROP CONC SIDEWALK		TREE/SHRUB
	EXISTING SIDEWALK/DRWY TO REMAIN		FENCE
	PROP SODDING		WATER VALVE
	PROP CONC DRWY		TRAFFIC SIGNAL BOX
	PROP CONC RIPRAP		IRRIGATION CONTROL VALVE
	PROP RETAINING WALL		ELECTRICAL PULL BOX
	PROP CONC SIDEWALK		DRIVEWAY ID
	EXISTING SIDEWALK/DRWY TO REMAIN		PEDESTRIAN SIGNAL
	PROP SODDING		GAS METER
	PROP CONC DRWY		SPRINKLER HEAD
	PROP CONC RIPRAP		UTILITY MARKER POST
	PROP RETAINING WALL		OVERHEAD ELECTRIC LINE
	PROP CONC SIDEWALK		
	EXISTING SIDEWALK/DRWY TO REMAIN		

ITEM	DESCRIPTION	UNIT	QTY
0104 6015	REMOVING CONC (SIDEWALKS)	SY	49
0104 6017	REMOVING CONC (DRIVEWAYS)	SY	84
0104 6029	REMOVING CONC (CURB OR CURB & GUTTER)	LF	10
0160 6003	FURNISHING AND PLACING TOP SOIL (4")	SY	6
0162 6002	BLOCK SODDING	SY	6
0168 6001	VEGETATIVE WATERING	MG	0.3
0479 6005	ADJUSTING MANHOLES (WATER VALVE BOX)	EA	2
0529 6008	CONC CURB & GUTTER (TY II)	LF	68
0530 6004	DRIVEWAYS (CONC)	SY	52
0531 6001	CONC SIDEWALK (4")	SY	81

P:\Jobs\202007-Pedestrian\TXDOT_Amp\1110\CA00\VP3-SHEETS\047_AM_US_60_ST150F44.dgn
 5:18:20 PM
 1/27/2022

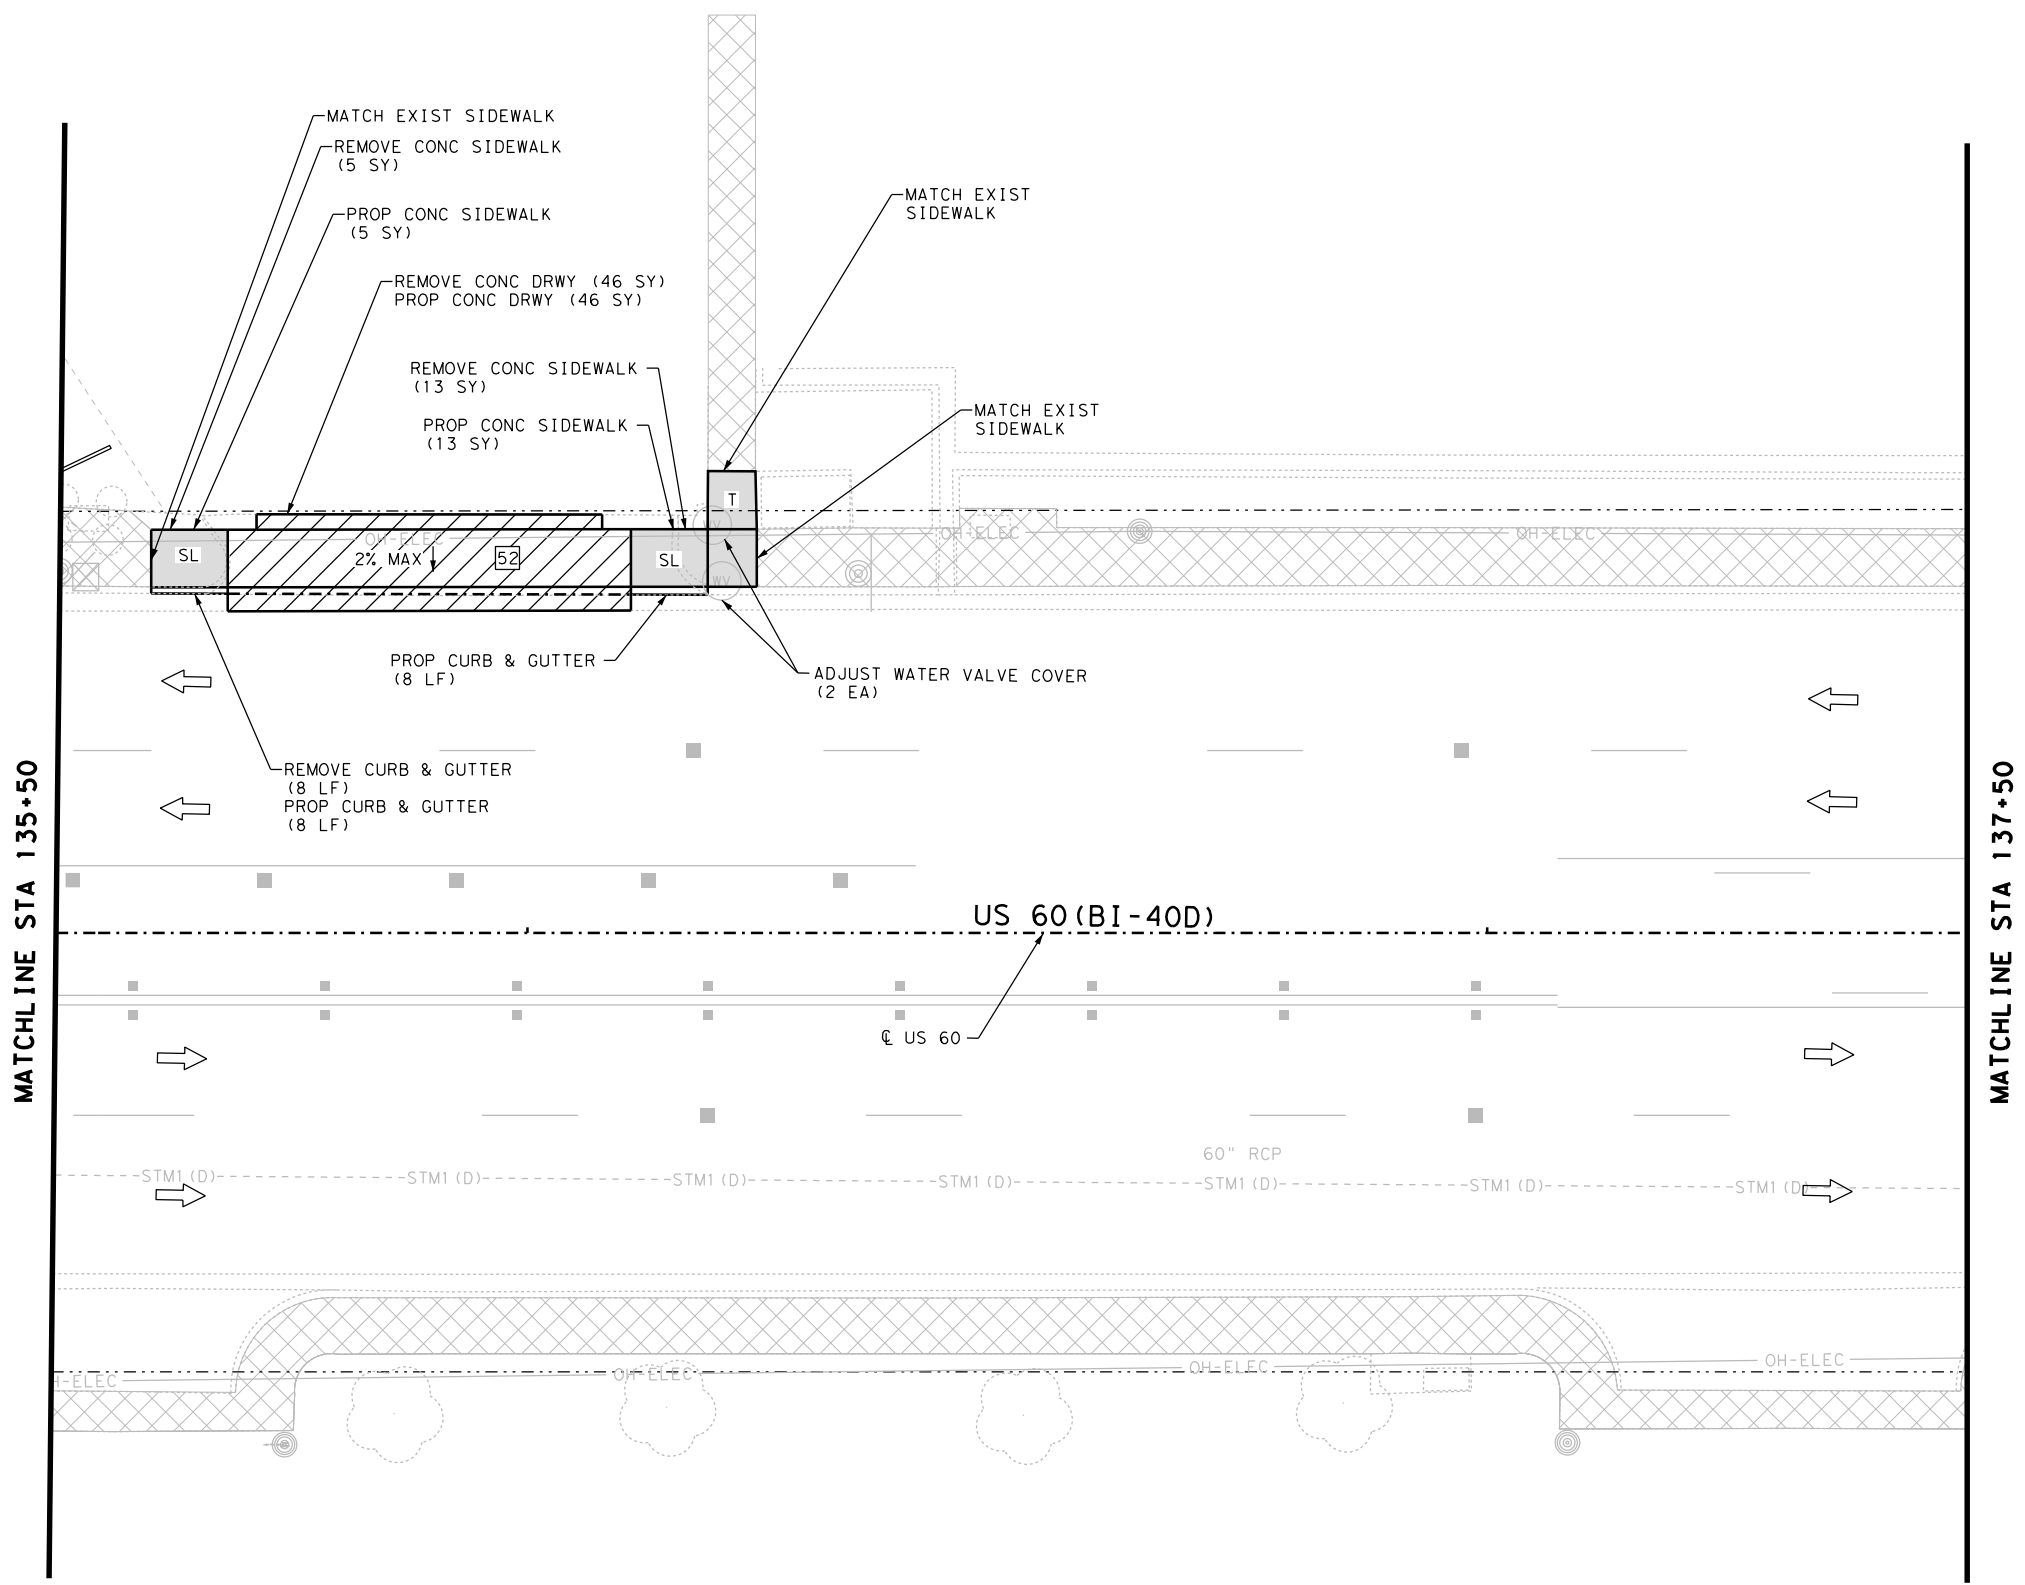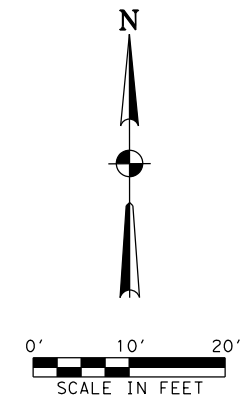

NOTES:
 * FOR CONTRACTOR INFORMATION ONLY
 1. THE EXISTENCE AND LOCATION OF ALL UTILITIES AND DRAINAGE STRUCTURES INDICATED IN THE PLANS ARE TAKEN FROM THE BEST RECORDS AVAILABLE AND ARE NOT GUARANTEED TO BE ACCURATE. CONTRACTOR SHALL COORDINATE WITH ALL UTILITY COMPANIES TO FIELD VERIFY UTILITIES PRIOR TO BEGINNING CONSTRUCTION.

NO.	DATE	REVISION	BY



GLOBAL CIVIL SOLUTIONS, LLC
 11551 FOREST CENTRAL DRIVE
 SUITE 220
 DALLAS, TX 75243
 F-12801



**US 60 (BI 40-D)
 SIDEWALK PLAN**

STA 135+50 TO STA 137+50



SHEET 16 OF 44

DESIGN MI	FED. RD. DIV. NO. 6	FEDERAL AID PROJECT NO. (SEE TITLE SHEET)	HIGHWAY NO. VARIOUS
GRAPHICS PS	STATE TEXAS	DISTRICT AMA	COUNTY POTTER
CHECK MF	CONTROL 0904	SECTION 02	JOB 047
CHECK FS			SHEET NO. 044

LEGEND			
	PROP SODDING	R	RAMP
	PROP CONC DRWY	L	LANDING PAD
	PROP CONC RIPRAP	F	FLARE
	PROP RETAINING WALL	SL	LONG. SLOPE MAY NOT EXCEED 5% OR ADJACENT ROAD SLOPE
	PROP CONC SIDEWALK	T	TRANSITION
	EXISTING SIDEWALK/DRWY TO REMAIN	LS	LEVEL SIDEWALK (2% MAX)
	TRAFFIC FLOW		EXISTING SIGN
	PROPOSED SIGN		MANHOLE
	POWER POLE		TRAFFIC SIGNAL POLE
	IRRIGATION CONTROL VALVE		LIGHT POLE
	ELECTRICAL PULL BOX		WATER METER
	DRIVEWAY ID		FIRE HYDRANT
	PEDESTRIAN SIGNAL		GUY WIRE
	GAS METER		TREE/SHRUB
	SPRINKLER HEAD		FENCE
	UTILITY MARKER POST		WATER VALVE
	OVERHEAD ELECTRIC LINE		TRAFFIC SIGNAL BOX

ITEM	DESCRIPTION	UNIT	QTY
0104 6015	REMOVING CONC (SIDEWALKS)	SY	18
0104 6017	REMOVING CONC (DRIVEWAYS)	SY	46
0104 6029	REMOVING CONC (CURB OR CURB & GUTTER)	LF	8
0479 6005	ADJUSTING MANHOLES (WATER VALVE BOX)	EA	2
0529 6008	CONC CURB & GUTTER (TY II)	LF	16
0530 6004	DRIVEWAYS (CONC)	SY	46
0531 6001	CONC SIDEWALK (4")	SY	18

P:\Jobs\202007-Pedestrian\TXDOT_Amor\1110\CA00\PS3_SHEETS\047_AM_US_60_ST160F44.dgn
 5:18:22 PM
 1/27/2022

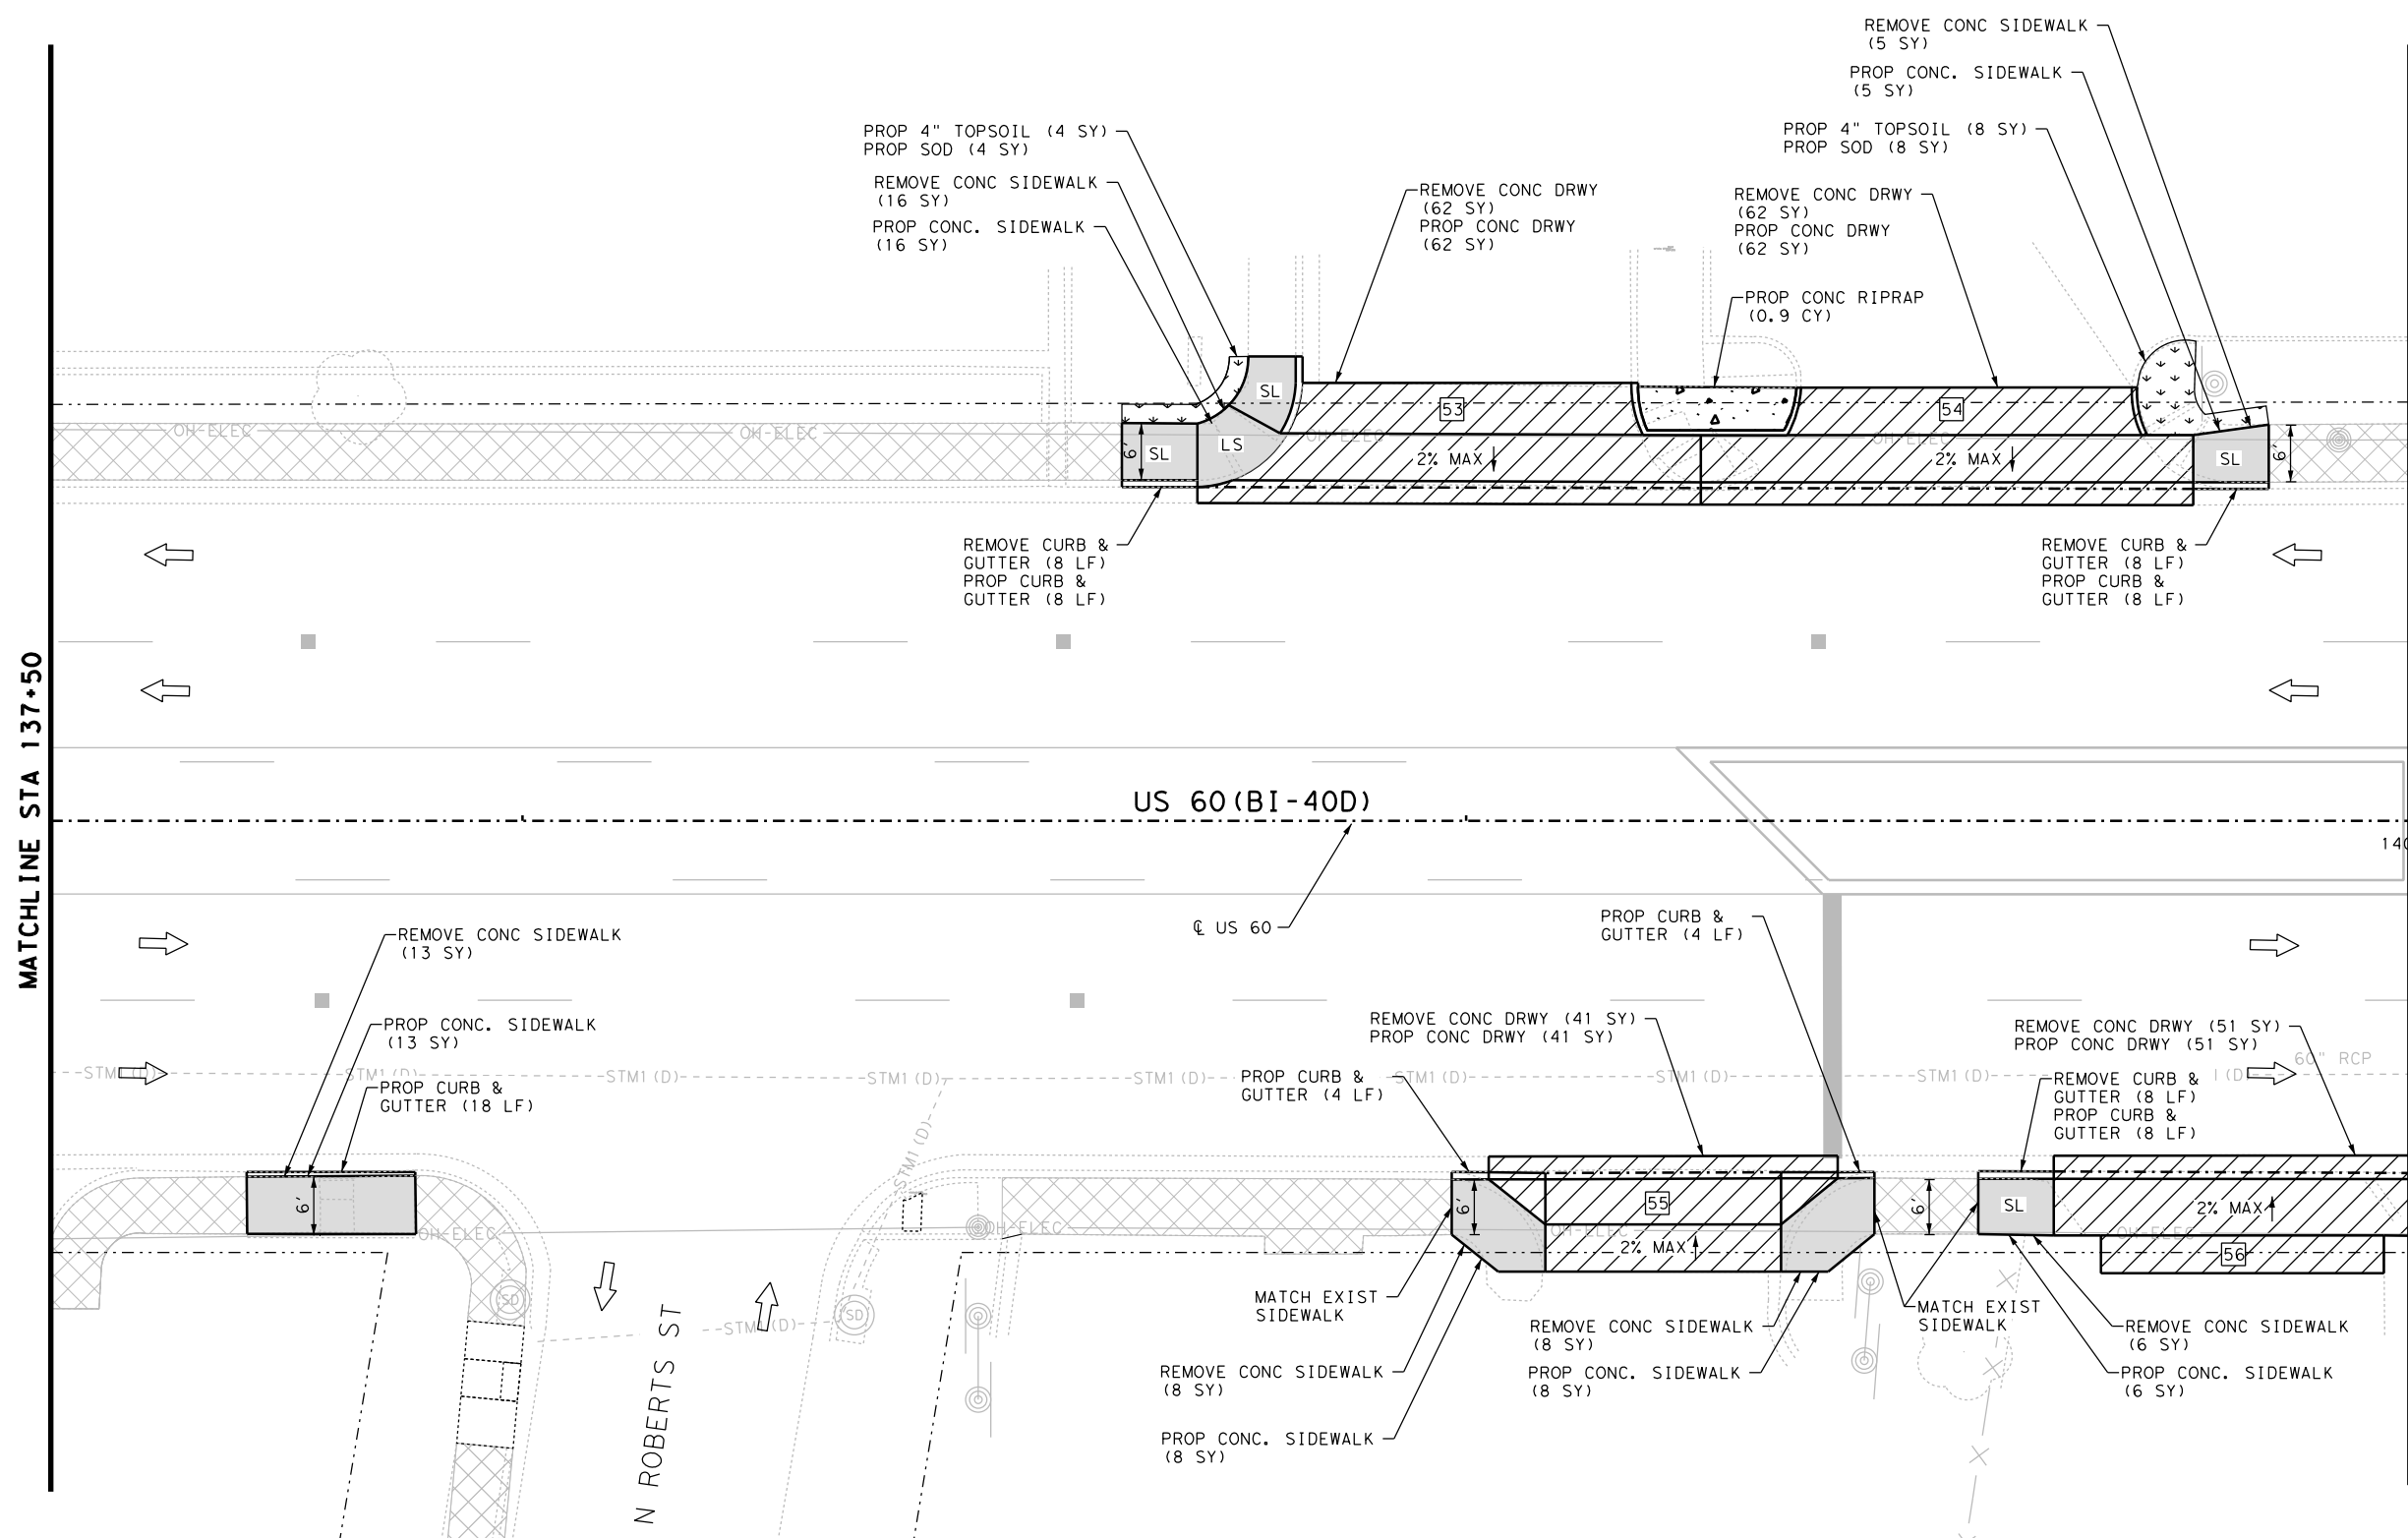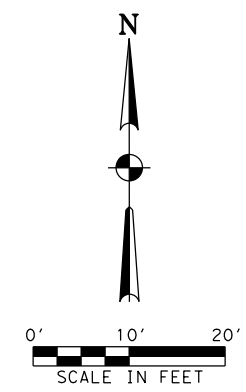

- NOTES:
- * FOR CONTRACTOR INFORMATION ONLY
 - 1. THE EXISTENCE AND LOCATION OF ALL UTILITIES AND DRAINAGE STRUCTURES INDICATED IN THE PLANS ARE TAKEN FROM THE BEST RECORDS AVAILABLE AND ARE NOT GUARANTEED TO BE ACCURATE. CONTRACTOR SHALL COORDINATE WITH ALL UTILITY COMPANIES TO FIELD VERIFY UTILITIES PRIOR TO BEGINNING CONSTRUCTION.

NO.	DATE	REVISION	BY



GLOBAL CIVIL SOLUTIONS, LLC
 11551 FOREST CENTRAL DRIVE
 SUITE 220
 DALLAS, TX 75243
 F-12801



US 60 (BI 40-D)
SIDEWALK PLAN

STA 137+50 TO STA 140+00


SHEET 17 OF 44

DESIGN	FED. RD. DIV. NO.	FEDERAL AID PROJECT NO.	HIGHWAY NO.
MI	6	(SEE TITLE SHEET)	VARIOUS
GRAPHICS	STATE	DISTRICT	COUNTY
PS	TEXAS	AMA	POTTER
CHECK	CONTROL	SECTION	JOB
MF			
CHECK	FS	0904	02 047

P:\Jobs\2020007-Pedestrian\1110-CA00-V3-SHEETS\047_AM_US_60_ST170F44.dgn
 5:18:23 PM
 1/27/2022


LEGEND			
	PROP SODDING	R	RAMP
	PROP CONC DRWY	L	LANDING PAD
	PROP CONC RIPRAP	F	FLARE
	PROP RETAINING WALL	SL	LONG. SLOPE MAY NOT EXCEED 5% OR ADJACENT ROAD SLOPE
	PROP CONC SIDEWALK	T	TRANSITION
	EXISTING SIDEWALK/DRWY TO REMAIN	LS	LEVEL SIDEWALK (2% MAX)
			TRAFFIC FLOW
			EXISTING SIGN
			PROPOSED SIGN
			MANHOLE
	POWER POLE		TRAFFIC SIGNAL POLE
	LIGHT POLE		WATER METER
	FIRE HYDRANT		GUY WIRE
	TREE/SHRUB		FENCE
	WATER VALVE		TRAFFIC SIGNAL BOX
	IRRIGATION CONTROL VALVE		
	ELECTRICAL PULL BOX		
	DRIVEWAY ID		
	PEDESTRIAN SIGNAL		
	GAS METER		
	SPRINKLER HEAD		
	UTILITY MARKER POST		
	OVERHEAD ELECTRIC LINE		

ITEM	DESCRIPTION	UNIT	QTY
0104 6015	REMOVING CONC (SIDEWALKS)	SY	56
0104 6017	REMOVING CONC (DRIVEWAYS)	SY	216
0104 6029	REMOVING CONC (CURB OR CURB & GUTTER)	LF	24
0160 6003	FURNISHING AND PLACING TOP SOIL (4")	SY	12
0162 6002	BLOCK SODDING	SY	12
0168 6001	VEGETATIVE WATERING	MG	0.5
0432 6001	RIPRAP (CONC) (4 IN)	CY	0.9
0529 6008	CONC CURB & GUTTER (TY II)	LF	50
0530 6004	DRIVEWAYS (CONC)	SY	216
0531 6001	CONC SIDEWALK (4")	SY	56

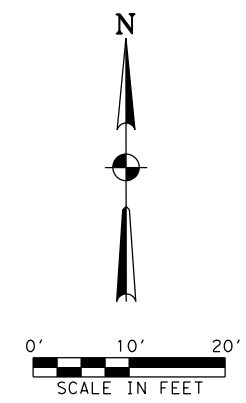

MATCHLINE STA 140+00

MATCHLINE STA 142+50

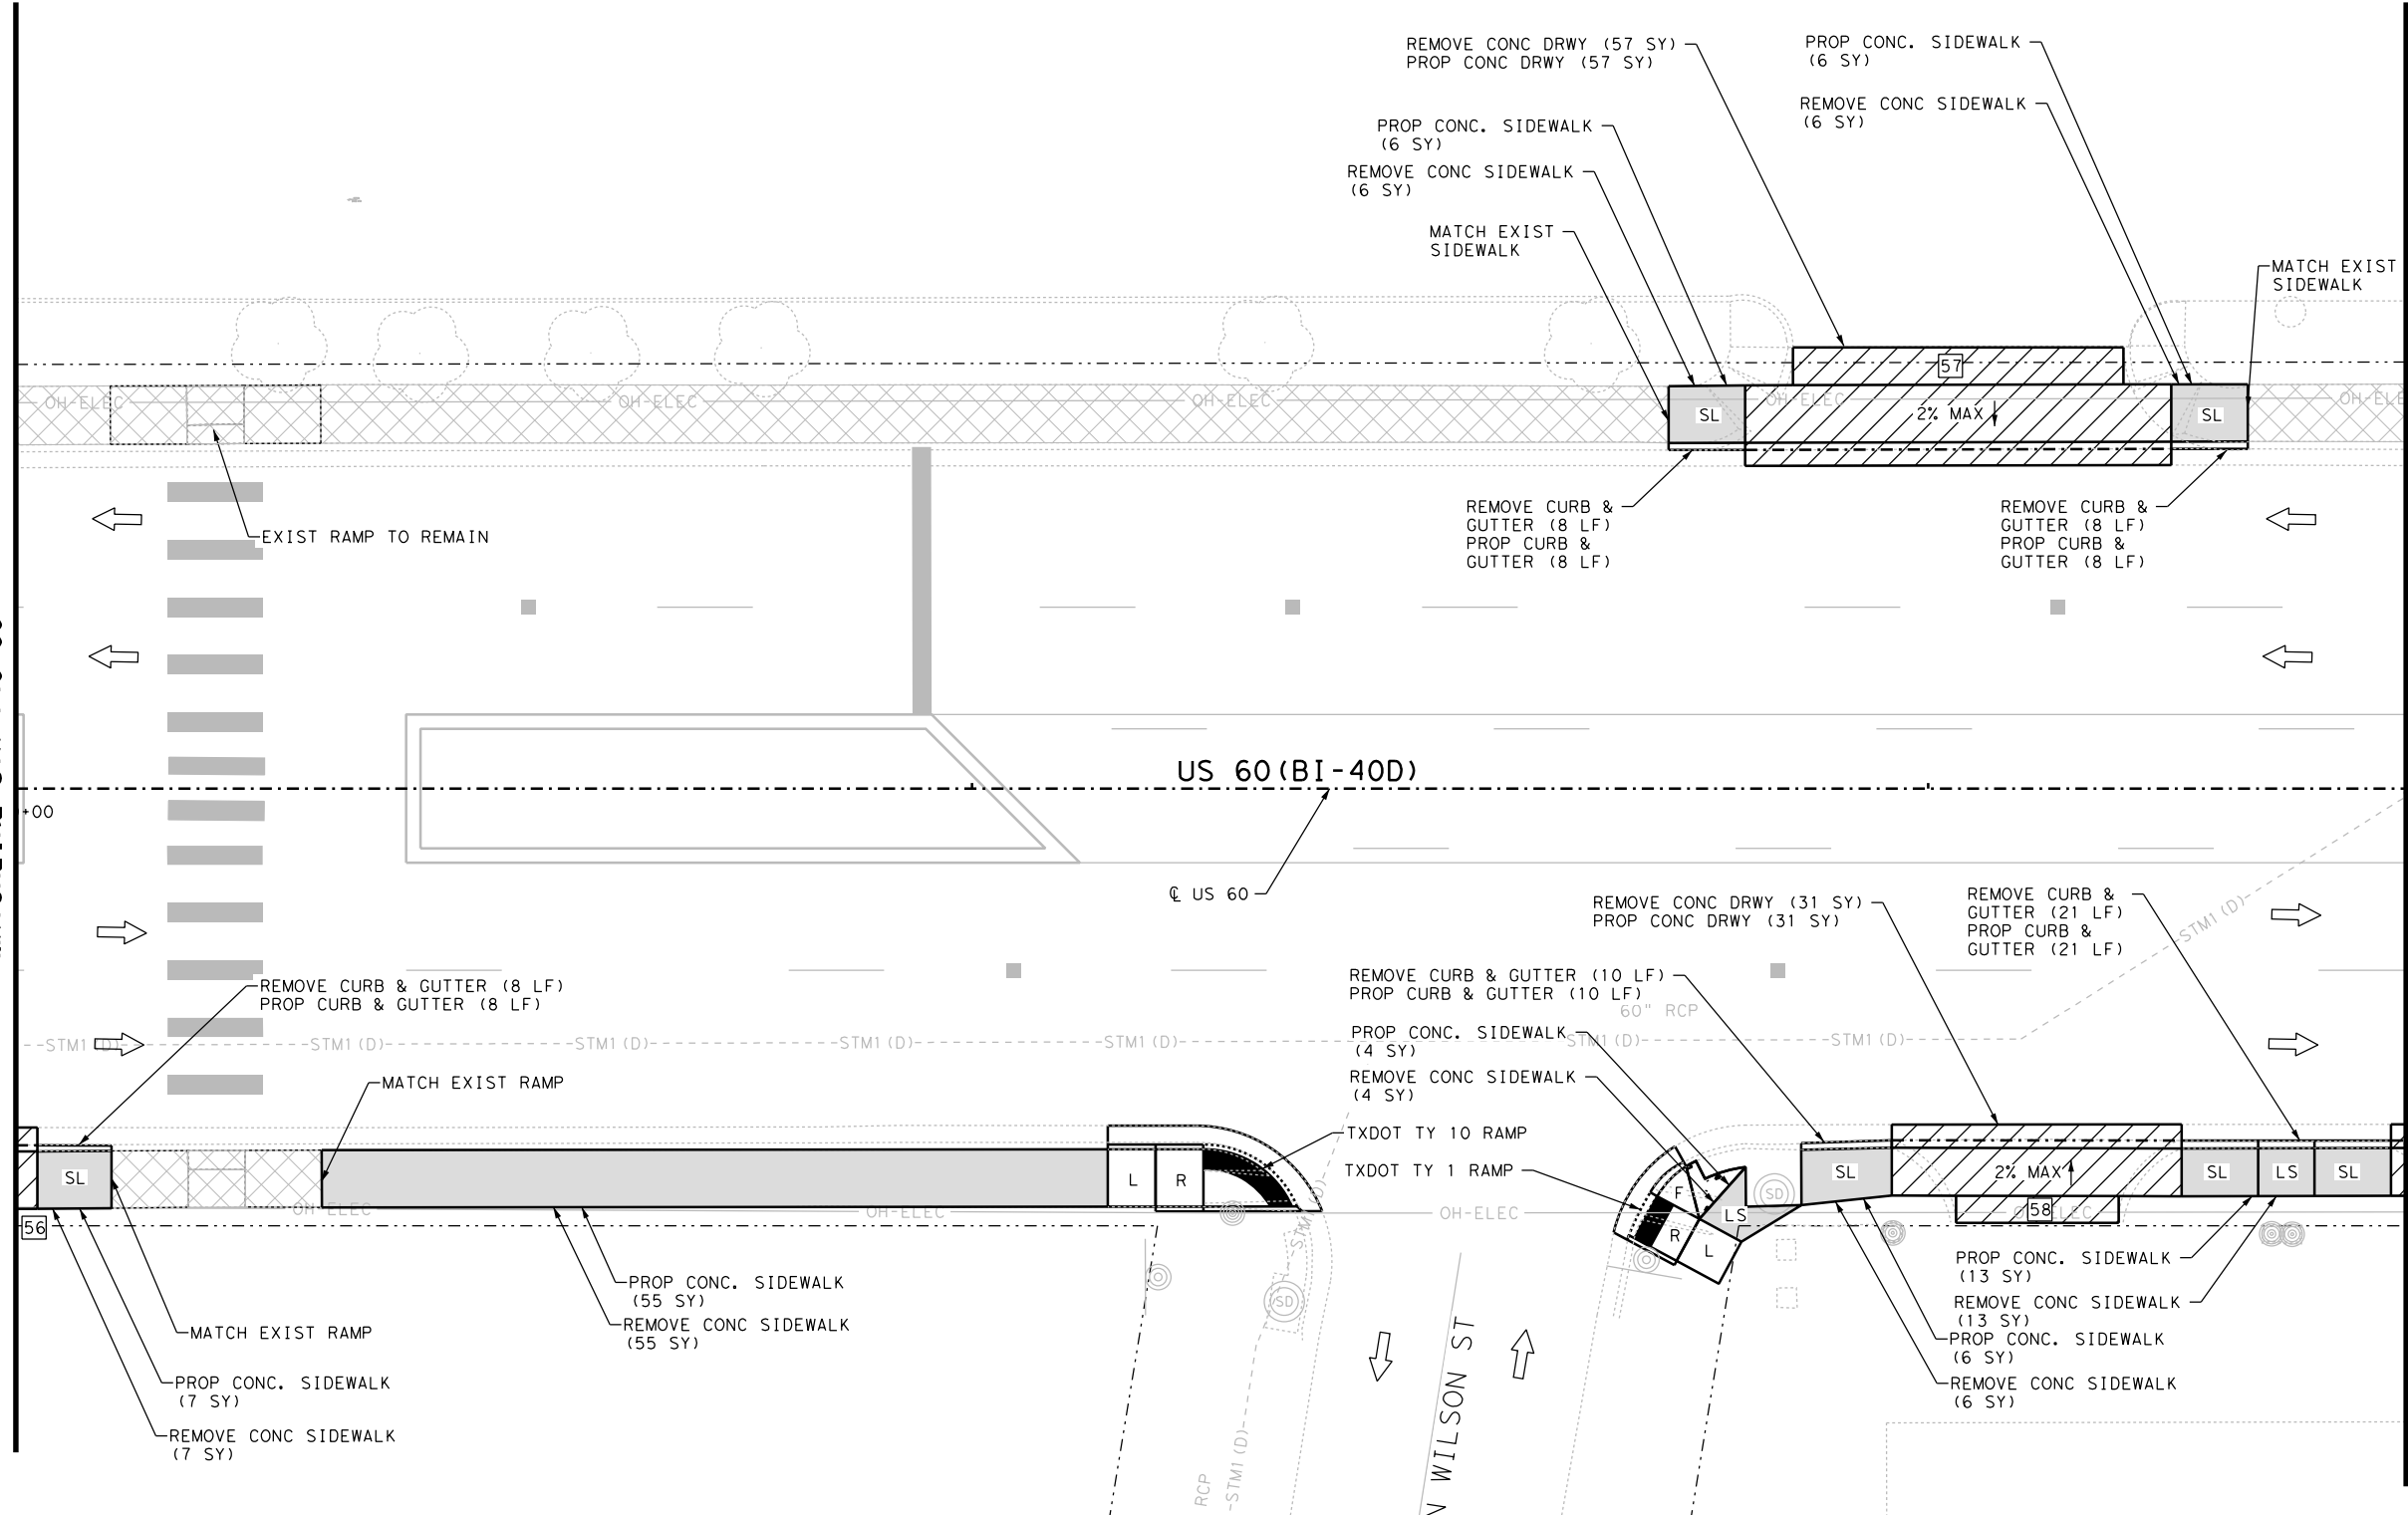

- NOTES:
- * FOR CONTRACTOR INFORMATION ONLY
 - 1. THE EXISTENCE AND LOCATION OF ALL UTILITIES AND DRAINAGE STRUCTURES INDICATED IN THE PLANS ARE TAKEN FROM THE BEST RECORDS AVAILABLE AND ARE NOT GUARANTEED TO BE ACCURATE. CONTRACTOR SHALL COORDINATE WITH ALL UTILITY COMPANIES TO FIELD VERIFY UTILITIES PRIOR TO BEGINNING CONSTRUCTION.

NO.	DATE	REVISION	BY



GLOBAL CIVIL SOLUTIONS, LLC
 11551 FOREST CENTRAL DRIVE
 SUITE 220
 DALLAS, TX 75243
 F-12801



**US 60 (BI 40-D)
 SIDEWALK PLAN**



STA 140+00 TO STA 142+50

SHEET 18 OF 44

LEGEND	
	PROP SODDING
	PROP CONC DRWY
	PROP CONC RIPRAP
	PROP RETAINING WALL
	PROP CONC SIDEWALK
	EXISTING SIDEWALK/DRWY TO REMAIN
R	RAMP
L	LANDING PAD
F	FLARE
SL	LONG. SLOPE MAY NOT EXCEED 5% OR ADJACENT ROAD SLOPE
T	TRANSITION
LS	LEVEL SIDEWALK (2% MAX)
	TRAFFIC FLOW
	EXISTING SIGN
	PROPOSED SIGN
	MANHOLE
	POWER POLE
	TRAFFIC SIGNAL POLE
	LIGHT POLE
	WATER METER
	FIRE HYDRANT
	GUY WIRE
	TREE/SHRUB
	FENCE
	WATER VALVE
	TRAFFIC SIGNAL BOX
	IRRIGATION CONTROL VALVE
	ELECTRICAL PULL BOX
	DRIVEWAY ID
	PEDESTRIAN SIGNAL
	GAS METER
	SPRINKLER HEAD
	UTILITY MARKER POST
	OVERHEAD ELECTRIC LINE

ITEM	DESCRIPTION	UNIT	QTY
0104 6015	REMOVING CONC (SIDEWALKS)	SY	97
0104 6017	REMOVING CONC (DRIVEWAYS)	SY	88
0104 6029	REMOVING CONC (CURB OR CURB & GUTTER)	LF	55
0529 6008	CONC CURB & GUTTER (TY II)	LF	55
0530 6004	DRIVEWAYS (CONC)	SY	88
0531 6001	CONC SIDEWALK (4")	SY	97
0531 6004	CURB RAMPS (TY 1)	EA	1
0531 6013	CURB RAMPS (TY 10)	EA	1

P:\Jobs\202007-Pedestrian\TXDOT\Amor\1110\CA00\VP3-SHEETS\047_AM_US_60_ST180F44.dgn
 5:18:25 PM
 1/27/2022

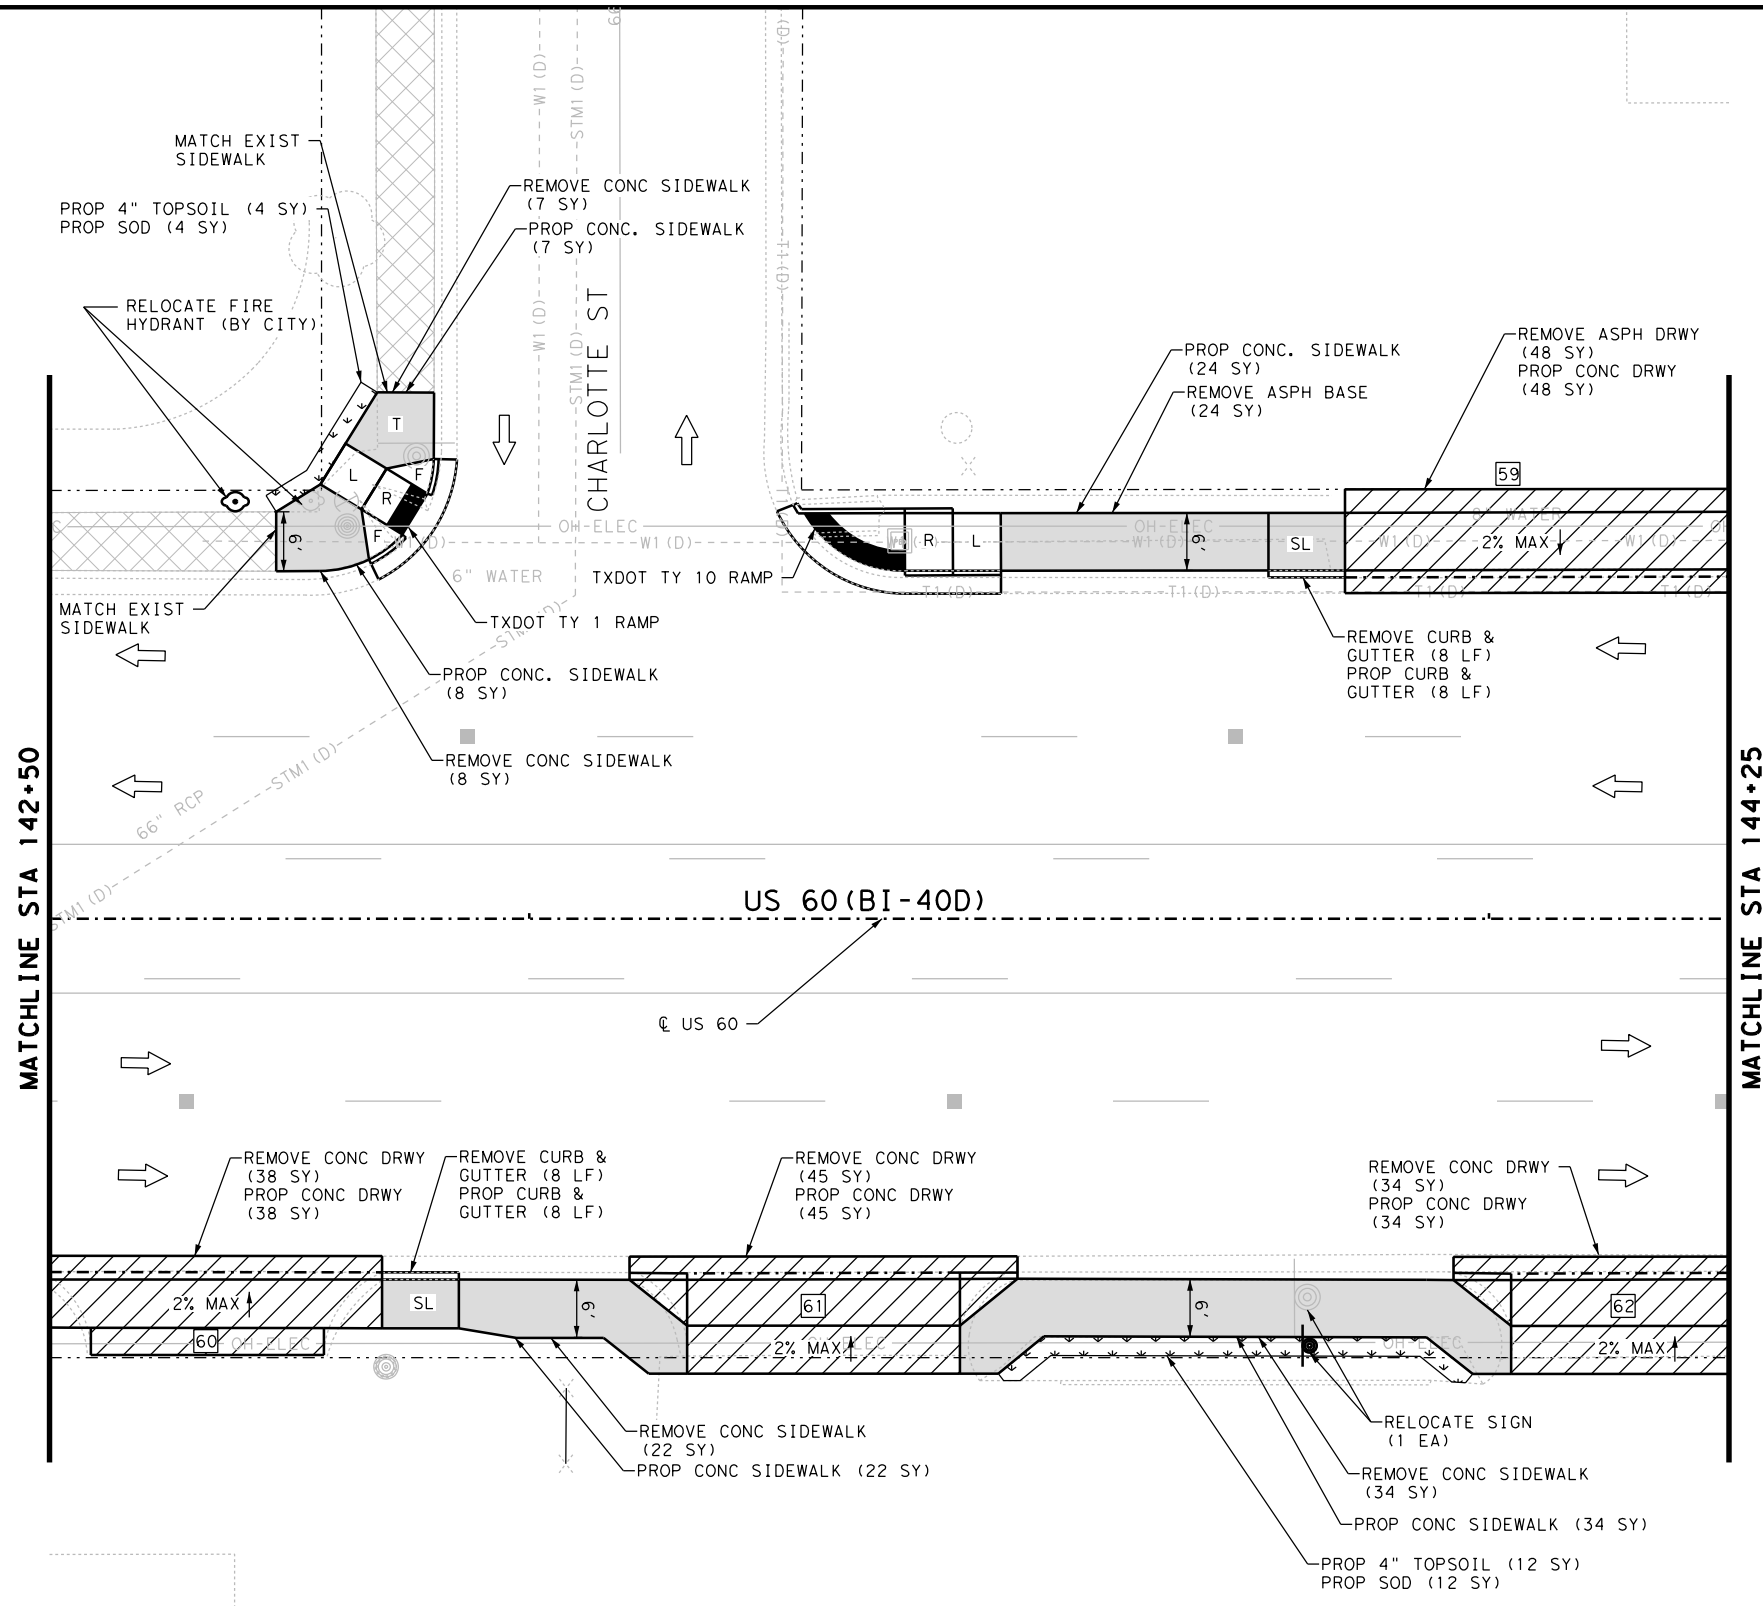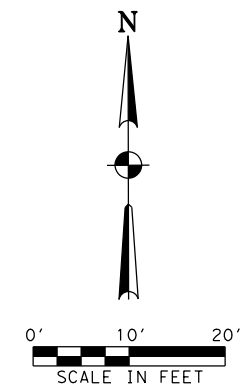

NOTES:
 * FOR CONTRACTOR INFORMATION ONLY
 1. THE EXISTENCE AND LOCATION OF ALL UTILITIES AND DRAINAGE STRUCTURES INDICATED IN THE PLANS ARE TAKEN FROM THE BEST RECORDS AVAILABLE AND ARE NOT GUARANTEED TO BE ACCURATE. CONTRACTOR SHALL COORDINATE WITH ALL UTILITY COMPANIES TO FIELD VERIFY UTILITIES PRIOR TO BEGINNING CONSTRUCTION.

NO.	DATE	REVISION	BY



GLOBAL CIVIL SOLUTIONS, LLC
 11551 FOREST CENTRAL DRIVE
 SUITE 220
 DALLAS, TX 75243
 F-12801



**US 60 (BI 40-D)
 SIDEWALK PLAN**

STA 142+50 TO STA 144+25



SHEET 19 OF 44

DESIGN	FED. RD. DIV. NO.	FEDERAL AID PROJECT NO.	HIGHWAY NO.
MI	6	(SEE TITLE SHEET)	VARIOUS
GRAPHICS	STATE	DISTRICT	COUNTY
PS	TEXAS	AMA	POTTER
CHECK	CONTROL	SECTION	JOB
MFM			
CHECK	CONTROL	SECTION	JOB
FS	0904	02	047

P:\Jobs\202007-Pedestrian\TxDOT\Amor\1110\CA00\VP3\SHEETS\047_AM_US_60_ST190F44.dgn
 5:18:26 PM
 1/27/2022

LEGEND			
	PROP SODDING	R	RAMP
	PROP CONC DRWY	L	LANDING PAD
	PROP CONC RIPRAP	F	FLARE
	PROP RETAINING WALL	SL	LONG. SLOPE MAY NOT EXCEED 5% OR ADJACENT ROAD SLOPE
	PROP CONC SIDEWALK	T	TRANSITION
	EXISTING SIDEWALK/DRWY TO REMAIN	LS	LEVEL SIDEWALK (2% MAX)
	PROP SODDING	↑	TRAFFIC FLOW
	PROP SODDING	⊙	EXISTING SIGN
	PROP SODDING	⊙	PROPOSED SIGN
	PROP SODDING	⊙	MANHOLE
	POWER POLE	⊙	TRAFFIC SIGNAL POLE
	TRAFFIC SIGNAL POLE	⊙	LIGHT POLE
	WATER METER	⊙	FIRE HYDRANT
	FIRE HYDRANT	⊙	GUY WIRE
	TREE/SHRUB	⊙	FENCE
	FENCE	⊙	WATER VALVE
	WATER VALVE	⊙	TRAFFIC SIGNAL BOX
	TRAFFIC SIGNAL BOX	⊙	IRRIGATION CONTROL VALVE
	IRRIGATION CONTROL VALVE	⊙	ELECTRICAL PULL BOX
	ELECTRICAL PULL BOX	⊙	DRIVEWAY ID
	DRIVEWAY ID	⊙	PEDESTRIAN SIGNAL
	PEDESTRIAN SIGNAL	⊙	GAS METER
	GAS METER	⊙	SPRINKLER HEAD
	SPRINKLER HEAD	⊙	UTILITY MARKER POST
	UTILITY MARKER POST	⊙	OVERHEAD ELECTRIC LINE
	OVERHEAD ELECTRIC LINE	⊙	

ITEM	DESCRIPTION	UNIT	QTY
0104 6015	REMOVING CONC (SIDEWALKS)	SY	71
0104 6017	REMOVING CONC (DRIVEWAYS)	SY	117
0104 6029	REMOVING CONC (CURB OR CURB & GUTTER)	LF	16
0105 6070	REMOVING STAB BASE & ASPH PAV (6" - 8")	SY	72
0160 6003	FURNISHING AND PLACING TOP SOIL (4")	SY	16
0162 6002	BLOCK SODDING	SY	16
0168 6001	VEGETATIVE WATERING	MG	0.6
0529 6008	CONC CURB & GUTTER (TY II)	LF	16
0530 6004	DRIVEWAYS (CONC)	SY	165
0531 6001	CONC SIDEWALK (4")	SY	95
0531 6004	CURB RAMPS (TY 1)	EA	1
0531 6013	CURB RAMPS (TY 10)	EA	1
0644 6068	RELOCATE SM RD SN SUP&M TY 10BWG	EA	1

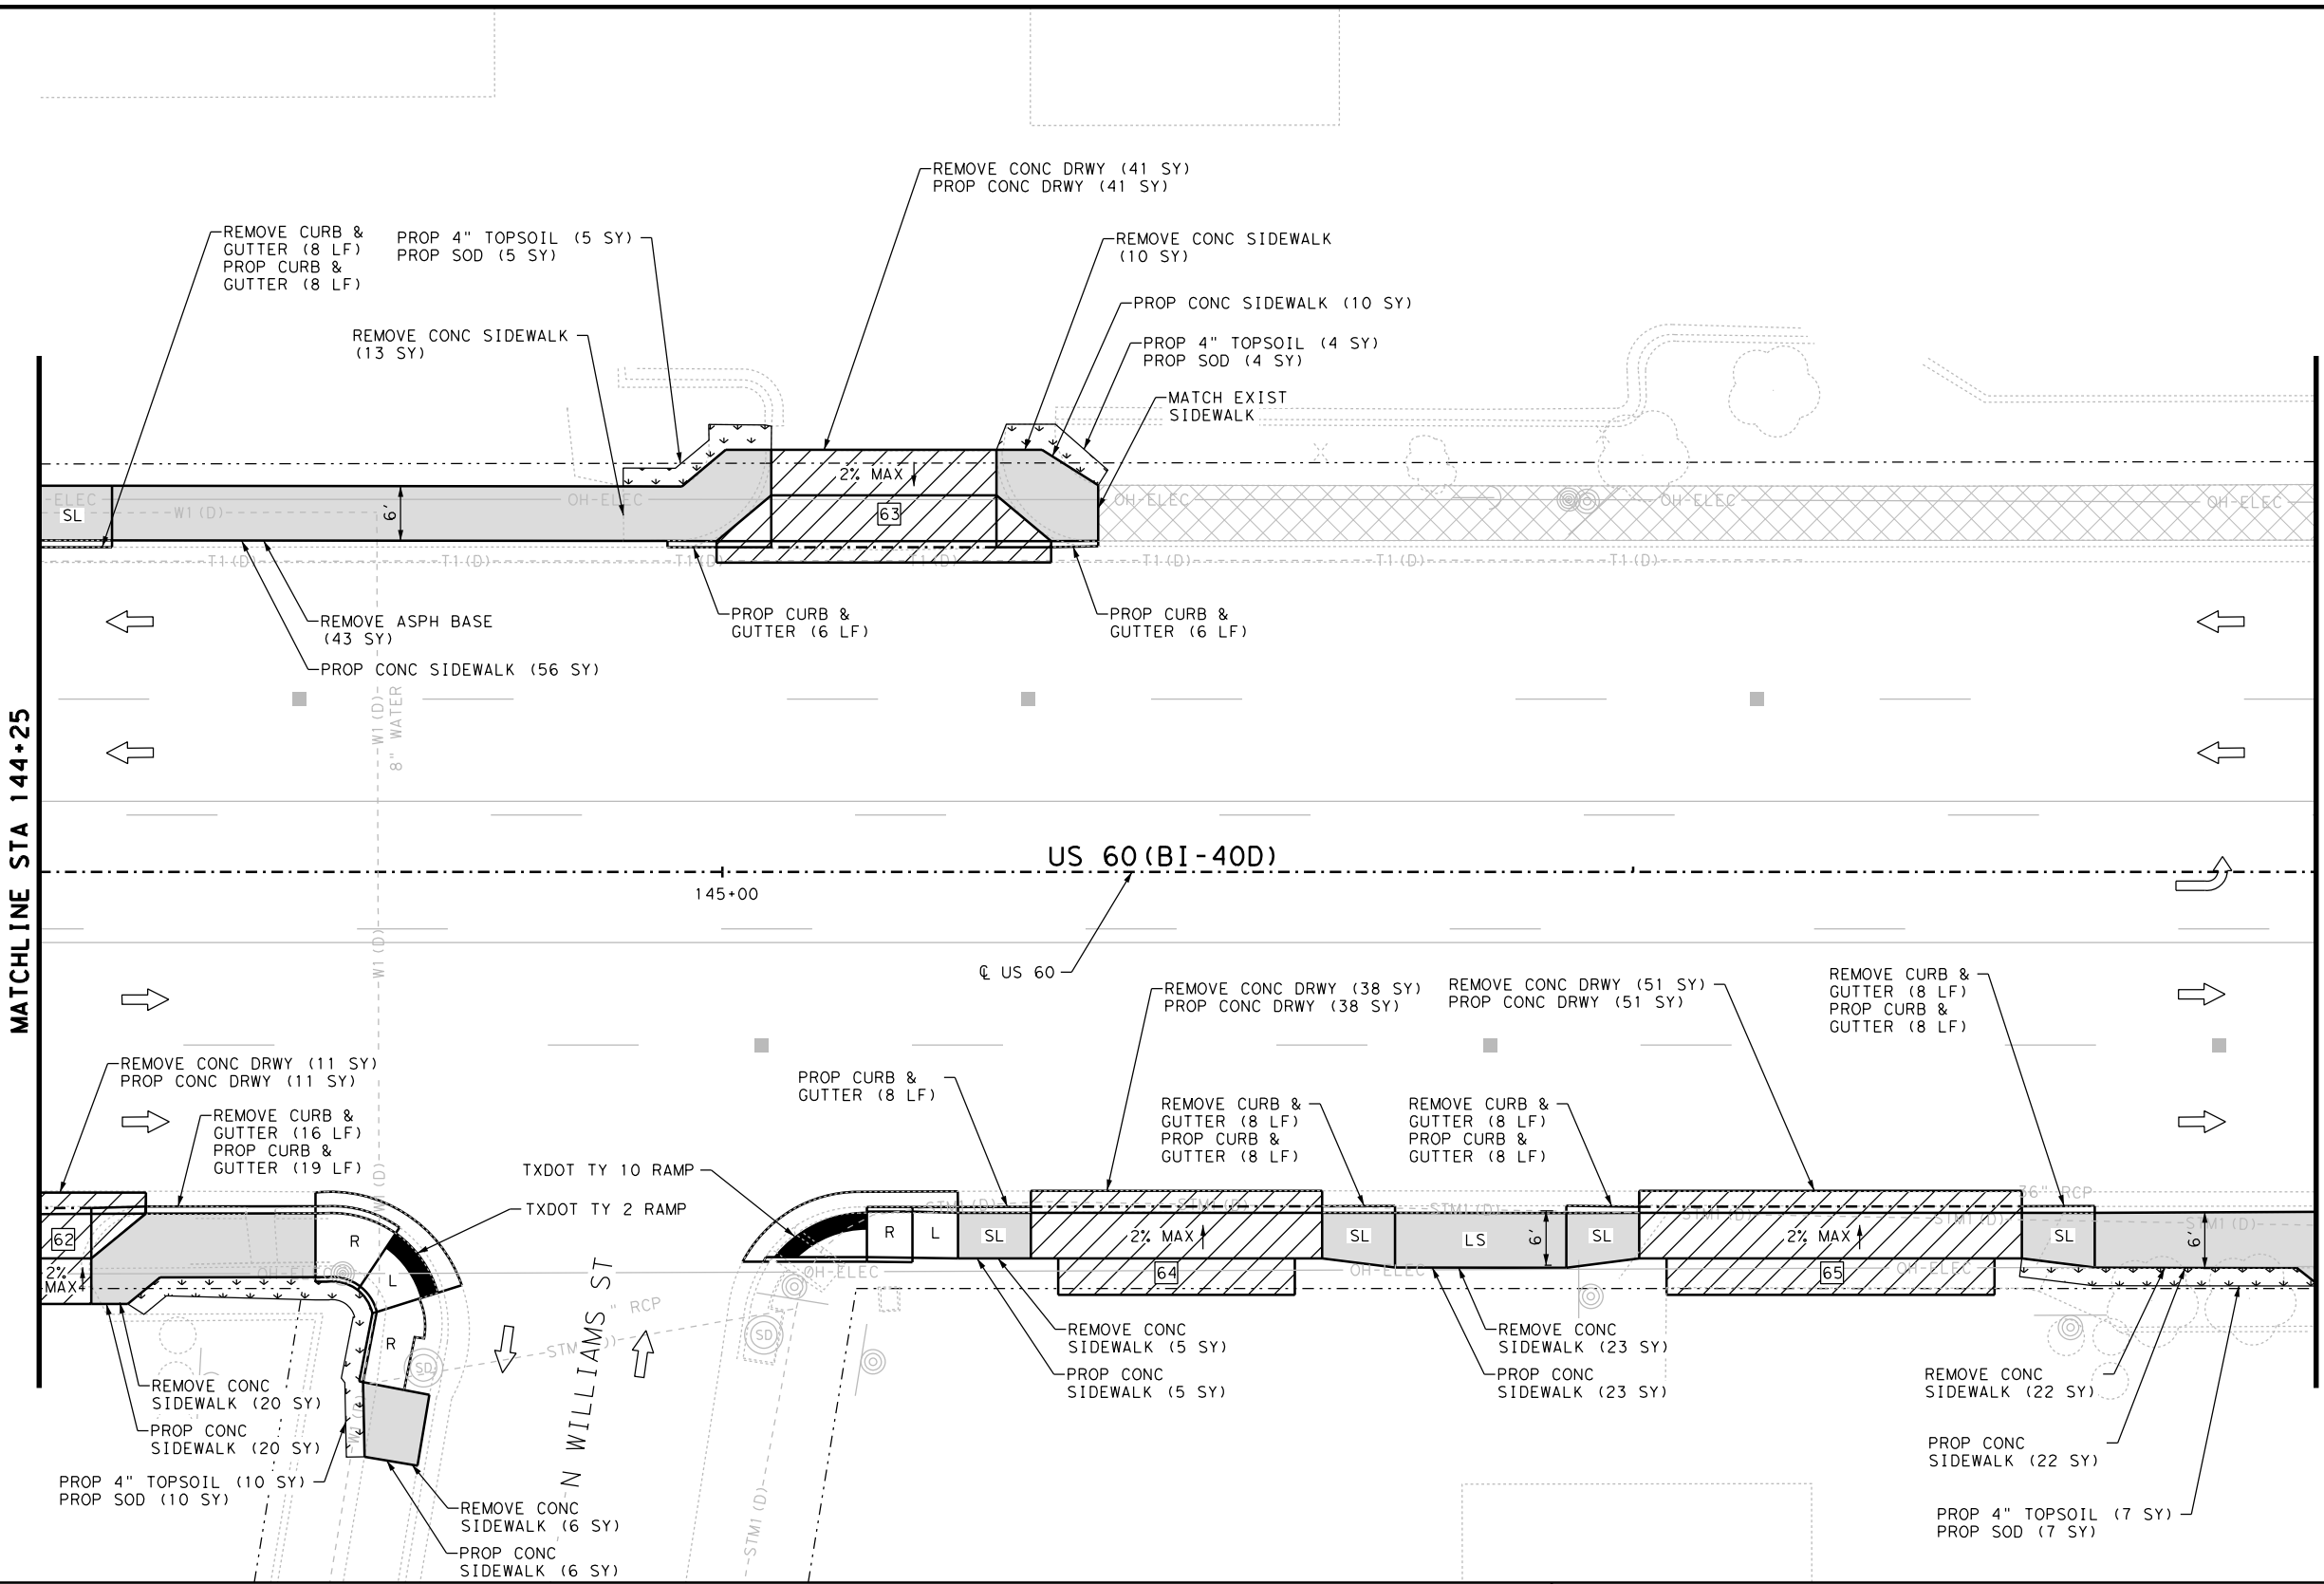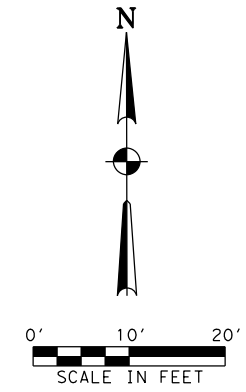

NOTES:
 * FOR CONTRACTOR INFORMATION ONLY
 1. THE EXISTENCE AND LOCATION OF ALL UTILITIES AND DRAINAGE STRUCTURES INDICATED IN THE PLANS ARE TAKEN FROM THE BEST RECORDS AVAILABLE AND ARE NOT GUARANTEED TO BE ACCURATE. CONTRACTOR SHALL COORDINATE WITH ALL UTILITY COMPANIES TO FIELD VERIFY UTILITIES PRIOR TO BEGINNING CONSTRUCTION.

NO.	DATE	REVISION	BY



GLOBAL CIVIL SOLUTIONS, LLC
 11551 FOREST CENTRAL DRIVE
 SUITE 220
 DALLAS, TX 75243
 F-12801



**US 60 (BI 40-D)
 SIDEWALK PLAN**



STA 144+25 TO STA 146+75

SHEET 20 OF 44

LEGEND					
	PROP SODDING	R	RAMP		POWER POLE
	PROP CONC DRWY	L	LANDING PAD		TRAFFIC SIGNAL POLE
	PROP CONC RIPRAP	F	FLARE		LIGHT POLE
	PROP RETAINING WALL	SL	LONG. SLOPE MAY NOT EXCEED 5% OR ADJACENT ROAD SLOPE		WATER METER
	PROP CONC SIDEWALK	T	TRANSITION		FIRE HYDRANT
	EXISTING SIDEWALK/DRWY TO REMAIN	LS	LEVEL SIDEWALK (2% MAX)		GUY WIRE
			TRAFFIC FLOW		TREE/SHRUB
			EXISTING SIGN		FENCE
			PROPOSED SIGN		WATER VALVE
			MANHOLE		TRAFFIC SIGNAL BOX
					IRRIGATION CONTROL VALVE
					ELECTRICAL PULL BOX
					DRIVEWAY ID
					PEDESTRIAN SIGNAL
					GAS METER
					SPRINKLER HEAD
					UTILITY MARKER POST
					OVERHEAD ELECTRIC LINE

ITEM	DESCRIPTION	UNIT	QTY
0104 6015	REMOVING CONC (SIDEWALKS)	SY	99
0104 6017	REMOVING CONC (DRIVEWAYS)	SY	148
0104 6029	REMOVING CONC (CURB OR CURB & GUTTER)	LF	48
0105 6070	REMOVING STAB BASE & ASPH PAV (6" - 8")	SY	43
0160 6003	FURNISHING AND PLACING TOP SOIL (4")	SY	26
0162 6002	BLOCK SODDING	SY	26
0168 6001	VEGETATIVE WATERING	MG	1.0
0529 6008	CONC CURB & GUTTER (TY II)	LF	71
0530 6004	DRIVEWAYS (CONC)	SY	148
0531 6001	CONC SIDEWALK (4")	SY	142
0531 6005	CURB RAMPS (TY 2)	EA	1
0531 6013	CURB RAMPS (TY 10)	EA	1

P:\Jobs\2020007-Pedestrian\TXDOT\Amor\1110\CA00\VP3\SHEETS\047_AM_US_60_ST200F44.dgn
 5:18:28 PM 1/27/2022

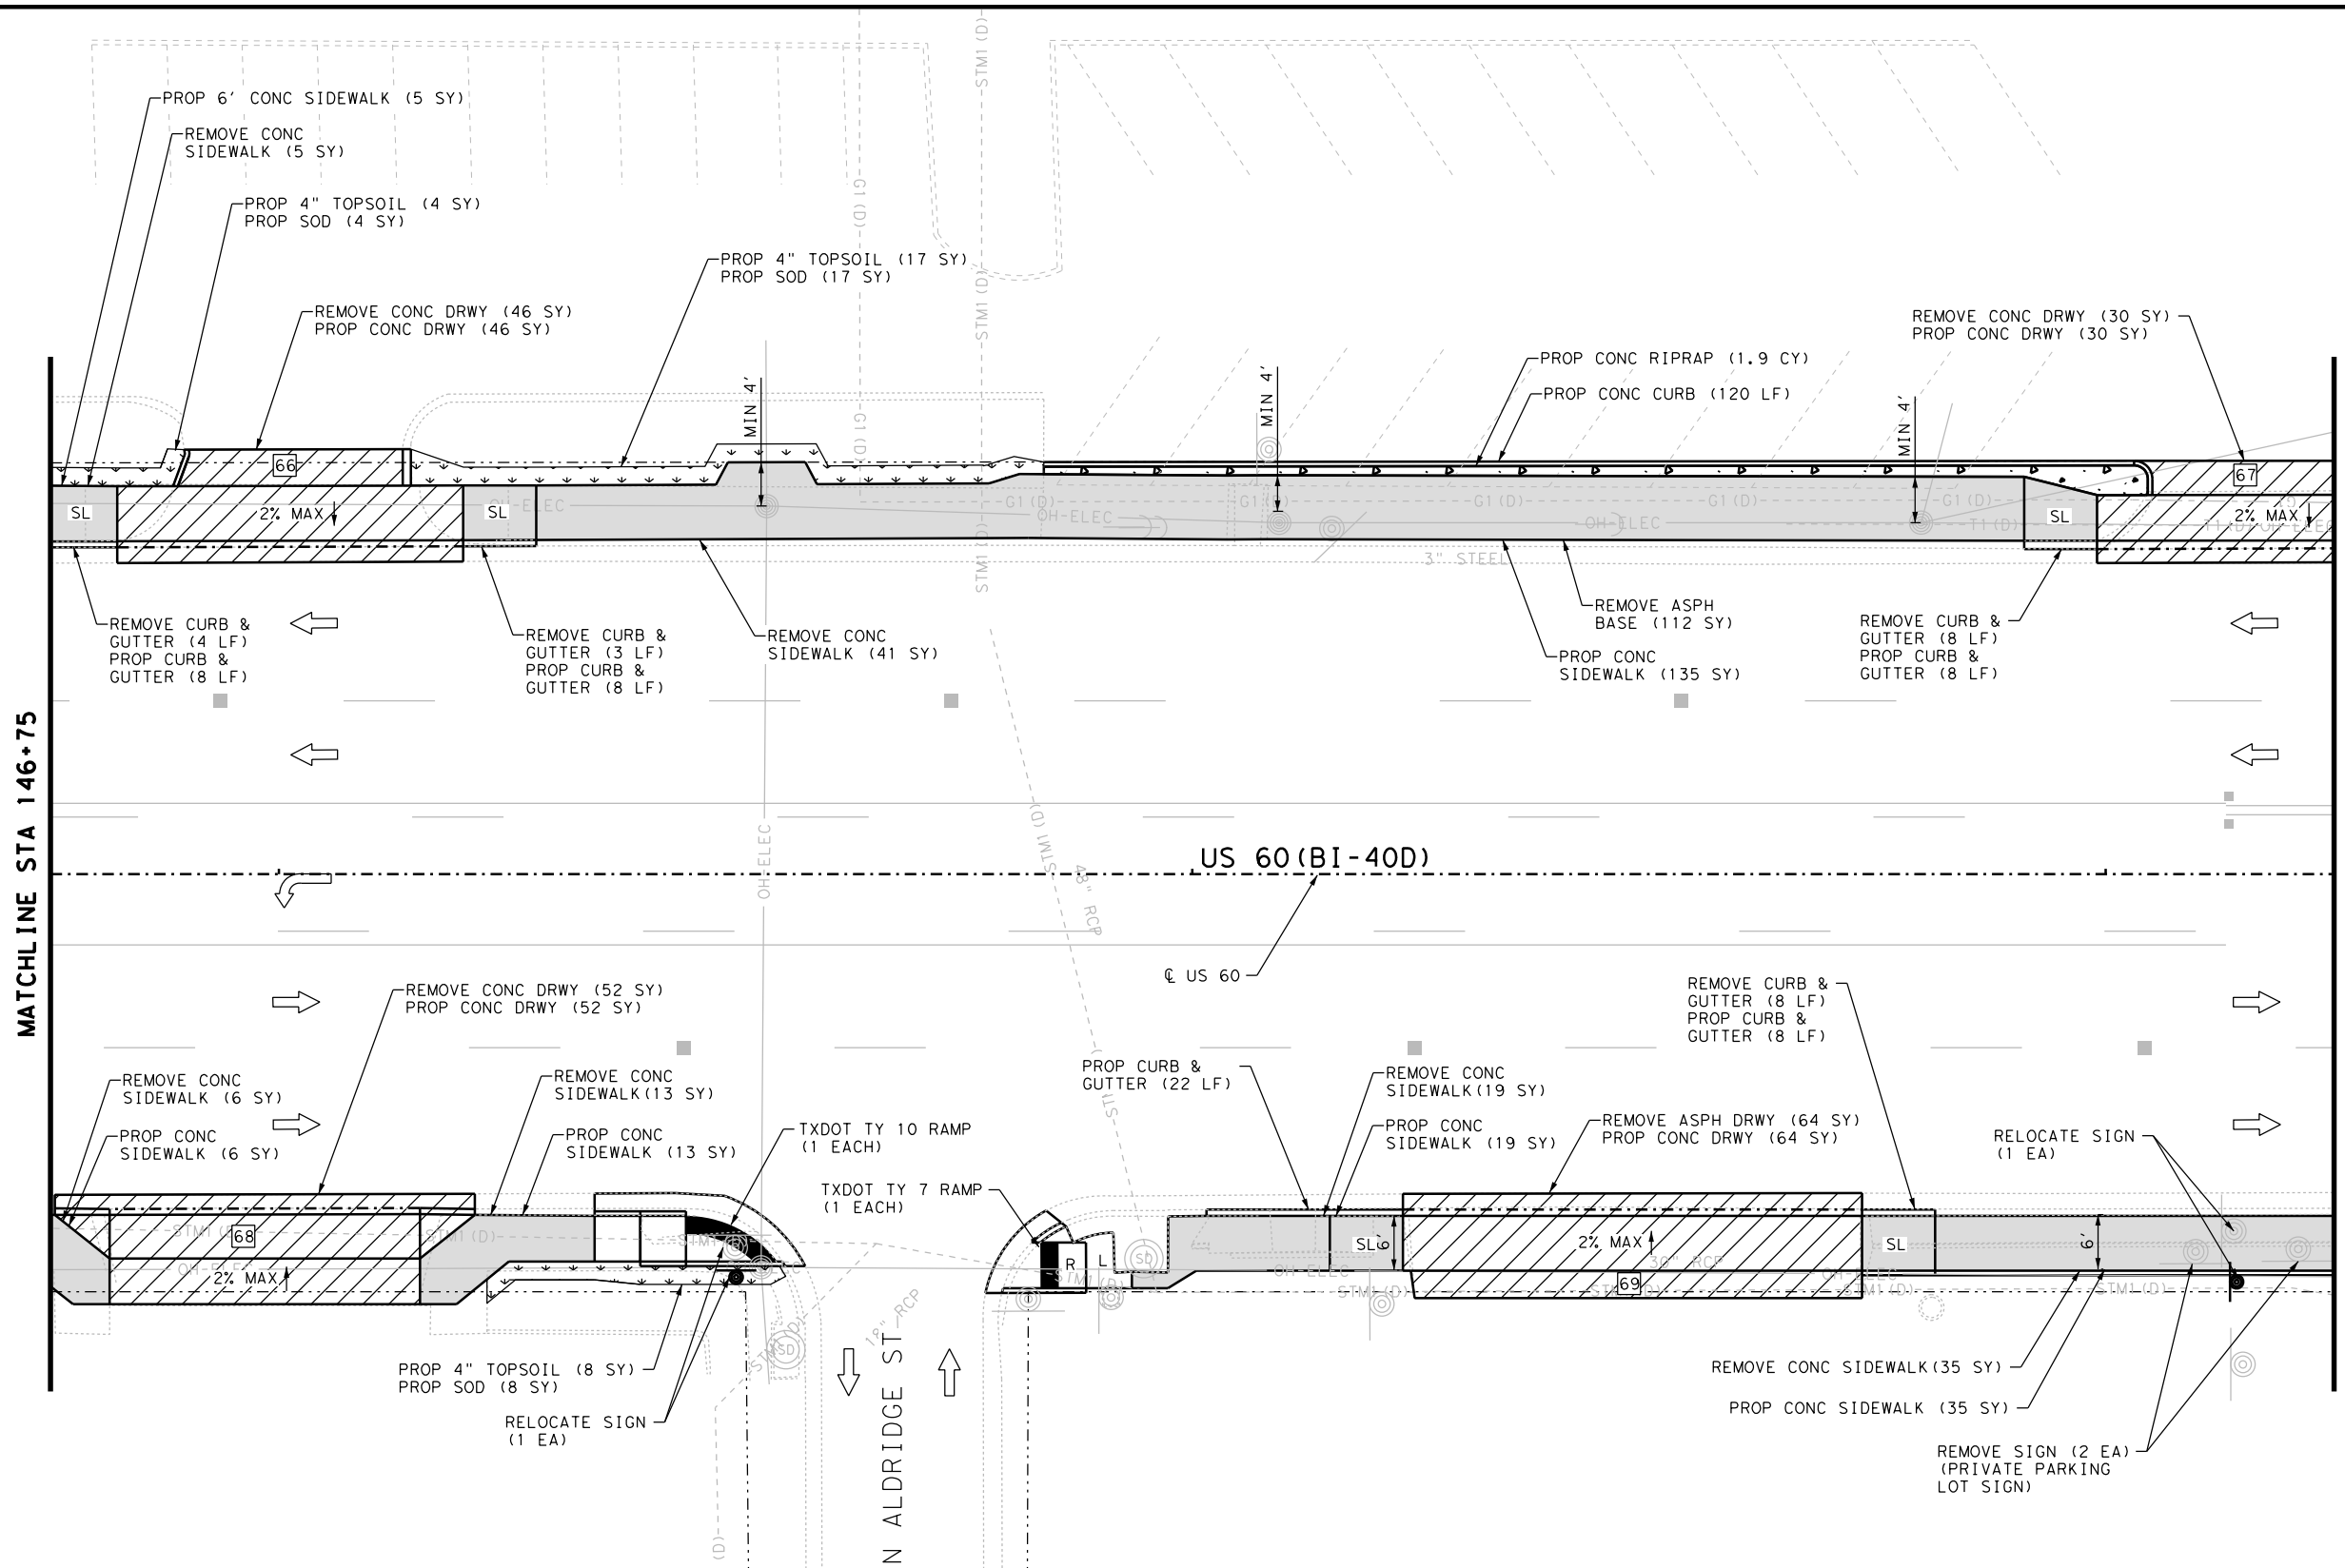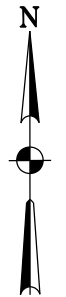

- NOTES:
- * FOR CONTRACTOR INFORMATION ONLY
 - 1. THE EXISTENCE AND LOCATION OF ALL UTILITIES AND DRAINAGE STRUCTURES INDICATED IN THE PLANS ARE TAKEN FROM THE BEST RECORDS AVAILABLE AND ARE NOT GUARANTEED TO BE ACCURATE. CONTRACTOR SHALL COORDINATE WITH ALL UTILITY COMPANIES TO FIELD VERIFY UTILITIES PRIOR TO BEGINNING CONSTRUCTION.

NO.	DATE	REVISION	BY



GLOBAL CIVIL SOLUTIONS, LLC
 11551 FOREST CENTRAL DRIVE
 SUITE 220
 DALLAS, TX 75243
 F-12801



**US 60 (BI 40-D)
 SIDEWALK PLAN**

STA 146+75 TO STA 149+25

SHEET 21 OF 44

DESIGN	FED. RD. DIV. NO.	FEDERAL AID PROJECT NO.	HIGHWAY NO.
MI	6	(SEE TITLE SHEET)	VARIOUS
GRAPHICS	STATE	DISTRICT	COUNTY
PS	TEXAS	AMA	POTTER
CHECK	CONTROL	SECTION	JOB
MF	0904	02	047
CHECK	FS		



049

LEGEND

- | | | | |
|----------------------------------|---|---------------------|--------------------------|
| PROP SODDING | R RAMP | POWER POLE | IRRIGATION CONTROL VALVE |
| PROP CONC DRWY | L LANDING PAD | TRAFFIC SIGNAL POLE | ELECTRICAL PULL BOX |
| PROP CONC RIPRAP | F FLARE | LIGHT POLE | DRIVEWAY ID |
| PROP RETAINING WALL | SL LONG. SLOPE MAY NOT EXCEED 5% OR ADJACENT ROAD SLOPE | WATER METER | PEDESTRIAN SIGNAL |
| PROP CONC SIDEWALK | T TRANSITION | FIRE HYDRANT | GAS METER |
| EXISTING SIDEWALK/DRWY TO REMAIN | LS LEVEL SIDEWALK (2% MAX) | GUY WIRE | SPRINKLER HEAD |
| | TRAFFIC FLOW | TREE/SHRUB | UTILITY MARKER POST |
| | EXISTING SIGN | FENCE | OVERHEAD ELECTRIC LINE |
| | PROPOSED SIGN | WATER VALVE | |
| | MANHOLE | TRAFFIC SIGNAL BOX | |

ITEM	DESCRIPTION	UNIT	QTY
0104 6015	REMOVING CONC (SIDEWALKS)	SY	119
0104 6017	REMOVING CONC (DRIVEWAYS)	SY	128
0104 6029	REMOVING CONC (CURB OR CURB & GUTTER)	LF	23
0105 6070	REMOVING STAB BASE & ASPH PAV (6" - 8")	SY	176
0160 6003	FURNISHING AND PLACING TOP SOIL (4")	SY	29
0162 6002	BLOCK SODDING	SY	29
0168 6001	VEGETATIVE WATERING	MG	1.1
0432 6001	RIPRAP (CONC) (4 IN)	CY	1.9
0529 6008	CONC CURB & GUTTER (TY II)	LF	174
0530 6004	DRIVEWAYS (CONC)	SY	192
0531 6001	CONC SIDEWALK (4")	SY	213
0644 6068	RELOCATE SM RD SN SUP&M TY 10BWG	EA	2
0644 6076	REMOVE SM RD SN SUP&M	EA	2

P:\Jobs\2020007-Pedestrian\TxDOT\Amor\1110\CA00\VP3-SHEETS\047_AM_US_60_ST1210F44.dgn
 5:18:28 PM
 1/27/2022

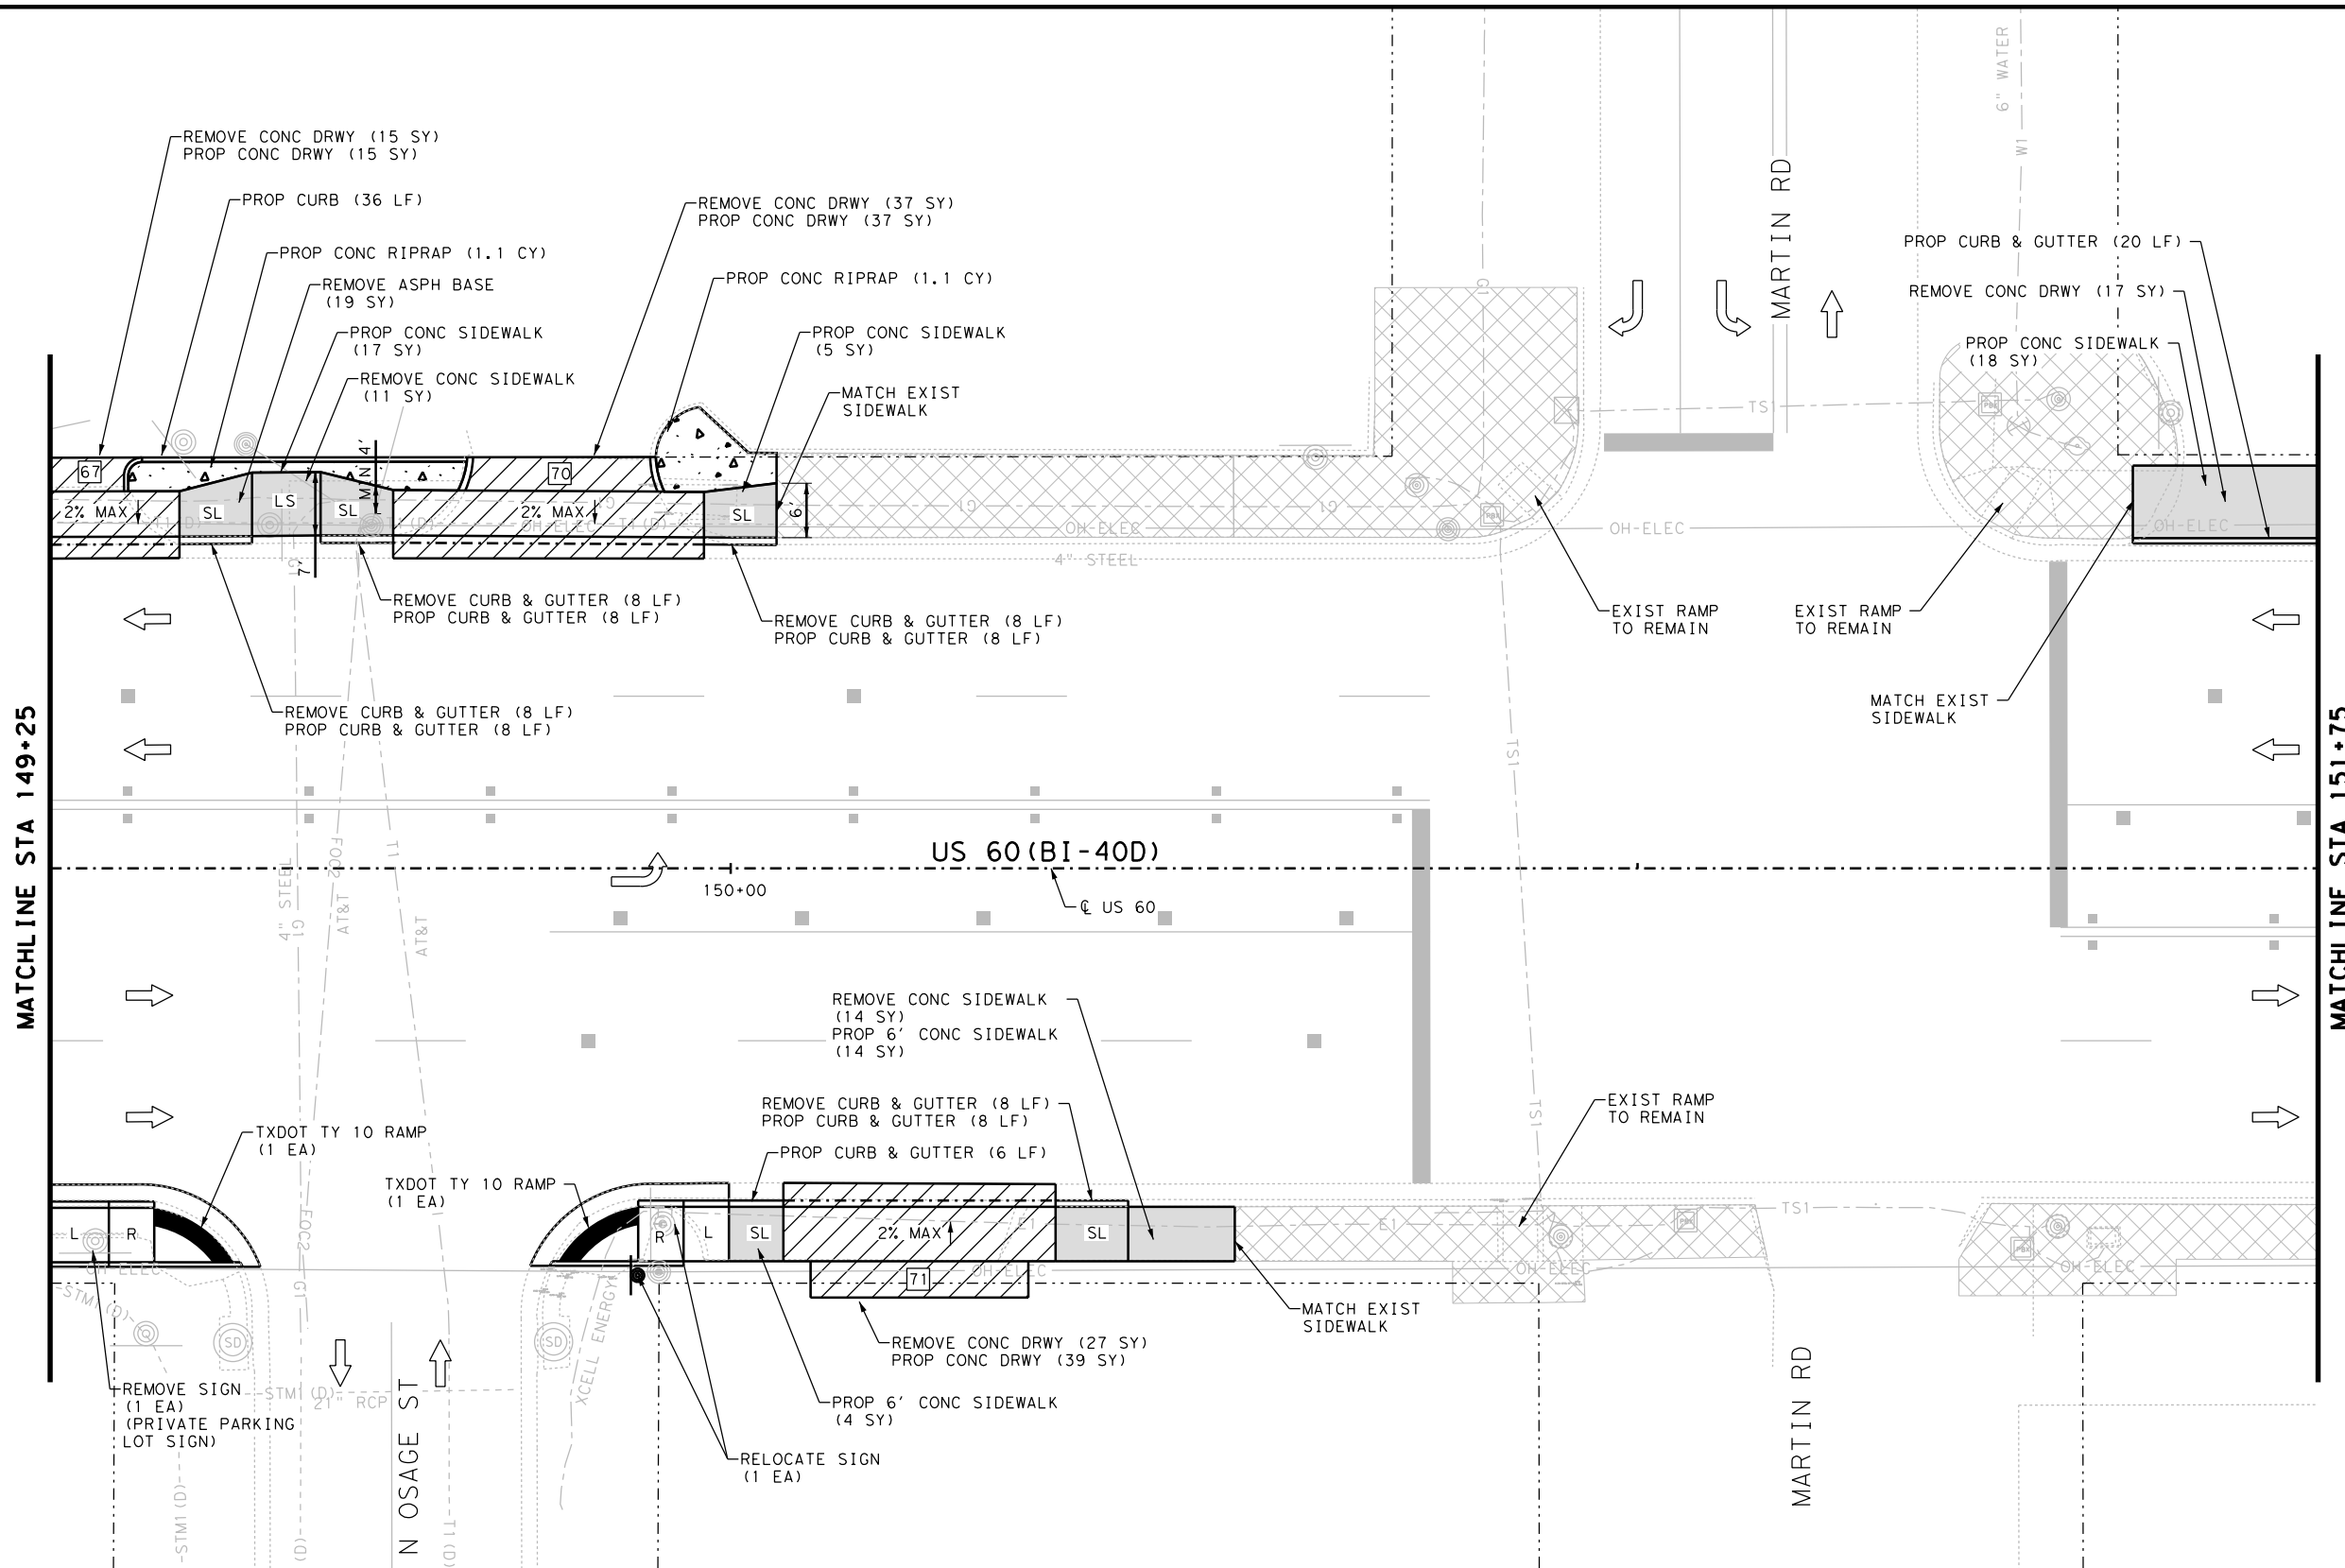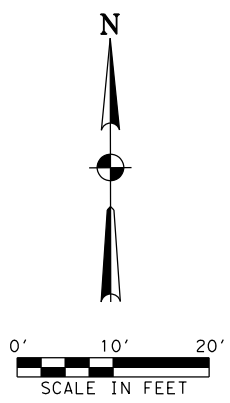

NOTES:
 * FOR CONTRACTOR INFORMATION ONLY
 1. THE EXISTENCE AND LOCATION OF ALL UTILITIES AND DRAINAGE STRUCTURES INDICATED IN THE PLANS ARE TAKEN FROM THE BEST RECORDS AVAILABLE AND ARE NOT GUARANTEED TO BE ACCURATE. CONTRACTOR SHALL COORDINATE WITH ALL UTILITY COMPANIES TO FIELD VERIFY UTILITIES PRIOR TO BEGINNING CONSTRUCTION.

NO.	DATE	REVISION	BY



GLOBAL CIVIL SOLUTIONS, LLC
 11551 FOREST CENTRAL DRIVE
 SUITE 220
 DALLAS, TX 75243
 F-12801



**US 60 (BI 40-D)
 SIDEWALK PLAN**

STA 149+25 TO STA 151+75

SHEET 22 OF 44

DESIGN	FED. RD. DIV. NO.	FEDERAL AID PROJECT NO.	HIGHWAY NO.
MI	6	(SEE TITLE SHEET)	VARIOUS
GRAPHICS	STATE	DISTRICT	COUNTY
PS	TEXAS	AMA	POTTER
CHECK	CONTROL	SECTION	JOB
MFM			
CHECK			
FS	0904	02	047



050

LEGEND

- | | | | | | | | |
|--|----------------------------------|----|--|--|---------------------|--|--------------------------|
| | PROP SODDING | R | RAMP | | POWER POLE | | IRRIGATION CONTROL VALVE |
| | PROP CONC DRWY | L | LANDING PAD | | TRAFFIC SIGNAL POLE | | ELECTRICAL PULL BOX |
| | PROP CONC RIPRAP | F | FLARE | | LIGHT POLE | | DRIVEWAY ID |
| | PROP RETAINING WALL | SL | LONG. SLOPE MAY NOT EXCEED 5% OR ADJACENT ROAD SLOPE | | WATER METER | | PEDESTRIAN SIGNAL |
| | PROP CONC SIDEWALK | T | TRANSITION | | FIRE HYDRANT | | GAS METER |
| | EXISTING SIDEWALK/DRWY TO REMAIN | LS | LEVEL SIDEWALK (2% MAX) | | GUY WIRE | | SPRINKLER HEAD |
| | | | TRAFFIC FLOW | | TREE/SHRUB | | UTILITY MARKER POST |
| | | | EXISTING SIGN | | FENCE | | OVERHEAD ELECTRIC LINE |
| | | | PROPOSED SIGN | | WATER VALVE | | |
| | | | MANHOLE | | TRAFFIC SIGNAL BOX | | |

ITEM	DESCRIPTION	UNIT	QTY
0104 6015	REMOVING CONC (SIDEWALKS)	SY	25
0104 6017	REMOVING CONC (DRIVEWAYS)	SY	96
0104 6029	REMOVING CONC (CURB OR CURB & GUTTER)	LF	32
0105 6070	REMOVING STAB BASE & ASPH PAV (6" - 8")	SY	19
0432 6001	RIPRAP (CONC) (4 IN)	CY	2.2
0529 6008	CONC CURB & GUTTER (TY II)	LF	94
0530 6004	DRIVEWAYS (CONC)	SY	91
0531 6001	CONC SIDEWALK (4")	SY	58
0531 6013	CURB RAMPS (TY 10)	EA	2
0644 6068	RELOCATE SM RD SN SUP&AM TY 10BWG	EA	1
0644 6076	REMOVE SM RD SN SUP&AM	EA	1

P:\Jobs\202007-Pedestrian\1110-CA00\VP3-SHEETS\047_AM_US_60_ST1220F44.dgn
 5:18:31 PM
 1/27/2022

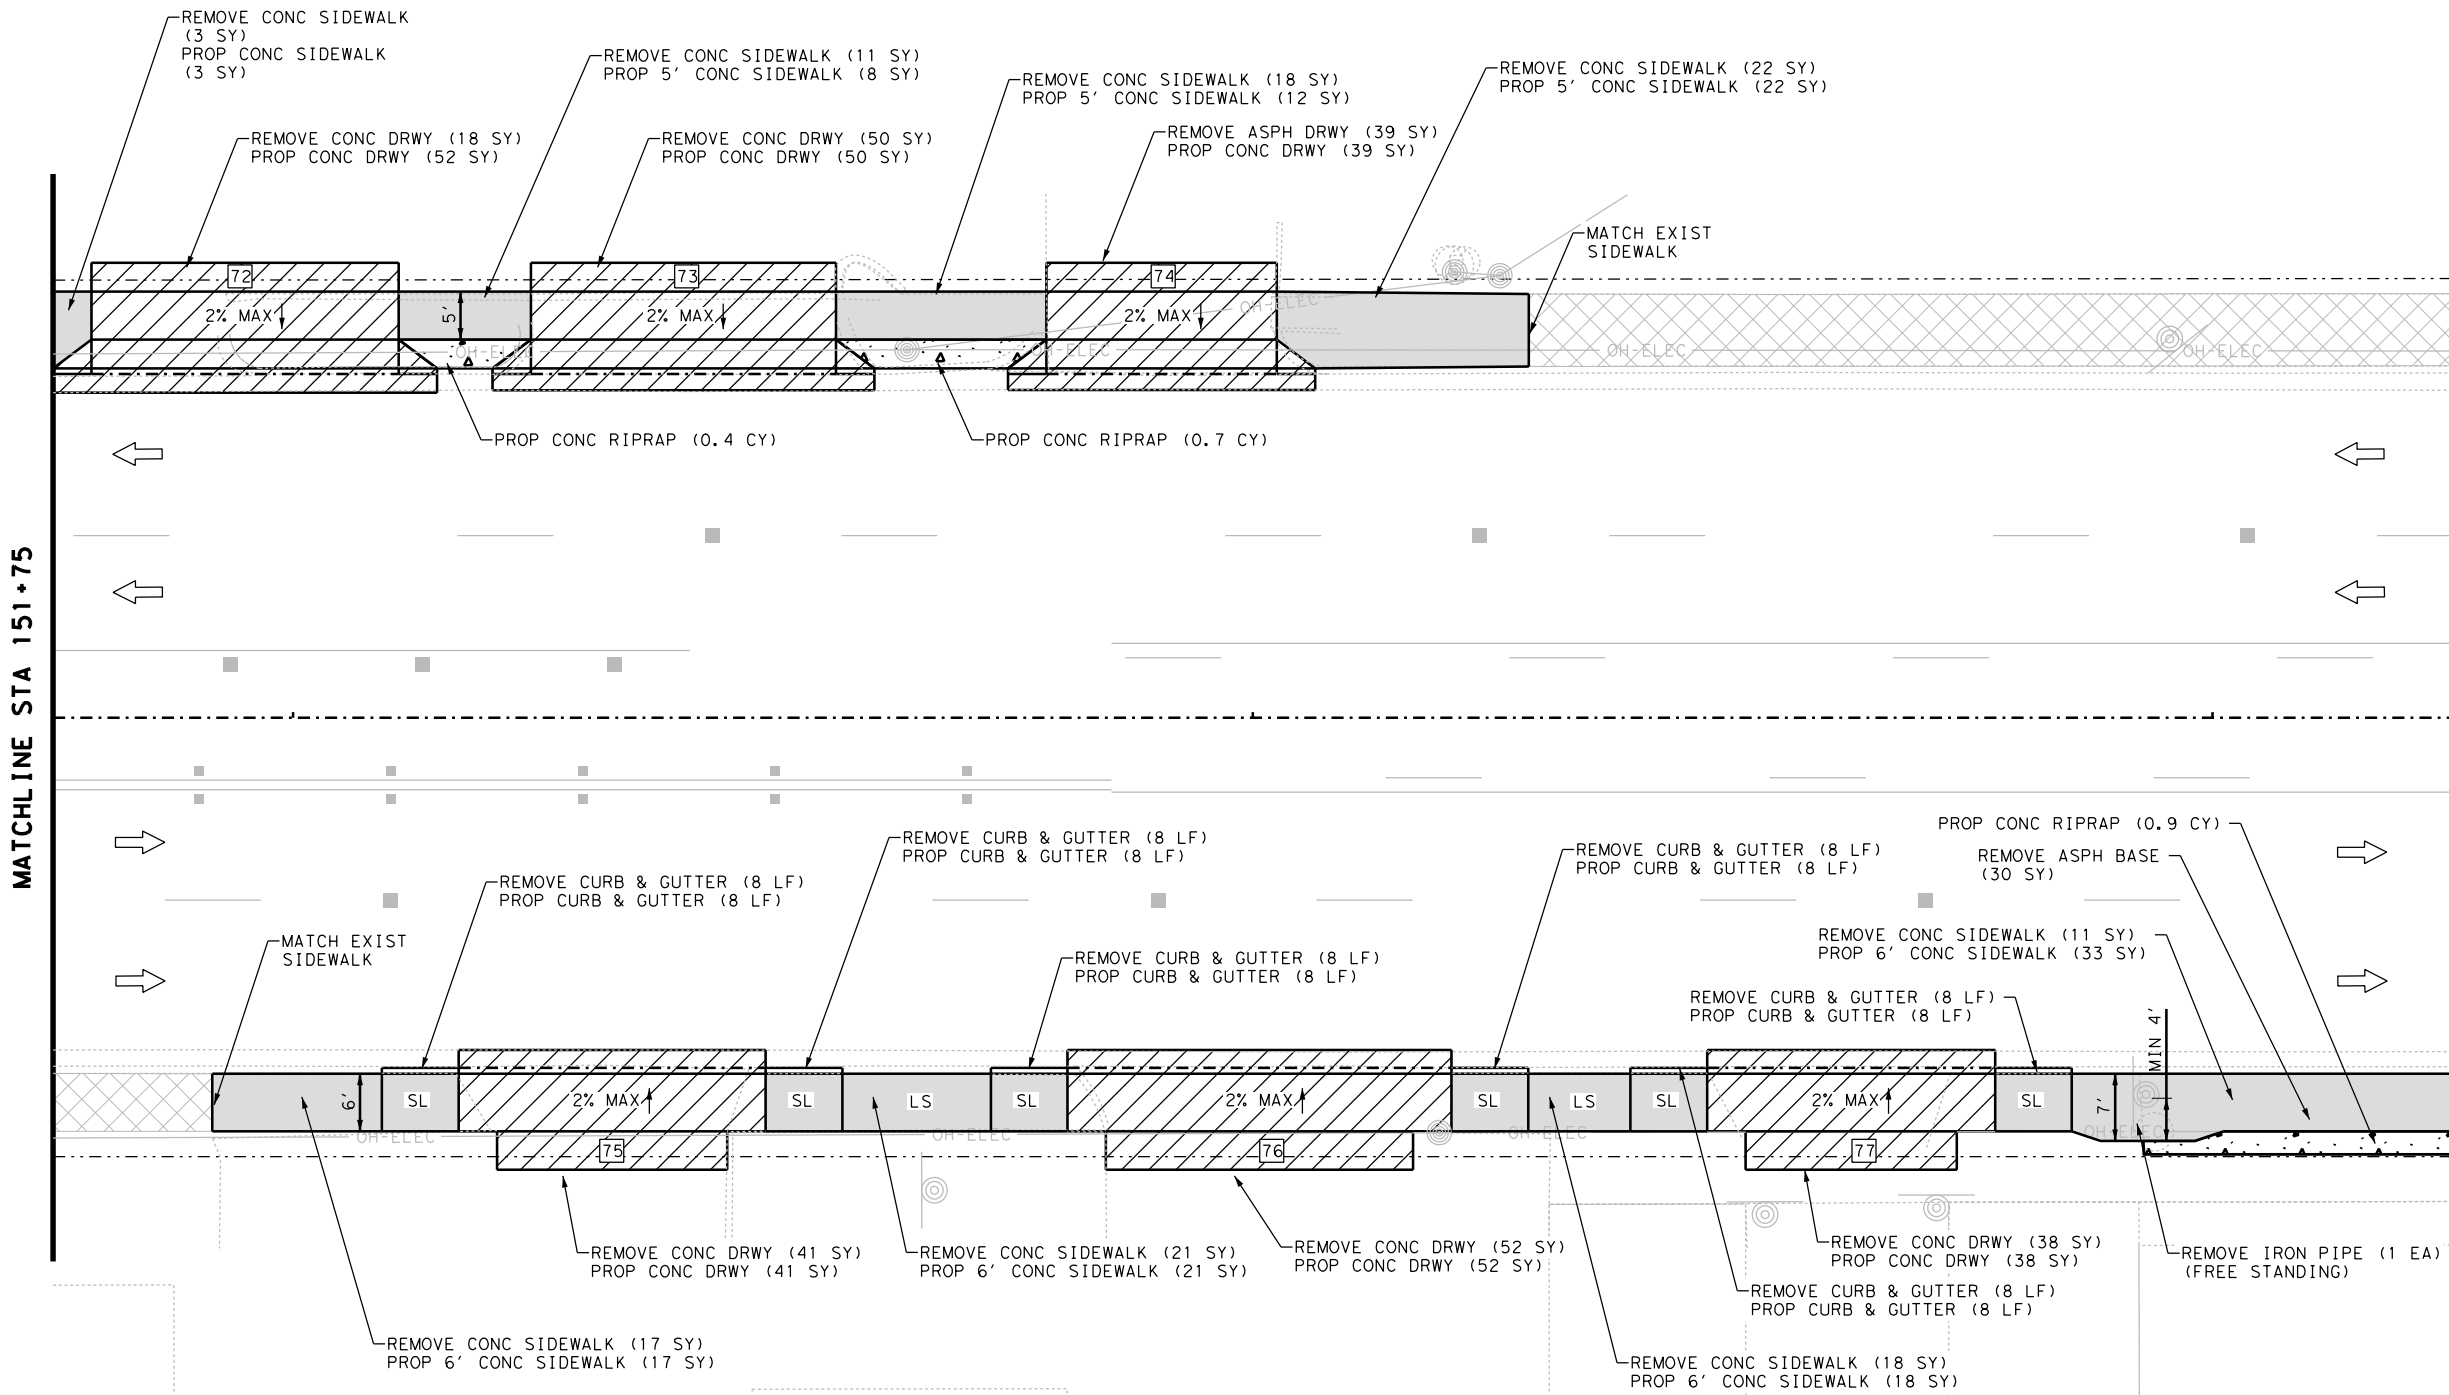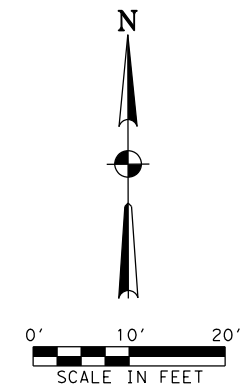

NOTES:
 * FOR CONTRACTOR INFORMATION ONLY
 1. THE EXISTENCE AND LOCATION OF ALL UTILITIES AND DRAINAGE STRUCTURES INDICATED IN THE PLANS ARE TAKEN FROM THE BEST RECORDS AVAILABLE AND ARE NOT GUARANTEED TO BE ACCURATE. CONTRACTOR SHALL COORDINATE WITH ALL UTILITY COMPANIES TO FIELD VERIFY UTILITIES PRIOR TO BEGINNING CONSTRUCTION.

NO.	DATE	REVISION	BY



GLOBAL CIVIL SOLUTIONS, LLC
 11551 FOREST CENTRAL DRIVE
 SUITE 220
 DALLAS, TX 75243
 F-12801



**US 60 (BI 40-D)
 SIDEWALK PLAN**

STA 151+75 TO STA 154+25



SHEET 23 OF 44

DESIGN	FED. RD. DIV. NO.	FEDERAL AID PROJECT NO.	HIGHWAY NO.
MI	6	(SEE TITLE SHEET)	VARIOUS
GRAPHICS	STATE	DISTRICT	COUNTY
PS	TEXAS	AMA	POTTER
CHECK	CONTROL	SECTION	JOB
MFM			
CHECK	FS	0904	02 047

ITEM	DESCRIPTION	UNIT	QTY
0104 6015	REMOVING CONC (SIDEWALKS)	SY	121
0104 6017	REMOVING CONC (DRIVEWAYS)	SY	199
0104 6029	REMOVING CONC (CURB OR CURB & GUTTER)	LF	48
0105 6070	REMOVING STAB BASE & ASPH PAV (6" - 8")	SY	69
0432 6001	RIPRAP (CONC) (4 IN)	CY	2.0
0496 6030	REMOVE STR (BOLLARD)	EA	1
0529 6008	CONC CURB & GUTTER (TY II)	LF	48
0530 6004	DRIVEWAYS (CONC)	SY	272
0531 6001	CONC SIDEWALK (4")	SY	134

LEGEND			
	PROP SODDING	R	RAMP
	PROP CONC DRWY	L	LANDING PAD
	PROP CONC RIPRAP	F	FLARE
	PROP RETAINING WALL	SL	LONG. SLOPE MAY NOT EXCEED 5% OR ADJACENT ROAD SLOPE
	PROP CONC SIDEWALK	T	TRANSITION
	EXISTING SIDEWALK/DRWY TO REMAIN	LS	LEVEL SIDEWALK (2% MAX)
	PROPOSED SIGN	←	TRAFFIC FLOW
	EXISTING SIGN	⊙	EXISTING SIGN
	PROPOSED SIGN	⊙	MANHOLE
	POWER POLE	⊙	TRAFFIC SIGNAL POLE
	TRAFFIC SIGNAL POLE	⊙	LIGHT POLE
	LIGHT POLE	⊙	WATER METER
	WATER METER	⊙	FIRE HYDRANT
	FIRE HYDRANT	⊙	GUY WIRE
	GUY WIRE	—x—x—	TREE/SHRUB
	TREE/SHRUB	⊗	FENCE
	FENCE	⊗	WATER VALVE
	WATER VALVE	⊗	TRAFFIC SIGNAL BOX
	TRAFFIC SIGNAL BOX	⊗	IRRIGATION CONTROL VALVE
	IRRIGATION CONTROL VALVE	⊗	ELECTRICAL PULL BOX
	ELECTRICAL PULL BOX	⊗	DRIVEWAY ID
	DRIVEWAY ID	⊗	PEDESTRIAN SIGNAL
	PEDESTRIAN SIGNAL	⊗	GAS METER
	GAS METER	⊗	SPRINKLER HEAD
	SPRINKLER HEAD	⊗	UTILITY MARKER POST
	UTILITY MARKER POST	⊗	OVERHEAD ELECTRIC LINE
	OVERHEAD ELECTRIC LINE	—OP—	

P:\Jobs\2020007-Pedestrian\TXDOT_Ampor\1110-CA00\VP3-SHEETS\047_AM_US_60_S1230F44.dgn
 5:18:32 PM
 1/27/2022

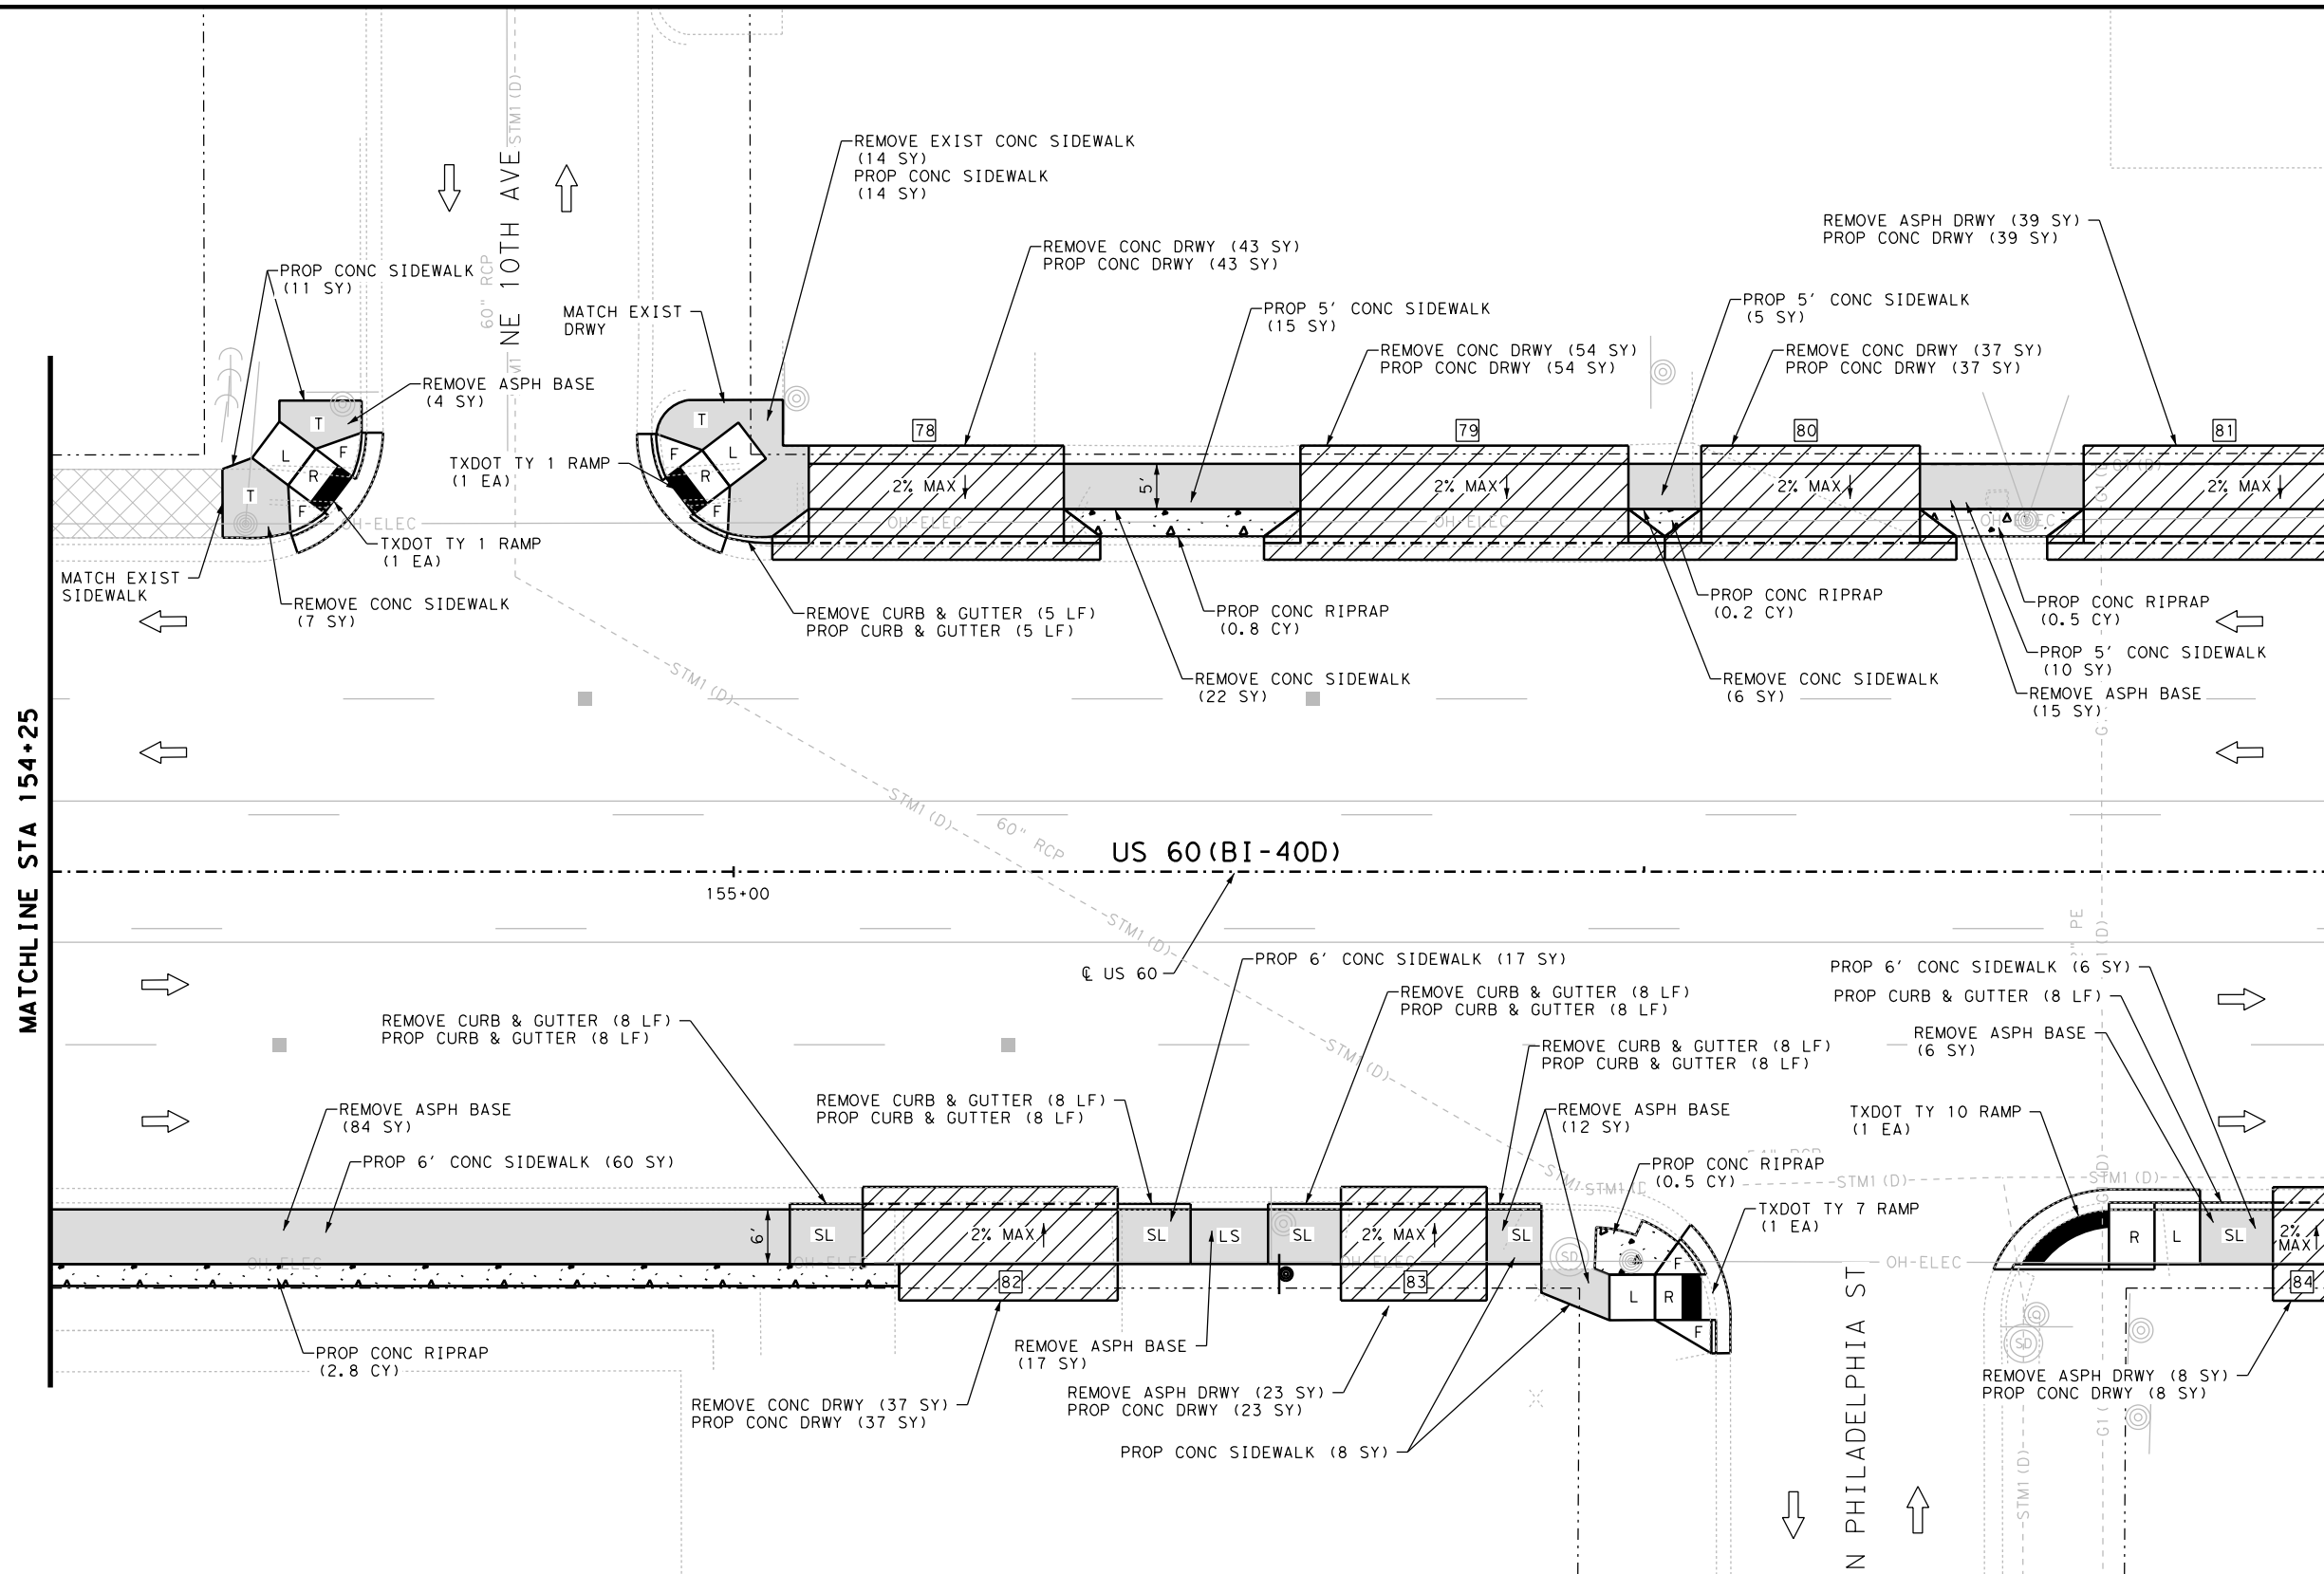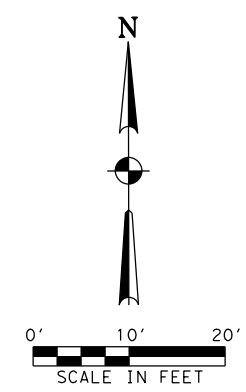

NOTES:
 * FOR CONTRACTOR INFORMATION ONLY
 1. THE EXISTENCE AND LOCATION OF ALL UTILITIES AND DRAINAGE STRUCTURES INDICATED IN THE PLANS ARE TAKEN FROM THE BEST RECORDS AVAILABLE AND ARE NOT GUARANTEED TO BE ACCURATE. CONTRACTOR SHALL COORDINATE WITH ALL UTILITY COMPANIES TO FIELD VERIFY UTILITIES PRIOR TO BEGINNING CONSTRUCTION.

NO.	DATE	REVISION	BY



GLOBAL CIVIL SOLUTIONS, LLC
 11551 FOREST CENTRAL DRIVE
 SUITE 220
 DALLAS, TX 75243
 F-12801



**US 60 (BI 40-D)
 SIDEWALK PLAN**

STA 154+25 TO STA 156+75

SHEET 24 OF 44



DESIGN	FED. RD. DIV. NO.	FEDERAL AID PROJECT NO.	HIGHWAY NO.
MI	6	(SEE TITLE SHEET)	VARIOUS
GRAPHICS	STATE	DISTRICT	COUNTY
PS	TEXAS	AMA	POTTER
CHECK	CONTROL	SECTION	JOB
MF			
CHECK	NO.	NO.	NO.
FS	0904	02	047

052

LEGEND			
	PROP SODDING	R	RAMP
	PROP CONC DRWY	L	LANDING PAD
	PROP CONC RIPRAP	F	FLARE
	PROP RETAINING WALL	SL	LONG. SLOPE MAY NOT EXCEED 5% OR ADJACENT ROAD SLOPE
	PROP CONC SIDEWALK	T	TRANSITION
	EXISTING SIDEWALK/DRWY TO REMAIN	LS	LEVEL SIDEWALK (2% MAX)
	TRAFFIC FLOW		EXISTING SIGN
	PROPOSED SIGN		MANHOLE
	POWER POLE		TRAFFIC SIGNAL POLE
	LIGHT POLE		WATER METER
	FIRE HYDRANT		GUY WIRE
	TREE/SHRUB		FENCE
	WATER VALVE		TRAFFIC SIGNAL BOX
	IRRIGATION CONTROL VALVE		ELECTRICAL PULL BOX
	DRIVEWAY ID		PEDESTRIAN SIGNAL
	GAS METER		SPRINKLER HEAD
	UTILITY MARKER POST		OVERHEAD ELECTRIC LINE

ITEM	DESCRIPTION	UNIT	QTY
0104 6015	REMOVING CONC (SIDEWALKS)	SY	49
0104 6017	REMOVING CONC (DRIVEWAYS)	SY	171
0104 6029	REMOVING CONC (CURB OR CURB & GUTTER)	LF	37
0105 6070	REMOVING STAB BASE & ASPH PAV (6" - 8")	SY	208
0432 6001	RIPRAP (CONC) (4 IN)	CY	4.8
0529 6008	CONC CURB & GUTTER (TY II)	LF	45
0530 6004	DRIVEWAYS (CONC)	SY	241
0531 6001	CONC SIDEWALK (4")	SY	146
0531 6004	CURB RAMPS (TY 1)	EA	2
0531 6010	CURB RAMPS (TY 7)	EA	1
0531 6013	CURB RAMPS (TY 10)	EA	1

P:\Jobs\2020007-Pedestrian\TxDOT_Amp\1110-CA00\VP3-SHEETS\047_AM_US_60_S1240F44.dgn
 5:18:34 PM
 1/27/2022

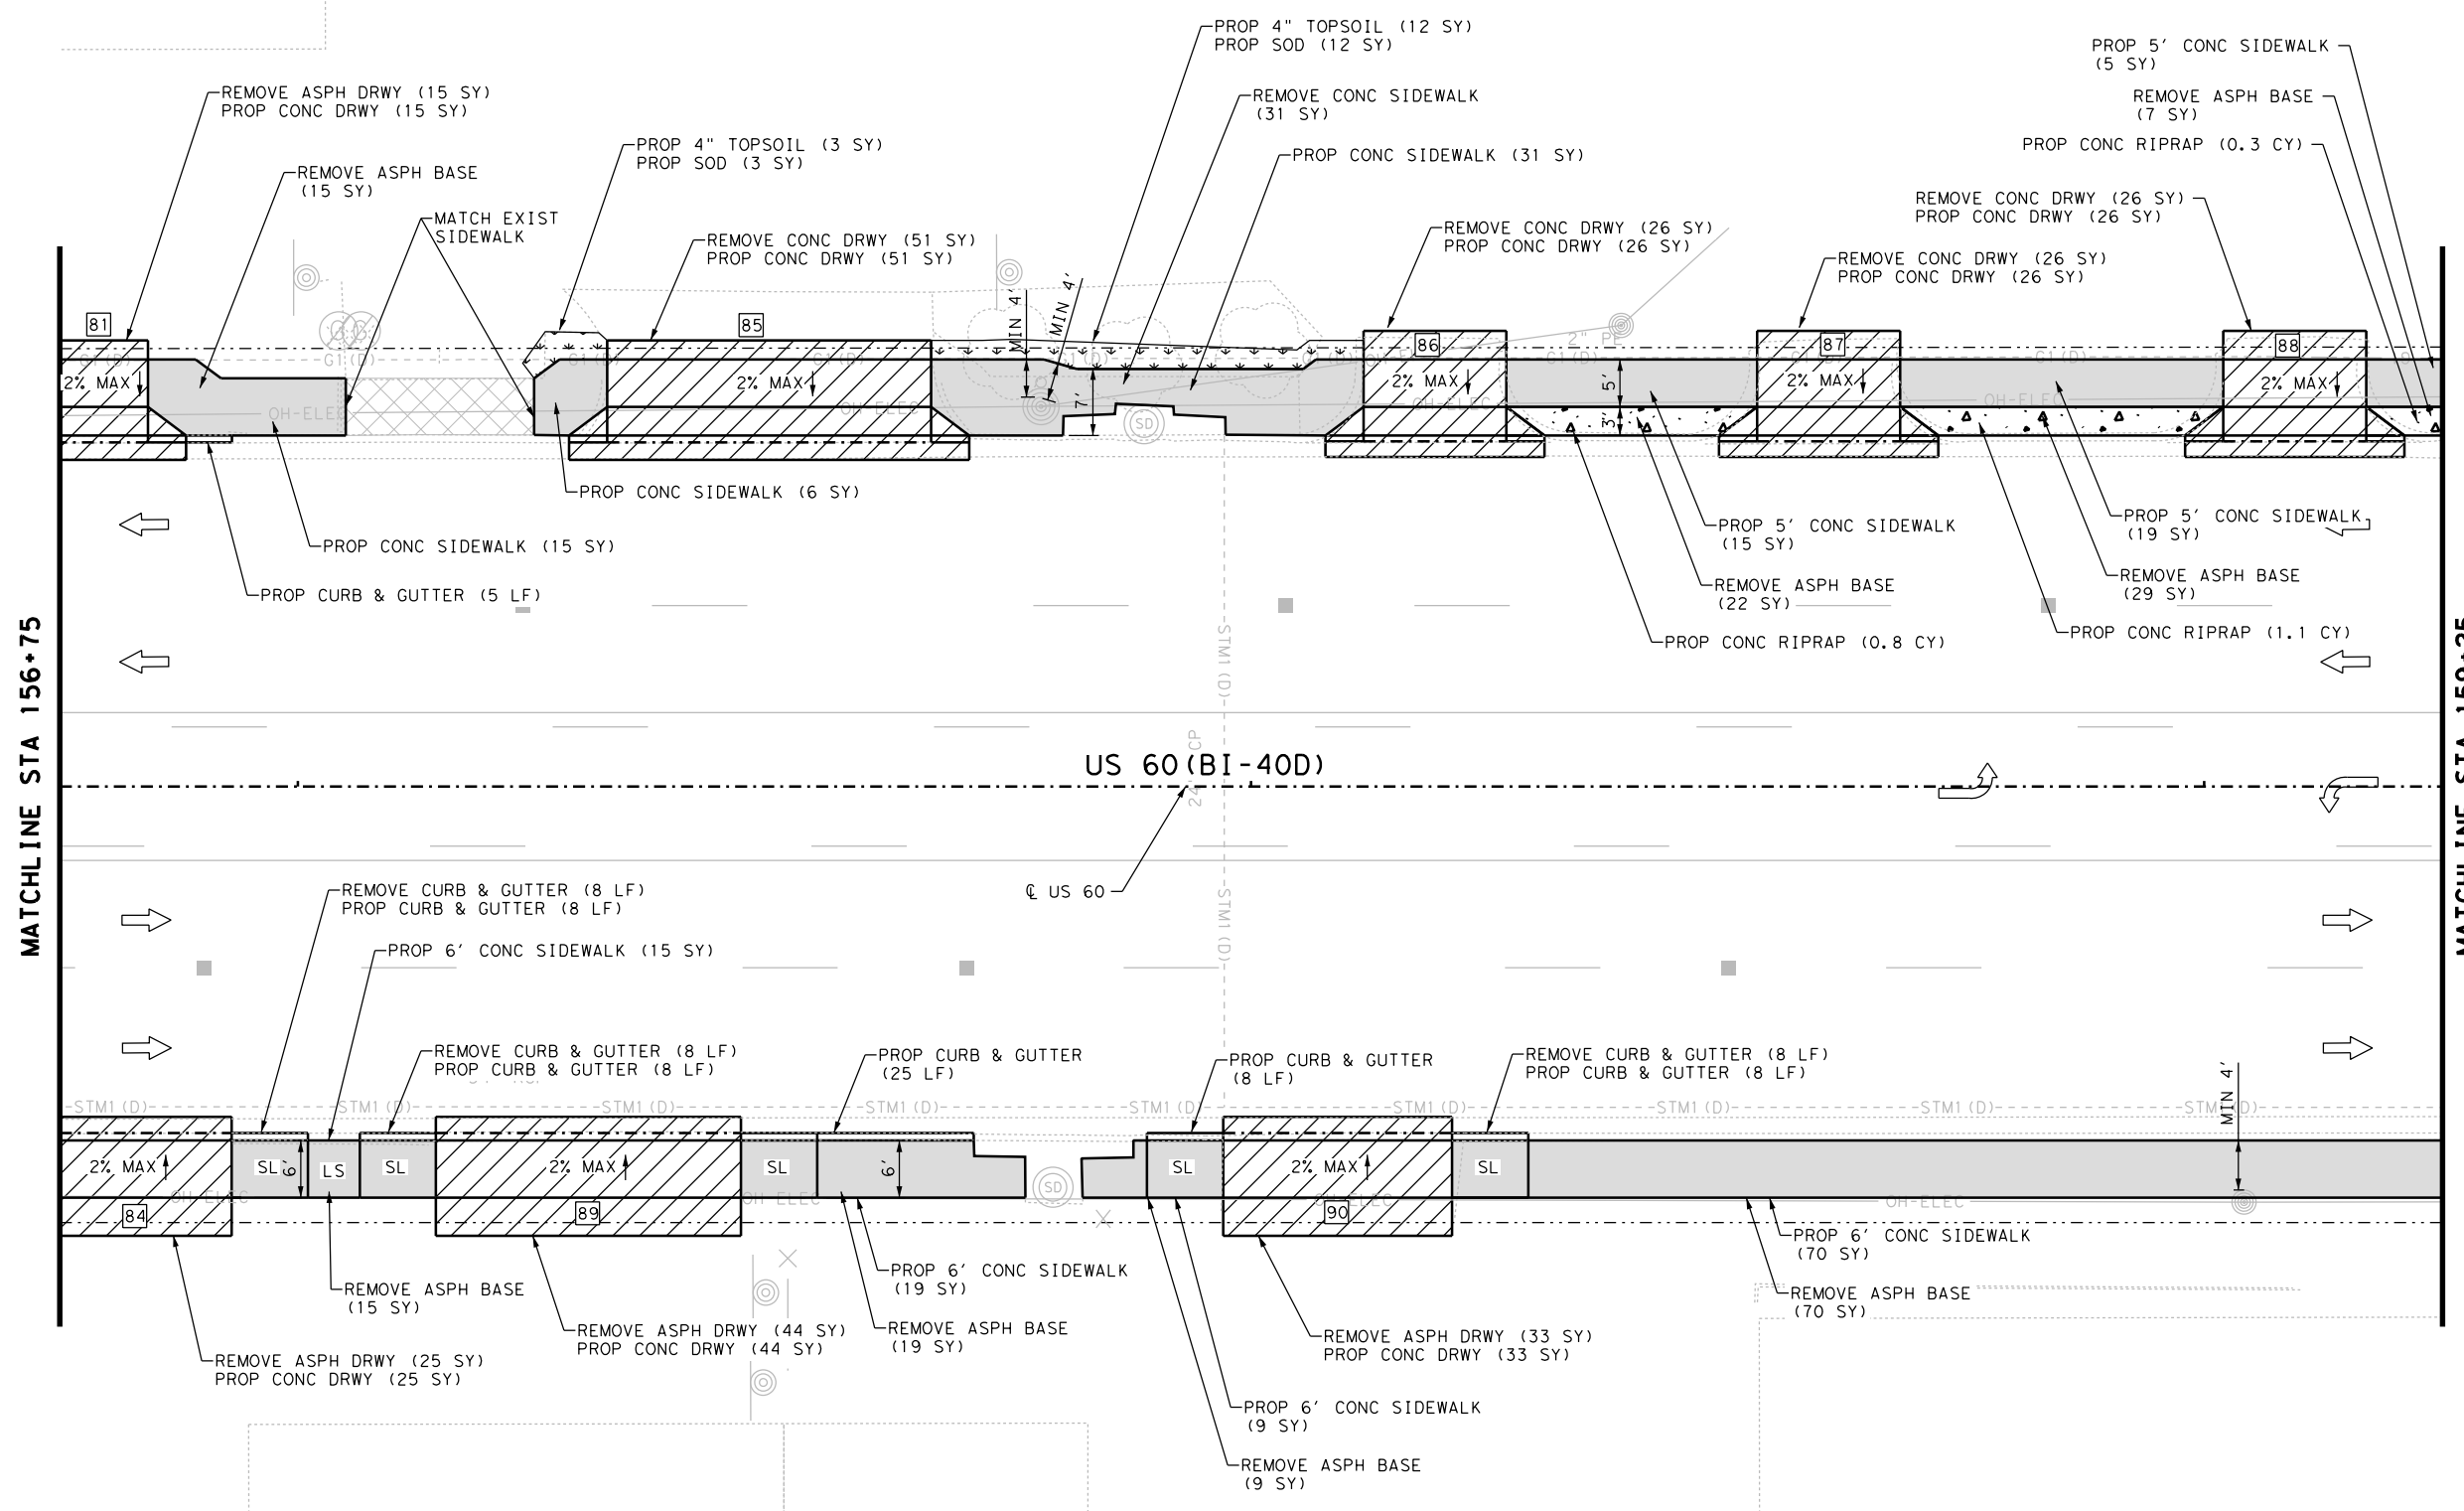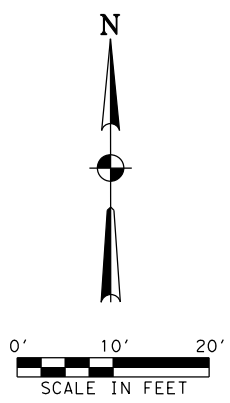

- NOTES:
- * FOR CONTRACTOR INFORMATION ONLY
 - 1. THE EXISTENCE AND LOCATION OF ALL UTILITIES AND DRAINAGE STRUCTURES INDICATED IN THE PLANS ARE TAKEN FROM THE BEST RECORDS AVAILABLE AND ARE NOT GUARANTEED TO BE ACCURATE. CONTRACTOR SHALL COORDINATE WITH ALL UTILITY COMPANIES TO FIELD VERIFY UTILITIES PRIOR TO BEGINNING CONSTRUCTION.

NO.	DATE	REVISION	BY



GLOBAL CIVIL SOLUTIONS, LLC
 11551 FOREST CENTRAL DRIVE
 SUITE 220
 DALLAS, TX 75243
 F-12801



US 60 (BI 40-D)
SIDEWALK PLAN

STA 156+75 TO STA 159+25



SHEET 25 OF 44

DESIGN	FED. RD. DIV. NO.	FEDERAL AID PROJECT NO.	HIGHWAY NO.
MI	6	(SEE TITLE SHEET)	VARIOUS
GRAPHICS	STATE	DISTRICT	COUNTY
PS	TEXAS	AMA	POTTER
CHECK	CONTROL	SECTION	JOB
MF			
CHECK	FS	0904	02 047

ITEM	DESCRIPTION	UNIT	QTY
0104 6015	REMOVING CONC (SIDEWALKS)	SY	31
0104 6017	REMOVING CONC (DRIVEWAYS)	SY	129
0104 6029	REMOVING CONC (CURB OR CURB & GUTTER)	LF	24
0105 6070	REMOVING STAB BASE & ASPH PAV (6" - 8")	SY	303
0160 6003	FURNISHING AND PLACING TOP SOIL (4")	SY	15
0162 6002	BLOCK SODDING	SY	15
0168 6001	VEGETATIVE WATERING	MG	0.6
0432 6001	RIPRAP (CONC) (4 IN)	CY	2.2
0529 6008	CONC CURB & GUTTER (TY II)	LF	62
0530 6004	DRIVEWAYS (CONC)	SY	246
0531 6001	CONC SIDEWALK (4")	SY	204

- LEGEND**
- | | | | | | | | |
|--|----------------------------------|----|--|--|---------------------|--|--------------------------|
| | PROP SODDING | R | RAMP | | POWER POLE | | IRRIGATION CONTROL VALVE |
| | PROP CONC DRWY | L | LANDING PAD | | TRAFFIC SIGNAL POLE | | ELECTRICAL PULL BOX |
| | PROP CONC RIPRAP | F | FLARE | | LIGHT POLE | | DRIVEWAY ID |
| | PROP RETAINING WALL | SL | LONG. SLOPE MAY NOT EXCEED 5% OR ADJACENT ROAD SLOPE | | WATER METER | | PEDESTRIAN SIGNAL |
| | PROP CONC SIDEWALK | T | TRANSITION | | FIRE HYDRANT | | GAS METER |
| | EXISTING SIDEWALK/DRWY TO REMAIN | LS | LEVEL SIDEWALK (2% MAX) | | GUY WIRE | | SPRINKLER HEAD |
| | | | TRAFFIC FLOW | | TREE/SHRUB | | UTILITY MARKER POST |
| | | | EXISTING SIGN | | FENCE | | OVERHEAD ELECTRIC LINE |
| | | | PROPOSED SIGN | | WATER VALVE | | |
| | | | MANHOLE | | TRAFFIC SIGNAL BOX | | |

P:\Jobs\2020007-Pedestr\1110-CA00\VP3-SHEETS\047_AM_US_60_ST250F44.dgn
 5:18:35 PM
 1/27/2022

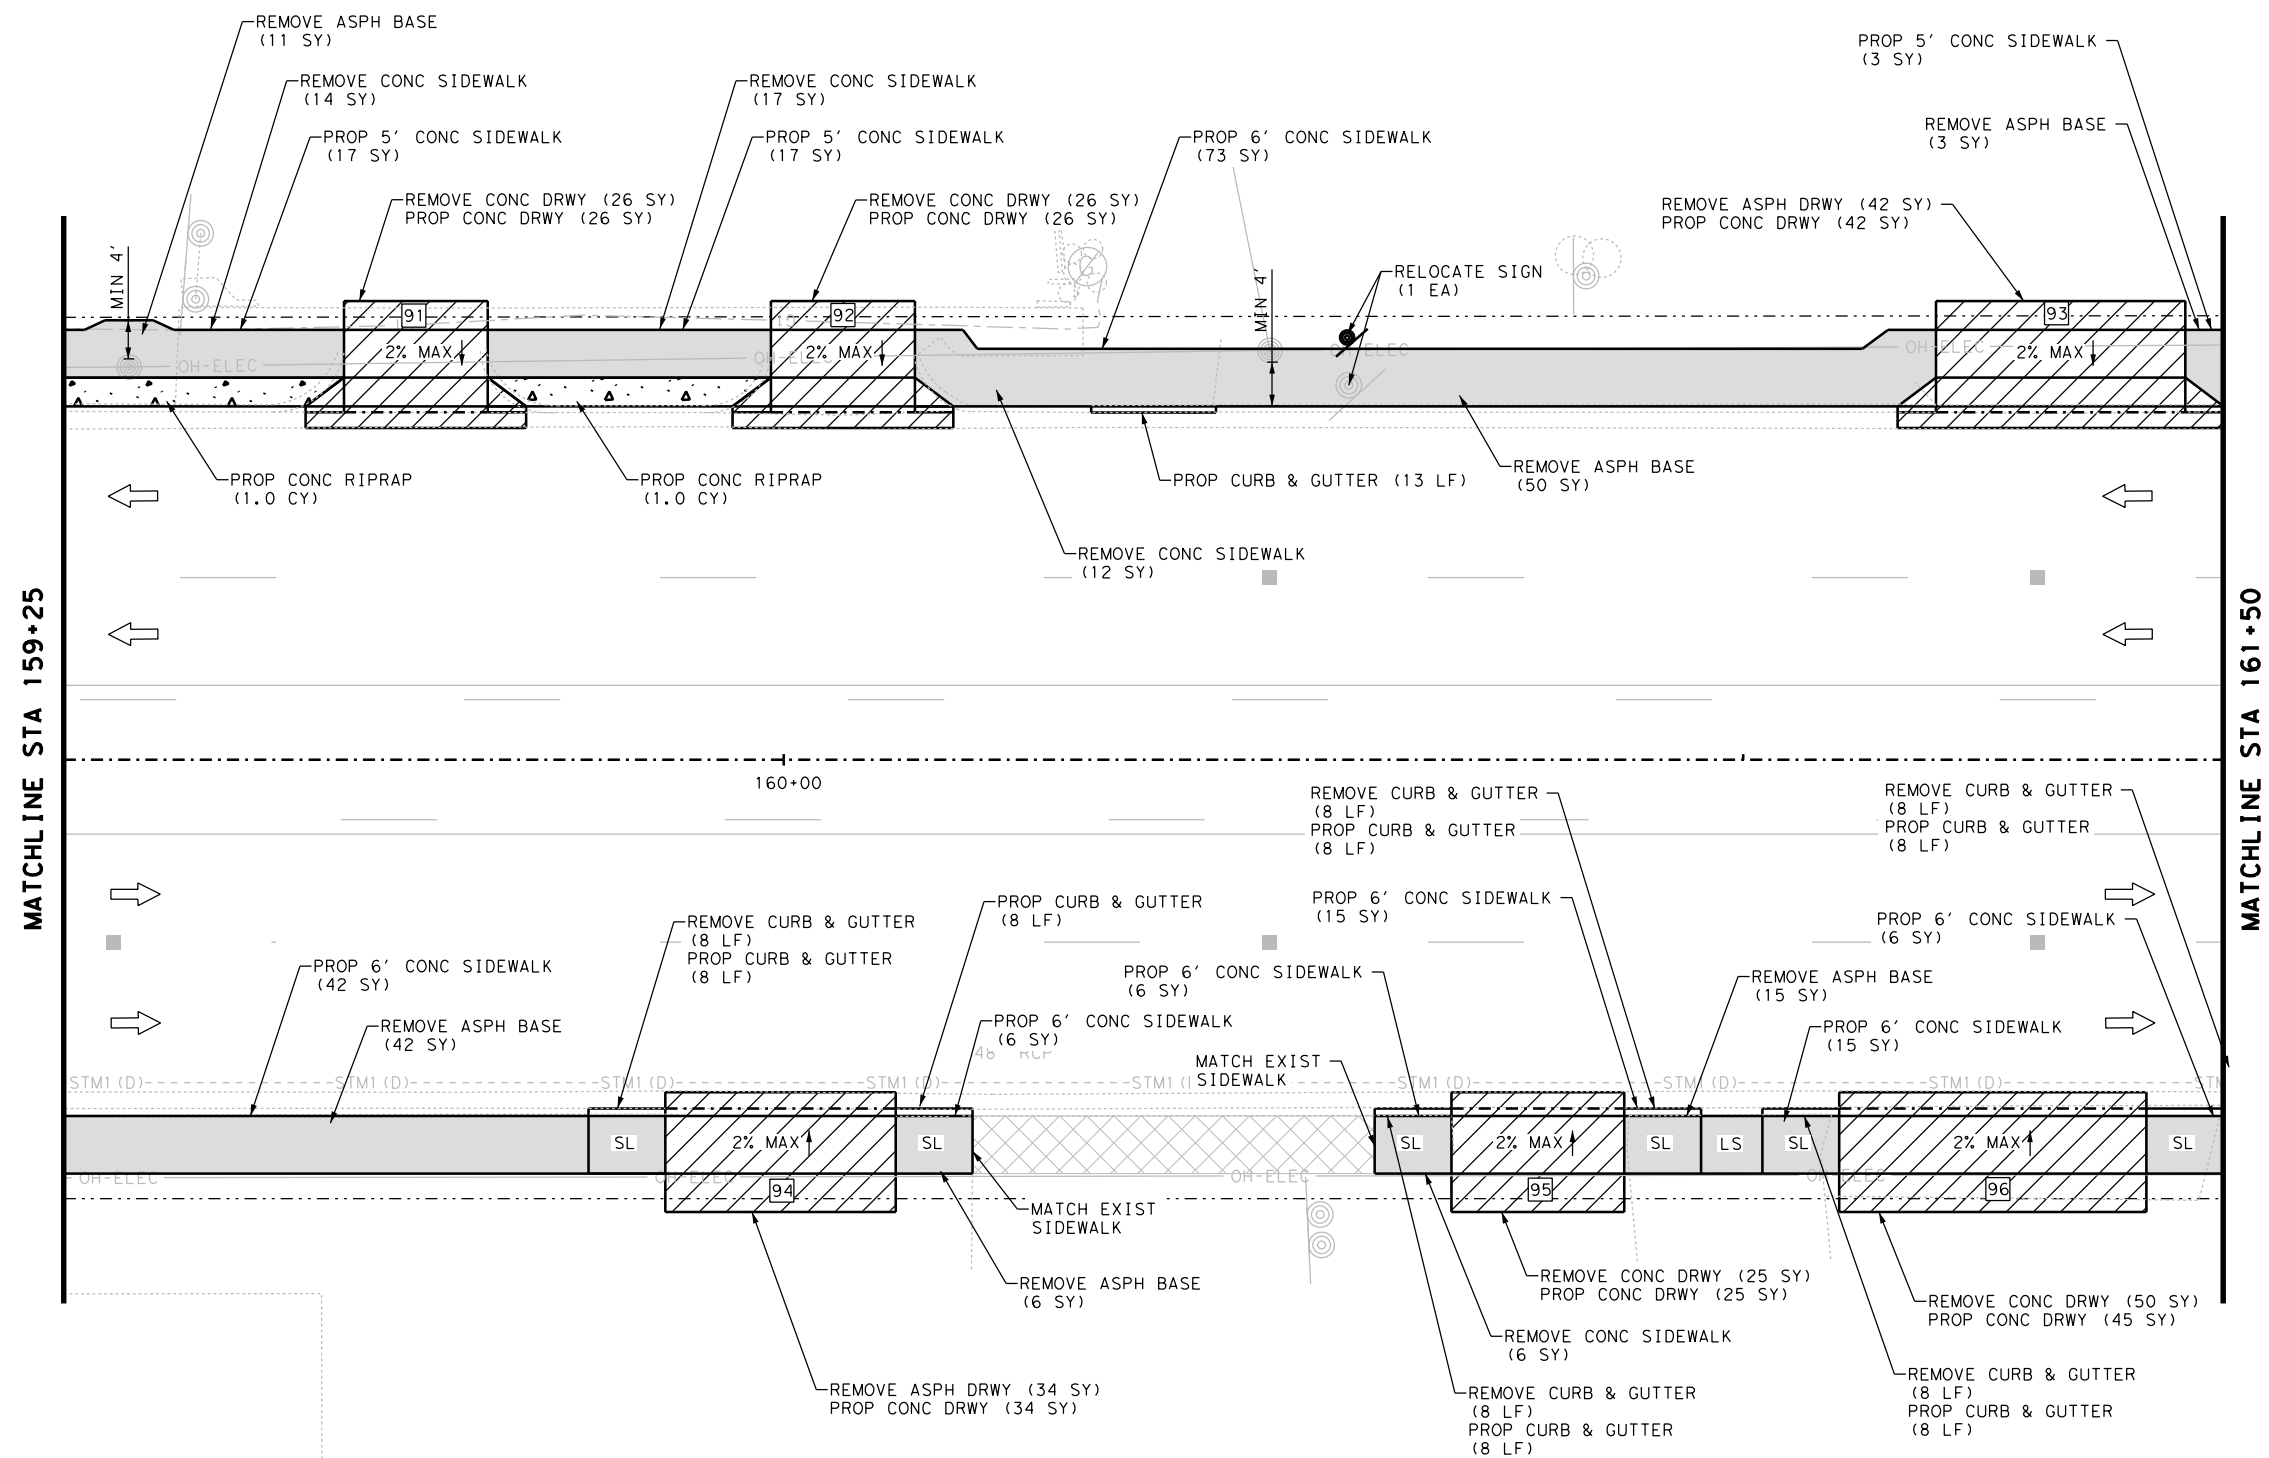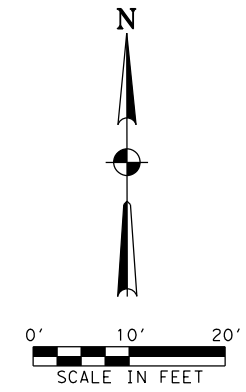

NOTES:
 * FOR CONTRACTOR INFORMATION ONLY
 1. THE EXISTENCE AND LOCATION OF ALL UTILITIES AND DRAINAGE STRUCTURES INDICATED IN THE PLANS ARE TAKEN FROM THE BEST RECORDS AVAILABLE AND ARE NOT GUARANTEED TO BE ACCURATE. CONTRACTOR SHALL COORDINATE WITH ALL UTILITY COMPANIES TO FIELD VERIFY UTILITIES PRIOR TO BEGINNING CONSTRUCTION.

NO.	DATE	REVISION	BY



GLOBAL CIVIL SOLUTIONS, LLC
 11551 FOREST CENTRAL DRIVE
 SUITE 220
 DALLAS, TX 75243
 F-12801



**US 60 (BI 40-D)
 SIDEWALK PLAN**

STA 159+25 TO STA 161+50

SHEET 26 OF 44



DESIGN	FED. RD. DIV. NO.	FEDERAL AID PROJECT NO.	HIGHWAY NO.
MI	6	(SEE TITLE SHEET)	VARIOUS
GRAPHICS	STATE	DISTRICT	COUNTY
PS	TEXAS	AMA	POTTER
CHECK	CONTROL	SECTION	JOB
MF			
CHECK	FS	0904	02 047

054

P:\Jobs\202007-Pedestrian\TXDOT_Am0r1110\CA00\VP3-SHEETS\047_AM_US_60_ST260F44.dgn
 5:18:37 PM
 1/27/2022

LEGEND			
	PROP SODDING	R	RAMP
	PROP CONC DRWY	L	LANDING PAD
	PROP CONC RIPRAP	F	FLARE
	PROP RETAINING WALL	SL	LONG. SLOPE MAY NOT EXCEED 5% OR ADJACENT ROAD SLOPE
	PROP CONC SIDEWALK	T	TRANSITION
	EXISTING SIDEWALK/DRWY TO REMAIN	LS	LEVEL SIDEWALK (2% MAX)
	PROP SODDING	←	TRAFFIC FLOW
	PROP CONC DRWY	⊙	EXISTING SIGN
	PROP CONC RIPRAP	⊙	PROPOSED SIGN
	PROP RETAINING WALL	⊙	MANHOLE
	PROP CONC SIDEWALK	⊙	
	EXISTING SIDEWALK/DRWY TO REMAIN	⊙	
	POWER POLE	⊙	TRAFFIC SIGNAL POLE
	TRAFFIC SIGNAL POLE	⊙	LIGHT POLE
	LIGHT POLE	⊙	WATER METER
	WATER METER	⊙	FIRE HYDRANT
	FIRE HYDRANT	⊙	GUY WIRE
	GUY WIRE	⊙	TREE/SHRUB
	TREE/SHRUB	⊙	FENCE
	FENCE	⊙	WATER VALVE
	WATER VALVE	⊙	TRAFFIC SIGNAL BOX
	TRAFFIC SIGNAL BOX	⊙	
	IRRIGATION CONTROL VALVE	⊙	
	ELECTRICAL PULL BOX	⊙	
	DRIVEWAY ID	⊙	
	PEDESTRIAN SIGNAL	⊙	
	GAS METER	⊙	
	SPRINKLER HEAD	⊙	
	UTILITY MARKER POST	⊙	
	OVERHEAD ELECTRIC LINE	⊙	

ITEM	DESCRIPTION	UNIT	QTY
0104 6015	REMOVING CONC (SIDEWALKS)	SY	49
0104 6017	REMOVING CONC (DRIVEWAYS)	SY	127
0104 6029	REMOVING CONC (CURB OR CURB & GUTTER)	LF	40
0105 6070	REMOVING STAB BASE & ASPH PAV (6" - 8")	SY	203
0432 6001	RIPRAP (CONC) (4 IN)	CY	2.0
0529 6008	CONC CURB & GUTTER (TY II)	LF	67
0530 6004	DRIVEWAYS (CONC)	SY	198
0531 6001	CONC SIDEWALK (4")	SY	185
0644 6068	RELOCATE SM RD SN SUP&AM TY 10BWG	EA	1

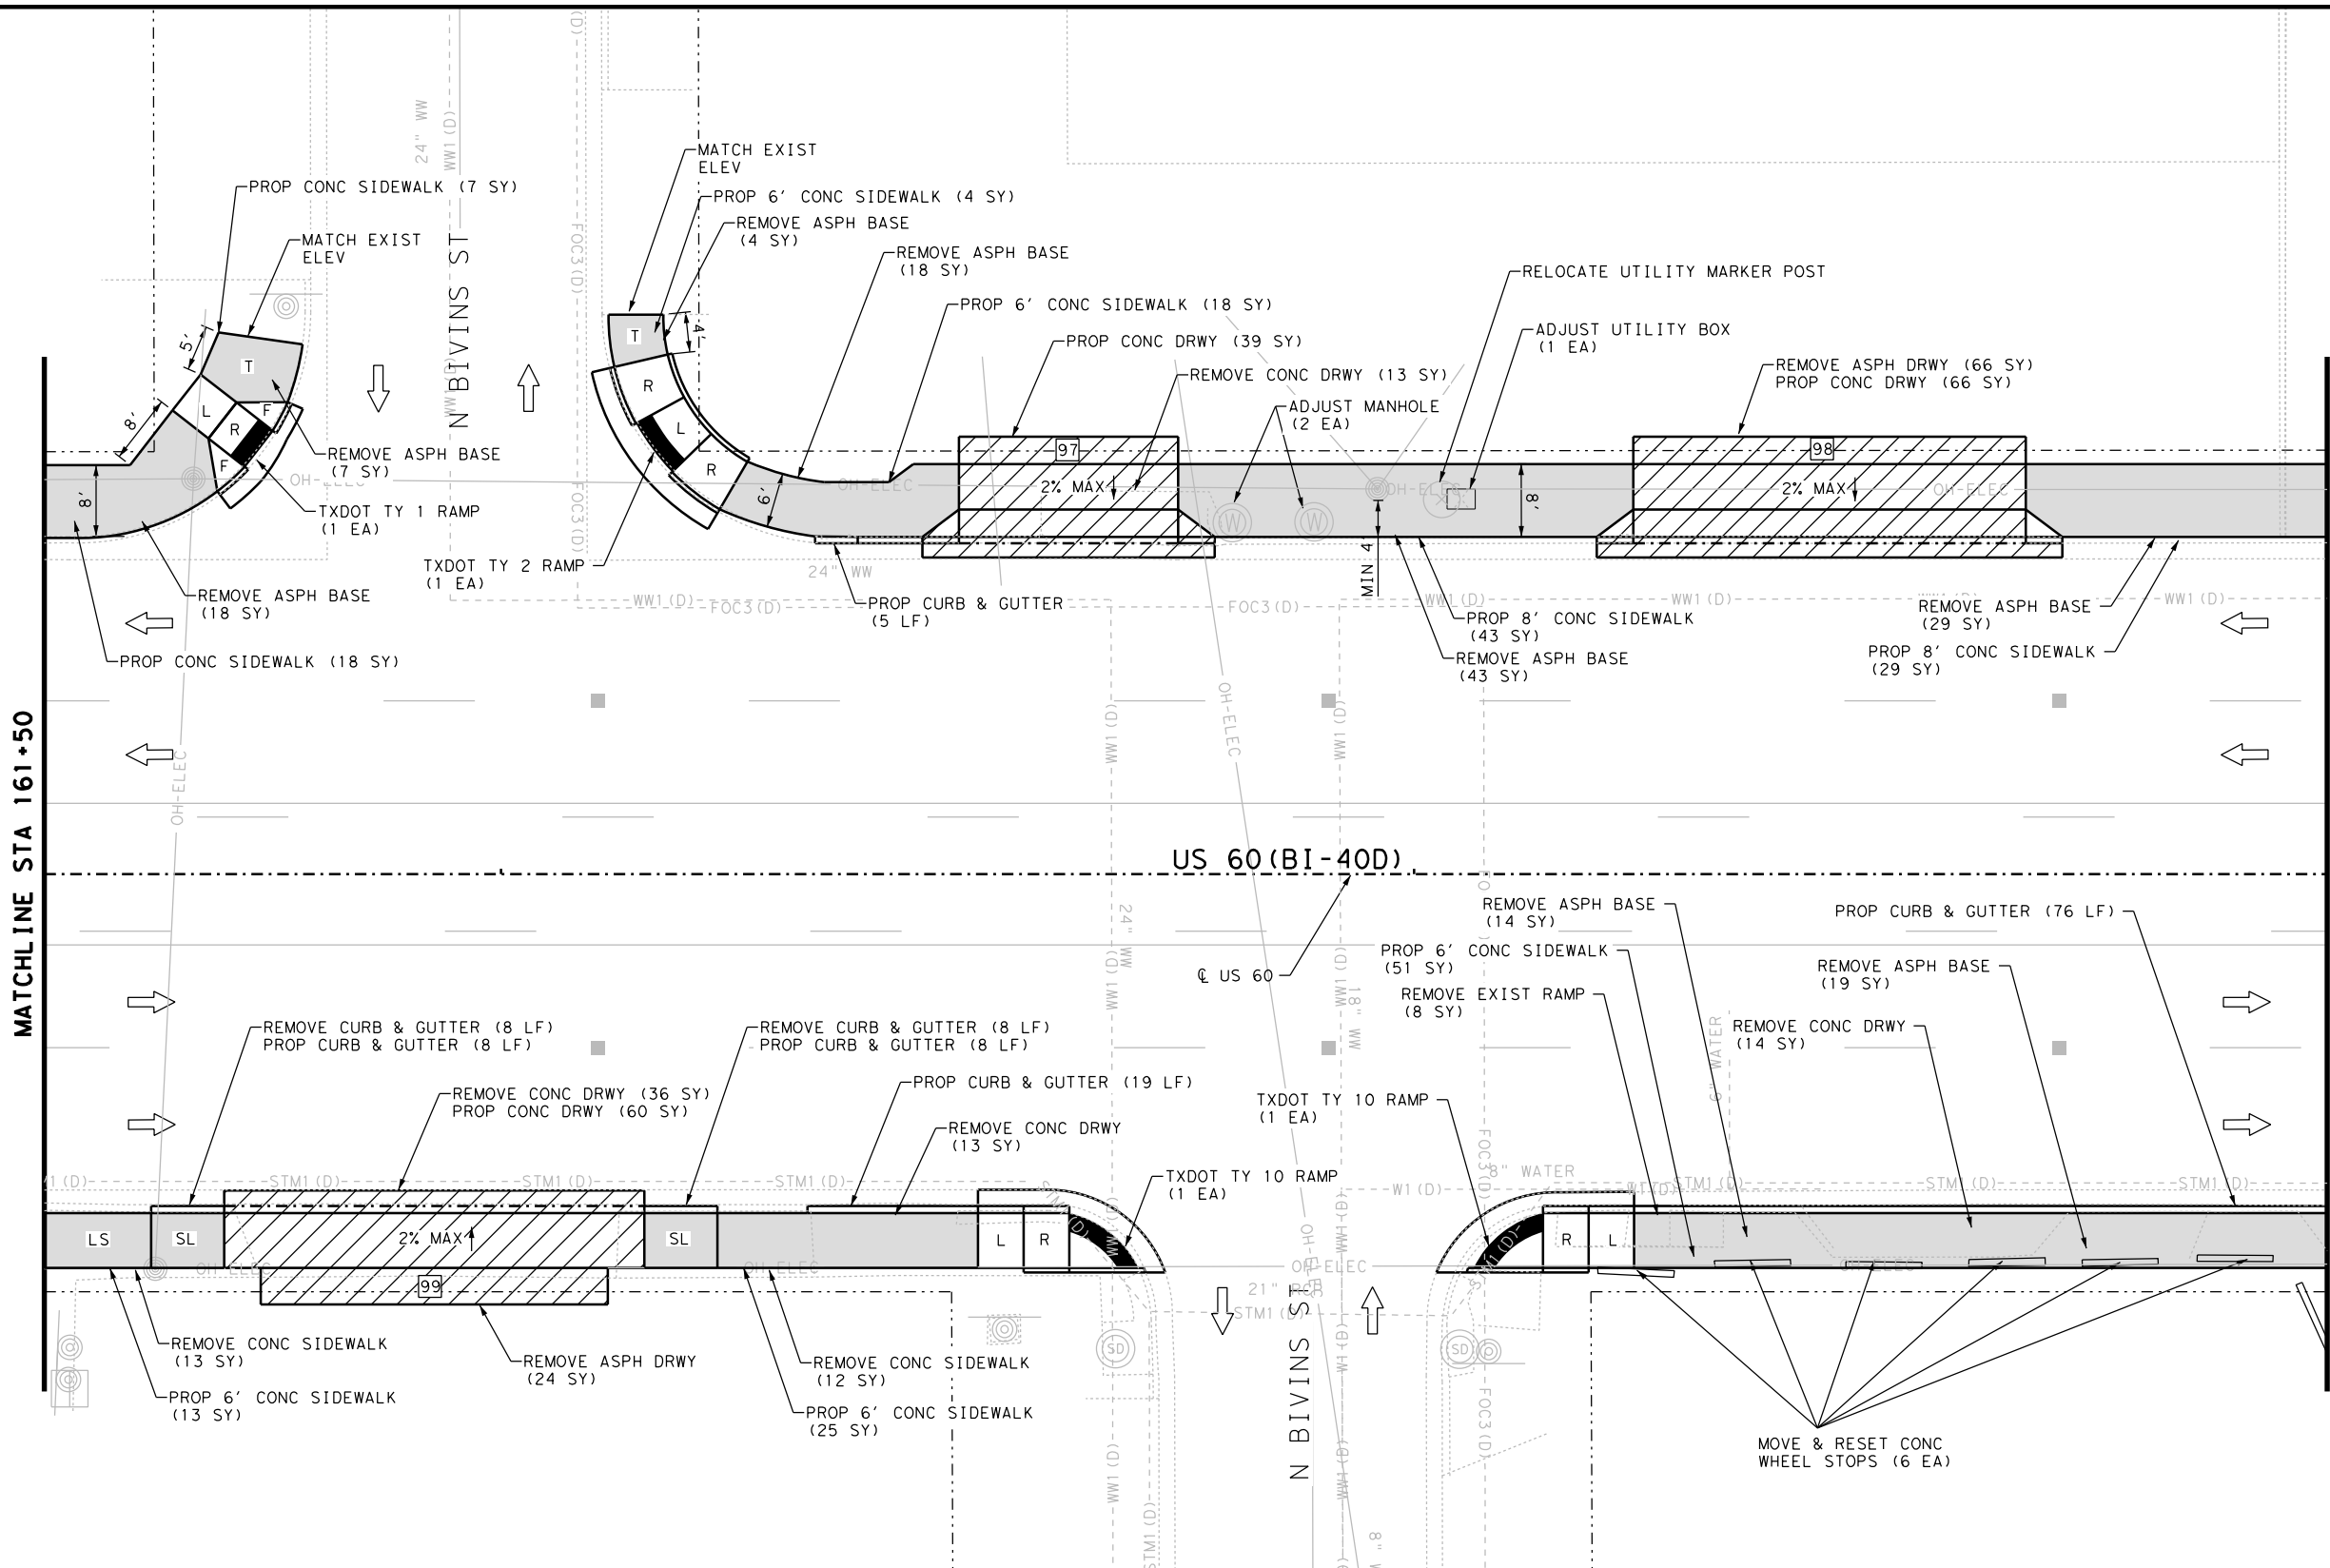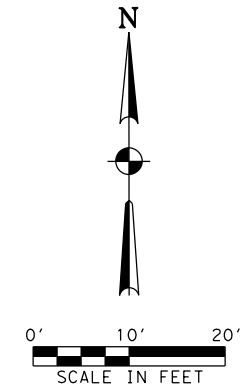

NO.	DATE	REVISION	BY



GLOBAL CIVIL SOLUTIONS, LLC
 11551 FOREST CENTRAL DRIVE
 SUITE 220
 DALLAS, TX 75243
 F-12801



US 60 (BI 40-D)
SIDEWALK PLAN

STA 161+50 TO STA 164+00

SHEET 27 OF 44



LEGEND	
	PROP SODDING
	PROP CONC DRWY
	PROP CONC RIPRAP
	PROP RETAINING WALL
	PROP CONC SIDEWALK
	EXISTING SIDEWALK/DRWY TO REMAIN
R	RAMP
L	LANDING PAD
F	FLARE
SL	LONG. SLOPE MAY NOT EXCEED 5% OR ADJACENT ROAD SLOPE
T	TRANSITION
LS	LEVEL SIDEWALK (2% MAX)
	TRAFFIC FLOW
	EXISTING SIGN
	PROPOSED SIGN
	MANHOLE
	POWER POLE
	TRAFFIC SIGNAL POLE
	LIGHT POLE
	WATER METER
	FIRE HYDRANT
	GUY WIRE
	TREE/SHRUB
	FENCE
	WATER VALVE
	TRAFFIC SIGNAL BOX
	IRRIGATION CONTROL VALVE
	ELECTRICAL PULL BOX
	DRIVEWAY ID
	PEDESTRIAN SIGNAL
	GAS METER
	SPRINKLER HEAD
	UTILITY MARKER POST
	OVERHEAD ELECTRIC LINE

ITEM	DESCRIPTION	UNIT	QTY
0104 6015	REMOVING CONC (SIDEWALKS)	SY	33
0104 6017	REMOVING CONC (DRIVEWAYS)	SY	76
0104 6029	REMOVING CONC (CURB OR CURB & GUTTER)	LF	16
0105 6070	REMOVING STAB BASE & ASPH PAV (6" - 8")	SY	242
0479 6001	ADJUSTING MANHOLES	EA	2
0529 6008	CONC CURB & GUTTER (TY II)	LF	116
0530 6004	DRIVEWAYS (CONC)	SY	165
0531 6001	CONC SIDEWALK (4")	SY	208
0531 6004	CURB RAMPS (TY 1)	EA	1
0531 6005	CURB RAMPS (TY 2)	EA	1
0531 6013	CURB RAMPS (TY 10)	EA	2
5057 6002	MOVE AND RESET PRECAST CONC WHEEL STOPS	EA	6
6027 6009	GROUND BOX (ADJUST)	EA	1

DESIGN	FED. RD. DIV. NO.	FEDERAL AID PROJECT NO.	HIGHWAY NO.
MI	6	(SEE TITLE SHEET)	VARIOUS
GRAPHICS	STATE	DISTRICT	COUNTY
PS	TEXAS	AMA	POTTER
CHECK	CONTROL	SECTION	JOB
MFM			
CHECK			
FS	0904	02	047

055

P:\Jobs\202007-Pedestrian-TxDOT_Amor\1110-CA00-V3-SHEETS\047_AM_US_60_S1270F44.dgn
 5:18:38 PM
 1/27/2022

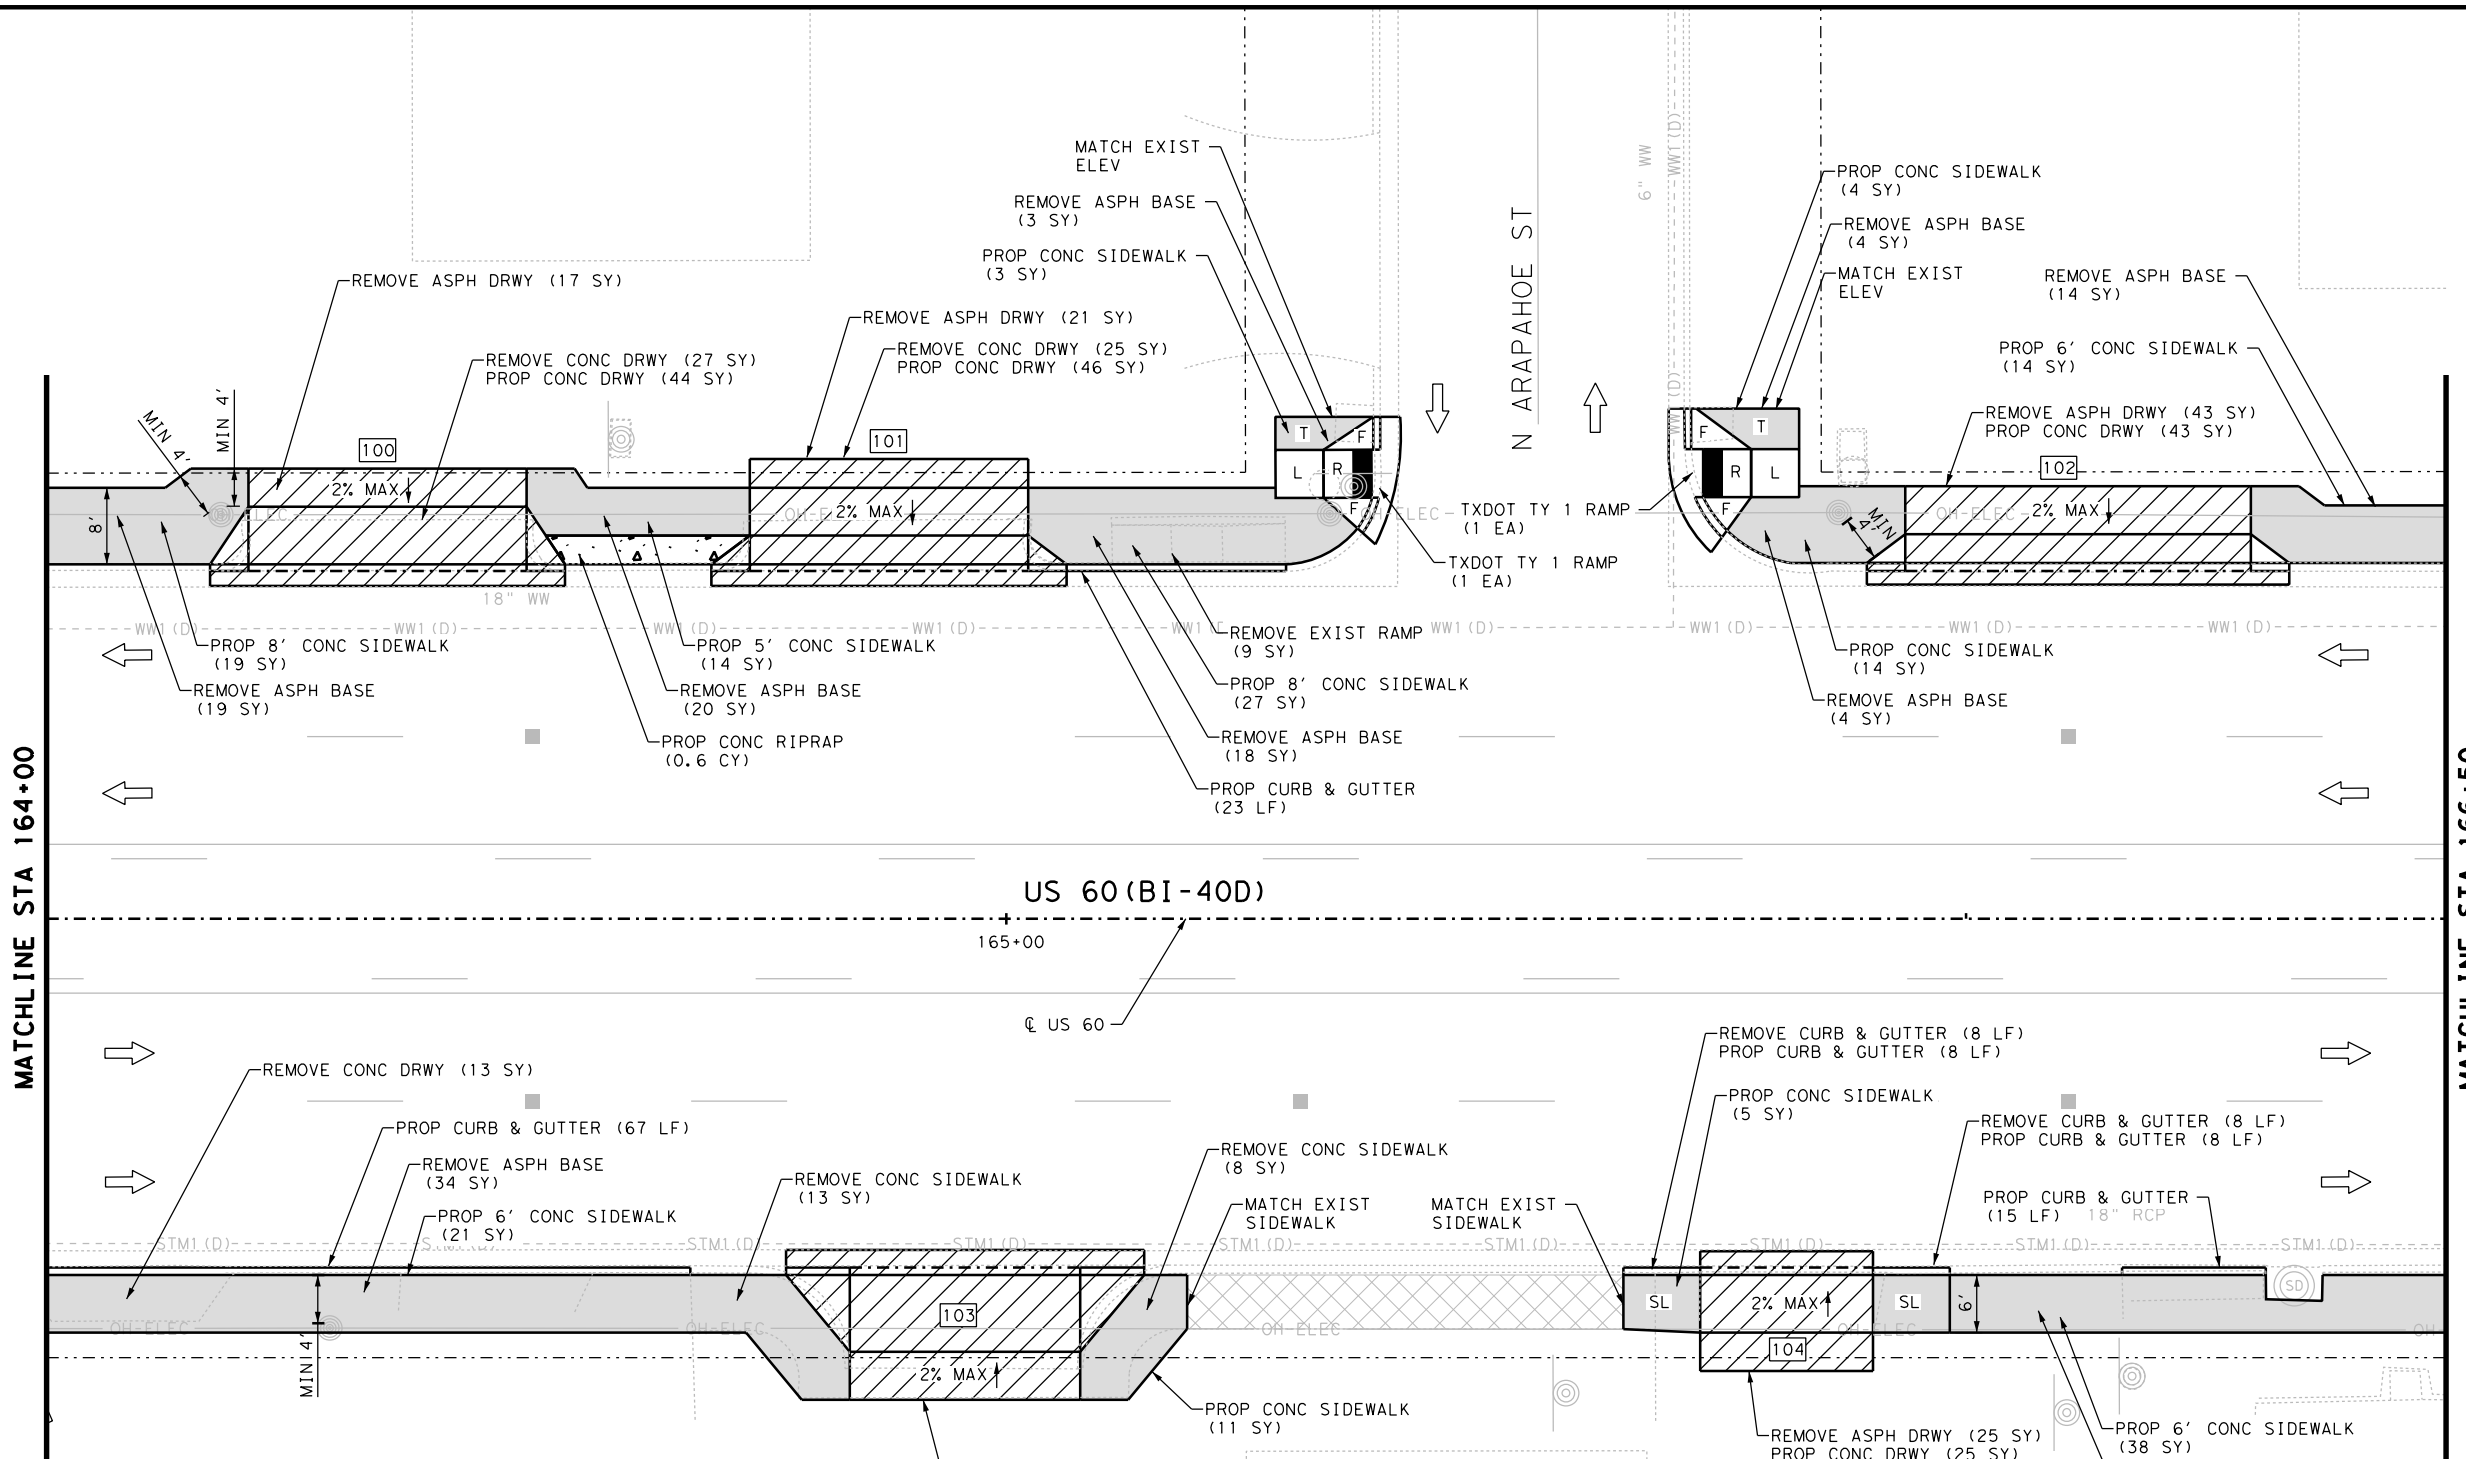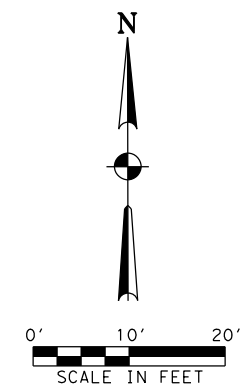

NO.	DATE	REVISION	BY



GLOBAL CIVIL SOLUTIONS, LLC
 11551 FOREST CENTRAL DRIVE
 SUITE 220
 DALLAS, TX 75243
 F-12801



**US 60 (BI 40-D)
 SIDEWALK PLAN**

STA 164+00 TO STA 166+50



SHEET 28 OF 44

DESIGN	FED. RD. DIV. NO.	FEDERAL AID PROJECT NO.	HIGHWAY NO.
MI	6	(SEE TITLE SHEET)	VARIOUS
GRAPHICS	STATE	DISTRICT	COUNTY
PS	TEXAS	AMA	POTTER
CHECK	CONTROL	SECTION	JOB
MF			
CHECK	NO.	SHEET NO.	
FS	0904	02	047

ITEM	DESCRIPTION	UNIT	QTY
0104 6015	REMOVING CONC (SIDEWALKS)	SY	30
0104 6017	REMOVING CONC (DRIVEWAYS)	SY	117
0104 6029	REMOVING CONC (CURB OR CURB & GUTTER)	LF	16
0105 6070	REMOVING STAB BASE & ASPH PAV (6" - 8")	SY	260
0432 6001	RIPRAP (CONC) (4 IN)	CY	0.6
0529 6008	CONC CURB & GUTTER (TY II)	LF	121
0530 6004	DRIVEWAYS (CONC)	SY	210
0531 6001	CONC SIDEWALK (4")	SY	170
0531 6004	CURB RAMPS (TY 1)	EA	2

- LEGEND**
- | | | | | | | | |
|--|----------------------------------|----|--|--|---------------------|--|--------------------------|
| | PROP SODDING | R | RAMP | | POWER POLE | | IRRIGATION CONTROL VALVE |
| | PROP CONC DRWY | L | LANDING PAD | | TRAFFIC SIGNAL POLE | | ELECTRICAL PULL BOX |
| | PROP CONC RIPRAP | F | FLARE | | LIGHT POLE | | DRIVEWAY ID |
| | PROP RETAINING WALL | SL | LONG. SLOPE MAY NOT EXCEED 5% OR ADJACENT ROAD SLOPE | | WATER METER | | PEDESTRIAN SIGNAL |
| | PROP CONC SIDEWALK | T | TRANSITION | | FIRE HYDRANT | | GAS METER |
| | EXISTING SIDEWALK/DRWY TO REMAIN | LS | LEVEL SIDEWALK (2% MAX) | | GUY WIRE | | SPRINKLER HEAD |
| | | | TRAFFIC FLOW | | TREE/SHRUB | | UTILITY MARKER POST |
| | | | EXISTING SIGN | | FENCE | | OVERHEAD ELECTRIC LINE |
| | | | PROPOSED SIGN | | WATER VALVE | | |
| | | | MANHOLE | | TRAFFIC SIGNAL BOX | | |

P:\Jobs\2020007-Pedestrian-TxDOT_Amp\1110-CA00-V3-SHEETS\047_AM_US_60_ST280F44.dgn
 5:18:40 PM
 1/27/2022

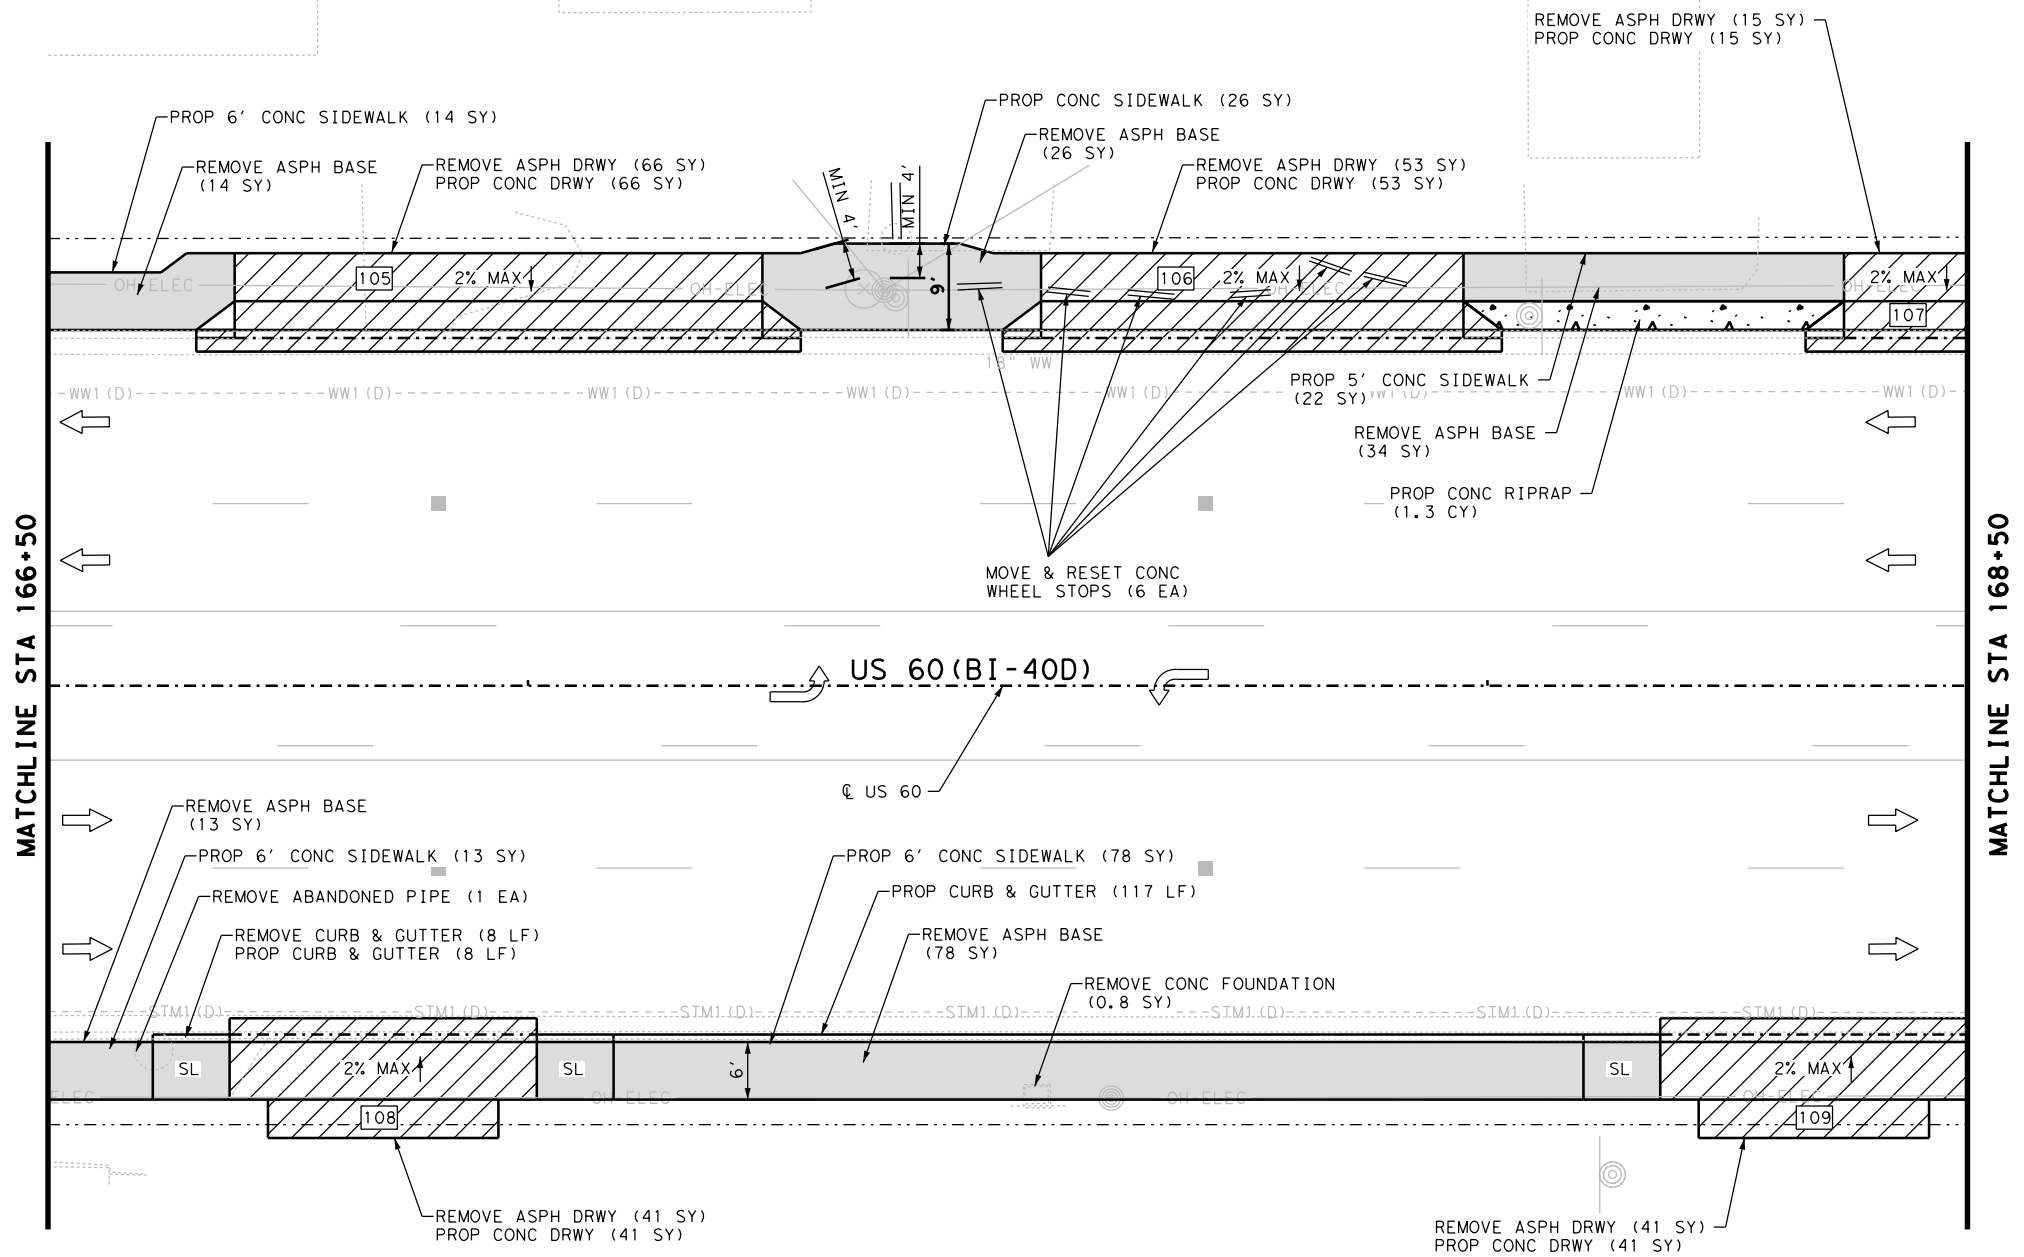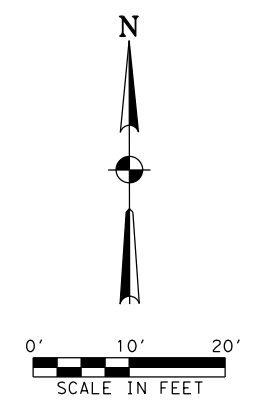

NOTES:
 * FOR CONTRACTOR INFORMATION ONLY
 1. THE EXISTENCE AND LOCATION OF ALL UTILITIES AND DRAINAGE STRUCTURES INDICATED IN THE PLANS ARE TAKEN FROM THE BEST RECORDS AVAILABLE AND ARE NOT GUARANTEED TO BE ACCURATE. CONTRACTOR SHALL COORDINATE WITH ALL UTILITY COMPANIES TO FIELD VERIFY UTILITIES PRIOR TO BEGINNING CONSTRUCTION.

NO.	DATE	REVISION	BY



GLOBAL CIVIL SOLUTIONS, LLC
 11551 FOREST CENTRAL DRIVE
 SUITE 220
 DALLAS, TX 75243
 F-12801



**US 60 (BI 40-D)
 SIDEWALK PLAN**

STA 166+50 TO STA 168+50



SHEET 29 OF 44

DESIGN	FED. RD. DIV. NO.	FEDERAL AID PROJECT NO.	HIGHWAY NO.
MI	6	(SEE TITLE SHEET)	VARIOUS
GRAPHICS	STATE	DISTRICT	COUNTY
PS	TEXAS	AMA	POTTER
CHECK	CONTROL	SECTION	JOB
MF			
CHECK	FS	0904	02 047

ITEM	DESCRIPTION	UNIT	QTY
0104 6013	REMOVING CONC (FOUNDATIONS)	SY	0.8
0104 6029	REMOVING CONC (CURB OR CURB & GUTTER)	LF	8
0105 6070	REMOVING STAB BASE & ASPH PAV (6" - 8")	SY	381
0432 6001	RIPRAP (CONC) (4 IN)	CY	1.3
0496 6030	REMOVE STR (BOLLARD)	EA	1
0529 6008	CONC CURB & GUTTER (TY II)	LF	125
0530 6004	DRIVEWAYS (CONC)	SY	216
0531 6001	CONC SIDEWALK (4")	SY	153
5057 6002	MOVE AND RESET PRECAST CONC WHEEL STOPS	EA	6

LEGEND			
	PROP SODDING	R	RAMP
	PROP CONC DRWY	L	LANDING PAD
	PROP CONC RIPRAP	F	FLARE
	PROP RETAINING WALL	SL	LONG. SLOPE MAY NOT EXCEED 5% OR ADJACENT ROAD SLOPE
	PROP CONC SIDEWALK	T	TRANSITION
	EXISTING SIDEWALK/DRWY TO REMAIN	LS	LEVEL SIDEWALK (2% MAX)
	POWER POLE	←	TRAFFIC FLOW
	TRAFFIC SIGNAL POLE	⊙	EXISTING SIGN
	LIGHT POLE	⊙	PROPOSED SIGN
	WATER METER	⊙	MANHOLE
	FIRE HYDRANT	⊙	
	GUY WIRE	⊙	
	TREE/SHRUB	⊙	
	FENCE	⊙	
	WATER VALVE	⊙	
	TRAFFIC SIGNAL BOX	⊙	
	IRRIGATION CONTROL VALVE	⊙	
	ELECTRICAL PULL BOX	⊙	
	DRIVEWAY ID	⊙	
	PEDESTRIAN SIGNAL	⊙	
	GAS METER	⊙	
	SPRINKLER HEAD	⊙	
	UTILITY MARKER POST	⊙	
	OVERHEAD ELECTRIC LINE	⊙	

P:\Jobs\202007-Pedestr\1110-CA00\VP3-SHEETS\047_AM_US_60_ST290F44.dgn
 5:18:41 PM
 1/27/2022

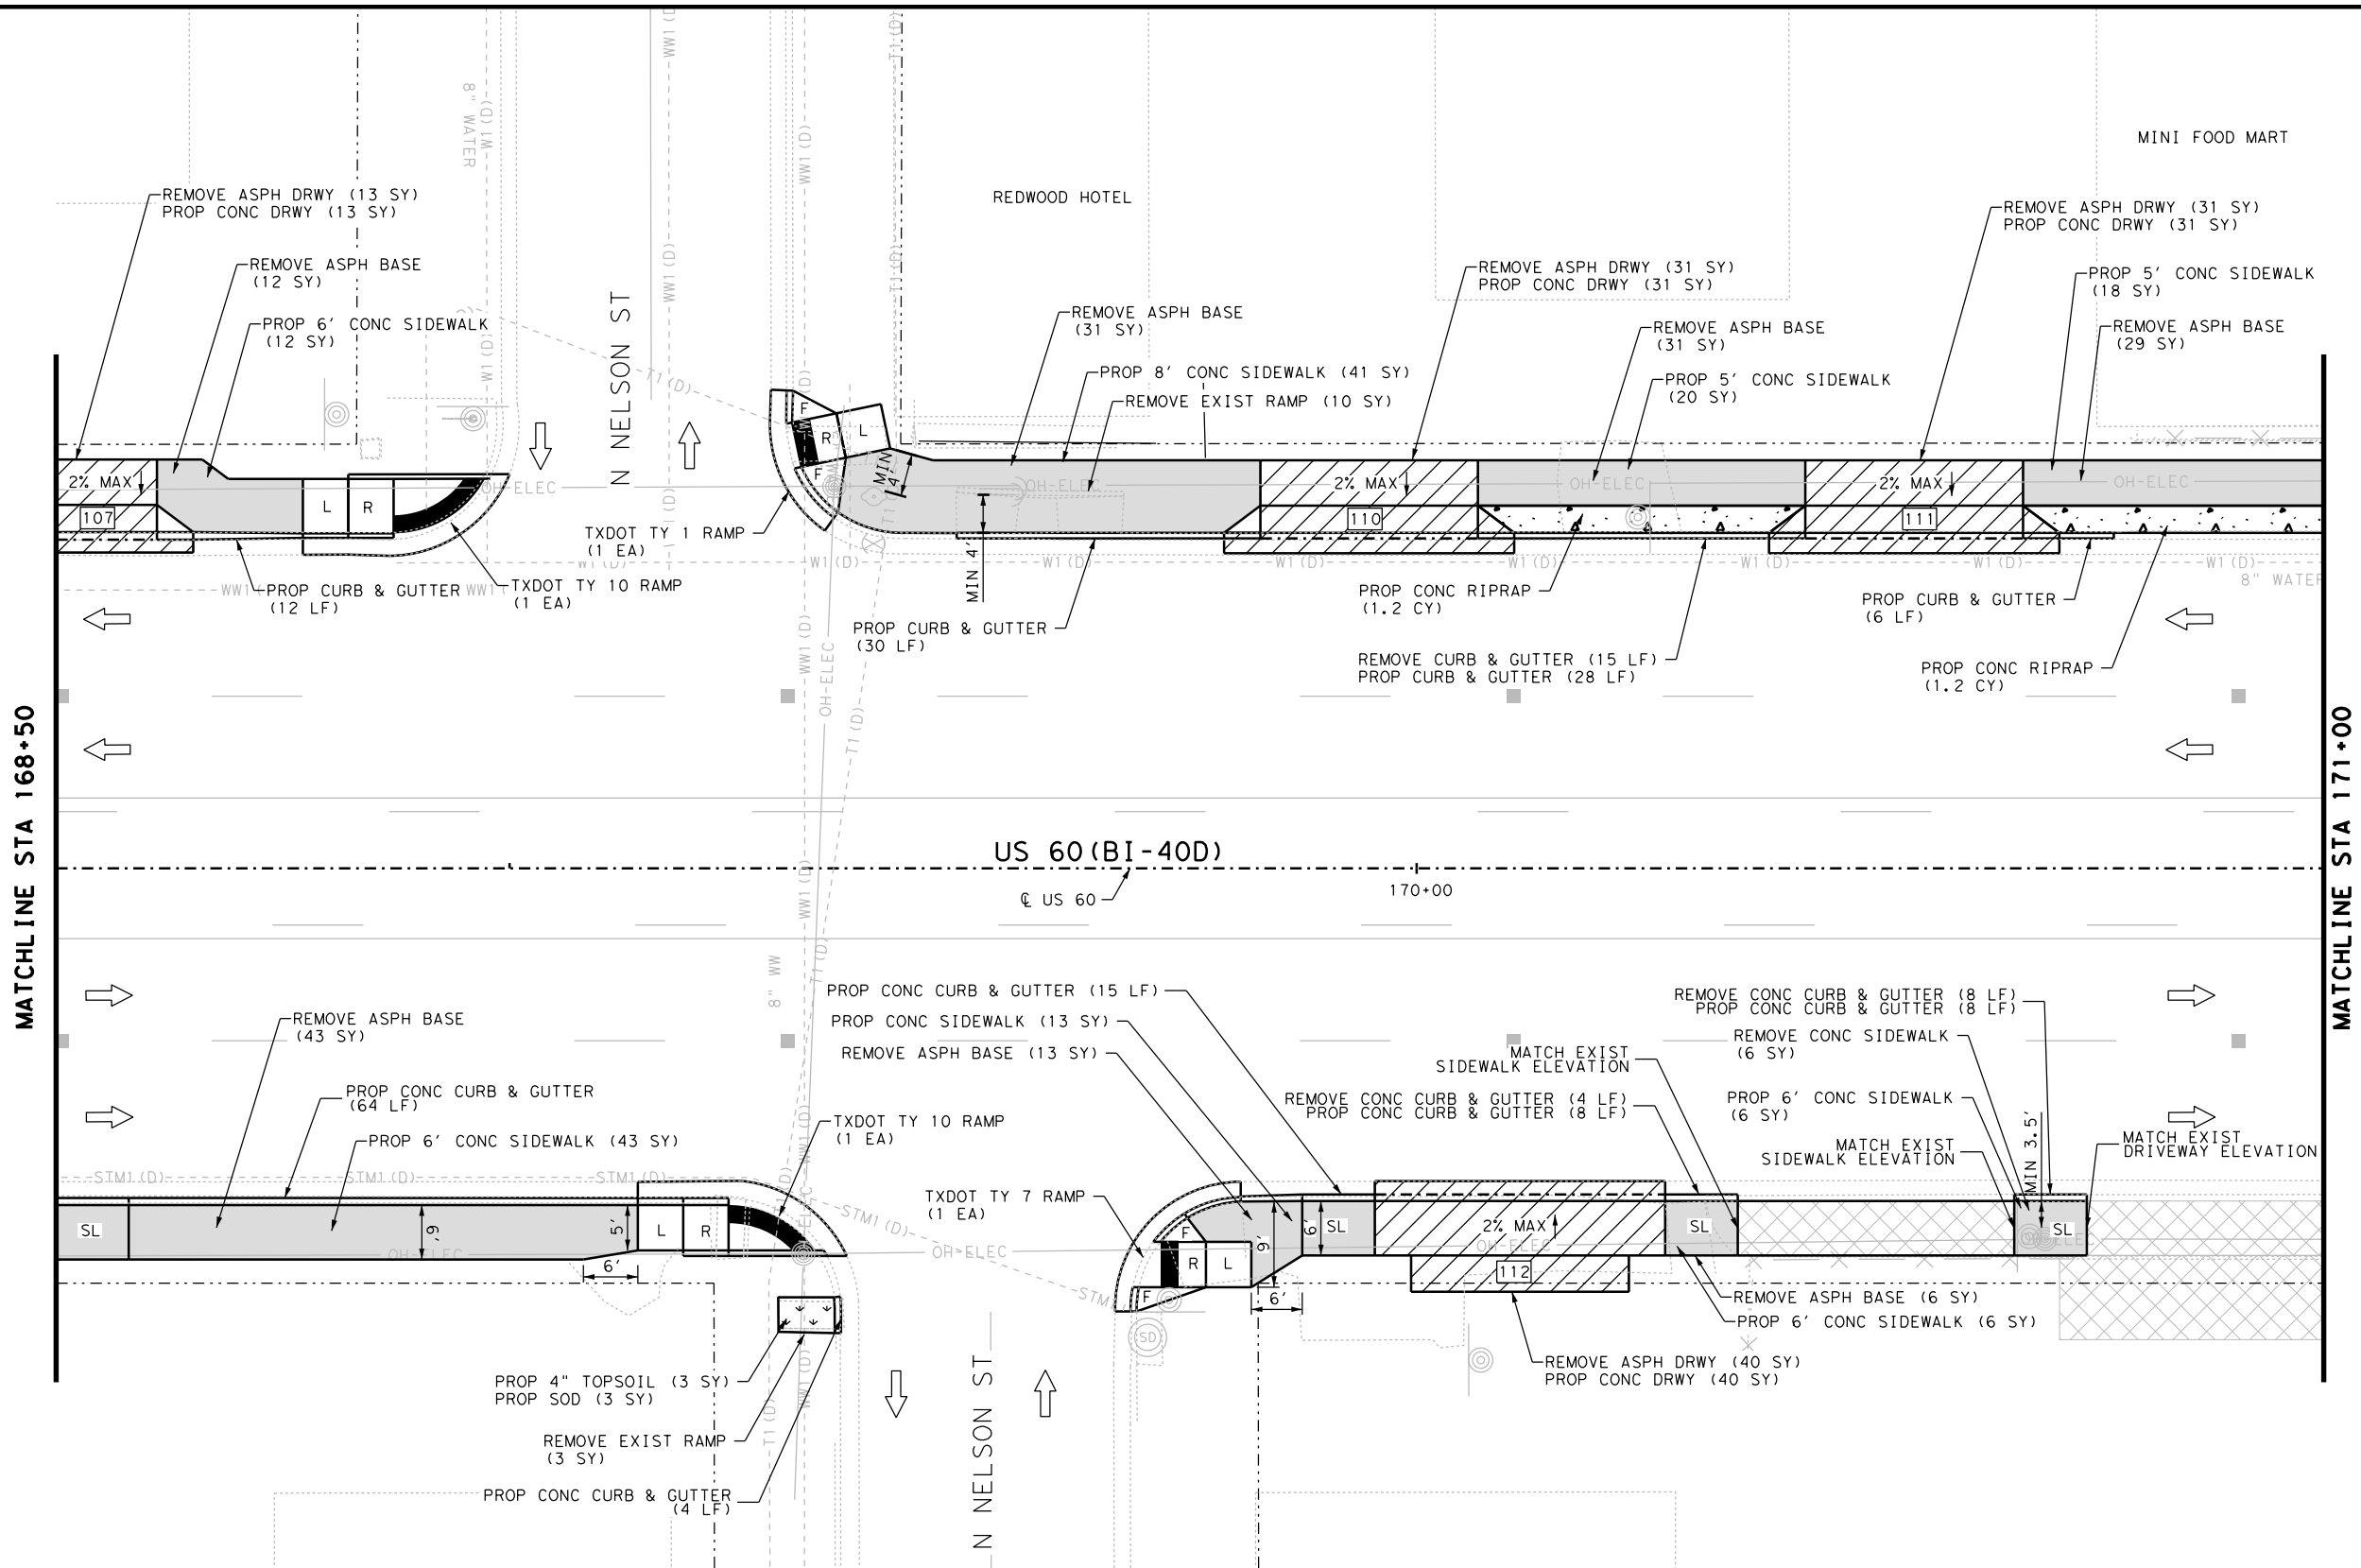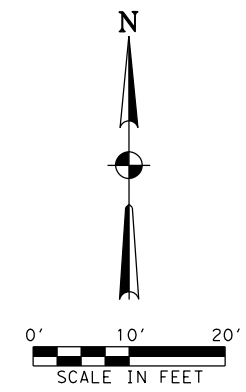

NOTES:
 * FOR CONTRACTOR INFORMATION ONLY
 1. THE EXISTENCE AND LOCATION OF ALL UTILITIES AND DRAINAGE STRUCTURES INDICATED IN THE PLANS ARE TAKEN FROM THE BEST RECORDS AVAILABLE AND ARE NOT GUARANTEED TO BE ACCURATE. CONTRACTOR SHALL COORDINATE WITH ALL UTILITY COMPANIES TO FIELD VERIFY UTILITIES PRIOR TO BEGINNING CONSTRUCTION.

NO.	DATE	REVISION	BY



GLOBAL CIVIL SOLUTIONS, LLC
 11551 FOREST CENTRAL DRIVE
 SUITE 220
 DALLAS, TX 75243
 F-12801



**US 60 (BI 40-D)
 SIDEWALK PLAN**

STA 168+50 TO STA 171+00



SHEET 30 OF 44

DESIGN	FED. RD. DIV. NO.	FEDERAL AID PROJECT NO.	HIGHWAY NO.
MI	6	(SEE TITLE SHEET)	VARIOUS
GRAPHICS	STATE	DISTRICT	COUNTY
PS	TEXAS	AMA	POTTER
CHECK	CONTROL	SECTION	JOB
MFM			
CHECK	FS	0904	02 047

P:\Jobs\2020007-Pedestrian\1110-CA00\VP3-SHEETS\047_AM_US_60_S1300F44.dgn
 5:18:41 PM
 1/27/2022

LEGEND	
	PROP SODDING
	PROP CONC DRWY
	PROP CONC RIPRAP
	PROP RETAINING WALL
	PROP CONC SIDEWALK
	EXISTING SIDEWALK/DRWY TO REMAIN
R	RAMP
L	LANDING PAD
F	FLARE
SL	LONG. SLOPE MAY NOT EXCEED 5% OR ADJACENT ROAD SLOPE
T	TRANSITION
LS	LEVEL SIDEWALK (2% MAX)
	TRAFFIC FLOW
	EXISTING SIGN
	PROPOSED SIGN
	MANHOLE
	POWER POLE
	TRAFFIC SIGNAL POLE
	LIGHT POLE
	WATER METER
	FIRE HYDRANT
	GUY WIRE
	TREE/SHRUB
	FENCE
	WATER VALVE
	TRAFFIC SIGNAL BOX
	IRRIGATION CONTROL VALVE
	ELECTRICAL PULL BOX
	DRIVEWAY ID
	PEDESTRIAN SIGNAL
	GAS METER
	SPRINKLER HEAD
	UTILITY MARKER POST
	OVERHEAD ELECTRIC LINE

ITEM	DESCRIPTION	UNIT	QTY
0104 6015	REMOVING CONC (SIDEWALKS)	SY	19
0104 6029	REMOVING CONC (CURB OR CURB & GUTTER)	LF	27
0105 6070	REMOVING STAB BASE & ASPH PAV (6" - 8")	SY	280
0160 6003	FURNISHING AND PLACING TOP SOIL (4")	SY	3
0162 6002	BLOCK SODDING	SY	3
0168 6001	VEGETATIVE WATERING	MG	0.2
0432 6001	RIPRAP (CONC) (4 IN)	CY	2.4
0529 6008	CONC CURB & GUTTER (TY II)	LF	175
0530 6004	DRIVEWAYS (CONC)	SY	115
0531 6001	CONC SIDEWALK (4")	SY	159
0531 6004	CURB RAMPS (TY 1)	EA	1
0531 6010	CURB RAMPS (TY 7)	EA	1
0531 6013	CURB RAMPS (TY 10)	EA	2

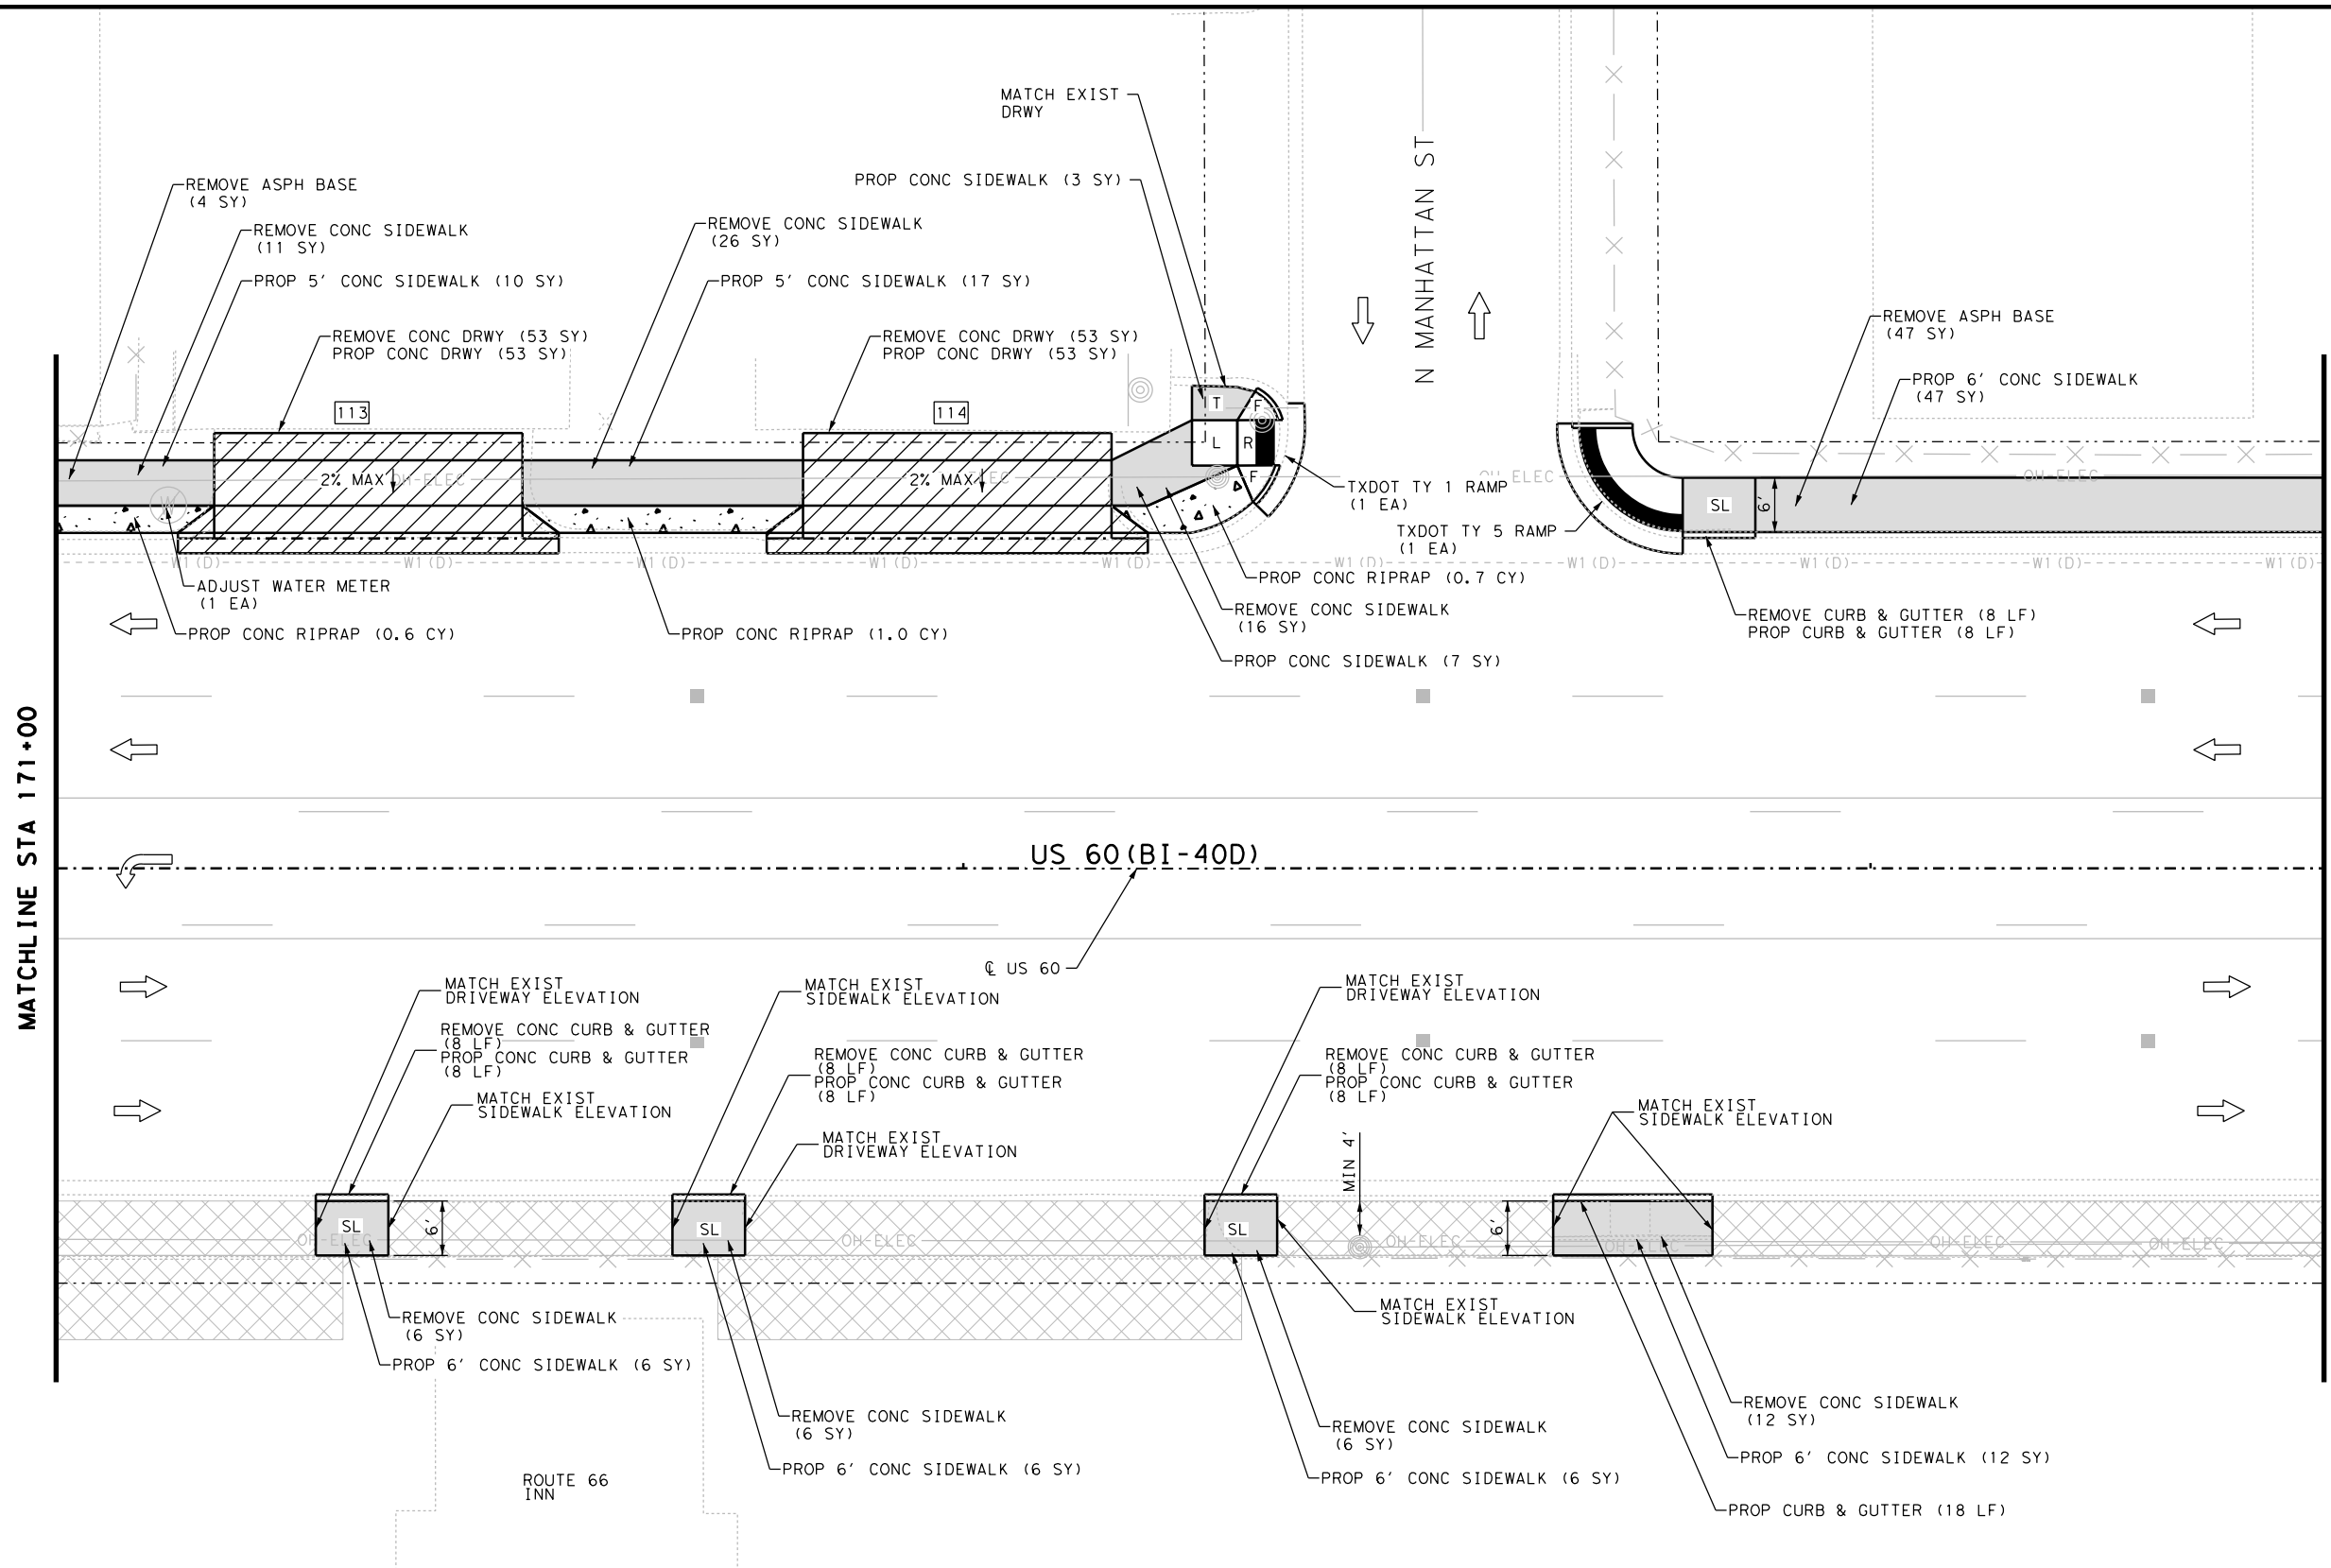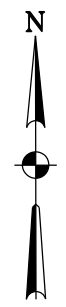

NOTES:
 * FOR CONTRACTOR INFORMATION ONLY
 1. THE EXISTENCE AND LOCATION OF ALL UTILITIES AND DRAINAGE STRUCTURES INDICATED IN THE PLANS ARE TAKEN FROM THE BEST RECORDS AVAILABLE AND ARE NOT GUARANTEED TO BE ACCURATE. CONTRACTOR SHALL COORDINATE WITH ALL UTILITY COMPANIES TO FIELD VERIFY UTILITIES PRIOR TO BEGINNING CONSTRUCTION.

NO.	DATE	REVISION	BY



GLOBAL CIVIL SOLUTIONS, LLC
 11551 FOREST CENTRAL DRIVE
 SUITE 220
 DALLAS, TX 75243
 F-12801



**US 60 (BI 40-D)
 SIDEWALK PLAN**

STA 171+00 TO STA 173+50

SHEET 31 OF 44

DESIGN	FED. RD. DIV. NO.	FEDERAL AID PROJECT NO.	HIGHWAY NO.
MI	6	(SEE TITLE SHEET)	VARIOUS
GRAPHICS	STATE	DISTRICT	COUNTY
PS	TEXAS	AMA	POTTER
CHECK	CONTROL	SECTION	JOB
MF			
CHECK	FS	0904	02 047



059

LEGEND

- | | | | |
|----------------------------------|---|---------------------|--------------------------|
| PROP SODDING | R RAMP | POWER POLE | IRRIGATION CONTROL VALVE |
| PROP CONC DRWY | L LANDING PAD | TRAFFIC SIGNAL POLE | ELECTRICAL PULL BOX |
| PROP CONC RIPRAP | F FLARE | LIGHT POLE | DRIVEWAY ID |
| PROP RETAINING WALL | SL LONG. SLOPE MAY NOT EXCEED 5% OR ADJACENT ROAD SLOPE | WATER METER | PEDESTRIAN SIGNAL |
| PROP CONC SIDEWALK | T TRANSITION | FIRE HYDRANT | GAS METER |
| EXISTING SIDEWALK/DRWY TO REMAIN | LS LEVEL SIDEWALK (2% MAX) | GUY WIRE | SPRINKLER HEAD |
| | TRAFFIC FLOW | TREE/SHRUB | UTILITY MARKER POST |
| | EXISTING SIGN | FENCE | OVERHEAD ELECTRIC LINE |
| | PROPOSED SIGN | WATER VALVE | |
| | MANHOLE | TRAFFIC SIGNAL BOX | |

ITEM	DESCRIPTION	UNIT	QTY
0104 6015	REMOVING CONC (SIDEWALKS)	SY	83
0104 6017	REMOVING CONC (DRIVEWAYS)	SY	106
0104 6029	REMOVING CONC (CURB OR CURB & GUTTER)	LF	32
0105 6070	REMOVING STAB BASE & ASPH PAV (6" - 8")	SY	51
0432 6001	RIPRAP (CONC) (4 IN)	CY	2.3
0479 6008	ADJUSTING MANHOLES (WATER METER)	EA	1
0529 6008	CONC CURB & GUTTER (TY II)	LF	50
0530 6004	DRIVEWAYS (CONC)	SY	106
0531 6001	CONC SIDEWALK (4")	SY	114
0531 6004	CURB RAMPS (TY 1)	EA	1
0531 6008	CURB RAMPS (TY 5)	EA	1

P:\Jobs\2020007-Pedestrian\TXDOT\Amor\1110\CA00\VP3\SHEETS\047_AM_US_60_S1310F44.dgn
 5:18:44 PM
 1/27/2022

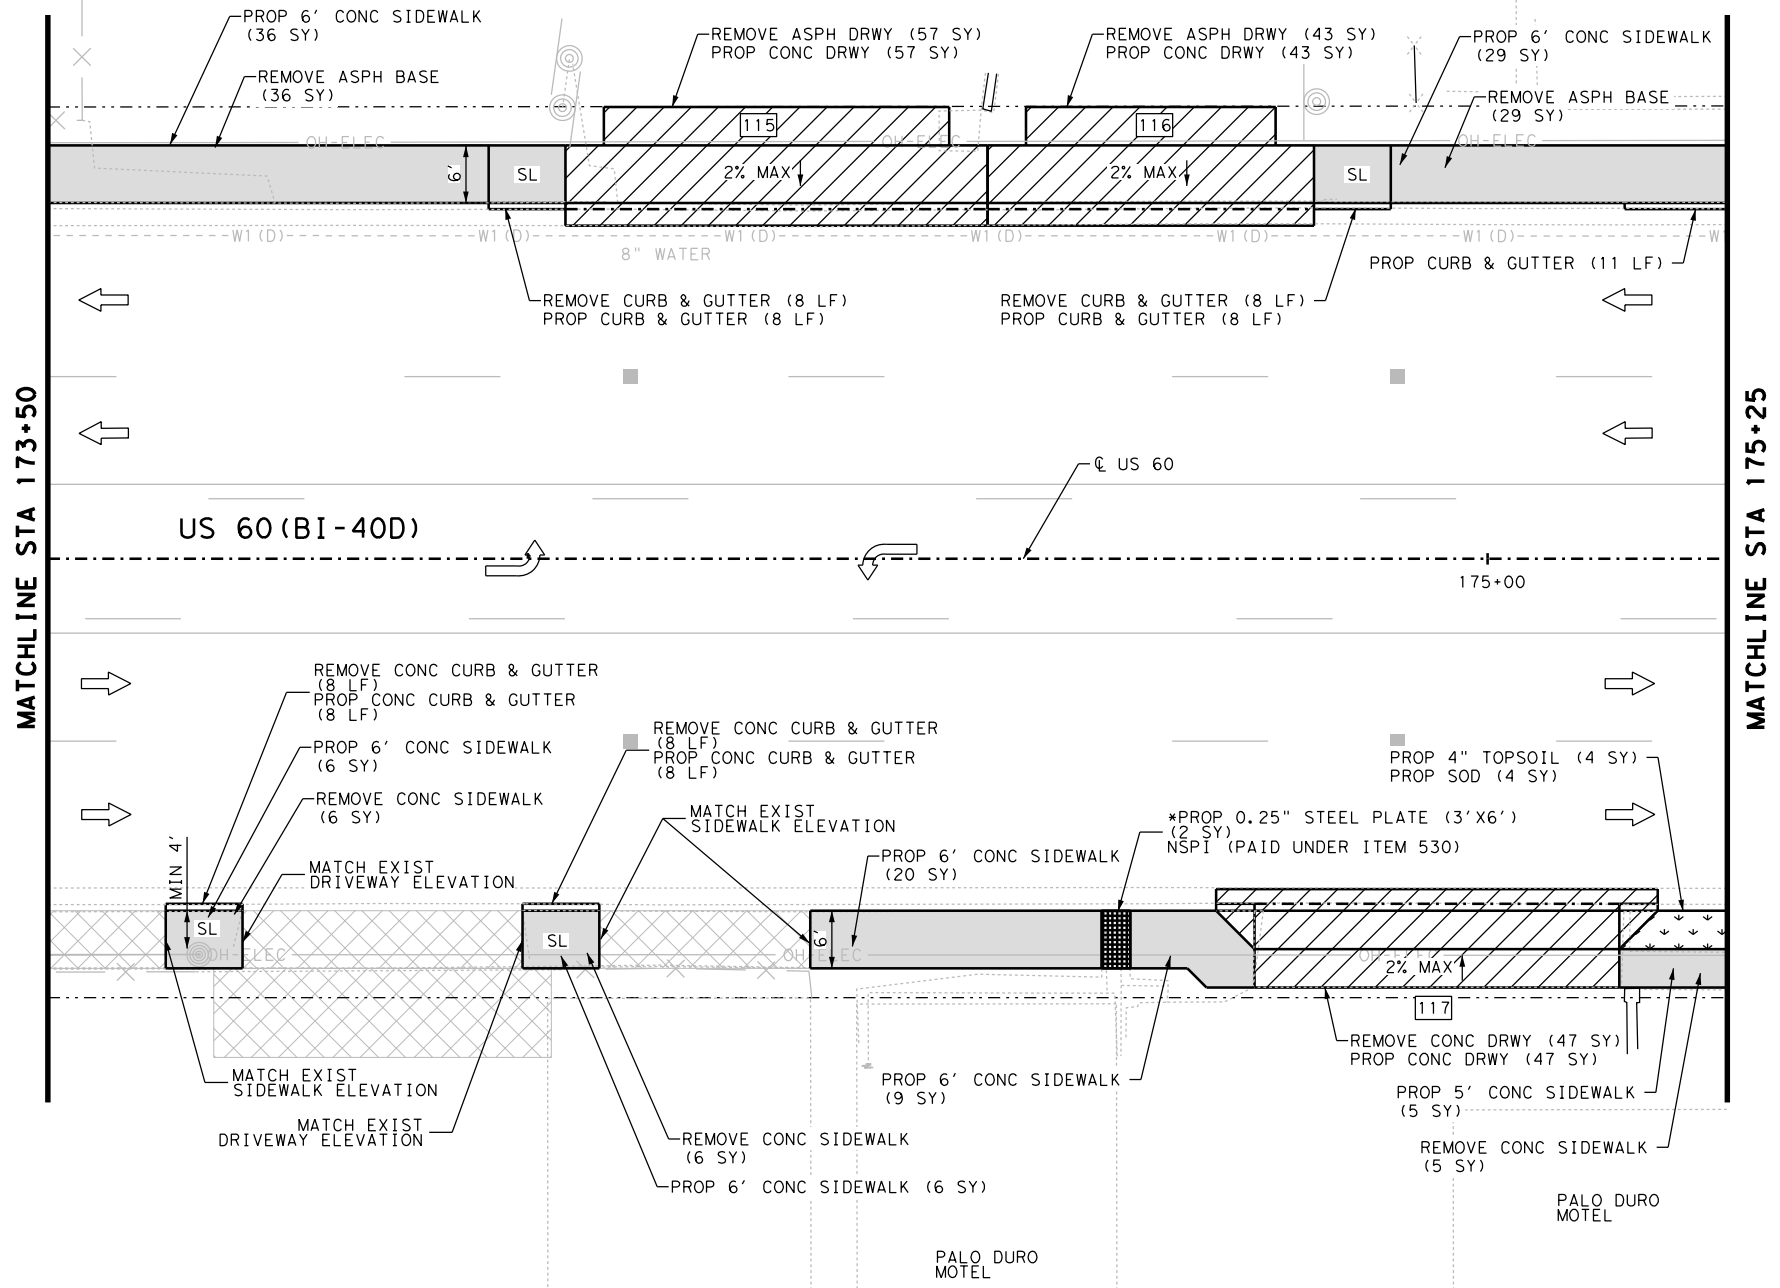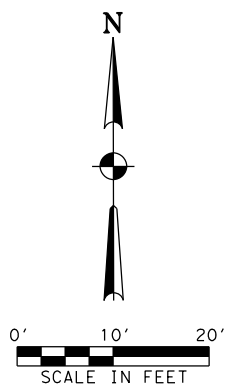

NOTES:
 * FOR CONTRACTOR INFORMATION ONLY
 1. THE EXISTENCE AND LOCATION OF ALL UTILITIES AND DRAINAGE STRUCTURES INDICATED IN THE PLANS ARE TAKEN FROM THE BEST RECORDS AVAILABLE AND ARE NOT GUARANTEED TO BE ACCURATE. CONTRACTOR SHALL COORDINATE WITH ALL UTILITY COMPANIES TO FIELD VERIFY UTILITIES PRIOR TO BEGINNING CONSTRUCTION.

NO.	DATE	REVISION	BY



GLOBAL CIVIL SOLUTIONS, LLC
 11551 FOREST CENTRAL DRIVE
 SUITE 220
 DALLAS, TX 75243
 F-12801



**US 60 (BI 40-D)
 SIDEWALK PLAN**

STA 173+50 TO STA 175+25

SHEET 32 OF 44



DESIGN	FED. RD. DIV. NO.	FEDERAL AID PROJECT NO.	HIGHWAY NO.
MI	6	(SEE TITLE SHEET)	VARIOUS
GRAPHICS	STATE	DISTRICT	COUNTY
PS	TEXAS	AMA	POTTER
CHECK	CONTROL	SECTION	JOB
MF			
CHECK	NO.	NO.	NO.
FS	0904	02	047

060

LEGEND			
	PROP SODDING	R	RAMP
	PROP CONC DRWY	L	LANDING PAD
	PROP CONC RIPRAP	F	FLARE
	PROP RETAINING WALL	SL	LONG. SLOPE MAY NOT EXCEED 5% OR ADJACENT ROAD SLOPE
	PROP CONC SIDEWALK	T	TRANSITION
	EXISTING SIDEWALK/DRWY TO REMAIN	LS	LEVEL SIDEWALK (2% MAX)
	PROPOSED SIGN	↑	TRAFFIC FLOW
	EXISTING SIGN	⊙	EXISTING SIGN
	PROPOSED SIGN	⊙	MANHOLE
	POWER POLE	⊙	TRAFFIC SIGNAL POLE
	TRAFFIC SIGNAL POLE	⊙	LIGHT POLE
	WATER METER	⊙	FIRE HYDRANT
	FIRE HYDRANT	⊙	GUY WIRE
	TREE/SHRUB	⊙	WATER VALVE
	FENCE	⊙	TRAFFIC SIGNAL BOX
	IRRIGATION CONTROL VALVE	⊙	
	ELECTRICAL PULL BOX	⊙	
	DRIVEWAY ID	⊙	
	PEDESTRIAN SIGNAL	⊙	
	GAS METER	⊙	
	SPRINKLER HEAD	⊙	
	UTILITY MARKER POST	⊙	
	OVERHEAD ELECTRIC LINE	⊙	

ITEM	DESCRIPTION	UNIT	QTY
0104 6015	REMOVING CONC (SIDEWALKS)	SY	17
0104 6017	REMOVING CONC (DRIVEWAYS)	SY	47
0104 6029	REMOVING CONC (CURB OR CURB & GUTTER)	LF	32
0105 6070	REMOVING STAB BASE & ASPH PAV (6" - 8")	SY	165
0160 6003	FURNISHING AND PLACING TOP SOIL (4")	SY	4
0162 6002	BLOCK SODDING	SY	4
0168 6001	VEGETATIVE WATERING	MG	0.2
0529 6008	CONC CURB & GUTTER (TY II)	LF	43
0530 6004	DRIVEWAYS (CONC)	SY	147
0531 6001	CONC SIDEWALK (4")	SY	111

P:\Jobs\2020007-Pedestr\1110-CA00\VP3-SHEETS\047_AM_US_60_S1320F44.dgn
 5:18:45 PM
 1/27/2022

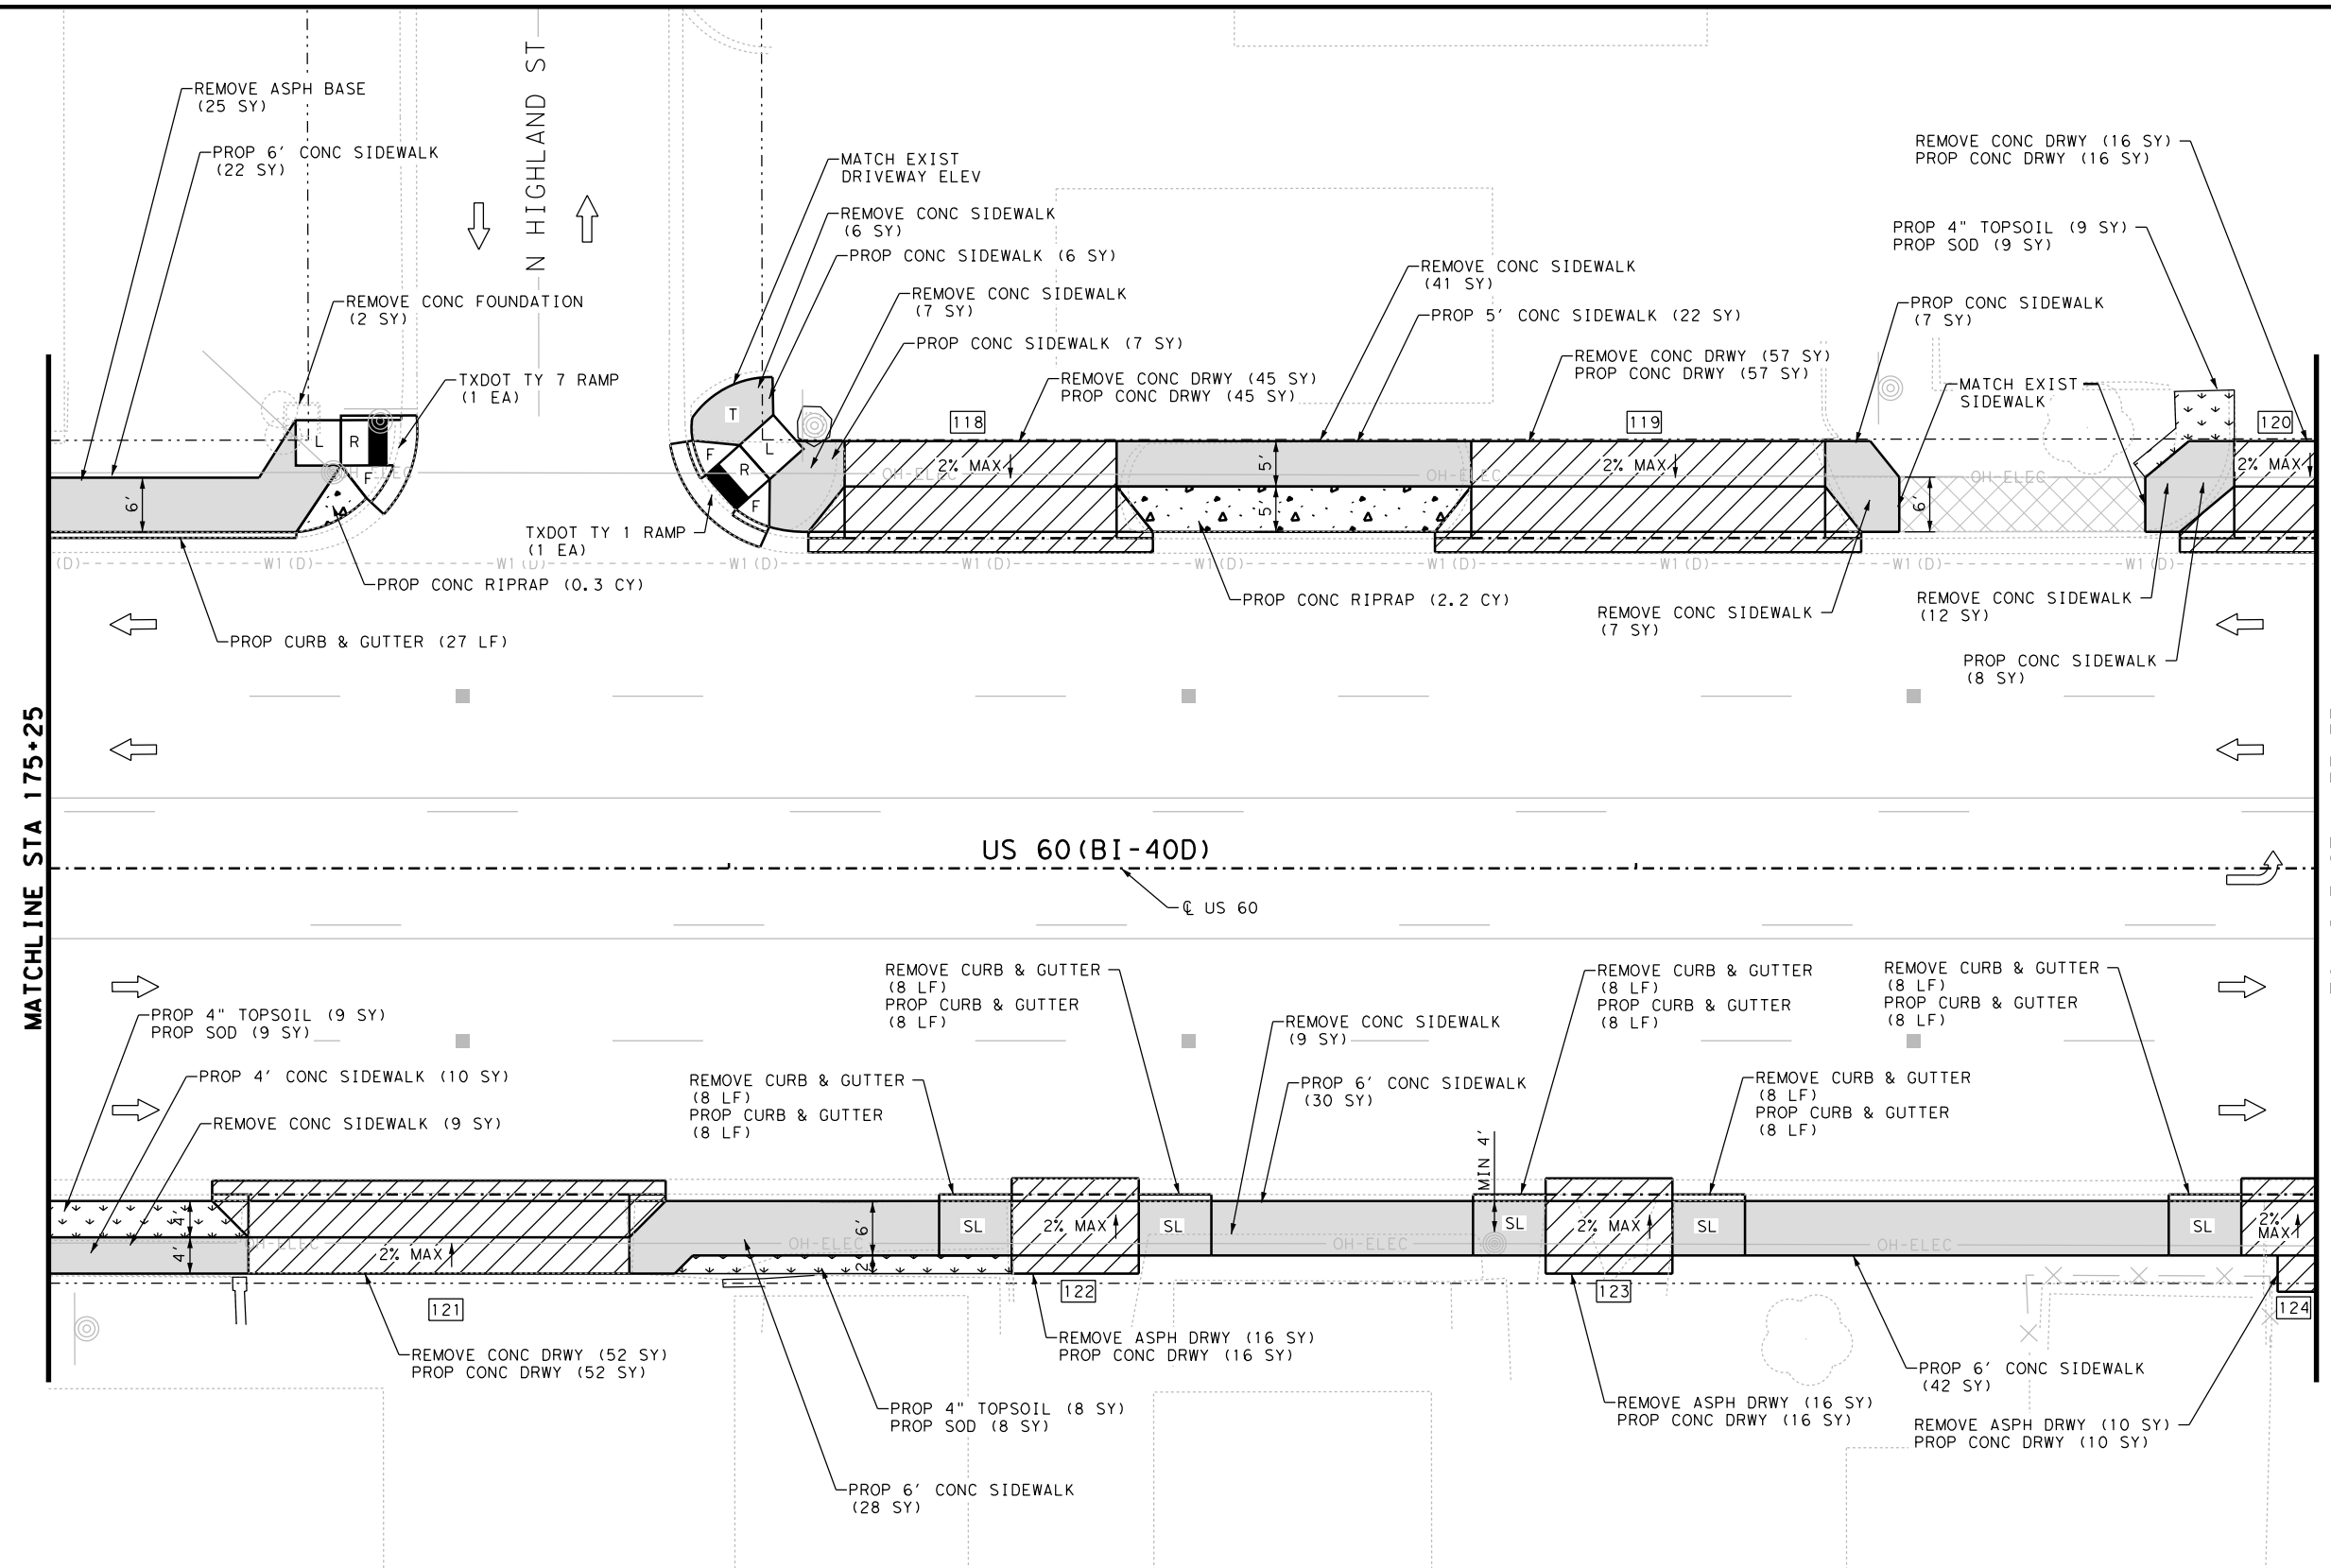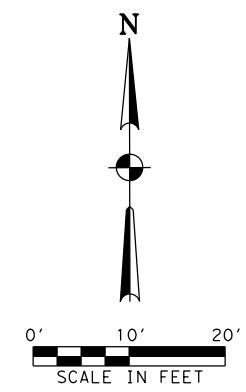

MATCHLINE STA 175+25

MATCHLINE STA 177+75

- NOTES:
- * FOR CONTRACTOR INFORMATION ONLY
 - 1. THE EXISTENCE AND LOCATION OF ALL UTILITIES AND DRAINAGE STRUCTURES INDICATED IN THE PLANS ARE TAKEN FROM THE BEST RECORDS AVAILABLE AND ARE NOT GUARANTEED TO BE ACCURATE. CONTRACTOR SHALL COORDINATE WITH ALL UTILITY COMPANIES TO FIELD VERIFY UTILITIES PRIOR TO BEGINNING CONSTRUCTION.

NO.	DATE	REVISION	BY



GLOBAL CIVIL SOLUTIONS, LLC
 11551 FOREST CENTRAL DRIVE
 SUITE 220
 DALLAS, TX 75243
 F-12801



**US 60 (BI 40-D)
 SIDEWALK PLAN**



STA 175+25 TO STA 177+75

SHEET 33 OF 44

LEGEND	
	PROP SODDING
	PROP CONC DRWY
	PROP CONC RIPRAP
	PROP RETAINING WALL
	PROP CONC SIDEWALK
	EXISTING SIDEWALK/DRWY TO REMAIN
R	RAMP
L	LANDING PAD
F	FLARE
SL	LONG. SLOPE MAY NOT EXCEED 5% OR ADJACENT ROAD SLOPE
T	TRANSITION
LS	LEVEL SIDEWALK (2% MAX)
	TRAFFIC FLOW
	EXISTING SIGN
	PROPOSED SIGN
	MANHOLE
	POWER POLE
	TRAFFIC SIGNAL POLE
	LIGHT POLE
	WATER METER
	FIRE HYDRANT
	GUY WIRE
	TREE/SHRUB
	FENCE
	WATER VALVE
	TRAFFIC SIGNAL BOX
	IRRIGATION CONTROL VALVE
	ELECTRICAL PULL BOX
	DRIVEWAY ID
	PEDESTRIAN SIGNAL
	GAS METER
	SPRINKLER HEAD
	UTILITY MARKER POST
	OVERHEAD ELECTRIC LINE

ITEM	DESCRIPTION	UNIT	QTY
0104 6013	REMOVING CONC (FOUNDATIONS)	SY	2.0
0104 6015	REMOVING CONC (SIDEWALKS)	SY	91
0104 6017	REMOVING CONC (DRIVEWAYS)	SY	170
0104 6029	REMOVING CONC (CURB OR CURB & GUTTER)	LF	40
0105 6070	REMOVING STAB BASE & ASPH PAV (6" - 8")	SY	67
0160 6003	FURNISHING AND PLACING TOP SOIL (4")	SY	26
0162 6002	BLOCK SODDING	SY	26
0168 6001	VEGETATIVE WATERING	MG	0.6
0432 6001	RIPRAP (CONC) (4 IN)	CY	2.5
0529 6008	CONC CURB & GUTTER (TY II)	LF	67
0530 6004	DRIVEWAYS (CONC)	SY	212
0531 6001	CONC SIDEWALK (4")	SY	182
0531 6004	CURB RAMPS (TY 1)	EA	1
0531 6010	CURB RAMPS (TY 7)	EA	1

P:\Jobs\2020007-Pedestrian\1110-CADD\PS3-SHEETS\047_AM_US_60_S1330F44.dgn 3/15/2022 2:08:22 PM

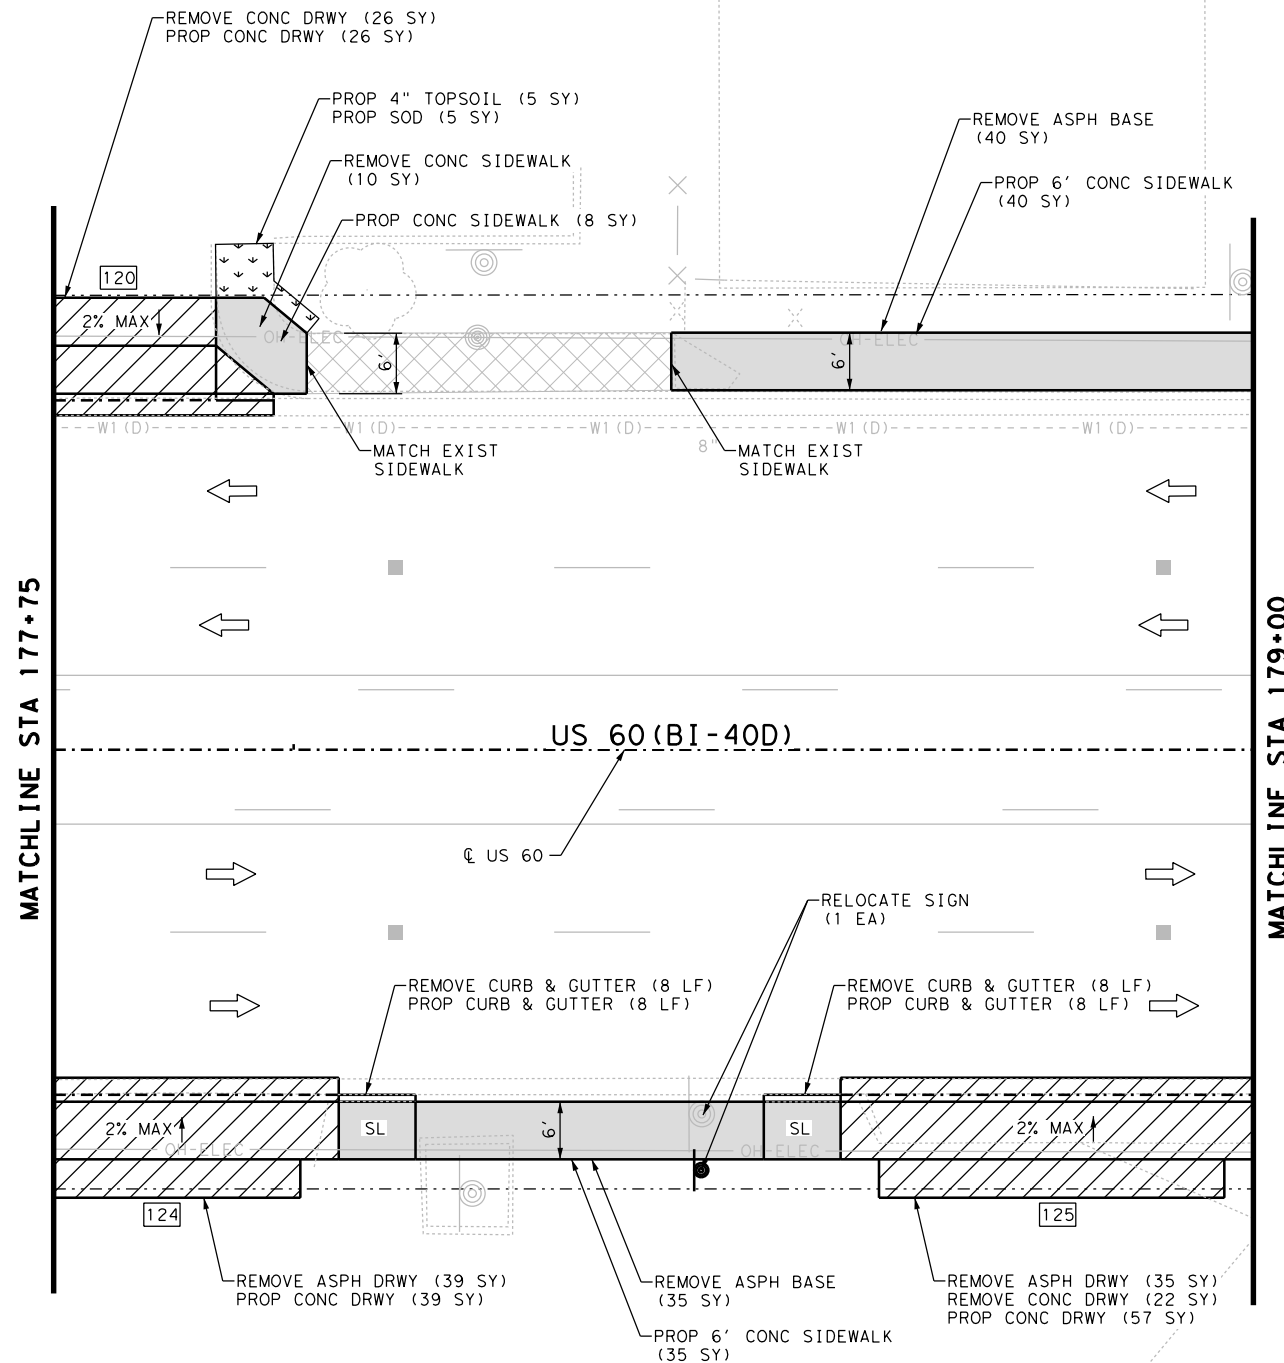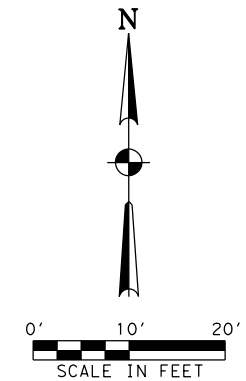

NOTES:

- * FOR CONTRACTOR INFORMATION ONLY
- 1. THE EXISTENCE AND LOCATION OF ALL UTILITIES AND DRAINAGE STRUCTURES INDICATED IN THE PLANS ARE TAKEN FROM THE BEST RECORDS AVAILABLE AND ARE NOT GUARANTEED TO BE ACCURATE. CONTRACTOR SHALL COORDINATE WITH ALL UTILITY COMPANIES TO FIELD VERIFY UTILITIES PRIOR TO BEGINNING CONSTRUCTION.

NO.	DATE	REVISION	BY



GLOBAL CIVIL SOLUTIONS, LLC
 11551 FOREST CENTRAL DRIVE
 SUITE 220
 DALLAS, TX 75243
 F-12801



US 60 (BI 40-D)
SIDEWALK PLAN

STA 177+75 TO STA 179+00

SHEET 34 OF 44



DESIGN MI	FED. RD. DIV. NO. 6	FEDERAL AID PROJECT NO. (SEE TITLE SHEET)	HIGHWAY NO. VARIOUS
GRAPHICS PS	STATE TEXAS	DISTRICT AMA	COUNTY POTTER
CHECK MF	CONTROL 0904	SECTION 02	JOB 047
CHECK FS			SHEET NO. 062

P:\Jobs\2020007-Pedestrian\1110\CA00\PS3-SHEETS\047_AM_US_60_S1340F44.dgn
 5:18:48 PM
 1/27/2022

LEGEND

- | | | | |
|----------------------------------|---|---------------------|--------------------------|
| PROP SODDING | R RAMP | POWER POLE | IRRIGATION CONTROL VALVE |
| PROP CONC DRWY | L LANDING PAD | TRAFFIC SIGNAL POLE | ELECTRICAL PULL BOX |
| PROP CONC RIPRAP | F FLARE | LIGHT POLE | DRIVEWAY ID |
| PROP RETAINING WALL | SL LONG. SLOPE MAY NOT EXCEED 5% OR ADJACENT ROAD SLOPE | WATER METER | PEDESTRIAN SIGNAL |
| PROP CONC SIDEWALK | T TRANSITION | FIRE HYDRANT | GAS METER |
| EXISTING SIDEWALK/DRWY TO REMAIN | LS LEVEL SIDEWALK (2% MAX) | GUY WIRE | SPRINKLER HEAD |
| | TRAFFIC FLOW | TREE/SHRUB | UTILITY MARKER POST |
| | EXISTING SIGN | FENCE | OVERHEAD ELECTRIC LINE |
| | PROPOSED SIGN | WATER VALVE | |
| | MANHOLE | TRAFFIC SIGNAL BOX | |

ITEM	DESCRIPTION	UNIT	QTY
0104 6015	REMOVING CONC (SIDEWALKS)	SY	10
0104 6017	REMOVING CONC (DRIVEWAYS)	SY	48
0104 6029	REMOVING CONC (CURB OR CURB & GUTTER)	LF	16
0105 6070	REMOVING STAB BASE & ASPH PAV (6" - 8")	SY	149
0160 6003	FURNISHING AND PLACING TOP SOIL (4")	SY	5
0162 6002	BLOCK SODDING	SY	5
0168 6001	VEGETATIVE WATERING	MG	0.2
0529 6008	CONC CURB & GUTTER (TY II)	LF	16
0530 6004	DRIVEWAYS (CONC)	SY	122
0531 6001	CONC SIDEWALK (4")	SY	83
0644 6068	RELOCATE SM RD SN SUP&M TY 10BWG	EA	1

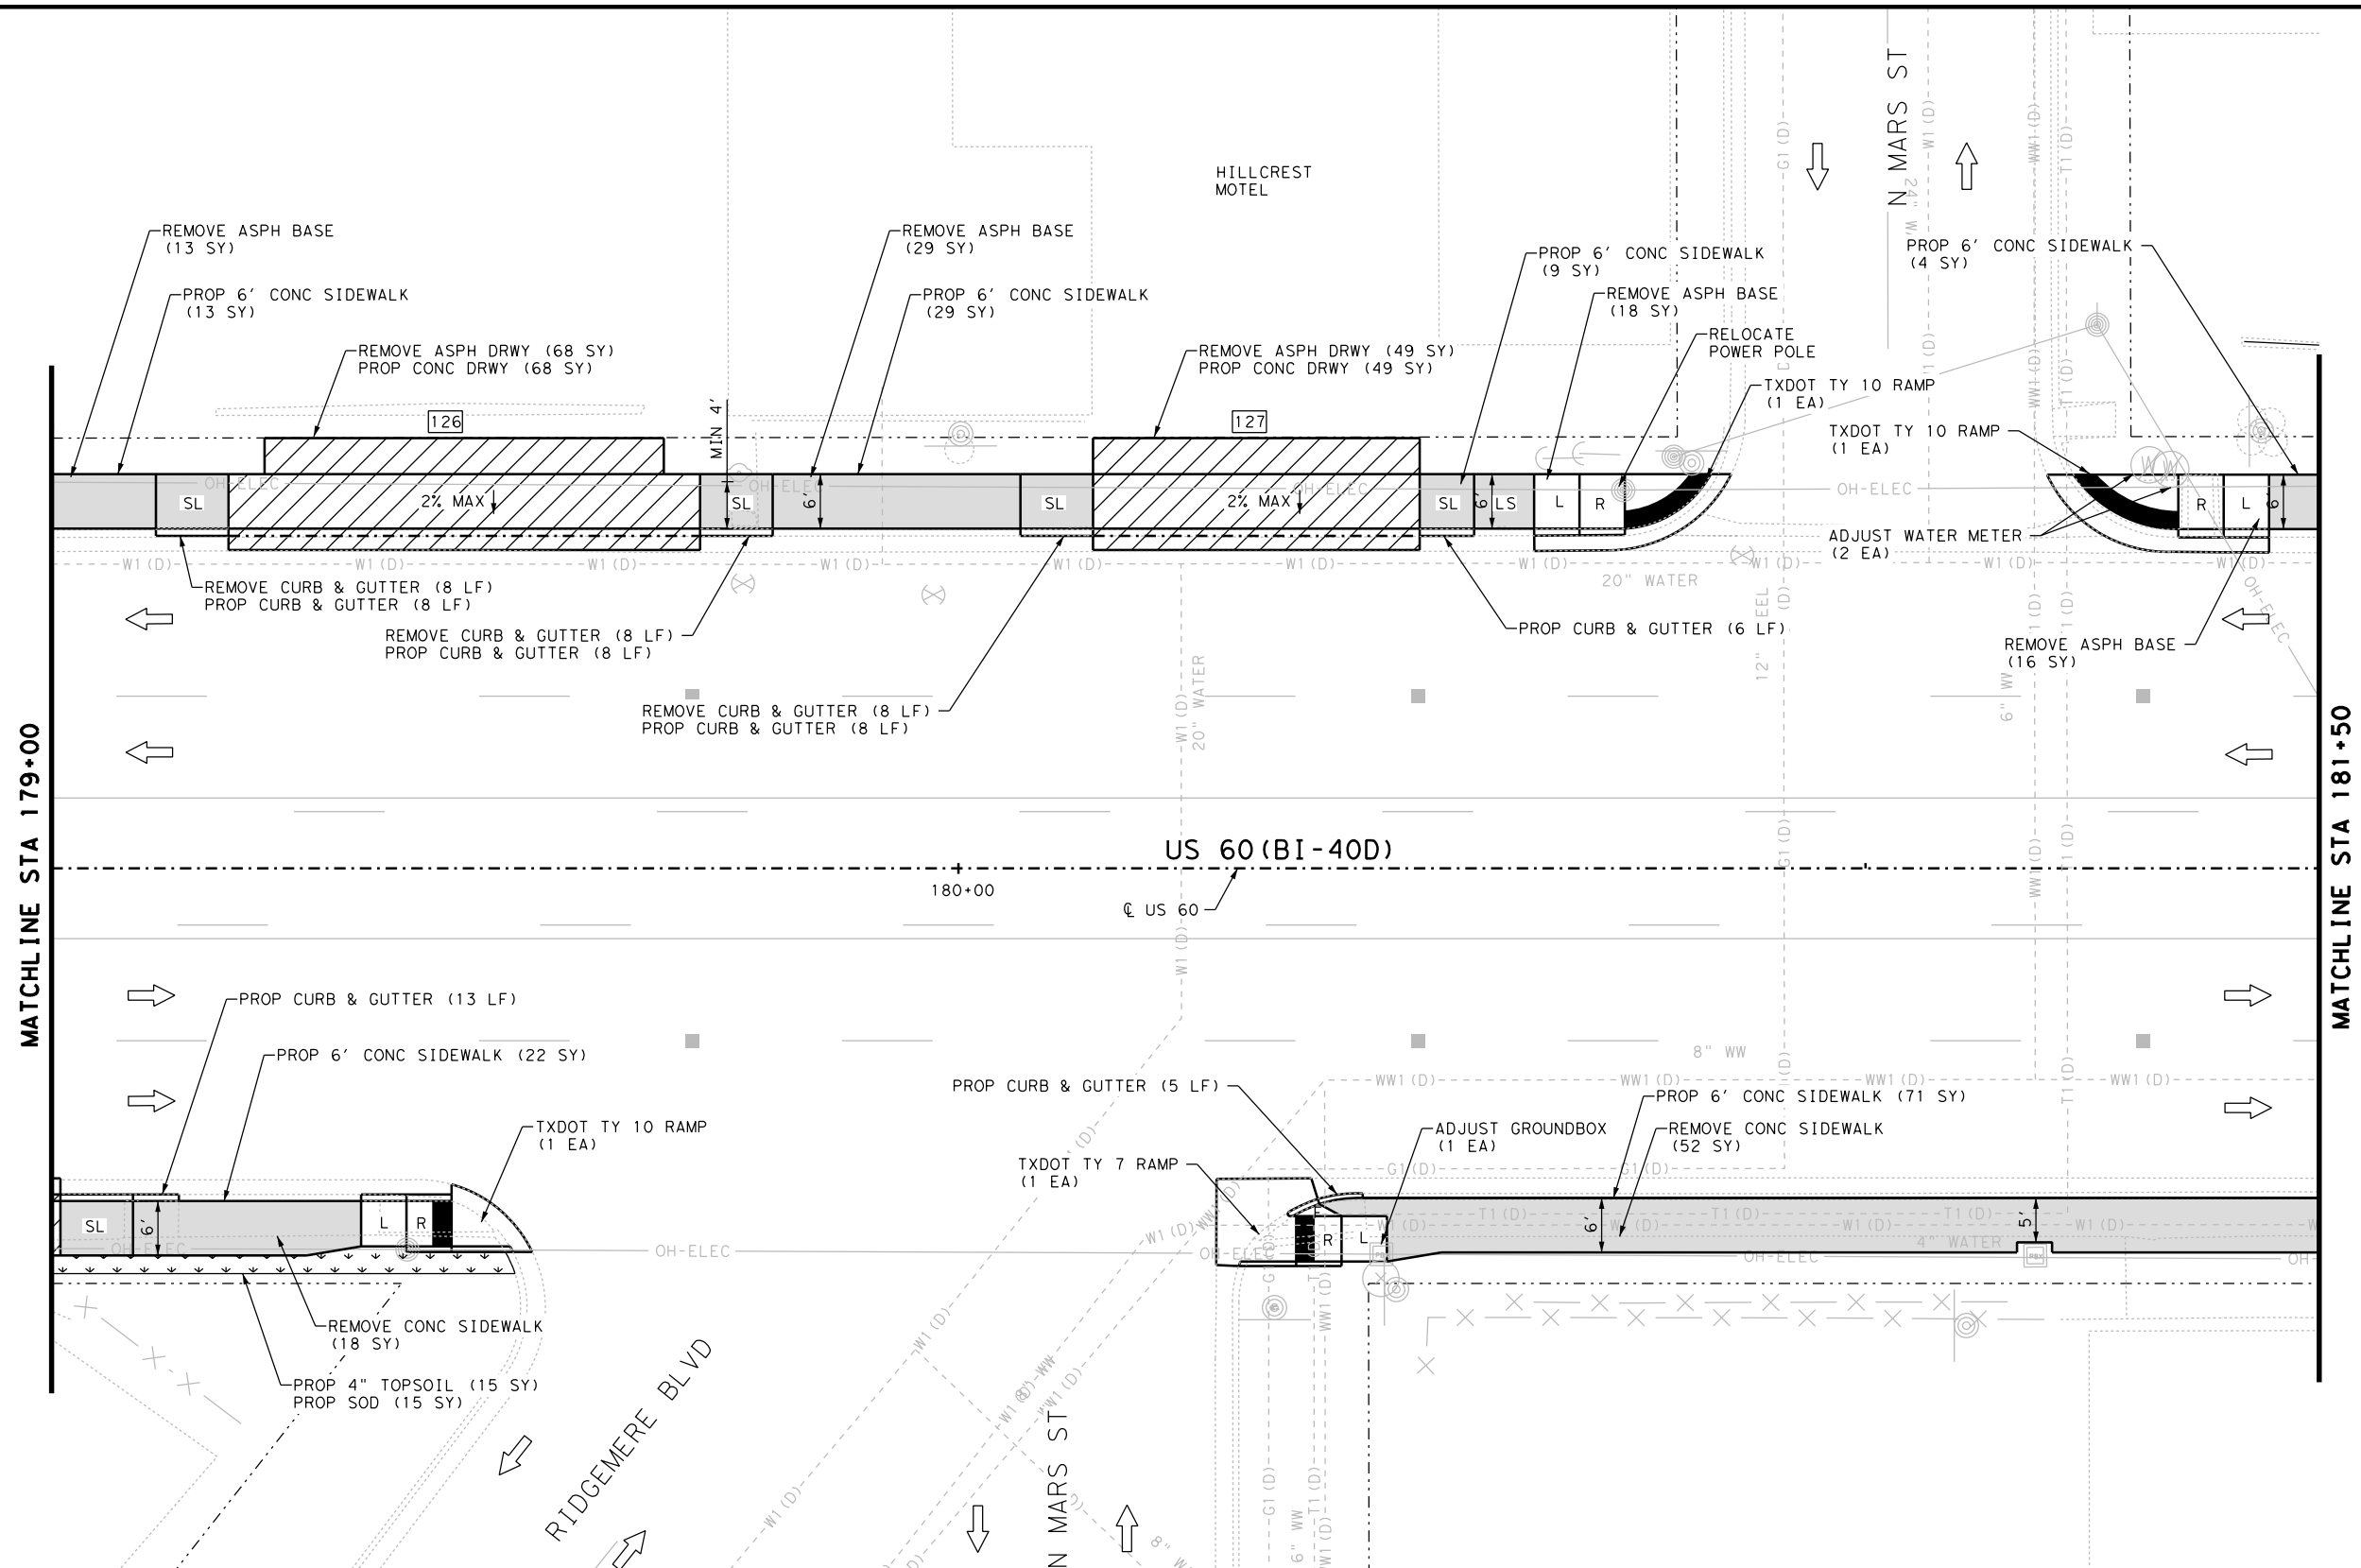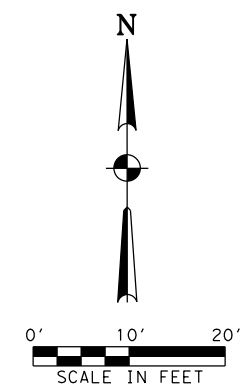

NOTES:
 * FOR CONTRACTOR INFORMATION ONLY
 1. THE EXISTENCE AND LOCATION OF ALL UTILITIES AND DRAINAGE STRUCTURES INDICATED IN THE PLANS ARE TAKEN FROM THE BEST RECORDS AVAILABLE AND ARE NOT GUARANTEED TO BE ACCURATE. CONTRACTOR SHALL COORDINATE WITH ALL UTILITY COMPANIES TO FIELD VERIFY UTILITIES PRIOR TO BEGINNING CONSTRUCTION.

NO.	DATE	REVISION	BY

GLOBAL CIVIL SOLUTIONS, LLC
 11551 FOREST CENTRAL DRIVE
 SUITE 220
 DALLAS, TX 75243
 F-12801



Texas Department of Transportation
 ©2022 TxDOT

US 60 (BI 40-D)			
SIDEWALK PLAN			
STA 179+00 TO STA 181+50			
SHEET 35 OF 44			
DESIGN	FED. RD. DIV. NO.	FEDERAL AID PROJECT NO.	HIGHWAY NO.
MI	6	(SEE TITLE SHEET)	VARIOUS
GRAPHICS	STATE	DISTRICT	COUNTY
PS	TEXAS	AMA	POTTER
CHECK	CONTROL	SECTION	JOB
MFM	0904	02	047
CHECK			
FS			
			063

P:\Jobs\2020007-Pedestr\on TxDOT\Amor\1110\CA00\VP3\SHEETS\047_AM_US_60_S1350F44.dgn
 5:18:50 PM
 1/27/2022

<p>LEGEND</p> <p> PROP SODDING</p> <p> PROP CONC DRWY</p> <p> PROP CONC RIPRAP</p> <p> PROP RETAINING WALL</p> <p> PROP CONC SIDEWALK</p> <p> EXISTING SIDEWALK/DRWY TO REMAIN</p>	<p>R RAMP</p> <p>L LANDING PAD</p> <p>F FLARE</p> <p>SL LONG SLOPE MAY NOT EXCEED 5% OR ADJACENT ROAD SLOPE</p> <p>T TRANSITION</p> <p>LS LEVEL SIDEWALK (2% MAX)</p> <p>← TRAFFIC FLOW</p> <p>⊙ EXISTING SIGN</p> <p>⊙ PROPOSED SIGN</p> <p>⊙ MANHOLE</p>	<p>⊙ POWER POLE</p> <p>⊙ TRAFFIC SIGNAL POLE</p> <p>⊙ LIGHT POLE</p> <p>⊙ WATER METER</p> <p>⊙ FIRE HYDRANT</p> <p>⊙ GUY WIRE</p> <p>⊙ TREE/SHRUB</p> <p>⊙ FENCE</p> <p>⊙ WATER VALVE</p> <p>⊙ TRAFFIC SIGNAL BOX</p>
<p>⊙ IRRIGATION CONTROL VALVE</p> <p>⊙ ELECTRICAL PULL BOX</p> <p>⊙ DRIVEWAY ID</p> <p>⊙ PEDESTRIAN SIGNAL</p> <p>⊙ GAS METER</p> <p>⊙ SPRINKLER HEAD</p> <p>⊙ UTILITY MARKER POST</p> <p>⊙ OVERHEAD ELECTRIC LINE</p>		

ITEM	DESCRIPTION	UNIT	QTY
0104 6015	REMOVING CONC (SIDEWALKS)	SY	70
0104 6029	REMOVING CONC (CURB OR CURB & GUTTER)	LF	24
0105 6070	REMOVING STAB BASE & ASPH PAV (6" - 8")	SY	191
0160 6003	FURNISHING AND PLACING TOP SOIL (4")	SY	15
0162 6002	BLOCK SODDING	SY	15
0168 6001	VEGETATIVE WATERING	MG	0.6
0479 6008	ADJUSTING MANHOLES (WATER METER)	EA	2
0529 6008	CONC CURB & GUTTER (TY II)	LF	48
0530 6004	DRIVEWAYS (CONC)	SY	117
0531 6001	CONC SIDEWALK (4")	SY	148
0531 6010	CURB RAMPS (TY 7)	EA	1
0531 6013	CURB RAMPS (TY 10)	EA	3
6027 6009	GROUND BOX (ADJUST)	EA	1

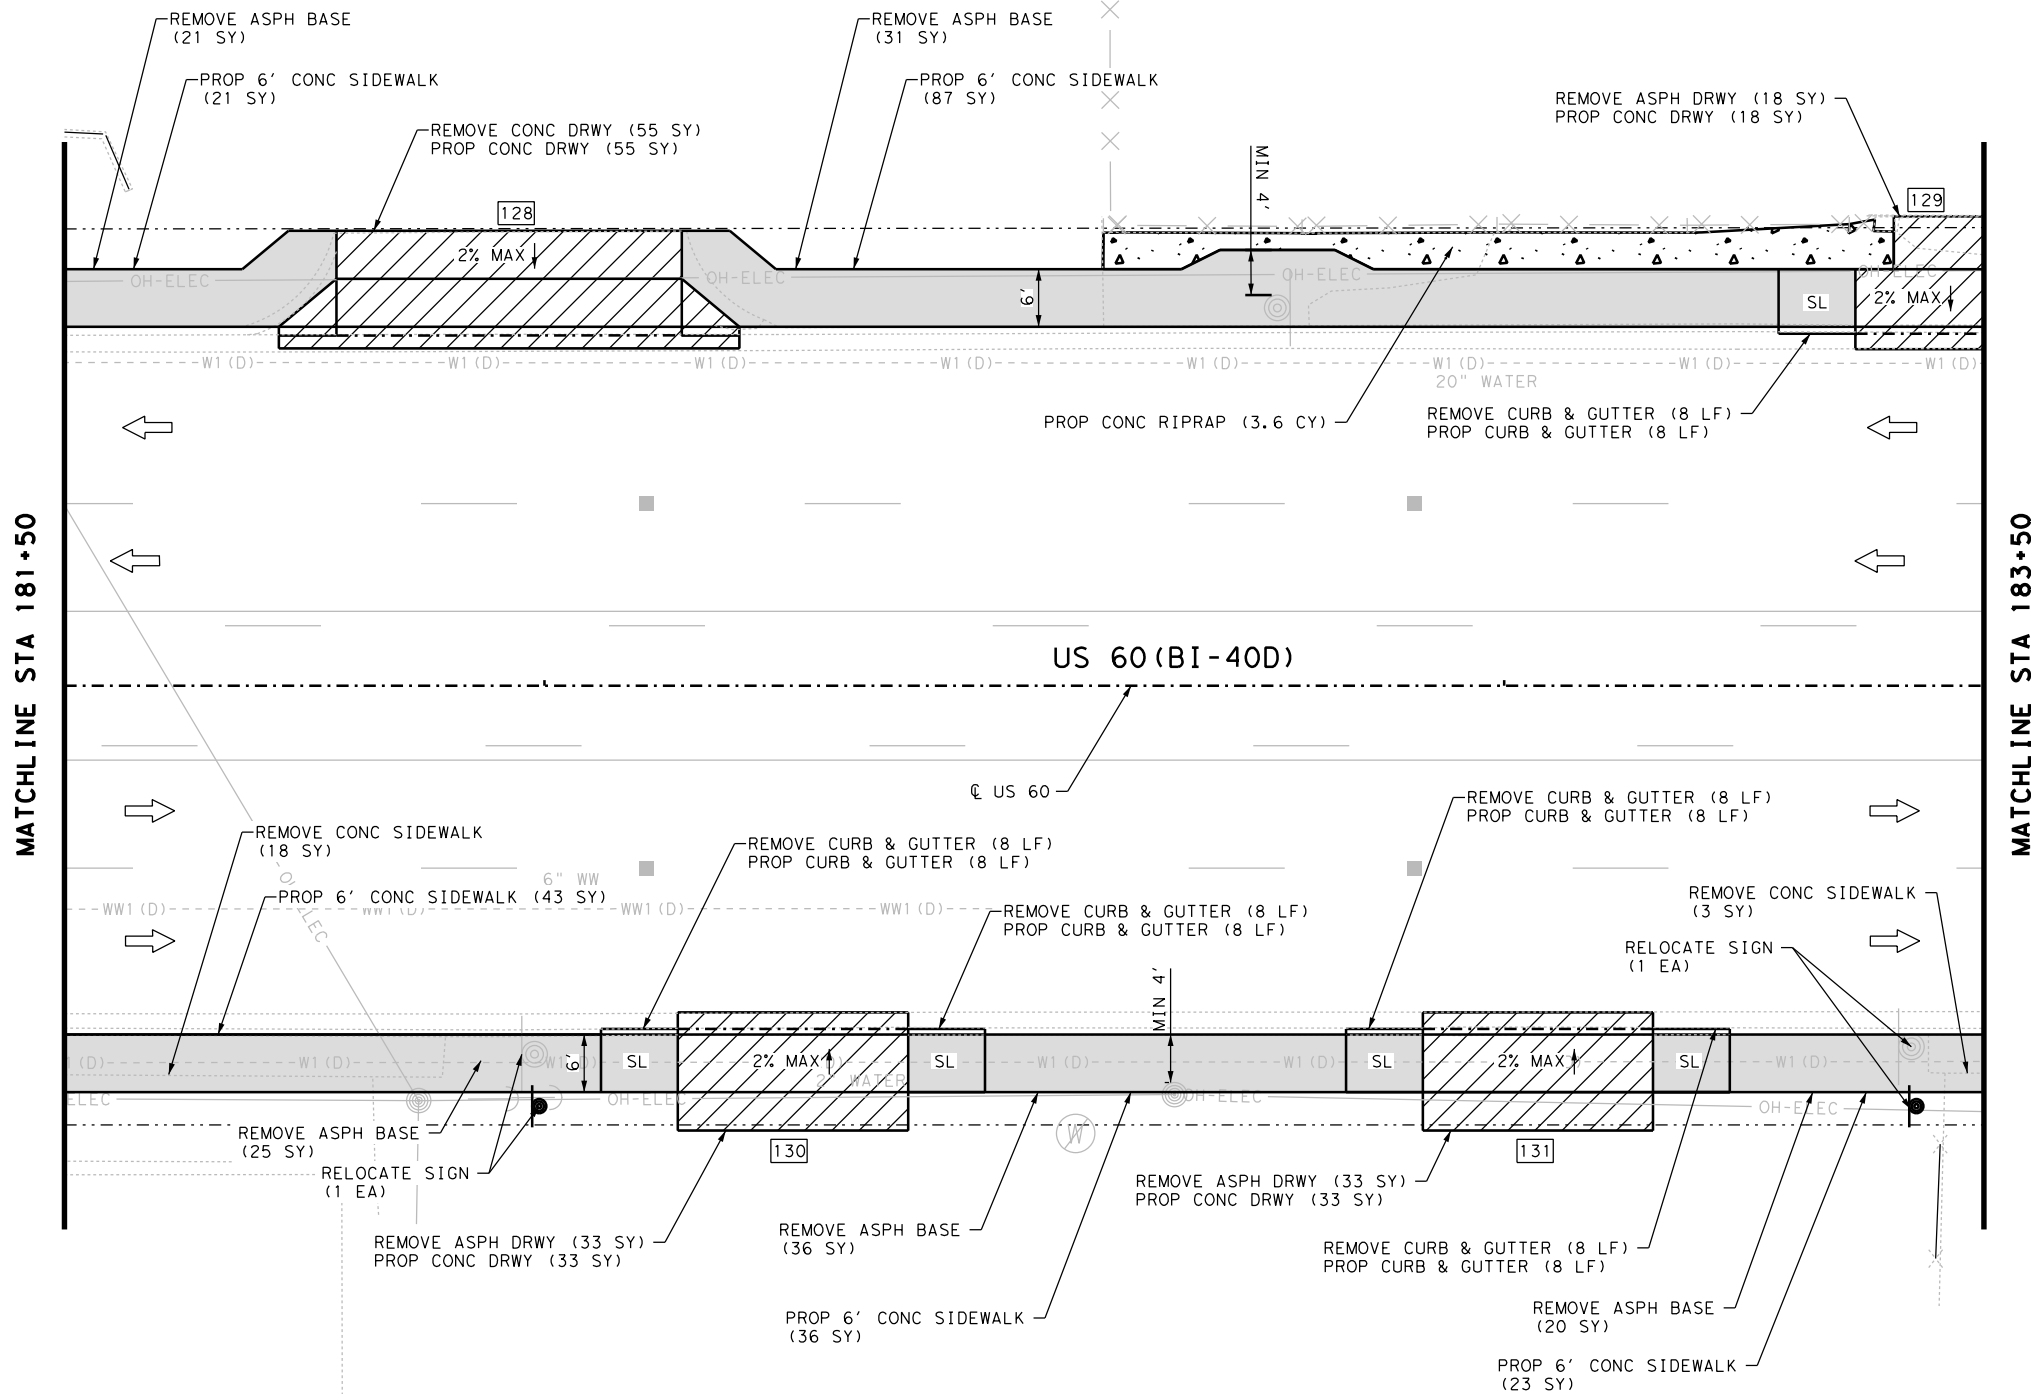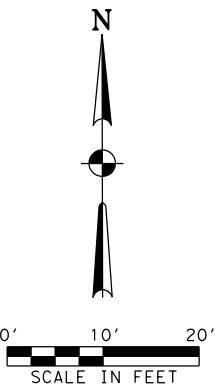

NOTES:
 * FOR CONTRACTOR INFORMATION ONLY
 1. THE EXISTENCE AND LOCATION OF ALL UTILITIES AND DRAINAGE STRUCTURES INDICATED IN THE PLANS ARE TAKEN FROM THE BEST RECORDS AVAILABLE AND ARE NOT GUARANTEED TO BE ACCURATE. CONTRACTOR SHALL COORDINATE WITH ALL UTILITY COMPANIES TO FIELD VERIFY UTILITIES PRIOR TO BEGINNING CONSTRUCTION.

NO.	DATE	REVISION	BY



GLOBAL CIVIL SOLUTIONS, LLC
 11551 FOREST CENTRAL DRIVE
 SUITE 220
 DALLAS, TX 75243
 F-12801



US 60 (BI 40-D)
SIDEWALK PLAN

STA 181+50 TO STA 183+50

SHEET 36 OF 44



DESIGN	FED. RD. DIV. NO.	FEDERAL AID PROJECT NO.	HIGHWAY NO.
MI	6	(SEE TITLE SHEET)	VARIOUS
GRAPHICS	STATE	DISTRICT	COUNTY
PS	TEXAS	AMA	POTTER
CHECK	CONTROL	SECTION	JOB
MF			
CHECK	CONTROL	SECTION	JOB
FS	0904	02	047

064

LEGEND			
	PROP SODDING	R	RAMP
	PROP CONC DRWY	L	LANDING PAD
	PROP CONC RIPRAP	F	FLARE
	PROP RETAINING WALL	SL	LONG. SLOPE MAY NOT EXCEED 5% OR ADJACENT ROAD SLOPE
	PROP CONC SIDEWALK	T	TRANSITION
	EXISTING SIDEWALK/DRWY TO REMAIN	LS	LEVEL SIDEWALK (2% MAX)
	TRAFFIC FLOW	←	TRAFFIC FLOW
	EXISTING SIGN	⊙	EXISTING SIGN
	PROPOSED SIGN	⊙	PROPOSED SIGN
	MANHOLE	⊙	MANHOLE
	POWER POLE	⊙	POWER POLE
	TRAFFIC SIGNAL POLE	⊙	TRAFFIC SIGNAL POLE
	LIGHT POLE	⊙	LIGHT POLE
	WATER METER	⊙	WATER METER
	FIRE HYDRANT	⊙	FIRE HYDRANT
	GUY WIRE	—	GUY WIRE
	TREE/SHRUB	—	TREE/SHRUB
	FENCE	—x—x—	FENCE
	WATER VALVE	⊙	WATER VALVE
	TRAFFIC SIGNAL BOX	⊙	TRAFFIC SIGNAL BOX
	IRRIGATION CONTROL VALVE	⊙	IRRIGATION CONTROL VALVE
	ELECTRICAL PULL BOX	⊙	ELECTRICAL PULL BOX
	DRIVEWAY ID	⊙	DRIVEWAY ID
	PEDESTRIAN SIGNAL	⊙	PEDESTRIAN SIGNAL
	GAS METER	⊙	GAS METER
	SPRINKLER HEAD	⊙	SPRINKLER HEAD
	UTILITY MARKER POST	⊙	UTILITY MARKER POST
	OVERHEAD ELECTRIC LINE	—OP—	OVERHEAD ELECTRIC LINE

ITEM	DESCRIPTION	UNIT	QTY
0104 6015	REMOVING CONC (SIDEWALKS)	SY	21
0104 6017	REMOVING CONC (DRIVEWAYS)	SY	55
0104 6029	REMOVING CONC (CURB OR CURB & GUTTER)	LF	40
0105 6070	REMOVING STAB BASE & ASPH PAV (6" - 8")	SY	217
0432 6001	RIPRAP (CONC) (4 IN)	CY	3.6
0529 6008	CONC CURB & GUTTER (TY II)	LF	40
0530 6004	DRIVEWAYS (CONC)	SY	139
0531 6001	CONC SIDEWALK (4")	SY	210
0644 6068	RELOCATE SM RD SN SUP&M TY 10BWG	EA	2

P:\Jobs\202007-Pedestrian\TXDOT\Amor\1110\CA00\VP3\SHEETS\047_AM_US_60_S1360F44.dgn
 5:18:51 PM
 1/27/2022

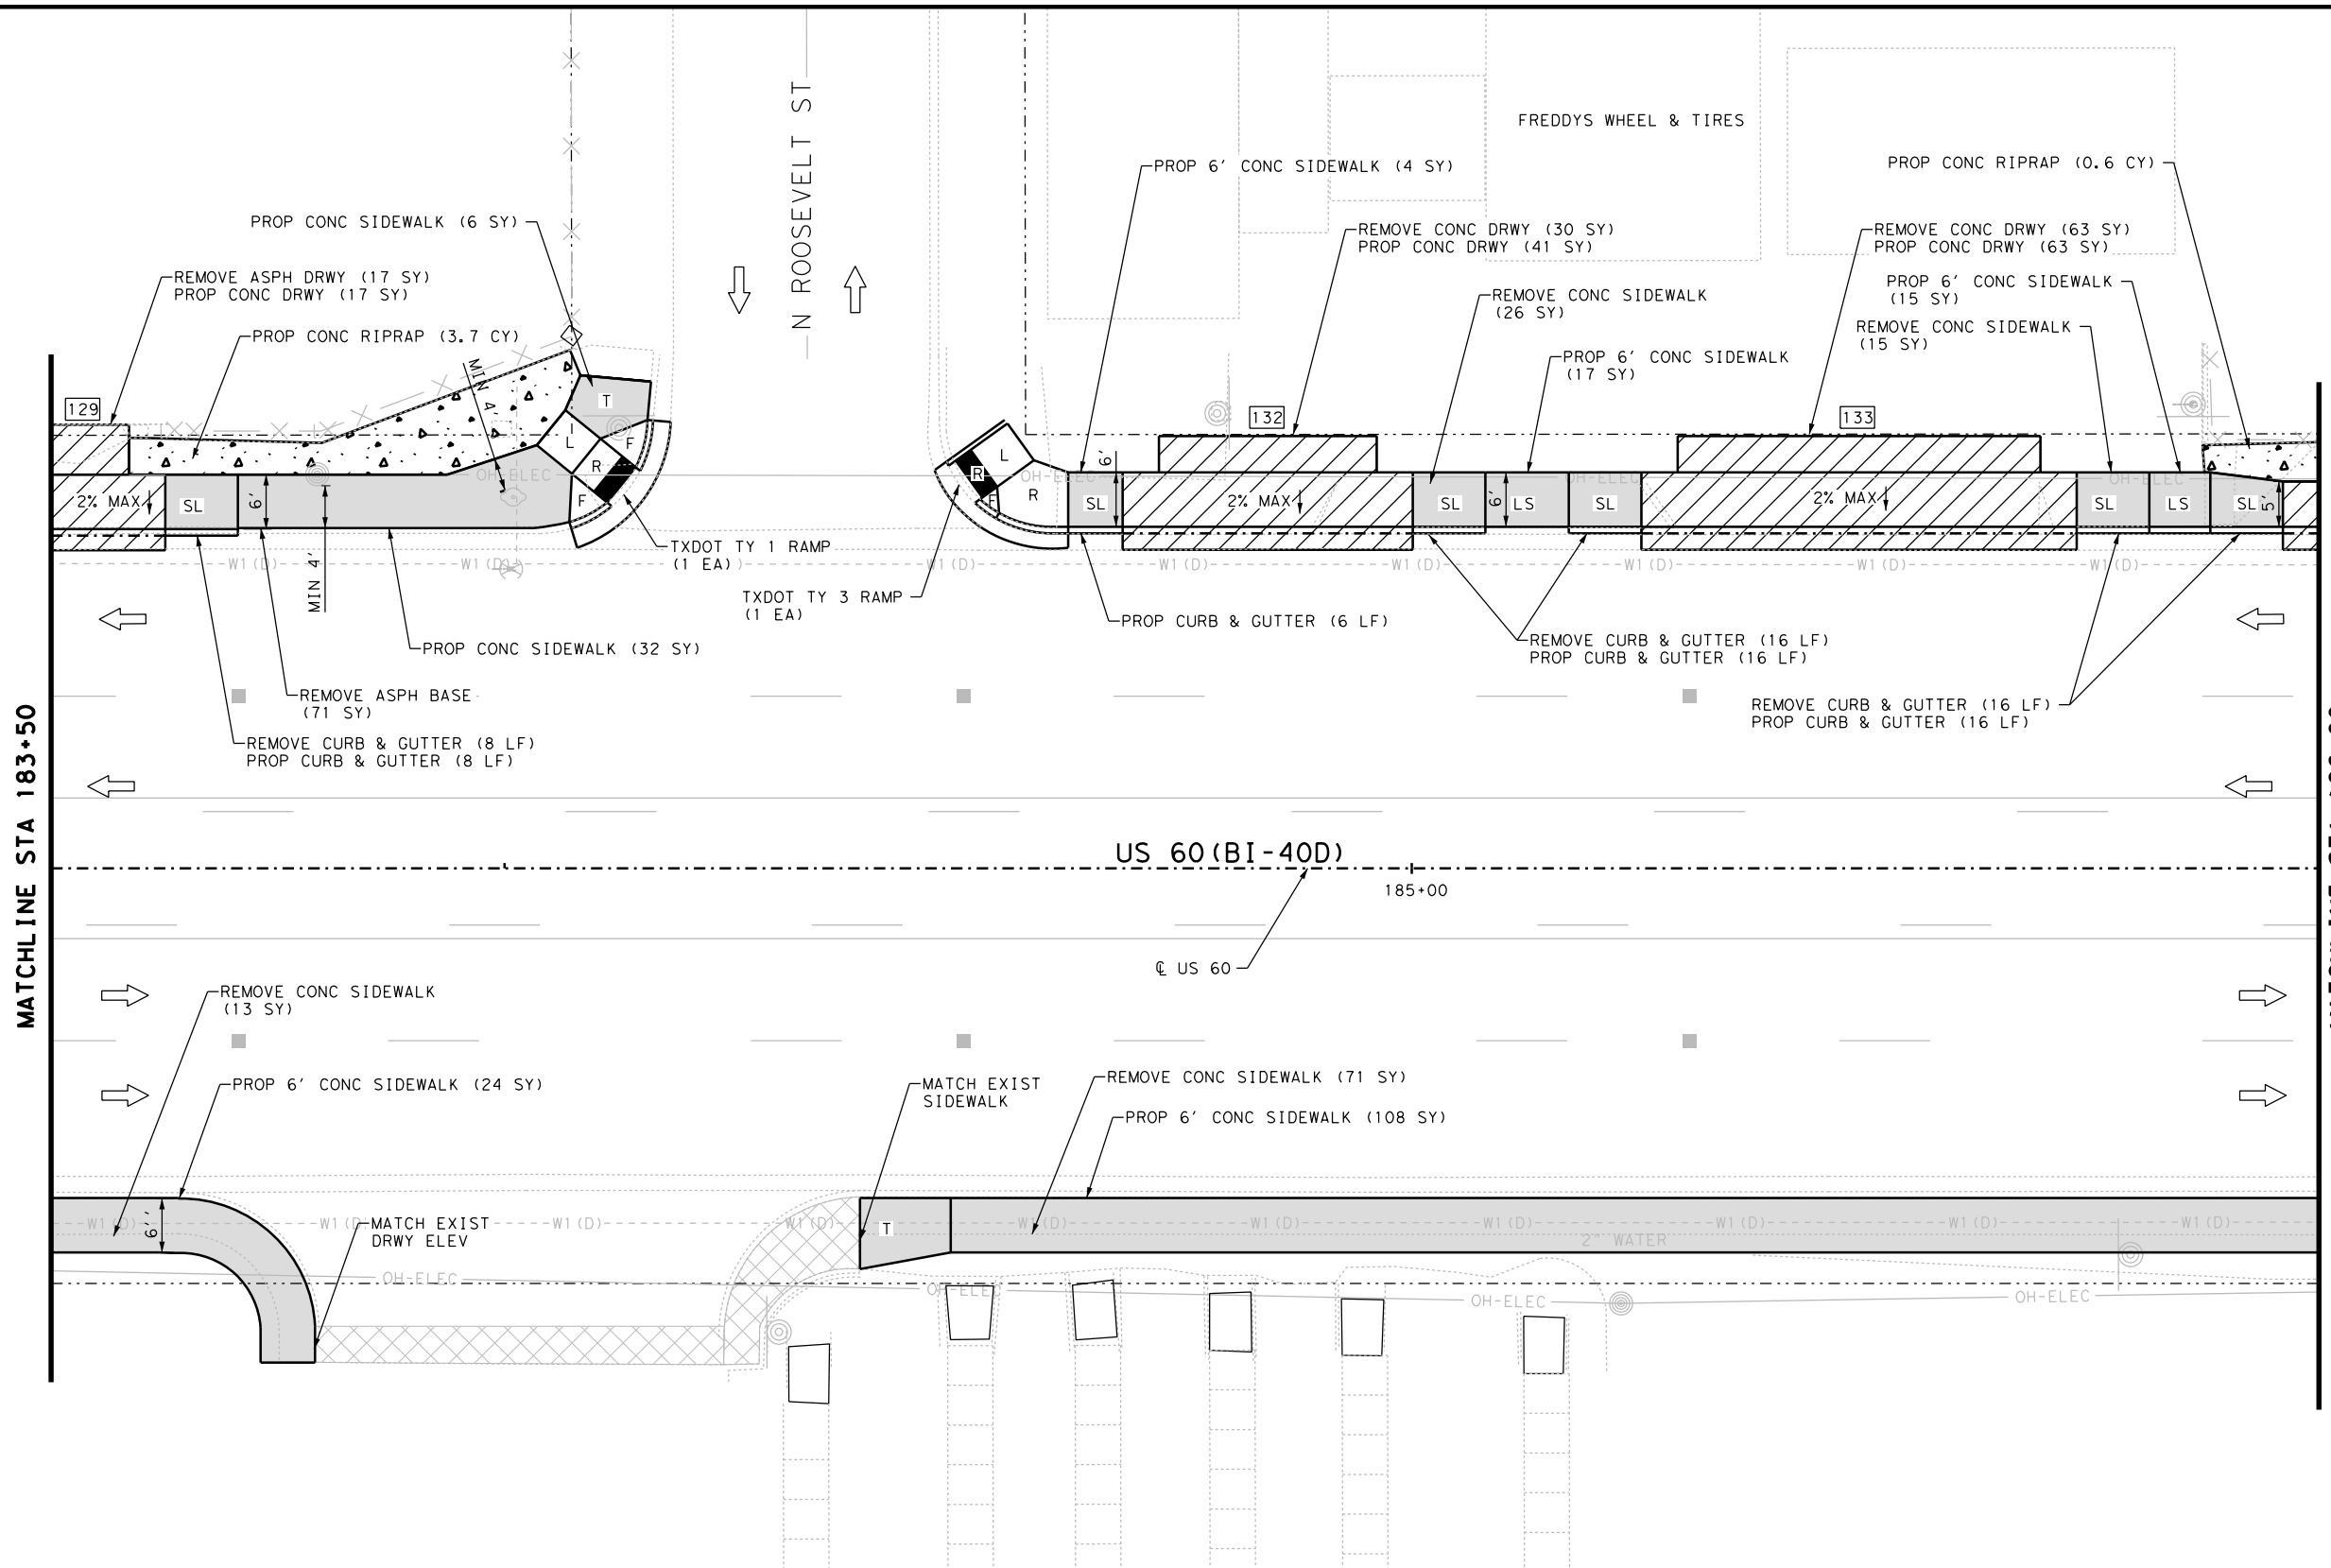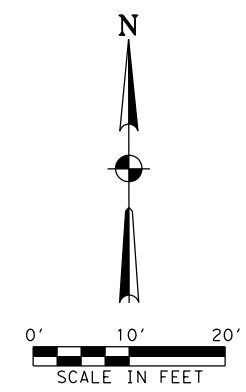

NOTES:
 * FOR CONTRACTOR INFORMATION ONLY
 1. THE EXISTENCE AND LOCATION OF ALL UTILITIES AND DRAINAGE STRUCTURES INDICATED IN THE PLANS ARE TAKEN FROM THE BEST RECORDS AVAILABLE AND ARE NOT GUARANTEED TO BE ACCURATE. CONTRACTOR SHALL COORDINATE WITH ALL UTILITY COMPANIES TO FIELD VERIFY UTILITIES PRIOR TO BEGINNING CONSTRUCTION.

NO.	DATE	REVISION	BY



GLOBAL CIVIL SOLUTIONS, LLC
 11551 FOREST CENTRAL DRIVE
 SUITE 220
 DALLAS, TX 75243
 F-12801



**US 60 (BI 40-D)
 SIDEWALK PLAN**

STA 183+50 TO STA 186+00



SHEET 37 OF 44

DESIGN MI	FED. RD. DIV. NO. 6	FEDERAL AID PROJECT NO. (SEE TITLE SHEET)	HIGHWAY NO. VARIOUS
GRAPHICS PS	STATE TEXAS	DISTRICT AMA	COUNTY POTTER
CHECK MF	CONTROL 0904	SECTION 02	JOB 047
CHECK FS			SHEET NO. 065

LEGEND			
	PROP SODDING		POWER POLE
	PROP CONC DRWY		TRAFFIC SIGNAL POLE
	PROP CONC RIPRAP		LIGHT POLE
	PROP RETAINING WALL		WATER METER
	PROP CONC SIDEWALK		FIRE HYDRANT
	EXISTING SIDEWALK/DRWY TO REMAIN		GUY WIRE
	R RAMP		TREE/SHRUB
	L LANDING PAD		FENCE
	F FLARE		WATER VALVE
	SL LONG SLOPE MAY NOT EXCEED 5% OR ADJACENT ROAD SLOPE		TRAFFIC SIGNAL BOX
	T TRANSITION		IRRIGATION CONTROL VALVE
	LS LEVEL SIDEWALK (2% MAX)		ELECTRICAL PULL BOX
	TRAFFIC FLOW		DRIVEWAY ID
	EXISTING SIGN		PEDESTRIAN SIGNAL
	PROPOSED SIGN		GAS METER
	MANHOLE		SPRINKLER HEAD
			UTILITY MARKER POST
			OVERHEAD ELECTRIC LINE

ITEM	DESCRIPTION	UNIT	QTY
0104 6015	REMOVING CONC (SIDEWALKS)	SY	125
0104 6017	REMOVING CONC (DRIVEWAYS)	SY	93
0104 6029	REMOVING CONC (CURB OR CURB & GUTTER)	LF	40
0105 6070	REMOVING STAB BASE & ASPH PAV (6" - 8")	SY	88
0432 6001	RIPRAP (CONC) (4 IN)	CY	4.3
0529 6008	CONC CURB & GUTTER (TY II)	LF	46
0530 6004	DRIVEWAYS (CONC)	SY	121
0531 6001	CONC SIDEWALK (4")	SY	206
0531 6004	CURB RAMPS (TY 1)	EA	1
0531 6006	CURB RAMPS (TY 3)	EA	1

P:\Jobs\202007-Pedestrion TxDOT Amor\1110\CA00\PS3-SHEETS\047_AM_US_60_S1370F44.dgn
 5:18:57 PM
 1/27/2022

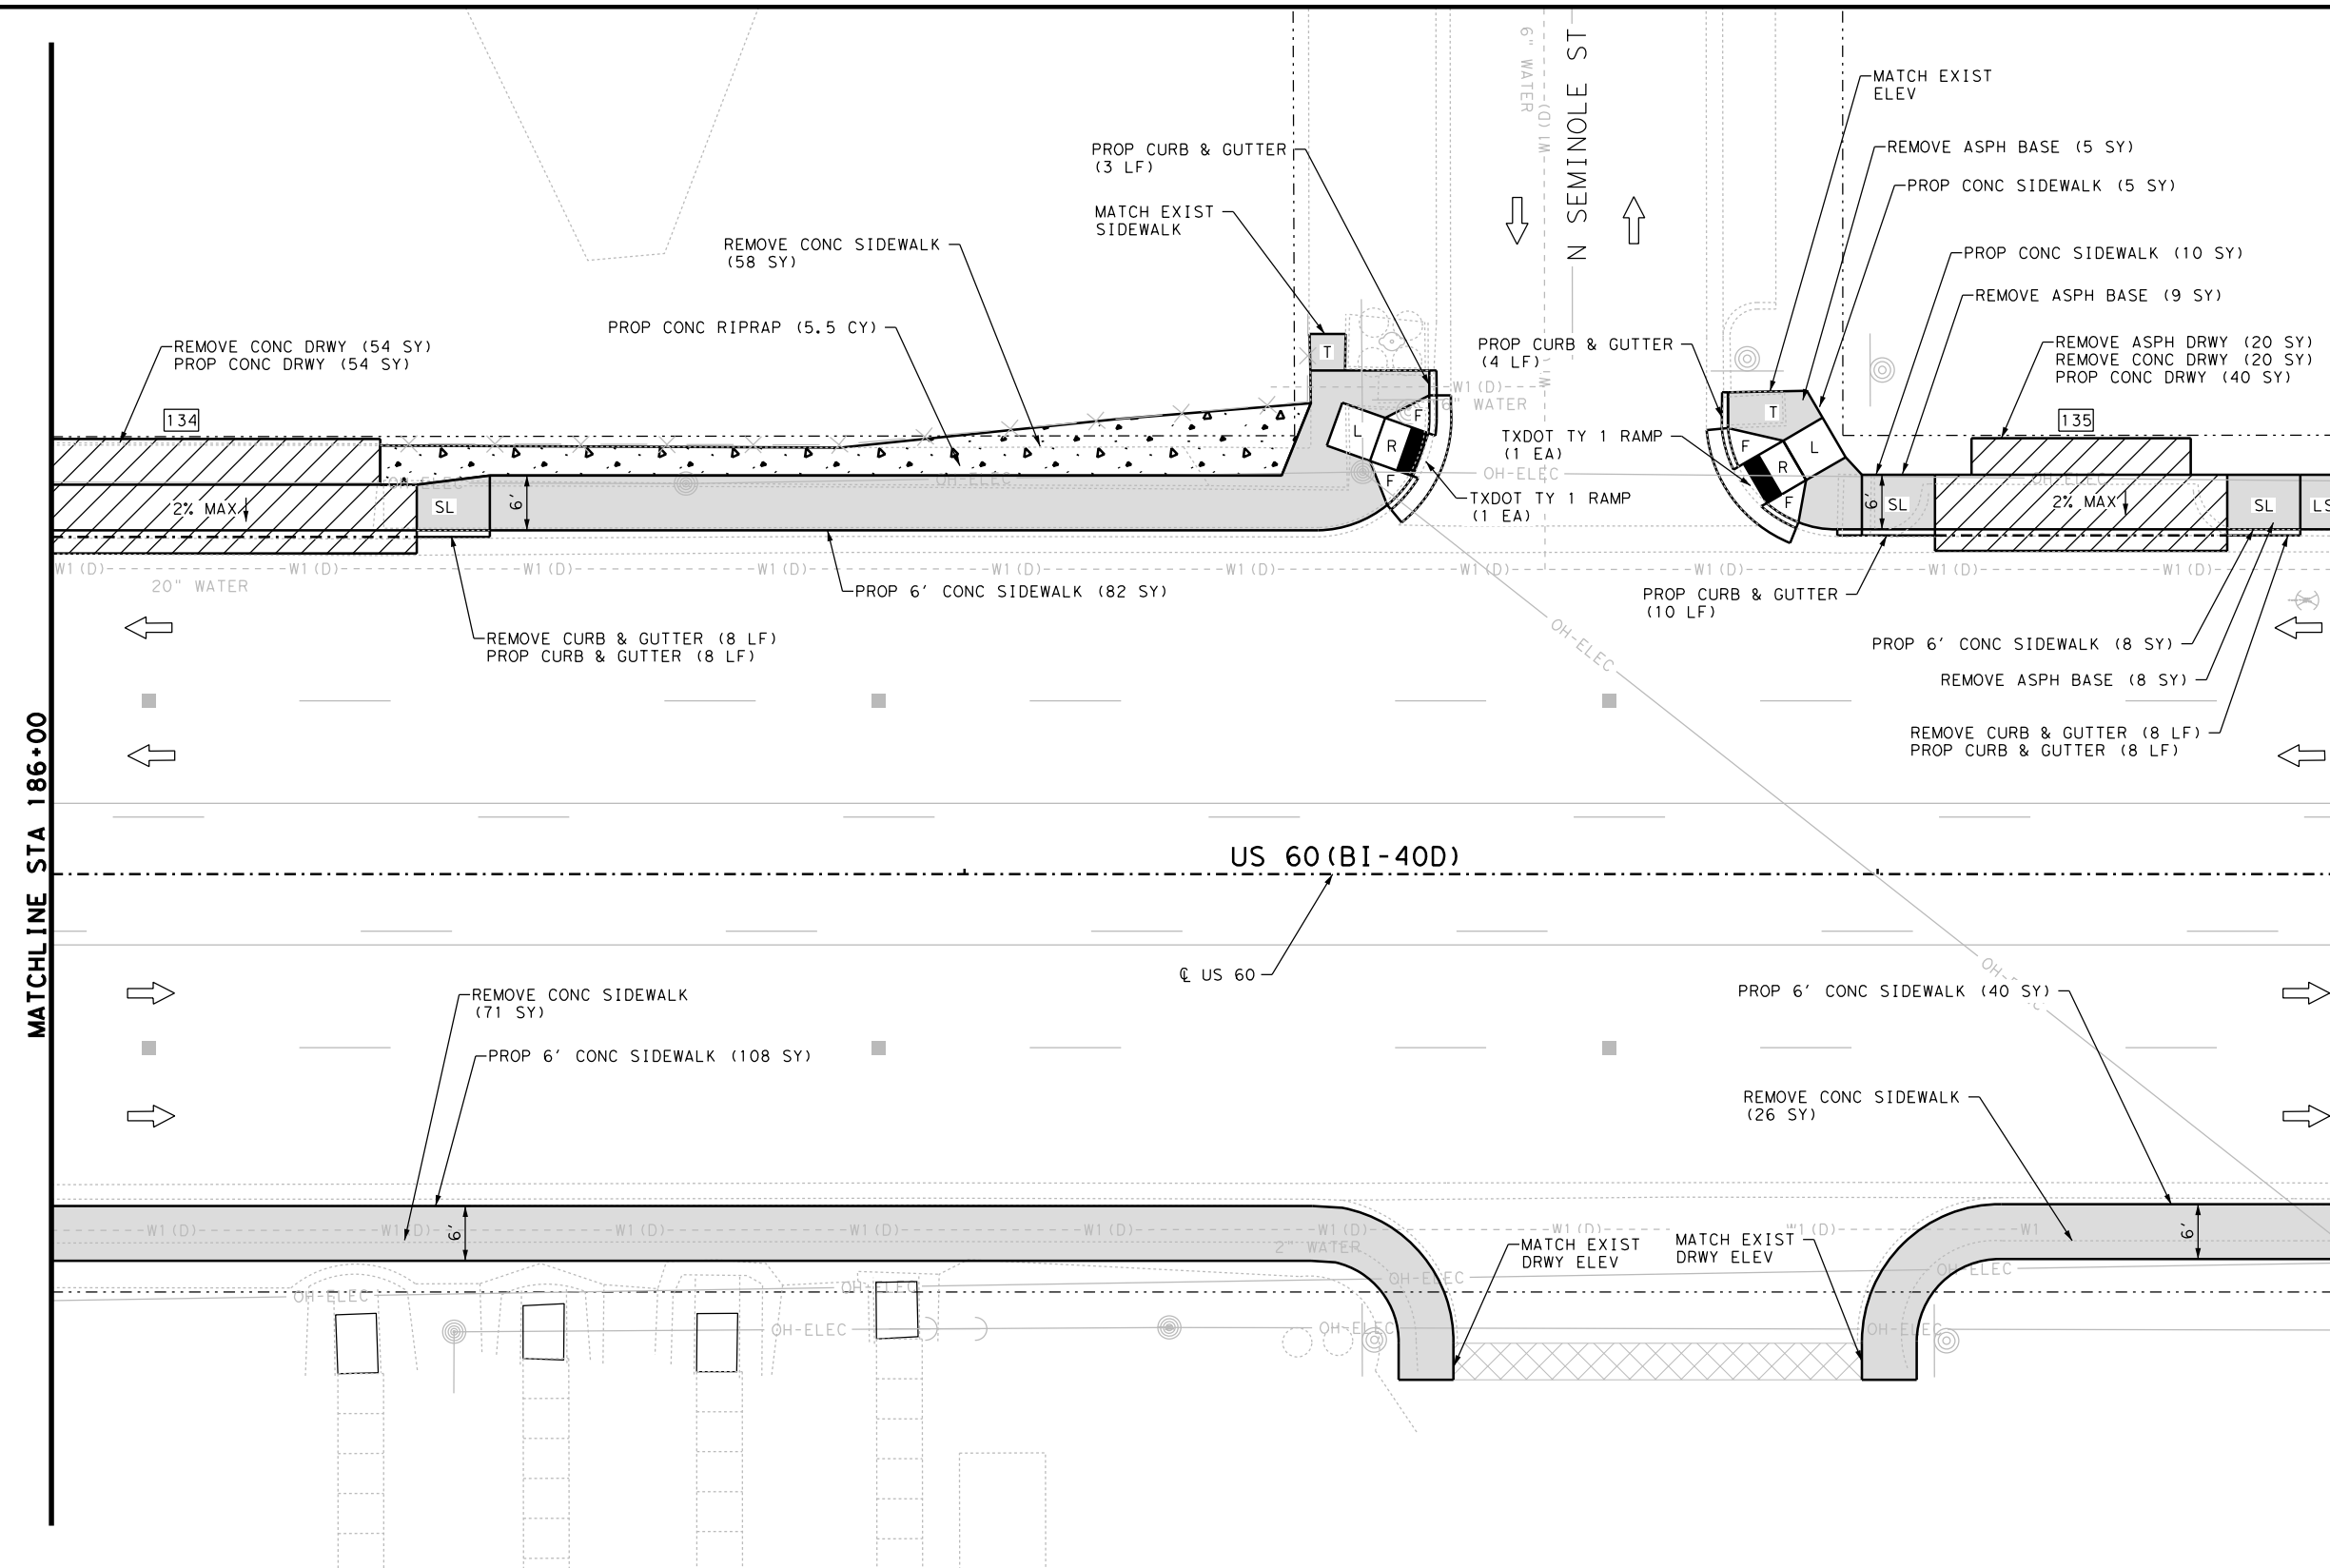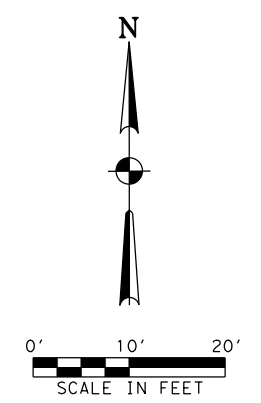


- NOTES:
- * FOR CONTRACTOR INFORMATION ONLY
 - 1. THE EXISTENCE AND LOCATION OF ALL UTILITIES AND DRAINAGE STRUCTURES INDICATED IN THE PLANS ARE TAKEN FROM THE BEST RECORDS AVAILABLE AND ARE NOT GUARANTEED TO BE ACCURATE. CONTRACTOR SHALL COORDINATE WITH ALL UTILITY COMPANIES TO FIELD VERIFY UTILITIES PRIOR TO BEGINNING CONSTRUCTION.

NO.	DATE	REVISION	BY



GLOBAL CIVIL SOLUTIONS, LLC
 1151 FOREST CENTRAL DRIVE
 SUITE 220
 DALLAS, TX 75243
 F-12801

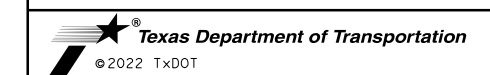

US 60 (BI 40-D)
SIDEWALK PLAN

STA 186+00 TO STA 188+50

SHEET 38 OF 44



DESIGN	FED. RD. DIV. NO.	FEDERAL AID PROJECT NO.	HIGHWAY NO.
MI	6	(SEE TITLE SHEET)	VARIOUS
GRAPHICS	STATE	DISTRICT	COUNTY
PS	TEXAS	AMA	POTTER
CHECK	CONTROL	SECTION	JOB
MFM			
CHECK	NO.	SHEET NO.	
FS	0904	02	047

066

P:\Jobs\202007-Pedestrian\TXDOT\Amor\1110\CA00\VP3\SHEETS\047_AM_US_60_S1380F44.dgn
 5:18:59 PM
 1/27/2022

LEGEND			
	PROP SODDING	R	RAMP
	PROP CONC DRWY	L	LANDING PAD
	PROP CONC RIPRAP	F	FLARE
	PROP RETAINING WALL	SL	LONG. SLOPE MAY NOT EXCEED 5% OR ADJACENT ROAD SLOPE
	PROP CONC SIDEWALK	T	TRANSITION
	EXISTING SIDEWALK/DRWY TO REMAIN	LS	LEVEL SIDEWALK (2% MAX)
	PROP SODDING	←	TRAFFIC FLOW
	PROP CONC DRWY	⊙	EXISTING SIGN
	PROP CONC RIPRAP	⊙	PROPOSED SIGN
	PROP RETAINING WALL	⊙	MANHOLE
	PROP CONC SIDEWALK	⊙	POWER POLE
	EXISTING SIDEWALK/DRWY TO REMAIN	⊙	TRAFFIC SIGNAL POLE
	PROP SODDING	⊙	LIGHT POLE
	PROP CONC DRWY	⊙	WATER METER
	PROP CONC RIPRAP	⊙	FIRE HYDRANT
	PROP RETAINING WALL	⊙	GUY WIRE
	PROP CONC SIDEWALK	⊙	TREE/SHRUB
	EXISTING SIDEWALK/DRWY TO REMAIN	⊙	FENCE
	PROP SODDING	⊙	WATER VALVE
	PROP CONC DRWY	⊙	TRAFFIC SIGNAL BOX
	PROP CONC RIPRAP	⊙	IRRIGATION CONTROL VALVE
	PROP RETAINING WALL	⊙	ELECTRICAL PULL BOX
	PROP CONC SIDEWALK	⊙	DRIVEWAY ID
	EXISTING SIDEWALK/DRWY TO REMAIN	⊙	PEDESTRIAN SIGNAL
	PROP SODDING	⊙	GAS METER
	PROP CONC DRWY	⊙	SPRINKLER HEAD
	PROP CONC RIPRAP	⊙	UTILITY MARKER POST
	PROP RETAINING WALL	⊙	OVERHEAD ELECTRIC LINE

ITEM	DESCRIPTION	UNIT	QTY
0104 6015	REMOVING CONC (SIDEWALKS)	SY	155
0104 6017	REMOVING CONC (DRIVEWAYS)	SY	74
0104 6029	REMOVING CONC (CURB OR CURB & GUTTER)	LF	16
0105 6070	REMOVING STAB BASE & ASPH PAV (6" - 8")	SY	42
0432 6001	RIPRAP (CONC) (4 IN)	CY	5.5
0529 6008	CONC CURB & GUTTER (TY II)	LF	33
0530 6004	DRIVEWAYS (CONC)	SY	94
0531 6001	CONC SIDEWALK (4")	SY	253
0531 6004	CURB RAMPS (TY 1)	EA	2

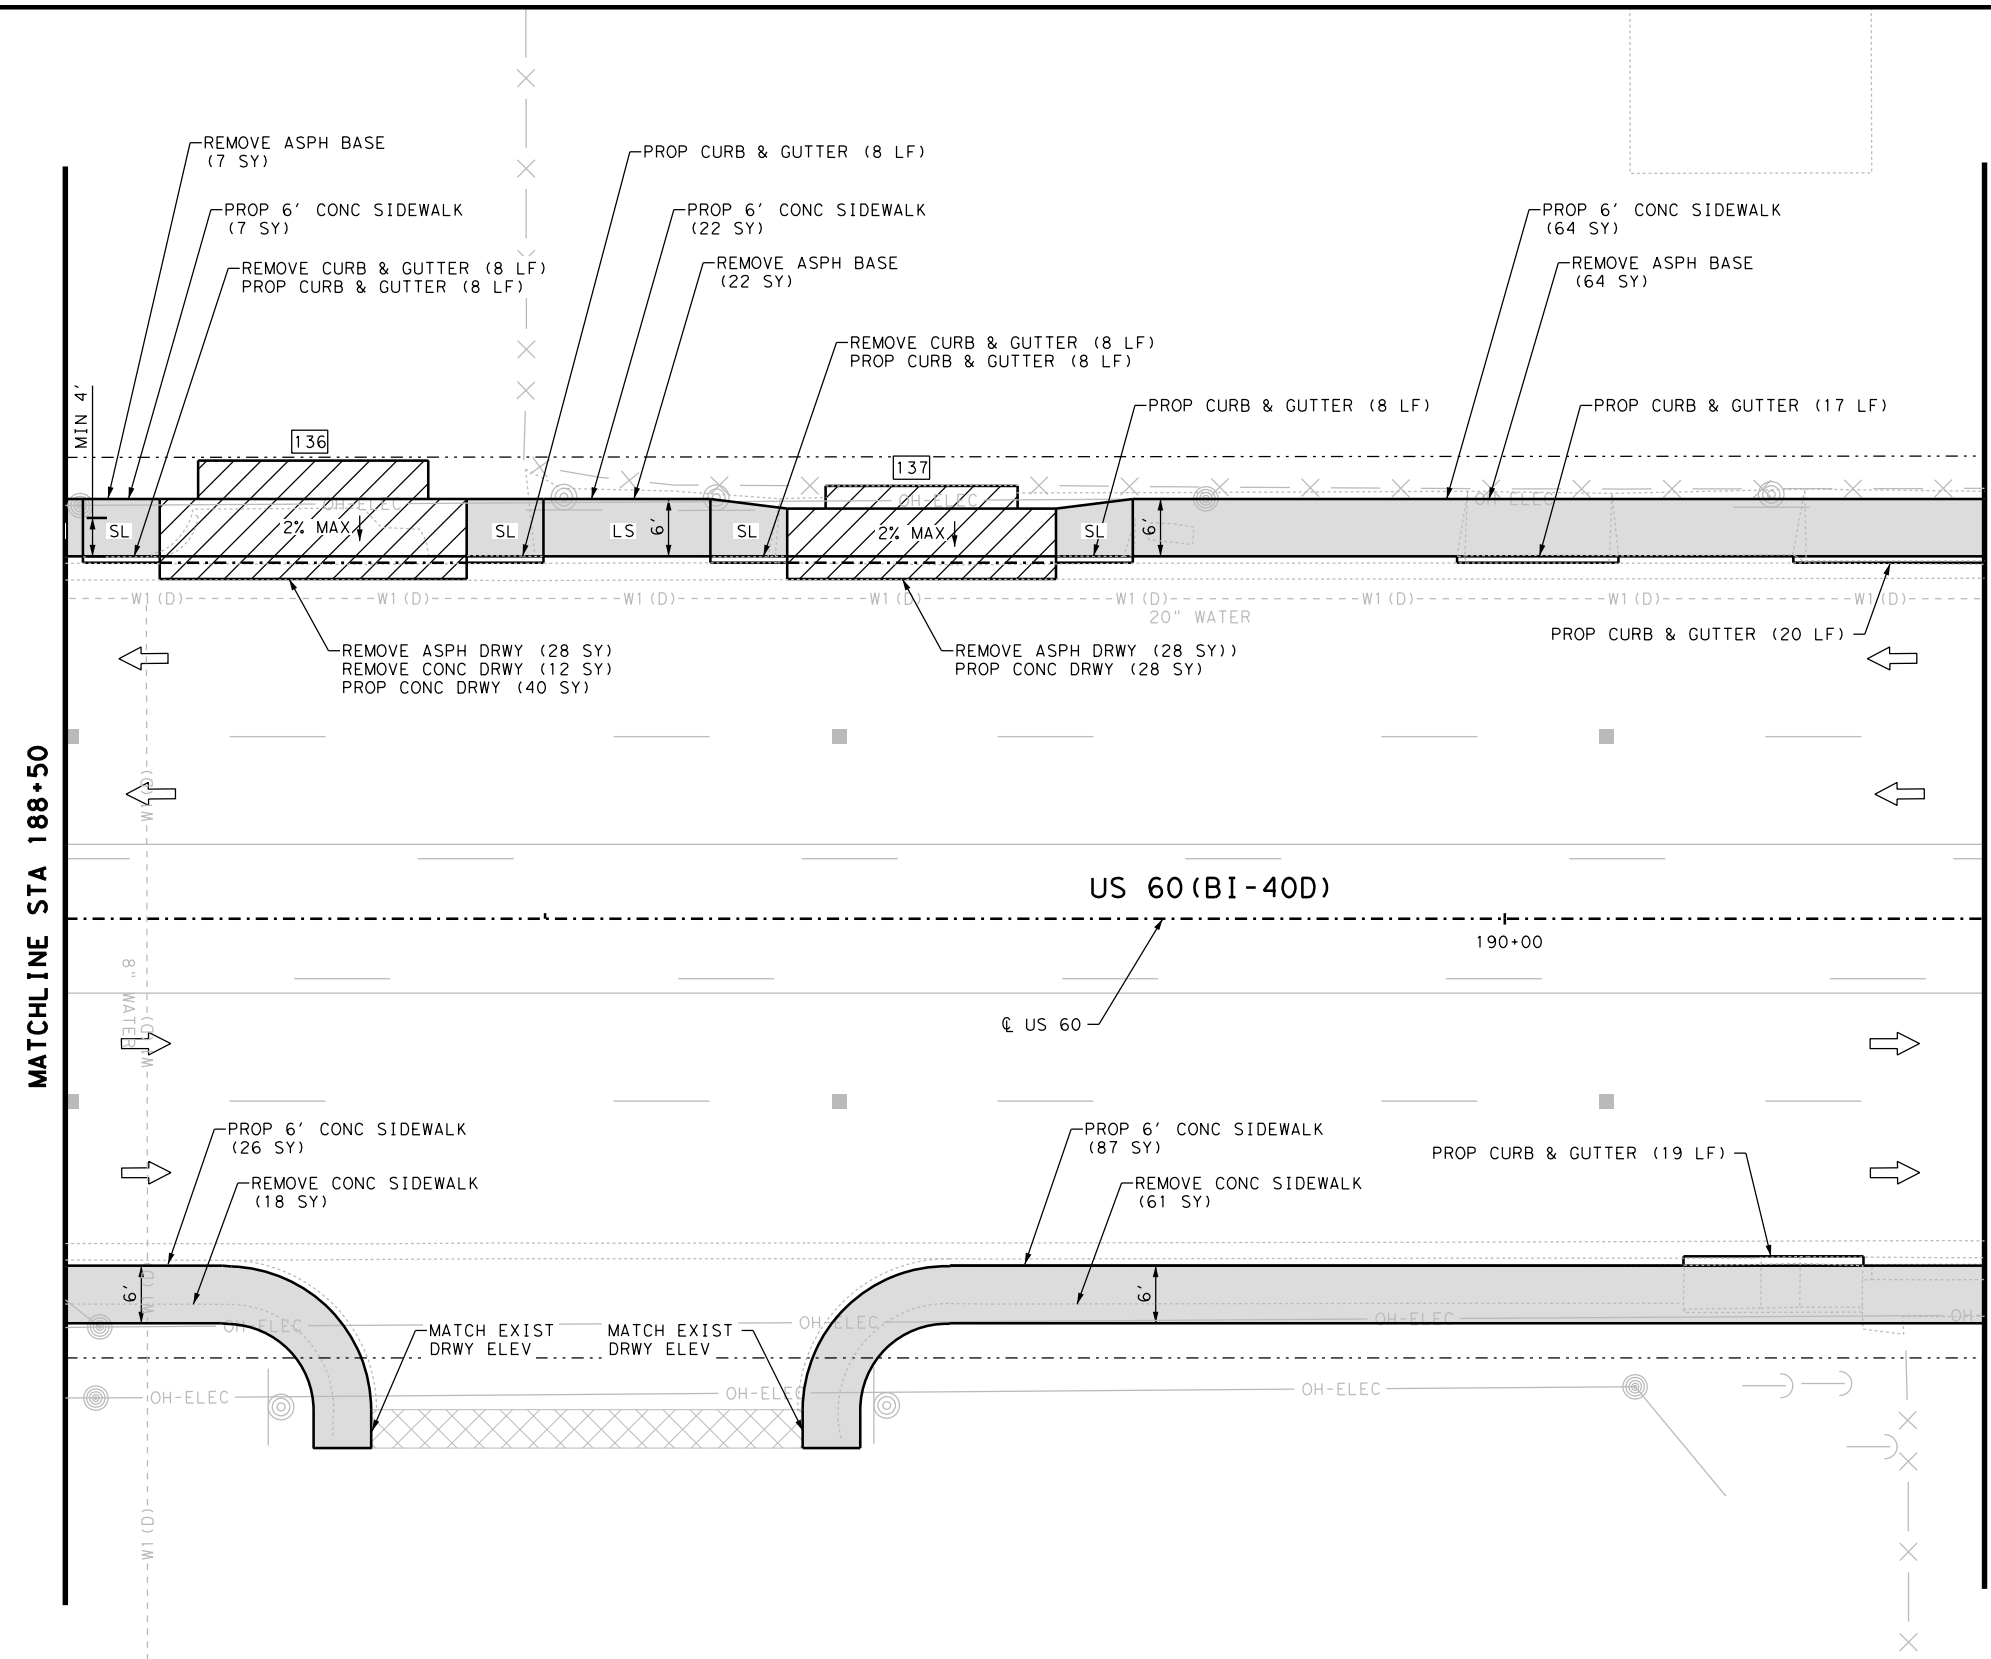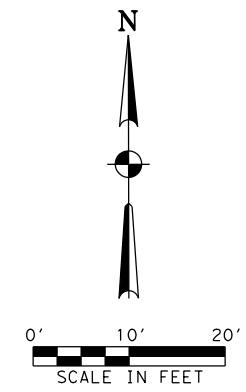

NOTES:
 * FOR CONTRACTOR INFORMATION ONLY
 1. THE EXISTENCE AND LOCATION OF ALL UTILITIES AND DRAINAGE STRUCTURES INDICATED IN THE PLANS ARE TAKEN FROM THE BEST RECORDS AVAILABLE AND ARE NOT GUARANTEED TO BE ACCURATE. CONTRACTOR SHALL COORDINATE WITH ALL UTILITY COMPANIES TO FIELD VERIFY UTILITIES PRIOR TO BEGINNING CONSTRUCTION.

NO.	DATE	REVISION	BY



GLOBAL CIVIL SOLUTIONS, LLC
 11551 FOREST CENTRAL DRIVE
 SUITE 220
 DALLAS, TX 75243
 F-12801



**US 60 (BI 40-D)
 SIDEWALK PLAN**

STA 188+50 TO STA 190+50

SHEET 39 OF 44



DESIGN	FED. RD. DIV. NO.	FEDERAL AID PROJECT NO.	HIGHWAY NO.
MI	6	(SEE TITLE SHEET)	VARIOUS
GRAPHICS	STATE	DISTRICT	COUNTY
PS	TEXAS	AMA	POTTER
CHECK	CONTROL	SECTION	JOB
MF			
CHECK	CONTROL	SECTION	JOB
FS	0904	02	047

067

LEGEND			
	PROP SODDING	R	RAMP
	PROP CONC DRWY	L	LANDING PAD
	PROP CONC RIPRAP	F	FLARE
	PROP RETAINING WALL	SL	LONG. SLOPE MAY NOT EXCEED 5% OR ADJACENT ROAD SLOPE
	PROP CONC SIDEWALK	T	TRANSITION
	EXISTING SIDEWALK/DRWY TO REMAIN	LS	LEVEL SIDEWALK (2% MAX)
			TRAFFIC FLOW
			EXISTING SIGN
			PROPOSED SIGN
			MANHOLE
	POWER POLE		TRAFFIC SIGNAL POLE
	LIGHT POLE		WATER METER
	FIRE HYDRANT		GUY WIRE
	TREE/SHRUB		FENCE
	WATER VALVE		TRAFFIC SIGNAL BOX
	IRRIGATION CONTROL VALVE		ELECTRICAL PULL BOX
	DRIVEWAY ID		PEDESTRIAN SIGNAL
	GAS METER		SPRINKLER HEAD
	UTILITY MARKER POST		OVERHEAD ELECTRIC LINE

ITEM	DESCRIPTION	UNIT	QTY
0104 6015	REMOVING CONC (SIDEWALKS)	SY	79
0104 6017	REMOVING CONC (DRIVEWAYS)	SY	12
0104 6029	REMOVING CONC (CURB OR CURB & GUTTER)	LF	16
0105 6070	REMOVING STAB BASE & ASPH PAV (6" - 8")	SY	149
0529 6008	CONC CURB & GUTTER (TY II)	LF	88
0530 6004	DRIVEWAYS (CONC)	SY	68
0531 6001	CONC SIDEWALK (4")	SY	206

P:\Jobs\202007-Pedestrian\1110-CA00-V3-SHEETS\047_AM_US_60_S1390F44.dgn
 5:19:00 PM
 1/27/2022

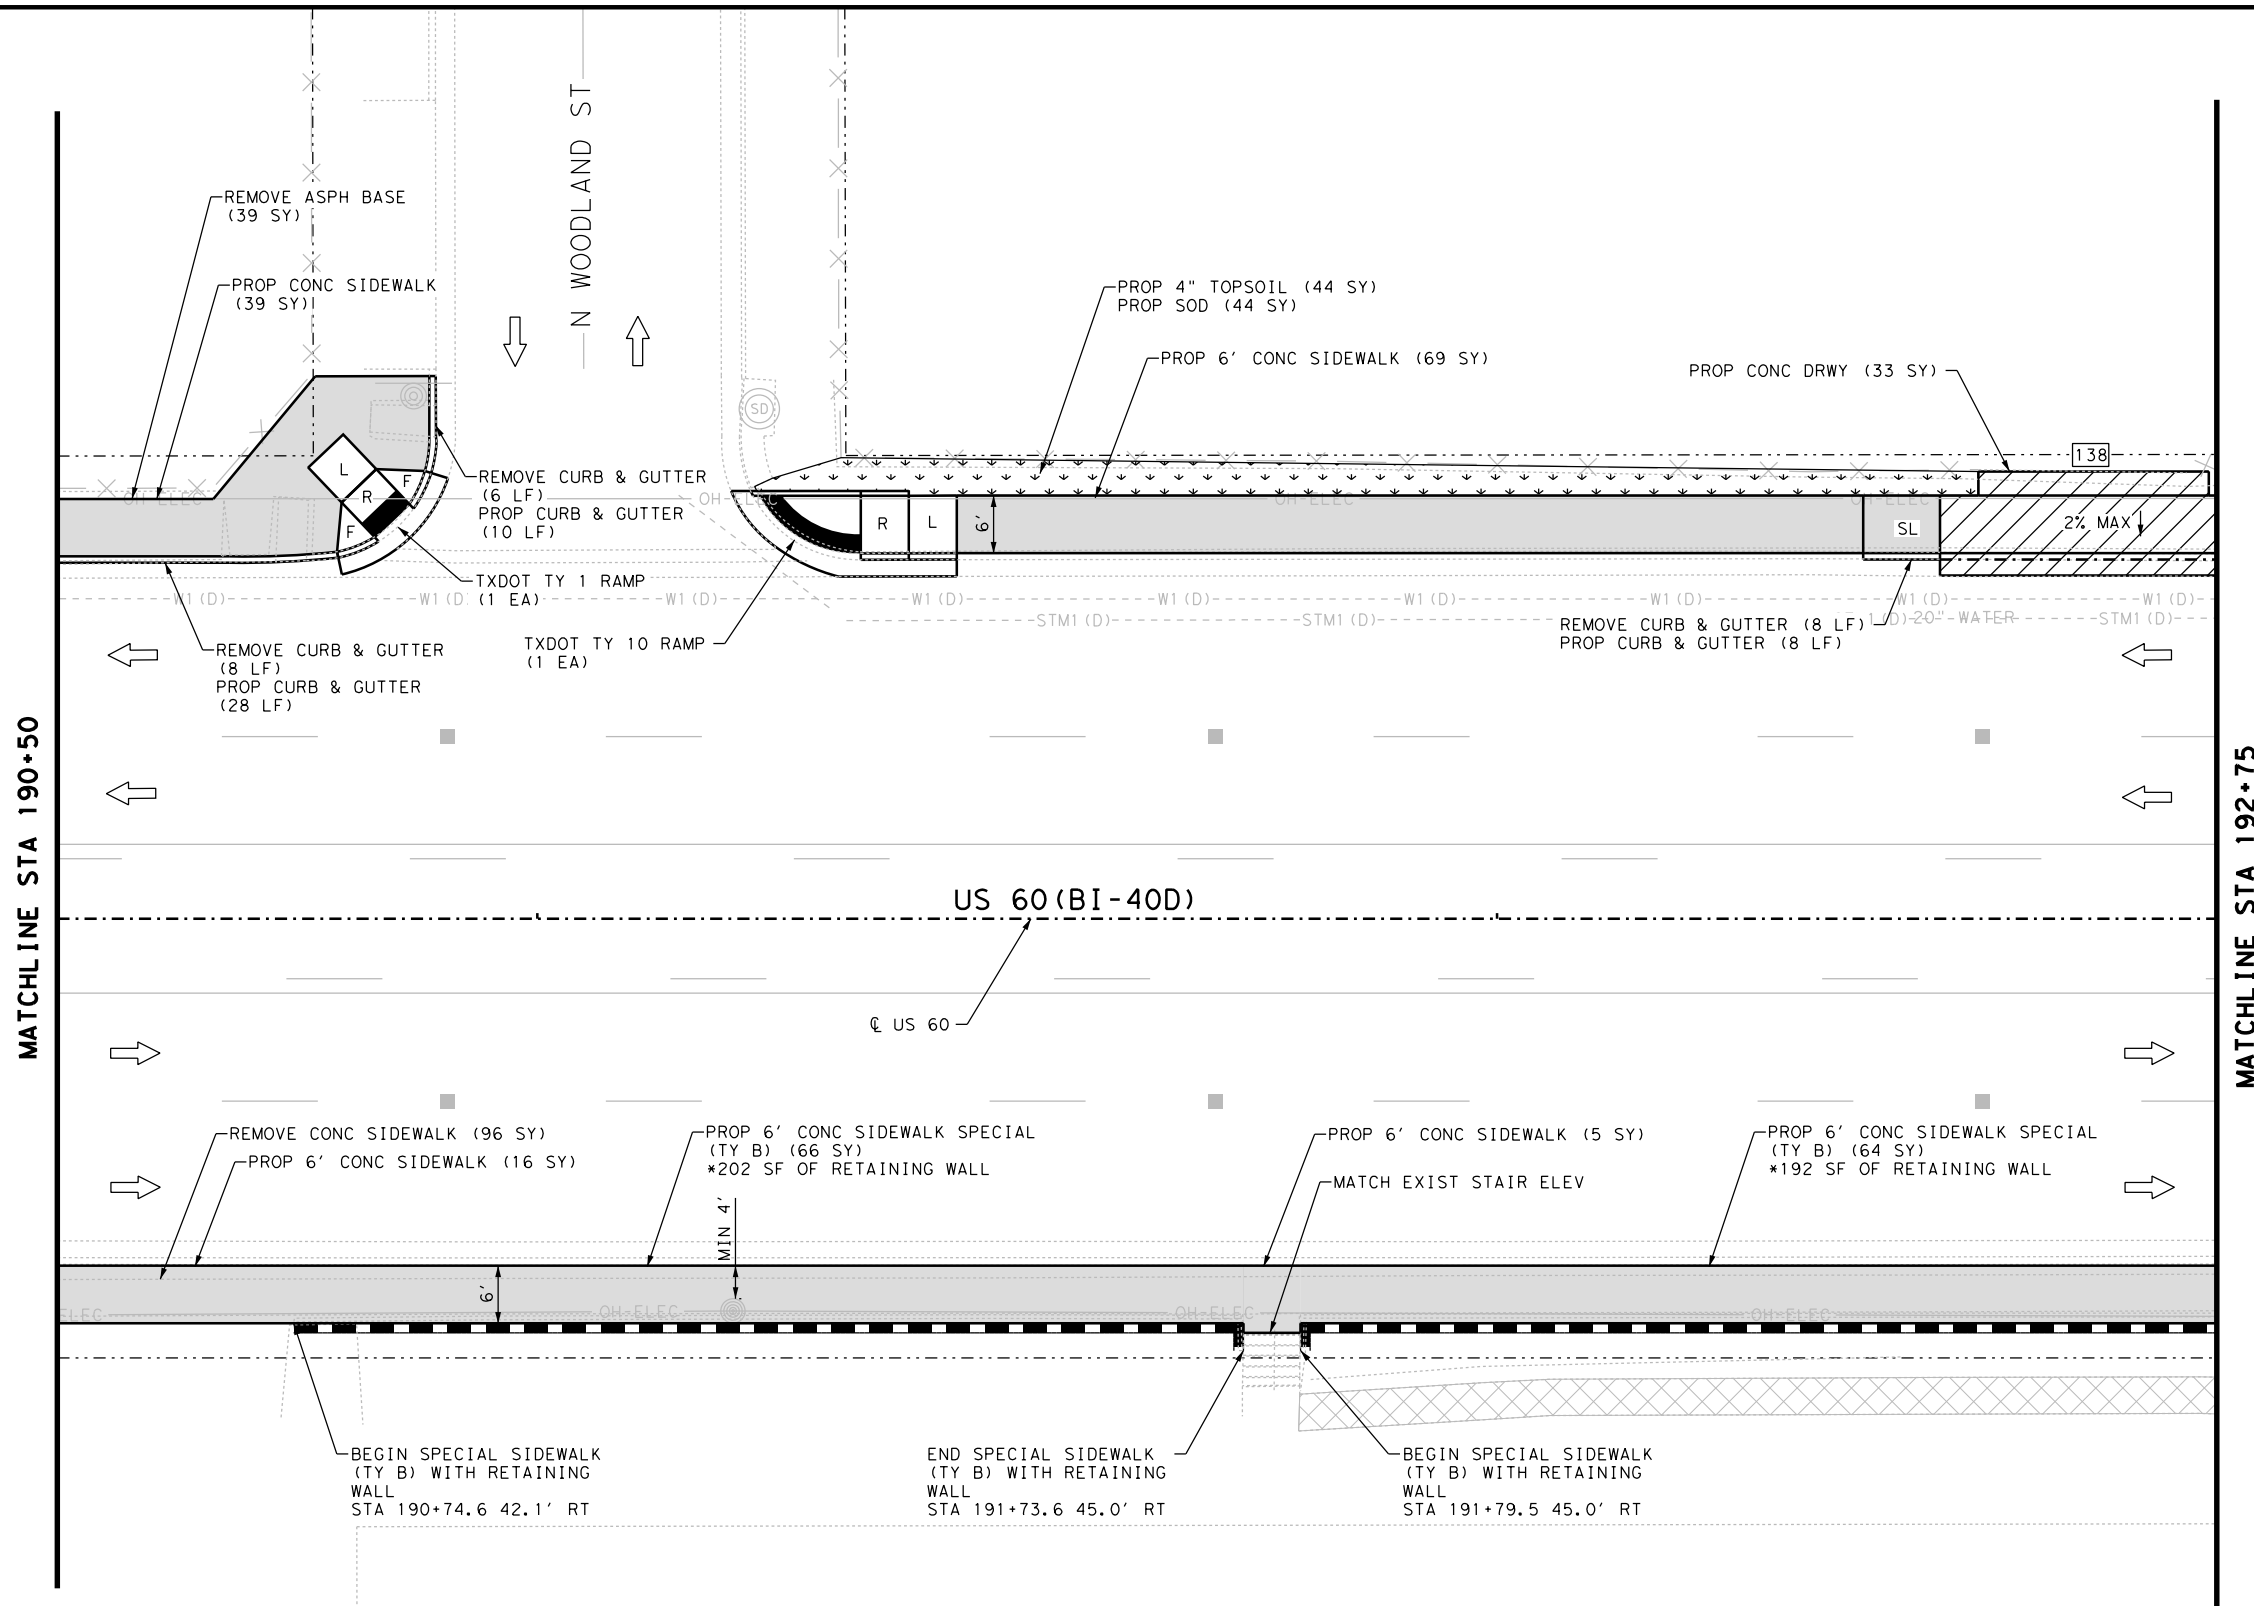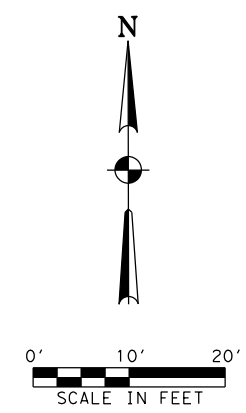

NOTES:
 * FOR CONTRACTOR INFORMATION ONLY
 1. THE EXISTENCE AND LOCATION OF ALL UTILITIES AND DRAINAGE STRUCTURES INDICATED IN THE PLANS ARE TAKEN FROM THE BEST RECORDS AVAILABLE AND ARE NOT GUARANTEED TO BE ACCURATE. CONTRACTOR SHALL COORDINATE WITH ALL UTILITY COMPANIES TO FIELD VERIFY UTILITIES PRIOR TO BEGINNING CONSTRUCTION.

NO.	DATE	REVISION	BY



GLOBAL CIVIL SOLUTIONS, LLC
 11551 FOREST CENTRAL DRIVE
 SUITE 220
 DALLAS, TX 75243
 F-12801



**US 60 (BI 40-D)
 SIDEWALK PLAN**

STA 190+50 TO STA 192+75

SHEET 40 OF 44

DESIGN	FED. RD. DIV. NO.	FEDERAL AID PROJECT NO.	HIGHWAY NO.
MI	6	(SEE TITLE SHEET)	VARIOUS
GRAPHICS	STATE	DISTRICT	COUNTY
PS	TEXAS	AMA	POTTER
CHECK	CONTROL	SECTION	JOB
MF			
CHECK	NO.	SHEET NO.	
FS	0904	02	047



068

LEGEND

- | | | | |
|----------------------------------|---|---------------------|--------------------------|
| PROP SODDING | R RAMP | POWER POLE | IRRIGATION CONTROL VALVE |
| PROP CONC DRWY | L LANDING PAD | TRAFFIC SIGNAL POLE | ELECTRICAL PULL BOX |
| PROP CONC RIPRAP | F FLARE | LIGHT POLE | DRIVELWAY ID |
| PROP RETAINING WALL | SL LONG. SLOPE MAY NOT EXCEED 5% OR ADJACENT ROAD SLOPE | WATER METER | PEDESTRIAN SIGNAL |
| PROP CONC SIDEWALK | T TRANSITION | FIRE HYDRANT | GAS METER |
| EXISTING SIDEWALK/DRWY TO REMAIN | LS LEVEL SIDEWALK (2% MAX) | GUY WIRE | SPRINKLER HEAD |
| | TRAFFIC FLOW | TREE/SHRUB | UTILITY MARKER POST |
| | EXISTING SIGN | FENCE | OVERHEAD ELECTRIC LINE |
| | PROPOSED SIGN | WATER VALVE | |
| | MANHOLE | TRAFFIC SIGNAL BOX | |

ITEM	DESCRIPTION	UNIT	QTY
0104 6015	REMOVING CONC (SIDEWALKS)	SY	96
0104 6029	REMOVING CONC (CURB OR CURB & GUTTER)	LF	22
0105 6070	REMOVING STAB BASE & ASPH PAV (6" - 8")	SY	39
0160 6003	FURNISHING AND PLACING TOP SOIL (4")	SY	44
0162 6002	BLOCK SODDING	SY	44
0168 6001	VEGETATIVE WATERING	MG	1.7
0529 6008	CONC CURB & GUTTER (TY II)	LF	46
0530 6004	DRIVEWAYS (CONC)	SY	33
0531 6001	CONC SIDEWALK (4")	SY	129
0531 6004	CURB RAMPS (TY 1)	EA	1
0531 6013	CURB RAMPS (TY 10)	EA	1
0531 6033		SY	130

P:\Jobs\2020007-Pedestrian\TXDOT\Amor\1110\CA00\VP3-SHEETS\047_AM_US_60_STA190+50.dgn
 5:19:02 PM 1/27/2022

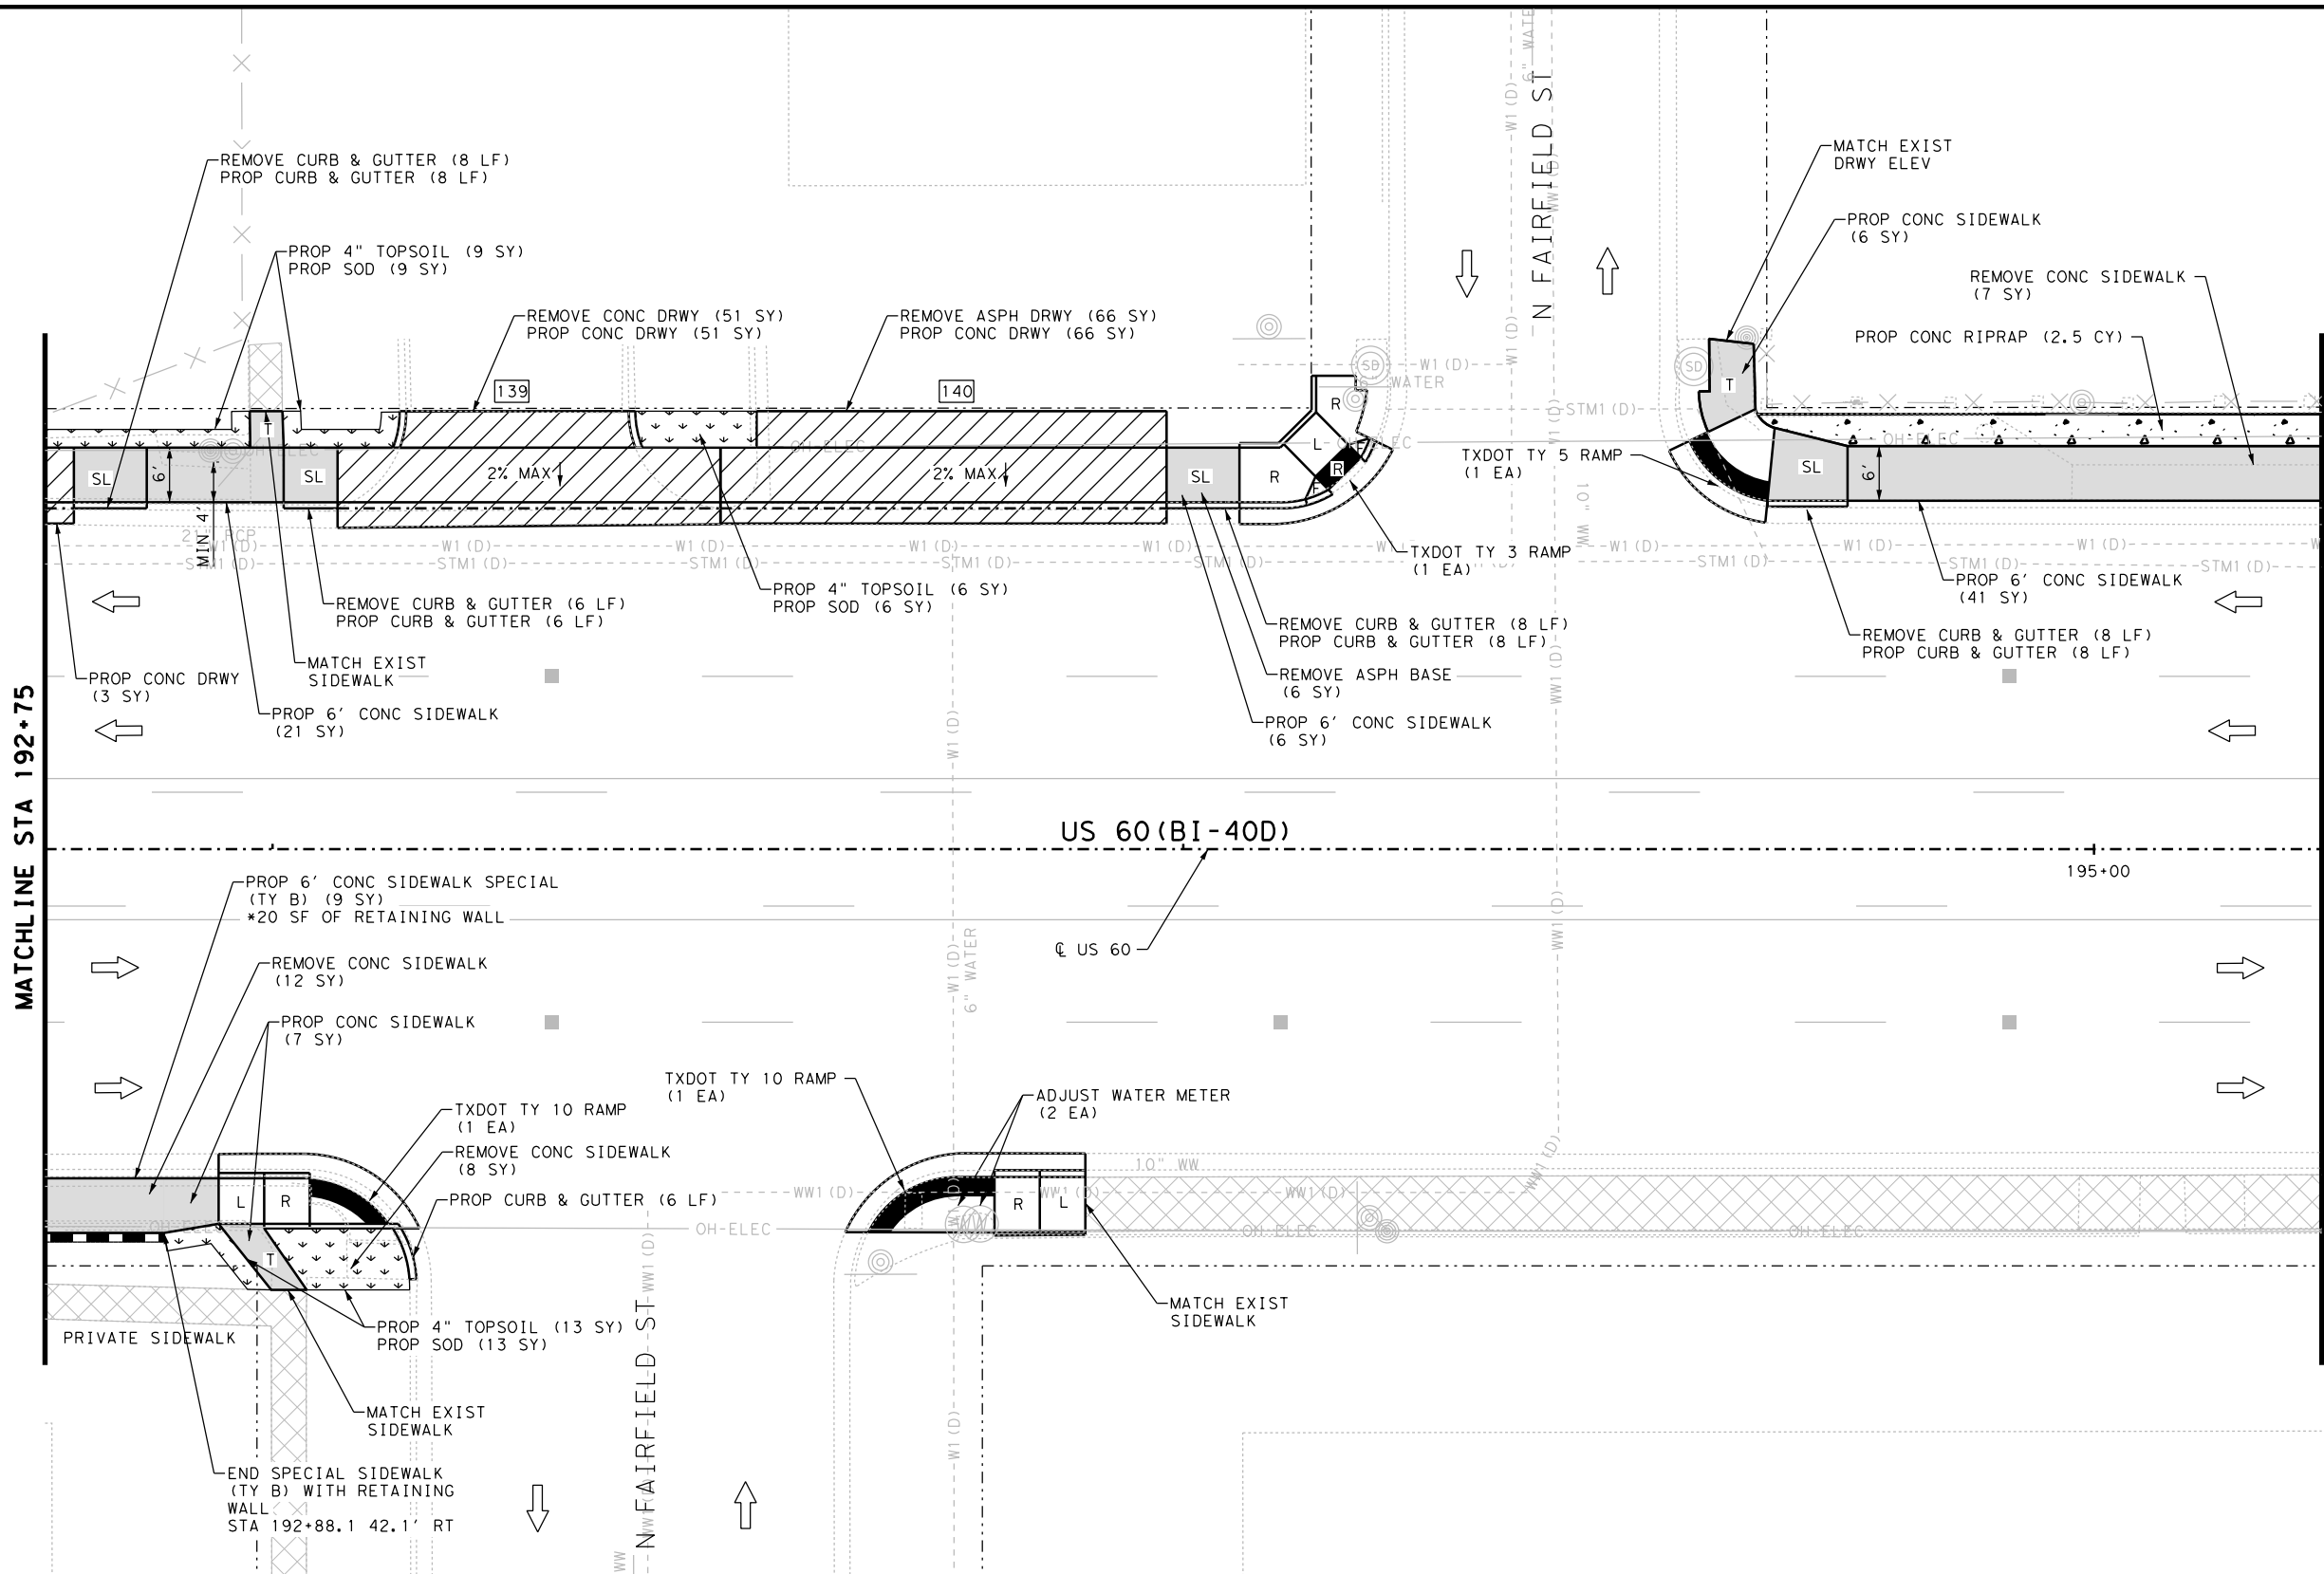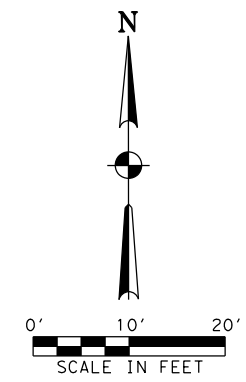

- NOTES:
- * FOR CONTRACTOR INFORMATION ONLY
 - 1. THE EXISTENCE AND LOCATION OF ALL UTILITIES AND DRAINAGE STRUCTURES INDICATED IN THE PLANS ARE TAKEN FROM THE BEST RECORDS AVAILABLE AND ARE NOT GUARANTEED TO BE ACCURATE. CONTRACTOR SHALL COORDINATE WITH ALL UTILITY COMPANIES TO FIELD VERIFY UTILITIES PRIOR TO BEGINNING CONSTRUCTION.

NO.	DATE	REVISION	BY



GLOBAL CIVIL SOLUTIONS, LLC
 1151 FOREST CENTRAL DRIVE
 SUITE 220
 DALLAS, TX 75243
 F-12801



US 60 (BI 40-D)
SIDEWALK PLAN

STA 192+75 TO STA 195+25



SHEET 41 OF 44

DESIGN	FED. RD. DIV. NO.	FEDERAL AID PROJECT NO.	HIGHWAY NO.
MI	6	(SEE TITLE SHEET)	VARIOUS
GRAPHICS	STATE	DISTRICT	COUNTY
PS	TEXAS	AMA	POTTER
CHECK	CONTROL	SECTION	JOB
MF			
CHECK	FS	0904	02 047

ITEM	DESCRIPTION	UNIT	QTY
0104 6015	REMOVING CONC (SIDEWALKS)	SY	35
0104 6017	REMOVING CONC (DRIVEWAYS)	SY	51
0104 6029	REMOVING CONC (CURB OR CURB & GUTTER)	LF	30
0105 6070	REMOVING STAB BASE & ASPH PAV (6" - 8")	SY	72
0160 6003	FURNISHING AND PLACING TOP SOIL (4")	SY	28
0162 6002	BLOCK SODDING	SY	28
0168 6001	VEGETATIVE WATERING	MG	1.1
0432 6001	RIPRAP (CONC) (4 IN)	CY	2.5
0479 6008	ADJUSTING MANHOLES (WATER METER)	EA	2
0529 6008	CONC CURB & GUTTER (TY II)	LF	30
0530 6004	DRIVEWAYS (CONC)	SY	120
0531 6001	CONC SIDEWALK (4")	SY	81
0531 6006	CURB RAMPS (TY 3)	EA	1
0531 6008	CURB RAMPS (TY 5)	EA	1
0531 6013	CURB RAMPS (TY 10)	EA	2
0531 6033	CONC SIDEWALK (SPECIAL) (TY B)	SY	6

- LEGEND**
- | | | | |
|----------------------------------|---|---------------------|--------------------------|
| PROP SODDING | R RAMP | POWER POLE | IRRIGATION CONTROL VALVE |
| PROP CONC DRWY | L LANDING PAD | TRAFFIC SIGNAL POLE | ELECTRICAL PULL BOX |
| PROP CONC RIPRAP | F FLARE | LIGHT POLE | DRIVEWAY ID |
| PROP RETAINING WALL | SL LONG. SLOPE MAY NOT EXCEED 5% OR ADJACENT ROAD SLOPE | WATER METER | PEDESTRIAN SIGNAL |
| PROP CONC SIDEWALK | T TRANSITION | FIRE HYDRANT | GAS METER |
| EXISTING SIDEWALK/DRWY TO REMAIN | LS LEVEL SIDEWALK (2% MAX) | GUY WIRE | SPRINKLER HEAD |
| | ← TRAFFIC FLOW | TREE/SHRUB | UTILITY MARKER POST |
| | ⊙ EXISTING SIGN | FENCE | OVERHEAD ELECTRIC LINE |
| | ● PROPOSED SIGN | WATER VALVE | |
| | ⊙ MANHOLE | TRAFFIC SIGNAL BOX | |

P:\Jobs\2020007-Pedestrian\1110-CA00\VP3-SHEETS\047_AM_US_60_STA192+75.dgn
 5:19:03 PM 1/27/2022

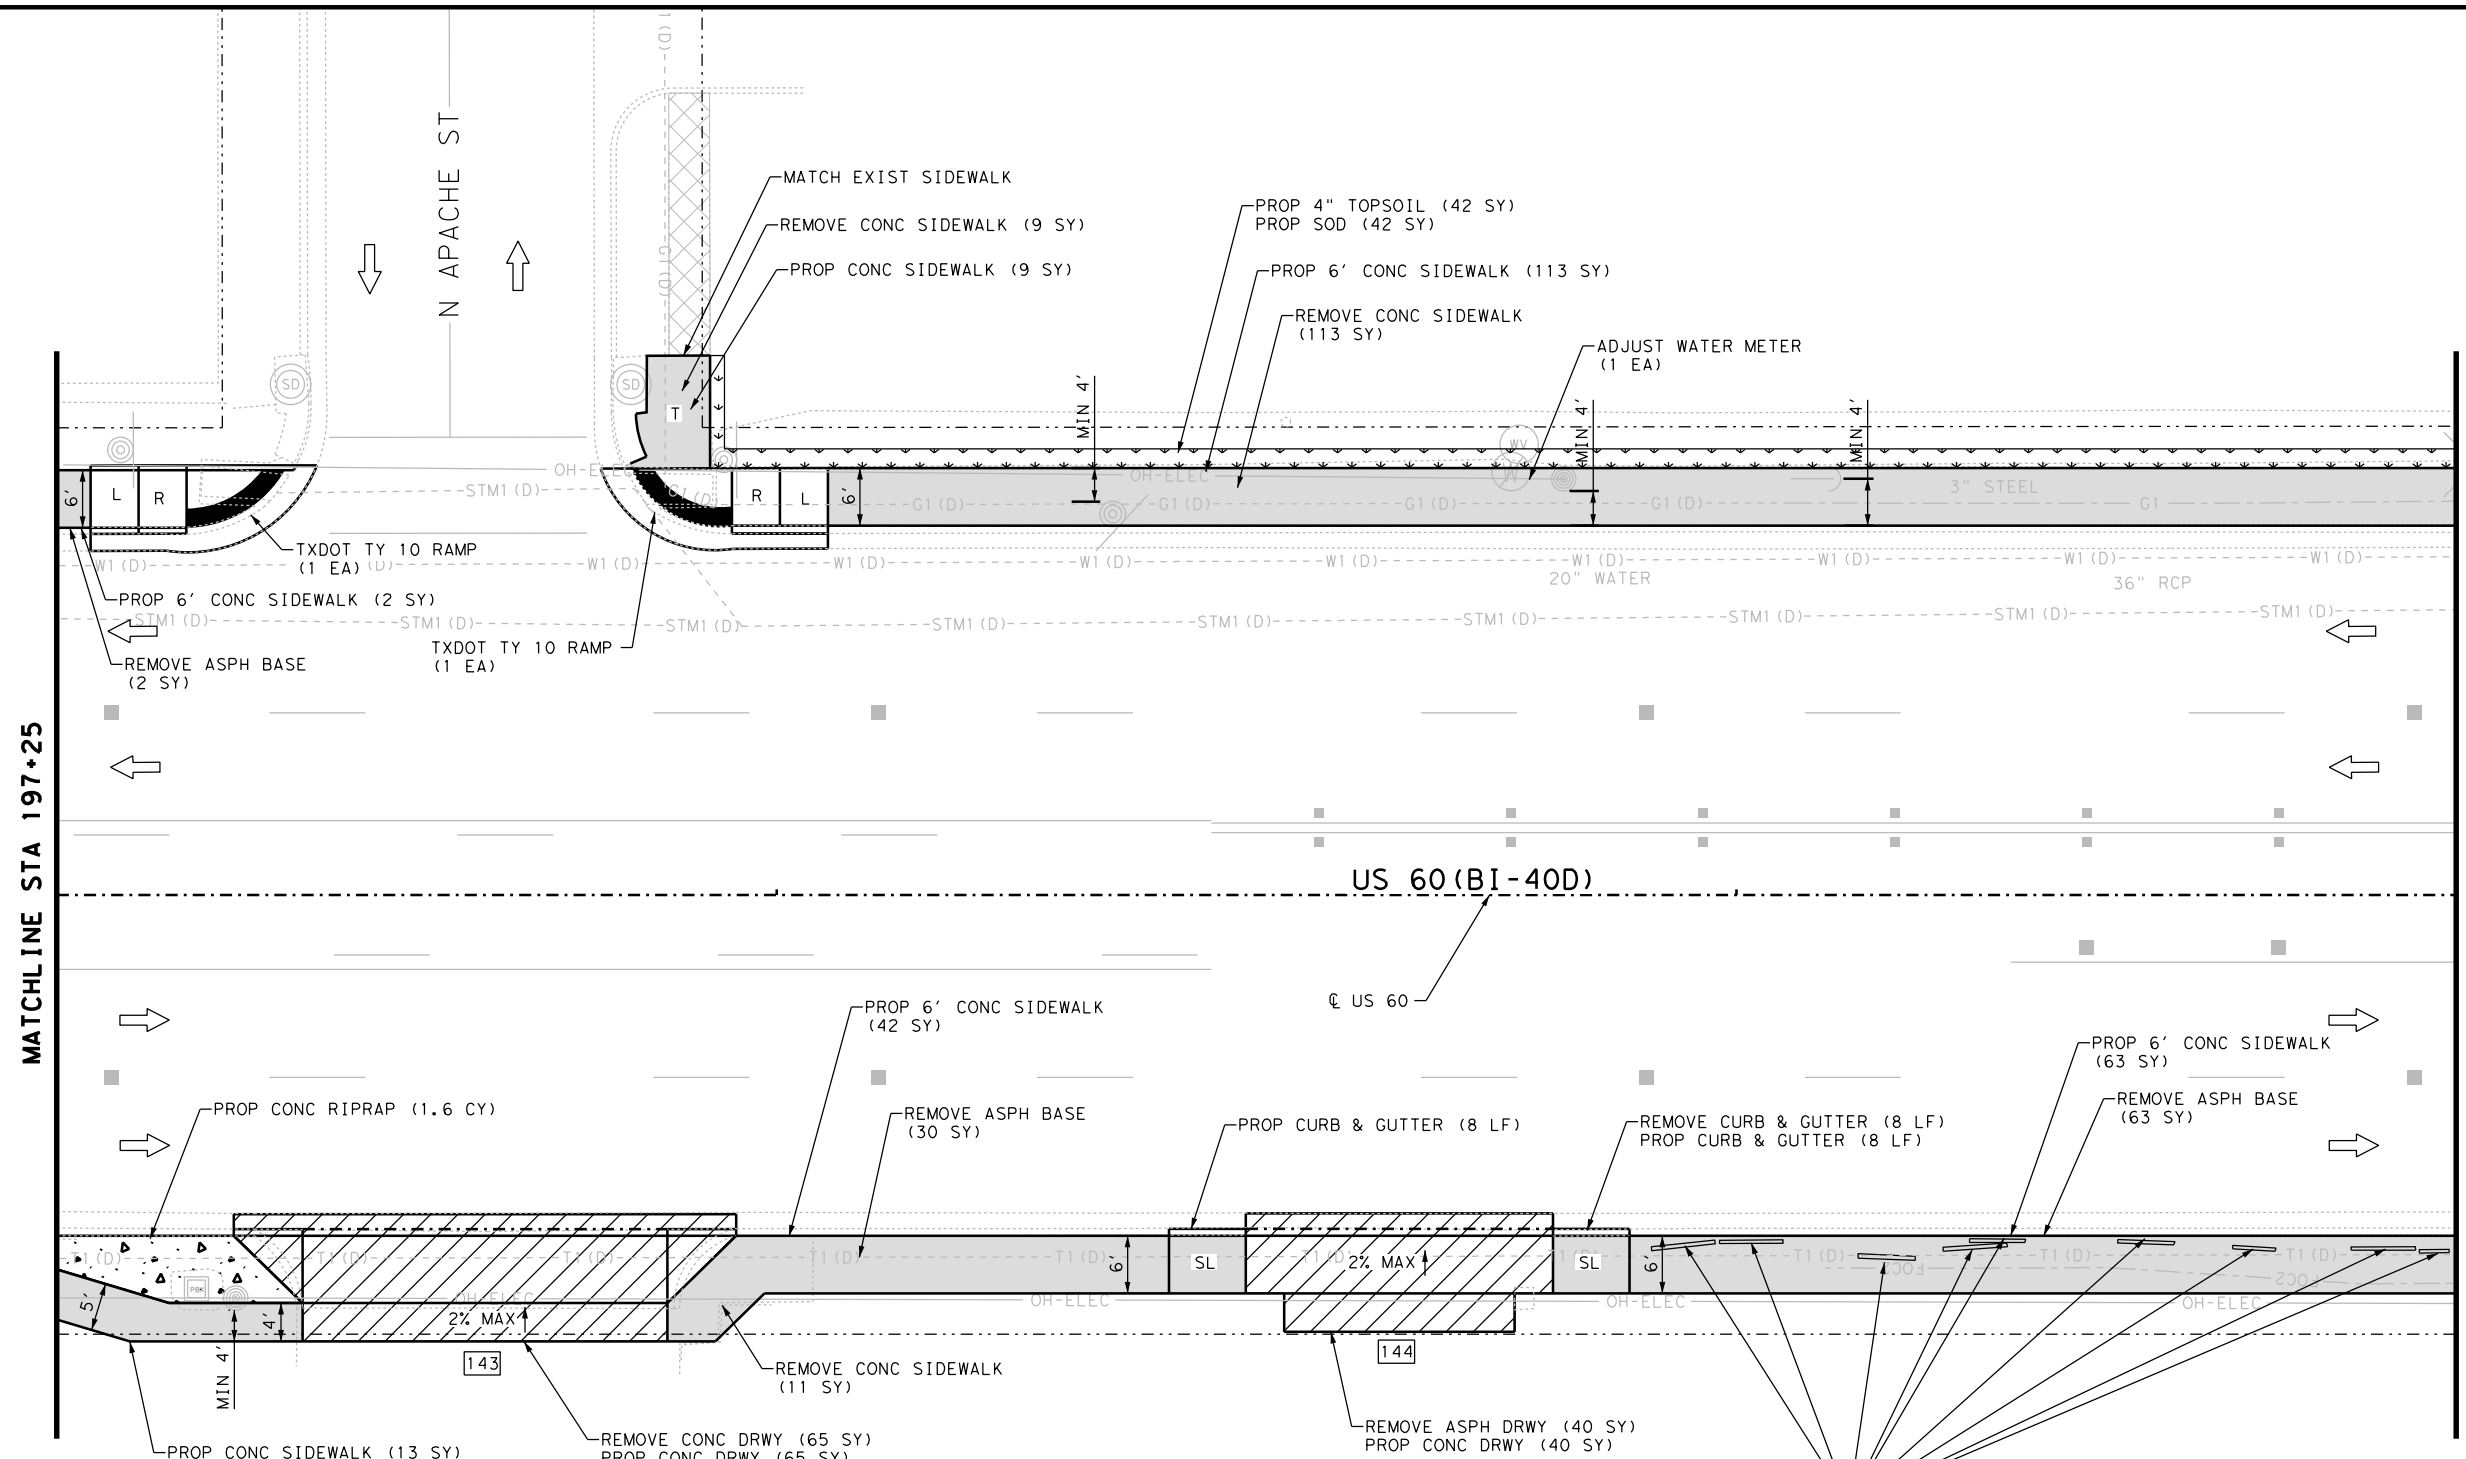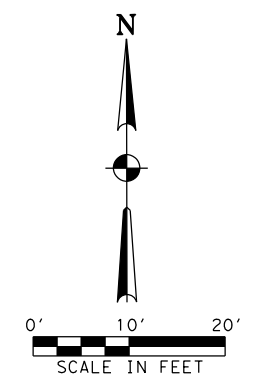


NOTES:

* FOR CONTRACTOR INFORMATION ONLY

1. THE EXISTENCE AND LOCATION OF ALL UTILITIES AND DRAINAGE STRUCTURES INDICATED IN THE PLANS ARE TAKEN FROM THE BEST RECORDS AVAILABLE AND ARE NOT GUARANTEED TO BE ACCURATE. CONTRACTOR SHALL COORDINATE WITH ALL UTILITY COMPANIES TO FIELD VERIFY UTILITIES PRIOR TO BEGINNING CONSTRUCTION.

NO.	DATE	REVISION	BY

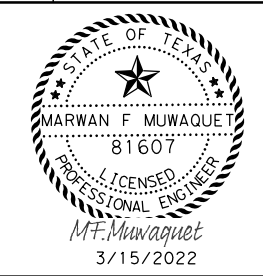

GLOBAL CIVIL SOLUTIONS, LLC
 1151 FOREST CENTRAL DRIVE
 SUITE 220
 DALLAS, TX 75243
 F-12801



US 60 (BI 40-D)
SIDEWALK PLAN

STA 197+25 TO STA 199+75

SHEET 43 OF 44



ITEM	DESCRIPTION	UNIT	QTY
0104 6015	REMOVING CONC (SIDEWALKS)	SY	133
0104 6017	REMOVING CONC (DRIVEWAYS)	SY	65
0104 6029	REMOVING CONC (CURB OR CURB & GUTTER)	LF	8
0105 6070	REMOVING STAB BASE & ASPH PAV (6" - 8")	SY	135
0160 6003	FURNISHING AND PLACING TOP SOIL (4")	SY	42
0162 6002	BLOCK SODDING	SY	42
0168 6001	VEGETATIVE WATERING	MG	1.6
0432 6001	RIPRAP (CONC) (4 IN)	CY	1.6
0479 6008	ADJUSTING MANHOLES (WATER METER)	EA	1
0529 6008	CONC CURB & GUTTER (TY II)	LF	16
0530 6004	DRIVEWAYS (CONC)	SY	105
0531 6001	CONC SIDEWALK (4")	SY	242
0531 6013	CURB RAMPS (TY 10)	EA	2
5057 6002	MOVE AND RESET PRECAST CONC WHEEL STOPS	EA	9

MOVE & RESET CONC WHEEL STOPS (9 EA)
COORDINATE WITH PROPERTY OWNER

LEGEND

- | | | | | | | | |
|--|----------------------------------|----|--|--|---------------------|--|--------------------------|
| | PROP SODDING | R | RAMP | | POWER POLE | | IRRIGATION CONTROL VALVE |
| | PROP CONC DRWY | L | LANDING PAD | | TRAFFIC SIGNAL POLE | | ELECTRICAL PULL BOX |
| | PROP CONC RIPRAP | F | FLARE | | LIGHT POLE | | DRIVEWAY ID |
| | PROP RETAINING WALL | SL | LONG. SLOPE MAY NOT EXCEED 5% OR ADJACENT ROAD SLOPE | | WATER METER | | PEDESTRIAN SIGNAL |
| | PROP CONC SIDEWALK | T | TRANSITION | | FIRE HYDRANT | | GAS METER |
| | EXISTING SIDEWALK/DRWY TO REMAIN | LS | LEVEL SIDEWALK (2% MAX) | | GUY WIRE | | SPRINKLER HEAD |
| | | | TRAFFIC FLOW | | TREE/SHRUB | | UTILITY MARKER POST |
| | | | EXISTING SIGN | | FENCE | | OVERHEAD ELECTRIC LINE |
| | | | PROPOSED SIGN | | WATER VALVE | | |
| | | | MANHOLE | | TRAFFIC SIGNAL BOX | | |

P:\Jobs\2020007-Pedestrian\TXDOT_Ampl\110\CA00\VP3\SHEETS\047_AM_US_60_STA197+25.dgn
 3/15/2022 2:09:06 PM

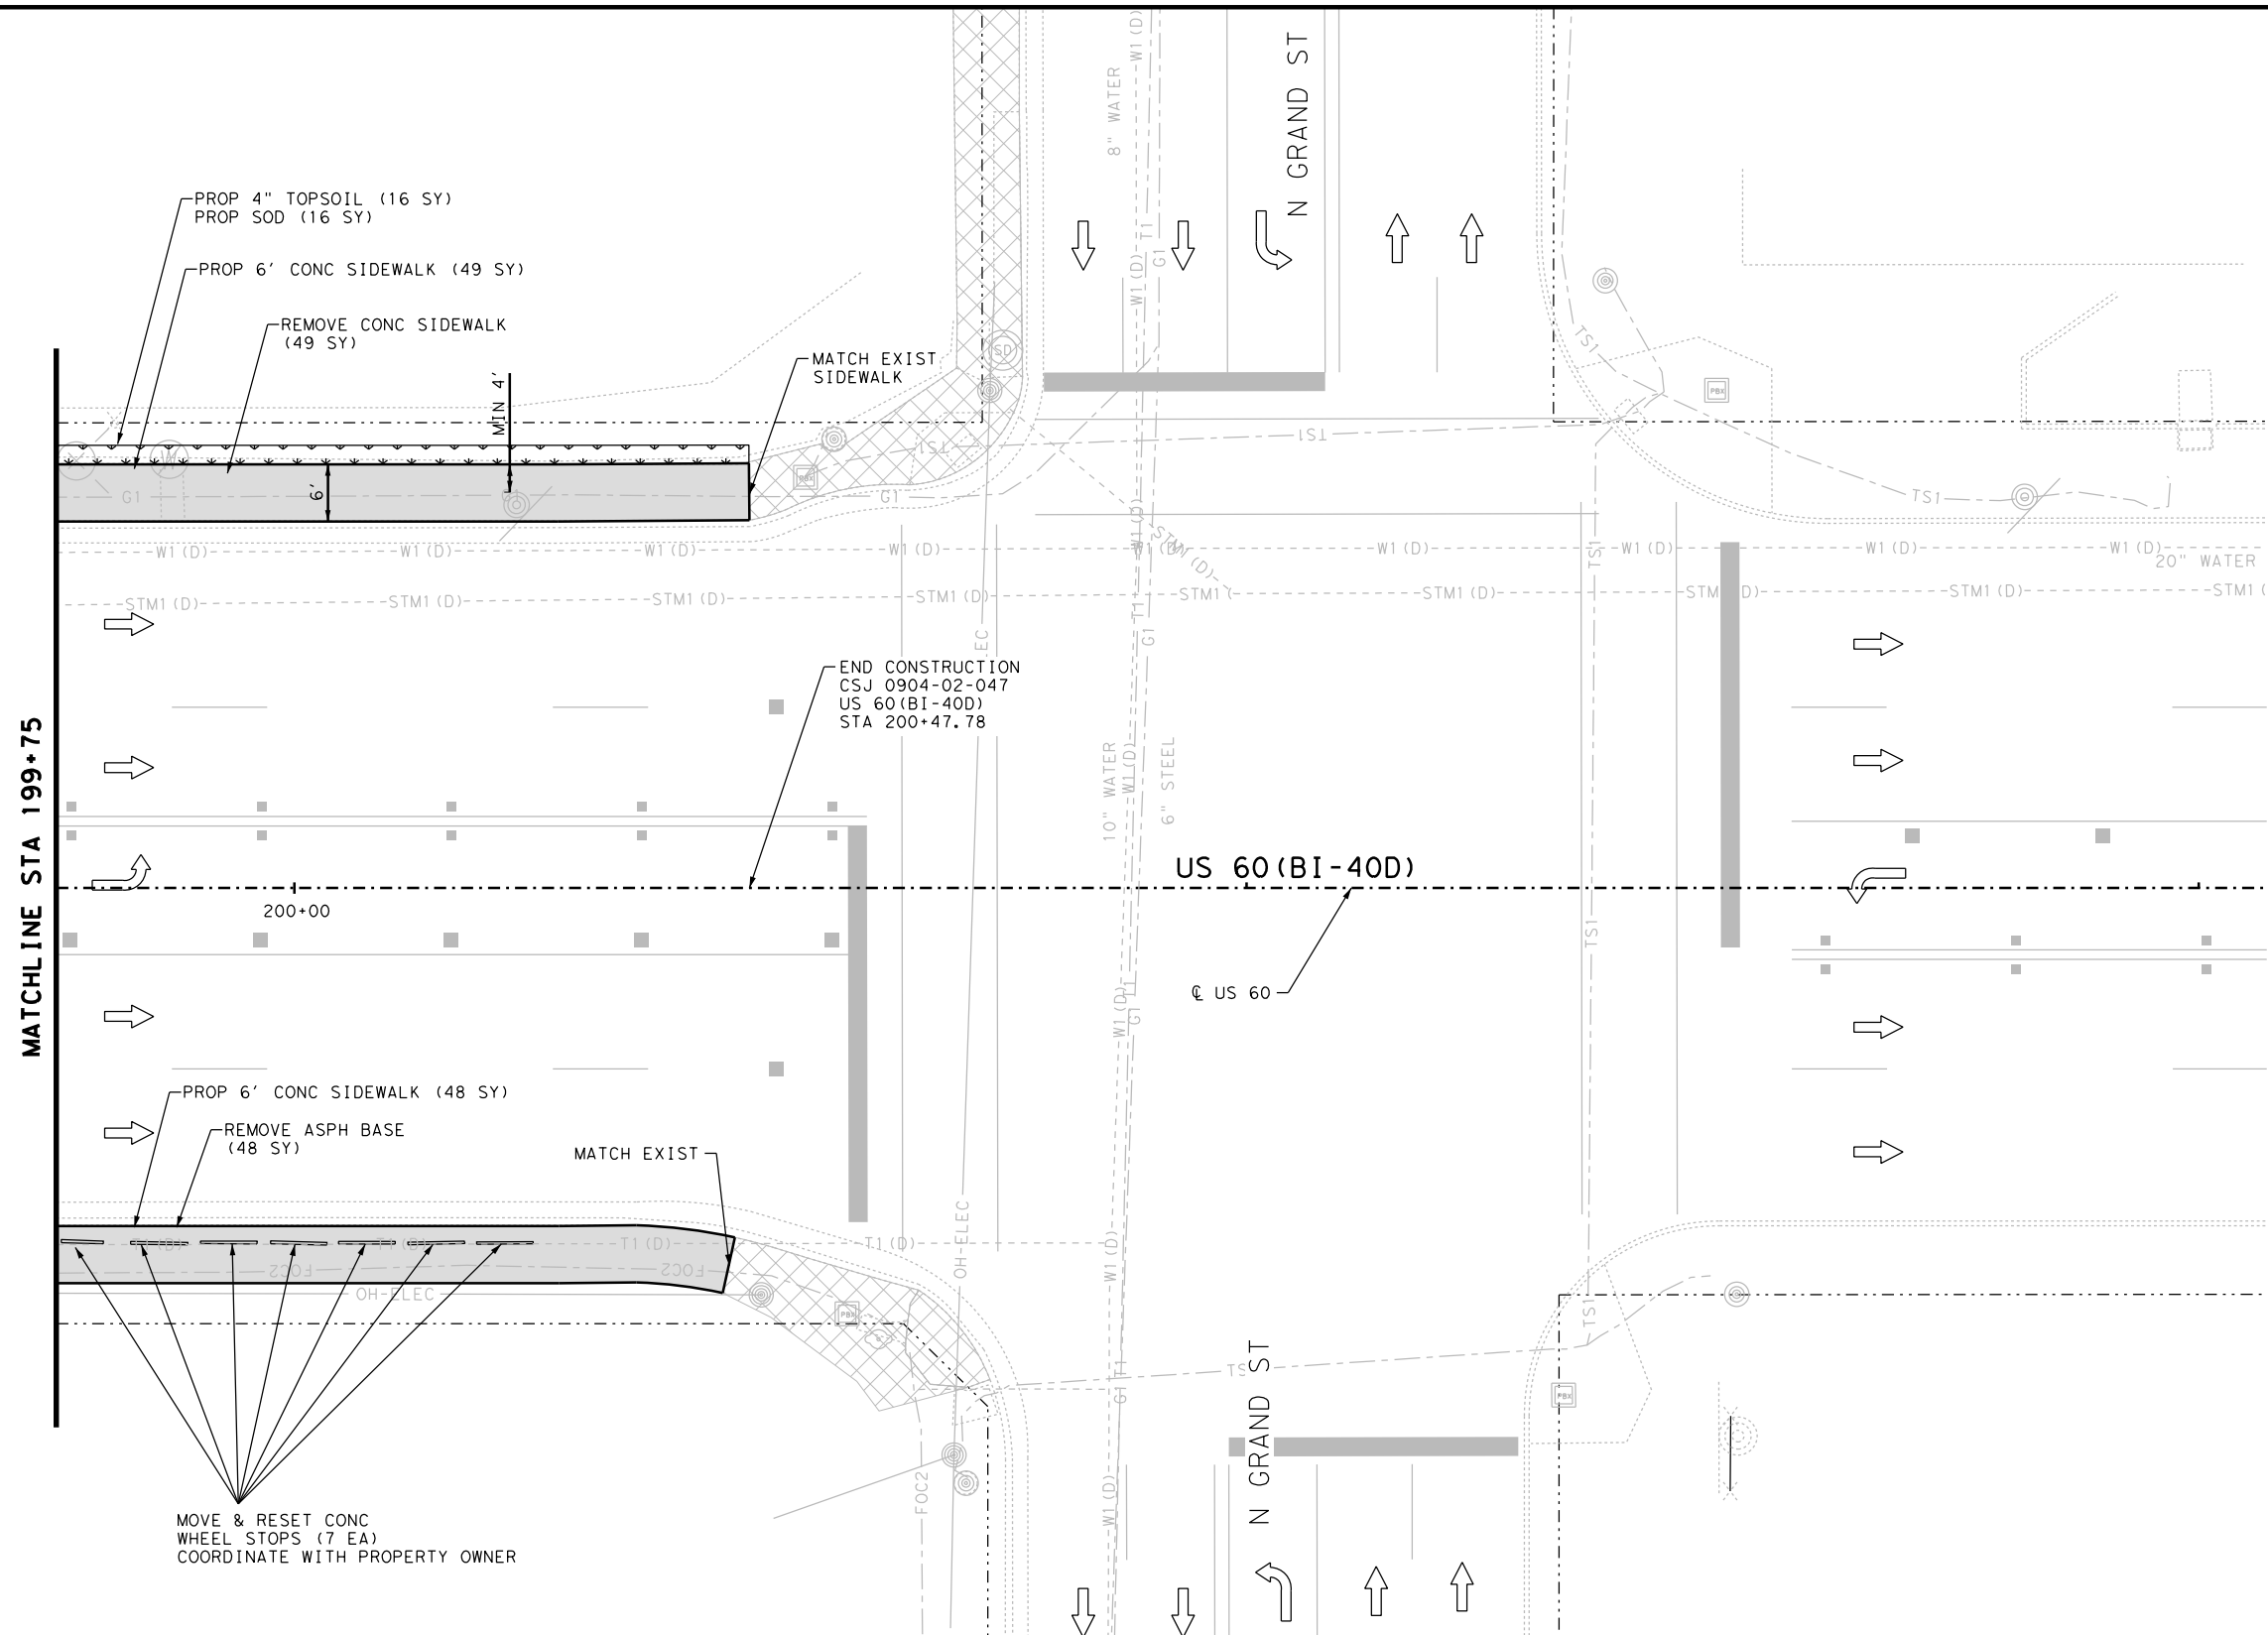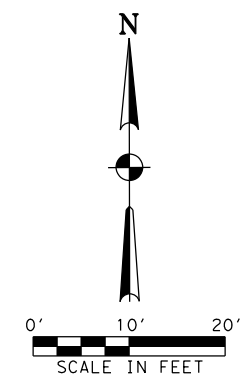

NOTES:
 * FOR CONTRACTOR INFORMATION ONLY
 1. THE EXISTENCE AND LOCATION OF ALL UTILITIES AND DRAINAGE STRUCTURES INDICATED IN THE PLANS ARE TAKEN FROM THE BEST RECORDS AVAILABLE AND ARE NOT GUARANTEED TO BE ACCURATE. CONTRACTOR SHALL COORDINATE WITH ALL UTILITY COMPANIES TO FIELD VERIFY UTILITIES PRIOR TO BEGINNING CONSTRUCTION.

NO.	DATE	REVISION	BY



GLOBAL CIVIL SOLUTIONS, LLC
 11551 FOREST CENTRAL DRIVE
 SUITE 220
 DALLAS, TX 75243
 F-12801



ITEM	DESCRIPTION	UNIT	QTY
0104 6015	REMOVING CONC (SIDEWALKS)	SY	49
0105 6070	REMOVING STAB BASE & ASPH PAV (6" - 8")	SY	48
0160 6003	FURNISHING AND PLACING TOP SOIL (4")	SY	16
0162 6002	BLOCK SODDING	SY	16
0168 6001	VEGETATIVE WATERING	MG	0.6
0531 6001	CONC SIDEWALK (4")	SY	97
5057 6002	MOVE AND RESET PRECAST CONC WHEEL STOPS	EA	7

LEGEND	
	PROP SODDING
	PROP CONC DRWY
	PROP CONC RIPRAP
	PROP RETAINING WALL
	PROP CONC SIDEWALK
	EXISTING SIDEWALK/DRWY TO REMAIN
	R RAMP
	L LANDING PAD
	F FLARE
	SL LONG SLOPE MAY NOT EXCEED 5% OR ADJACENT ROAD SLOPE
	T TRANSITION
	LS LEVEL SIDEWALK (2% MAX)
	← TRAFFIC FLOW
	⊙ EXISTING SIGN
	⊙ PROPOSED SIGN
	⊙ MANHOLE
	⊙ POWER POLE
	⊙ TRAFFIC SIGNAL POLE
	⊙ LIGHT POLE
	⊙ WATER METER
	⊙ FIRE HYDRANT
	— GUY WIRE
	☁ TREE/SHRUB
	—x—x— FENCE
	⊗ WATER VALVE
	⊗ TRAFFIC SIGNAL BOX
	⊙ IRRIGATION CONTROL VALVE
	⊙ ELECTRICAL PULL BOX
	⊙ DRIVEWAY ID
	⊙ PEDESTRIAN SIGNAL
	⊙ GAS METER
	⊙ SPRINKLER HEAD
	⊙ UTILITY MARKER POST
	---OP--- OVERHEAD ELECTRIC LINE

**US 60 (BI 40-D)
 SIDEWALK PLAN**


STA 199+75 TO END PROJECT

SHEET 44 OF 44


DESIGN MI	FED. RD. DIV. NO. 6	FEDERAL AID PROJECT NO. (SEE TITLE SHEET)	HIGHWAY NO. VARIOUS
GRAPHICS PS	STATE TEXAS	DISTRICT AMA	COUNTY POTTER
CHECK MFM	CONTROL 0904	SECTION 02	JOB 047
CHECK FS			SHEET NO. 072

P:\Jobs\202007-Pedestr\110-CA00\PS3-SHEETS\047_AM_US_60_STA199+75.dgn
 2:09:46 PM
 5/15/2022


CONCRETE ROADWAY OR CURB AND GUTTER SECTION

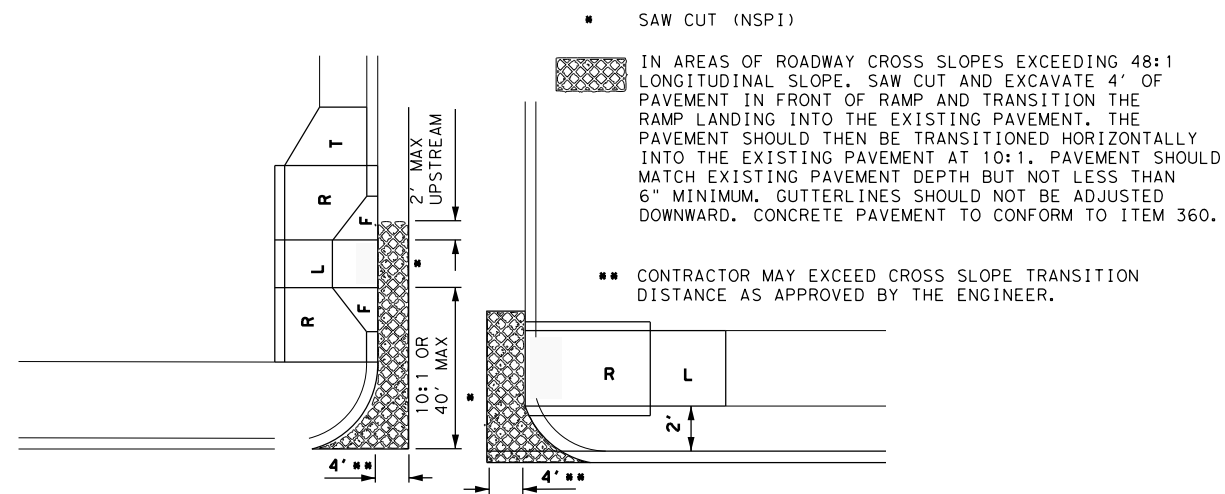


ASPHALT/SEALCOAT ROADWAY

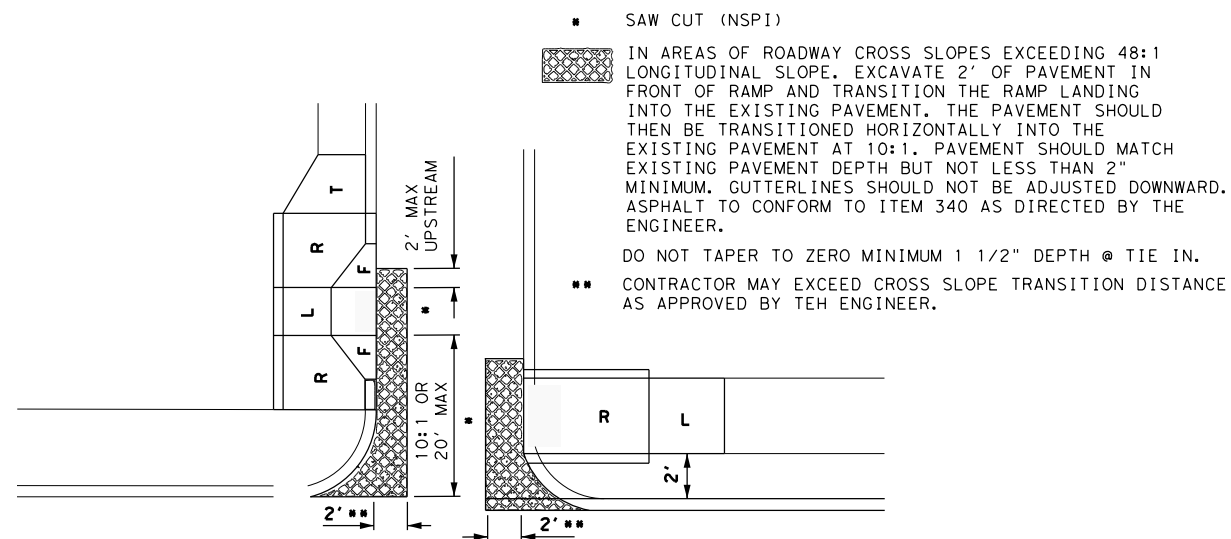

ROADWAY TRANSITION

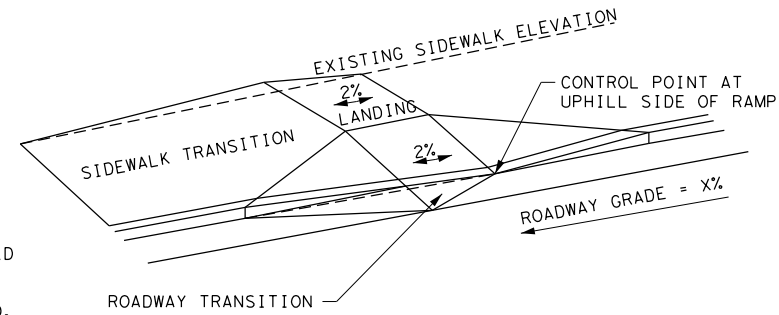

CURB ELEVATION

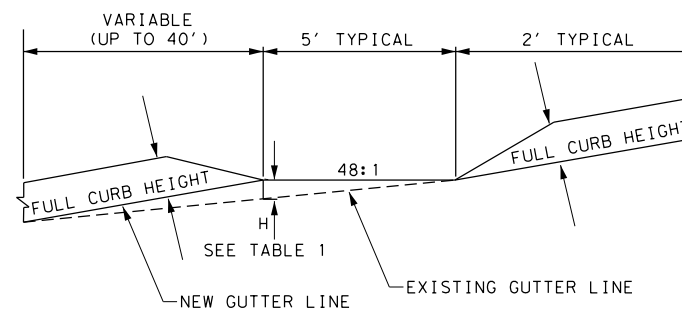

DIFFERENTIAL BETWEEN RAMP AND ROADWAY LOGITUDINAL SLOPE	H	
1%	0.04'	0.50"
2%	0.08'	1.00"
3%	0.12'	1.50"
4%	0.16'	2.00"
5%	0.20'	2.40"
6%	0.24'	2.90"


LEGEND

- F = FLARE (10:1 OR LESS)
- R = RAMP (CROSS SLOPE NOT TO EXCEED 48:1 LONGITUDINAL NOT TO EXCEED 12:1)
- L = LANDING (SHALL NOT EXCEED 48:1 SLOPE IN ANY DIRECTION)
- L1 = SHARED LANDING (SHALL NOT EXCEED 48:1 SLOPE IN ANY DIRECTION)
- LS = LEVEL SIDEWALK (SHALL NOT EXCEED 48:1 SLOPE IN ANY DIRECTION) (PAID AS SIDEWALK)
- T = TRANSITION (PAID FOR UNDER CONC SIDEWALKS)
- X' = LENGTH MEASURED FROM P1 POINT
- ⊕ = PI POINT MEASURED FROM TANGENTIAL CURBLINE INTERSECTION
- ⊙ = BLOCK SOD
- (NSPI) = ITEM IS INCIDENTAL TO CURB RAMP/SIDEWALK CONSTRUCTION. (NO SEPARATE PAY ITEM)

NOTES


- FLARE (F), RAMP (R), AND LANDING (L), DIRECTLY IN CONTACT WITH THE CURB RAMP ARE PAID FOR UNDER ITEM 531 "CURB RAMPS"
- LEVEL SIDEWALK (LS) AND RAMPS (R) NOT DIRECTLY IN CONTACT WITH THE CURB RAMP ARE PAID FOR UNDER ITEM 531 "SIDEWALK".

HORIZONTAL RAMP CONTROL

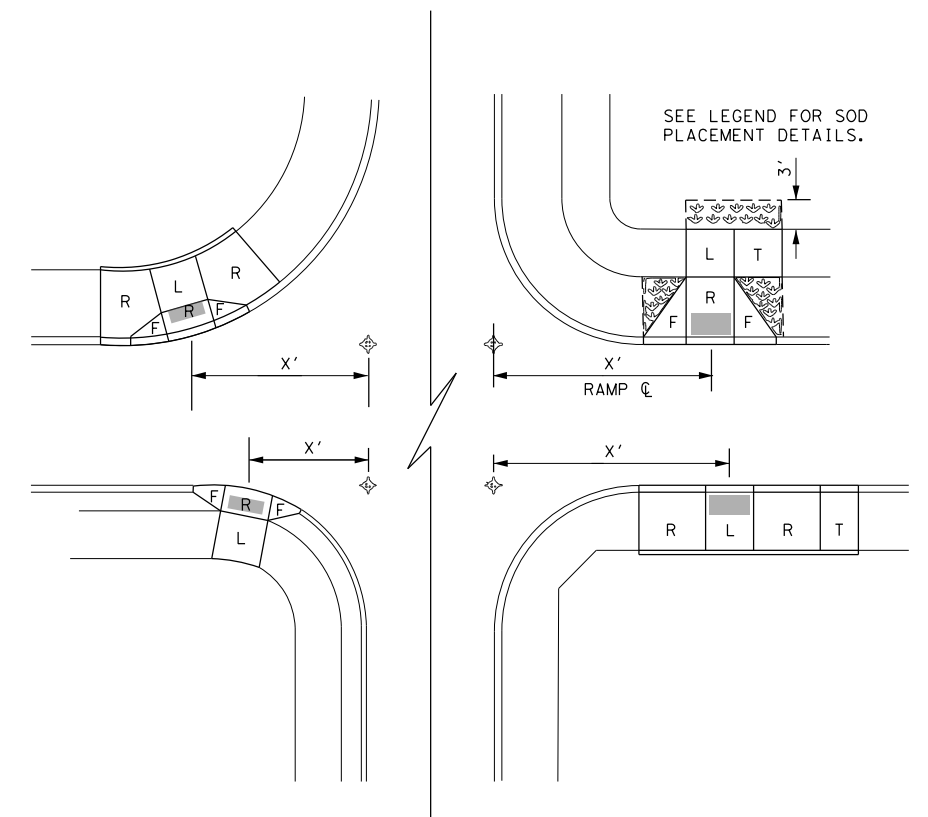

SEQUENCE OF WORK NARRATIVE

- ESTABLISH AND MAINTAIN TRAFFIC CONTROL AND SW3P FEATURES PER THE VARIOUS STANDARDS INCLUDED IN THIS PLAN SET OR AS DIRECTED.
- REMOVE EXISTING CONCRETE, ASPHALT, FOUNDATIONS, OR OTHER FEATURES WHERE INDICATED IN THE PLANS WITHIN THE AREA OF PROPOSED WORK.
- EXCAVATE OR BACKFILL AS NECESSARY TO ACHIEVE PROPOSED GRADES, PLACE BEDDING MATERIALS.
- FORM PROPOSED CONCRETE FEATURES.
- PLACE CONCRETE OR ASPHALT, REMOVE AND INSTALL PAVEMENT MARKINGS, AND RELOCATE SIGNS WHERE INDICATED.
- REMOVE FORMWORK AND BACKFILL DISTURBED AREAS FOR A SMOOTH FINISHED GRADE. GRADE TO DRAIN AS NECESSARY.
- PLACE AND IRRIGATE BLOCK SODDING WHERE INDICATED AND AS SPECIFIED.
- REMOVE ANY DEBRIS, TRAFFIC CONTROL, AND SW3P FEATURES AT THE COMPLETION OF CONSTRUCTION.

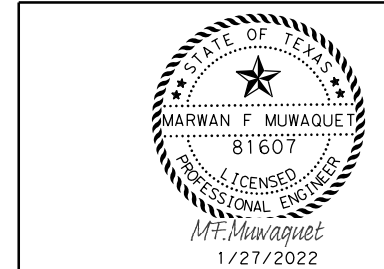


GLOBAL CIVIL SOLUTIONS, LLC
 11551 FOREST CENTRAL DRIVE
 SUITE 220
 DALLAS, TX 75243
 F-12801




MISCELLANEOUS DETAILS

SHEET 1 OF 6			
DESIGN MI	FED. RD. DIV. NO. 6	FEDERAL AID PROJECT NO. (SEE TITLE SHEET)	HIGHWAY NO. VARIOUS
GRAPHICS PS	STATE TEXAS	DISTRICT AMA	COUNTY POTTER
CHECK MF	CONTROL 0904	SECTION 02	JOB 047
CHECK FS			SHEET NO. 073

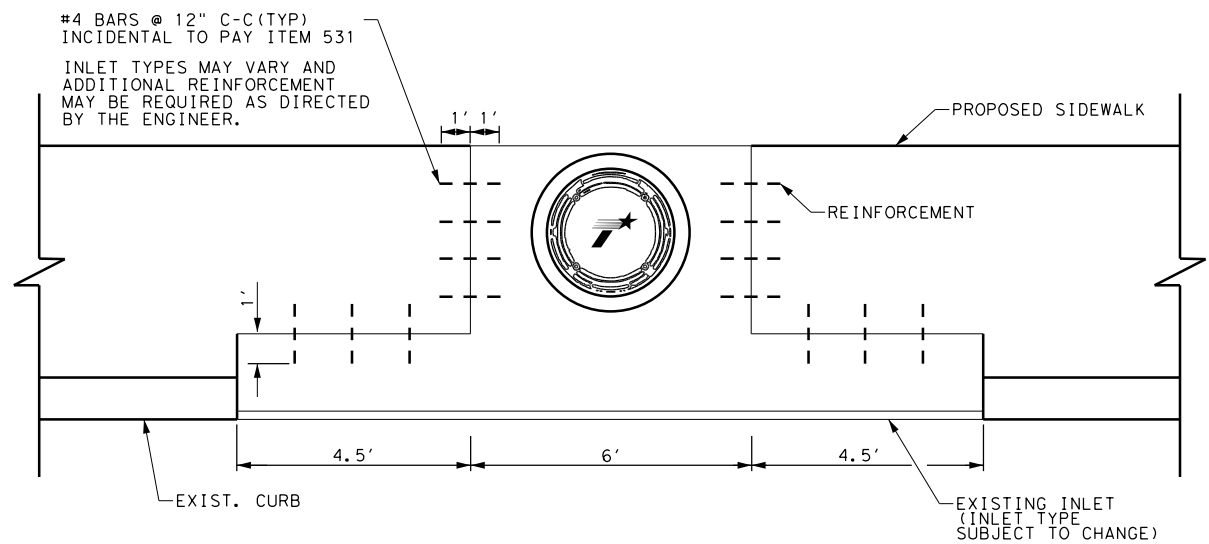

INLET DOWELING DETAIL
N.T.S.

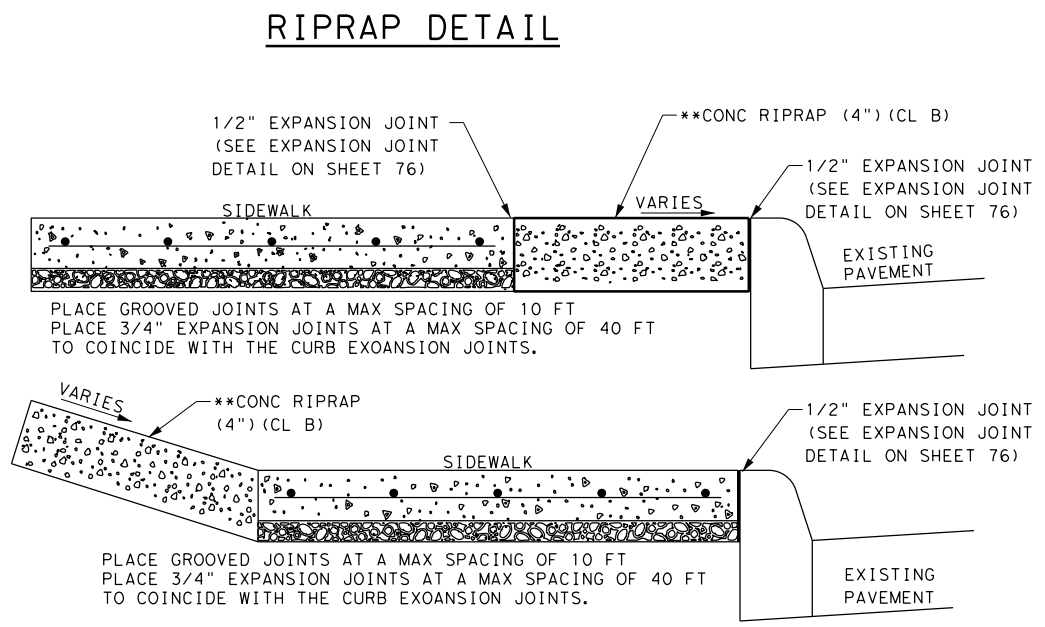


** CONTRACTOR TO USE NO. 4 REINFORCING BARS AS SPECIFIED IN ITEM 432. CONTRACTOR MAY USE HIGHER STRENGTH CLASS A CONCRETE IN LIEU OF CLASS B.

CURB RAMPS

ALL CURB RAMPS ARE TO BE 6" IN THICKNESS UNLESS OTHERWISE SHOWN

SPOT REPAIR DETAIL

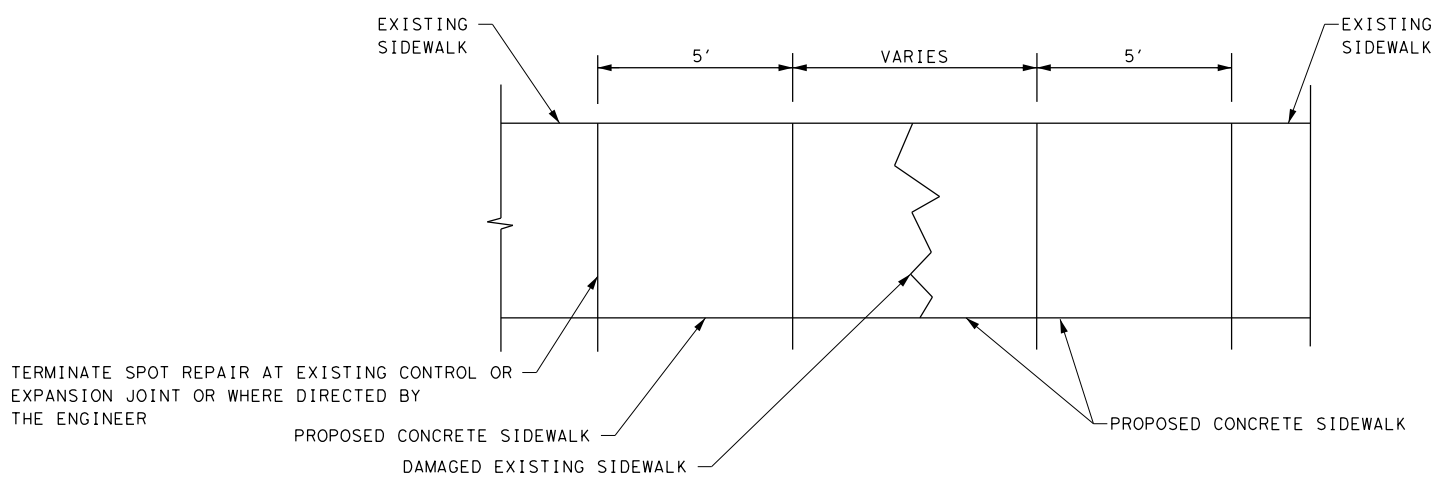

NOTE: SPOT REPAIR LOCATIONS ARE TO BE DETERMINED BY THE ENGINEER. PAYMENT FOR SPOT REPAIR IS INCLUDED UNDER ITEM 531. INDEFINITE QUANTITIES.



GLOBAL CIVIL SOLUTIONS, LLC
11551 FOREST CENTRAL DRIVE
SUITE 220
DALLAS, TX 75243
F-12801




MISCELLANEOUS DETAILS

SHEET 2 OF 6


DESIGN	FED. RD. DIV. NO.	FEDERAL AID PROJECT NO.	HIGHWAY NO.
MI	6	(SEE TITLE SHEET)	VARIOUS
GRAPHICS	STATE	DISTRICT	COUNTY
PS	TEXAS	AMA	POTTER
CHECK	CONTROL	SECTION	JOB
MFM	0904	02	047
CHECK	FS		

074


P:\Jobs\2020007-Pedestrian TxDOT Amorillo\CA00\PS\SHEETS\074_Miscellaneous Details 2 OF 6.dgn 5:19:18 PM 1/27/2022

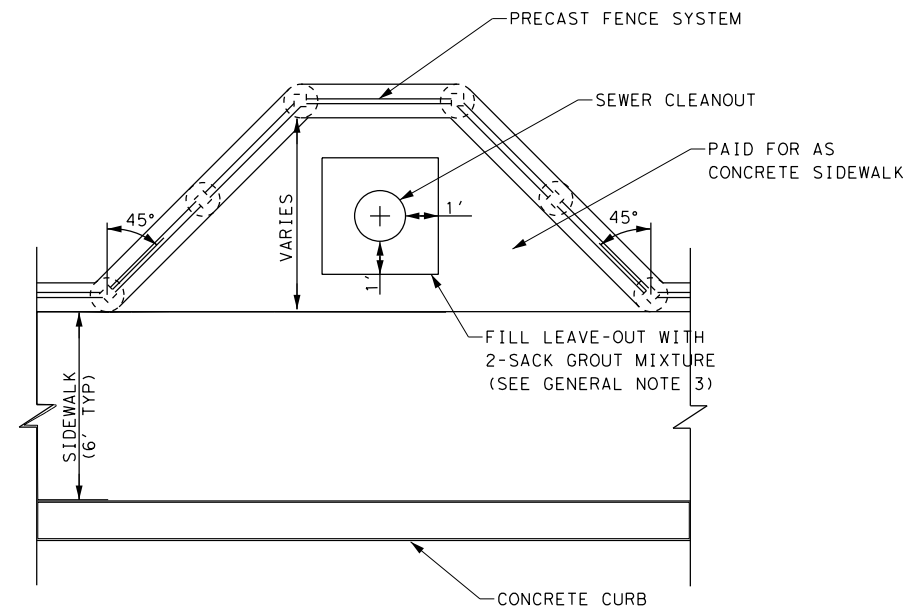


SEWER CLEANOUT BLOCKOUT
N. T. S.

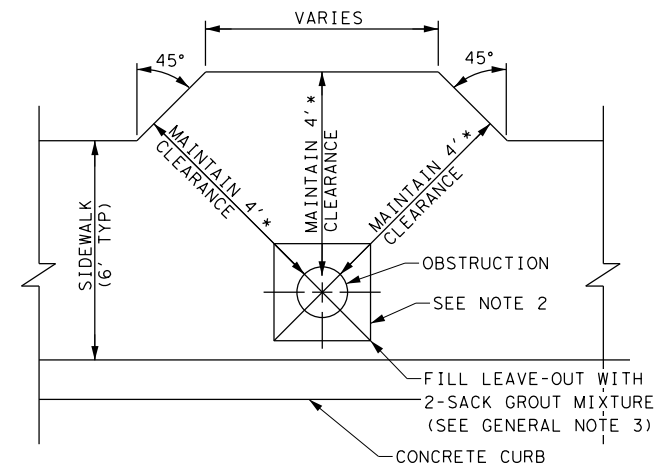

OBSTRUCTION IN SIDEWALK
* UNLESS OTHERWISE SPECIFIED

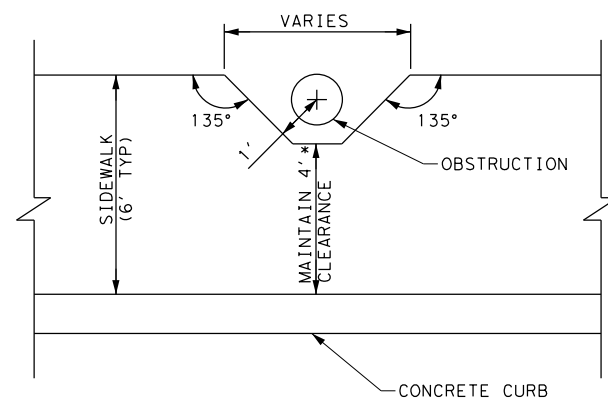

OBSTRUCTION IN SIDEWALK
* UNLESS OTHERWISE SPECIFIED

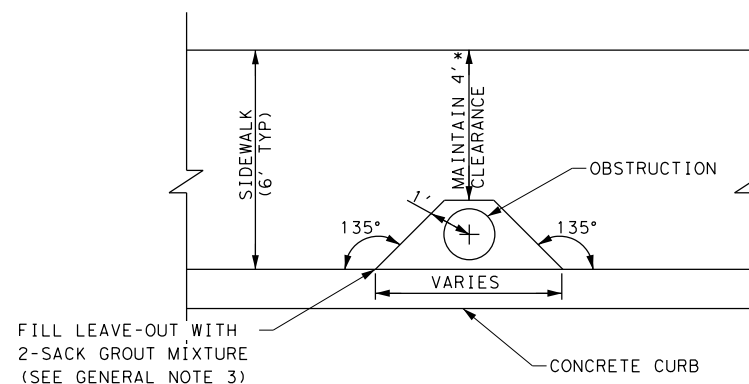

OBSTRUCTION IN SIDEWALK
* UNLESS OTHERWISE SPECIFIED

NOTES:

1. UTILIZE DETAIL AT OBSTRUCTION ENCROACHMENTS INTO THE PEDESTRIAN ACCESS ROUTE A MINIMUM UNOBSTRUCTED CLEARANCE OF 4,' UNLESS OTHERWISE SPECIFIED, SHOULD BE MAINTAINED AROUND THE OBSTRUCTION MEASURED FROM THE MOST RESTRICTIVE LOCATION OR AS APPROVED BY THE ENGINEER.
2. IF OBSTRUCTION IS LOCATED WITHIN THE SIDEWALK, CONSTRUCT 2' SQUARE CONSTRUCTION JOINT CENTERED ON OBSTRUCTION TO FACILITATE FUTURE MAINTENANCE WITHOUT FULL SIDEWALK PANEL REMOVAL/REPLACEMENT.
3. THE LEAVE-OUTS SHALL BE FILLED WITH NO MORE THAN A 2-SACK GROUT MIXTURE AND PLACED IN ACCORDANCE WITH SECTION 421.2.F, "MORTAR AND GROUT". PAYMENT FOR FURNISHING AND PLACING THE GROUT MIXTURE WILL BE SUBSIDIARY TO THE PAY ITEM OF CONCRETE SIDEWALKS.

P:\Jobs\2020007-Pedestrian\TxDOT\mor1110\CA00\VP3_SHEETS\075_Miscellaneous Details 3 OF 6.dgn 5:19:23 PM 1/27/2022




GLOBAL CIVIL SOLUTIONS, LLC
11551 FOREST CENTRAL DRIVE
SUITE 220
DALLAS, TX 75243
F-12801




Texas Department of Transportation
© 2022 TxDOT

MISCELLANEOUS DETAILS


				SHEET 3 OF 6
DESIGN	FED. RD. DIV. NO.	FEDERAL AID PROJECT NO.	HIGHWAY NO.	
MI	6	(SEE TITLE SHEET)	VARIOUS	
GRAPHICS	STATE	DISTRICT	COUNTY	SHEET NO.
PS	TEXAS	AMA	POTTER	075
CHECK	CONTROL	SECTION	JOB	
MF	FS	0904	02	047

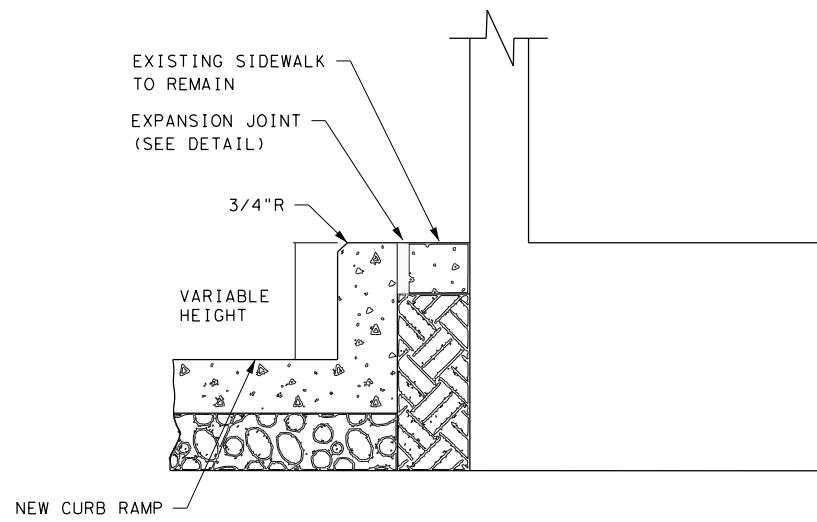


ADJACENT SIDEWALK TO REMAIN DETAIL

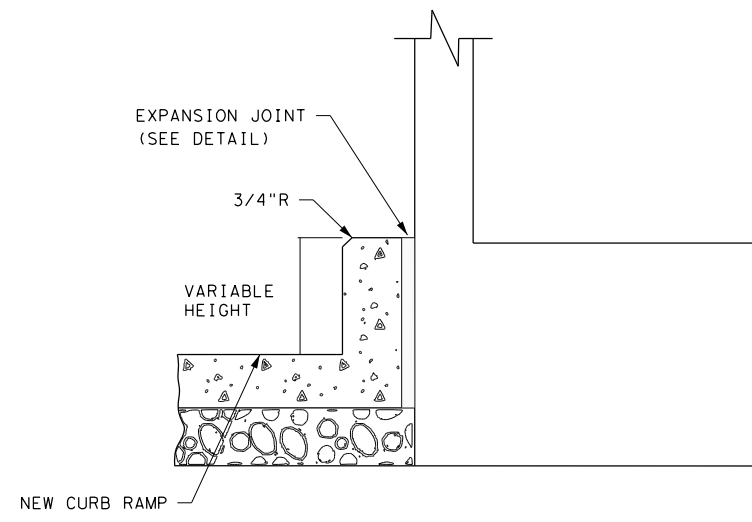

ADJACENT SIDEWALK REMOVED DETAIL

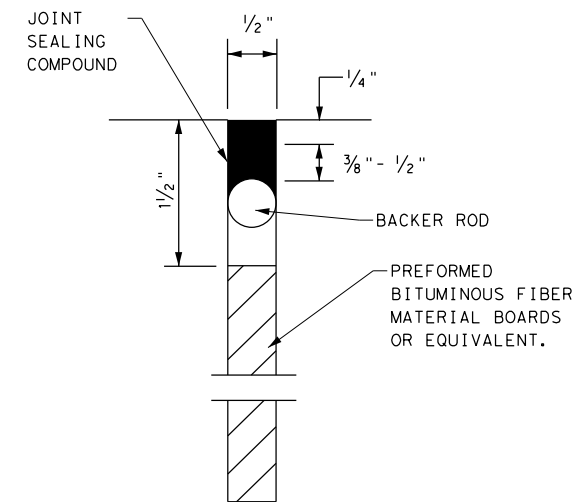

EXPANSION JOINT DETAIL

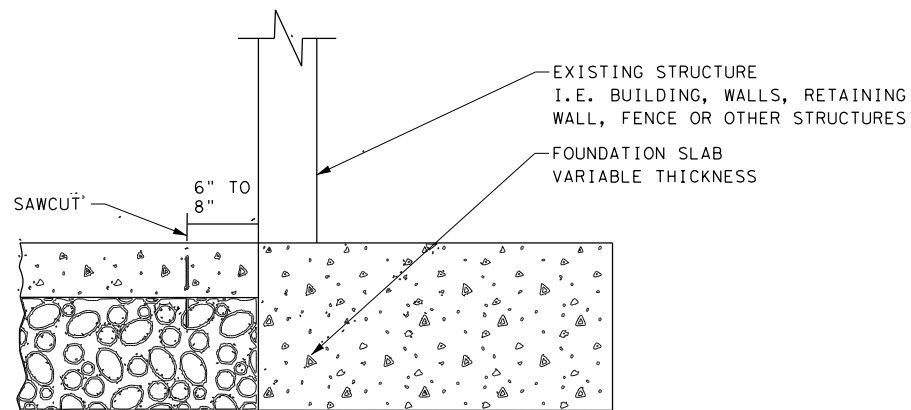

SAWCUT DETAIL

PAVING OPTION @ BUILDING FACE
NOT TO SCALE

GENERAL PROTECTION NOTES FOR BUILDINGS AND HISTORIC STRUCTURES:

1. SAW CUT EXISTING SIDEWALK 6 TO 8 INCHES AWAY FROM PROTECTED BUILDING/STRUCTURE TO MINIMIZE POTENTIAL DAMAGE PRIOR TO DEMOLITION OF WALK.
2. CONTRACTOR IS RESPONSIBLE FOR PREVENTING DAMAGE TO ALL BUILDINGS AND STRUCTURES DURING THE ENTIRE CONSTRUCTION PROJECT, IF DIRECTED BY ENGINEER TO HAND REMOVE EXISTING PAVING ADJACENT TO HISTORIC STRUCTURES. PROTECT FOUNDATION, MATERIALS, ELEVATION AND ENTRYWAYS. DO NOT REMOVE EXISTING MATERIALS IF FACADE (BRICK/STONE, ETC.) UTILIZES THE MATERIALS TO BE REMOVED AS A FOOTING, FOUNDATION OR SUPPORT. IF THIS CONDITION IS OBSERVED, IMMEDIATELY CONTACT ENGINEER AND DO NOT EXCAVATE FURTHER. SEPARATE PAYMENT WILL NOT BE MADE FOR HAND REMOVAL.
3. REPAIR OR REPLACE IN KIND, AT NO EXPENSE TO THE DEPARTMENT, ANY DAMAGE TO HISTORIC OR NON-HISTORIC MATERIAL THAT RESULTS FROM AN ACT OF OMISSION ON THE PART OF OR ON BEHALF OF THE CONTRACTOR. CONTRACTOR IS RESPONSIBLE FOR LOCATING A REPLACEMENT SOURCE FOR HISTORIC AND NON-HISTORIC MATERIALS DAMAGED IN THE PROCESS OF CONSTRUCTION. INFORM TXDOT ENVIRONMENTAL AFFAIRS DIVISION (ENV) OF PROPOSED REPAIRS AND/OR DAMAGED AREAS IN ORDER TO FACILITATE CONSULTATION WITH TEXAS HISTORICAL COMMISSION. MATERIAL AND SOURCE SHALL BE APPROVED BY TXDOT ENV PRIOR TO REPLACEMENT.
4. PROTECT BUILDINGS AND STRUCTURE FROM CONCRETE SPLASH UTILIZING A MATERIAL APPROVED BY THE ENGINEER. ANY CONCRETE SPLASH AS A RESULT OF CONSTRUCTION ACTIVITIES MUST BE REMOVED FROM THE BUILDING OR STRUCTURE AT CONTRACTOR'S EXPENSE. NO PAYMENT WILL BE MADE FOR BUILDING PROTECTION.



GLOBAL CIVIL SOLUTIONS, LLC
11551 FOREST CENTRAL DRIVE
SUITE 220
DALLAS, TX 75243
F-12801



Texas Department of Transportation
© 2022 TXDOT


MISCELLANEOUS DETAILS

SHEET 4 OF 6

DESIGN	FED. RD. DIV. NO.	FEDERAL AID PROJECT NO.	HIGHWAY NO.
MI	6	(SEE TITLE SHEET)	VARIOUS
GRAPHICS	STATE	DISTRICT	COUNTY
PS	TEXAS	AMA	POTTER
CHECK	CONTROL	SECTION	JOB
MFM	0904	02	047
CHECK	FS		

076


P:\Jobs\2020007-Pedestrian\TXDOT\Amor\110\CA00\PS\SHEETS\077_Miscellaneous Details 5 OF 6.dgn
 5:19:30 PM
 1/27/2022

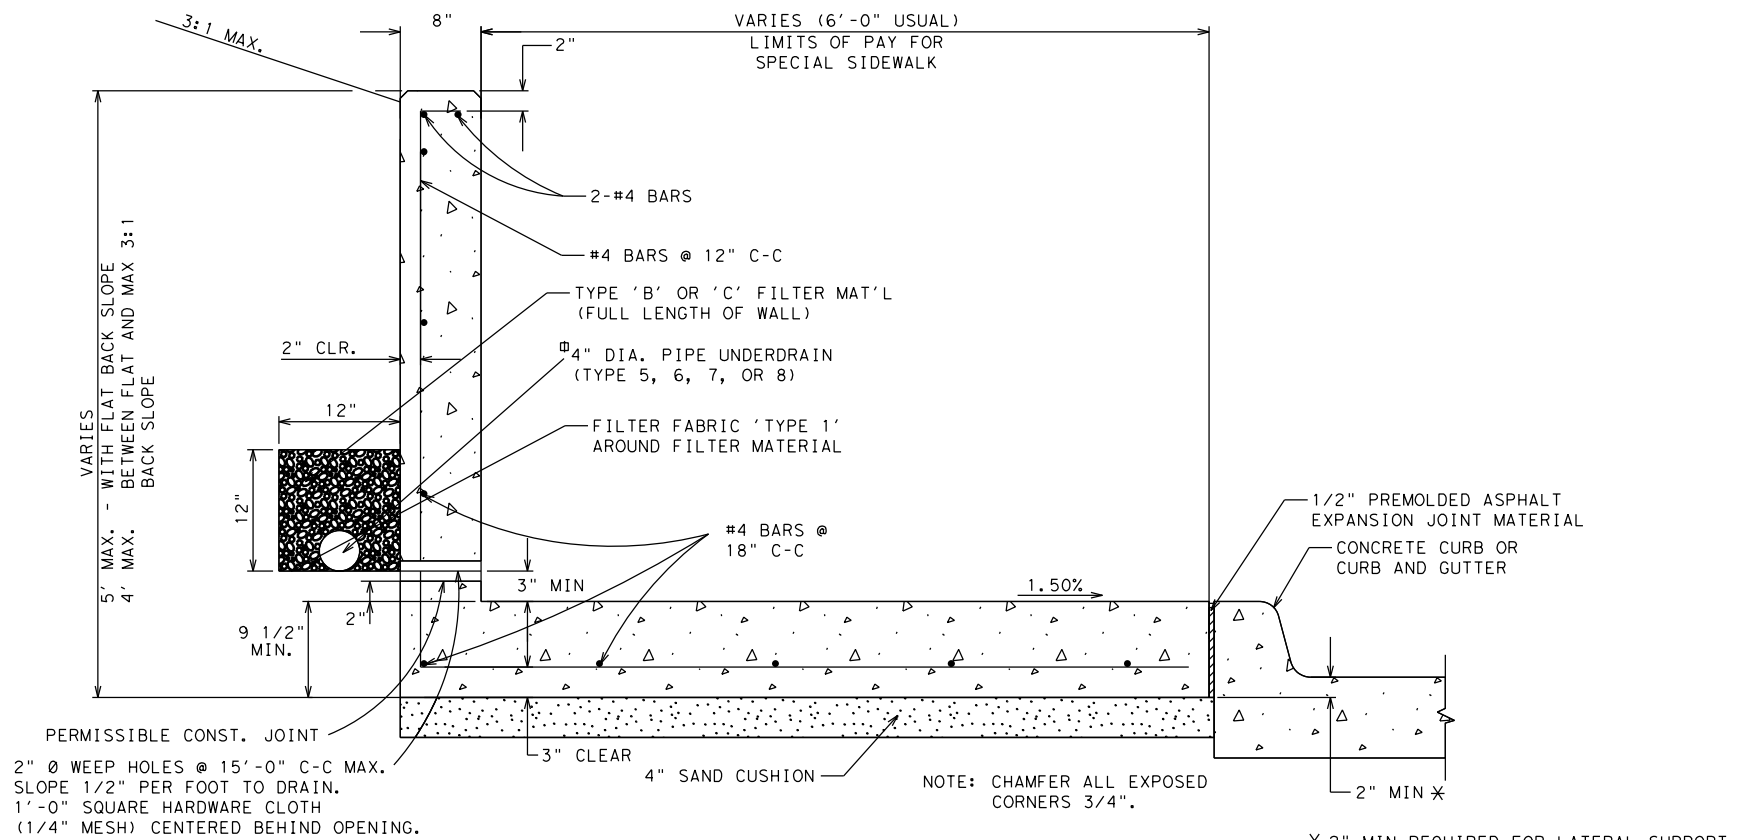

PERMISSIBLE CONST. JOINT
 2" Ø WEEP HOLES @ 15'-0" C-C MAX.
 SLOPE 1/2" PER FOOT TO DRAIN.
 1'-0" SQUARE HARDWARE CLOTH
 (1/4" MESH) CENTERED BEHIND OPENING.
 SLOPE TO DRAIN AND CONNECT TO STORM
 DRAIN. IF, IN THE OPINION OF THE ENGINEER,
 USE OF UNDERDRAIN IS IMPRACTICAL, WEEP
 HOLES MAY BE USED.

SIDEWALK ADJACENT TO CURB
TYPE B SIDEWALK OR RAMP W/ RETAINING WALL
 N. T. S.

TO BE PAID FOR UNDER ITEM 531 6033 CONC SIDEWALK (SPECIAL) (TYPE B)

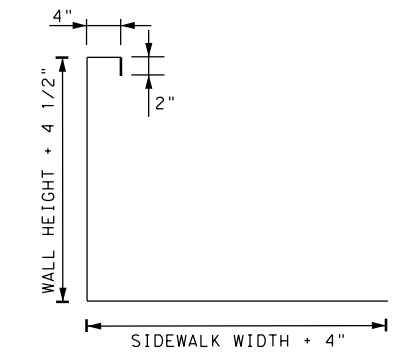

REINFORCING STEEL DETAIL
 N. T. S.

NOTE: CHAMFER ALL EXPOSED
 CORNERS 3/4".




GLOBAL CIVIL SOLUTIONS, LLC
 11551 FOREST CENTRAL DRIVE
 SUITE 220
 DALLAS, TX 75243
 F-12801




MISCELLANEOUS DETAILS

SHEET 5 OF 6


DESIGN MI	FED. RD. DIV. NO. 6	FEDERAL AID PROJECT NO. (SEE TITLE SHEET)	HIGHWAY NO. VARIOUS
GRAPHICS PS	STATE TEXAS	DISTRICT AMA	COUNTY POTTER
CHECK MF	CONTROL 0904	SECTION 02	JOB 047
CHECK FS			077

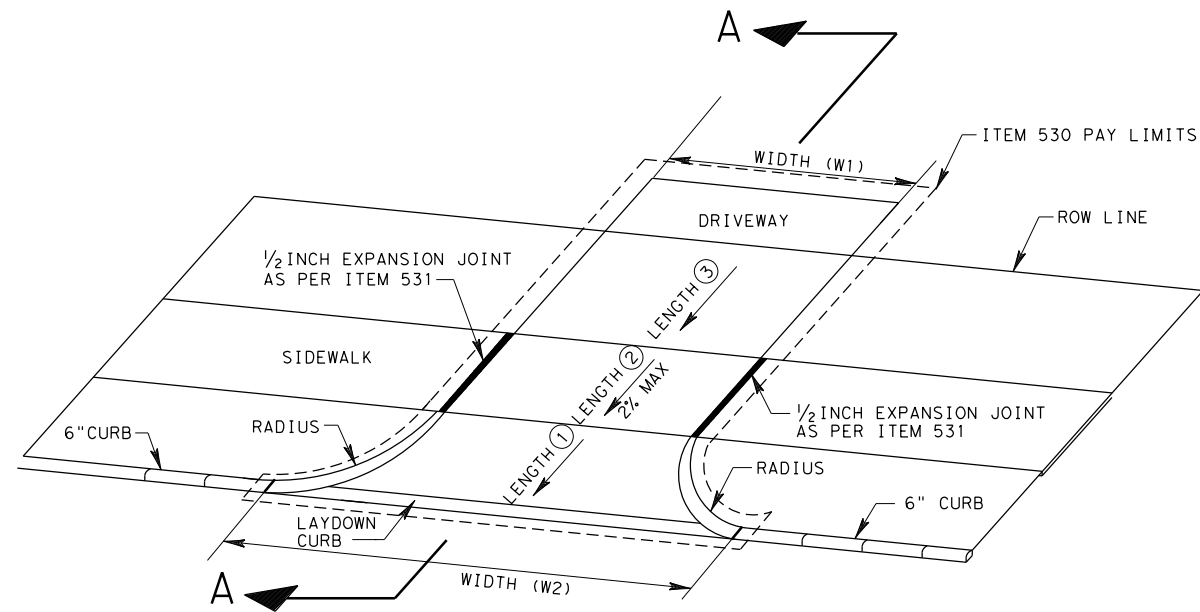


SIDEWALK OFFSET FROM CURB DETAILS

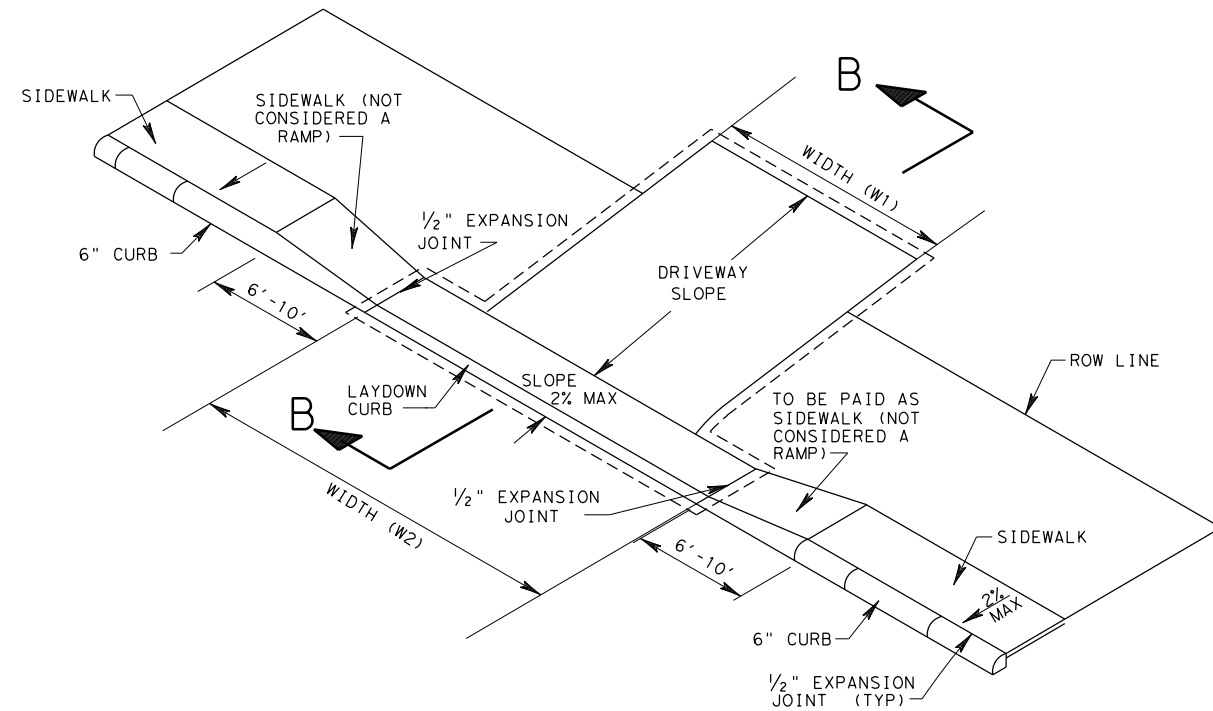

SIDEWALK ADJACENT TO CURB DETAILS

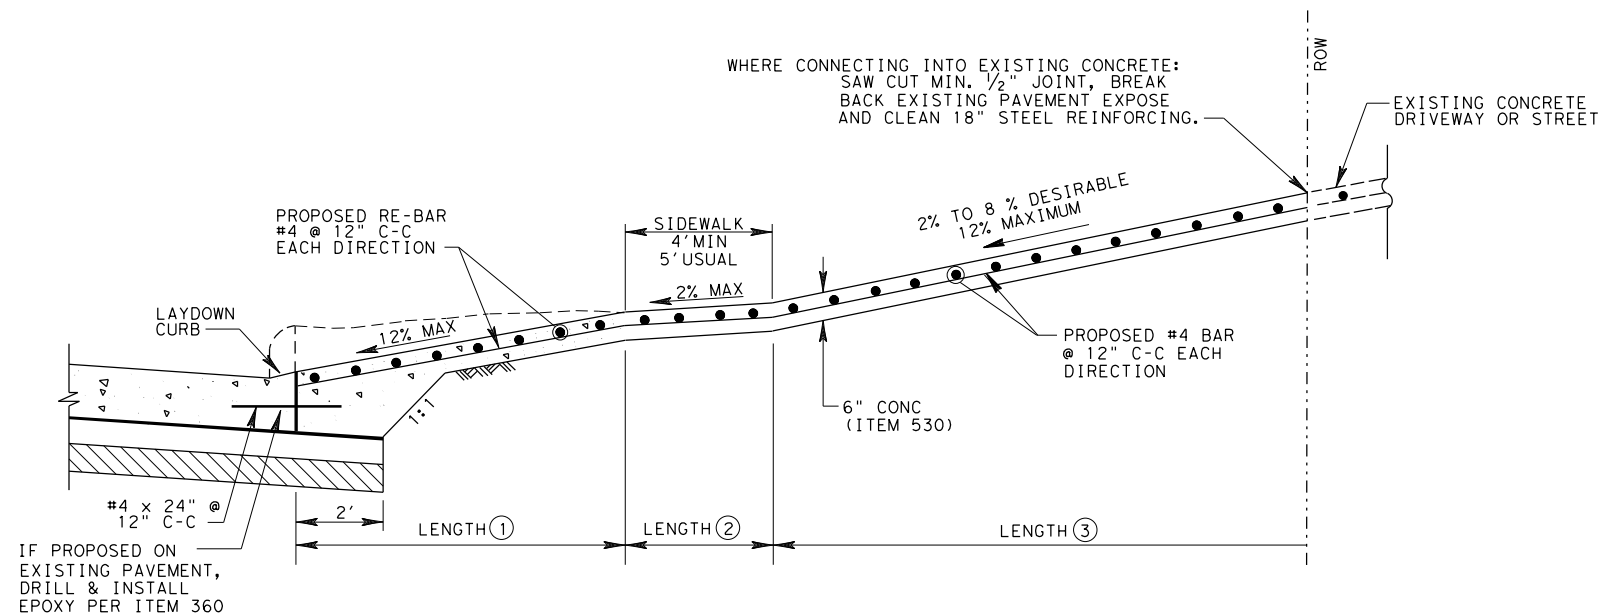

SLOPES W/ SIDEWALKS OFFSET FROM CURB (SECTION A-A)

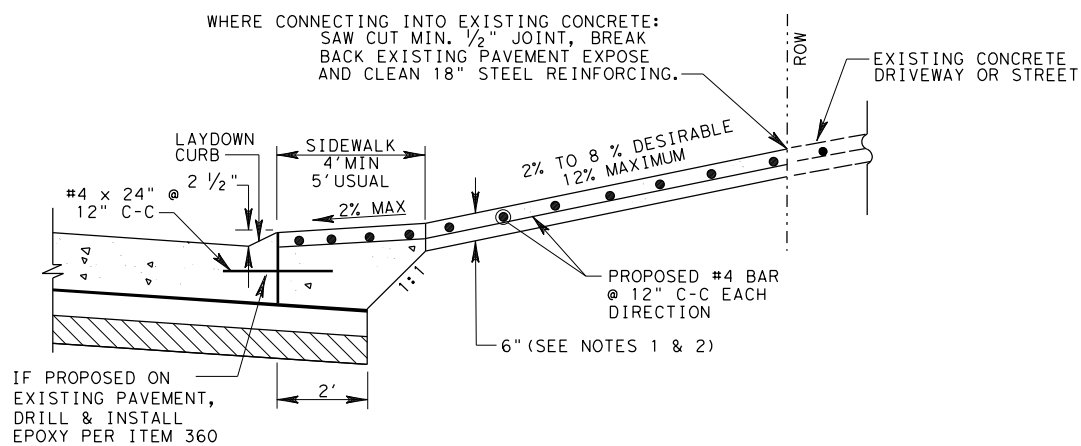

DRIVEWAY SLOPES W/ SIDEWALKS ADJACENT TO CURB (SECTION B-B)

NOTES:

1. FAST TRACK CONCRETE IS PAID AS DRVWY (CONC) (FAST TRACK).
2. THICKNESS OF DRIVEWAY IS 6 INCHES FOR REGULAR AND FAST TRACK CONCRETE.

NO.	DATE	REVISION	BY



GLOBAL CIVIL SOLUTIONS, LLC
11551 FOREST CENTRAL DRIVE
SUITE 220
DALLAS, TX 75243
F-12801



MISCELLANEOUS DETAILS


SHEET 6 OF 6

DESIGN	FED. RD. DIV. NO.	FEDERAL AID PROJECT NO.	HIGHWAY NO.
MI1	6	(SEE TITLE SHEET)	VARIOUS
GRAPHICS	STATE	DISTRICT	COUNTY
PS	TEXAS	AMA	POTTER
CHECK	CONTROL	SECTION	JOB
MF	0904	02	047
CHECK	FS		


SHEET NO. 078

DISCLAIMER: The use of this standard is governed by the "Texas Engineering Practice Act". No warranty of any kind is made by TxDOT for any purpose whatsoever. TxDOT assumes no responsibility for the conversion of this standard to other formats or for incorrect results or damages resulting from its use.


DATE:
FILE:

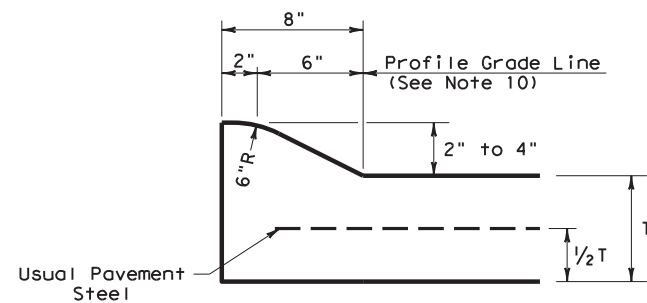


TYPE I CURB (MONOLITHIC)
2" - 4" HEIGHT

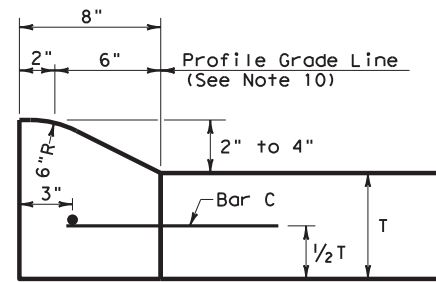


TYPE I CURB
2" - 4" HEIGHT

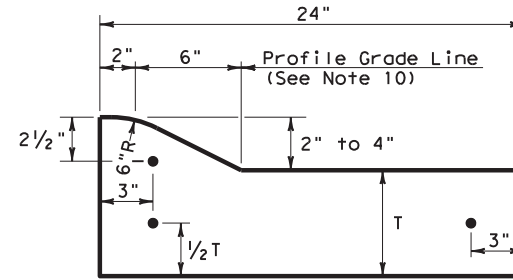


TYPE I CURB AND GUTTER
2" - 4" HEIGHT

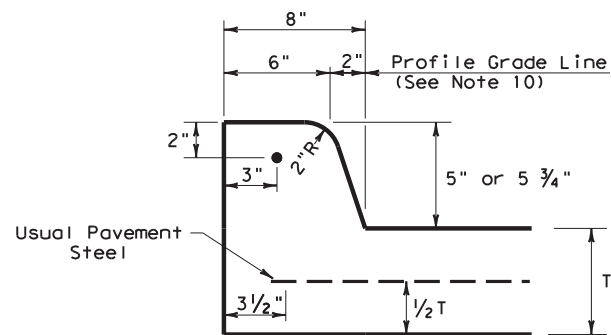


TYPE II CURB (MONOLITHIC)
5" - 5 3/4" HEIGHT

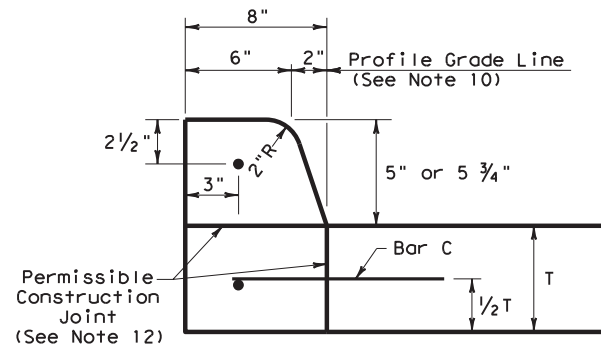


TYPE II CURB
5" - 5 3/4" HEIGHT

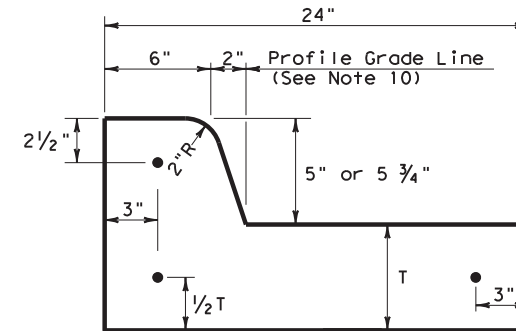


TYPE II CURB AND GUTTER
5" - 5 3/4" HEIGHT

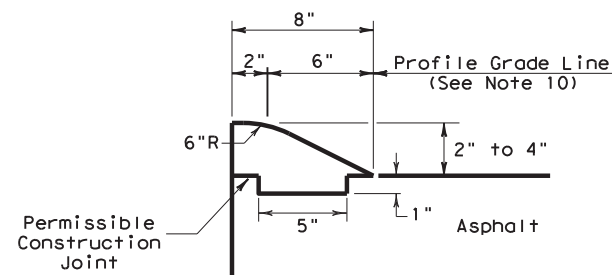


TYPE III CURB (KEYED)
2" - 4" HEIGHT

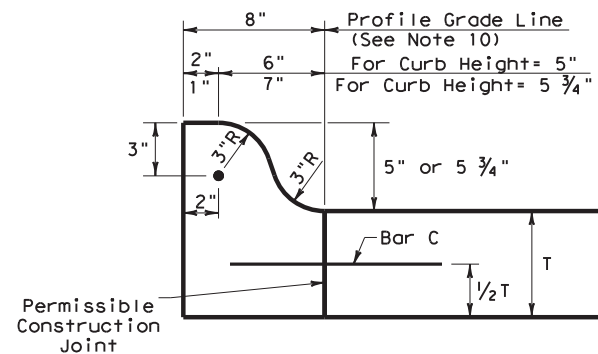


TYPE IIa CURB
5" - 5 3/4" HEIGHT

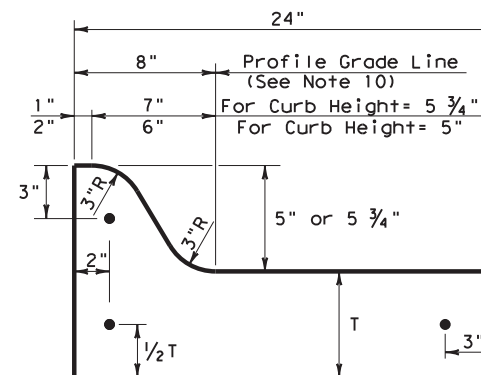


TYPE IIa CURB AND GUTTER
5" - 5 3/4" HEIGHT

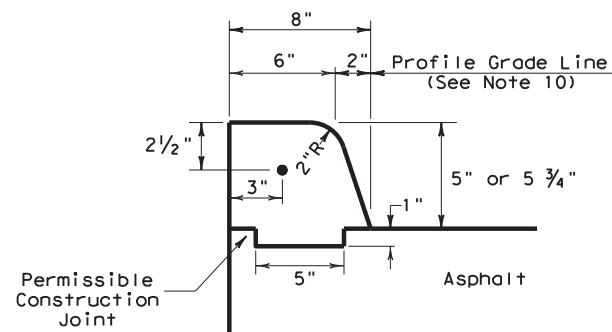

TYPE IV CURB (KEYED)
5" - 5 3/4" HEIGHT

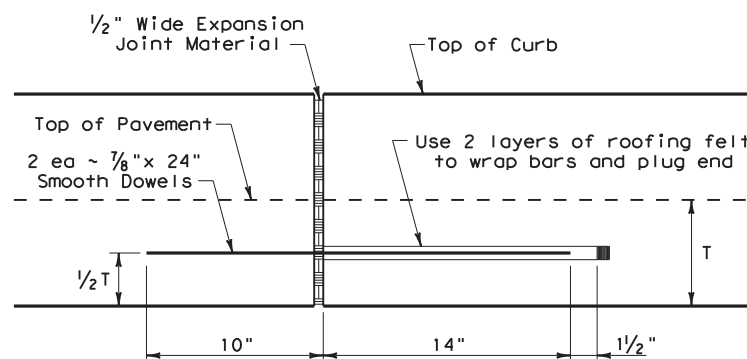

EXPANSION JOINT DETAIL

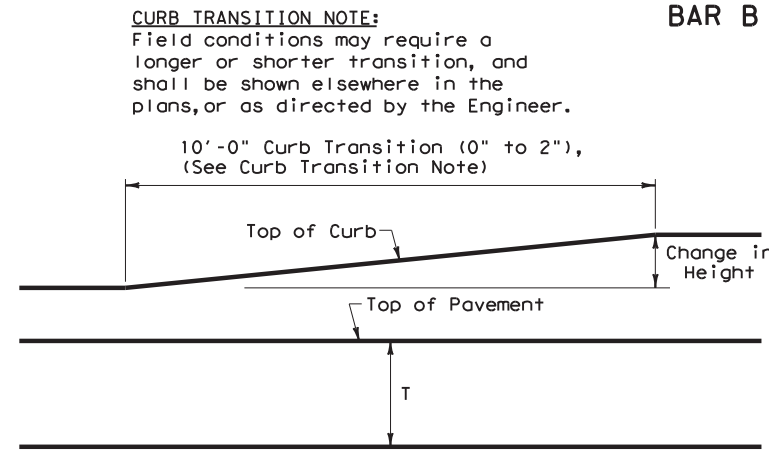


CURB TRANSITION

Note: To be paid for as Highest Curb

GENERAL NOTES

- All materials and construction shall be in accordance with Item 529, "Concrete Curb, Gutter, and Combined Curb and Gutter."
- Concrete shall be Class A.
- When reinforcing bars are used, they shall be No.4 unless otherwise shown. The use of fiber reinforced concrete in lieu of reinforcing steel is acceptable. Use fibers meeting the requirements of DMS 4550, "Fibers for Concrete," and dose fibers in accordance with Material Producers List (MPL) "Fibers for Class A and B Concrete Applications."
- Round exposed sharp edges with a rounding tool, to a minimum radius of 1/4 inch.
- All existing curbs and driveways to be removed shall be sawed or removed at existing joints.
- Where concrete curb is to be placed on existing concrete pavement, Bar B may be drilled and the grouted in place, or may be inserted into fresh concrete.
- Expansion and contraction joints shall be constructed to match pavement joints in all curbs and curb and gutter adjacent to jointed concrete pavement. Where placement of curb or curb and gutter is not adjacent to concrete pavement, expansion joints shall be provided at structures, curb returns at streets, and at locations directed by The Engineer.
- Vertical and horizontal dowel bars and transverse reinforcing bars shall be placed at four feet C-C.
- Dimension 'T' shown is the thickness of concrete pavement. When curb is installed adjacent to flexible pavement dimension 'T' is 8" maximum.
- Usual profile grade line. Refer to typical sections and plan-profile sheets for exact locations.
- One-half inch expansion joint material shall be provided where curb or curb and gutter is adjacent to sidewalk or riprap.
- When horizontal permissible construction joints are used, the longitudinal pavement steel shall be placed in accordance with pavement details shown elsewhere in the plans. Reinforcing steel for curb section shall then conform to that required for concrete curb.
- Bar B used as needed to support curb reinforcing steel during concrete placement.











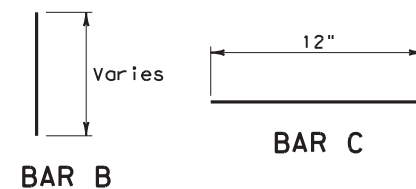


CURB TRANSITION NOTE:
Field conditions may require a longer or shorter transition, and shall be shown elsewhere in the plans, or as directed by the Engineer.

				Design Division Standard	
CONCRETE CURB AND GUTTER					
CCCG-21					
FILE: cccg21.dgn	DN: TxDOT	CK: AN	DW: SS	CK: KM	
© TxDOT: FEBRUARY 2021	CONT	SECT	JOB	HIGHWAY	
REVISIONS	0904	02	047	VARIOUS	
	DIST	COUNTY		SHEET NO.	
	AMA	POTTER		079	

DISCLAIMER: The use of this standard is governed by the "Texas Engineering Practice Act". No warranty of any kind is made by TxDOT for any purpose whatsoever. TxDOT assumes no responsibility for the conversion of this standard to other formats or for incorrect results or damages resulting from its use.

DATE:
FILE:

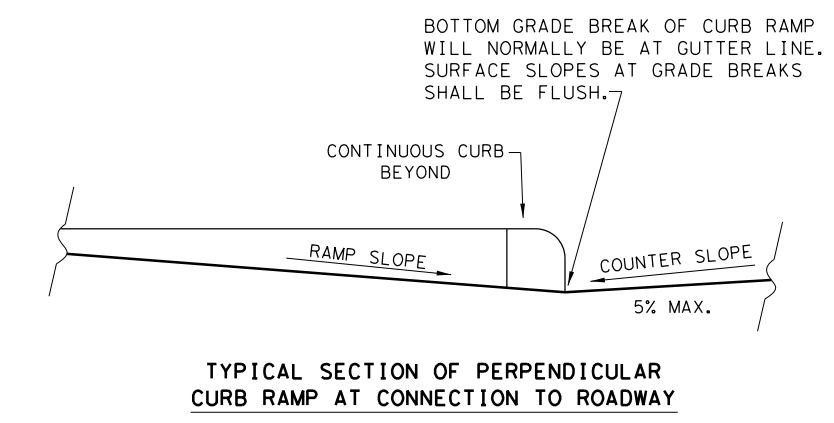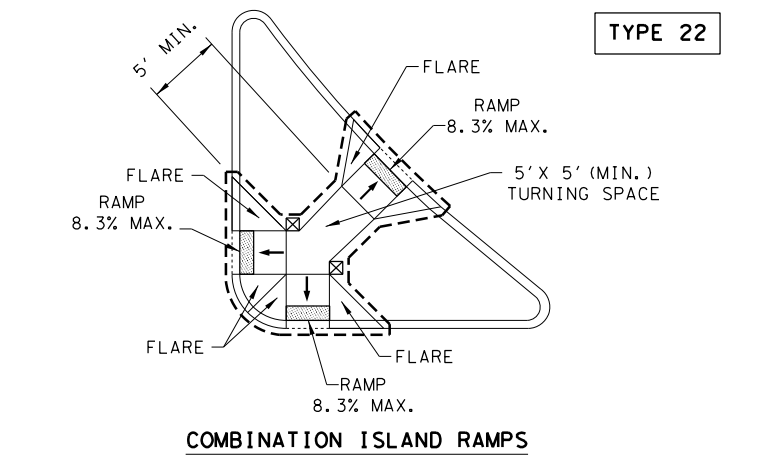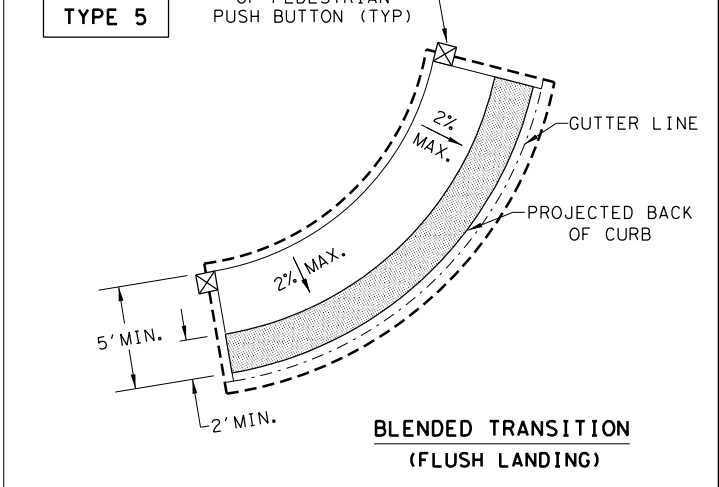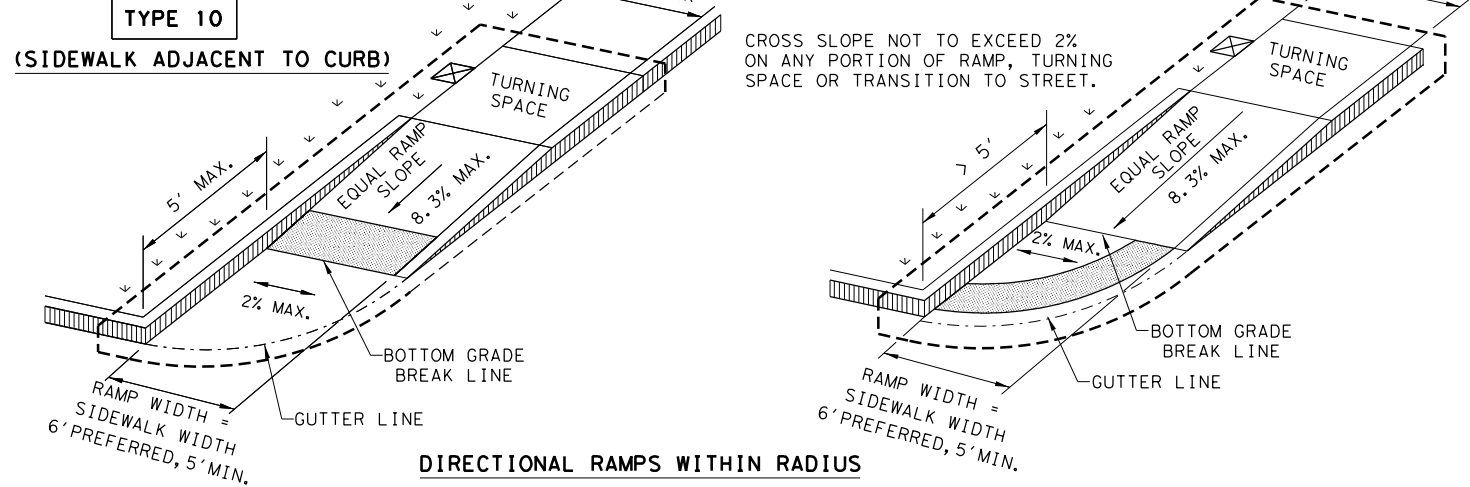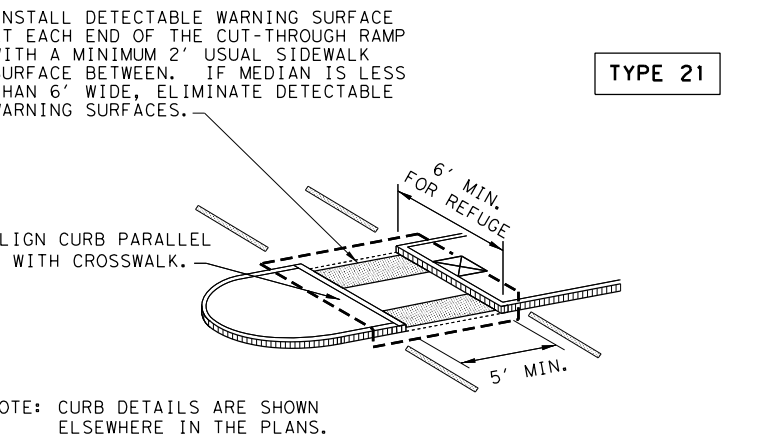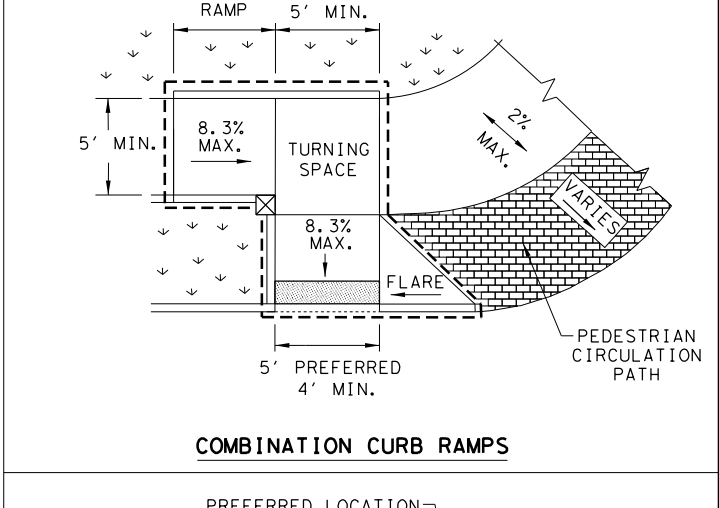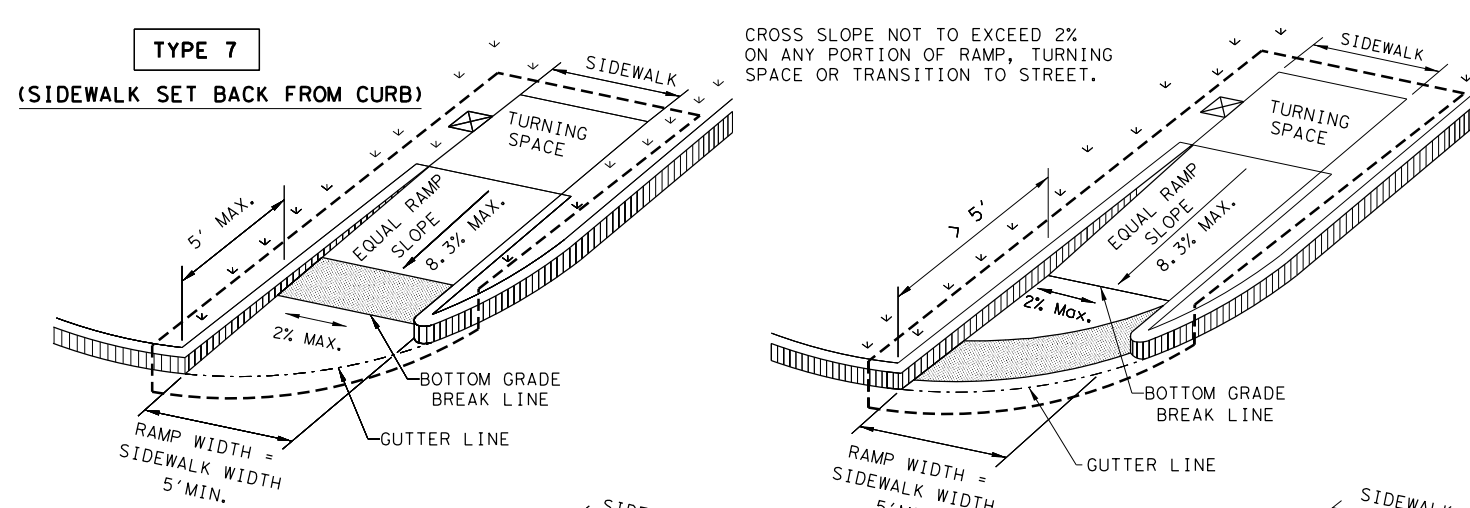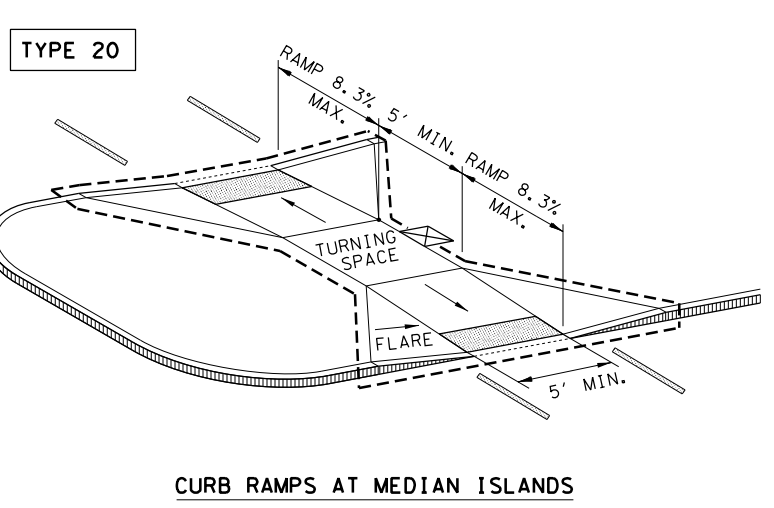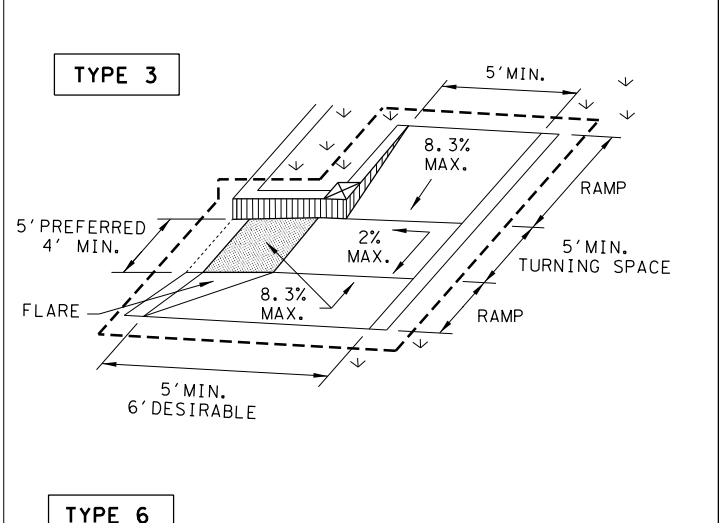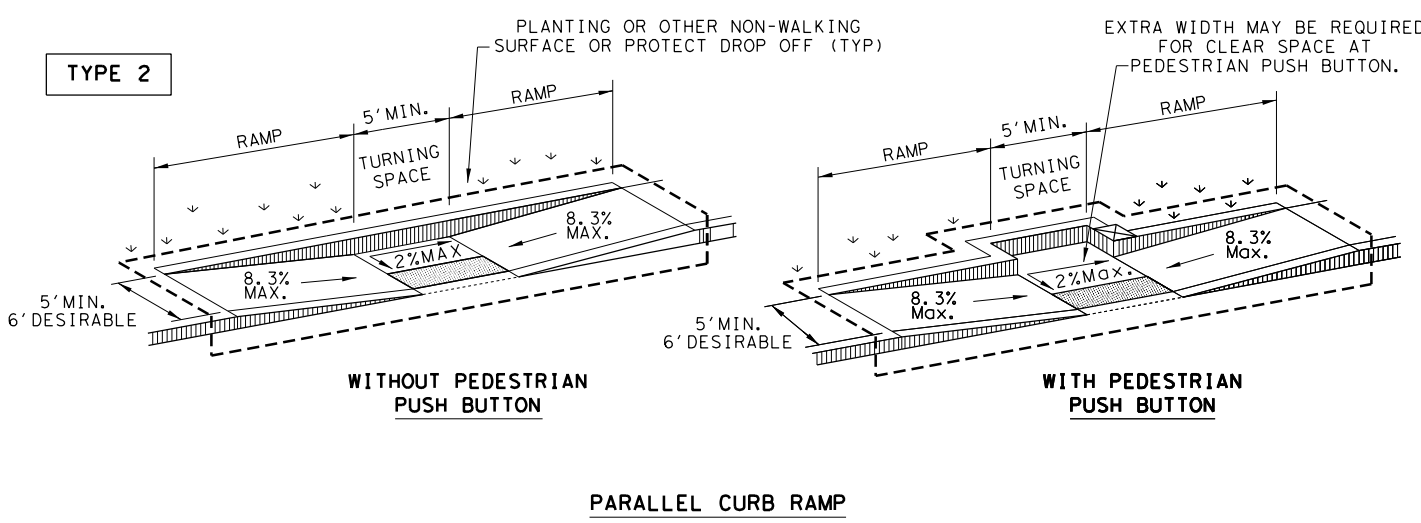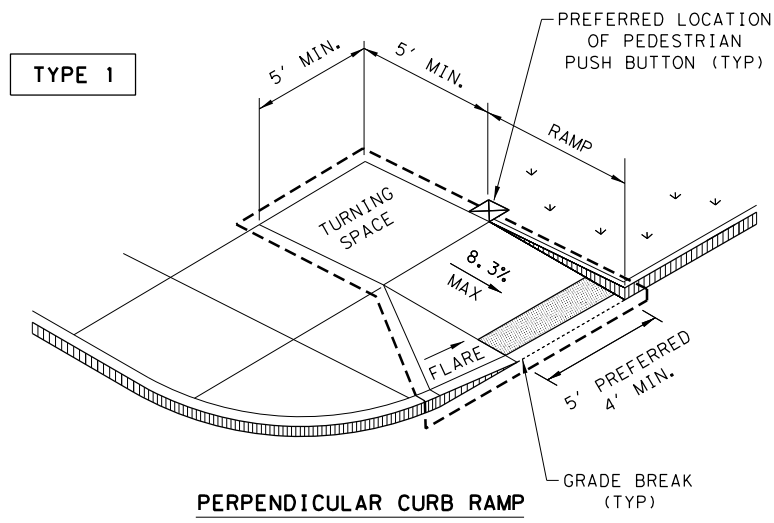

NOTES / LEGEND:

SEE GENERAL NOTES ON SHEET 2 OF 4 FOR MORE INFORMATION.

DENOTES PLANTING OR NON-WALKING SURFACE NOT PART OF PEDESTRIAN CIRCULATION PATH.

DENOTES PREFERRED LOCATION OF PEDESTRIAN PUSH BUTTON IF APPLICABLE.

DENOTES PLANTING OR NON-WALKING SURFACE NOT PART OF PEDESTRIAN CIRCULATION PATH.

DENOTES PREFERRED LOCATION OF PEDESTRIAN PUSH BUTTON IF APPLICABLE.

DENOTES PLANTING OR NON-WALKING SURFACE NOT PART OF PEDESTRIAN CIRCULATION PATH.

DENOTES PREFERRED LOCATION OF PEDESTRIAN PUSH BUTTON IF APPLICABLE.

DENOTES PLANTING OR NON-WALKING SURFACE NOT PART OF PEDESTRIAN CIRCULATION PATH.

DENOTES PREFERRED LOCATION OF PEDESTRIAN PUSH BUTTON IF APPLICABLE.

SHEET 1 OF 4

Texas Department of Transportation

Design Division Standard

PEDESTRIAN FACILITIES CURB RAMPS

PED-18

FILE: ped18	DN: TxDOT	DW: VP	CK: KM	CK: PK & JG
© TxDOT: MARCH, 2002	CONT	SECT	JOB	HIGHWAY
REVISIONS	904	02	047	VARIOUS
REVISED 08, 2009	DIST	COUNTY	SHEET NO.	
REVISED 06, 2012	AMA	POTTER	080	
REVISED 01, 2018				

DISCLAIMER: The use of this standard is governed by the "Texas Engineering Practice Act". No warranty of any kind is made by TxDOT for any purpose whatsoever. TxDOT assumes no responsibility for the conversion of this standard to other formats or for incorrect results or damages resulting from its use.

GENERAL NOTES

CURB RAMP

1. Install a curb ramp or blended transition at each pedestrian street crossing.
2. All slopes shown are maximum allowable. Cross slopes of 1.5% and lesser running should be used. Adjust curb ramp length or grade of approach sidewalks as directed.
3. Maximum allowable cross slope on sidewalk and curb ramp surfaces is 2%.
4. The minimum sidewalk width is 5'. Where the sidewalk is adjacent to the back of curb, a 6' sidewalk width is desirable. Where a 5' sidewalk cannot be provided due to site constraints, sidewalk width may be reduced to 4' for short distances. 5' x 5' passing areas at intervals not to exceed 200' are required.
5. Turning Spaces shall be 5' x 5' minimum. Cross slope shall be maximum 2%.
6. Clear space at the bottom of curb ramps shall be a minimum of 4' x 4' wholly contained within the crosswalk and wholly outside the parallel vehicular travel path.
7. Provide flared sides where the pedestrian circulation path crosses the curb ramp. Flared sides shall be sloped at 10% maximum, measured parallel to the curb. Returned curbs may be used only where pedestrians would not normally walk across the ramp, either because the adjacent surface is planted, substantially obstructed, or otherwise protected.
8. Additional information on curb ramp location, design, light reflective value and texture may be found in the latest draft of the Proposed Guidelines for Pedestrian Facilities in the Public Right of Way (PROWAG) as published by the U.S. Architectural and Transportation Barriers Compliance Board (Access Board).
9. To serve as a pedestrian refuge area, the median should be a minimum of 6' wide, measured from back of curbs. Medians should be designed to provide accessible passage over or through them.
10. Small channelization islands, which do not provide a minimum 5' x 5' landing at the top of curb ramps, shall be cut through level with the surface of the street.
11. Crosswalk dimensions, crosswalk markings and stop bar locations shall be as shown elsewhere in the plans. At intersections where crosswalk markings are not required, curb ramps shall align with theoretical crosswalks unless otherwise directed.
12. Provide curb ramps to connect the pedestrian access route at each pedestrian street crossing. Handrails are not required on curb ramps.
13. Curb ramps and landings shall be constructed and paid for in accordance with Item 531 "Sidewalks".
14. Place concrete at a minimum depth of 5" for ramps, flares and landings, unless otherwise directed.
15. Furnish and install No. 3 reinforcing steel bars at 18" o.c. both ways, unless otherwise directed.
16. Provide a smooth transition where the curb ramps connect to the street.
17. Curbs shown on sheet 1 within the limits of payment are considered part of the curb ramp for payment, whether it is concrete curb, gutter, or combined curb and gutter.
18. Existing features that comply with applicable standards may remain in place unless otherwise shown on the plans.

DETECTABLE WARNING MATERIAL


19. Curb ramps must contain a detectable warning surface that consists of raised truncated domes complying with PROWAG. The surface must contrast visually with adjoining surfaces, including side flares. Furnish and install an approved cast-in-place dark brown or dark red detectable warning surface material adjacent to uncolored concrete, unless specified elsewhere in the plans.
20. Detectable Warning Materials must meet TxDOT Departmental Materials Specification DMS 4350 and be listed on the Material Producer List. Install products in accordance with manufacturer's specifications.
21. Detectable warning surfaces must be firm, stable and slip resistant.
22. Detectable warning surfaces shall be a minimum of 24 inches in depth in the direction of pedestrian travel, and extend the full width of the curb ramp or landing where the pedestrian access route enters the street.
23. Detectable warning surfaces shall be located so that the edge nearest the curb line is at the back of curb and neither end of that edge is greater than 5 feet from the back of curb. Detectable warning surfaces may be curved along the corner radius.
24. Shaded areas on Sheet 1 of 4 indicate the approximate location for the detectable warning surface for each curb ramp type.

DETECTABLE WARNING PAVERS (IF USED)

25. Furnish detectable warning paver units meeting all requirements of ASTM C-936, C-33. Lay in a two by two unit basket weave pattern or as directed.
26. Lay full-size units first followed by closure units consisting of at least 25 percent (25%) of a full unit. Cut detectable warning paver units using a power saw.




SIDEWALKS

27. Provide clear ground space at operable parts, including pedestrian push buttons. Operable parts shall be placed within unobstructed reach range specified in PROWAG section R406.
28. Place traffic signal or illumination poles, ground boxes, controller boxes, signs, drainage facilities and other items so as not to obstruct the pedestrian access route or clear ground space.
29. Street grades and cross slopes shall be as shown elsewhere in the plans.
30. Changes in level greater than 1/4 inch are not permitted.
31. The least possible grade should be used to maximize accessibility. The running slope of sidewalks and crosswalks within the public right of way may follow the grade of the parallel roadway. Where a continuous grade greater than five percent (5%) must be provided, handrails may be desirable to improve accessibility. Handrails may also be needed to protect pedestrians from potentially hazardous conditions. If provided, handrails shall comply with PROWAG R409.
32. Handrail extensions shall not protrude into the usable landing area or into intersecting pedestrian routes.
33. Driveways and turnouts shall be constructed and paid for in accordance with Item "Intersections, Driveways and Turnouts". Sidewalks shall be constructed and paid for in accordance with Item, "Sidewalks".
34. Sidewalk details are shown elsewhere in the plans.

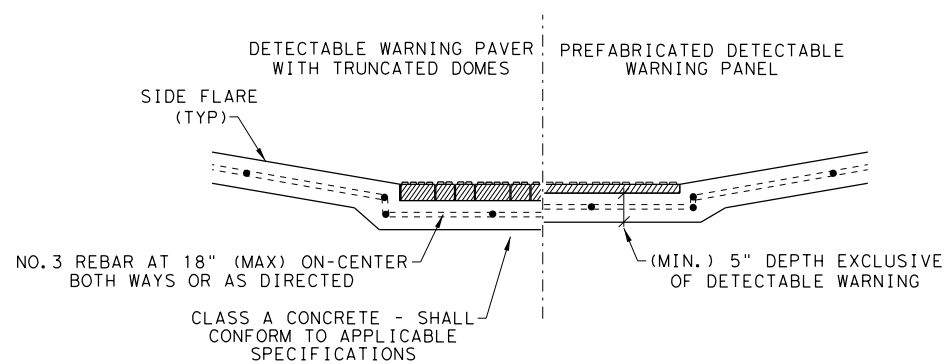

**SECTION VIEW DETAIL
CURB RAMP AT DETECTIBLE WARNINGS**

DETECTABLE WARNING SURFACE DETAILS

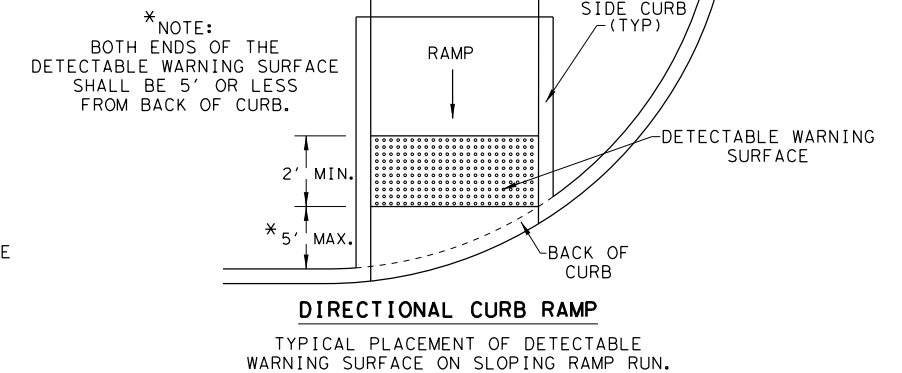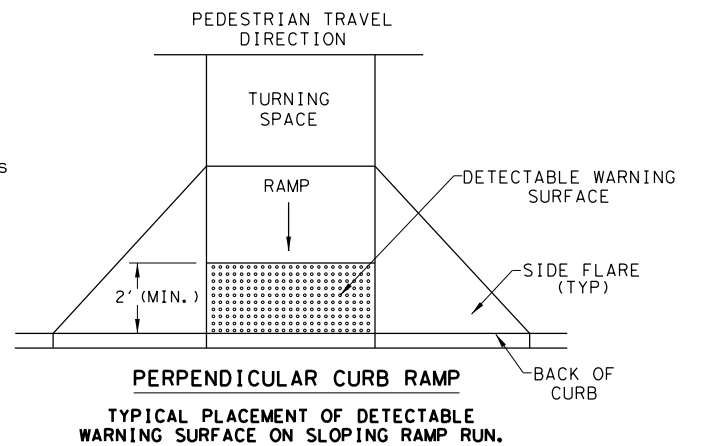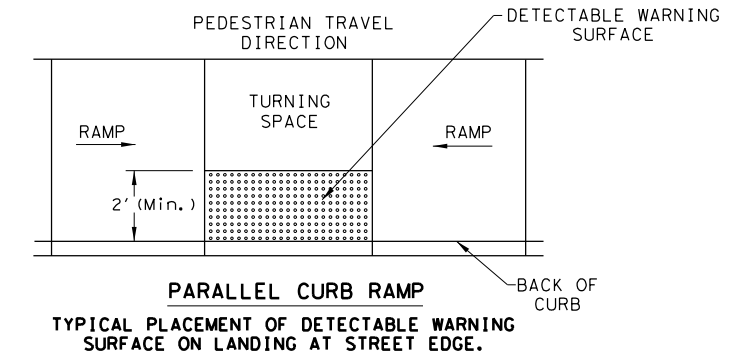





SHEET 2 OF 4

		Design Division Standard	
<h1>PEDESTRIAN FACILITIES</h1> <h2>CURB RAMPS</h2> <h3>PED-18</h3>			
FILE: ped18	DN: TxDOT	DW: VP	CK: KM
© TxDOT: MARCH, 2002	CONT	SECT	JOB
	904	02	047
REVISIONS			
REVISED 08, 2009			
REVISED 06, 2012			
REVISED 01, 2018			
	DIST	COUNTY	SHEET NO.
	AMA	POTTER	081


DATE:
FILE:

DISCLAIMER: The use of this standard is governed by the "Texas Engineering Practice Act". No warranty of any kind is made by TxDOT for any purpose whatsoever. TxDOT assumes no responsibility for the conversion of this standard to other formats or for incorrect results or damages resulting from its use.



SIDEWALK TREATMENT AT DRIVEWAYS

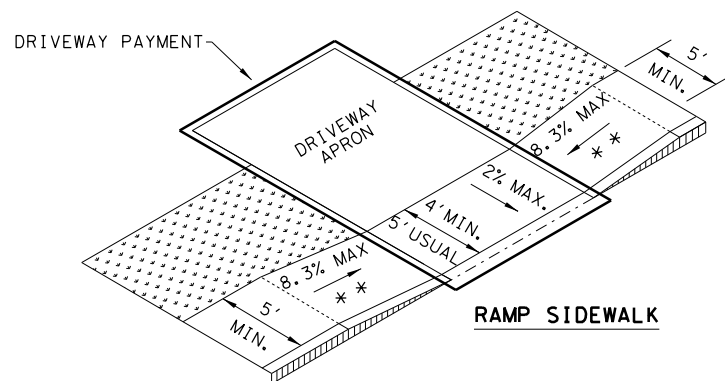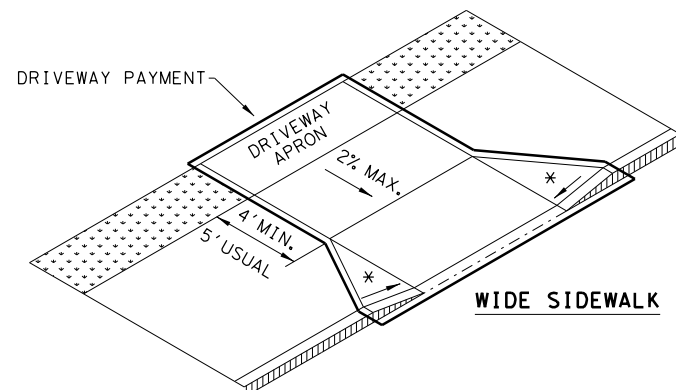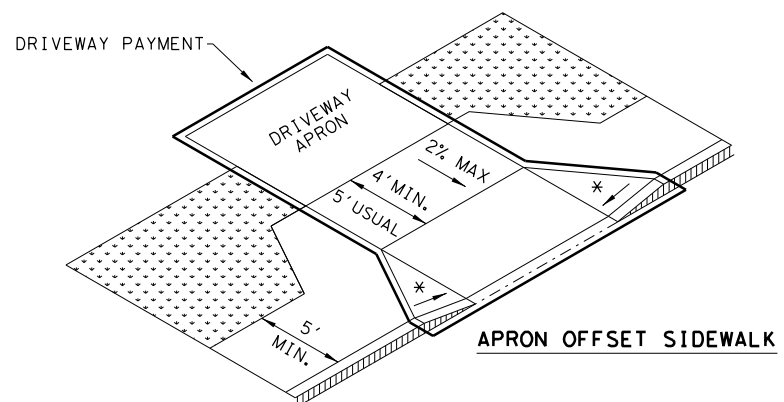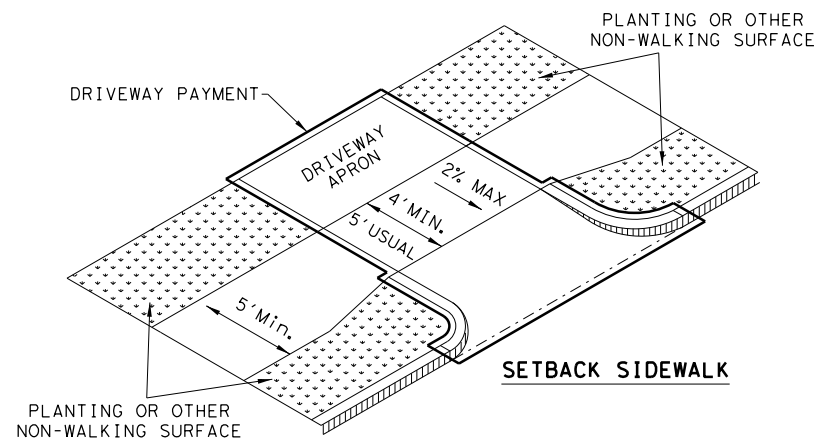

NOTES:
 * WHERE DRIVEWAYS CROSS THE PEDESTRIAN ROUTE, SIDES SHALL BE FLARED AT 10% MAX SLOPE.
 * * IF CURB HEIGHT IS GREATER THAN 6 INCHES, USE GRADE LESS THAN OR EQUAL TO 5%. HANDRAIL AND DETECTABLE WARNING ARE NOT REQUIRED.

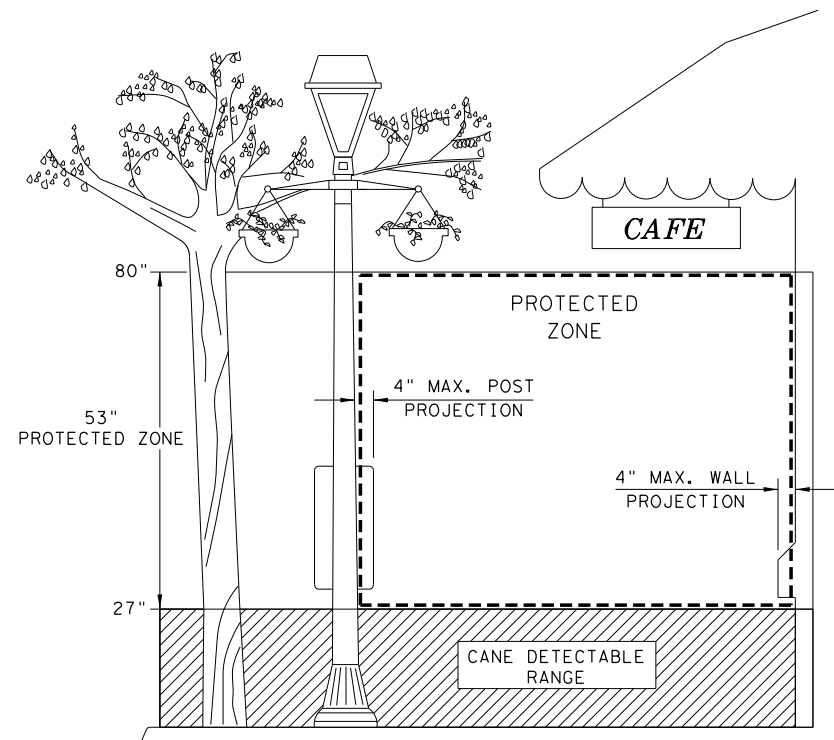


NOTE: IN PEDESTRIAN CIRCULATION AREA, MAXIMUM 4" PROJECTION FOR POST OR WALL MOUNTED OBJECTS BETWEEN 27" AND 80" ABOVE THE SURFACE.

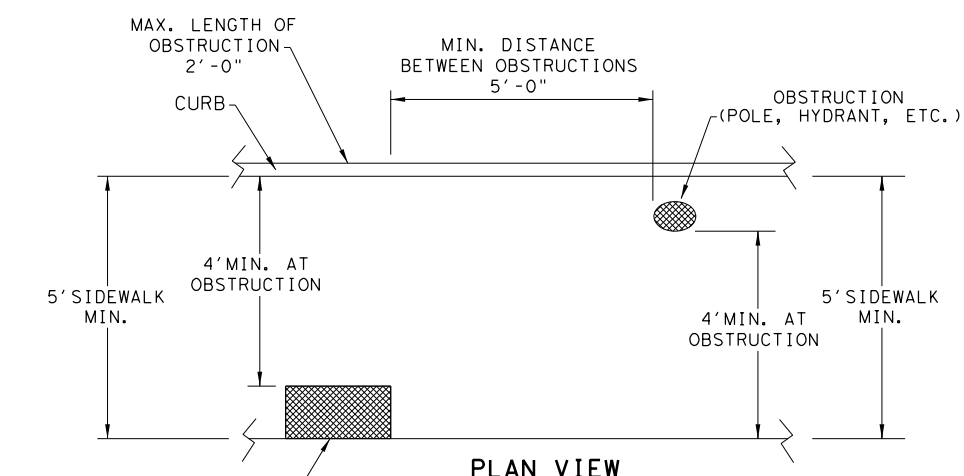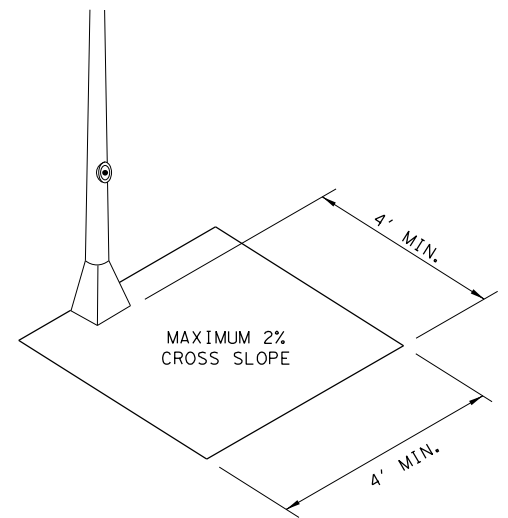

PLACEMENT OF STREET FIXTURES

NOTE: ITEMS NOT INTENDED FOR PUBLIC USE. MINIMUM 4' X 4' CLEAR GROUND SPACE REQUIRED AT PUBLIC USE FIXTURES.

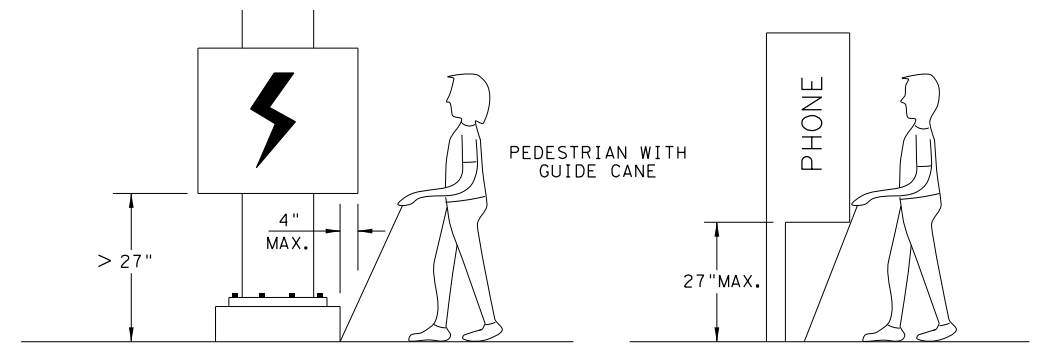

WHEN AN OBSTRUCTION OF A HEIGHT GREATER THAN 27" FROM THE SURFACE WOULD CREATE A PROTRUSION OF MORE THAN 4" INTO THE PEDESTRIAN CIRCULATION AREA, CONSTRUCT ADDITIONAL CURB OR FOUNDATION AT THE BOTTOM TO PROVIDE A MAXIMUM 4" OVERHANG.

PROTRUDING OBJECTS OF A HEIGHT ≤ 27" ARE DETECTABLE BY CANE AND DO NOT REQUIRE ADDITIONAL TREATMENT.



PEDESTRIAN FACILITIES CURB RAMPS



PED-18

FILE: ped18	DN: TxDOT	DW: VP	CK: KM	CK: PK & JG
© TxDOT: MARCH, 2002	CONT	SECT	JOB	HIGHWAY
REVISIONS	904	02	047	VARIOUS
REVISED 08, 2005	DIST	COUNTY	SHEET NO.	
REVISED 06, 2012	AMA	POTTER	082	
REVISED 01, 2018				

DATE:
FILE:


DISCLAIMER: The use of this standard is governed by the "Texas Engineering Practice Act". No warranty of any kind is made by TxDOT for any purpose whatsoever. TxDOT assumes no responsibility for the conversion of this standard to other formats or for incorrect results or damages resulting from its use.

TYPICAL CROSSING LAYOUTS
SEE SHEET 1 OF 4 FOR DETAILS AND DIMENSIONS

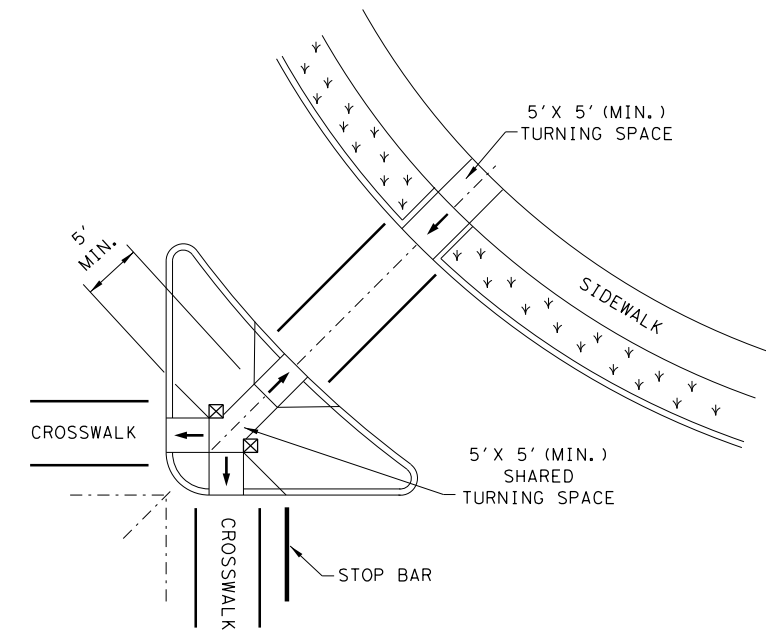
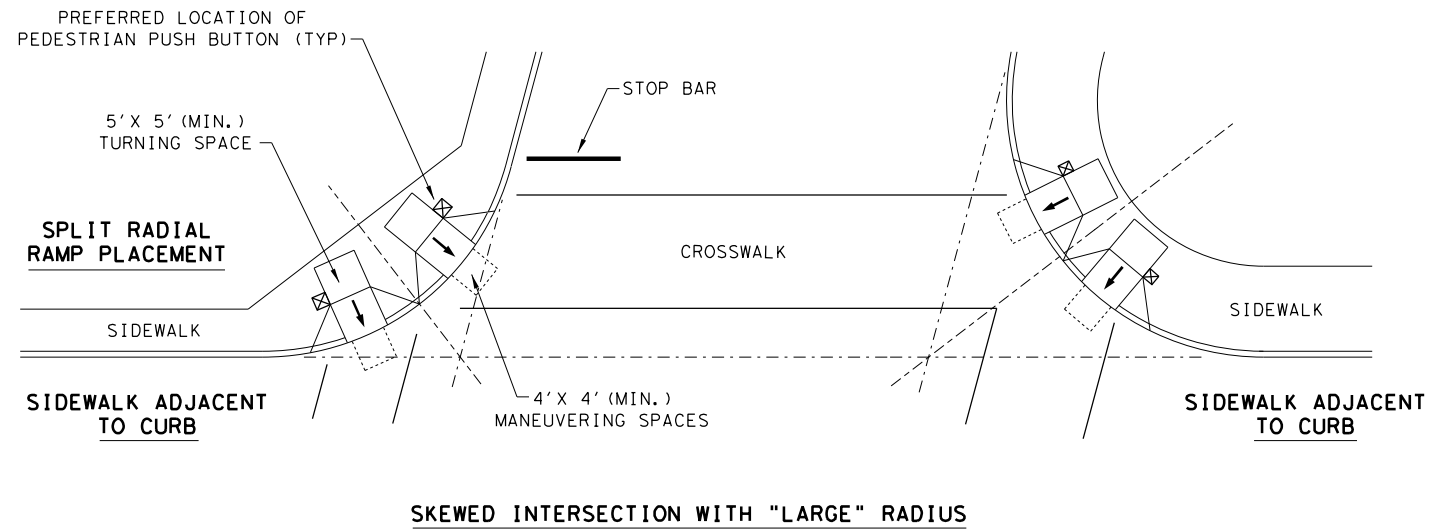


SKewed INTERSECTION WITH "LARGE" RADIUS


AT INTERSECTION
W/FREE RIGHT TURN & ISLAND

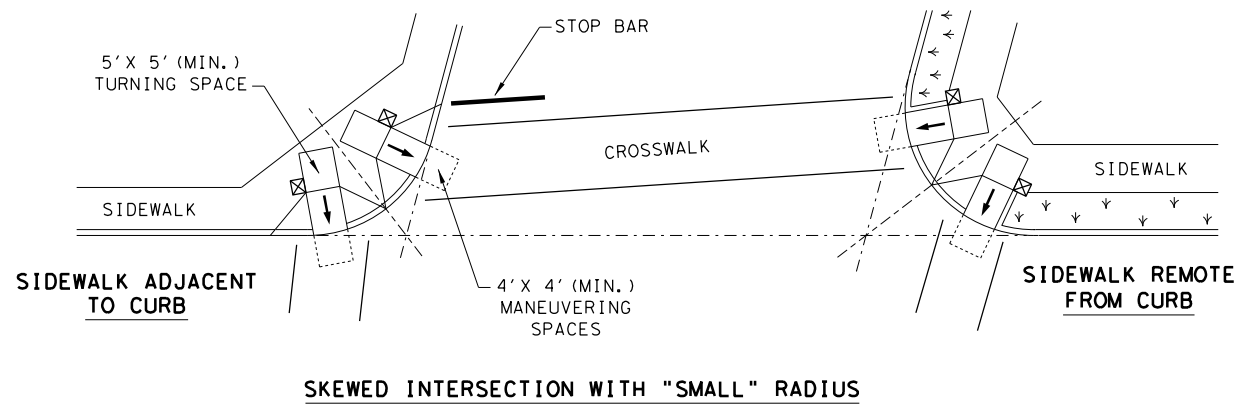

SKewed INTERSECTION WITH "SMALL" RADIUS

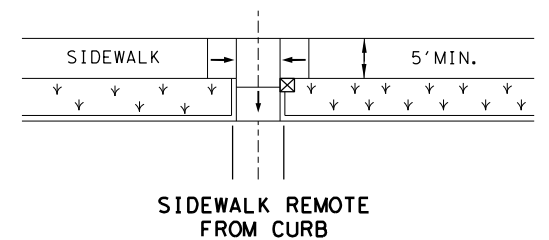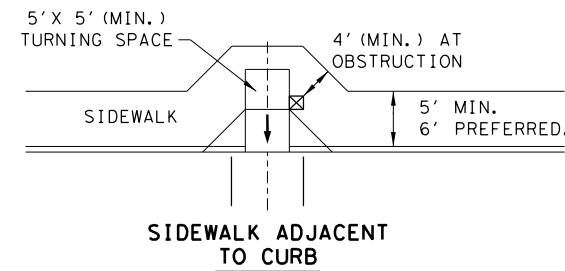

MID-BLOCK PLACEMENT
PERPENDICULAR RAMPS

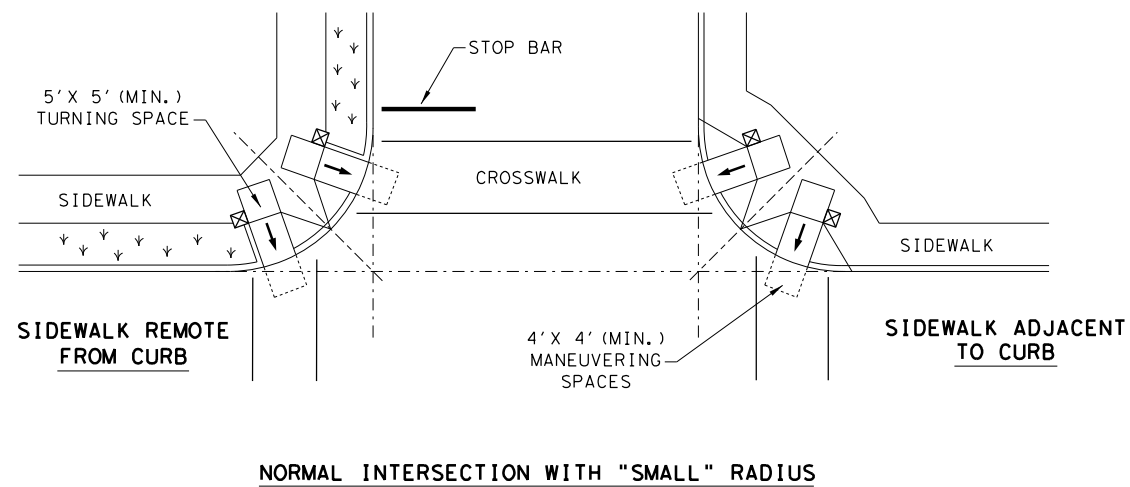

NORMAL INTERSECTION WITH "SMALL" RADIUS

LEGEND:

SHOWS DOWNWARD SLOPE. →


DENOTES PREFERRED LOCATION OF PEDESTRIAN PUSH BUTTON (IF APPLICABLE). ☒

DENOTES PLANTING OR NON-WALKING SURFACE NOT PART OF PEDESTRIAN CIRCULATION PATH. ↙ ↘ ↙ ↘ ↙ ↘


		Design Division Standard	
<h1>PEDESTRIAN FACILITIES</h1> <h2>CURB RAMPS</h2> <h3>PED-18</h3>			
FILE: ped18	DN: TxDOT	DW: VP	CK: KM
© TxDOT: MARCH, 2002	CON: 904	SECT: 02	JOB: 047
REVISIONS	DIST: COUNTY		SHEET NO.
REVISED 08, 2005	AMA POTTER		083
REVISED 06, 2012			
REVISED 01, 2018			

DATE:
FILE:


DISCLAIMER: The use of this standard is governed by the "Texas Engineering Practice Act". No warranty of any kind is made by TxDOT for any purpose whatsoever. TxDOT assumes no responsibility for the conversion of this standard to other formats or for incorrect results or damages resulting from its use.

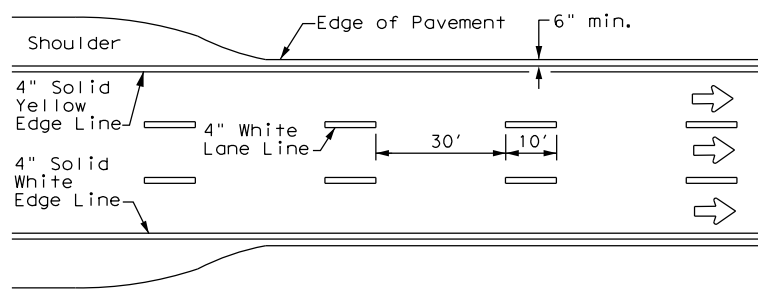


**EDGE LINE AND LANE LINES
ONE-WAY ROADWAY
WITH OR WITHOUT SHOULDERS**

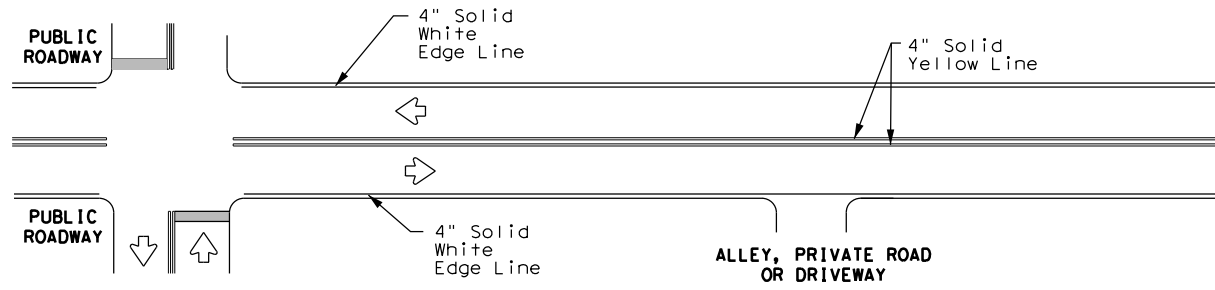


**TYPICAL TWO-LANE, TWO-WAY PAVEMENT
MARKINGS THROUGH INTERSECTIONS**

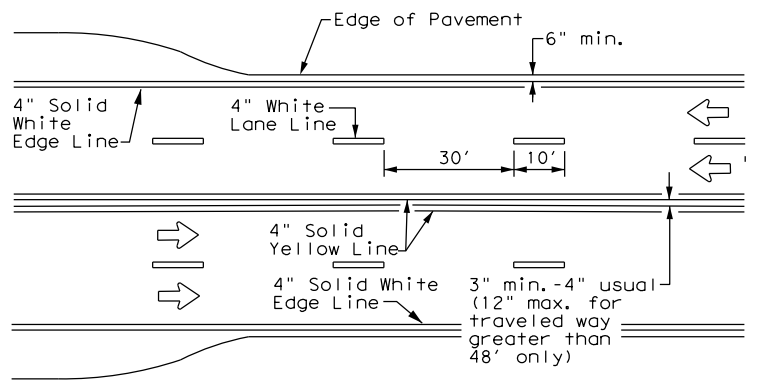


**CENTERLINE AND LANE LINES
FOUR LANE TWO-WAY ROADWAY
WITH OR WITHOUT SHOULDERS**

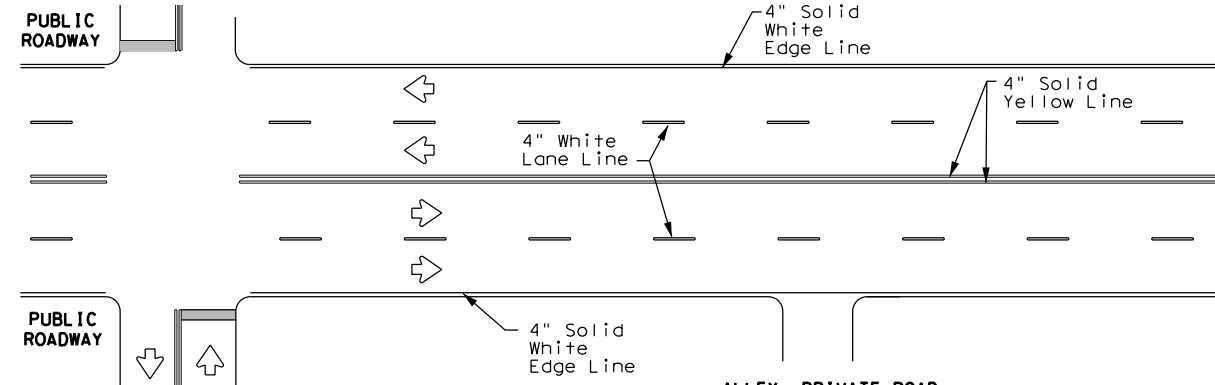


**TYPICAL MULTI-LANE, TWO-WAY PAVEMENT
MARKINGS THROUGH INTERSECTIONS**

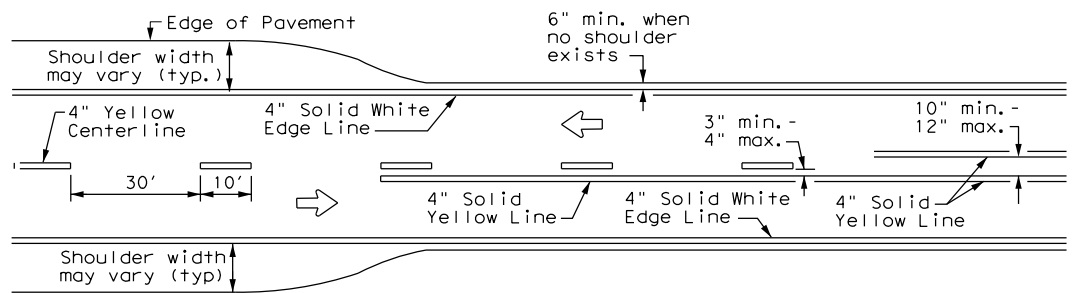

**TWO LANE TWO-WAY ROADWAY
WITH OR WITHOUT SHOULDERS**

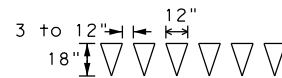


For posted speed on road being marked equal to or less than 40 MPH.

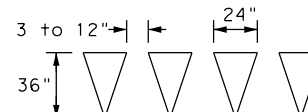

For posted speed on road being marked equal to or greater than 45 MPH.

YIELD LINES

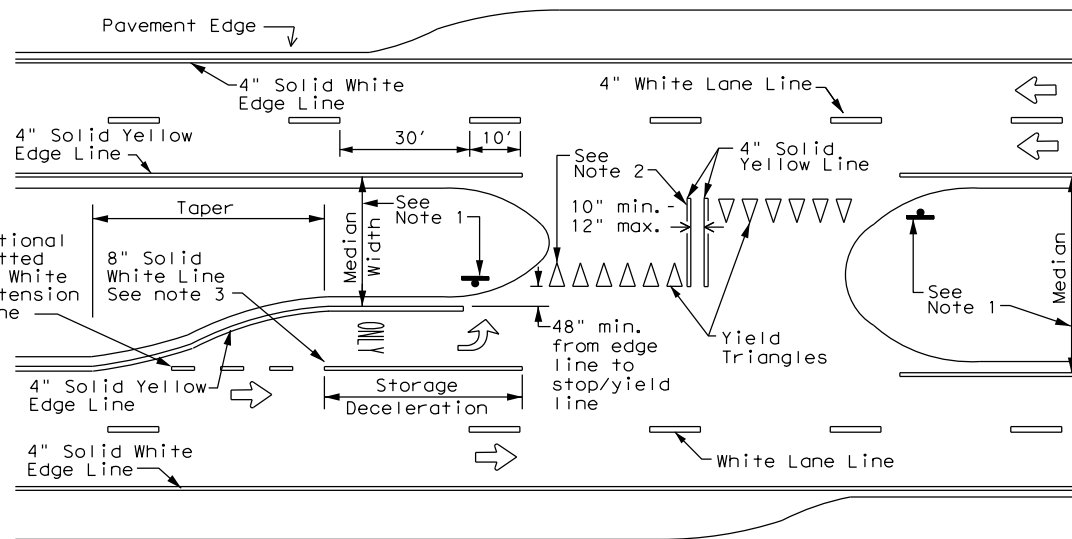

FOUR LANE DIVIDED ROADWAY CROSSOVERS

NOTES

- Where divided highways are separated by median widths at the median opening itself of 30 feet or more, median openings shall be signed as two separate intersections. Each median opening has two width measurements, with one measurement for each approach. The narrow median width will be the controlling width to determine if signs are required. Yield signs are the typical intersection control. Stop signs are optional as determined by the Engineer.
- Install median striping (double yellow centerlines and stop bars/yield triangles) when a 50' or greater median centerline can be placed. Stop bars shall only be used with stop signs. Yield triangles shall only be used with yield signs.
- Length of turn bays, including taper, deceleration, and storage lengths shall be as shown on the plans or as directed by the Engineer.


GENERAL NOTES

- Edgeline striping shall be as shown in the plans or as directed by the Engineer. The edgeline should not be placed less than 6 inches from the edge of pavement. This distance may vary due to pavement raveling or other conditions. Edgelines are not required in curb and gutter sections of roadways.
- The traveled way includes only that portion of the roadway used for vehicular travel. It does not include the parking lanes, sidewalks, berms and shoulders. The traveled ways shall be measured from the inside of edgeline to the inside of edgeline of a two lane roadway.

MATERIAL SPECIFICATIONS

PAVEMENT MARKERS (REFLECTORIZED)	DMS-4200
EPOXY AND ADHESIVES	DMS-6100
BITUMINOUS ADHESIVE FOR PAVEMENT MARKERS	DMS-6130
TRAFFIC PAINT	DMS-8200
HOT APPLIED THERMOPLASTIC	DMS-8220
PERMANENT PREFABRICATED PAVEMENT MARKINGS	DMS-8240

All pavement marking materials shall meet the required Departmental Material Specifications as specified by the plans.

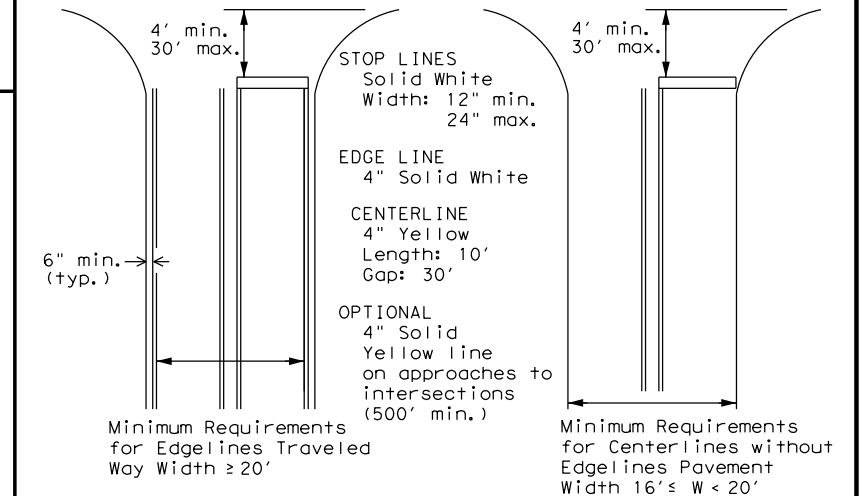

**GUIDE FOR PLACEMENT OF STOP LINES,
EDGE LINE & CENTERLINE**

Based on Traveled Way and Pavement Widths for Undivided Highways



**TYPICAL STANDARD
PAVEMENT MARKINGS**


PM(1)-20

FILE: pml-20.dgn	DN:	CK:	DW:	CK:
© TxDOT November 1978	CONT	SECT	JOB	HIGHWAY
8-95 3-03 REVISIONS	904	02	047	VARIOUS
5-00 2-12	DIST	COUNTY	SHEET NO.	
8-00 6-20	AMA	POTTER	084	


DATE:
FILE:

REFLECTIVE RAISED PAVEMENT MARKERS FOR VEHICLE POSITIONING GUIDANCE



DISCLAIMER: The use of this standard is governed by the "Texas Engineering Practice Act". No warranty of any kind is made by TxDOT for any purpose whatsoever. TxDOT assumes no responsibility for the conversion of this standard to other formats or for incorrect results or damages resulting from its use.

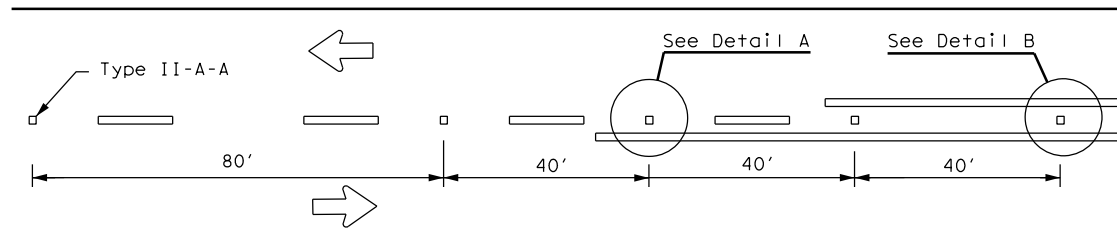


CENTERLINE FOR ALL TWO LANE ROADWAYS

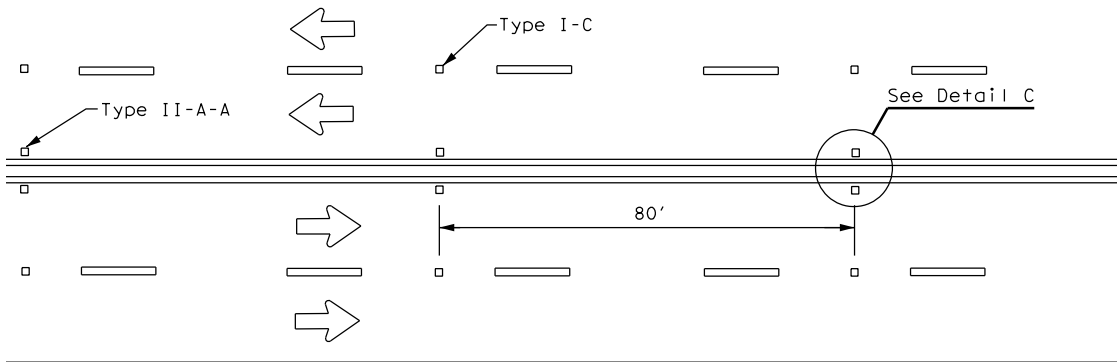

**CENTERLINE & LANE LINES
FOR FOUR LANE TWO-WAY HIGHWAYS**

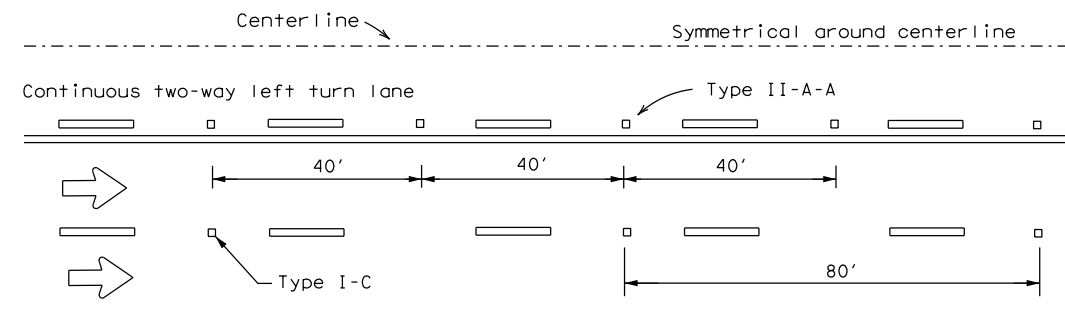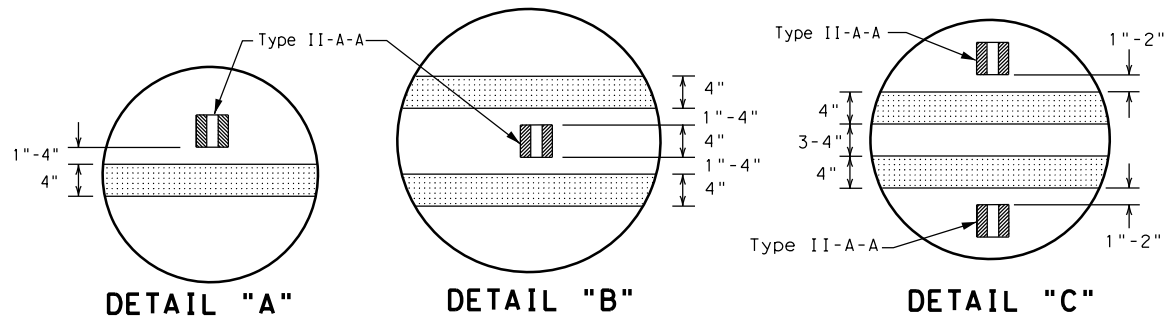

CENTERLINE AND LANE LINES FOR TWO-WAY LEFT TURN LANE

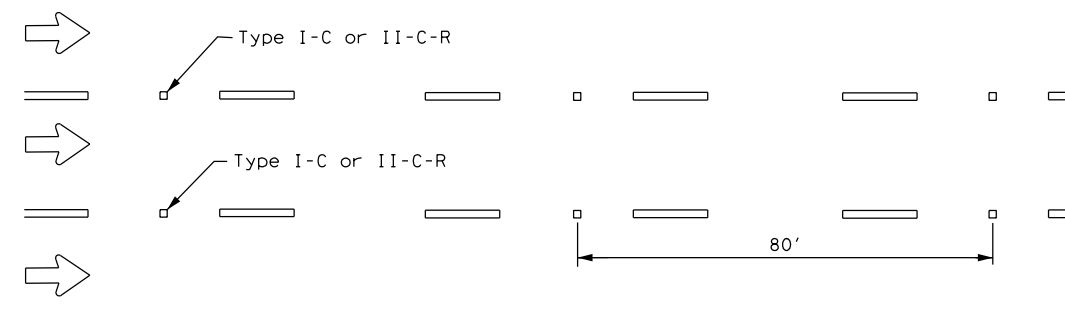


LANE LINES FOR ONE-WAY ROADWAY (NON-FREEWAY FACILITIES)


Raised pavement markers Type II-C-R shall have clear face toward normal traffic and red face toward wrong-way traffic.

MATERIAL SPECIFICATIONS	
PAVEMENT MARKERS (REFLECTORIZED)	DMS-4200
EPOXY AND ADHESIVES	DMS-6100
BITUMINOUS ADHESIVE FOR PAVEMENT MARKERS	DMS-6130
TRAFFIC PAINT	DMS-8200
HOT APPLIED THERMOPLASTIC	DMS-8220
PERMANENT PREFABRICATED PAVEMENT MARKINGS	DMS-8240


All pavement marking materials shall meet the required Departmental Material Specifications as specified by the plans.

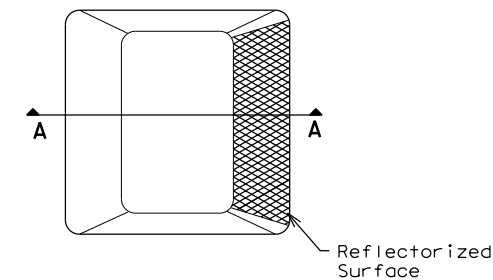

Type I (Top View)

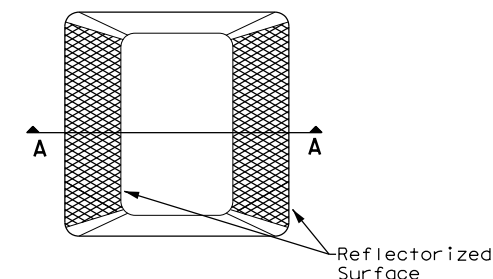

Type II (Top View)

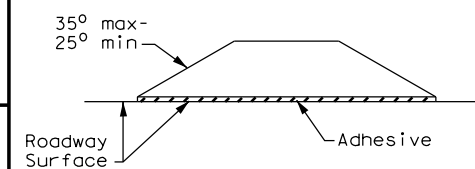

SECTION A

RAISED PAVEMENT MARKERS




POSITION GUIDANCE USING RAISED MARKERS REFLECTORIZED PROFILE MARKINGS PM(2) - 20

FILE: pm2-20.dgn	DN:	CK:	DW:	CK:
© TxDOT April 1977	CONT	SECT	JOB	HIGHWAY
4-92 2-10 REVISIONS	904	02	047	VARIOUS
5-00 2-12	DIST	COUNTY	SHEET NO.	
8-00 6-20	AMA	POTTER	085	


GENERAL NOTES

- All raised pavement markers placed in broken lines shall be placed in line with and midway between the stripes.
- On concrete pavements the raised pavement markers should be placed to one side of the longitudinal joints.

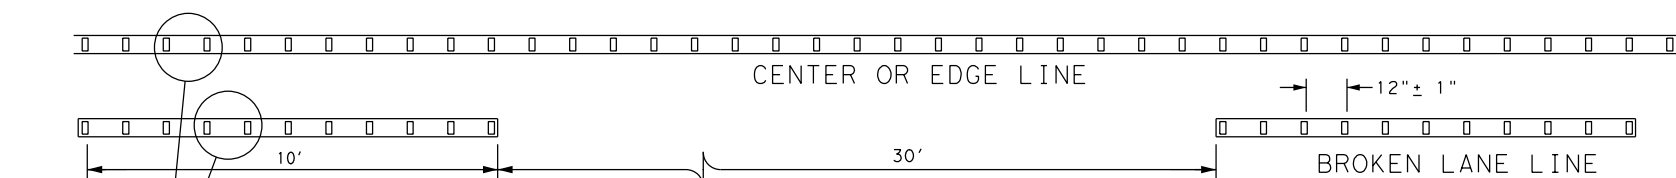

REFLECTORIZED PROFILE PATTERN DETAIL

USING REFLECTIVE PROFILE PAVEMENT MARKINGS

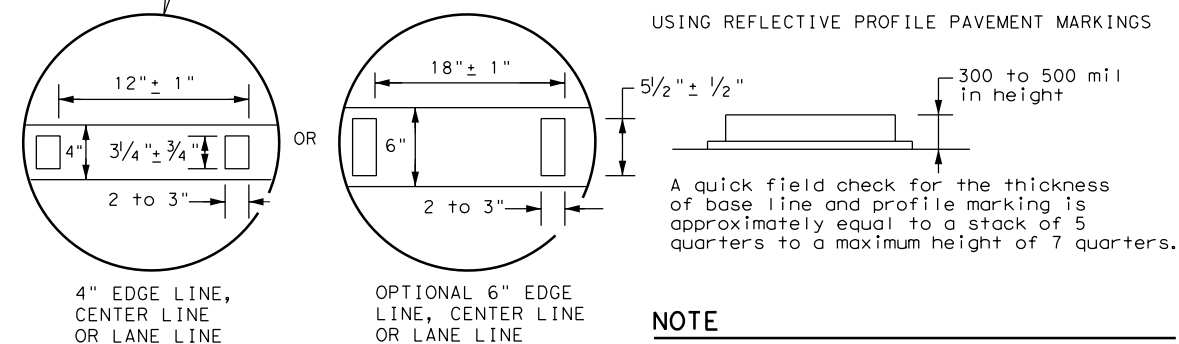


NOTE

Profile markings shall not be placed on roadways with a posted speed limit of 45 MPH or less.

DATE:
FILE:

DISCLAIMER: The use of this standard is governed by the "Texas Engineering Practice Act". No warranty of any kind is made by TxDOT for any purpose whatsoever. TxDOT assumes no responsibility for the conversion of this standard to other formats or for incorrect results or damages resulting from its use.

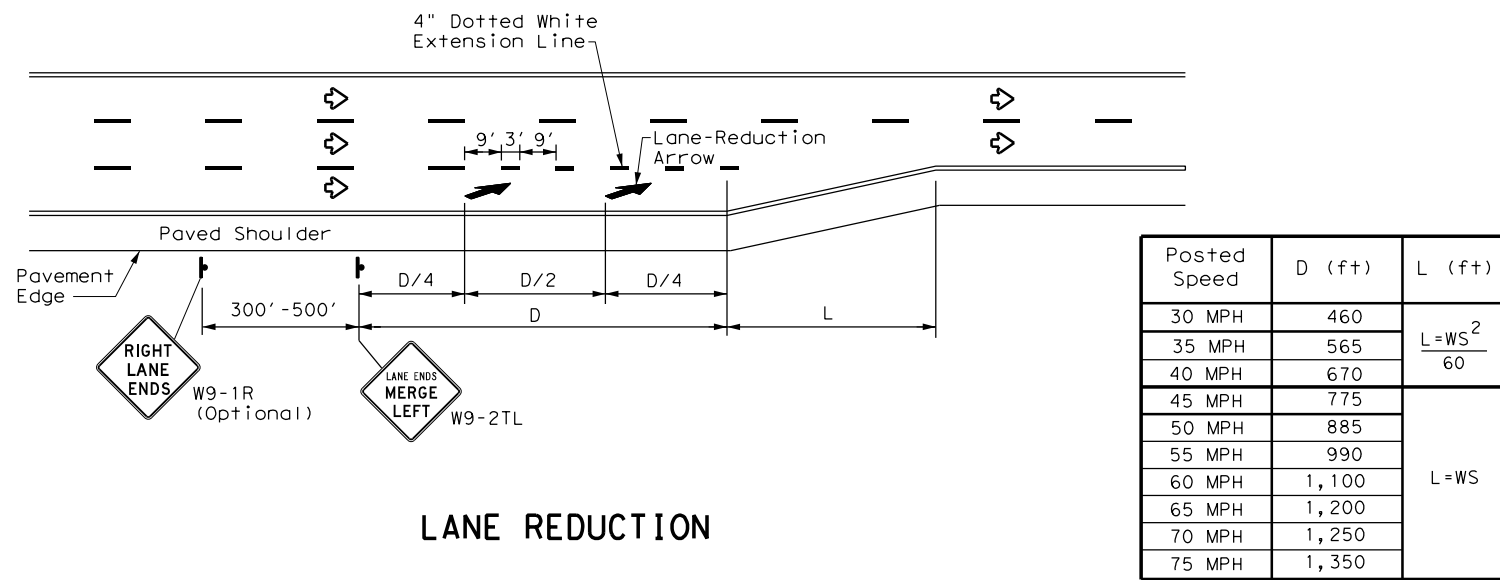

Posted Speed	D (ft)	L (ft)
30 MPH	460	$L = \frac{WS^2}{60}$
35 MPH	565	
40 MPH	670	L=WS
45 MPH	775	
50 MPH	885	
55 MPH	990	
60 MPH	1,100	
65 MPH	1,200	
70 MPH	1,250	
75 MPH	1,350	


LANE REDUCTION

NOTES

- Lane reduction pavement markings are used where the number of through lanes is reduced because of narrowing of the roadway or because of a section of on-street parking in what would otherwise be a through lane. For Texas Super 2 Passing Lanes, see TS2(PL) standard sheets.
- On divided highways, an additional W9-1R "RIGHT LANE ENDS" sign may be installed in the median aligned with the W9-1R sign on the right side of the highway.
- Lane reduction arrows are required for speeds of 45 mph or greater. An optional third lane reduction arrow may be added based on engineering judgement. If used, the optional third lane reduction arrow should be centered between the first and last lane reduction arrows.
- For lane reductions on Freeways and Expressways, signing shall conform to the TxDOT Freeway Signing Handbook.

GENERAL NOTES

- Lane use word and arrow markings shall be used where through lanes approaching an intersection become mandatory turn lanes. Lane use word and arrow markings should be used in auxiliary lanes of substantial length. Lane use arrow markings or word and arrow markings may be used in other lanes and turn bays for emphasis. Details for words and arrows are as shown in the Standard Highway Sign Designs for Texas.
- When lane-use words and arrow markings are used, two sets of arrows should be used if the length of the bay is greater than 180 feet. When a single lane use arrow or word and arrow marking is used for a short turn lane, it should be located at or near the upstream end of the full-width turn lane.
- Use raised pavement marker Type I-C with undivided highways, flush medians and two way left turn lanes. Use raised pavement marker Type II-C-R with divided highways and raised medians.
- Length of turn bays, including taper, deceleration, and storage lengths shall be as shown on the plans or as directed by the Engineer.

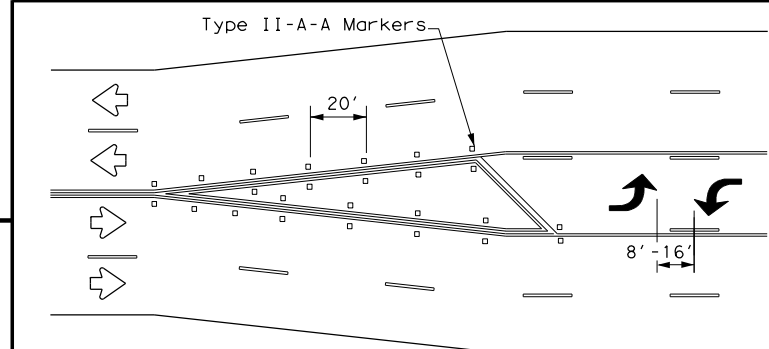


A two-way left-turn (TWLTL) lane-use arrow pavement marking should be used at or just downstream from the beginning of a two-way left-turn lane within a corridor. Repeating the marking after each intersection or dedicated turn bay is not required unless stated elsewhere in the plans.


TYPICAL TRANSITION FOR TWLTL AND DIVIDED HIGHWAY

MATERIAL SPECIFICATIONS	
PAVEMENT MARKERS (REFLECTORIZED)	DMS-4200
EPOXY AND ADHESIVES	DMS-6100
BITUMINOUS ADHESIVE FOR PAVEMENT MARKERS	DMS-6130
TRAFFIC PAINT	DMS-8200
HOT APPLIED THERMOPLASTIC	DMS-8220
PERMANENT PREFABRICATED PAVEMENT MARKINGS	DMS-8240


All pavement marking materials shall meet the required Departmental Material Specifications as specified by the plans.

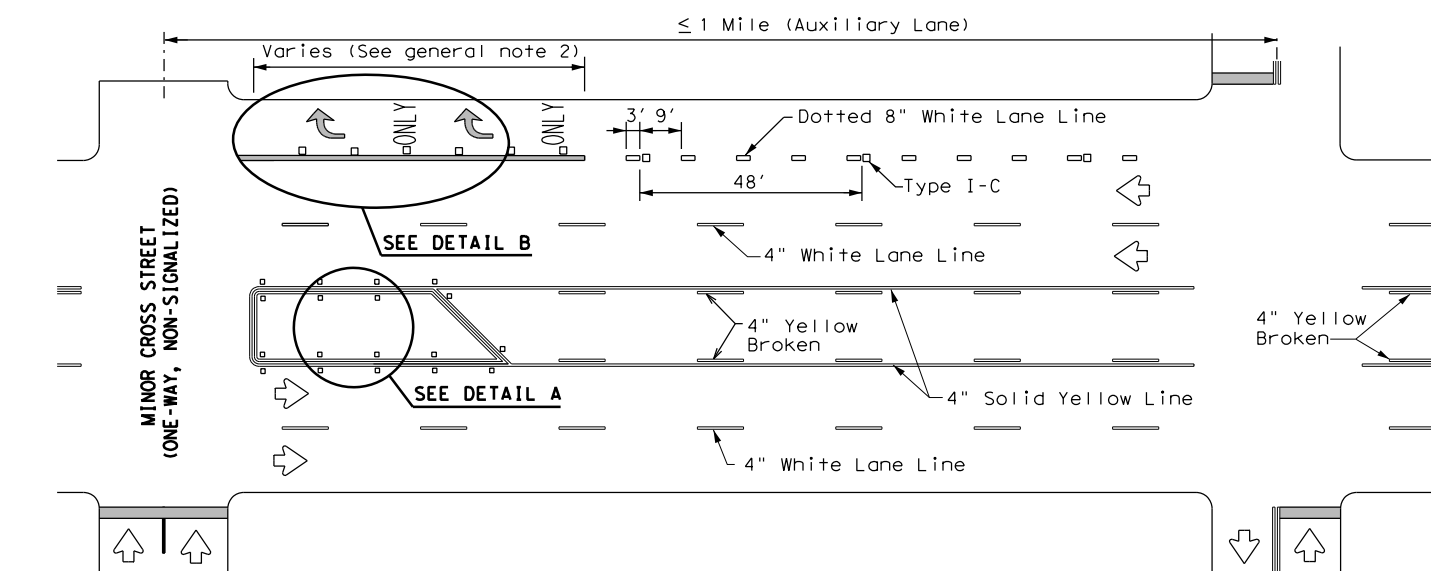


TYPICAL TWLTL AT ONE-WAY STREET AND RIGHT TURN AUXILIARY LANE

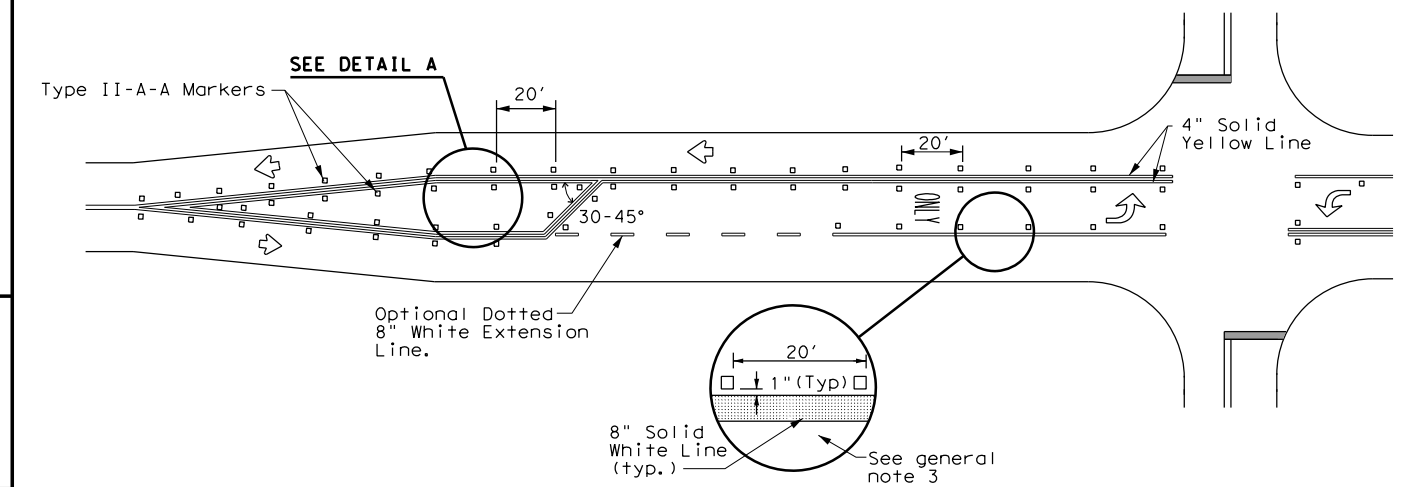

TYPICAL TWO-LANE HIGHWAY INTERSECTION WITH LEFT TURN BAYS

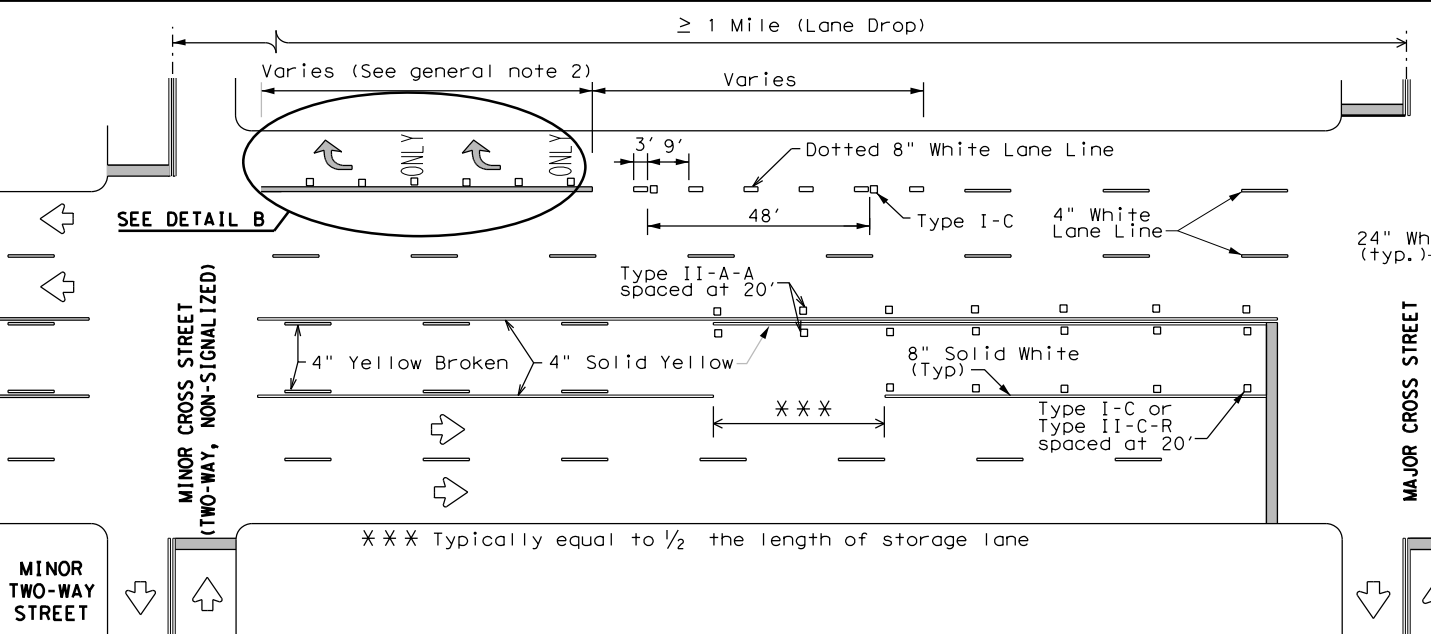

TYPICAL TWLTL AT TWO-WAY CROSS STREET AND RIGHT TURN LANE DROP

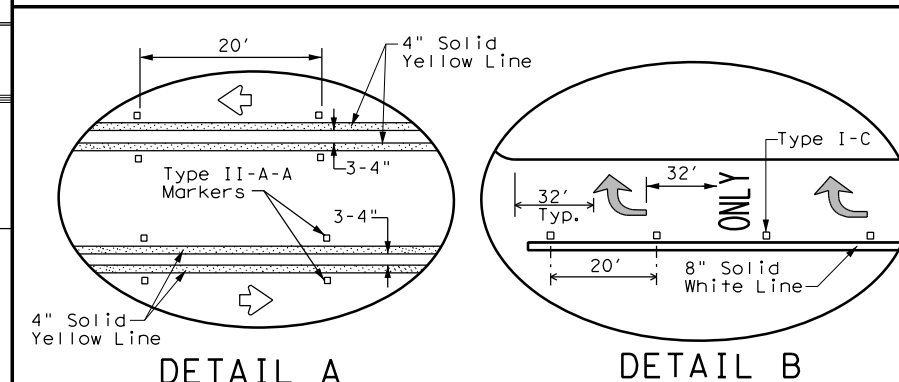

DETAIL A

DETAIL B

Texas Department of Transportation
Traffic Safety Division Standard


TWO-WAY LEFT TURN LANES, RURAL LEFT TURN BAYS, AND LANE REDUCTION PAVEMENT MARKINGS PM(3) - 20

FILE: pm3-20.dgn	DN:	CK:	DW:	CK:
© TxDOT April 1998	CONT	SECT	JOB	HIGHWAY
REVISIONS	904	02	047	VARIOUS
5-00 2-10	DIST	COUNTY	SHEET NO.	
8-00 2-12	AMA	POTTER	086	
3-03 6-20				

220

DATE:
FILE:

DISCLAIMER: The use of this standard is governed by the "Texas Engineering Practice Act". No warranty of any kind is made by TxDOT for any purpose whatsoever. TxDOT assumes no responsibility for the conversion of this standard to other formats or for incorrect results or damages resulting from its use.

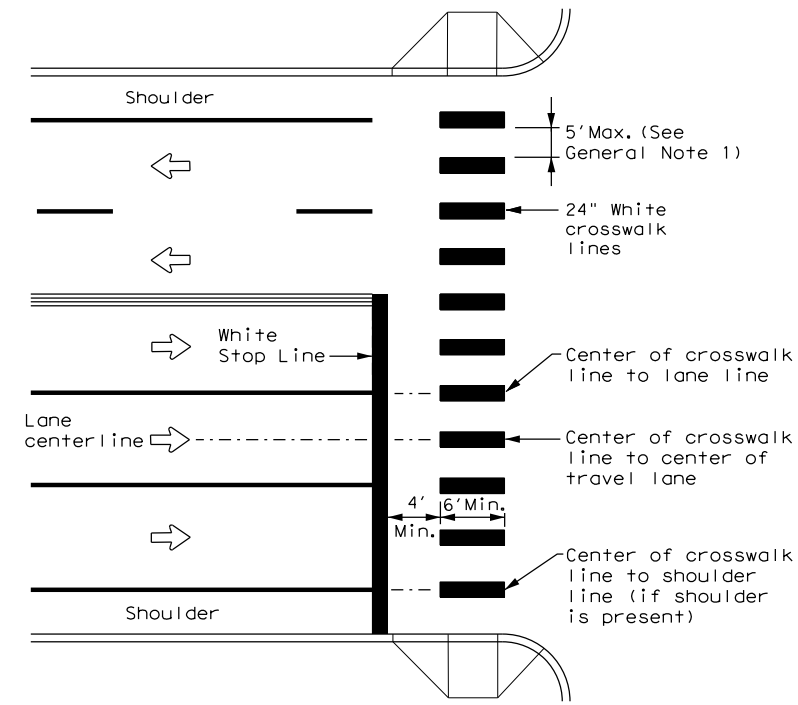


HIGH-VISIBILITY LONGITUDINAL CROSSWALK AT CONTROLLED APPROACH

GENERAL NOTES

1. Longitudinal crosswalk lines should not be placed in the wheel path of vehicles. Center the crosswalk lines on travel lanes, lane lines, and shoulder lines (if present).
2. A minimum 6" clear distance shall be provided to the curb face. If the last crosswalk line falls into this distance it must be omitted.
3. For divided roadways, adjustments in spacing of the crosswalk lines should be made in the median so that the crosswalk lines are maintained in their proper location across the travel portion of the roadway.
4. At skewed crosswalks, the crosswalk lines are to remain parallel to the lane lines.
5. Each crosswalk shall be a minimum of 6' wide.
6. The High-Visibility Longitudinal Crosswalk is the preferred crosswalk pattern on State Highways. Other crosswalk patterns as shown in the "Texas Manual on Uniform Traffic Control Devices" may be used. All crosswalk designs and dimension shall comply with the "Texas Manual on Uniform Traffic Control Devices."
7. Final placement of Stop Bar/Yield Triangles and Crosswalk shall be approved by the Engineer in the field.

MATERIAL SPECIFICATIONS	
PAVEMENT MARKERS (REFLECTORIZED)	DMS-4200
EPOXY AND ADHESIVES	DMS-6100
BITUMINOUS ADHESIVE FOR PAVEMENT MARKERS	DMS-6130
TRAFFIC PAINT	DMS-8200
HOT APPLIED THERMOPLASTIC	DMS-8220
PERMANENT PREFABRICATED PAVEMENT MARKINGS	DMS-8240

All pavement marking materials shall meet the required Departmental Material Specifications as specified by the plans.

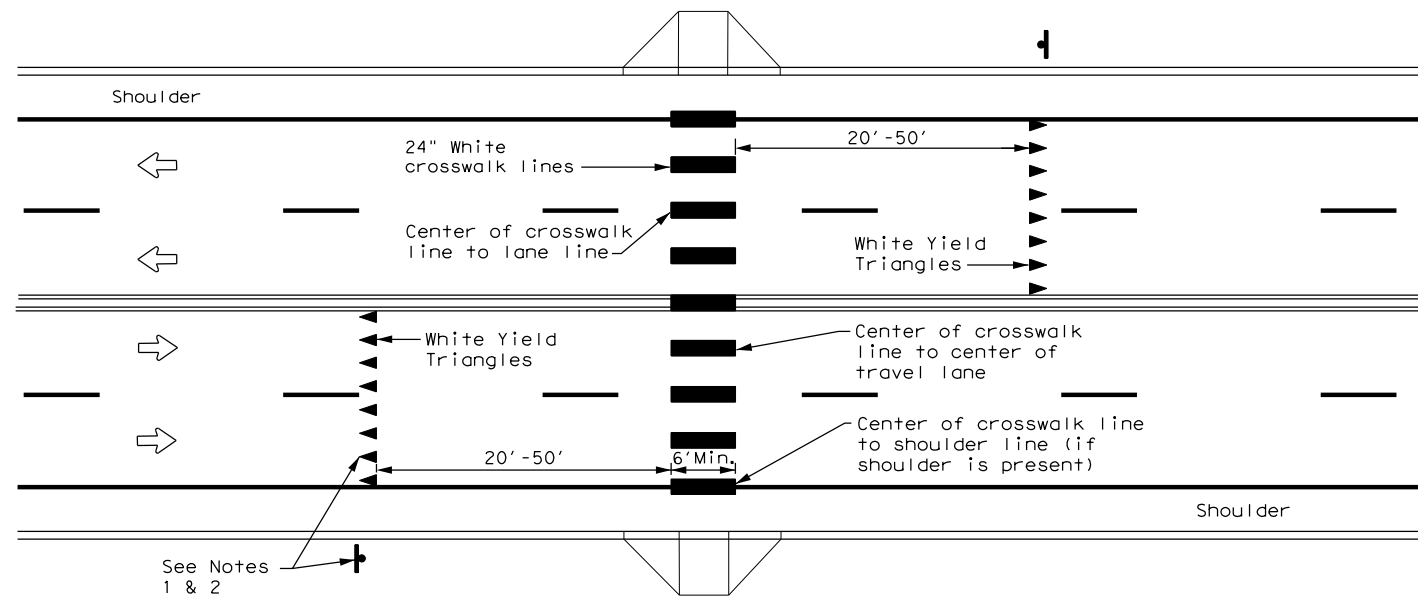

UNSIGNALIZED MID BLOCK HIGH-VISIBILITY LONGITUDINAL CROSSWALK

NOTES

1. Use yield triangles with "Yield Here to Pedestrians" signs at unsignalized mid block crosswalks.
2. Use stop bars with "Stop Here on Red" signs at mid block crosswalks controlled by traffic signals or pedestrian hybrid beacons.



CROSSWALK PAVEMENT MARKINGS

PM(4) - 20

FILE: pm4-20.dgn	DN:	CK:	DW:	CK:
© TxDOT June 2020	CONT	SECT	JOB	HIGHWAY
REVISIONS	904	02	047	VARIOUS
	DIST	COUNTY	SHEET NO.	
	AMA	POTTER	087	

DATE:
FILE:

DISCLAIMER: The use of this standard is governed by the "Texas Engineering Practice Act". No warranty of any kind is made by TxDOT for any purpose whatsoever. TxDOT assumes no responsibility for the conversion of this standard to other formats or for incorrect results or damages resulting from its use.

SIGN SUPPORT DESCRIPTIVE CODES

(Descriptive Codes correspond to project estimate and quantities sheets)

SM RD SGN ASSM TY XXXXX (X) XX (X-XXXX)

Post Type

FRP = Fiberglass Reinforced Plastic Pipe (see SMD (FRP))
 TWT = Thin-Walled Tubing (see SMD (TWT))
 10BWG = 10 BWG Tubing (see SMD (SLIP-1) to (SLIP-3))
 S80 = Schedule 80 Pipe (see SMD (SLIP-1) to (SLIP-3))

Number of Posts (1 or 2)


Anchor Type

UA = Universal Anchor - Concreted (see SMD (FRP) and (TWT))
 UB = Universal Anchor - Bolted down (see SMD (FRP) and (TWT))
 WS = Wedge Anchor Steel - (see SMD (TWT))
 WP = Wedge Anchor Plastic (see SMD (TWT))
 SA = Slipbase - Concreted (see SMD (SLIP-1) to (SLIP-3))
 SB = Slipbase - Bolted Down (see SMD (SLIP-1) to (SLIP-3))

Sign Mounting Designation

P = Prefab. "Plain" (see SMD (SLIP-1) to (SLIP-3), (TWT), (FRP))
 T = Prefab. "T" (see SMD (SLIP-1) to (SLIP-3), (TWT))
 U = Prefab. "U" (see SMD (SLIP-1) to (SLIP-3))
 IF REQUIRED
 1EXT or 2EXT = Number of Extensions (see SMD (SLIP-1) to (SLIP-3), (TWT))
 BM = Extruded Wind Beam (see SMD (SLIP-1) to (SLIP-3))
 WC = 1.12 #/ft Wing Channel (see SMD (SLIP-1) to (SLIP-3))
 EXAL = Extruded Aluminum Sign Panels (see SMD (SLIP-3))


REQUIRED CLEARANCE FOR BREAKAWAY SUPPORT

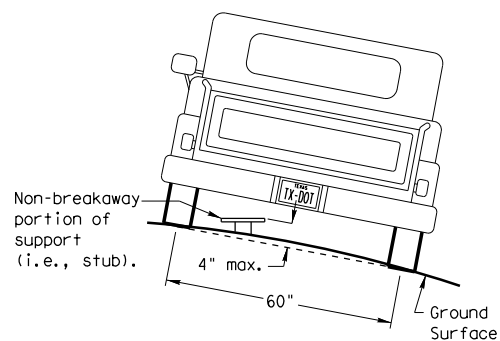

To avoid vehicle undercarriage snagging, any substantial remains of a breakaway support, when it is broken away, should not project more than 4 inches above a 60-inch chord (i.e., typical space between wheel paths).


SIGN LOCATION

PAVED SHOULDERS

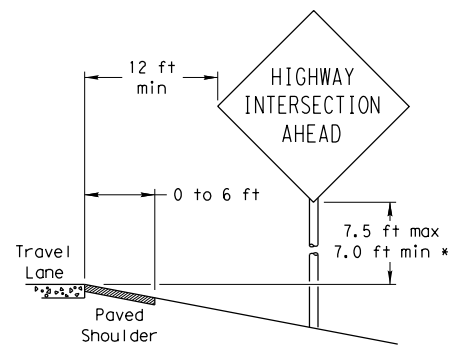

LESS THAN 6 FT. WIDE


When the shoulder is 6 ft. or less in width, the sign must be placed at least 12 ft. from the edge of the travel lane.

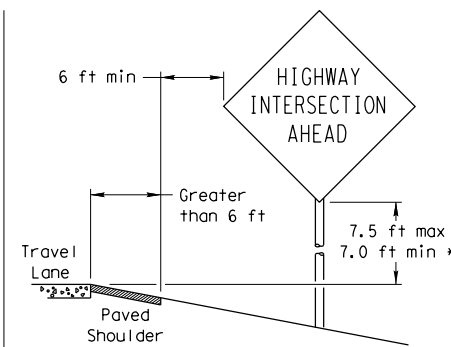

GREATER THAN 6 FT. WIDE


When the shoulder is greater than 6 ft in width, the sign must be placed at least 6 ft. from the edge of the shoulder.

T-INTERSECTION

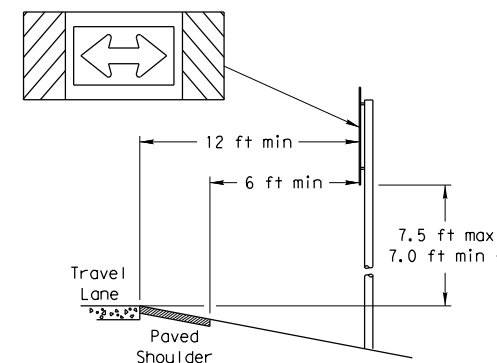


When this sign is needed at the end of a two-lane, two way roadway, the right edge of the sign should be in line with the centerline of the roadway. Place as close to ROW as practical.

No more than 2 sign posts should be located within a 7 ft. circle.

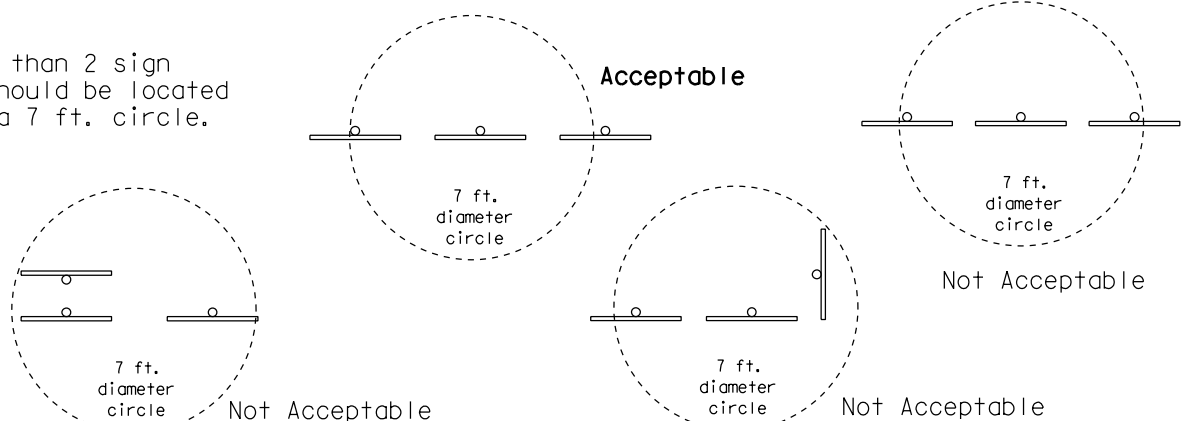


BEHIND BARRIER

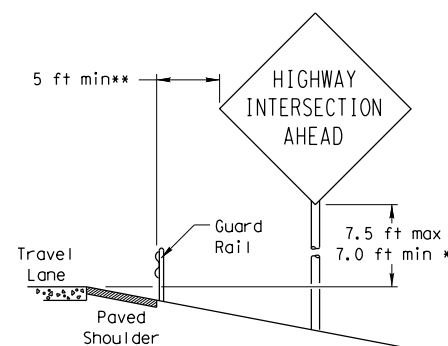


BEHIND GUARDRAIL

**Sign clearance based on distance required for proper guard rail or concrete barrier performance.

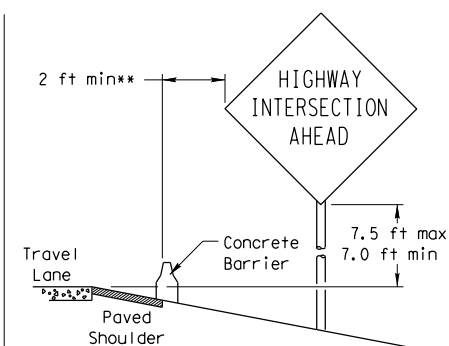

BEHIND CONCRETE BARRIER

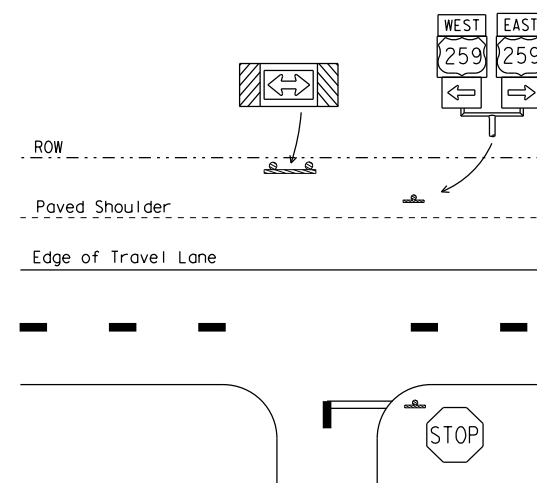

* Signs shall be mounted using the following condition that results in the greatest sign elevation:


- (1) a minimum of 7 to a maximum of 7.5 feet above the edge of the travel lane or
- (2) a minimum of 7 to a maximum of 7.5 feet above the grade at the base of the support when sign is installed on the backslope.

The maximum values may be increased when directed by the Engineer.

See the Traffic Operations Division website for detailed drawings of sign clamps, Triangular Slipbase System components and Wedge Anchor System components.

The website address is:
<http://www.txdot.gov/publications/traffic.htm>

TYPICAL SIGN ATTACHMENT DETAIL

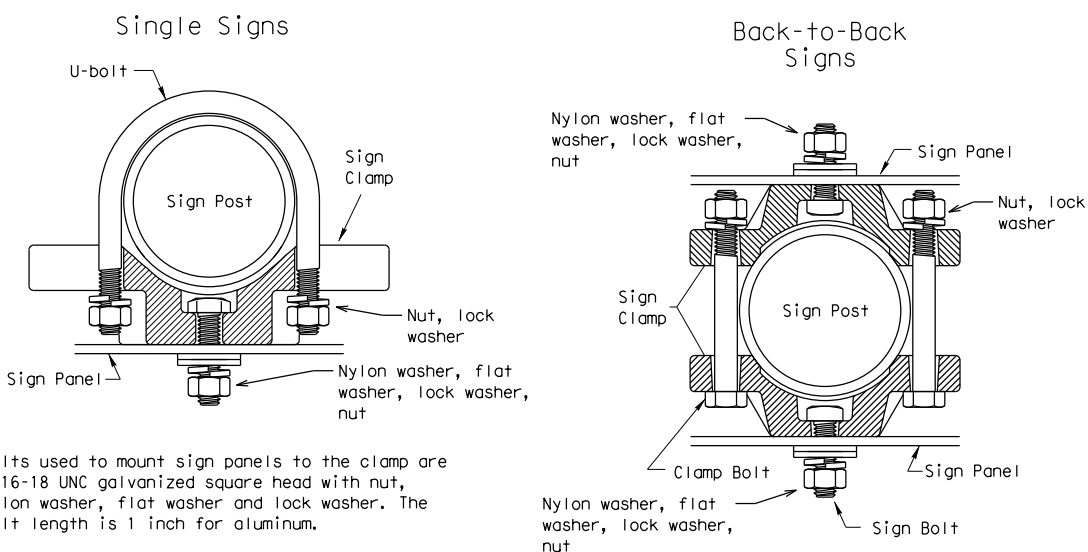


Bolts used to mount sign panels to the clamp are 5/16-18 UNC galvanized square head with nut, nylon washer, flat washer and lock washer. The bolt length is 1 inch for aluminum.

When two sign clamps are used to mount signs back-to-back, use a 5/16-18 UNC galvanized hex head per ASTM A307 with nut and helical-spring lock washer. The approximate bolt lengths for various post sizes and the sign clamp types are given in the table at right. The bolt length may need to be adjusted depending upon field conditions.

Sign clamps may be either the specific size clamp or the universal clamp.


Pipe Diameter	Approximate Bolt Length	
	Specific Clamp	Universal Clamp
2" nominal	3"	3 or 3 1/2"
2 1/2" nominal	3 or 3 1/2"	3 1/2 or 4"
3" nominal	3 1/2 or 4"	4 1/2"

SIGNS WITH PLAQUES

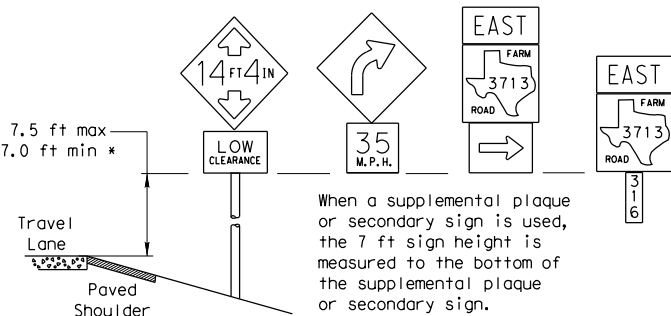


When a supplemental plaque or secondary sign is used, the 7 ft sign height is measured to the bottom of the supplemental plaque or secondary sign.

CURB & GUTTER OR RAISED ISLAND

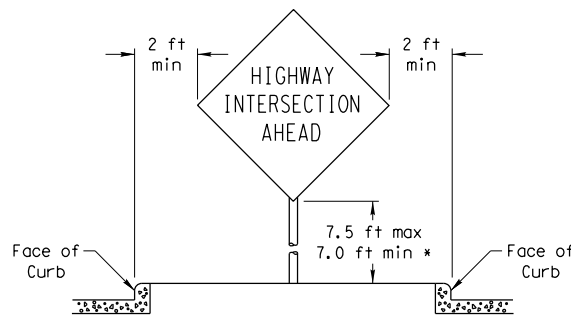

RESTRICTED RIGHT-OF-WAY (When 6 ft min. is not possible.)

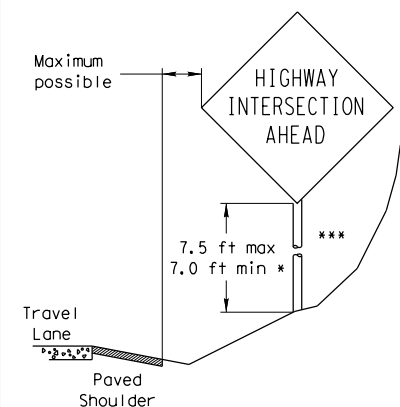

Right-of-way restrictions may be created by rocks, water, vegetation, forest, buildings, a narrow island, or other factors.

In situations where a lateral restriction prevents the minimum horizontal clearance from the edge of the travel lane, signs should be placed as far from the travel lane as practical.

*** Post may be shorter if protected by guardrail or if Engineer determines the post could not be hit due to extreme slope.




SIGN MOUNTING DETAILS SMALL ROADSIDE SIGNS GENERAL NOTES & DETAILS

SMD (GEN) -08

© TxDOT July 2002		DN: TxDOT	CK: TxDOT	DW: TxDOT	CK: TxDOT
9-08	REVISIONS	CONT	SECT	JOB	HIGHWAY
		904	02	047	VARIOUS
		DIST	COUNTY		SHEET NO.
		AMA	POTTER		088

DISCLAIMER: The use of this standard is governed by the "Texas Engineering Practice Act". No warranty of any kind is made by TxDOT for any purpose whatsoever. TxDOT assumes no responsibility for the conversion of this standard to other formats or for incorrect results or damages resulting from its use.

TRIANGULAR SLIPBASE INSTALLATION GENERAL REQUIREMENTS

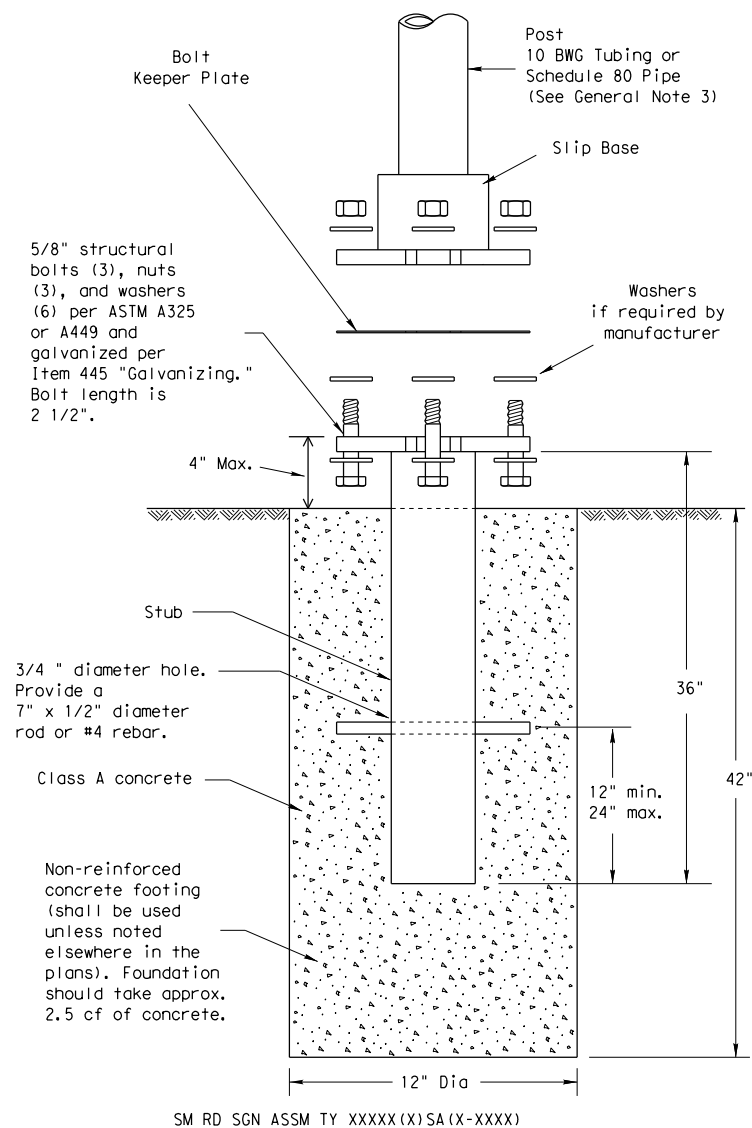

NOTE

There are various devices approved for the Triangular Slipbase System. Please reference the Material Producer List for approved slip base systems. http://www.txdot.gov/business/producer_list.htm The devices shall be installed per manufacturers' recommendations. Installation procedures shall be provided to the Engineer by Contractor.

GENERAL NOTES:

- Slip base shall be permanently marked to indicate manufacturer. Method, design, and location of marking are subject to approval of the TxDOT Traffic Standards Engineer.
- Material used as post with this system shall conform to the following specifications:
 - 10 BWG Tubing (2.875" outside diameter)
 - 0.134" nominal wall thickness
 - Seamless or electric-resistance welded steel tubing or pipe
 - Steel shall be HSLAS Gr 55 per ASTM A1011 or ASTM A1008
 - Other steels may be used if they meet the following:
 - 55,000 PSI minimum yield strength
 - 70,000 PSI minimum tensile strength
 - 20% minimum elongation in 2"
 - Wall thickness (uncoated) shall be within the range of 0.122" to 0.138"
 - Outside diameter (uncoated) shall be within the range of 2.867" to 2.883"
 - Galvanization per ASTM A123 or ASTM A653 G210. For precoated steel tubing (ASTM A653), recoat tube outside diameter weld seam by metallizing with zinc wire per ASTM B833.
 - Schedule 80 Pipe (2.875" outside diameter)
 - 0.276" nominal wall thickness
 - Steel tubing per ASTM A500 Gr C
 - Other seamless or electric-resistance welded steel tubing or pipe with equivalent outside diameter and wall thickness may be used if they meet the following:
 - 46,000 PSI minimum yield strength
 - 62,000 PSI minimum tensile strength
 - 21% minimum elongation in 2"
 - Wall thickness (uncoated) shall be within the range of 0.248" to 0.304"
 - Outside diameter (uncoated) shall be within the range of 2.855" to 2.895"
 - Galvanization per ASTM A123
- See the Traffic Operations Division website for detailed drawings of sign clamps and Texas Universal Triangular Slipbase System components. The website address is: <http://www.txdot.gov/publications/traffic.htm>
- Sign supports shall not be spliced except where shown. Sign support posts shall not be spliced.

ASSEMBLY PROCEDURE


Foundation

- Prepare 12-inch diameter by 42-inch deep hole. If solid rock is encountered, the depth of the foundation may be reduced such that it is embedded a minimum of 18 inches into the solid rock.
- The Engineer may permit batches of concrete less than 2 cubic yards to be mixed with a portable, motor-driven concrete mixer. For small placements less than 0.5 cubic yards, hand mixing in a suitable container may be allowed by Engineer. Concrete shall be Class A.
- Push the pipe end of the slip base stub into the center of the concrete. Rotate the stub back and forth while pushing it down into the concrete to assure good contact between the concrete and stub. Continue to work the stub into the concrete until it is between 2 to 4 inches above the ground.
- Plumb the stub. Allow a minimum of 4 days to set, unless otherwise directed by the Engineer.
- The triangular slipbase system is multidirectional and is designed to release when struck from any direction.

Support

- Cut support so that the bottom of the sign will be 7 to 7.5 feet above the edge of the travelway (i.e., edge of the closest lane) when slip plate is below the edge of pavement or 7 to 7.5 feet above slip plate when the slip plate is above the edge of the travelway. The cut shall be plumb and straight.
- Attach sign to support using connections shown. When multiple signs are installed on the same support, ensure the minimum clearance between each sign is maintained. See SMD(SLIP-2) for clearances based on sign types.

CONCRETE ANCHOR

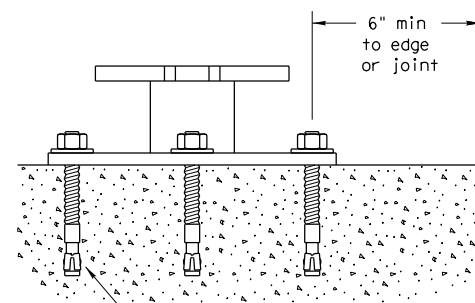

5/8" diameter Concrete Anchor - 8 places (embed a minimum of 5 1/2" and torque to min. of 50 ft-lbs). Anchor may be expansion or adhesive type.

SM RD SGN ASSM TY XXXXX(X)SB(X-XXXX)

Concrete anchor consists of 5/8" diameter stud bolt with UNC series bolt threads on the upper end. Heavy hex nut per ASTM A563, and hardened washer per ASTM F436. The stud bolt shall have a minimum yield and ultimate tensile strength of 50 and 75 KSI, respectively. Nuts, bolts and washers shall be galvanized per Item 445, "Galvanizing." Adhesive type anchors shall have stud bolts installed with Type III epoxy per DMS-6100, "Epoxyes and Adhesives." Adhesive anchors may be loaded after adequate epoxy cure time per the manufacturer's recommendations. Top of bolt shall extend at least flush with top of the nut when installed. The anchor, when installed in 4000 psi normal-weight concrete with a 5 1/2" minimum embedment, shall have a minimum allowable tension and shear of 3900 and 3100 psi, respectively.
















Texas Department of Transportation
Traffic Operations Division

SIGN MOUNTING DETAILS
SMALL ROADSIDE SIGNS
TRIANGULAR SLIPBASE SYSTEM

SMD(SLIP-1)-08

© TxDOT July 2002	DN: TxDOT	CK: TxDOT	DW: TxDOT	CK: TxDOT	
9-08	REVISIONS	CONT	SECT	JOB	HIGHWAY
		904	02	047	VARIOUS
		DIST	COUNTY	SHEET NO.	
		AMA	POTTER	089	

DISCLAIMER: The use of this standard is governed by the "Texas Engineering Practice Act". No warranty of any kind is made by TxDOT for any purpose whatsoever. TxDOT assumes no responsibility for the conversion of this standard to other formats or for incorrect results or damages resulting from its use.

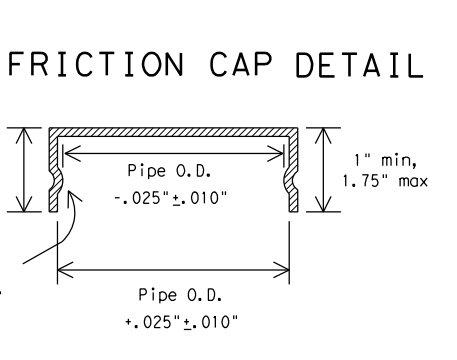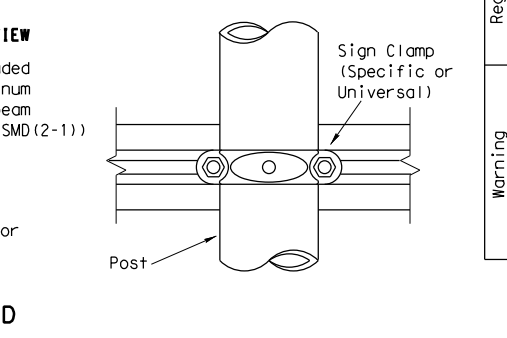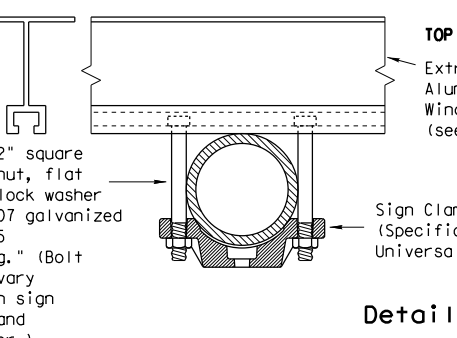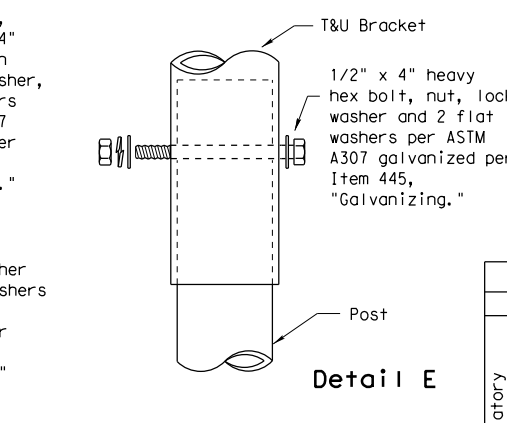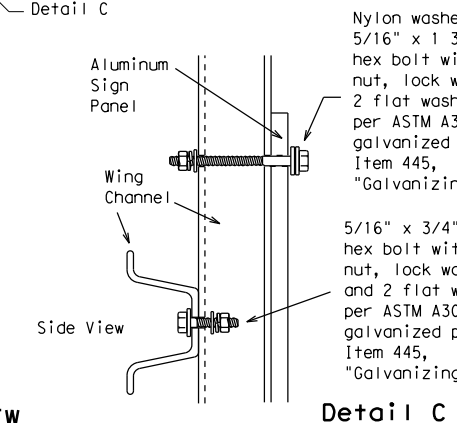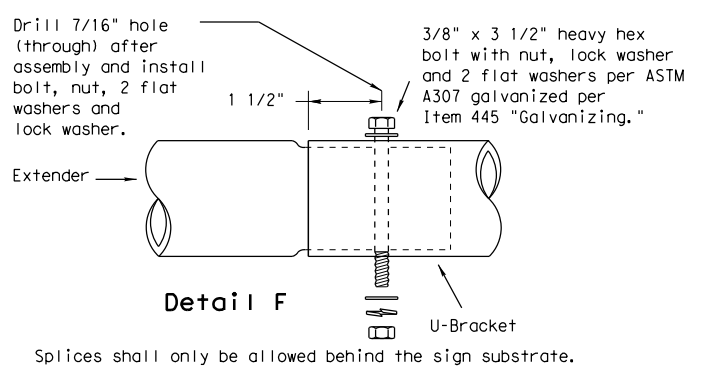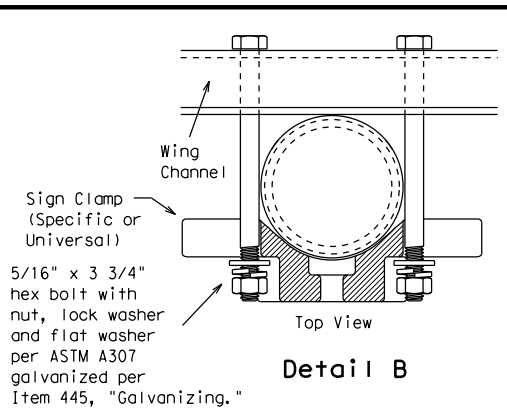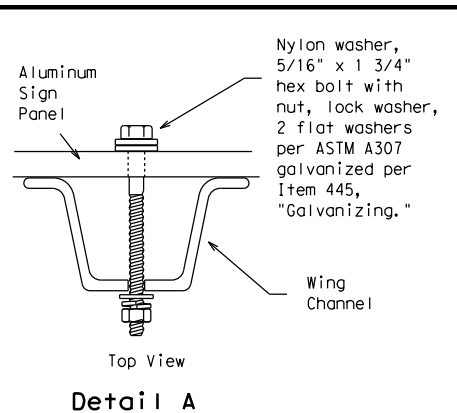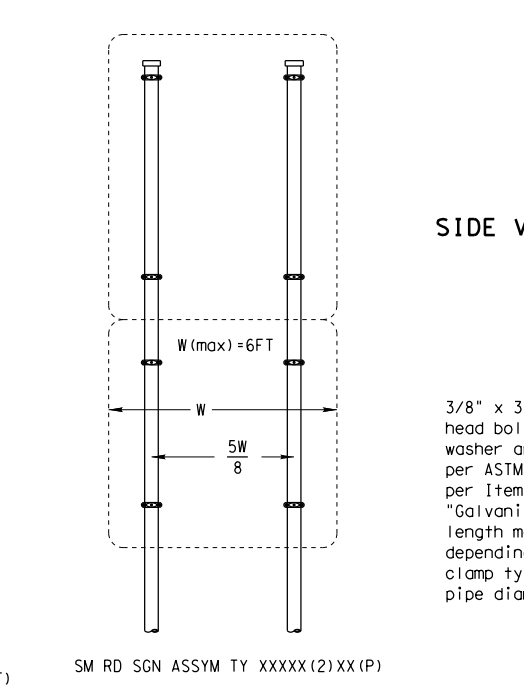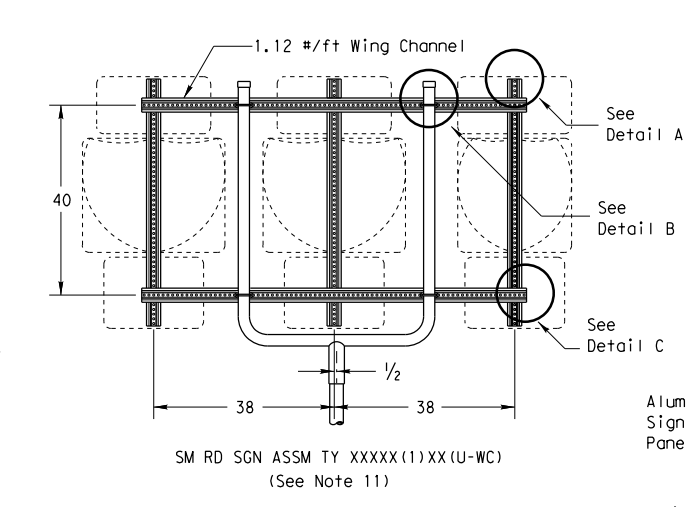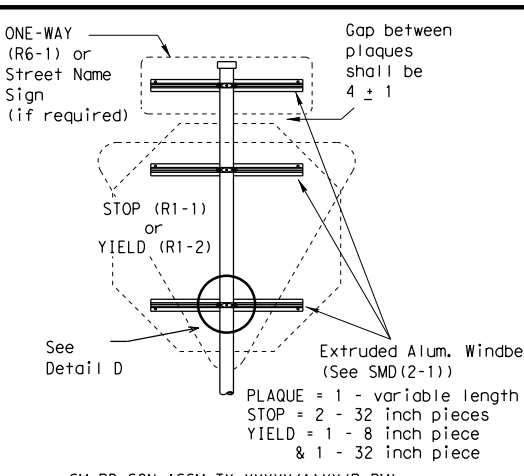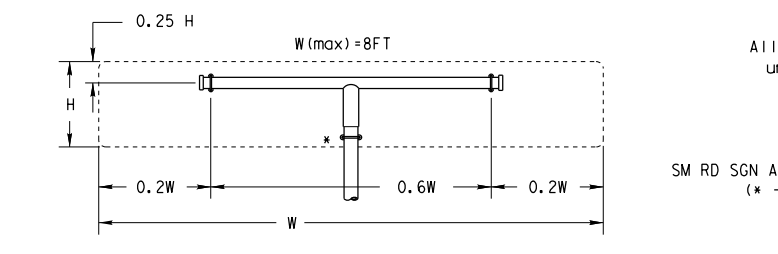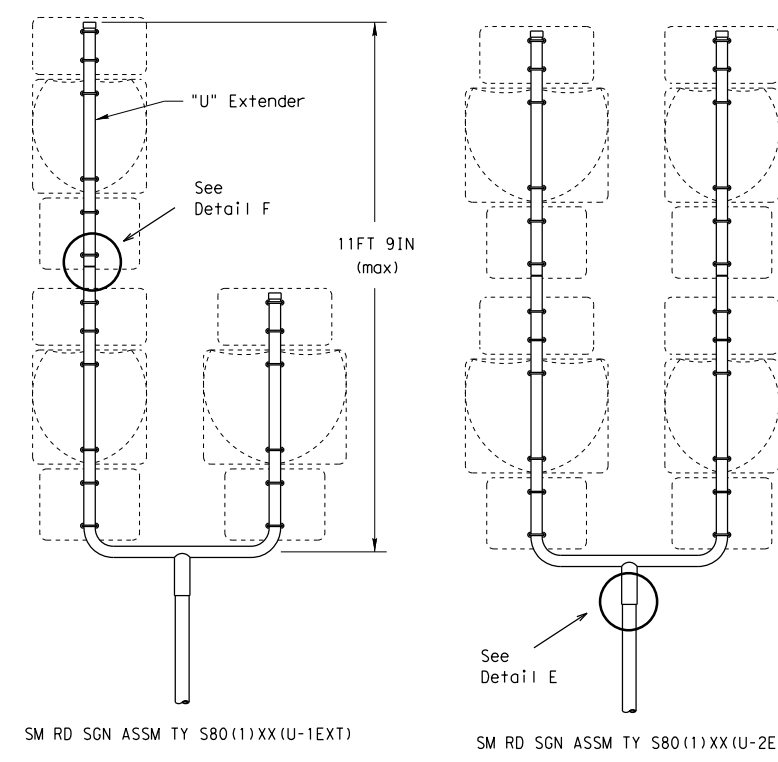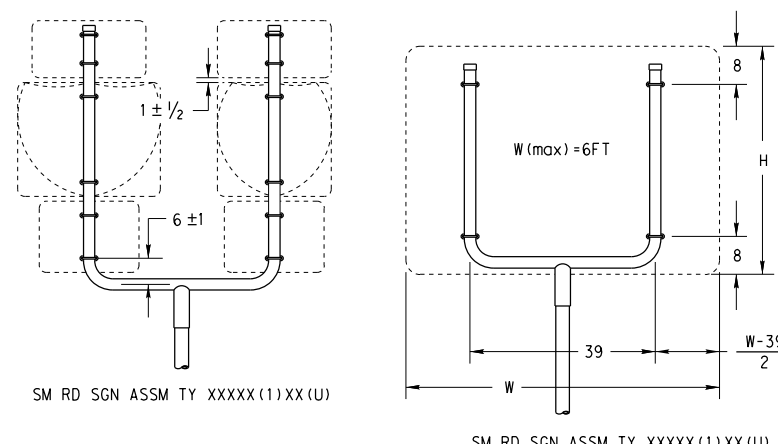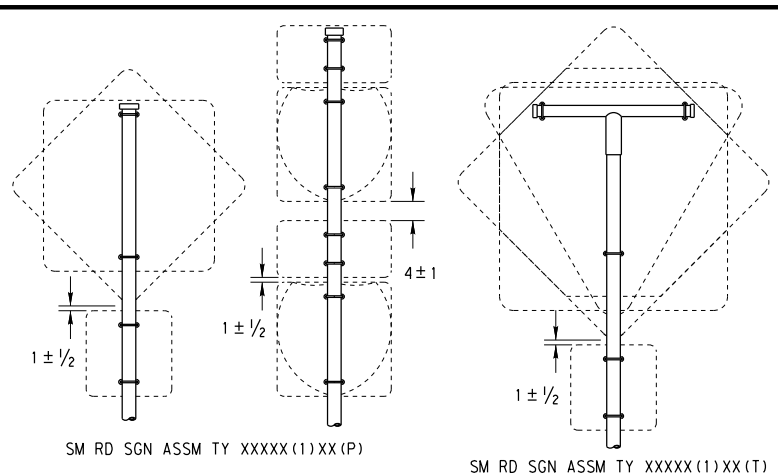

GENERAL NOTES:

- | SIGN SUPPORT | # OF POSTS | MAX. SIGN AREA |
|--------------|------------|----------------|
| 10 BWG | 1 | 16 SF |
| 10 BWG | 2 | 32 SF |
| Sch 80 | 1 | 32 SF |
| Sch 80 | 2 | 64 SF |
- The Engineer may require that a Schedule 80 post be used in place of a 10 BWG where a sign height is abnormally high due to a fill slope.
- Sign supports shall not be spliced except where shown. Sign support posts shall not be spliced.
- Aluminum sign blanks shall conform to Departmental Material Specifications DMS-7110 and shall have the following minimum thicknesses: 0.080 for signs less than 7.5 sq. ft., 0.100 for signs 7.5 to 15 sq. ft., and 0.125 for signs greater than 15 sq. ft.
- Signs that require specific supports due to reasons in addition to windloading are indicated on the "REQUIRED SUPPORT" table on this sheet.
- For horizontal rectangular signs fabricated from flat aluminum, T-brackets are used for signs 24 inches or less in height. U-brackets are used for signs of greater height.
- When two triangular slipbase supports are used to support a single sign, they shall not be "rigidly" connected to each other except through the sign panel. This will allow each support to act independently when impacted by an errant vehicle.
- Wing channel shall meet ASTM A 1011 SS Gr 50 and be galvanized per ASTM A 123.
- Excess pipe, wing channel, or windbeam shall be cut off so that it does not extend beyond the sign panel (i.e., excess support shall not be visible when the sign is viewed from the front.) Repair galvanized coating at cut support ends per Item 445, "Galvanizing."
- Additional route markers may be added vertically, provided the total sign area does not exceed the maximum allowable amount per Note 1.
- Additional sign clamp required on the "T-bracket" post for 24 inch height signs. Place the clamp 3 inches above bottom of sign when possible.
- Post open ends shall be fitted with Friction Caps.
- Sign blanks shall be the sizes and shapes shown on the plans.

REQUIRED SUPPORT	
SIGN DESCRIPTION	SUPPORT
48-inch STOP sign (R1-1)	TY 10BWG(1)XX(T) TY 10BWG(1)XX(P-BM)
60-inch YIELD sign (R1-2)	TY 10BWG(1)XX(T) TY 10BWG(1)XX(P-BM)
48x16-inch ONE-WAY sign (R6-1)	TY 10BWG(1)XX(T) TY 10BWG(1)XX(P-BM)
36x48, 48x36, and 48x48-inch signs	TY 10BWG(1)XX(T)
48x60-inch signs	TY S80(1)XX(T)
48x48-inch signs (diamond or square)	TY 10BWG(1)XX(T)
48x60-inch signs	TY S80(1)XX(T)
48-inch Advance School X-ing sign (S1-1)	TY 10BWG(1)XX(T)
48-inch School X-ing sign (S2-1)	TY 10BWG(1)XX(T)
Large Arrow sign (W1-6 & W1-7)	TY 10BWG(1)XX(T)

Friction caps may be manufactured from hot rolled or cold rolled steel sheets. The minimum sheet metal thickness shall be 24 gauge for all cap sizes. The rim edges shall be reasonably straight and smooth. Caps shall be sized and formed in such a manner as to produce a drive-on friction fit and have no tendency to rock when seated on the pipe. The depth shall be sufficient to give positive protection against entrance of rainwater. They shall be free of sharp creases or indentations and show no evidence of metal fracture. Caps shall have an electrodeposited coating of zinc in accordance with the requirements of ASTM B633 Class FE/ZN 8.












SIGN MOUNTING DETAILS
SMALL ROADSIDE SIGNS
TRIANGULAR SLIPBASE SYSTEM
SMD(SLIP-2)-08

© TxDOT July 2002		DN: TxDOT	CK: TxDOT	DW: TxDOT	CK: TxDOT
9-08	REVISIONS	CONT	SECT	JOB	HIGHWAY
		904	02	047	VARIOUS
		DIST	COUNTY		SHEET NO.
		AMA	POTTER		090

DISCLAIMER: The use of this standard is governed by the "Texas Engineering Practice Act". No warranty of any kind is made by TxDOT for any purpose whatsoever. TxDOT assumes no responsibility for the conversion of this standard to other formats or for incorrect results or damages resulting from its use.


DATE:
FILE:

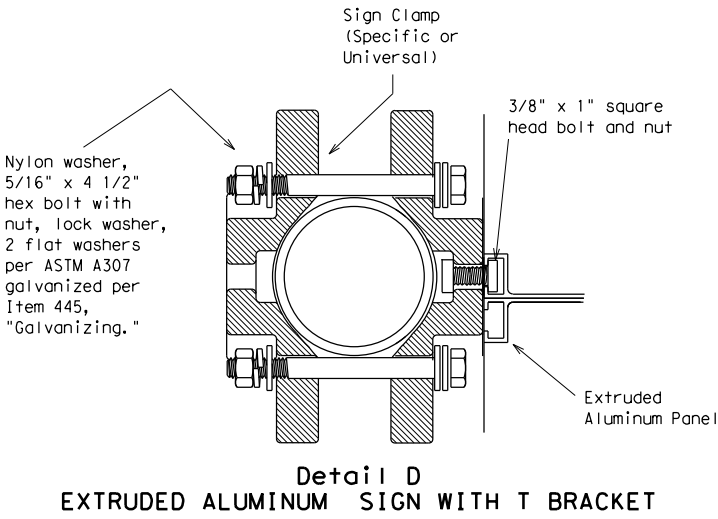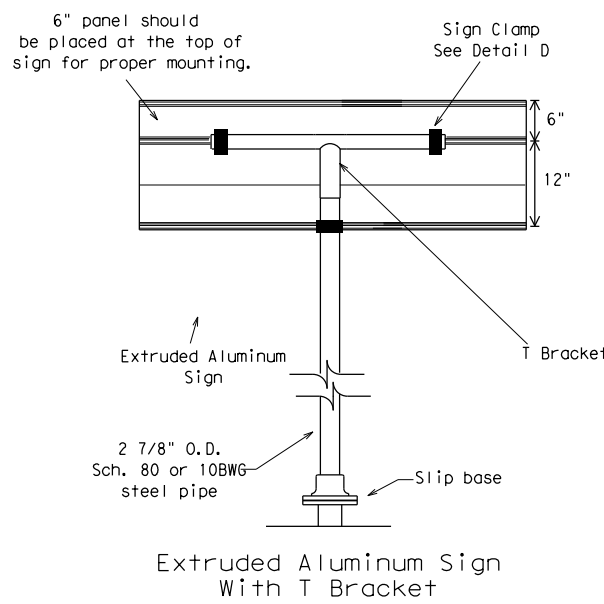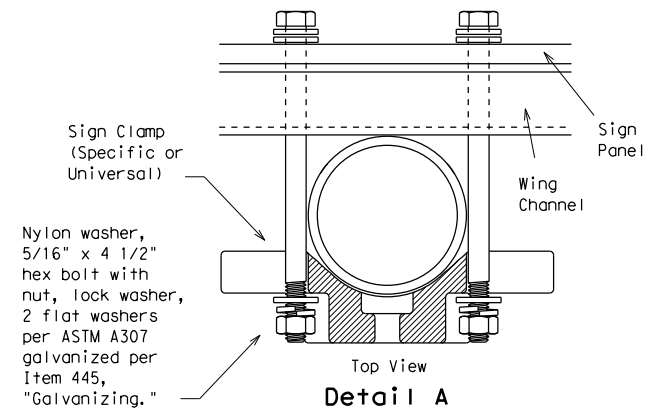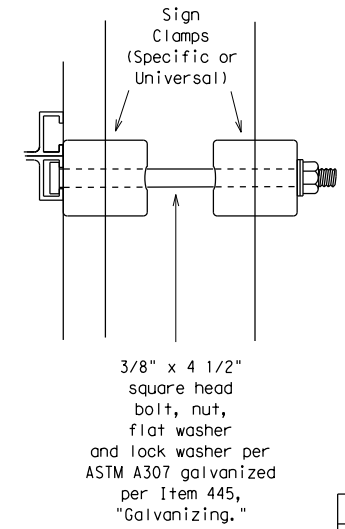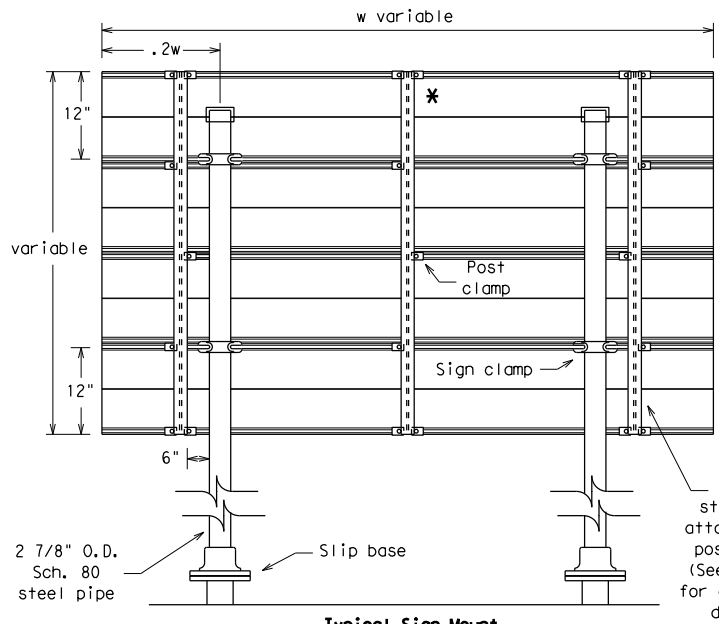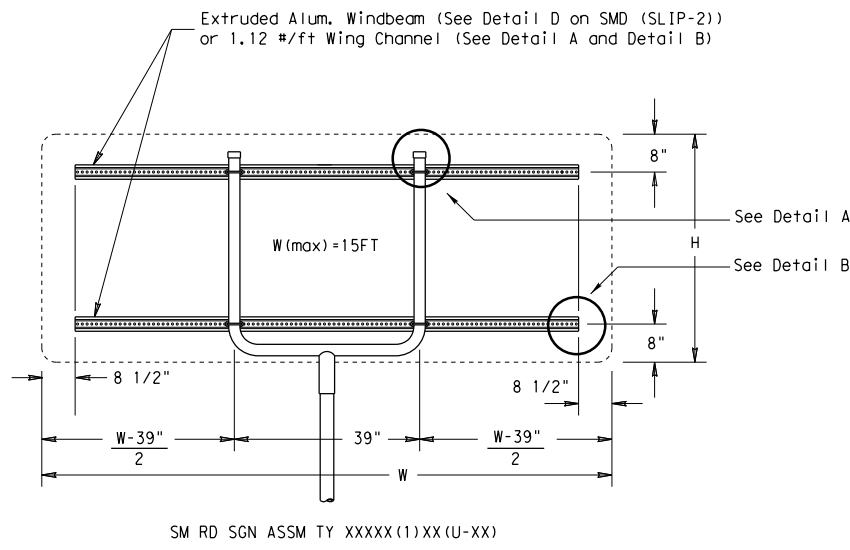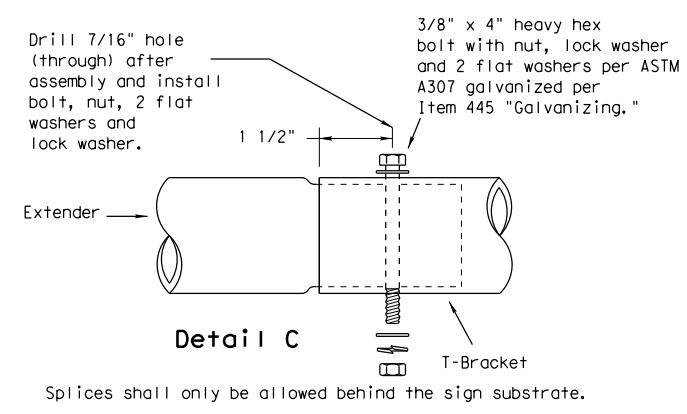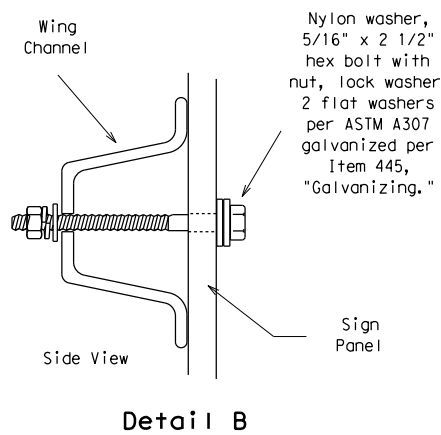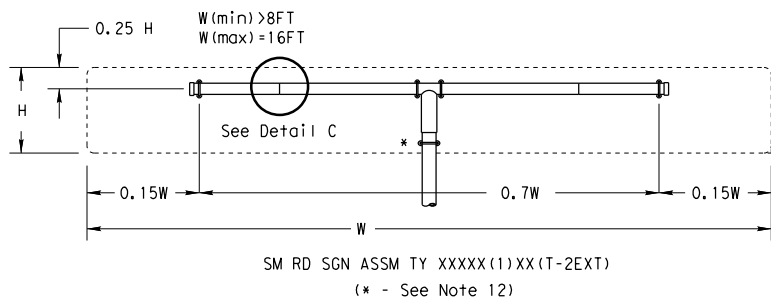

GENERAL NOTES:

- | SIGN SUPPORT | # OF POSTS | MAX. SIGN AREA |
|--------------|------------|----------------|
| 10 BWG | 1 | 16 SF |
| 10 BWG | 2 | 32 SF |
| Sch 80 | 1 | 32 SF |
| Sch 80 | 2 | 64 SF |
- The Engineer may require that a Schedule 80 post be used in place of a 10 BWG where a sign height is abnormally high due to a fill slope.
- Sign supports shall not be spliced except where shown. Sign support posts shall not be spliced.
- Aluminum sign blanks shall conform to Departmental Material Specifications DMS-7110 and shall have the following minimum thicknesses: 0.080 for signs less than 7.5 sq. ft., 0.100 for signs 7.5 to 15 sq. ft., and 0.125 for signs greater than 15 sq. ft.
- Signs that require specific supports due to reasons in addition to windloading are indicated on the "REQUIRED SUPPORT" table on this sheet.
- For horizontal rectangular signs fabricated from flat aluminum, T-brackets are used for signs 24 inches or less in height. U-brackets are used for signs of greater height.
- When two triangular slipbase supports are used to support a single sign, they shall not be "rigidly" connected to each other except through the sign panel. This will allow each support to act independently when impacted by an errant vehicle.
- Wing channel shall meet ASTM A 1011 SS Gr 50 and be galvanized per ASTM A 123.
- Excess pipe, wing channel, or windbeam shall be cut off so that it does not extend beyond the sign panel (i.e., excess support shall not be visible when the sign is viewed from the front.) Repair galvanized coating at cut support ends per Item 445, "Galvanizing."
- Sign blanks shall be the sizes and shapes shown on the plans.
- Additional sign clamp required on the "T-bracket" post for 24 inch high signs. Place the clamp 3 inches above bottom of sign when possible.
- Post open ends shall be fitted with Friction Caps.

REQUIRED SUPPORT		
	SIGN DESCRIPTION	SUPPORT
Regulatory	48-inch STOP sign (R1-1)	TY 10BWG(1)XX(T) TY 10BWG(1)XX(P-BM)
	60-inch YIELD sign (R1-2)	TY 10BWG(1)XX(T) TY 10BWG(1)XX(P-BM)
	48x16-inch ONE-WAY sign (R6-1)	TY 10BWG(1)XX(T) TY 10BWG(1)XX(P-BM)
	36x48, 48x36, and 48x48-inch signs	TY 10BWG(1)XX(T)
	48x60-inch signs	TY S80(1)XX(T)
Warning	48x48-inch signs (diamond or square)	TY 10BWG(1)XX(T)
	48x60-inch signs	TY S80(1)XX(T)
	48-inch Advance School X-ing sign (S1-1)	TY 10BWG(1)XX(T)
	48-inch School X-ing sign (S2-1)	TY 10BWG(1)XX(T)
	Large Arrow sign (W1-6 & W1-7)	TY 10BWG(1)XX(T)

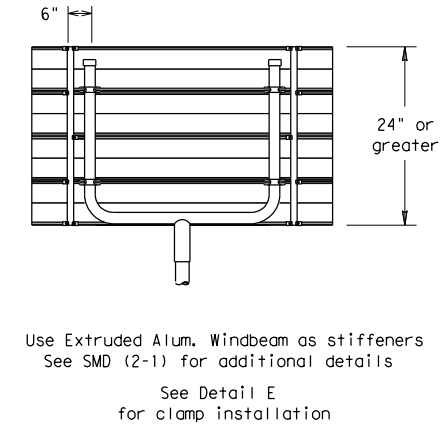

Texas Department of Transportation
Traffic Operations Division

SIGN MOUNTING DETAILS
SMALL ROADSIDE SIGNS
TRIANGULAR SLIPBASE SYSTEM
SMD(SLIP-3) -08

© TxDOT July 2002	DN: TxDOT	CK: TxDOT	DW: TxDOT	CK: TxDOT
9-08 REVISIONS	CONT	SECT	JOB	HIGHWAY
	904	02	047	VARIOUS
	DIST	COUNTY		SHEET NO.
	AMA	POTTER		091

DISCLAIMER: The use of this standard is governed by the "Texas Engineering Practice Act". No warranty of any kind is made by TxDOT for any purpose whatsoever. TxDOT assumes no responsibility for the conversion of this standard to other formats or for incorrect results or damages resulting from its use.

DATE: FILE:

I. STORMWATER POLLUTION PREVENTION-CLEAN WATER ACT SECTION 402

TPDES TXR 150000: Stormwater Discharge Permit or Construction General Permit required for projects with 1 or more acres disturbed soil. Projects with any disturbed soil must protect for erosion and sedimentation in accordance with Item 506.

List MS4 Operator(s) that may receive discharges from this project. They may need to be notified prior to construction activities.

1. City of Amarillo

No Action Required Required Action

Action No.

- Prevent stormwater pollution by controlling erosion and sedimentation in accordance with TPDES Permit TXR 150000
- Comply with the SW3P and revise when necessary to control pollution or required by the Engineer.
- Post Construction Site Notice (CSN) with SW3P information on or near the site, accessible to the public and TCEQ, EPA or other inspectors.
- When Contractor project specific locations (PSL's) increase disturbed soil area to 5 acres or more, submit NOI to TCEQ and the Engineer.
-

II. WORK IN OR NEAR STREAMS, WATERBODIES AND WETLANDS CLEAN WATER ACT SECTIONS 401 AND 404

USACE Permit required for filling, dredging, excavating or other work in any water bodies, rivers, creeks, streams, wetlands or wet areas.

The Contractor must adhere to all of the terms and conditions associated with the following permit(s):

- No Permit Required
- Nationwide Permit 14 - PCN not Required (less than 1/10th acre waters or wetlands affected)
- Nationwide Permit 14 - PCN Required (1/10 to <1/2 acre, 1/3 in tidal waters)
- Individual 404 Permit Required
- Other Nationwide Permit Required: NWP# _____

Required Actions: List waters of the US permit applies to, location in project and check Best Management Practices planned to control erosion, sedimentation and post-project TSS.

-
-
- The elevation of the ordinary high water marks of any areas requiring work to be performed in the waters of the US requiring the use of a nationwide permit can be found on the Bridge Layouts.

Best Management Practices:

Erosion	Sedimentation	Post-Construction TSS
<input type="checkbox"/> Temporary Vegetation	<input checked="" type="checkbox"/> Silt Fence	<input type="checkbox"/> Vegetative Filter Strips
<input type="checkbox"/> Blankets/Matting	<input type="checkbox"/> Rock Berm	<input type="checkbox"/> Retention/Irrigation Systems
<input type="checkbox"/> Mulch	<input type="checkbox"/> Triangular Filter Dike	<input type="checkbox"/> Extended Detention Basin
<input checked="" type="checkbox"/> Sodding	<input type="checkbox"/> Sand Bag Berm	<input type="checkbox"/> Constructed Wetlands
<input type="checkbox"/> Interceptor Swale	<input type="checkbox"/> Straw Bale Dike	<input type="checkbox"/> Wet Basin
<input type="checkbox"/> Diversion Dike	<input type="checkbox"/> Brush Berms	<input type="checkbox"/> Erosion Control Compost
<input type="checkbox"/> Erosion Control Compost	<input type="checkbox"/> Erosion Control Compost	<input type="checkbox"/> Mulch Filter Berm and Socks
<input type="checkbox"/> Mulch Filter Berm and Socks	<input type="checkbox"/> Mulch Filter Berm and Socks	<input type="checkbox"/> Compost Filter Berm and Socks
<input type="checkbox"/> Compost Filter Berm and Socks	<input type="checkbox"/> Compost Filter Berm and Socks	<input type="checkbox"/> Vegetation Lined Ditches
	<input type="checkbox"/> Stone Outlet Sediment Traps	<input type="checkbox"/> Sand Filter Systems
	<input type="checkbox"/> Sediment Basins	<input type="checkbox"/> Grassy Swales

III. CULTURAL RESOURCES

Refer to TxDOT Standard Specifications in the event historical issues or archeological artifacts are found during construction. Upon discovery of archeological artifacts (bones, burnt rock, flint, pottery, etc.) cease work in the immediate area and contact the Engineer immediately.

No Action Required Required Action

Action No.

- In the event that unanticipated archeological deposits are encountered during construction, work in the immediate area will cease and TxDOT archeological staff will be contacted to initiate post-review discovery procedures.

IV. VEGETATION RESOURCES

Comply with Executive Order 13112 on Invasive Species and the intent of the Executive Order Memorandum on Beneficial Landscapes for re-vegetating the project area. The proposed seed mixture (both grasses and forbs) would be in accordance with Item 164, Seeding for Erosion Control in TxDOT's Standard Specifications for the construction of Highways, Streets, and Bridges.

No Action Required Required Action

Action No.

-
-

V. FEDERAL LISTED, PROPOSED THREATENED, ENDANGERED SPECIES, CRITICAL HABITAT, STATE LISTED SPECIES, CANDIDATE SPECIES AND MIGRATORY BIRDS.

No Action Required Required Action

Action No.

- If any species on the Potter County Threatened & Endangered List is sighted in the project area during construction, stop construction and notify the Area Engineer.
- Texas Horned Lizard: Contractors will be advised of potential occurrence in the project area, and to avoid harming the species if encountered. This should include avoiding harvester ant beds in the selection of Project Specific Locations (PSL's).
- Bird BMP's: a) Do not disturb, destroy, or remove active nests, including ground nesting birds, during the nesting season; b) avoid the removal of unoccupied, inactive nests, as practicable; c) do not collect, capture, relocate, or transport birds, eggs, young, or active nests without a permit.
- The Migratory Bird Treaty Act of 1918 states that it is unlawful to kill, capture, collect, possess, buy, sell, trade, or transport any migratory bird, nest, young, feather, egg in part or in whole, without a Federal permit issued in accordance within the Act's policies and regulations. In the event that migratory birds are encountered on-site during project construction, adverse impacts on protected birds, active nests, eggs, and/or young would be avoided and bridge work would not begin until the young have left the nest.

If any of the listed species are observed, cease work in the immediate area, do not disturb species or habitat and contact the Engineer immediately. The work may not remove active nests from bridges and other structures during nesting season of the birds associated with the nests. If caves or sinkholes are discovered, cease work in the immediate area, and contact the Engineer immediately.

LIST OF ABBREVIATIONS

BMP: Best Management Practice	SPCC: Spill Prevention Control and Countermeasure
CGP: Construction General Permit	SW3P: Storm Water Pollution Prevention Plan
DSHS: Texas Department of State Health Services	PCN: Pre-Construction Notification
FHWA: Federal Highway Administration	PSL: Project Specific Location
MOA: Memorandum of Agreement	TCEQ: Texas Commission on Environmental Quality
MOU: Memorandum of Understanding	TPDES: Texas Pollutant Discharge Elimination System
MS4: Municipal Separate Stormwater Sewer System	TPWD: Texas Parks and Wildlife Department
MBTA: Migratory Bird Treaty Act	TxDOT: Texas Department of Transportation
NOT: Notice of Termination	T&E: Threatened and Endangered Species
NWP: Nationwide Permit	USACE: U.S. Army Corps of Engineers
NOI: Notice of Intent	USFWS: U.S. Fish and Wildlife Service

VI. HAZARDOUS MATERIALS OR CONTAMINATION ISSUES

General (applies to all projects):

Comply with the Hazard Communication Act (the Act) for personnel who will be working with hazardous materials by conducting safety meetings prior to beginning construction and making workers aware of potential hazards in the workplace. Ensure that all workers are provided with personal protective equipment appropriate for any hazardous materials used. Obtain and keep on-site Material Safety Data Sheets (MSDS) for all hazardous products used on the project, which may include, but are not limited to the following categories: Paints, acids, solvents, asphalt products, chemical additives, fuels and concrete curing compounds or additives. Provide protected storage, off bare ground and covered, for products which may be hazardous. Maintain product labelling as required by the Act. Maintain an adequate supply of on-site spill response materials, as indicated in the MSDS. In the event of a spill, take actions to mitigate the spill as indicated in the MSDS, in accordance with safe work practices, and contact the District Spill Coordinator immediately. The Contractor shall be responsible for the proper containment and cleanup of all product spills.

Contact the Engineer if any of the following are detected:

- * Dead or distressed vegetation (not identified as normal)
- * Trash piles, drums, canister, barrels, etc.
- * Undesirable smells or odors
- * Evidence of leaching or seepage of substances

Does the project involve any bridge class structure rehabilitation or replacements (bridge class structures not including box culverts)?

Yes No

If "No", then no further action is required.

If "Yes", then TxDOT is responsible for completing asbestos assessment/inspection.

Are the results of the asbestos inspection positive (is asbestos present)?

Yes No

If "Yes", then TxDOT must retain a DSHS licensed asbestos consultant to assist with the notification, develop abatement/mitigation procedures, and perform management activities as necessary. The notification form to DSHS must be postmarked at least 15 working days prior to scheduled demolition.

If "No", then TxDOT is still required to notify DSHS 15 working days prior to any scheduled demolition.

In either case, the Contractor is responsible for providing the date(s) for abatement activities and/or demolition with careful coordination between the Engineer and asbestos consultant in order to minimize construction delays and subsequent claims.

Any other evidence indicating possible hazardous materials or contamination discovered on site. Hazardous Materials or Contamination Issues Specific to this Project:

No Action Required Required Action

Action No.

-
-


VII. OTHER ENVIRONMENTAL ISSUES

(includes regional issues such as Edwards Aquifer District, etc.)

No Action Required Required Action

Action No.

- Tree removal should be planned to take place outside the bird nesting season (April 1-Aug 31). If the tree removal occurs between April 1 and August 31, the contractor shall complete a survey of active bird nests and will coordinate with the TxDOT Amarillo District Environmental Coordinator to determine appropriate survey procedures in accordance with TxDOT requirements.

		Design Division Standard		
<p>ENVIRONMENTAL PERMITS, ISSUES AND COMMITMENTS</p> <p>EPIC</p>				
FILE: epic.dgn	DN: TxDOT	CK: RG	DW: VP	CK: AR
© TxDOT: February 2015	CONT	SECT	JOB	HIGHWAY
12-12-2011 (DS) REVISIONS	0904	02	047	VARIOUS
05-07-14 ADDED NOTE SECTION IV.	DIST	COUNTY	SHEET NO.	
01-23-2015 SECTION I (CHANGED ITEM 1122 TO ITEM 506, ADDED GRASSY SWALES.	AMA	POTTER	092	

SITE DESCRIPTION

PROJECT LIMITS: FROM US 87 (N BUCHANAN ST) TO N GRAND ST

PROJECT DESCRIPTION: FOR THE CONSTRUCTION OF ADA CURB RAMPS, SIDEWALK, AND MISCELLANEOUS PEDESTRIAN ELEMENTS

MAJOR SOIL DISTURBING ACTIVITIES: VEGETATIVE CLEARING, EXCAVATION AND/OR FILL, GRADING, CONSTRUCTION OF CURB RAMPS, SIDEWALK, AND MISCELLANEOUS PEDESTRIAN ELEMENTS, FINAL SURFACE PREPARATION AND STABILIZATION (GRADING, TOPSOIL, AND SODDING)

TOTAL PROJECT AREA: 31.52 Acres

TOTAL AREA TO BE DISTURBED: 3.78 Acres

WEIGHTED RUNOFF COEFFICIENT
(BEFORE CONSTRUCTION): N.A.
(AFTER CONSTRUCTION): N.A.

EXPLANATION OF THE TECHNICAL BASIS USED TO SELECT THE PRACTICES TO CONTROL POLLUTION WHERE FLOWS EXCEED PRE-DEVELOPMENT LEVELS

EXISTING CONDITION OF SOIL & VEGETATIVE COVER AND % OF EXISTING VEGETATIVE COVER: N.A.

NAME OF RECEIVING WATERS:

Non-jurisdictional Playa Lakes

SOIL STABILIZATION PRACTICES:

- TEMPORARY SEEDING
- PERMANENT PLANTING, SODDING, OR SEEDING
- MULCHING
- SOIL RETENTION BLANKET
- BUFFER ZONES
- PRESERVATION OF NATURAL RESOURCES

OTHER:

EROSION AND SEDIMENT CONTROLS

STRUCTURAL PRACTICES:

Permanent Temporary

- SILT FENCES
- HAY BALES
- ROCK BERMS
- DIVERSION, INTERCEPTOR, OR PERIMETER DIKES
- DIVERSION, INTERCEPTOR, OR PERIMETER SWALES
- DIVERSION DIKE AND SWALE COMBINATIONS
- PIPE SLOPE DRAINS
- PAVED FLUMES
- ROCK BEDDING AT CONSTRUCTION EXIT
- TIMBER MATTING AT CONSTRUCTION EXIT
- CHANNEL LINERS
- SEDIMENT TRAPS
- SEDIMENT BASINS
- STORM INLET SEDIMENT TRAP
- STONE OUTLET STRUCTURES
- CURBS AND GUTTERS
- STORM SEWERS
- VELOCITY CONTROL DEVICES

OTHER:

NARRATIVE - SEQUENCE OF CONSTRUCTION (STORM WATER MANAGEMENT) ACTIVITIES:

STORM WATER MANAGEMENT: (Sequence of Construction)

(Describe Storm Water Management Activities by Phases. See Example Below.)

The order of activities will be as follows:

- 1. Install perimeter controls, clear R.O.W. on side where construction will take place, and make required utility adjustments*

DESCRIPTION OF ANY MEASURES INSTALLED DURING THE CONSTRUCTION PROCESS TO CONTROL STORM WATER DISCHARGES AFTER CONSTRUCTION OPERATIONS HAVE BEEN COMPLETED:

OTHER EROSION AND SEDIMENT CONTROLS:

MAINTENANCE: All erosion and sediment controls will be maintained in good working order. If a repair is necessary, it will be done at the earliest date possible, but no later than 7 calendar days after the surrounding exposed ground has dried sufficiently to prevent further damage from heavy equipment. The areas adjacent to creeks and drainage ways shall have priority followed by devices protecting storm sewer inlets.

OTHER EROSION AND SEDIMENT CONTROLS CONTINUED:

INSPECTION: For areas of the construction site that have not been finally stabilized, area used for storage of materials, structural control measures, and locations where vehicles enter or exit the site, personnel provided by the permittee and familiar with the SW3P must inspect disturbed areas at least once every fourteen (14) calendar days and within twenty-four (24) hours of the end of a storm event 0.5 inches or greater.

WASTE MATERIALS: All waste materials will be collected and stored in a securely lidded dumpster. All trash and construction debris from the site will be deposited as necessary at a local dump. No construction waste material will be buried on site.

HAZARDOUS WASTE (INCLUDING SPILL REPORTING): At a minimum, any products in the following categories to be hazardous: Paints, Acids for cleaning masonry surfaces, Cleaning Solvents, Asphalt products, Chemical additives for soil stabilization, or Concrete curing compounds and additives. In the event of a spill which may be hazardous, the spill Coordinator should be contacted immediately at (806) 356-3200. Emptying of excess concrete should not be allowed on site. Likewise, washout of concrete trucks should not be performed on site. These discharges are considered non-allowable non-storm water discharges. Concrete trucks should never be allowed to dump into storm drains or sanitary sewers.

SANITARY WASTE: All sanitary waste will be collected from the portable units as necessary or as required by local regulation by a licensed sanitary waste management contractor.

OFF SITE VEHICLE TRACKING:

- HAUL ROADS DAMPENED FOR DUST CONTROL
- LOADED HAUL TRUCKS TO BE COVERED WITH TARPULIN
- EXCESS DIRT ON ROAD REMOVED DAILY
- STABILIZED CONSTRUCTION ENTRANCE

OTHER: Contractor shall adhere to the following:

1. Construction Materials List of materials stored on job site to be provided by Contractor.
2. The project SW3P File shall be located at the project field office or within the Contractor's mobile office at all times and shall contain the N.O.I., CGP, Signature Authorization, Certification/Qualification Statements, Inspection Reports, Required Maps, and the TPDES Permit, Part II. This File to be presented to authorized State and Federal Agents upon request.





REMARKS:

1/27/2022 P:\Jobs\2020007-Pedestrian TxDOT Amarillo\CADD\B3-SHEETS\ENVIRONMENTAL ISSUES\093_TxDOT_STORM_WATER_POLLUTION_PREVENTION_PLAN (SW3P).dgn



TxDOT STORM WATER
POLLUTION PREVENTION
PLAN (SW3P)

FED. RD. DIV. NO.	PROJECT NO.		SHEET NO.
6			093
STATE	DIST.	COUNTY	
TEXAS	AMA	POTTER	
CONT.	SECT.	JOB	HIGHWAY NO.
0904	02	047	VARIOUS

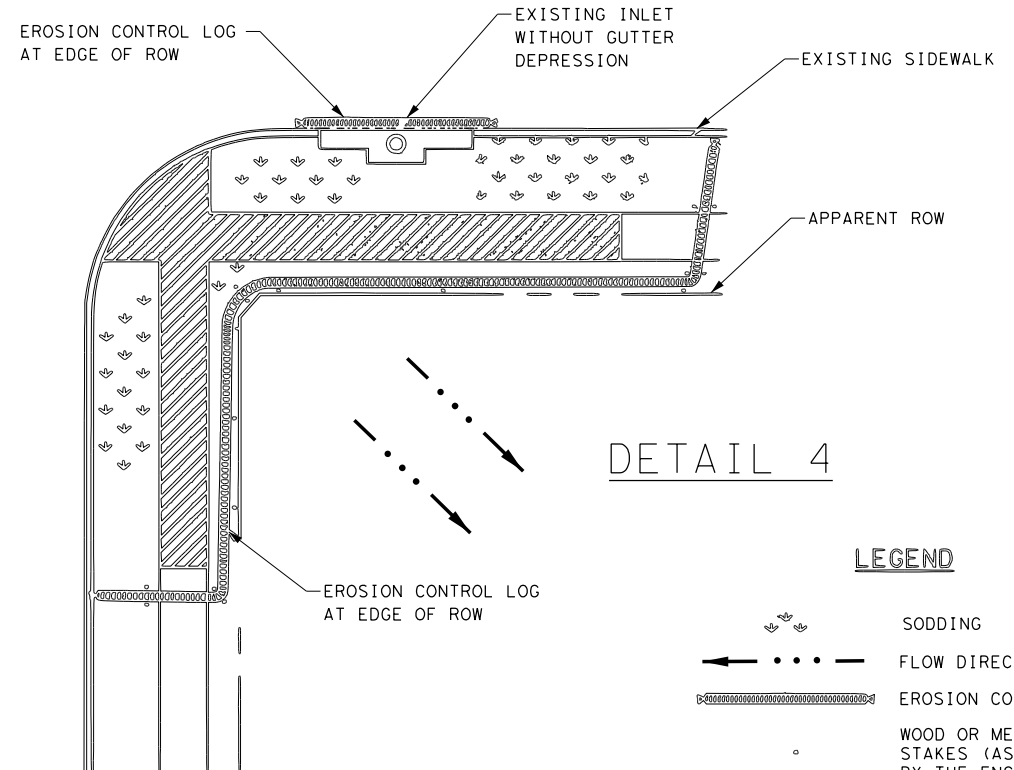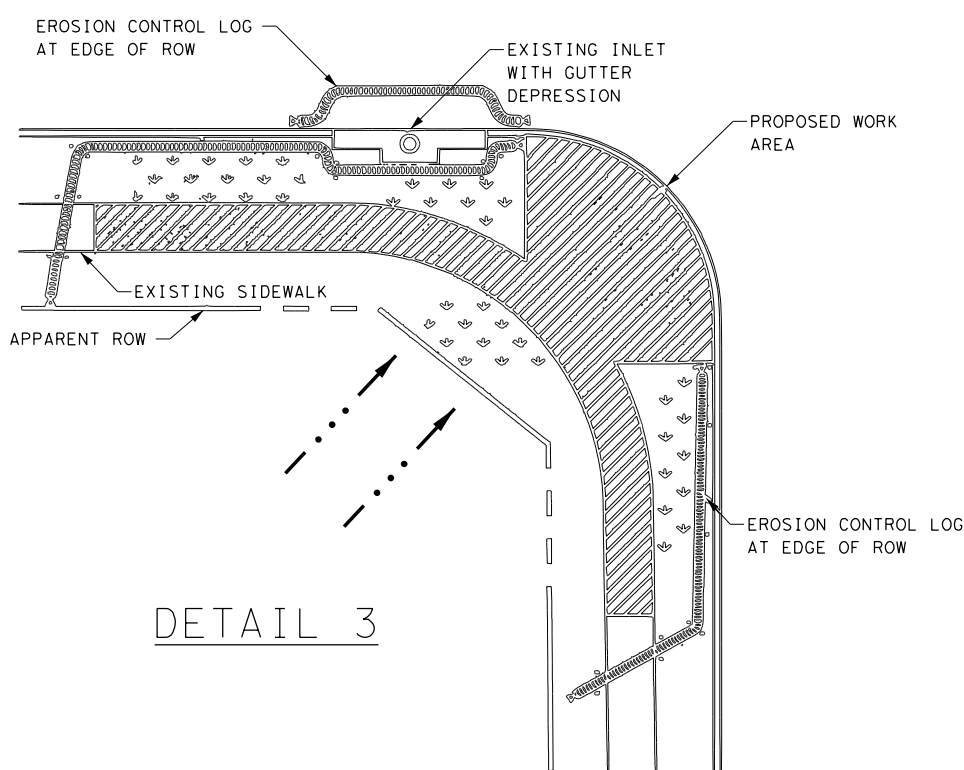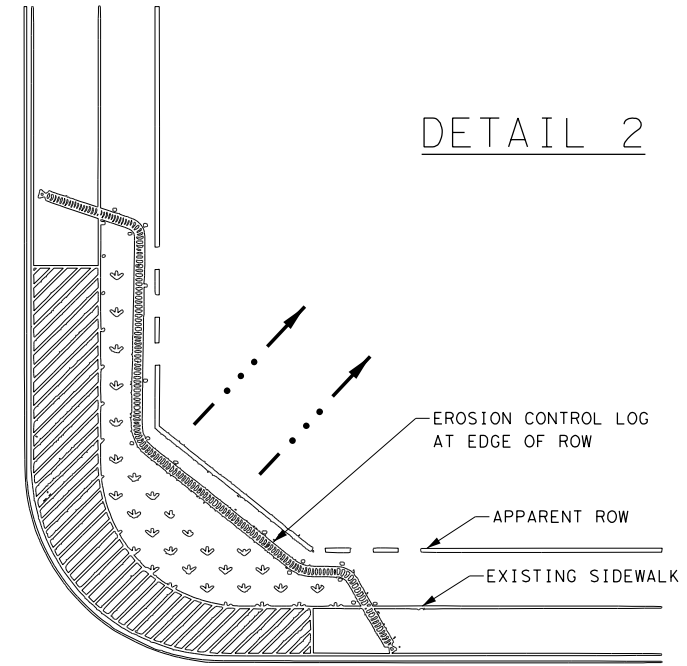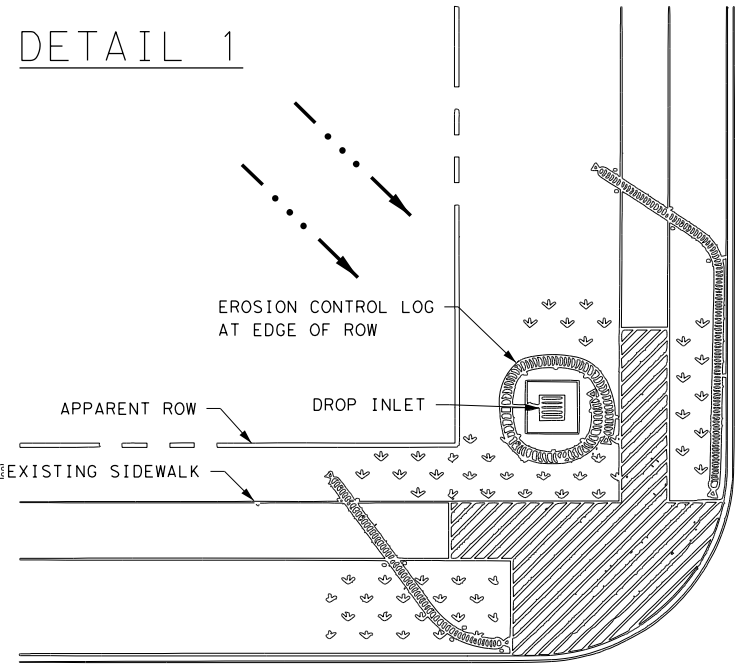

- LEGEND**
- SODDING
 - FLOW DIRECTION
 - EROSION CONTROL LOG
 - WOOD OR METAL STAKES (AS APPROVED BY THE ENGINEER)
 - EXISTING FEATURES
 - PROPOSED WORK AREA

- NOTES:**
1. REFERENCE ENVIRONMENTAL PERMITS, ISSUES AND COMMITMENTS (EPIC) AND STORM WATER POLLUTION PREVENTION PLAN (SW3P) STANDARDS FOR SPECIFIC CONSTRUCTION CONSIDERATIONS OR REQUIREMENTS.
 2. EXAMPLES SHOWN ON THE SHEET ARE FOR GENERAL GUIDANCE AND MAY BE MODIFIED AS DIRECTED BY THE ENGINEER.
 3. TEMPORARY SEDIMENT CONTROL FENCE MAY BE USED IN LIEU OF EROSION CONTROL. LOGS WHERE APPROVED BY THE ENGINEER.
 4. SITE CONDITIONS MAY DICTATE ADDITIONAL COUNTER MEASURES AS DIRECTED BY THE ENGINEER.
 5. USE ADDITIONAL STAKES AS NEEDED TO HOLD IN PLACE (NSPI).
 6. INSTALLATION OF COUNTERMEASURES MUST BE APPROVED BY THE ENGINEER PRIOR TO PLACEMENT.



GLOBAL CIVIL SOLUTIONS, LLC
 11551 FOREST CENTRAL DRIVE
 SUITE 220
 DALLAS, TX 75243
 F-12801




SW3P GENERAL LAYOUT

DESIGN				SHEET 1 OF 1	
MI	FED. RD. DIV. NO.	FEDERAL AID PROJECT NO.	HIGHWAY NO.		VARIOUS
PS	6	(SEE TITLE SHEET)			
CHECK	STATE	DISTRICT	COUNTY	SHEET NO.	094
MFM	TEXAS	AMA	POTTER		
CHECK	CONTROL	SECTION	JOB		
FS	0904	02	047		

P:\Jobs\2020007-Pedestrian\TxDOT\Amort\110\CA00\PS\SHEETS\ENVIRONMENTAL ISSUES\094-SW3P GENERAL LAYOUT.dgn
 2:11:42 PM
 3/15/2022


DISCLAIMER: This standard is governed by the "Texas Engineering Practice Act". No warranty of any kind is made by TxDOT for any purpose whatsoever. The use of this standard is governed by the "Texas Engineering Practice Act". No warranty of any kind is made by TxDOT for any purpose whatsoever. TxDOT assumes no responsibility for the conversion of this standard to other formats or for incorrect results or damages resulting from its use.

DATE
FILE

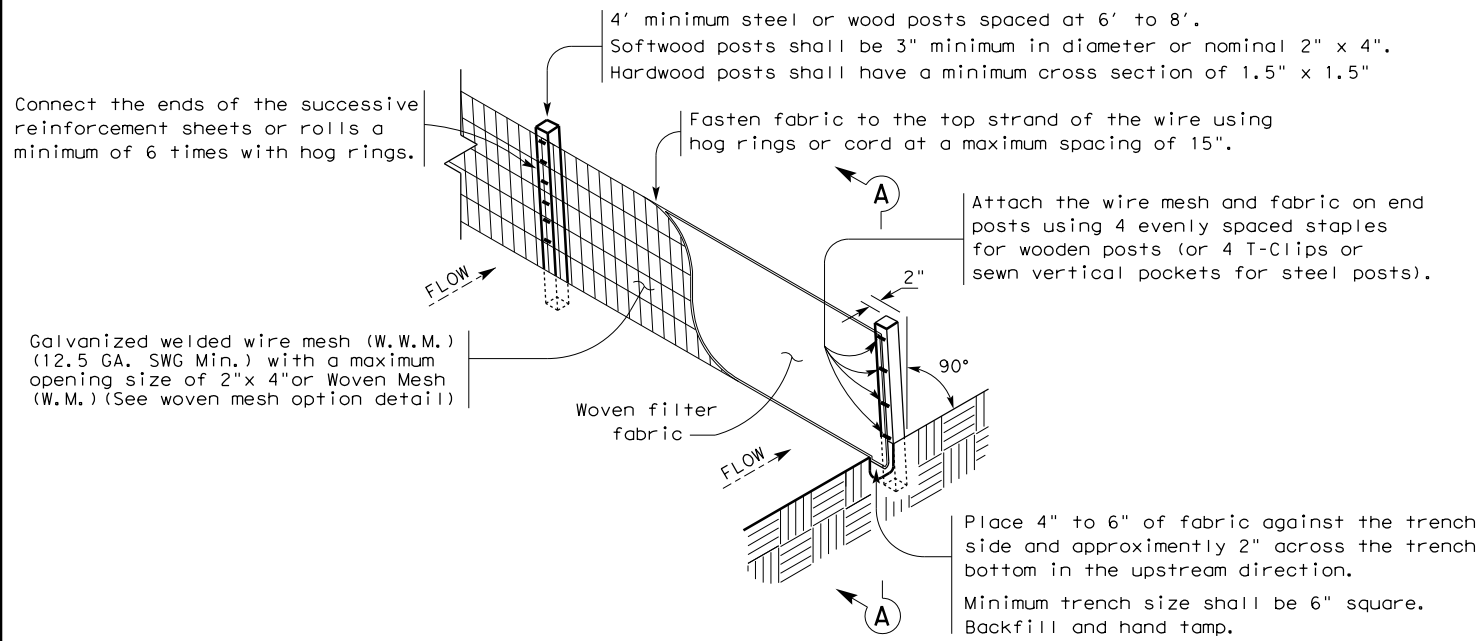

TEMPORARY SEDIMENT CONTROL FENCE

SCF

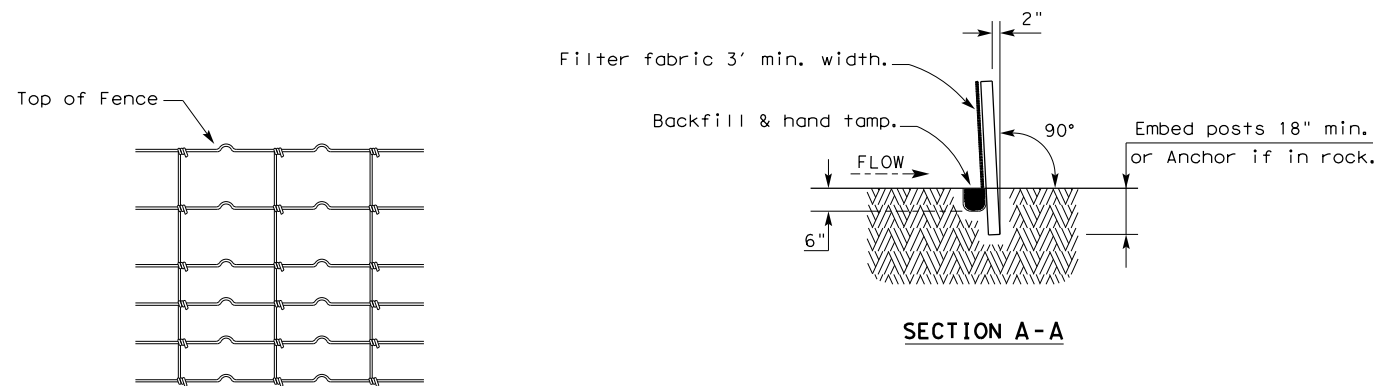

HINGE JOINT KNOT WOVEN MESH (OPTION) DETAIL

Galvanized hinge joint knot woven mesh (12.5 GA. SWG Min.) requires a minimum of five horizontal wires spaced at a maximum of 12 inches apart and all vertical wires spaced at a maximum of 12 inches apart.

SEDIMENT CONTROL FENCE USAGE GUIDELINES

A sediment control fence may be constructed near the downstream perimeter of a disturbed area along a contour to intercept sediment from overland runoff. A 2 year storm frequency may be used to calculate the flow rate to be filtered.

Sediment control fence should be sized to filter a maximum flow through rate of 100 GPM/FT². Sediment control fence is not recommended to control erosion from a drainage area larger than 2 acres.


LEGEND

Sediment Control Fence

SCF

GENERAL NOTES

1. Vertical tracking is required on projects where soil distributing activities have occurred unless otherwise approved.
2. Perform vertical tracking on slopes to temporarily stabilize soil.
3. Provide equipment with a track undercarriage capable of producing linear soil impressions measuring a minimum of 12" in length by 2" to 4" in width by 1/2" to 2" in depth.
4. Do not exceed 12" between track impressions.
5. Install continuous linear track impressions where the minimum 12" length impressions are perpendicular to the slope or direction of water flow.

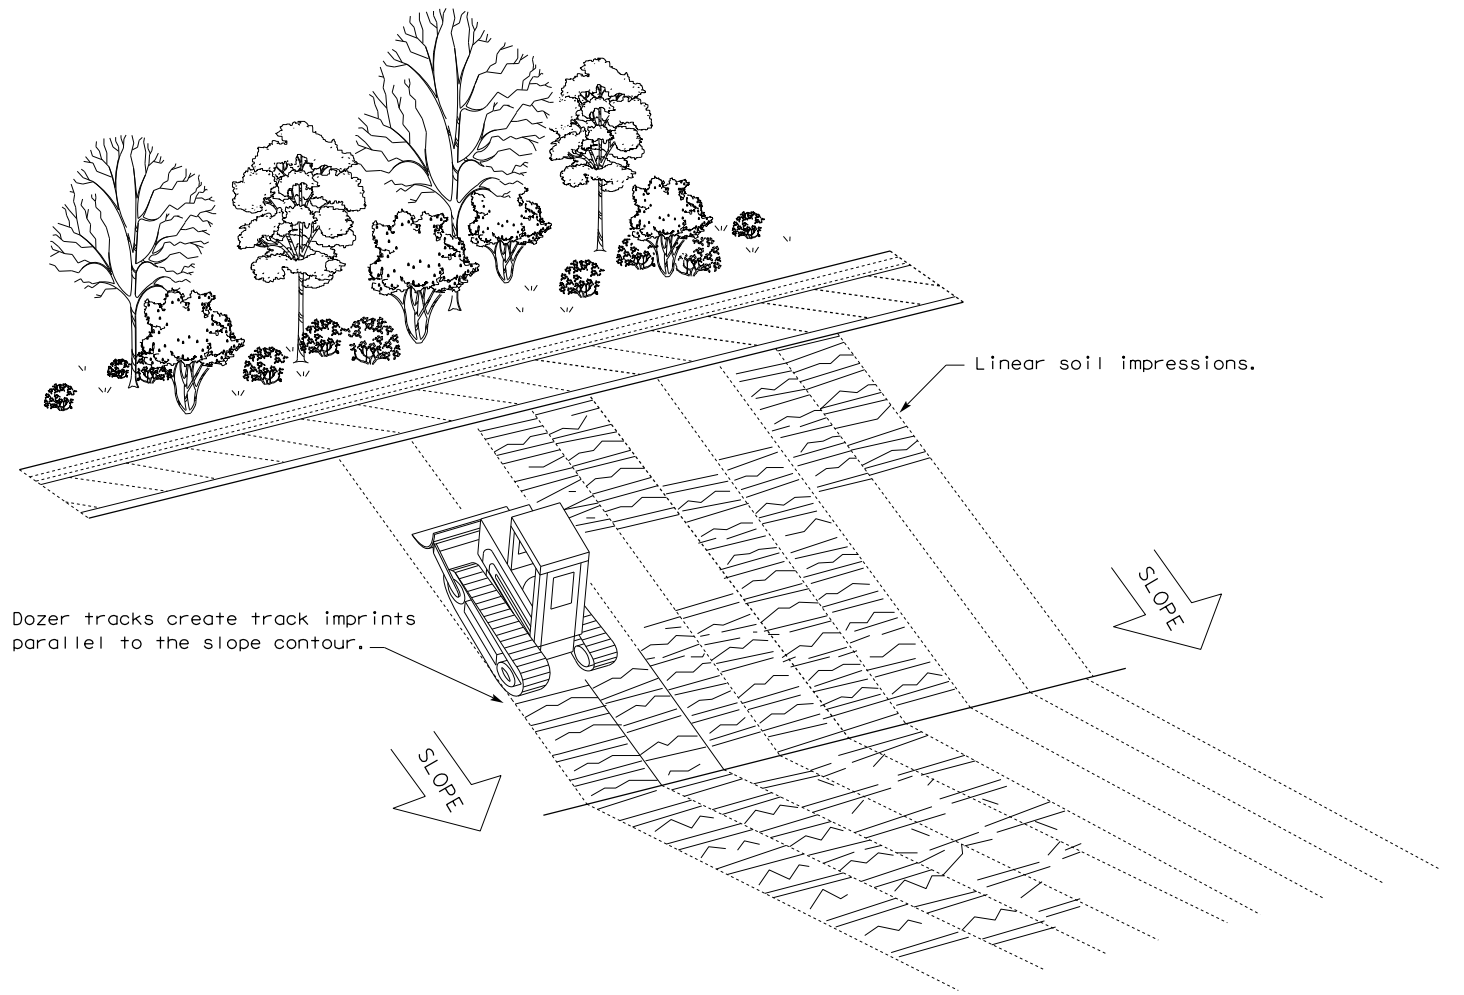

VERTICAL TRACKING




TEMPORARY EROSION, SEDIMENT AND WATER POLLUTION CONTROL MEASURES FENCE & VERTICAL TRACKING EC(1)-16


FILE: ec116	DN: TxDOT	CK: KM	DW: VP	DN/CK: LS
© TxDOT: JULY 2016	CONT	SECT	JOB	HIGHWAY
REVISIONS	904	02	047	VARIOUS
	DIST	COUNTY	SHEET NO.	
	AMA	POTTER	095	

DISCLAIMER: This standard is governed by the "Texas Engineering Practice Act". No warranty of any kind is made by TxDOT for any purpose whatsoever. The use of this standard for the conversion of this standard to other formats or for incorrect results or damages resulting from its use. TxDOT assumes no responsibility for the conversion of this standard to other formats or for incorrect results or damages resulting from its use.

DATE:
FILE:

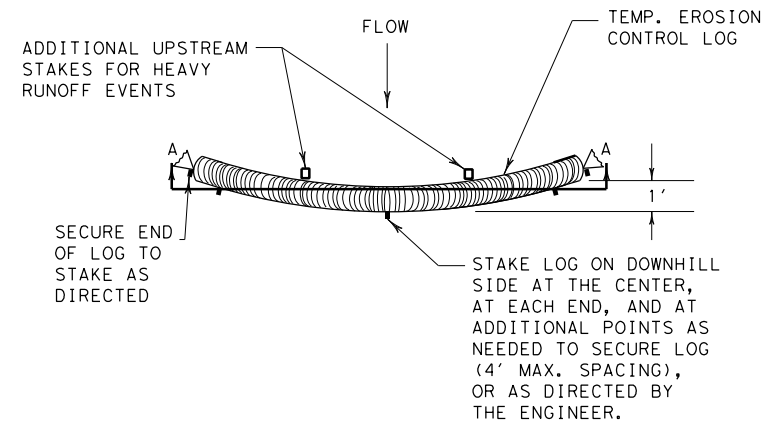


PLAN VIEW

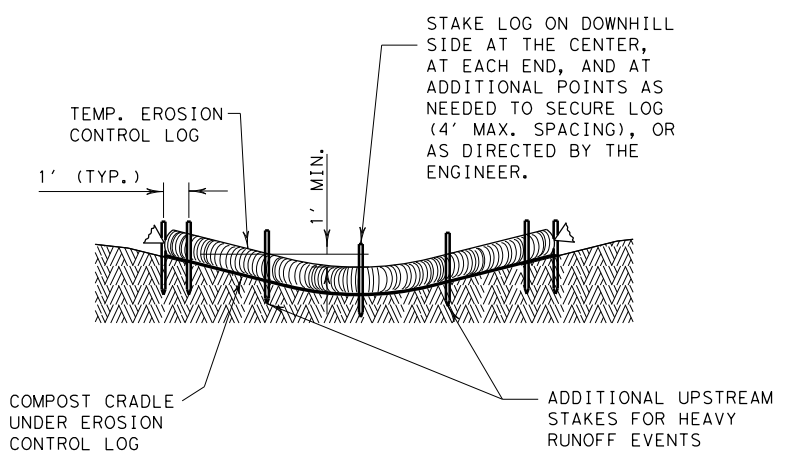


SECTION A-A

EROSION CONTROL LOG DAM

CL-D

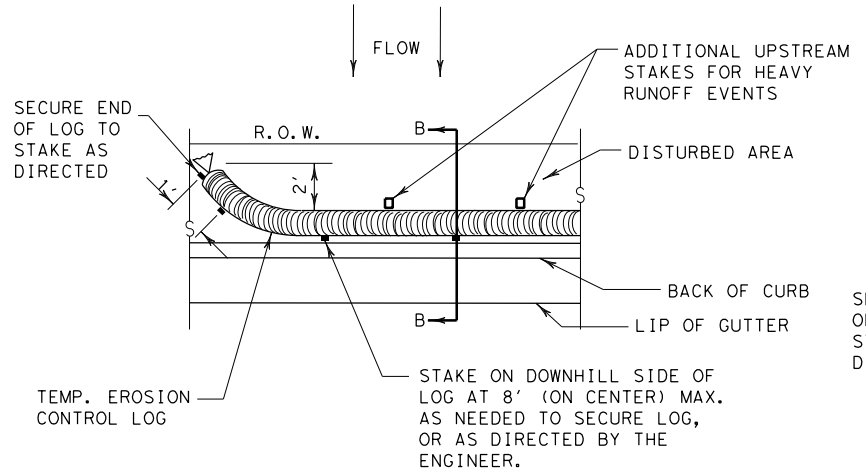


PLAN VIEW

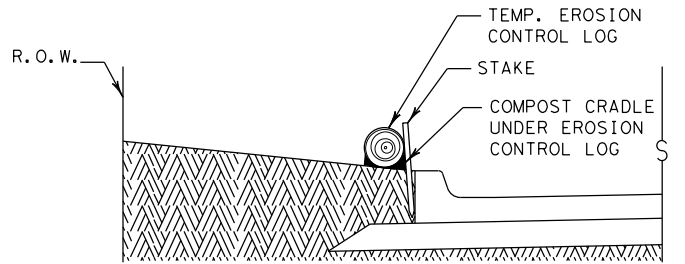


SECTION B-B

EROSION CONTROL LOG AT BACK OF CURB

CL-BOC

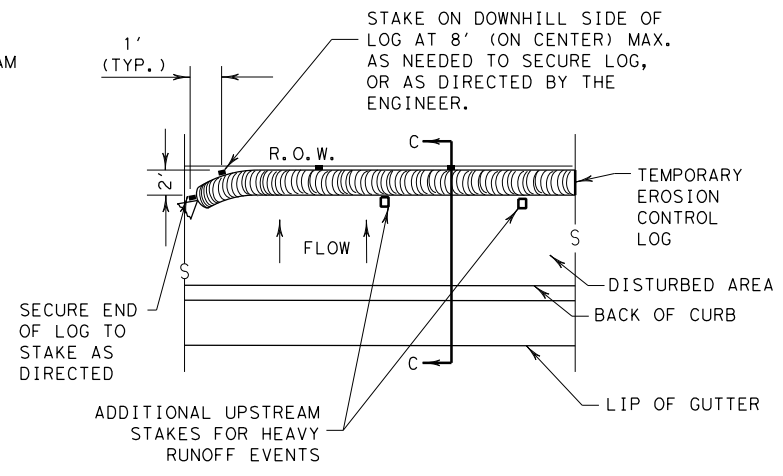


PLAN VIEW

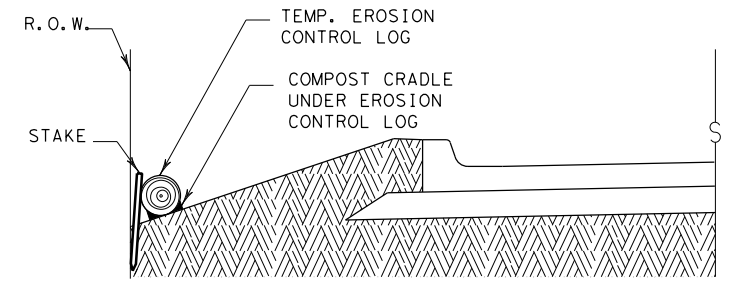

SECTION C-C


EROSION CONTROL LOG AT EDGE OF RIGHT-OF-WAY

CL-ROW

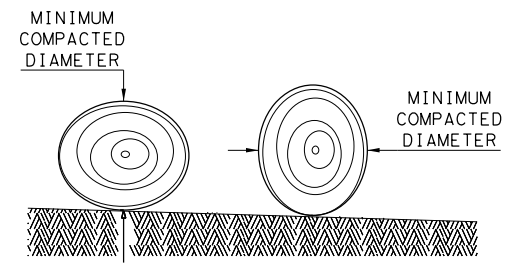

DIAMETER MEASUREMENTS OF EROSION CONTROL LOGS SPECIFIED IN PLANS

- LEGEND**
- CL-D EROSION CONTROL LOG DAM
 - CL-BOC EROSION CONTROL LOG AT BACK OF CURB
 - CL-ROW EROSION CONTROL LOG AT EDGE OF RIGHT-OF-WAY
 - CL-SST EROSION CONTROL LOGS ON SLOPES STAKE AND TRENCHING ANCHORING
 - CL-SSL EROSION CONTROL LOGS ON SLOPES STAKE AND LASHING ANCHORING
 - CL-DI EROSION CONTROL LOG AT DROP INLET
 - CL-CI EROSION CONTROL LOG AT CURB INLET
 - CL-GI EROSION CONTROL LOG AT CURB & GRATE INLET

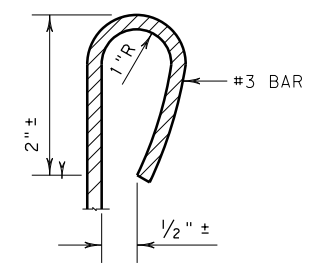

REBAR STAKE DETAIL

SEDIMENT BASIN & TRAP USAGE GUIDELINES

An erosion control log sediment trap may be used to filter sediment out of runoff draining from an unstabilized area.

Log Traps: The drainage area for a sediment trap should not exceed 5 acres. The trap capacity should be 1800 CF/Acre (0.5" over the drainage area).

Control logs should be placed in the following locations:

1. Within drainage ditches spaced as needed or min. 500' on center
2. Immediately preceding ditch inlets or drain inlets
3. Just before the drainage enters a water course
4. Just before the drainage leaves the right of way
5. Just before the drainage leaves the construction limits where drainage flows away from the project.

The logs should be cleaned when the sediment has accumulated to a depth of 1/2 the log diameter.

Cleaning and removal of accumulated sediment deposits is incidental and will not be paid for separately.

GENERAL NOTES:


1. EROSION CONTROL LOGS SHALL BE INSTALLED IN ACCORDANCE WITH MANUFACTURER'S RECOMMENDATIONS, OR AS DIRECTED BY THE ENGINEER.
2. LENGTHS OF EROSION CONTROL LOGS SHALL BE IN ACCORDANCE WITH MANUFACTURER'S RECOMMENDATIONS AND AS REQUIRED FOR THE PURPOSE INTENDED.
3. UNLESS OTHERWISE DIRECTED, USE BIODEGRADABLE OR PHOTODEGRADABLE CONTAINMENT MESH ONLY WHERE LOG WILL REMAIN IN PLACE AS PART OF A VEGETATIVE SYSTEM. FOR TEMPORARY INSTALLATIONS, USE RECYCLABLE CONTAINMENT MESH.
4. FILL LOGS WITH SUFFICIENT FILTER MATERIAL TO ACHIEVE THE MINIMUM COMPACTED DIAMETER SPECIFIED IN THE PLANS WITHOUT EXCESSIVE DEFORMATION.
5. STAKES SHALL BE 2" X 2" WOOD OR #3 REBAR, 2'-4' LONG, EMBEDDED SUCH THAT 2" PROTRUDES ABOVE LOG, OR AS DIRECTED BY THE ENGINEER.
6. DO NOT PLACE STAKES THROUGH CONTAINMENT MESH.
7. COMPOST CRADLE MATERIAL IS INCIDENTAL & WILL NOT BE PAID FOR SEPARATELY.
8. SANDBAGS USED AS ANCHORS SHALL BE PLACED ON TOP OF LOGS & SHALL BE OF SUFFICIENT SIZE TO HOLD LOGS IN PLACE.
9. TURN THE ENDS OF EACH ROW OF LOGS UPSLOPE TO PREVENT RUNOFF FROM FLOWING AROUND THE LOG.
10. FOR HEAVY RUNOFF EVENTS, ADDITIONAL UPSTREAM STAKES MAY BE NECESSARY TO KEEP LOG FROM FOLDING IN ON ITSELF.

SHEET 1 OF 3

		Design Division Standard	
TEMPORARY EROSION, SEDIMENT AND WATER POLLUTION CONTROL MEASURES			
EROSION CONTROL LOG			
EC (9) - 16			
FILE: ec916	DN: TxDOT	CK: KM	DW: LS/PT
© TxDOT: JULY 2016	CONT: 904	SECT: 02	JOB: 047
REVISIONS			HIGHWAY: VARIOUS
	DIST: AMA	COUNTY: POTTER	SHEET NO.: 096


DISCLAIMER: The use of this standard is governed by the "Texas Engineering Practice Act". No warranty of any kind is made by TxDOT for any purpose whatsoever. TxDOT assumes no responsibility for the conversion of this standard to other formats or for incorrect results or damages resulting from its use.

DATE:
FILE:

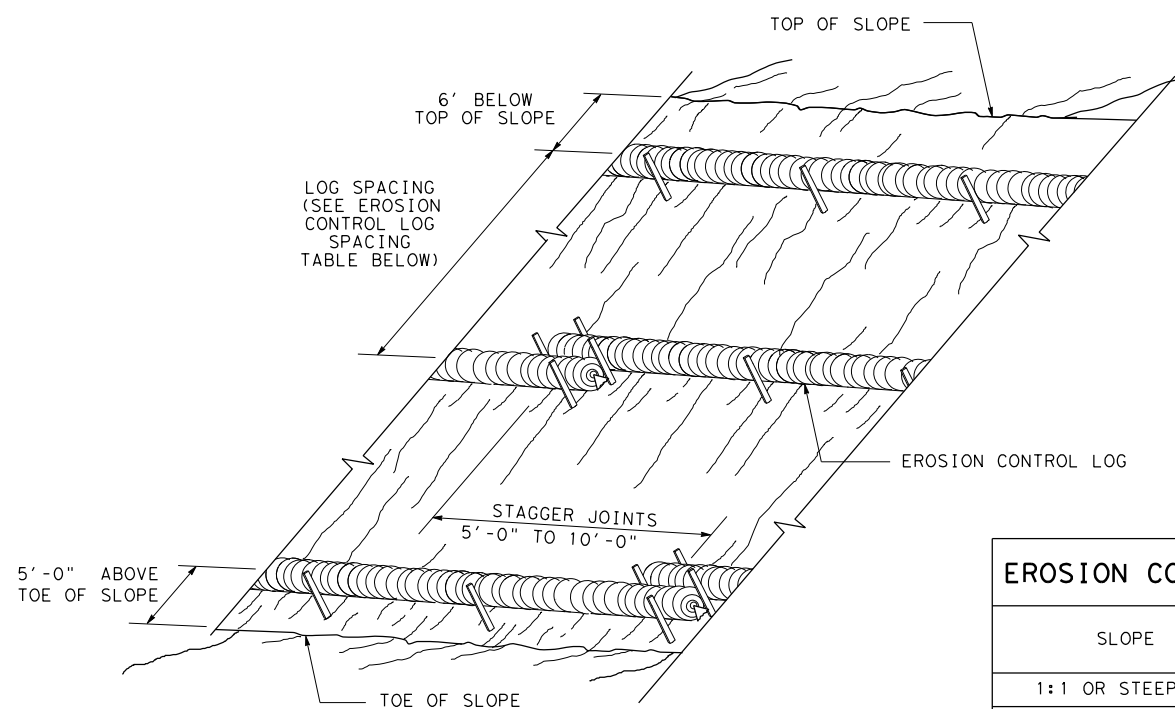


**EROSION CONTROL LOGS ON SLOPES
STAKE AND TRENCHING ANCHORING**

CL-SST

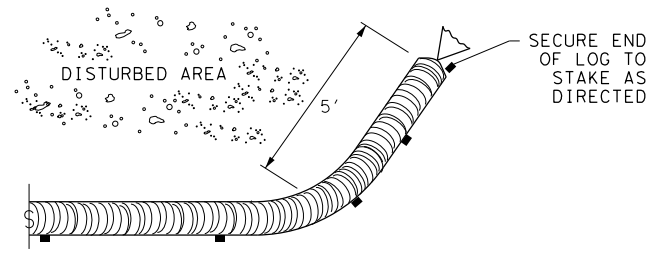

END SECTION RAP DETAIL

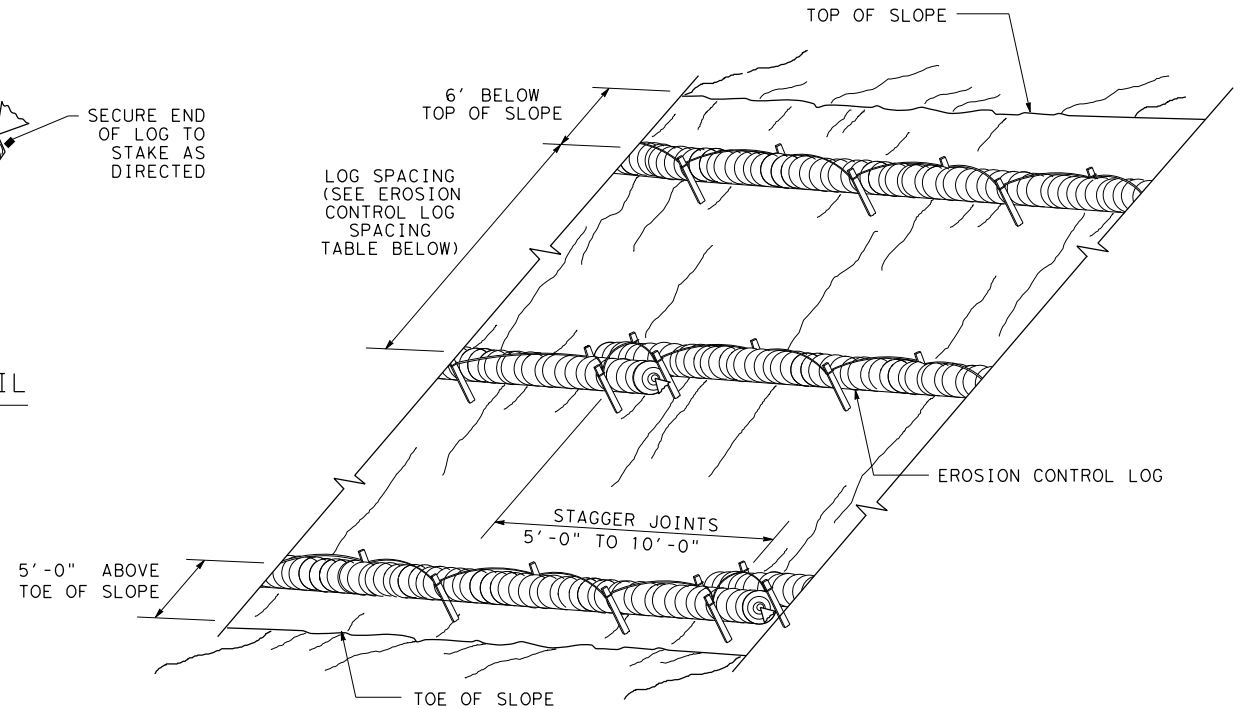


**EROSION CONTROL LOGS ON SLOPES
STAKE AND LASHING ANCHORING**

CL-SSL



SLOPE	LOG DIAMETER			
	6"	8"	12"	18"
1:1 OR STEEPER	5'	10'	15'	20'
2:1	10'	20'	30'	40'
3:1	15'	30'	45'	60'
4:1 OR FLATTER	20'	40'	60'	80'

* ADJUSTMENTS CAN BE MADE FOR SOIL TYPE:
SOFT, LOAMY SOILS-ADJUST ROWS CLOSER TOGETHER;
HARD, ROCKY SOILS- ADJUST ROWS FARTHER APART

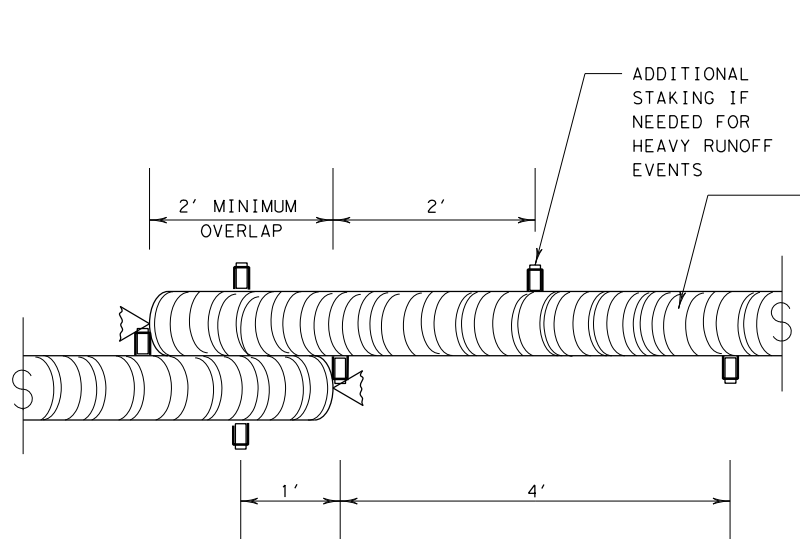


STAKE AND TRENCHING ANCHORING DETAIL

CL-SST

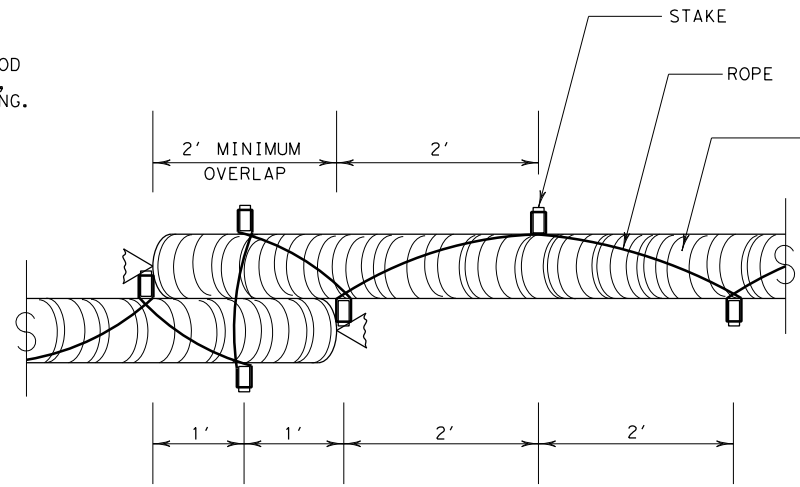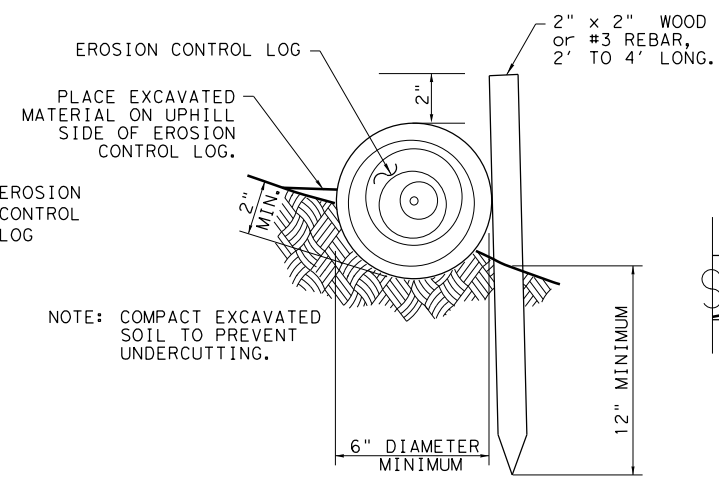


STAKE AND LASHING ANCHORING DETAIL

CL-SSL

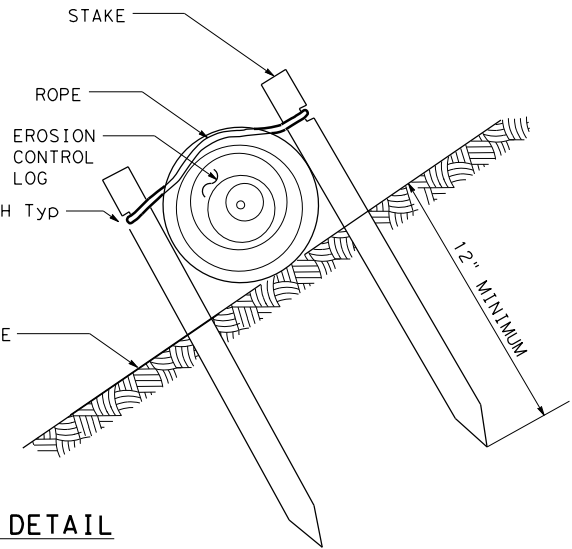

TRENCH DEPTH TABLE	
LOG DIAMETER	DEPTH
6"	2"
8"	3"
12"	4"
18"	5"

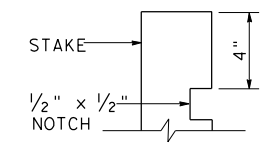


STAKE NOTCH DETAIL

SHEET 2 OF 3


		Design Division Standard	
TEMPORARY EROSION, SEDIMENT AND WATER POLLUTION CONTROL MEASURES EROSION CONTROL LOG EC (9) - 16			
FILE: ec116	DN: TxDOT	CK: KM	DW: LS/PT
© TxDOT: JULY 2016	CONT: 904	SECT: 02	JOB: 047
REVISIONS	DIST: AMA		COUNTY: POTTER
			SHEET NO.: 097

DISCLAIMER: This standard is governed by the "Texas Engineering Practice Act". No warranty of any kind is made by TxDOT for any purpose whatsoever. TxDOT assumes no responsibility for the conversion of this standard to other formats or for incorrect results or damages resulting from its use.

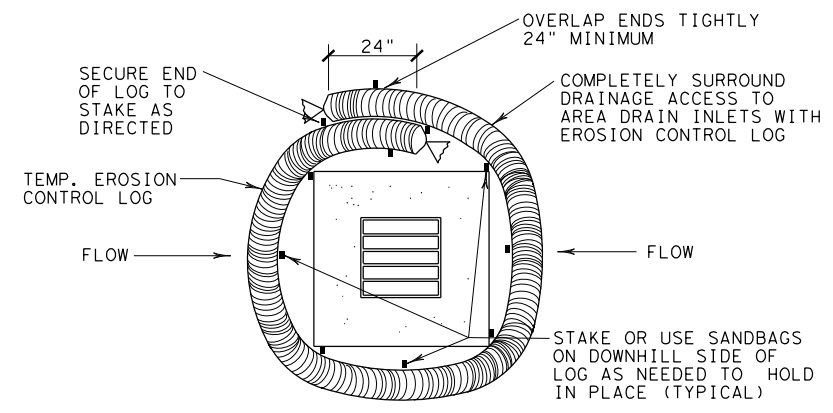


EROSION CONTROL LOG AT DROP INLET

CL-DI

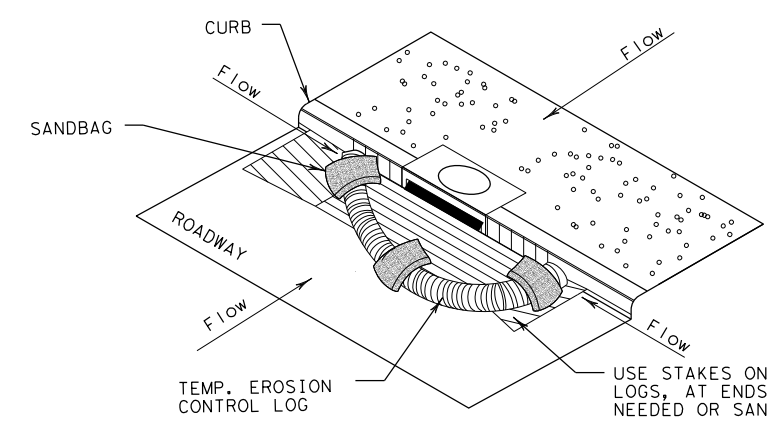

EROSION CONTROL LOG AT CURB INLET


CL-CI

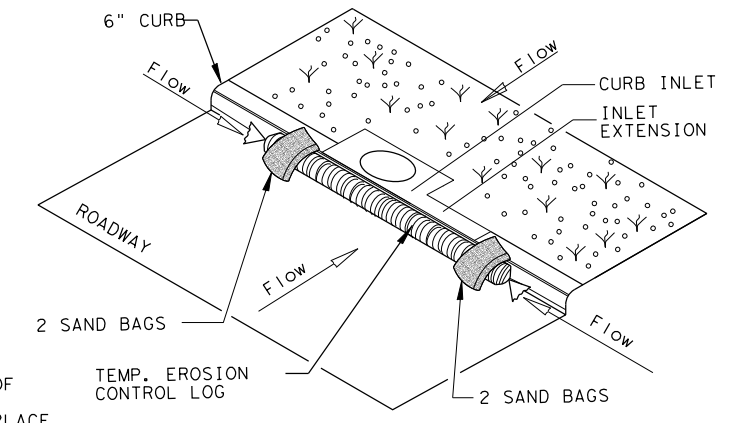

EROSION CONTROL LOG AT CURB INLET


CL-CI

NOTE:
EROSION CONTROL LOGS USED AT CURB INLETS SHOULD ONLY BE USED IF THEY WILL NOT IMPEDE TRAFFIC OR FLOOD THE ROADWAY OR WHEN THE STORM SEWER SYSTEM IS NOT FULLY FUNCTIONAL.

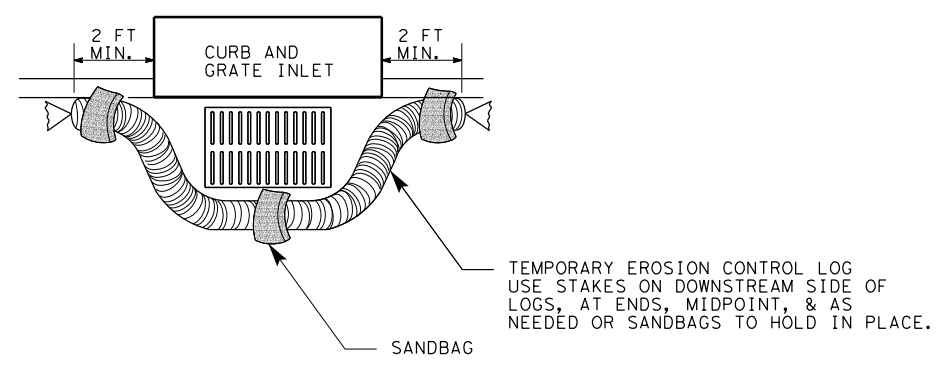

EROSION CONTROL LOG AT CURB & GRADE INLET

CL-GI

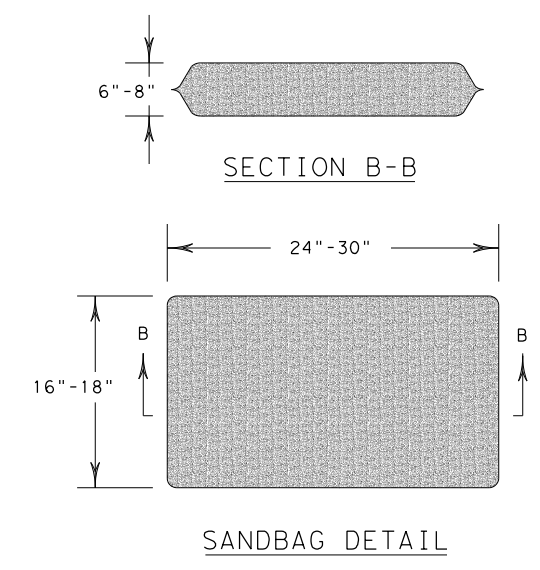

SHEET 3 OF 3

				Design Division Standard	
TEMPORARY EROSION, SEDIMENT AND WATER POLLUTION CONTROL MEASURES EROSION CONTROL LOG EC (9) - 16					
FILE: ec916	DN: TxDOT	CK: KM	DW: LS/PT	CK: LS	
© TxDOT: JULY 2016	CONT	SECT	JOB	HIGHWAY	
REVISIONS	904	02	047	VARIOUS	
	DIST	COUNTY	SHEET NO.		
	AMA	POTTER	098		

DATE:
FILE: