DocuSign Envelope ID: 6E5BC07A-E60D-484D-8510-634F0E42047F STATE OF TEXAS INDEX OF SHEETS DEPARTMENT OF TRANSPORTATION SEE SHEET 2 FOR INDEX OF SHEETS  $\square$ PLANS OF PROPOSED STATE HIGHWAY IMPROVEMENT FEDERAL PROJECT: BR 2023 (226) CSJ: 0923-17-084 CR 392 FINAL PLANS STATEMENT COMANCHE COUNTY THIS AREA S RESERVED FOR THE PE's SEAL THE CONSTRUCTION WORK WAS PERFORMED FOR THE CONSTRUCTION OF BRIDGE REPLACEMENT IN ACCORDANCE WITH THE PLANS. CONSISTING OF REPLACING BRIDGE AND APPROACHES LIMITS: AT RESLEY CREEK P.E. 
 NET LENGTH OF ROADWAY
 =
 300
 FT.
 =
 0.057
 MI.

 NET LENGTH OF BRIDGE
 =
 125
 FT.
 =
 0.024
 MI.
 AREA ENGINEER DATE TEXAS DEPARTMENT OF TRANSPORTATION NET LENGTH OF PROJECT = 425 FT. = 0.081 MI. VOLUME 3 *CONTRACT CSJ:0923-17-090* L.M) CR 30 27 ģ / CR 396 8 CR 388 CR 394 BEGIN PROJECT STA 9+57.00 CSJ: 0923-17-084 CR 105 60 CR 103 8 END PROJECT STA 13+82.00 CSJ: 0923-17-084 CR 607 CA 101 281 (9 CH-30 5  $\tilde{\phantom{a}}$ 202 BR (EM 2905) ENA 2486 PROJ. NO. LETTING DATE FM 218 HAMILTON EXCEPTIONS: NONE NOT TO SCALE EQUATIONS: NONE RAILROAD CROSSING: NONE COMANCH CR 392 ACCEPTED PGAI 12/14/2023 R:\1005000нүш. NO. COUNTY DATE SPECIFICATIONS ADOPTED BY THE TEXAS DEPARTMENT OF TRANSPORTATION, TBPE REG. NO. F-2742 NOVEMBER 1, 2014 AND SPECIFICATION ITEMS LISTED AND DATED AS FOLLOWS, SHALL GOVERN ON THIS PROJECT: REQUIRED CONTRACT PROVISIONS FOR ALL


FEDERAL-AID CONSTRUCTION CONTRACTS (FORM FHWA 1273, OCTOBER 2023)


	FEDERAL AID PROJECT NO.
	CONT SECT JOB HIGHWAY
	CONT SECT JOB HIGHWAY 0923 17 090, ETC CR 260, ETC
-	DIST COUNTY SHEET NO.
E	BWD COMANCHE, ETC 1
DESIGN SP A.D.T. (201 A.D.T. (203	
FINAL PLANS	
LETTING DATE: DATE CONTRACTOR BEGAN WORK:	
DATE WORK WAS COMPLETED & ACCEPTED:	
FINAL CONTRACT COST: \$	
CONTRACTOR :	
REQUIRED SIGNS SHALL BE IN ACC BC (1)- 21 THRU BC (12)- 21 AND 1 MANUAL ON UNIFORM TRAFFIC CO	THE "TEXAS
	12/27/2023
CONCURRENCE:	
	DocuSigned by:
	Stephanne & Davis
C	Dephance of Lauro
COL	-5B0490540F63477 INTY JUDGE
	<b>tment of Transportation</b> F TRANSPORTATION:ALL RIGHTS RESERVED.
SUBMITTED FOR LETTING:	1/3/2024
DocuSigned by:	
/ALS	ETT.P.E.
770447770040405	
77D14777834646F DISTRICT	DESIGN ENGINEER
RECOMMENDED FOR LETTI	1/3/2024 NG:
DocuSigned by:	
	OTTOE
//177 2	A.P.E.
DISTRICT DIRECT	OR OF TRANSPORTATION
PLANNING AI	ND DEVELOPMENT
RECOMMENDED FOR LETTI	1/3/2024 NG:
DocuSigned by:	
Gregory W. (	dillo, P.E.
58E2D01C26B3446TR/	JI ENGINEEK


ά	SHEET		GENERAL INFORMATION	SHEET		BRIDGE
	1		TITTLE SHEET	38		BRIDGE LAYOUT
	2		INDEX OF SHEETS	39 - 40		SOIL BORINGS
:MC	3		TYPICAL SECTIONS	41		ESTIMATED QUANTITIES AND BEARING SEAT ELEVATIONS
	4		QUANTITY SUMMARIES	42		BRIDGE IDENTIFICATION NUMBER
0						
ë			TRAFFIC CONTROL			BRIDGE STANDARDS
	5		TRAFFIC CONTROL PLAN	43 - 45	#	AIG-24
:NG				46	#	AJ
<u>a</u>			TRAFFIC CONTROL STANDARDS	47 - 48	#	CSAB
	6 - 17	#	BC(1)-21 THRU BC(12)-21	49 - 50	#	FD
				51 - 52	#	IGD
			<u>ROADWAY</u>	53 - 55	#	IGEB
	18		SURVEY CONTROL INDEX	56 - 57	#	IGMS
	19		HORIZONTAL & VERTICAL CONTROL	58 - 59	#	IGSD-24
	20		HORIZONTAL ALIGNMENT DATA	60	#	IGSK
	21		ROADWAY PLAN & PROFILE	61	#	IGTS
	22		RIPRAP, GRADING & FENCE LAYOUT	62 - 63	#	MEBR(C)
				64 - 67	#	PCP
			ROADWAY STANDARDS	68	#	PCP-FAB
	23	#	D&OM(1)-20	69 - 70	#	PMDF
	24	#	D&OM(2)-20	71 - 72	#	SIG-24
	25	#	D&OM(3)-20	73 - 74	#	SRR
	26	#	D&OM(5)-20	75 - 77	#	T223
	27	#	D&OM(VIA)-20			
	28	#	GF(31)-19			ENVIRONMENTAL
	29	#	GF(31)-TRTL2-19	78		EPIC
	30	#	SGT(10S)31-16	79 - 80		SWP3
	31	#	SGT(11S)31-18	81		SWP3 LAYOUT
	32	#	SGT(12)31-18	82		TEMPORARY CROSSING
	33	#	WF(1)-10	83 - 84		TRUSS RELOCATION
	34	#	WF(2)-10			
						ENVIRONMENTAL STANDARDS
			DRAINAGE	85	#	EC(1)-16
	35		DRAINAGE AREA MAP	86 - 88	#	EC(9)-16
	36 - 37		HYDRAULIC DATA			

Juis A. Bonalez

LUIS A. GONZĂLEZ

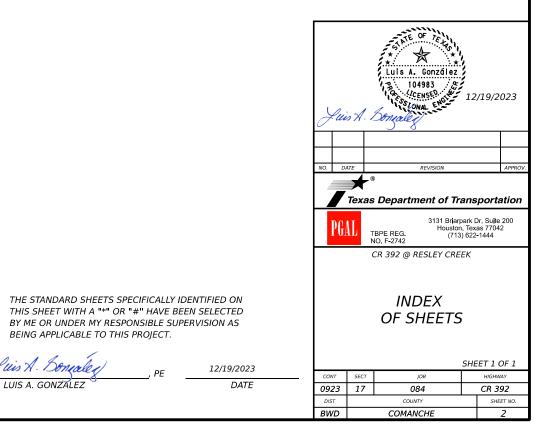

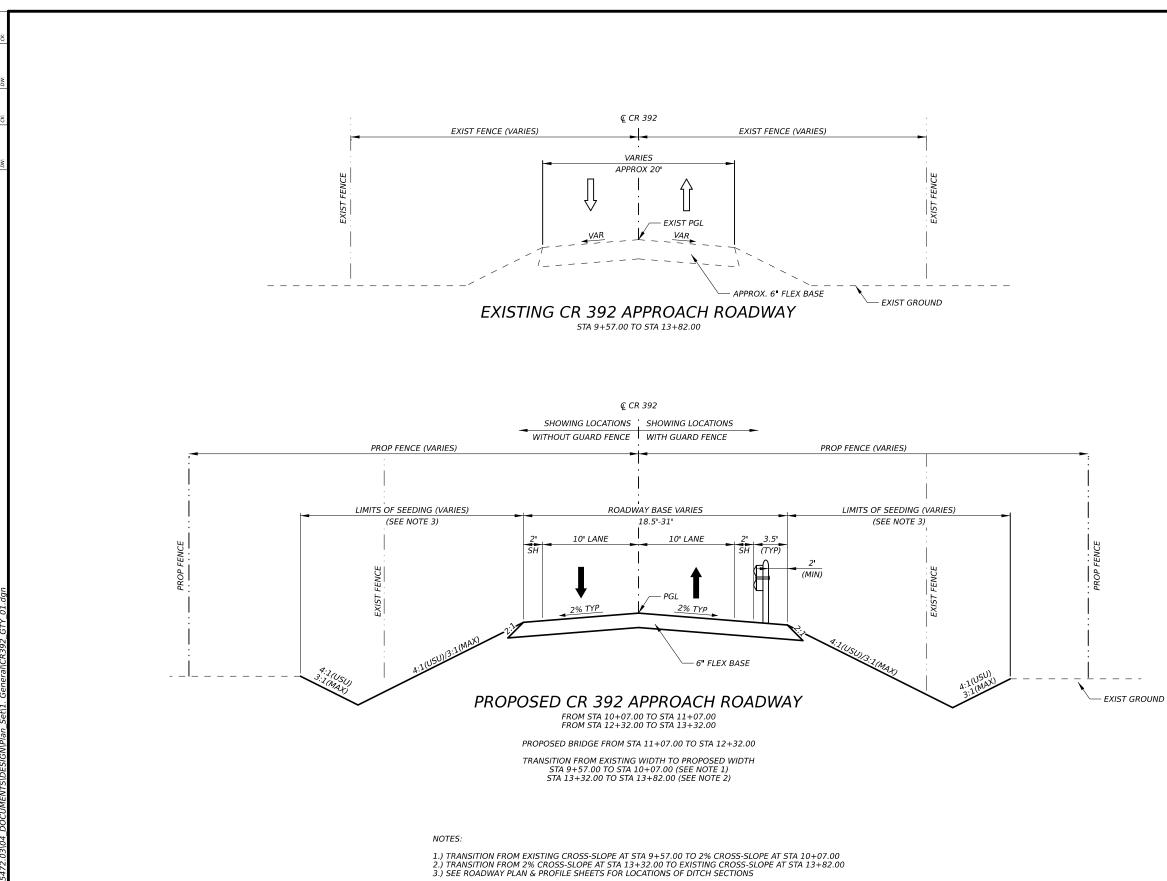


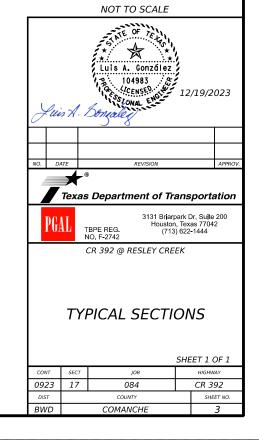

:MQ	
ск;	

					, co, io ii, ii qe				
		100	247	530	540	540	544	658	658
		6002	6055	6016	6002	6007	6001	6014	6062
STATION T	O STATION	1 PREPARING ROW	FL BS (CMP IN PLC)(TY D GR 3)(FNAL POS)	DRIVEWAYS (BASE)	MTL W-BEAM GD FEN (STEEL POST)	MTL BEAM GD FEN TRANS (TL2)	GUARDRAIL END TREATMENT (INSTALL)	INSTL DEL ASSM (D-SW)SZ (BRF)CTB (BI)	INSTL DEL ASSM (D-SW)SZ 1(BRF)GF2(BI)
CSJ: 092	3-17-084	STA	CY	SY	LF	EA	EA	EA	EA
FROM	то								
9+57.00	10+02.00	0.45	22	33					
10+02.00	11+07.00	1.05	61		50	2	2		
11+07.00	12+32.00	1.25							
12+32.00	13+37.00	1.05	61		50	2	2		
13+37.00	13+82.00	0.45	24						
	TOTALS:	4.25	168	33	100	4	4	6	8

		ARTHWORK QU				
ITEM	110	110	132	132		
DESCRIPTION	6001	6002	6005	6005		
LOCATION	EXCAVATION (ROADWAY)	EXCAVATION (CHANNEL)	2 EMBANKMENT (FINAL)(ORD COMP)(TY C)	3 EMBANKMENT (FINAL)(ORD COMP)(TY C)		
CSJ:0923-17-084	CY	CY	СҮ	CY		
9+57.00 R1	0		0			
9+75.00 R1	8		0			
10+00.00 R1	13		3			
10+25.00 R1	14		6			
10+50.00 R1	20		17			
10+75.00 R1	21		15			
11+00.00 R1	17		17			
11+25.00 R1	10	1 [	8			
11+50.00 R1	5	1	0			
11+75.00 R1	0	.3930	0	50		
12+00.00 R1	0	3930	0	- 58		
12+25.00 R1	5	1	0			
12+50.00 R1	10	1	3			
12+75.00 R1	10	1 [	7			
13+00.00 R1	11		6			
13+25.00 R1	11		3			
13+50.00 R1	11		2			
13+75.00 R1	11		1			
13+82.00 R1	3		0			
TOTALS:	180	3930	88	58		

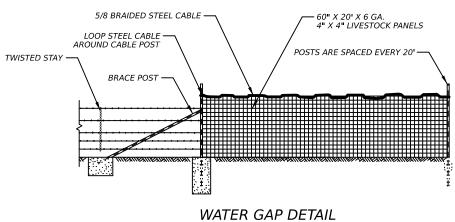

NOT TO SCALE

NOTE: REMOVAL OF EXISTING PAVEMENT STRUCTURE INCLUDED WITHIN EXCAVATION QUANTITY. VOLUME OF BACKFILL VOID LEFT FROM REMOVAL OF EXISTING PAVEMENT STRUCTURE INCLUDED WITHIN EMBANKMENT QUANTITY.

SUMMARY OF FENCE QUANTITIES							
		552	552	552	552		
		6001	6003	6006	6008		
STATION TO STATION		4 WIRE FENCE (TY A)	(TY A) WIRE FENCE (TY C) GATE (T		WIRE FENCE (WATER GAP)		
CSJ: 0923-17-084		LF	LF E/		LF		
FROM	то						
9+57.00	13+82.00	400	631	2	125		
тот	ALS:	400	631	2 *	125		

\* EACH GATE SHALL BE 10 FT LENGTH

	SUMMARY OF SWP3 QUANTITIES									
	164	164	164	168	169	169	506	506	506	506
	6001	6009	6011	6001	6004	6007	6038	6039	6042	6043
STATION TO STATION	BROADCAST SEED (PERM) (RURAL) (SANDY)	BROADCAST SEED (TEMP) (WARM)	BROADCAST SEED (TEMP) (COOL)	VEGETATIVE WATERING	SOIL RETENTION BLANKETS (CL 1) (TY D)	SOIL RETENTION BLANKETS (CL 2) (TY G)	TEMP SEDMT CONT FENCE (INSTALL)	TEMP SEDMT CONT FENCE (REMOVE)	BIODEG EROSN CONT LOGS (INSTL) (18")	BIODEG EROSN CONT LOGS (REMOVE)
CSJ: 0923-17-084	SY	SY	SY	MG	SY	SY	LF	LF	LF	LF
FROM TO										
9+57.00 13+82.00	2387	1194	1194	38.48	2219	125	753	753	611	611
TOTALS:	2387	1194	1194	38	2219	125	753	753	611	611

SUMMARY OF REMOVAL QUANTITIES

STATION TO STATION

CSJ: 0923-17-084

TOTALS:

то

13+82.00

FROM

9+57.00


496 6009 REMOV STR (BRIDGE 0 - 99 FT LENGTH)


EA

1

1

- BRUSH REMOVAL AND TREE REMOVAL REQUIRED FOR CLEARING AREAS WITHIN THE GRADING LIMITS OF THE PROJECT ARE CONSIDERED SUBSIDARY TO BID ITEM 100 "PREPARING ROW".
- 2 EMBANKMENT FOR ROADWAY
- (3) EMBANKMENT FOR CHANNEL GRADING
- PLACE WIRE FENCE AS DIRECTED BY THE ENGINEER. WIRE FENCE (TY A) IS TO BE USED FOR TEMPORARY FENCE AND QUANTITIES ARE APPROXIMATE AND MAY BE ADJUSTED. WILL REQUIRE APPROXIMATELY 4 CORNERS.

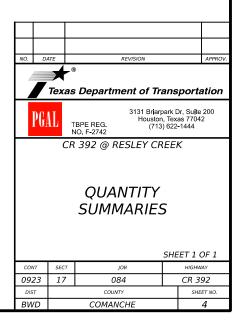

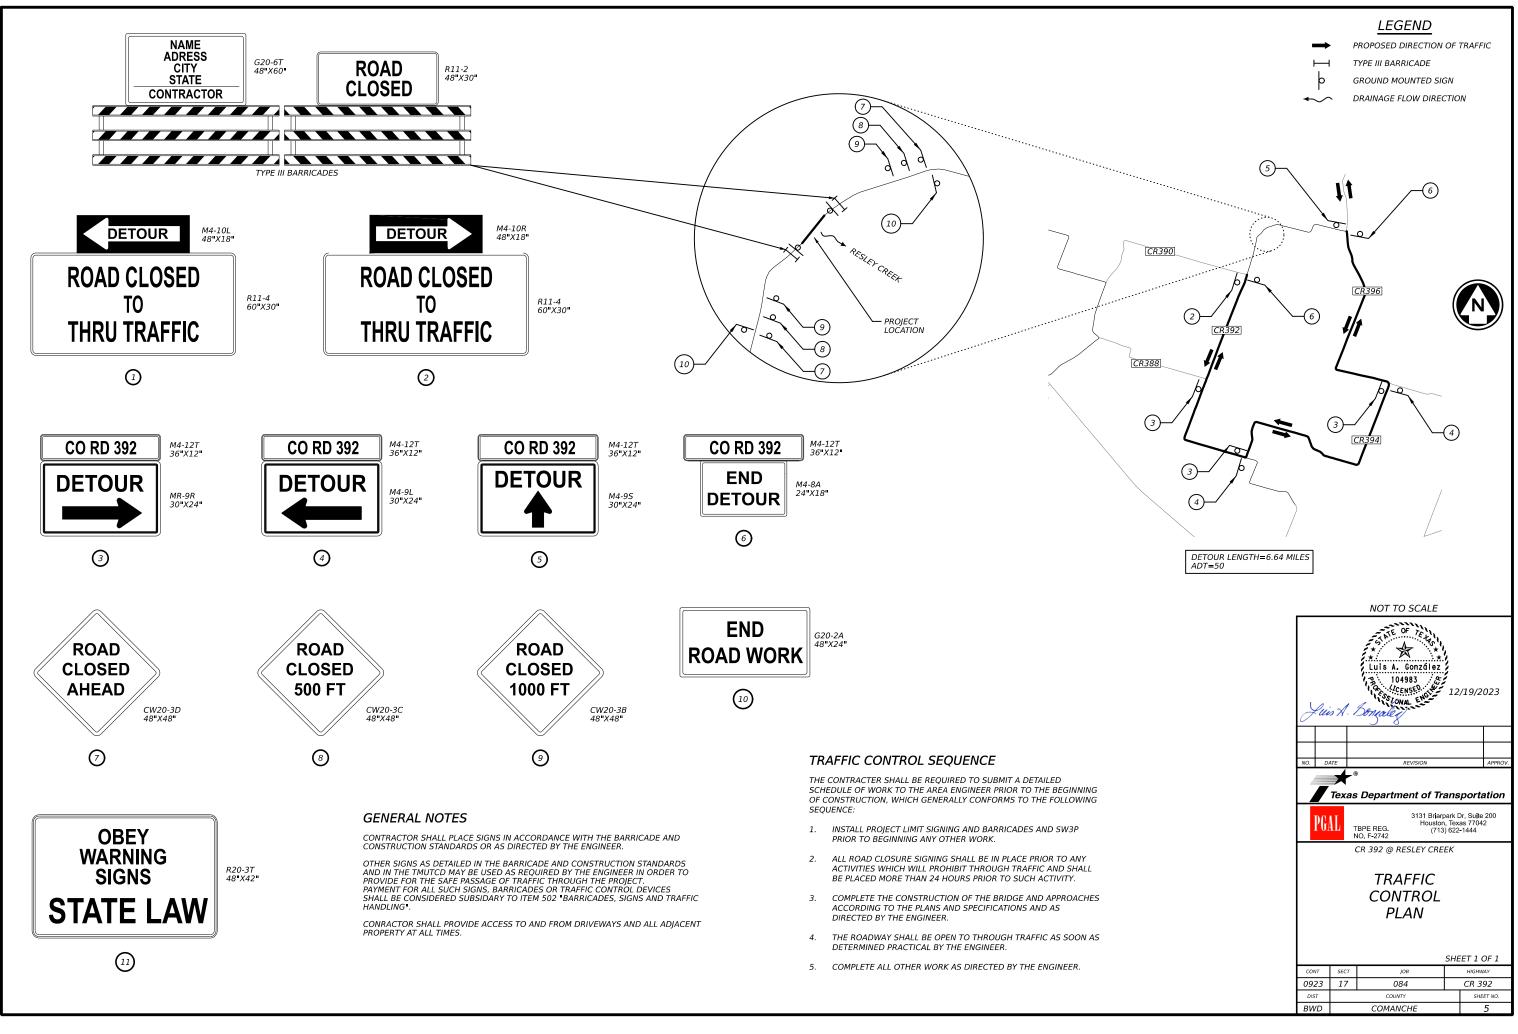

DATE: 12/19/2023 4:00:08 PM FILE: R:11005000-1005999/1005472.03/04 DOCUMENTS/DES/GN/Plan\_Set/2. Traffic Control/CR39

# BARRICADE AND CONSTRUCTION (BC) STANDARD SHEETS GENERAL NOTES:

- The Barricade and Construction Standard Sheets (BC sheets) are intended 1. to show typical examples for placement of temporary traffic control devices, construction pavement markings, and typical work zone signs. The information contained in these sheets meet or exceed the requirements shown in the "Texas Manual on Uniform Traffic Control Devices" (TMUTCD).
- The development and design of the Traffic Control Plan (TCP) is the 2. responsibility of the Engineer.
- The Contractor may propose changes to the TCP that are signed and sealed by a licensed professional engineer for approval. The Engineer may develop, sign and seal Contractor proposed changes.
- 4. The Contractor is responsible for installing and maintaining the traffic control devices as shown in the plans. The Contractor may not move or change the approximate location of any device without the approval of the Engineer.
- 5. Geometric design of lane shifts and detours should, when possible, meet the applicable design criteria contained in manuals such as the American Association of State Highway and Transportation Officials (AASHTO), "A Policy on Geometric Design of Highways and Streets," the TxDOT "Roadway Design Manual" or engineering judgment.
- When projects abut, the Engineer(s) may omit the END ROAD WORK, TRAFFIC FINES DOUBLE, and other advance warning signs if the signing would be redundant and the work areas appear continuous to the motorists. If the adjacent project is completed first, the Contractor shall erect the necessary warning signs as shown on these sheets, the TCP sheets or as directed by the Engineer. The BEGIN ROAD WORK NEXT X MILES sign shall be revised to show appropriate work zone distance.
- The Engineer may require duplicate warning signs on the median side of divided highways where median width will permit and traffic volumes iustify the signing.
- 8. All signs shall be constructed in accordance with the details found in the "Standard Highway Sign Designs for Texas," latest edition. Sign details not shown in this manual shall be shown in the plans or the Engineer shall provide a detail to the Contractor before the sign is manufactured.
- The temporary traffic control devices shown in the illustrations of the 9. BC sheets are examples. As necessary, the Engineer will determine the most appropriate traffic control devices to be used.
- 10. Where highway construction or maintenance work is being undertaken, other than mobile operations as defined by the Texas Manual on Uniform Traffic Control Devices, CSJ limit signs are required. CSJ limit signs are shown on BC(2). The OBEY WARNING SIGNS STATE LAW sign, STAY ALERT TALK OR TEXT LATER and the WORK ZONE TRAFFIC FINES DOUBLE sign with plaque shall be erected in advance of the CSJ limits. The BEGIN ROAD WORK NEXT X MILES. CONTRACTOR and END ROAD WORK signs shall be erected at or near the CSJ limits. For mobile operations, CSJ limit signs are not required.
- 11. Traffic control devices should be in place only while work is actually in progress or a definite need exists.
- 12. The Engineer has the final decision on the location of all traffic control devices.
- 13. Inactive equipment and work vehicles, including workers' private vehicles must be parked away from travel lanes. They should be as close to the right-of-way line as possible, or located behind a barrier or guardrail, or as approved by the Engineer.

## WORKER SAFETY NOTES:

- 1. Workers on foot who are exposed to traffic or to construction equipment within the right-of-way shall wear high-visibility safety apparel meeting the requirements of ISEA "American National Standard for High-Visibility" Apparel," or equivalent revisions, and labeled as ANSI 107-2004 standard performance for Class 2 or 3 risk exposure. Class 3 garments should be considered for high traffic volume work areas or night time work.
- 2. Except in emergency situations, flagger stations shall be illuminated when flagging is used at night.

## COMPLIANT WORKZONE TRAFFIC CONTROL DEVICES

- 1. Only pre-qualified products shall be used. The "Compliant Work Zone Traffic Control Devices List" (CWZTCD) describes pre-qualified products and their sources.
- 2. Work zone traffic control devices shall be compliant with the Manual for Assessing safety Hardware (MASH).


THE DOCUMENTS BELOW CAN BE FOUND ON-LINE AT http://www.txdot.gov					
COMPLIANT WORK ZONE TRAFFIC CONTROL DEVICES LIST (CWZTCD)					
DEPARTMENTAL MATERIAL SPECIFICATIONS (DMS)					
MATERIAL PRODUCER LIST (MPL)					
ROADWAY DESIGN MANUAL - SEE "MANUALS (ONLINE MANUALS)"					
STANDARD HIGHWAY SIGN DESIGNS FOR TEXAS (SHSD)					
TEXAS MANUAL ON UNIFORM TRAFFIC CONTROL DEVICES (TMUTCD)					
TRAFFIC ENGINEERING STANDARD SHEETS					


Σč

4:00:09

12/19/2023 B: \1005000-

DATE:

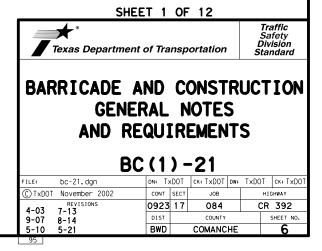

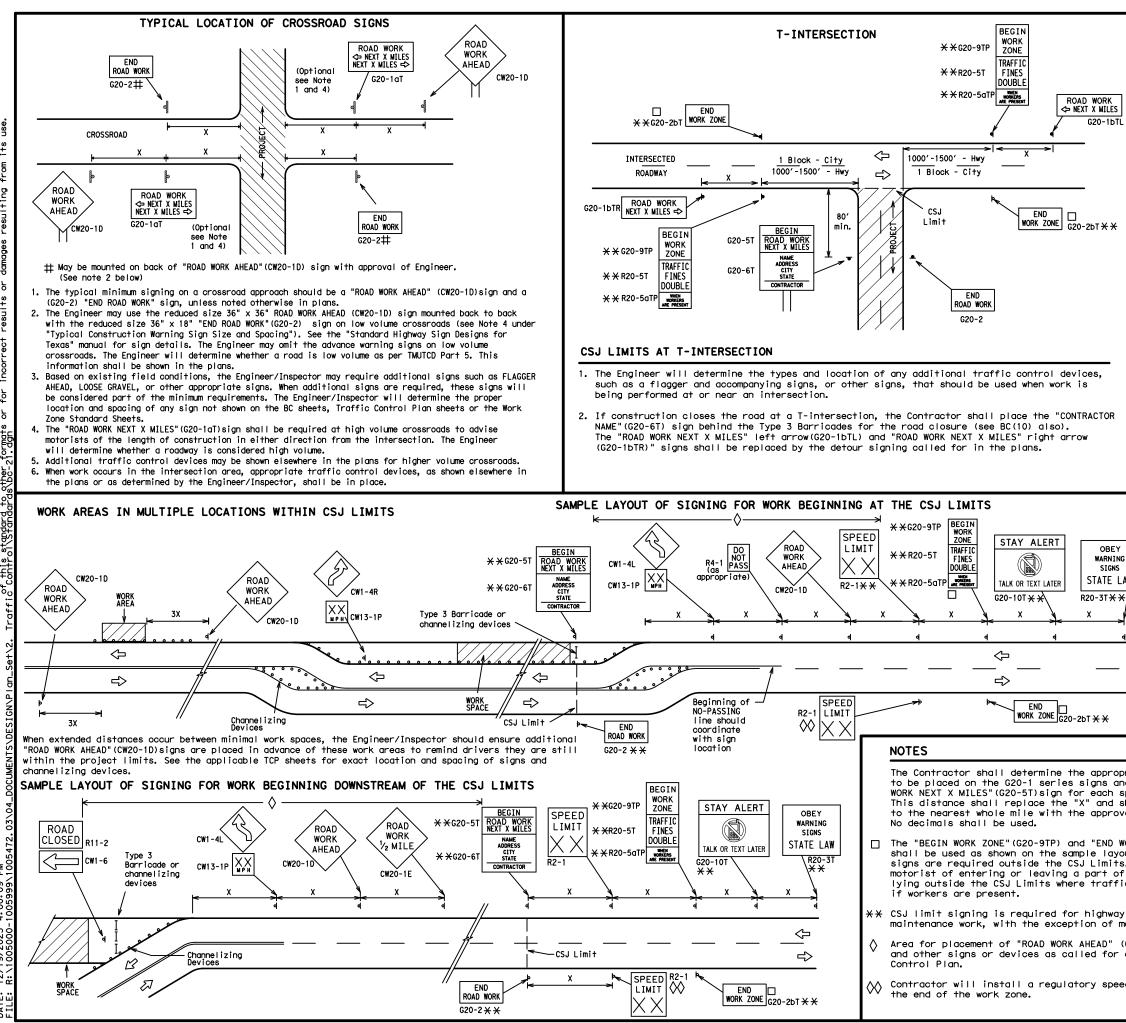


Σç 4:00:09 12/19/2023 DATE:

	ITPICAL CON	STRUCTION WA	KNING SIGN	SIZE ANU S	SPACING			
		SIZE		SF	PACING			
s DTL	Sign Number or Series	Conventional Road	Expressway/ Freeway	Posted Speed	Sign∆ Spacing "X"			
DIL	CW20 <sup>4</sup> CW21 CW22 CW23	48" × 48"	48" × 48"	MPH 30 35	Feet (Apprx.) 120 160			
×	CW25 CW1, CW2, CW7, CW8, CW9, CW11, CW14	36" × 36"	48" × 48"	40 45 50 55 60	240 320 400 500 <sup>2</sup> 600 <sup>2</sup>			
	CW3, CW4, CW5, CW6, CW8-3, CW10, CW12	48" × 48"	48" × 48"	65 70 75 80	700 <sup>2</sup> 800 <sup>2</sup> 900 <sup>2</sup> 1000 <sup>2</sup>			
				*	* 3			
٦	(TMUTCD) typica △ Minimum distanc work area and/c	the "Texas Manual application di the from work area or distance betwee	on Uniform Traf agrams or TCP St to first Advanc	fic Control De andard Sheets. e Warning sign	vices"			
	GENERAL NOTES		v be used as nec	essory.				
	2. Distance betwee advance warning	n signs should b	-	-	e 1500 feet			
EY IING NS LAW X	<ul> <li>3. Distance between signs should be increased as required to have 1/2 mile or more advance warning.</li> <li>4. 36" x 36" "ROAD WORK AHEAD" (CW20-1D) signs may be used on low volume crossroads at the discretion of the Engineer as per TMUTCD Part 5. See Note 2 under "Typical Location of Crossroad Signs".</li> <li>5. Only diamond shaped warning sign sizes are indicated.</li> <li>6. See sign size listing in "TMUTCD", Sign Appendix or the "Standard Highway Sign Designs for Texas" manual for complete list of available sign design sizes.</li> </ul>							
9			LEGE	ND				
_			Type 3 Ba					
		000		ing Devices				
opria	ite distance	x	Warning S Spacing c TMUTCD fo	al Construc ign Size an hart or the r sign equirements	d			
spec	BEGIN ROAD ific project.		SHEET 2	OF 12				
oval	I be rounded of the Engineer.	Texas De	partment of Tra		Traffic Safety Division Standard			
iyout ts. Ti of th	work ZONE" (G20-ZDI) yout when advance is. They inform the of the work zone Fic fines may double BARRICADE AND CONSTRUCTION							
mobi	nstruction and le operations.	ľ	PROJECT	LIMII				
(CW2 or on	:0-1D)sign the Traffic		BC (2					
eed I	imit sign at	FILE: bc-21.dgr CTxDOT November REVISIONS 9-07 8-14	2002 CONT	SECT JOB	TxDOT         ck: TxDOT           HIGHWAY         CR 392           SHEET NO.			
		7-13 5-21 96	BWD	COMANCHE	7			

96

TYPICAL CONSTRUCTION WARNING SIGN SIZE AND SPACING<sup>1,5,6</sup>

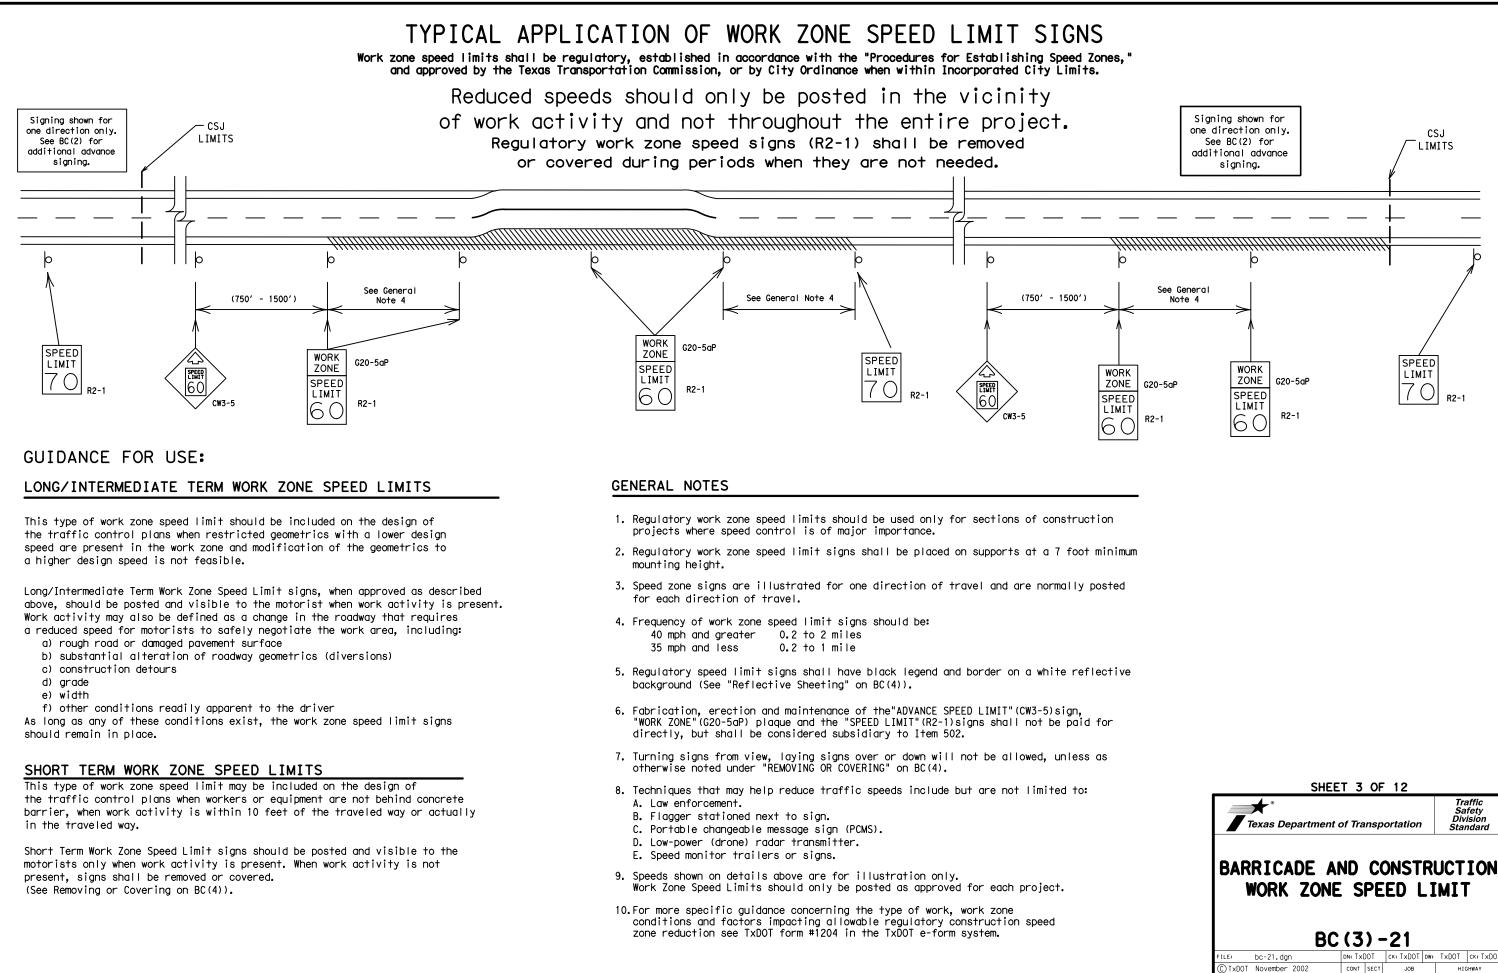

Σç

4:00:09

12/19/2023 R: \1005000-

DATE:

7-13 5-21

9-07 8-14

084

COUNTY

COMANCHE


0923 17

BWD

CR 392

SHEET NO

Q

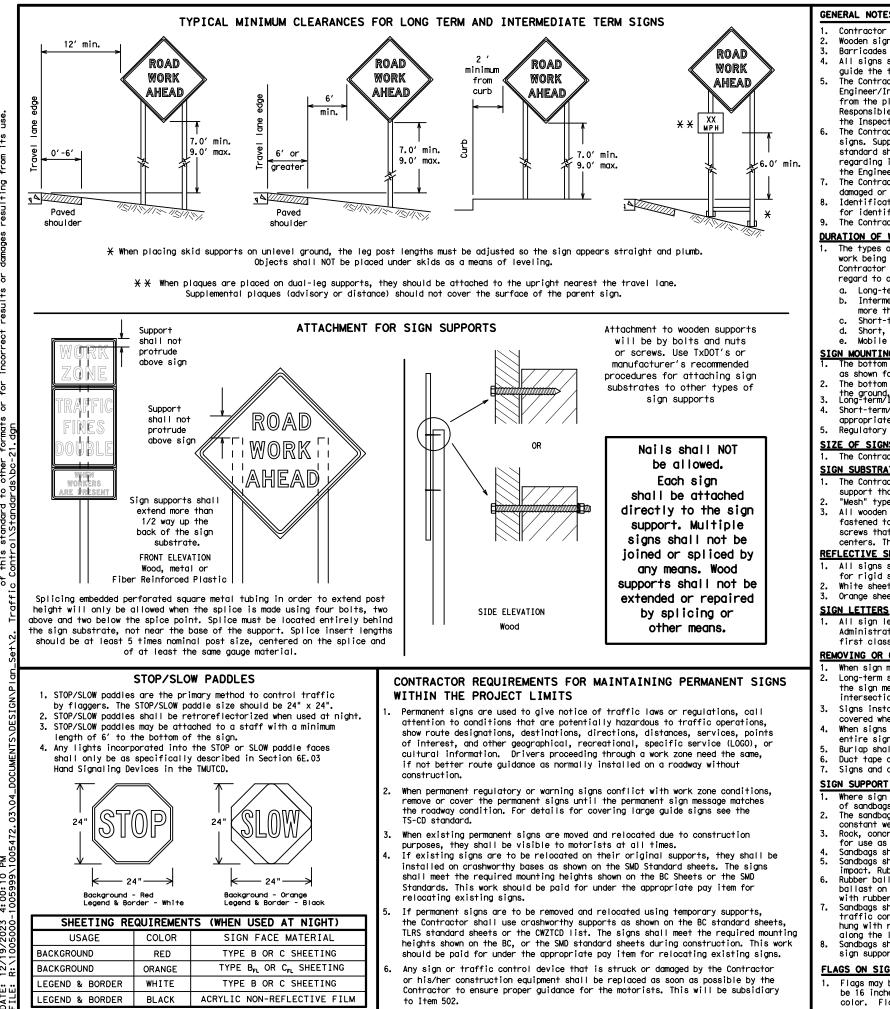

## GENERAL NOTES FOR WORK ZONE SIGNS

- Contractor shall install and maintain signs in a straight and plumb condition and/or as directed by the Engineer. Wooden sign posts shall be painted white.
- Barricades shall NOT be used as sign supports.
- guide the traveling public safely through the work zone.
- the Inspector's TxDOT diary and having both the Inspector and Contractor initial and date the agreed upon changes.
- the Engineer can verify the correct procedures are being followed.
- damaged or marred reflective sheeting as directed by the Engineer/Inspector.
- for identification shall be 1 inch.
- The Contractor shall replace damaged wood posts. New or damaged wood sign posts shall not be spliced.

# <u>DURATION OF WORK (as defined by the "Texas Manual on Uniform Traffic Control Devices" Part 6)</u>

- The types of sign supports, sign mounting height, the size of signs, and the type of sign substrates can vary based on the type of reagrd to crashworthiness and duration of work requirements.
- a. Long-term stationary work that occupies a location more than 3 days.
- more than one hour.
- Short, duration work that occupies a location up to 1 hour.
- Mobile work that moves continuously or intermittently (stopping for up to approximately 15 minutes.)

### SIGN MOUNTING HEIGHT

- as shown for supplemental plaques mounted below other signs.
- the ground. Long-term/Intermediate-term Signs may be used in lieu of Short-term/Short Duration signing.
- Short-term/Short Duration signs shall be used only during daylight and shall be removed at the end of the workday or raised to
- appropriate Long-term/Intermediate sign height.

# SIZE OF SIGNS

The Contractor shall furnish the sign sizes shown on BC (2) unless otherwise shown in the plans or as directed by the Engineer.

# SIGN SUBSTRATES

- "Mesh" type materials are NOT an approved sign substrate, regardless of the tightness of the weave. centers. The Engineer may approve other methods of splicing the sign face.

## REFLECTIVE SHEETING

- 1. All signs shall be retroreflective and constructed of sheeting meeting the color and retro-reflectivity requirements of DMS-8300
- for rigid signs or DMS-8310 for roll-up signs. The web address for DMS specifications is shown on BC(1).
- White sheeting, meeting the requirements of DMS-8300 Type A, shall be used for signs with a white background.

1. All sign letters and numbers shall be clear, and open rounded type uppercase alphabet letters as approved by the Federal Highway first class workmanship in accordance with Department Standards and Specifications.

## REMOVING OR COVERING

- When sign messages may be confusing or do not apply, the signs shall be removed or completely covered.
- intersections where the sign may be seen from approaching traffic. Signs installed on wooden skids shall not be turned at 90 degree angles to the roadway. These signs should be removed or completely
- covered when not required. When signs are covered, the material used shall be opaque, such as heavy mil black plastic, or other materials which will cover the
- entire sign face and maintain their opaque properties under automobile headlights at night, without damaging the sign sheeting. Burlap shall NOT be used to cover signs.
- Duct tape or other adhesive material shall NOT be affixed to a sign face.
- Signs and anchor stubs shall be removed and holes backfilled upon completion of work.

# SIGN SUPPORT WEIGHTS

- 1. Where sign supports require the use of weights to keep from turning over, the use of sandbags with dry, cohesionless sand should be used. The sandbags will be tied shut to keep the sand from spilling and to maintain a
- constant weight. Rock, concrete, iron, steel or other solid objects shall not be permitted
- for use as sign support weights. Sandbags should weigh a minimum of 35 lbs and a maximum of 50 lbs.
- Sandbags shall be made of a durable material that tears upon vehicular
- impact. Rubber (such as tire inner tubes) shall NOT be used. Rubber ballasts designed for channelizing devices should not be used for ballast on portable sign supports. Sign supports designed and manufactured with rubber bases may be used when shown on the CWZTCD list. Sandbags shall only be placed along or laid over the base supports of the
- traffic control device and shall not be suspended above ground level or hung with rope, wire, chains or other fasteners. Sandbags shall be placed along the length of the skids to weigh down the sign support.
- Sandbags shall NOT be placed under the skid and shall not be used to level sign supports placed on slopes.

### FLAGS ON SIGNS

1. Flags may be used to draw attention to warning signs. When used, the flag shall be 16 inches square or larger and shall be orange or fluorescent red-orange in color. Flags shall not be allowed to cover any portion of the sign face.

No warranty of any for the conversion m its use. Texas Engineering Practice Act". TxDOT assumes no responsibility t results or damages resulting fro this standard is governed by the "T "TXDOT for any purpose whatsoever." "A to other formats or for incorrect "dards.hn-21.fam ISCLAIM The ind is f this ₽ŧ.

> ΜŠ 10 4:00: 2023 6 12/1

All signs shall be installed in accordance with the plans or as directed by the Engineer. Signs shall be used to regulate, warn, and

The Contractor may furnish either the sign design shown in the plans or in the "Standard Highway Sign Designs for Texas" (SHSD). The Engineer/Inspector may require the Contractor to furnish other work zone signs that are shown in the TMUTCD but may have been omitted from the plans. Any variation in the plans shall be documented by written agreement between the Engineer and the Contractor's Responsible Person. All changes must be documented in writing before being implemented. This can include documenting the changes in

The Contractor shall furnish sign supports listed in the "Compliant Work Zone Traffic Control Device List" (CWZTCD) for small roadside signs. Supports for temporary large roadside signs shall meet the requirements detailed on the Temporary Large Roadside Signs (TLRS) standard sheets. The Contractor shall install the sign support in accordance with the manufacturer's recommendations. If there is a question reaarding installation procedures, the Contractor shall furnish the Engineer a copy of the manufacturer's installation recommendations so

The Contractor is responsible for installing signs on approved supports and replacing signs with damaged or cracked substrates and/or

Identification markings may be shown only on the back of the sign substrate. The maximum height of letters and/or company logos used

work being performed. The Engineer is responsible for selecting the appropriate size sign for the type of work being performed. The Contractor is responsible for ensuring the sign support, sign mounting height and substrate meets manufacturer's recommendations in

Intermediate-term stationary - work that occupies a location more than one daylight period up to 3 days, or nighttime work lasting

Short-term stationary - daytime work that occupies a location for more than 1 hour in a single daylight period.

The bottom of Long-term/Intermediate-term signs shall be at least 7 feet, but not more than 9 feet, above the paved surface, except

The bottom of Short-term/Short Duration signs shall be a minimum of 1 foot above the pavement surface but no more than 2 feet above

Regulatory signs shall be mounted at least 7 feet, but not more than 9 feet, above the paved surface regardless of work duration.

The Contractor shall ensure the sign substrate is installed in accordance with the manufacturer's recommendations for the type of sign support that is being used. The CWZTCD lists each substrate that can be used on the different types and models of sign supports. All wooden individual sign panels fabricated from 2 or more pieces shall have one or more plywood cleat, 1/2" thick by 6" wide, fastened to the back of the sign and extending fully across the sign. The cleat shall be attached to the back of the sign using wood screws that do not penetrate the face of the sign panel. The screws shall be placed on both sides of the splice and spaced at 6"

3. Orange sheeting, meeting the requirements of DMS-8300 Type B<sub>FL</sub> or Type C<sub>FL</sub>, shall be used for rigid signs with orange backgrounds.

Administration (FHWA) and as published in the "Standard Highway Sign Design for Texas" manual. Signs, letters and numbers shall be of

Long-term stationary or intermediate stationary signs installed on square metal tubing may be turned away from traffic 90 degrees when the sign message is not applicable. This technique may not be used for signs installed in the median of divided highways or near any


SHEET 4 OF 12

Texas Department of Transportation

Traffic Safety Division Standaro

# BARRICADE AND CONSTRUCTION TEMPORARY SIGN NOTES

BC (4) -21							
FILE:	bc-21.dgn	DN: T:	<b>K</b> DOT	ск: TxDOT	DW:	TxDOT	ск: TxDOT
(C) TxDOT	November 2002	CONT	SECT	JOB		HIC	GHWAY
	REVISIONS	0923	17	084		CR	392
9-07	8-14	DIST		COUNTY			SHEET NO.
7-13	5-21	BWD		COMANC	HE		9
98							

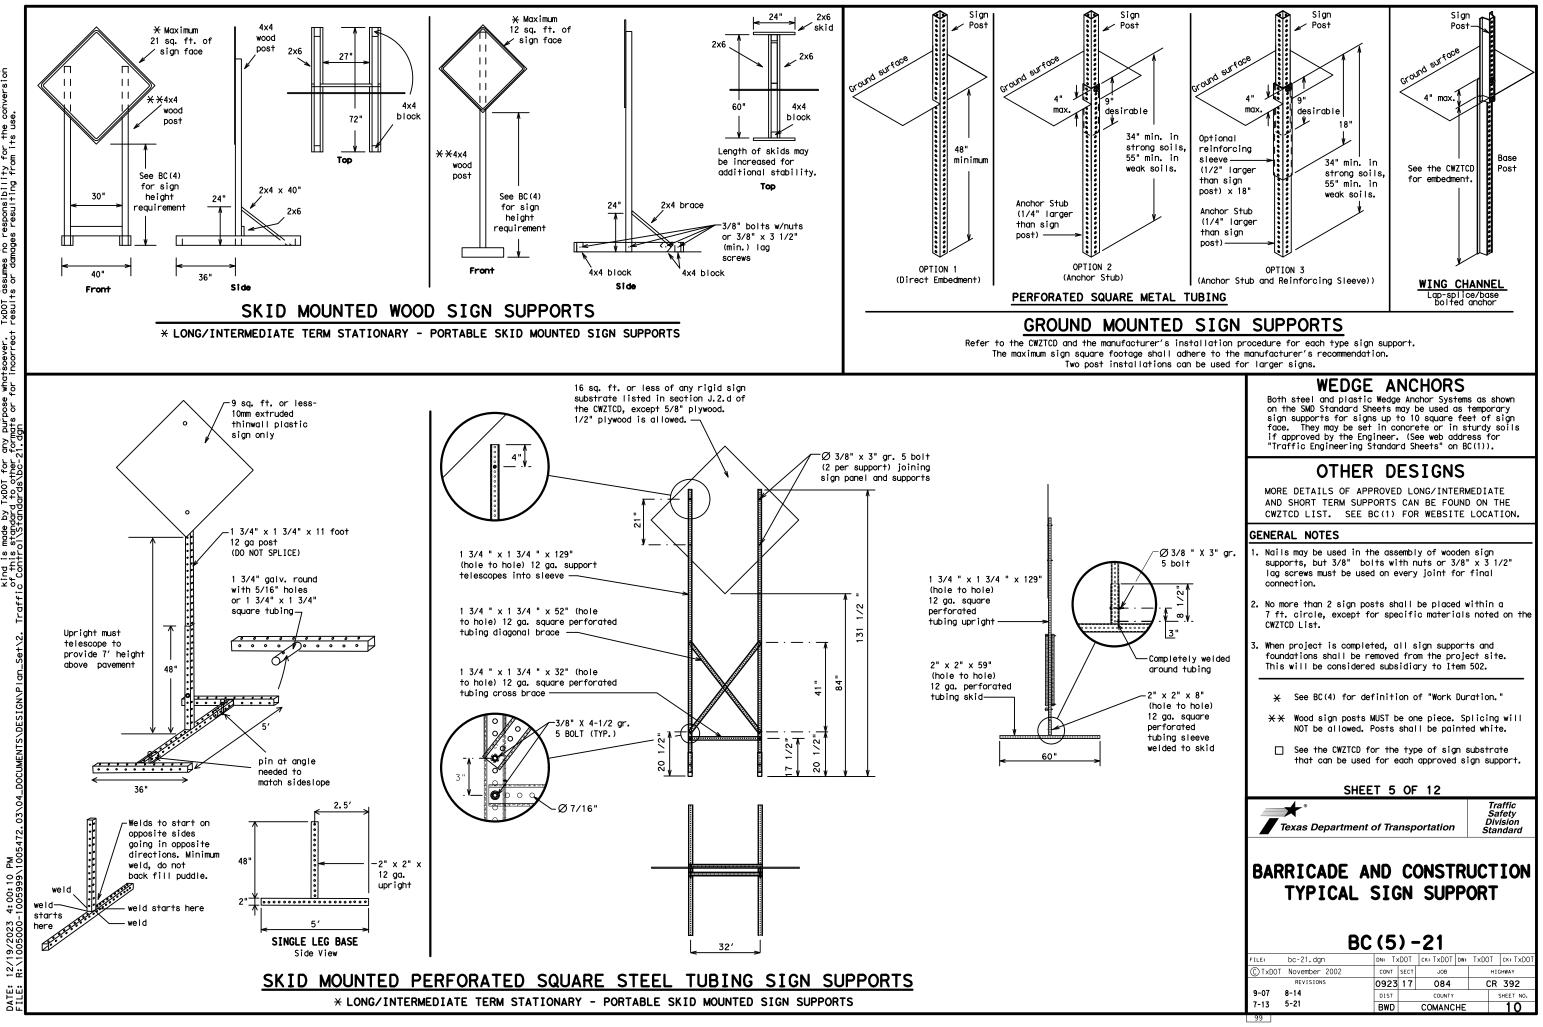

is governed by the "Texas Engineering Practice Act". No warranty of any purpose whatscever. TxDOT assumes no responsibility for the conversion mots or for incorrect results or damages resulting from its use. of this standard is e by TxDOT for any i ndard to other form ISCLAIN The ind is

WHEN NOT IN USE, REMOVE THE PCMS FROM THE RIGHT-OF-WAY OR PLACE THE PCMS BEHIND BARRIER OR GUARDRAIL WITH SIGN PANEL TURNED PARALLEL TO TRAFFIC

### PORTABLE CHANGEABLE MESSAGE SIGNS

- 1. The Engineer/Inspector shall approve all messages used on portable changeable message signs (PCMS).
- Messages on PCMS should contain no more than 8 words (about four to 2. eight characters per word), not including simple words such as "TO, "FOR, " "AT, " etc.
- Messages should consist of a single phase, or two phases that 3. alternate. Three-phase messages are not allowed. Each phase of the message should convey a single thought, and must be understood by itself.
- 4. Use the word "EXIT" to refer to an exit ramp on a freeway; i.e., "EXIT CLOSED." Do not use the term "RAMP."
- Always use the route or interstate designation (IH, US, SH, FM) 5. along with the number when referring to a roadway.
- When in use, the bottom of a stationary PCMS message panel should be a minimum 7 feet above the roadway, where possible.
- The message term "WEEKEND" should be used only if the work is to 7. start on Saturday morning and end by Sunday evening at midnight. Actual days and hours of work should be displayed on the PCMS if work is to begin on Friday evening and/or continue into Monday morning.
- The Engineer/Inspector may select one of two options which are available for displaying a two-phase message on a PCMS. Each phase may be displayed for either four seconds each or for three seconds each.
- Do not "flash" messages or words included in a message. The message 9. should be steady burn or continuous while displayed.
- 10. Do not present redundant information on a two-phase message; i.e., keeping two lines of the message the same and changing the third line. 11. Do not use the word "Danger" in message.
- 12. Do not display the message "LANES SHIFT LEFT" or "LANES SHIFT RIGHT" on a PCMS. Drivers do not understand the message.
- 13. Do not display messages that scroll horizontally or vertically across the face of the sign.
- 14. The following table lists abbreviated words and two-word phrases that are acceptable for use on a PCMS. Both words in a phrase must be displayed together. Words or phrases not on this list should not be abbreviated, unless shown in the TMUTCD.
- 15. PCMS character height should be at least 18 inches for trailer mounted units. They should be visible from at least 1/2 (.5) mile and the text should be legible from at least 600 feet at night and 800 feet in daylight. Truck mounted units must have a character height of 10 inches and must be legible from at least 400 feet.
- 16. Each line of text should be centered on the message board rather than left or right justified.
- 17. If disabled, the PCMS should default to an illegible display that will not alarm motorists and will only be used to alert workers that the PCMS has malfunctioned. A pattern such as a series of horizontal solid bars is appropriate.

WORD OR PHRASE	ABBREVIATION	WORD OR PHRASE	ABBREVIATION
Access Road	ACCS RD	Major	MAJ
Alternate	ALT	Miles	IMI
Avenue	AVE	Miles Per Hour	MPH
Best Route	BEST RTE	Minor	MNR
Boulevard	BLVD	Monday	MON
Bridge	BRDG	Normal	NORM
Cannot	CANT	North	N
Center	CTR	Northbound	(route) N
Construction Ahead	CONST AHD	Parking	PKING RD
CROSSING	XING	Road Right Lang	
Detour Route	DETOUR RTE	Right Lane	RT LN SAT
Do Not	DONT	Saturday	
East	F	Service Road	SERV RD
Eastbound	(route) E	Shoulder	SHLDR
Emergency	EMER	Slippery	SLIP
Emergency Vehicle		South	S
Entrance, Enter	ENT	Southbound	(route) S
Express Lane	EXP LN	Speed	SPD
Expressway	EXPWY	Street	ST
XXXX Feet	XXXX FT	Sunday	SUN
Fog Ahead	FOG AHD	Telephone	PHONE
Freeway	FRWY, FWY	Temporary	TEMP
Freeway Blocked	FWY BLKD	Thursday	THURS
	FRI	To Downtown	TO DWNTN
Friday Hazardous Driving		Traffic	TRAF
Hazardous Material		Travelers	TRVLRS
		Tuesday	TUES
<u>High-Occupancy</u> Vehicle	HOV	Time Minutes	TIME MIN
	HWY	Upper Level	UPR LEVEL
Highway	HR, HRS	Vehicles (s)	VEH, VEHS
Hour (s)	INFO	Warning	WARN
Information		Wednesday	WED
It Is	ITS	Weight Limit	WT LIMIT
Junction	JCT	West	W
Left	LFT	Westbound	(route) W
Left Lane	LFT LN	Wet Pavement	WET PVMT
Lane Closed	LN CLOSED	Will Not	WONT
Lower Level	LWR LEVEL		
Maintenance	MAINT		

# RECOMMENDED PHASES AND FORMATS FOR PCMS MESSAGES DURING ROADWORK ACTIVITIES (The Engineer may approve other messages not specifically covered here.)

# Phase 1: Condition Lists

# Road/Lane/Ramp Closure List

FREEWAY CLOSED X MILE	FRONTAGE ROAD CLOSED	ROADWORK XXX FT	ROAD REPAIRS XXXX FT
ROAD CLOSED AT SH XXX	SHOULDER CLOSED XXX FT	FLAGGER XXXX FT	LANE NARROWS XXXX FT
ROAD CLSD AT FM XXXX	RIGHT LN CLOSED XXX FT	RIGHT LN NARROWS XXXX FT	TWO-WAY TRAFFIC XX MILE
RIGHT X LANES CLOSED	RIGHT X LANES OPEN	MERGING TRAFFIC XXXX FT	CONST TRAFFIC XXX FT
CENTER LANE CLOSED	DAYTIME LANE CLOSURES	LOOSE GRAVEL XXXX FT	UNEVEN LANES XXXX FT
NIGHT LANE CLOSURES	I-XX SOUTH EXIT CLOSED	DETOUR X MILE	ROUGH ROAD XXXX FT
VARIOUS LANES CLOSED	EXIT XXX CLOSED X MILE	ROADWORK PAST SH XXXX	ROADWORK NEXT FRI-SUN
EXIT CLOSED	RIGHT LN TO BE CLOSED	BUMP XXXX FT	US XXX EXIT X MILES
MALL DRIVEWAY CLOSED	X LANES CLOSED TUE - FRI	TRAFFIC SIGNAL XXXX FT	LANES SHIFT <del>X</del>
XXXXXXXX BLVD CLOSED	₭ LANES SHIFT in Phase	1 must be used wit	th STAY IN LANE in Phase

Other Co	ndition List
ROADWORK XXX FT	ROAD REPAIRS XXXX FT
FLAGGER XXXX FT	LANE NARROWS XXXX FT
RIGHT LN NARROWS XXXX FT	TWO-WAY TRAFFIC XX MILE
MERGING TRAFFIC XXXX FT	CONST TRAFFIC XXX FT
LOOSE GRAVEL XXXX FT	UNEVEN LANES XXXX FT
DETOUR X MILE	ROUGH ROAD XXXX FT
ROADWORK PAST SH XXXX	ROADWORK NEXT FRI-SUN
BUMP XXXX FT	US XXX EXIT X MILES
TRAFFIC SIGNAL XXXX FT	LANES SHIFT

### Action to Take/Effect on Travel List MERGE FORM RIGHT X LINES RIGHT DETOUR USE XXXXX NEXT RD EXIT X EXITS USE USE EXIT EXIT XXX I-XX NORTH STAY ON USE US XXX I-XX F SOUTH TO I-XX N TRUCKS WATCH USF FOR US XXX N TRUCKS WATCH EXPECT FOR DELAYS TRUCKS PREPARE EXPECT DELAYS ΤO STOP REDUCE END SPEED SHOULDER XXX FT USE USE WATCH OTHER FOR ROUTES WORKERS STAY ΤN LANE

### APPLICATION GUIDELINES

- 1. Only 1 or 2 phases are to be used on a PCMS. 2. The 1st phase (or both) should be selected from the
- "Road/Lane/Ramp Closure List" and the "Other Condition List".
- 3. A 2nd phase can be selected from the "Action to Take/Effect on Travel, Location, General Warning, or Advance Notice Phase Lists".
- 4. A Location Phase is necessary only if a distance or location is not included in the first phase selected.
- 5. If two PCMS are used in sequence, they must be separated by a minimum of 1000 ft. Each PCMS shall be limited to two phases, and should be understandable by themselves.
- 6. For advance notice, when the current date is within seven days of the actual work date, calendar days should be replaced with days of the week. Advance notification should typically be for no more than one week prior to the work.

### WORDING ALTERNATIVES

- 1. The words RIGHT, LEFT and ALL can be interchanged as appropriate.
- appropriate.
- be interchanged as appropriate.
- 4. Highway names and numbers replaced as appropriate.
- 5. ROAD, HIGHWAY and FREEWAY can be interchanged as needed.
- 6. AHEAD may be used instead of distances if necessary. 7. FT and MI. MILE and MILES interchanged as appropriate.
- 8. AT. BEFORE and PAST interchanged as needed.
  - 9. Distances or AHEAD can be eliminated from the message if a
  - location phase is used.

PCMS SIGNS WITHIN THE R.O.W. SHALL BE BEHIND GUARDRAIL OR CONCRETE BARRIER OR SHALL HAVE A MINIMUM OF FOUR (4) PLASTIC DRUMS PLACED PERPENDICULAR TO TRAFFIC ON THE UPSTREAM SIDE OF THE PCMS, WHEN EXPOSED TO ONE DIRECTION OF TRAFFIC. WHEN EXPOSED TO TWO WAY TRAFFIC. THE FOUR DRUMS SHOULD BE PLACED WITH ONE DRUM AT EACH OF THE FOUR CORNERS OF THE UNIT.

### FULL MATRIX PCMS SIGNS

- 1. When Full Matrix PCMS signs are used, the character height and legibility/visibility requirements shall be maintained as listed in Note 15 under "PORTABLE CHANGEABLE MESSAGE SIGNS" above.
- 2. When symbol signs, such as the "Flagger Symbol" (CW20-7) are represented graphically on the Full Matrix PCMS sign and, with the approval of the Engineer, it shall maintain the legibility/visibility requirement listed above.
- When symbol signs are represented graphically on the Full Matrix PCMS, they shall only supplement the use of the static sign represented, and shall not substitute 3. for, or replace that sign.
- 4. A full matrix PCMS may be used to simulate a flashing arrow board provided it meets the visibility, flash rate and dimming requirements on BC(7), for the same size arrow.

<u>ę</u>e


Roadway

12/19/: R: \100

DATE:


designation # IH-number, US-number, SH-number, FM-number


# Phase 2: Possible Component Lists

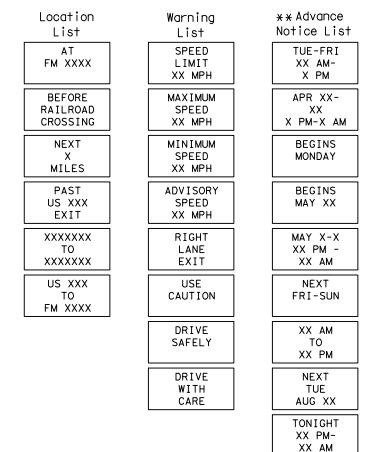


X X See Application Guidelines Note 6.


2. Roadway designations IH, US, SH, FM and LP can be interchanged as EAST, WEST, NORTH and SOUTH (or abbreviations E, W, N and S) can

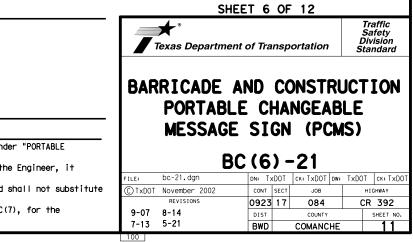


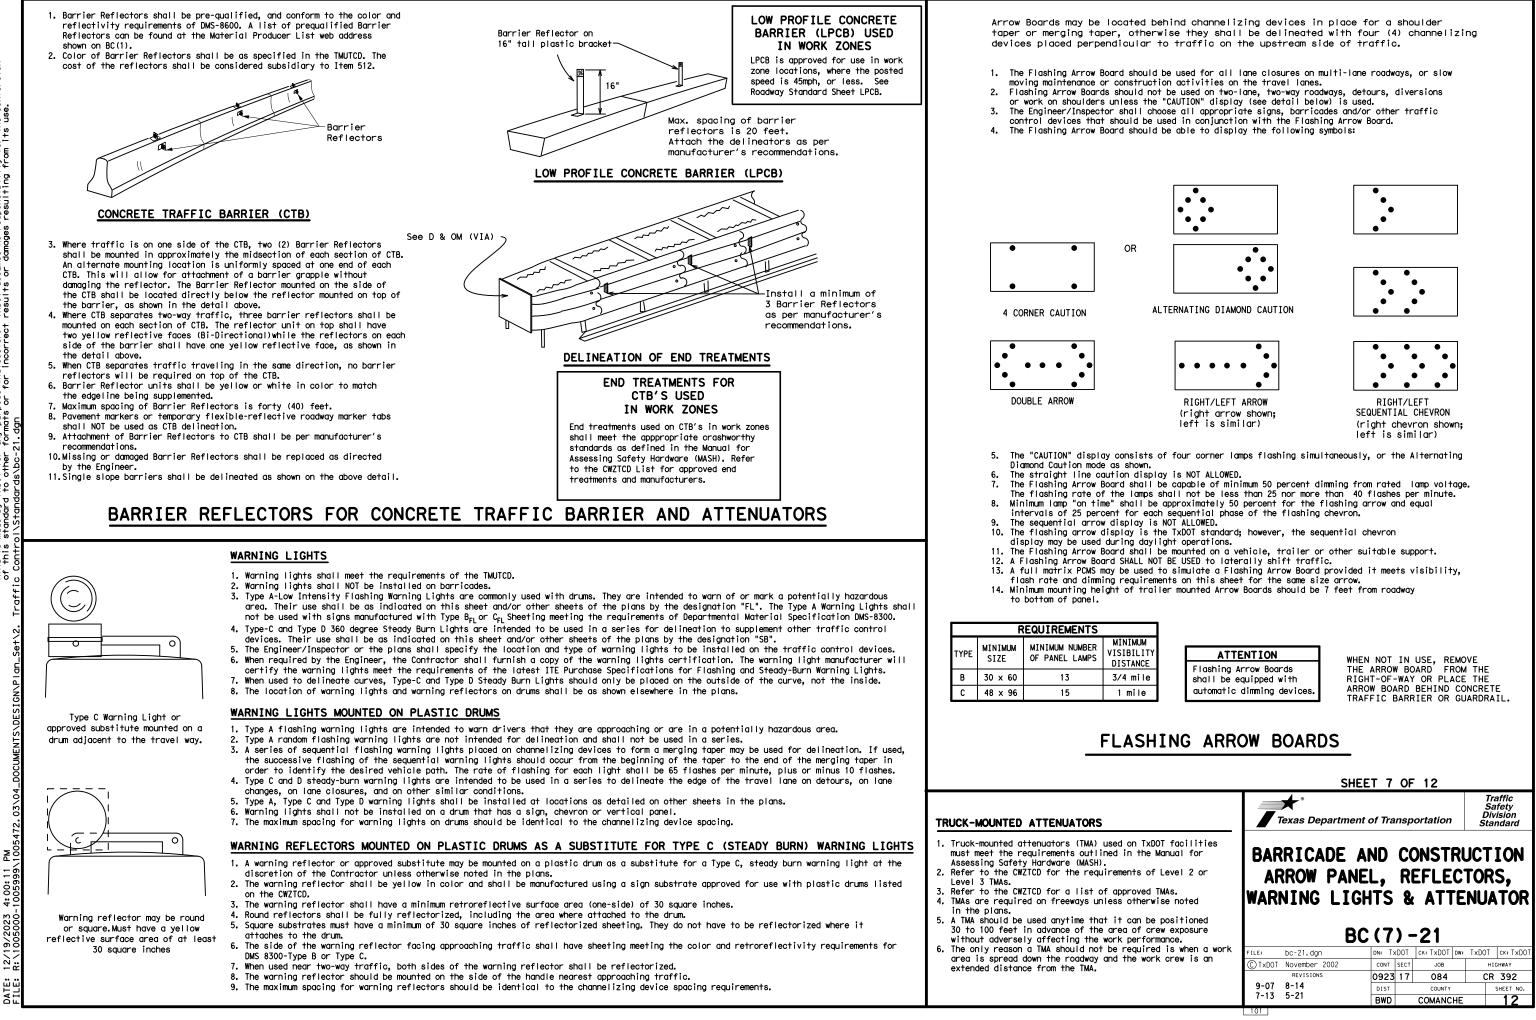



M 4:00:11

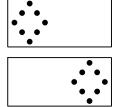

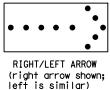

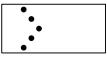

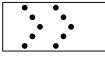

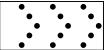

# GENERAL NOTES

- 1. For long term stationary work zones on freeways, drums shall be used as the primary channelizing device.
- 2. For intermediate term stationary work zones on freeways, drums should be used as the primary channelizing device but may be replaced in tangent sections by vertical panels, or 42" two-piece cones. In tangent sections, one-piece cones may be used with the approval of the Engineer but only if personnel are present on the project at all times to maintain the cones in proper position and location.
- 3. For short term stationary work zones on freeways, drums are the preferred channelizing device but may be replaced in tapers, transitions and tangent sections by vertical panels, two-piece cones or one-piece cones as approved by the Engineer.
- 4. Drums and all related items shall comply with the requirements of the current version of the "Texas Manual on Uniform Traffic Control Devices" (TMUTCD) and the "Compliant Work Zone Traffic Control Devices List" (CWZTCD).
- 5. Drums, bases, and related materials shall exhibit good workmanship and shall be free from objectionable marks or defects that would adversely affect their appearance or serviceability.
- 6. The Contractor shall have a maximum of 24 hours to replace any plastic drums identified for replacement by the Engineer/Inspector. The replacement device must be an approved device.

### GENERAL DESIGN REQUIREMENTS

- Pre-qualified plastic drums shall meet the following requirements:
- 1. Plastic drums shall be a two-piece design; the "body" of the drum shall be the top portion and the "base" shall be the bottom.
- 2. The body and base shall lock together in such a manner that the body separates from the base when impacted by a vehicle traveling at a speed of 20 MPH or greater but prevents accidental separation due to normal handling and/or air turbulence created by passing vehicles.
- 3. Plastic drums shall be constructed of lightweight flexible, and deformable materials. The Contractor shall NOT use metal drums or single piece plastic drums as channelization devices or sign supports.
- 4. Drums shall present a profile that is a minimum of 18 inches in width at the 36 inch height when viewed from any direction. The height of drum unit (body installed on base) shall be a minimum of 36 inches and a maximum of 42 inches.
- 5. The top of the drum shall have a built-in handle for easy pickup and shall be designed to drain water and not collect debris. The handle shall have a minimum of two widely spaced 9/16 inch diameter holes to allow attachment of a warning light, warning reflector unit or approved compliant sian.
- 6. The exterior of the drum body shall have a minimum of four alternating orange and white retroreflective circumferential stripes not less than 4 inches nor greater than 8 inches in width. Any non-reflectorized space between any two adjacent stripes shall not exceed 2 inches in width.
- 7. Bases shall have a maximum width of 36 inches, a maximum height of 4 inches, and a minimum of two footholds of sufficient size to allow base to be held down while separating the drum body from the base.
- 8. Plastic drums shall be constructed of ultra-violet stabilized, orange, high-density polyethylene (HDPE) or other approved material.
- 9. Drum body shall have a maximum unballasted weight of 11 lbs.
- 10. Drum and base shall be marked with manufacturer's name and model number.

## RETROREFLECTIVE SHEETING

- 1. The stripes used on drums shall be constructed of sheeting meeting the color and retroreflectivity requirements of Departmental Materials Specification DMS-8300, "Sign Face Materials." Type A or Type B reflective sheeting shall be supplied unless otherwise specified in the plans.
- 2. The sheeting shall be suitable for use on and shall adhere to the drum surface such that, upon vehicular impact, the sheeting shall remain adhered in-place and exhibit no delaminating, cracking, or loss of retroreflectivity other than that loss due to abrasion of the sheeting surface.

### BALLAST

ΜŠ

12


4:00:


99

12/1

DATE:

- 1. Unballasted bases shall be large enough to hold up to 50 lbs. of sand. This base, when filled with the ballast material, should weigh between 35 lbs (minimum) and 50 lbs (maximum). The ballast may be sand in one to three sandbags separate from the base, sand in a sand-filled plastic base, or other ballasting devices as approved by the Engineer. Stacking of sandbags will be allowed, however height of sandbags above pavement surface may not exceed 12 inches.
- 2. Bases with built-in ballast shall weigh between 40 lbs. and 50 lbs. Built-in ballast can be constructed of an integral crumb rubber base or a solid rubber base.
- Recycled truck tire sidewalls may be used for ballast on drums approved for this type of ballast on the CWZTCD list.
- 4. The ballast shall not be heavy objects, water, or any material that would become hazardous to motorists, pedestrians, or workers when the drum is struck by a vehicle.
- 5. When used in regions susceptible to freezing, drums shall have drainage holes in the bottoms so that water will not collect and freeze becoming a hazard when struck by a vehicle.
- 6. Ballast shall not be placed on top of drums.
- 7. Adhesives may be used to secure base of drums to pavement.

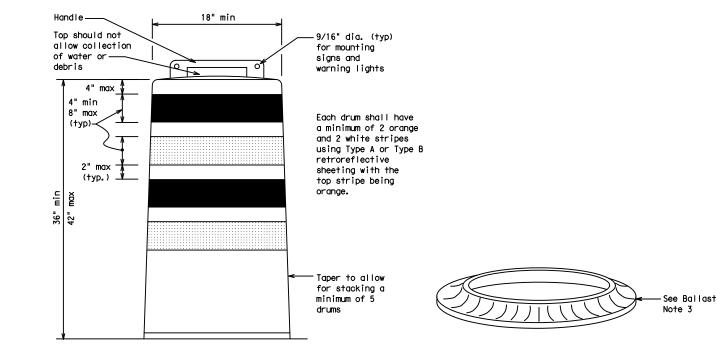


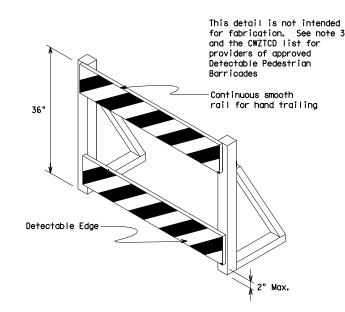



### DETECTABLE PEDESTRIAN BARRICADES

- 1. When existing pedestrian facilities are disrupted, closed, or relocated in a TTC zone, the temporary facilities shall be detectable and include accessibility features consistent with the features present in the existing pedestrian facility. Refer to WZ(BTS-2) for Pedestrian Control requirements for Sidewalk Diversions, Sidewalk Detours and Crosswalk Closures. 2. Where pedestrians with visual disabilities normally use the
- closed sidewalk, a Detectable Pedestrian Barricade shall be placed across the full width of the closed sidewalk instead of a Type 3 Barricade.
- 3. Detectable pedestrian barricades similar to the one pictured above, longitudinal channelizing devices, some concrete barriers, and wood or chain link fencing with a continuous detectable edging can satisfactorily delineate a pedestrian
- 4. Tape, rope, or plastic chain strung between devices are not detectable, do not comply with the design standards in the "Americans with Disabilities Act Accessibility Guidelines (ADAAG)" and should not be used as a control for pedestrian movements.
- 5. Warning lights shall not be attached to detectable pedestrian barricades.
- 6. Detectable pedestrian barricades should use 8" nominal barricade rails as shown on BC(10) provided that the top rail provides a smooth continuous rail suitable for hand trailing with no splinters, burrs, or sharp edges.

È C

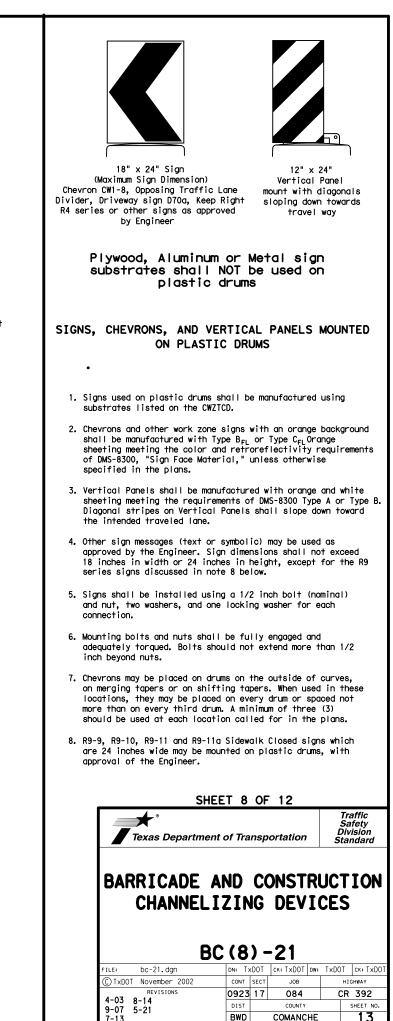

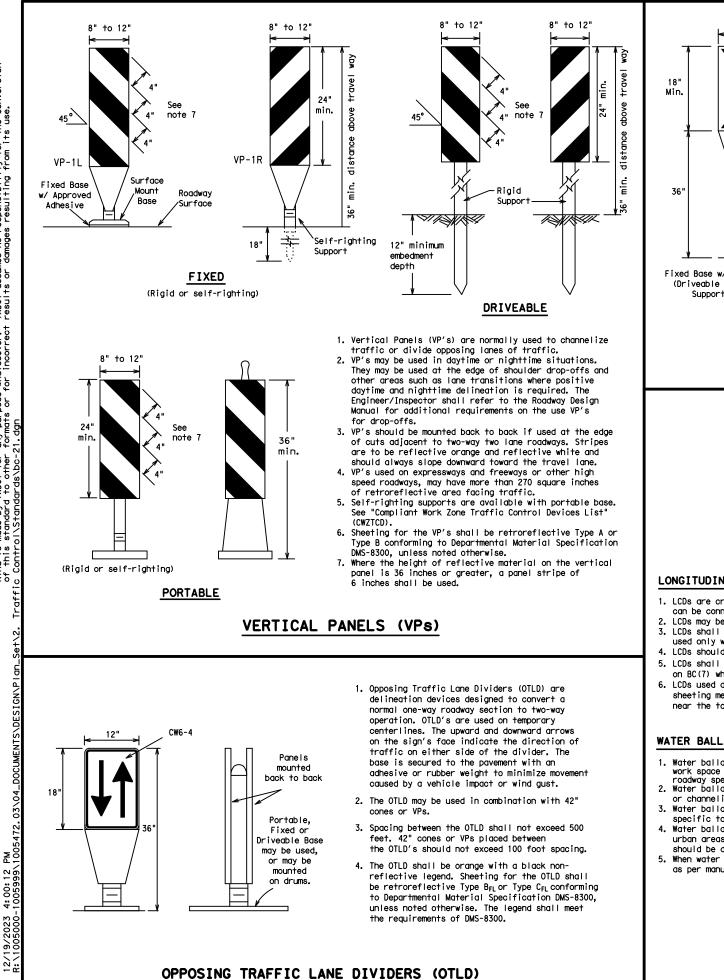

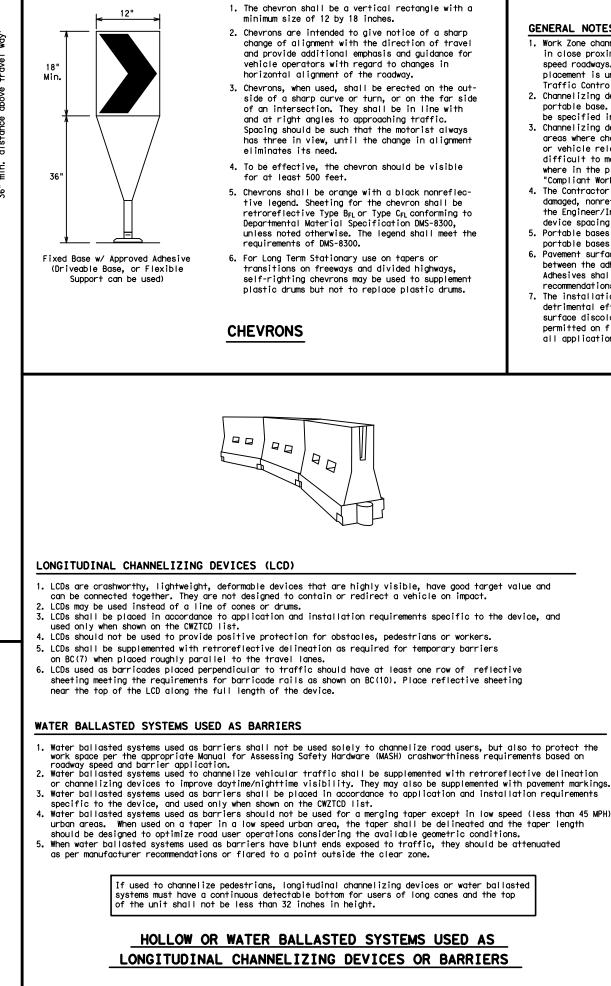

DATE:

### GENERAL NOTES

- 1. Work Zone channelizing devices illustrated on this sheet may be installed in close proximity to traffic and are suitable for use on high or low speed roadways. The Engineer/Inspector shall ensure that spacing and placement is uniform and in accordance with the "Texas Manual on Uniform Traffic Control Devices" (TMUTCD),
- 2. Channelizing devices shown on this sheet may have a driveable, fixed or portable base. The requirement for self-righting channelizing devices must be specified in the General Notes or other plan sheets.
- 3. Channelizing devices on self-righting supports should be used in work zone areas where channelizing devices are frequently impacted by errant vehicles or vehicle related wind gusts making alignment of the channelizing devices difficult to maintain. Locations of these devices shall be detailed elsewhere in the plans. These devices shall conform to the TMUTCD and the "Compliant Work Zone Traffic Control Devices List" (CWZTCD).
- 4. The Contractor shall maintain devices in a clean condition and replace damaged, nonreflective, faded, or broken devices and bases as required by the Engineer/Inspector. The Contractor shall be required to maintain proper device spacing and alignment.
- 5. Portable bases shall be fabricated from virgin and/or recycled rubber. The portable bases shall weigh a minimum of 30 lbs.
- Pavement surfaces shall be prepared in a manner that ensures proper bonding between the adhesives, the fixed mount bases and the pavement surface. Adhesives shall be prepared and applied according to the manufacturer's recommendations.
- 7. The installation and removal of channelizing devices shall not cause detrimental effects to the final pavement surfaces, including pavement surface discoloration or surface integrity. Driveable bases shall not be permitted on final pavement surfaces. The Engineer/Inspector shall approve all application and removal procedures of fixed bases.

Posted Speed	Formula	D	Minimur esirab er Leng <del>X X</del>	le	Spacir Channe	
		10' Offset	11' Offset	12' Offset	On a Tap <del>e</del> r	On a Tangent
30		150′	165′	180′	30′	60′
35	$L = \frac{WS^2}{60}$	205′	225′	245′	35′	70′
40	60	265'	295′	320′	40′	80′
45		450′	495′	540′	45′	90′
50		500'	550'	600′	50 <i>'</i>	100′
55	L=WS	550′	605′	660′	55′	110′
60	L - 11 S	600′	660′	720′	60 <i>'</i>	120′
65		650′	715′	780′	65′	130′
70		700′	770'	840′	70′	140′
75		750′	825′	900′	75′	150′
80		800′	880′	960′	80′	160′

SUGGESTED MAXIMUM SPACING OF CHANNELIZING DEVICES AND

L=Length of Taper (FT.) W=Width of Offset (FT.)


S=Posted Speed (MPH)

MINIMUM DESIRABLE TAPER LENGTHS

SHEET 9 OF 12 Traffic Safety Division Standard Texas Department of Transportation

# BARRICADE AND CONSTRUCTION CHANNELIZING DEVICES

		BC	(9	) -	·21			
ILE:	bc-21.dgn		DN: T>	DOT	ск: TxDOT	DW:	TxDOT	ск: TxDOT
C) TxDOT	November 2002		CONT	SECT	JOB		F	HIGHWAY
	REVISIONS		0923	17	084		CI	R 392
9-07	8-14		DIST		COUNTY			SHEET NO.
7-13	5-21		BWD		COMANC	HE		14
103								

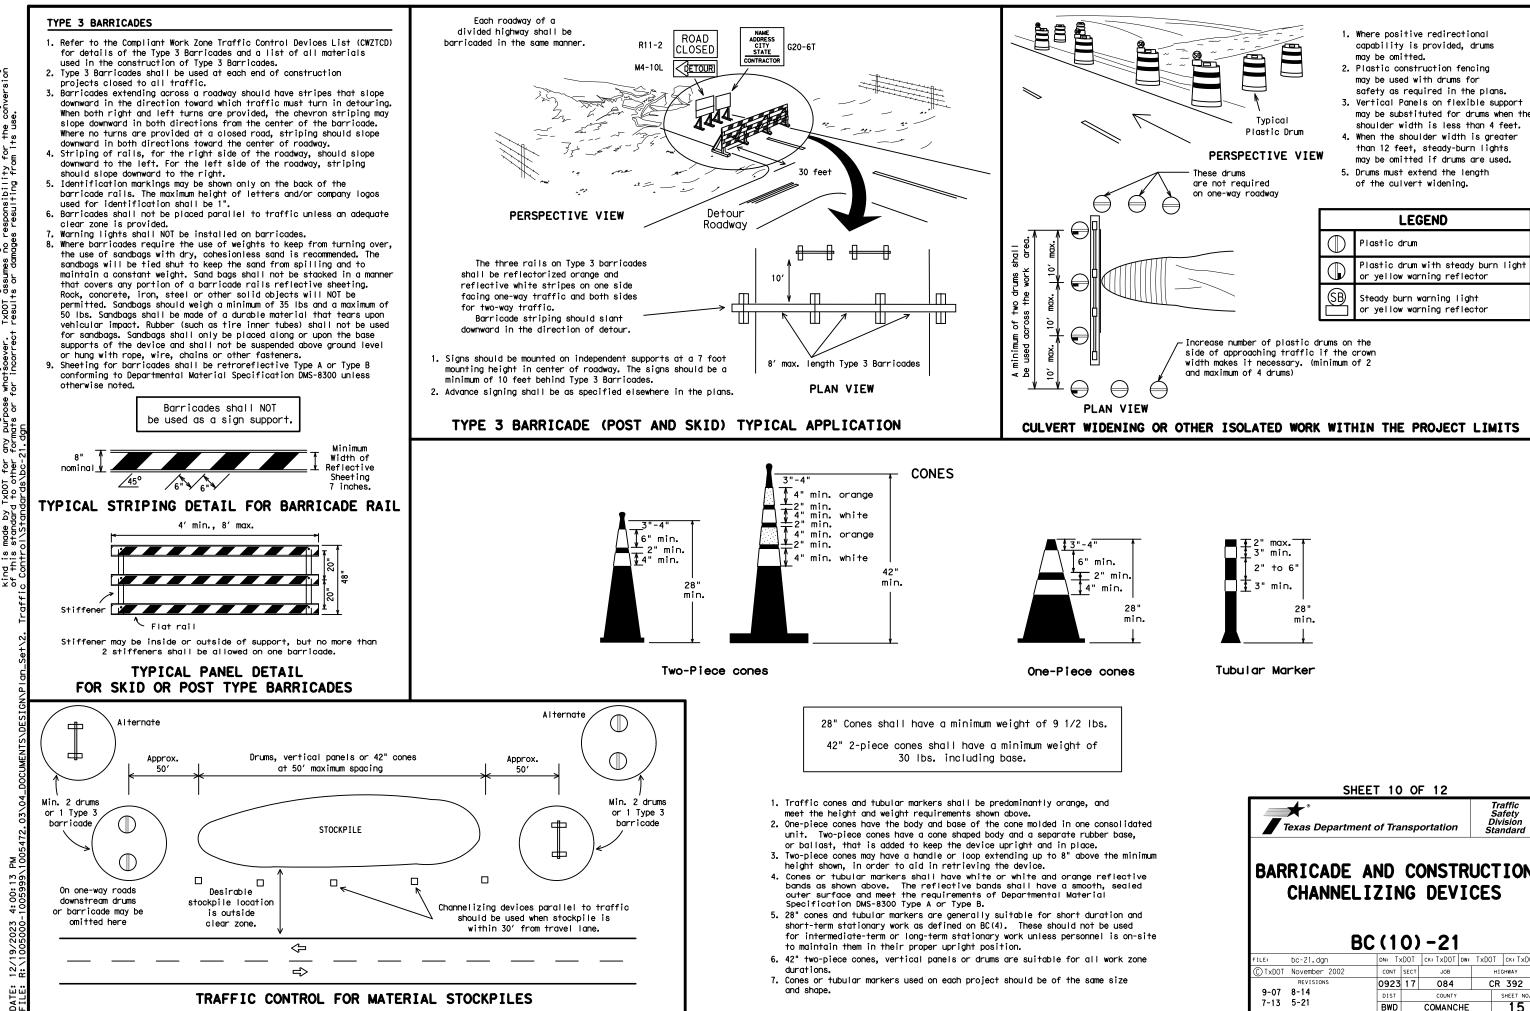

Σç 4:00:13 9/2023 12/1 DATE:

- SHEET 10 OF 12 Traffic Safety Division Standard Texas Department of Transportation BARRICADE AND CONSTRUCTION CHANNELIZING DEVICES BC(10)-21 DN: TXDOT CK: TXDOT DW: TXDOT CK: TXDO JOB HIGHWAY CR 392 084 SHEET N COMANCHE 15

# WORK ZONE PAVEMENT MARKINGS

### GENERAL

- The Contractor shall be responsible for maintaining work zone and existing pavement markings, in accordance with the standard specifications and special provisions, on all roadways open to traffic within the CSJ limits unless otherwise stated in the plans.
- 2. Color, patterns and dimensions shall be in conformance with the "Texas Manual on Uniform Traffic Control Devices" (TMUTCD).
- 3. Additional supplemental pavement marking details may be found in the plans or specifications.
- Pavement markings shall be installed in accordance with the TMUTCD and as shown on the plans.
- 5. When short term markings are required on the plans, short term markings shall conform with the TMUTCD, the plans and details as shown on the Standard Plan Sheet WZ (STPM).
- 6. When standard pavement markings are not in place and the roadway is opened to traffic, DO NOT PASS signs shall be erected to mark the beginning of the sections where passing is prohibited and PASS WITH CARE signs at the beginning of sections where passing is permitted.
- All work zone pavement markings shall be installed in accordance with Item 662, "Work Zone Pavement Markings."

### RAISED PAVEMENT MARKERS

- 1. Raised pavement markers are to be placed according to the patterns on BC(12).
- All raised pavement markers used for work zone markings shall meet the requirements of Item 672, "RAISED PAVEMENT MARKERS" and Departmental Material Specification DMS-4200 or DMS-4300.

### PREFABRICATED PAVEMENT MARKINGS

- 1. Removable prefabricated pavement markings shall meet the requirements of DMS-8241.
- Non-removable prefabricated pavement markings (foil back) shall meet the requirements of DMS-8240.


### MAINTAINING WORK ZONE PAVEMENT MARKINGS

- The Contractor will be responsible for maintaining work zone pavement markings within the work limits.
- Work zone pavement markings shall be inspected in accordance with the frequency and reporting requirements of work zone traffic control device inspections as required by Form 599.
- 3. The markings should provide a visible reference for a minimum distance of 300 feet during normal daylight hours and 160 feet when illuminated by automobile low-beam headlights at night, unless sight distance is restricted by roadway geometrics.
- Markings failing to meet this criteria within the first 30 days after placement shall be replaced at the expense of the Contractor as per Specification Item 662.

### REMOVAL OF PAVEMENT MARKINGS

- Pavement markings that are no longer applicable, could create confusion or direct a motorist toward or into the closed portion of the roadway shall be removed or obliterated before the roadway is opened to traffic.
- The above shall not apply to detours in place for less than three days, where flaggers and/or sufficient channelizing devices are used in lieu of markings to outline the detour route.
- Pavement markings shall be removed to the fullest extent possible, so as not to leave a discernable marking. This shall be by any method approved by TxDOT Specification Item 677 for "Eliminating Existing Pavement Markings and Markers".
- 4. The removal of pavement markings may require resurfacing or seal coating portions of the roadway as described in Item 677.
- Subject to the approval of the Engineer, any method that proves to be successful on a particular type pavement may be used.
- 6. Blast cleaning may be used but will not be required unless specifically shown in the plans.
- 7. Over-painting of the markings SHALL NOT BE permitted.
- 8. Removal of raised pavement markers shall be as directed by the Engineer.
- Removal of existing pavement markings and markers will be paid for directly in accordance with Item 677, "ELIMINATING EXISTING PAVEMENT MARKINGS AND MARKERS," unless otherwise stated in the plans.
- 10.Black-out marking tape may be used to cover conflicting existing markings for periods less than two weeks when approved by the Engineer.

# Temporary Flexible-Reflective Roadway Marker Tabs

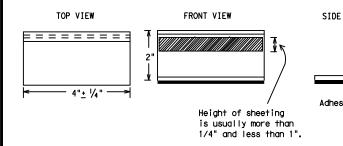

## STAPLES OR NAILS SHALL NOT BE USED TO SECU TEMPORARY FLEXIBLE-REFLECTIVE ROADWAY MARK TABS TO THE PAVEMENT SURFACE

- Temporary flexible-reflective roadway marker tabs used as guiden shall meet the requirements of DMS-8242.
- Tabs detailed on this sheet are to be inspected and accepted by Engineer or designated representative. Sampling and testing is n normally required, however at the option of the Engineer, either or "B" below may be imposed to assure quality before placement or roadway.
  - A. Select five (5) or more tabs at random from each lot or sh and submit to the Construction Division, Materials and Pav Section to determine specification compliance.
  - B. Select five (5) tabs and perform the following test. Affix (5) tabs at 24 inch intervals on an asphaltic pavement in straight line. Using a medium size passenger vehicle or pir run over the markers with the front and rear tires at a sp of 35 to 40 miles per hour, four (4) times in each direction more than one (1) out of the five (5) reflective surfaces a be lost or displaced as a result of this test.
- 3. Small design variances may be noted between tab manufacturers.
- 4. See Standard Sheet WZ(STPM) for tab placement on new pavements. Standard Sheet TCP(7-1) for tab placement on seal coat work.

## RAISED PAVEMENT MARKERS USED AS GUIDEMARK

- Raised pavement markers used as guidemarks shall be from the ap product list, and meet the requirements of DMS-4200.
- All temporary construction raised pavement markers provided on project shall be of the same manufacturer.
- Adhesive for guidemarks shall be bituminous material hot applie butyl rubber pad for all surfaces, or thermoplastic for concretsurfaces.

### Guidemarks shall be designated as:

YELLOW - (two amber reflective surfaces with yellow body). WHITE - (one silver reflective surface with white body).

ΜČ


4:00:13 1005999\

12/19/2023

DATE:

	DEPARTMENTAL MATERIAL SPEC	DMS-4200
	TRAFFIC BUTTONS	DMS-4200 DMS-4300
	EPOXY AND ADHESIVES	DMS-6100
E VIEW	BITUMINOUS ADHESIVE FOR PAVEMENT MARKERS	
57	PERMANENT PREFABRICATED PAVEMENT MARKING	
	TEMPORARY REMOVABLE, PREFABRICATED	
	PAVEMENT MARKINGS	DMS-8241
Ą	TEMPORARY FLEXIBLE, REFLECTIVE ROADWAY MARKER TABS	DMS-8242
sive pad	A list of prequalified reflective raised	navement markers
	non-reflective traffic buttons, roadway m	arker tabs and other
	pavement markings can be found at the Mate web address shown on BC(1).	eriai Producer List
RE		
ER		
narks		
the not		
"A"		
n the		
ipment		
ement		
five		
a		
ckup, eed		
on. No shall		
SHOTT		
See		
_		
s		
proved		
a		
d or e		
-		
	SHEET 11 OF	
		Traffic Safety Division
	Texas Department of Transpo	ortation Division Standard
	BARRICADE AND CO	NSTRUCTION
	PAVEMENT MA	rkings
	BC (11)	-21
		CK: TXDOT DW: TXDOT CK: TXDOT
	FILE: DC-21.dgn DN: 1XD01 C TXD0T February 1998 CONT SECT	JOB HIGHWAY
	REVISIONS 0923 17	084 CR 392
	1-02 7-13 11-02 8-14 BWD	COUNTY SHEET NO.
		10

105

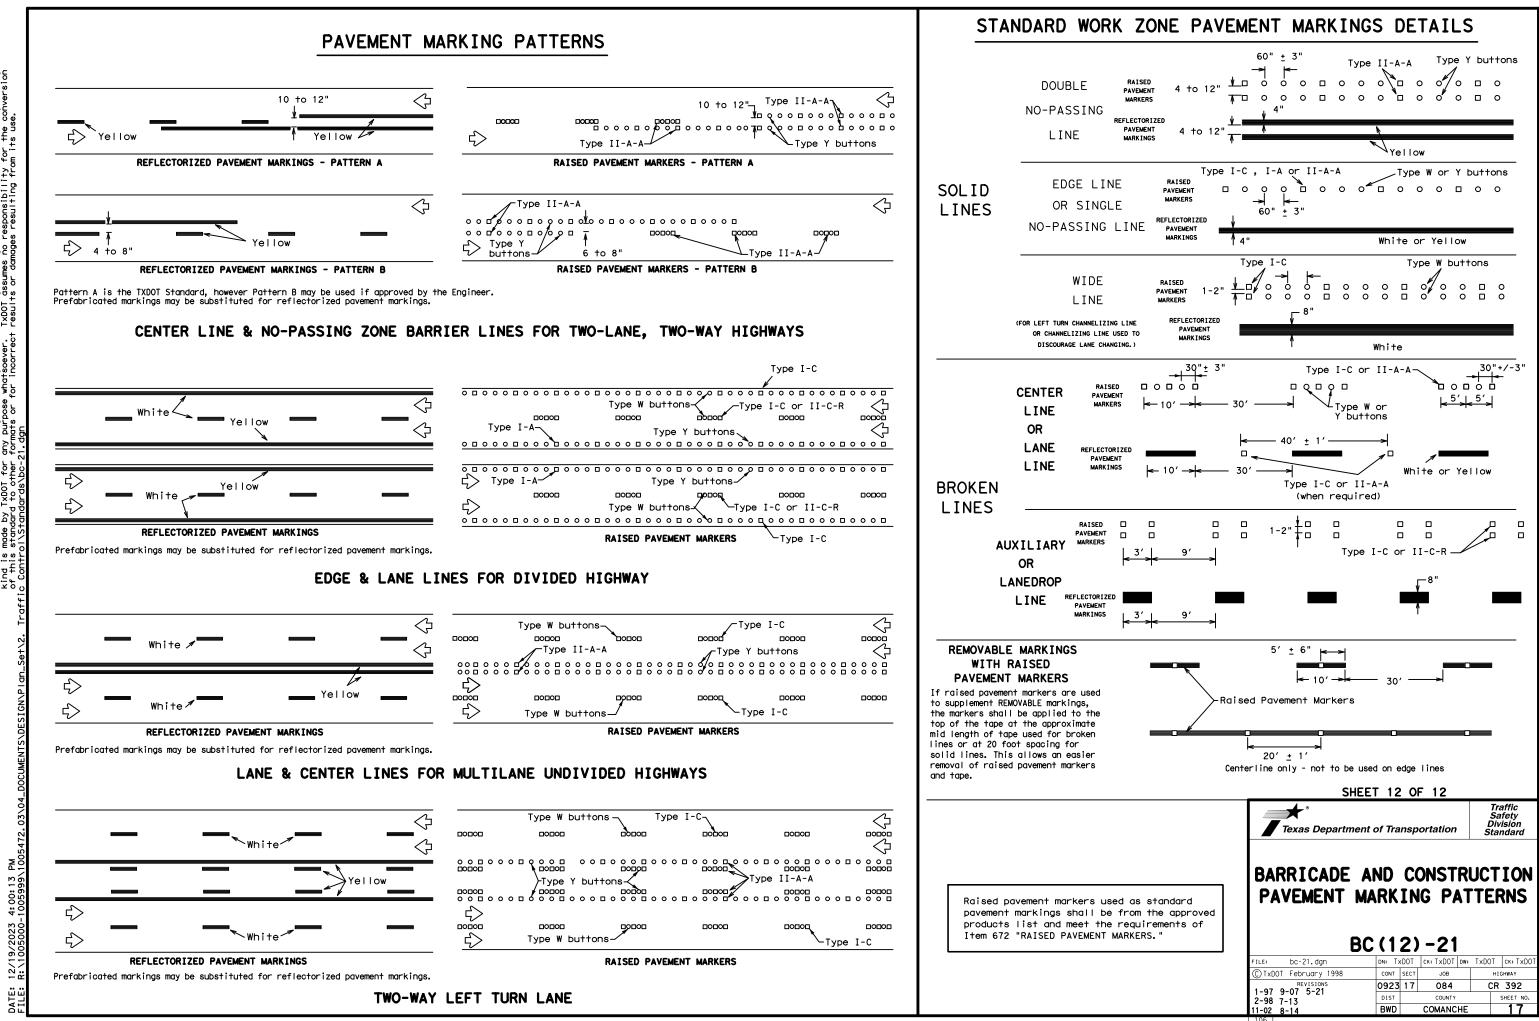

of this standard is governed by the "Texas Engineering Practice Act". No warranty of any by TXDOT for any purpose whatsoever. TXDOT assumes no responsibility for the conversion defect to other formats or for incorrect results or damages resulting from its use. DISCLAIMER: The use o kind is made of this stand

	CONTROL MONUMENTATION	N TABLE			
POINT STATION		STING (E) ELEV.	DESCRIPTION		
CP-2 10+18.7	7 18.76510 10,641,483,14 2,9	48,870,84 1066,19'	TXDOT ALLUM CAP		
CP-3 12+81.15	5 -12.53384 10,641,717.25 2,9	48,999.97 1067.90'	TXDOT ALLUM CAP		
CP-5 13+51.28	8 -11.94163 10,641,767.61 2,9	949,052.58 1068.30'	SET TXDOT MON		
				END PROJECT	
	MONUMENT INVERSE			CSJ: 0923-17-084	
FROM TO	BEARING DISTANCE			STA. 13+82.00	
CP-1 CP-4	N 13°26′46 E 1246.26′				1-1
CP-4 CP-2					5:00
CP-2 CP-3					1.1.3
CP-3 CP-5	N 46°15′13" E 72,82′				× C S \*
					Jos to
	INE DATA		/	CP-5, 5, 6	, AB. 10
LINE BEAF					10
	7' 20" E 82.03'		5		
	4′ 48 <b>° E</b> 192.54′				12
L3 N 52° 4	5′33 E 71.15′				162
			\		
				RESLEY CREEK HILLSISS	
			\	A CO. IN A. 12	C3
			\	to EEX 11 33.5	PI STATION = 14+86.29
			1		DELTA = 14° 14′ 18.50" (RT
					DEGREE OF CURVE = 11° 27'
					TANGENT = $62.45$
					LENGTH = 124.25
					RADIUS = 500.00
				in the second se	PC STATION = 14+23.85
		C1		ØI-OL STATION IN INTERNET	PT STATION = $15+48.10$
	PI STATION = 10+41	1.79			
	DELTA = 08° 52′ 31.36"				
DEGREE	OF CURVE = 19° 05′ 54.		er io		
	TANGENT = 23		×		
	LENGTH = 46		N.	CP-2	C2
	RADIUS = 300			10 NI	PI STATION = 13+05.51
	PC  STATION = 10+18				DELTA = 18° 10′ 44,30″ (RT)
	PT STATION = 10+64	4.98	/	9 <sup>L</sup> / Bhu	DEGREE OF CURVE = 19° 05' 54.94"
			12		TANGENT = 48.00
			/ G/		LENGTH = 95.19
			1 1		RADIUS = 300.00
			/ / CP-4		PC STATION = 12+57,51
			/ / 06 - 4		PT STATION = 13+52.70
			/ / r		
				BEGIN PROJECT /	
				CSJ: 0923-17-084 /	
			' '	STA. 09+57.00	
			L		

CP-1 ◬

NOTES:

1.ALL BEARINGS AND COORDINATES ARE BASED ON THE TEXAS COORDINATE SYSTEM, CENTRAL ZONE (4203), NORTH AMERICAN DATUM OF 1983 (NAD 83), (2011), EPOCH 2010.00. ALL DISTANCES AND COORDINATES SHOWN HEREON ARE SURFACE VALUES AND MAY BE CONVERTED TO GRID BY DIVIDING BY THE SURFACE ADJUSTMENT FACTOR OF 1.00003 FOR COMANCHE COUNTY, TEXAS,

2.HORIZONTAL CONTROL WAS DERIVED FROM MULTIPLE GPS OBSERVATIONS UTILIZING TXDOT RTN (VRS), HORIZONTAL SURVEY METHOD: TXDOT RTN

3.ALL ELEVATIONS HEREON ARE REFERENCED TO THE NORTH AMERICAN VERTICAL DATUM OF 1988 (NAVD 88).


4.THE ELEVATION OF THE EXISTING PROVIDED TXDOT CONTROL MONUMENT NO. 1 WAS HELD FOR VERTICAL CONTROL (NAVD88, GEOID 18). VERTICAL SURVEY METHODI DIGITAL LEVELING


5.FIELD SURVEYS WERE PERFORMED BETWEEN JUNE, 2023 AND AUGUST, 2023.


THE CONTROL POINTS SHOWN HEREIN WERE DETERMINED BY A SURVEY MADE ON THE GROUND UNDER MY SUPERVISION AND REPRESENTS AN UPDATE TO SURVEY CONTROL PREVIOUSLY ESTABLISHED AND PROVIDED BY TXDOT. SURVEY DATE: AUGUST, 2023






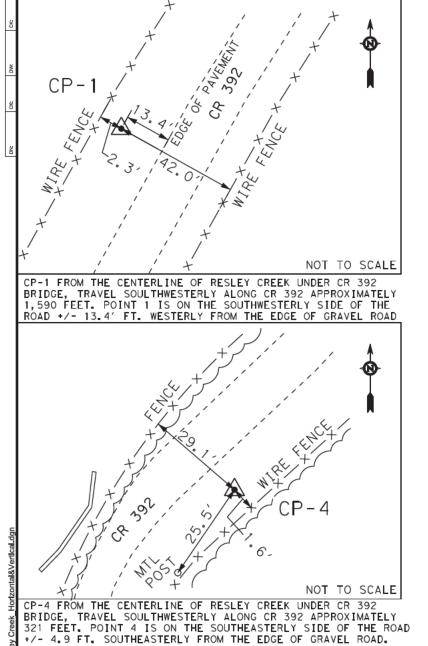

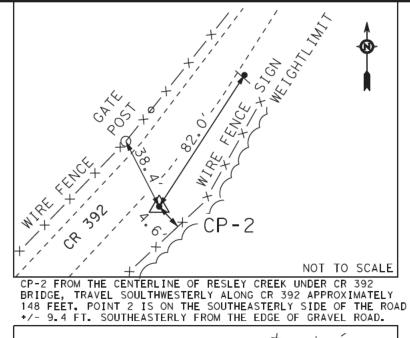

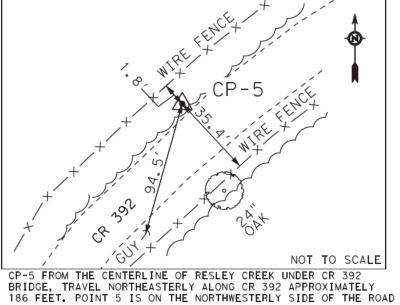

+/- 4.5 FT. NORTHWESTERLY FROM THE EDGE OF GRAVEL ROAD.

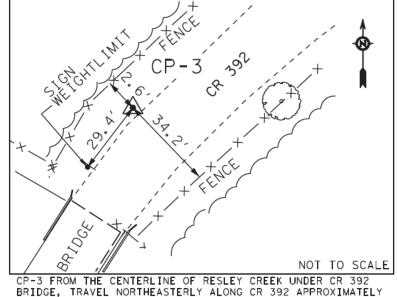

BRIDGE, TRAVEL NORTHEASTERLY ALONG CR 392 APPROXIMATELY 112 FEET, POINT 3 IS ON THE NORTHWESTERLY SIDE OF THE ROAD +/- 4.4 FT. NORTHWESTERLY FROM THE EDGE OF GRAVEL ROAD.

NOTES:

1.ALL BEARINGS AND COORDINATES ARE BASED ON THE TEXAS COORDINATE SYSTEM, CENTRAL ZONE (4203), NORTH AMERICAN DATUM OF 1983 (NAD 83), (2011), EPOCH 2010.00. ALL DISTANCES AND COORDINATES SHOWN HEREON ARE SURFACE VALUES AND MAY BE CONVERTED TO GRID BY DIVIDING BY THE SURFACE ADJUSTMENT FACTOR OF 1.00003 FOR COMANCHE COUNTY, TEXAS.

2.HORIZONTAL CONTROL WAS DERIVED FROM MULTIPLE GPS OBSERVATIONS UTILIZING TXDOT RTN (VRS). HORIZONTAL SURVEY METHOD: TXDOT RTN

3.ALL ELEVATIONS HEREON ARE REFERENCED TO THE NORTH AMERICAN VERTICAL DATUM OF 1988 (NAVD 88).

4.THE ELEVATION OF THE EXISTING PROVIDED TXDOT CONTROL MONUMENT NO. 1 WAS HELD FOR VERTICAL CONTROL (NAVD88, GEOID 18). VERTICAL SURVEY METHOD3 DIGITAL LEVELING

5. FIELD SURVEYS WERE PERFORMED BETWEEN JUNE, 2023 AND AUGUST, 2023

THE CONTROL POINTS SHOWN HEREIN WERE DETERMINED BY A SURVEY MADE ON THE GROUND UNDER MY SUPERVISION AND REPRESENTS AN UPDATE TO SURVEY CONTROL PREVIOUSLY ESTABLISHED AND PROVIDED BY TXDOT. SURVEY DATE: AUGUST, 2023

### NOT TO SCALE





HORIZONTAL ALIGNMENT REPORT				PC	14+23.85 R1	2949117.624	10641802.060
				PI	14+86.29 R1	2949167.340	10641839.850
Alignment name: CR 392				CC		2949420.209	10641404.010
Alignment description: Centerline of CR 392				PT	15+48.10 R1	2949224.823	10641864.250
Report Created: Monday, October 9, 2023				Radius:	500		
Time: 2:55:00 PM				Delta:	14°14'18.50" Right		
	STATION	X	Y	Degree of Curvature(Arc):	11°27'32.96"		
				Length:	124.25		
POT	9+36.48 R1		10641436.300	Tangent:	62.45		
PC	10+18.50 R1	2948857.031	10641495.850	Chord:	123.93		
Tangential Direction:	N43°27'19.56"E			Middle Ordinate:	3.85		
Tangential Length:	82.03			External:	3.88		
				Tangent Back Direction:	N52°45'32.50"E		
				Radial Direction:	S37°14'27.50"E		
PC	10+18.50 R1		10641495.850	Chord Direction:	N59°52'41.75"E		
PI	10+41.79 R1		10641512.750	Radial Direction:	S23°00'09.00"E		
			10641702.180	Tangent Ahead Direction:	N66°59'51.00"E		
PT	10+64.98 R1	2948886.258	10641531.920				
Radius:	300						
Delta:	08°52'31.36" Left			PT	15+48.10 R1	2949224.823	10641864.250
Degree of Curvature(Arc):	19°05'54.94"			POT	16+22.79 R1	2949293.572	10641893.440
Length:	46.47			Tangential Direction:	N66°59'51.00"E		
Length: Tangent:	23.28			Tangential Length:	74.69		
Chord:	46.42						
Middle Ordinate:	40.42 0.9						
External:	0.9						
Tangent Back Direction:	N43°27'19.56"E						
Radial Direction:	S46°32'40.44"E						
Chord Direction:	N39°01'03.88"E						
Radial Direction:	S55°25'11.80"E						
Tangent Ahead Direction:	N34°34'48.20"E						
PT	10+64.98 R1	2948886.258	10641531.920				
PC	12+57.51 R1		10641690.440				
Tangential Direction:	N34°34'48.20"E						
Tangential Length:	192.54						
PC	12+57.51 R1	2048005 524	10641690.440				
	12+57.51 R1 13+05.51 R1		10641729.960				
	107-05.51 MI		10641729.980				
PT	13+52.70 R1		10641759.000				
Radius:	300	2949000.983	10041/09.000				
Delta:	18°10'44.30"						
	Right						
Degree of Curvature(Arc):	19°05'54.94"						
Length:	95.18						
Length: Tangent:	95.18 48						
Length: Tangent: Chord:	95.18 48 94.79						
Length: Tangent: Chord: Middle Ordinate:	95.18 48 94.79 3.77						
Length: Tangent: Chord: Middle Ordinate: External:	95.18 48 94.79 3.77 3.82						
Length: Tangent: Chord: Middle Ordinate: External: Tangent Back Direction:	95.18 48 94.79 3.77 3.82 N34°34'48.20"E						
Length: Tangent: Chord: Middle Ordinate: External: Tangent Back Direction: Radial Direction:	95.18 48 94.79 3.77 3.82 N34°34'48.20"E 555°25'11.80"E						
Length: Tangent: Chord: Middle Ordinate: External: Tangent Back Direction: Radial Direction: Chord Direction:	95.18 48 94.79 3.77 3.82 N34°34'48.20"E 555°25'11.80"E N43°40'10.35"E						
Length: Tangent: Chord: Middle Ordinate: External: Tangent Back Direction: Radial Direction: Chord Direction: Radial Direction:	95.18 48 94.79 3.77 3.82 N34°34'48.20"E 555°25'11.80"E N43°40'10.35"E 537°14'27.50"E						
Length: Tangent: Chord: Middle Ordinate: External: Tangent Back Direction: Radial Direction: Chord Direction:	95.18 48 94.79 3.77 3.82 N34°34'48.20"E 555°25'11.80"E N43°40'10.35"E						
Length: Tangent: Chord: Middle Ordinate: External: Tangent Back Direction: Radial Direction: Chord Direction: Radial Direction:	95.18 48 94.79 3.77 3.82 N34°34'48.20"E 555°25'11.80"E N43°40'10.35"E 537°14'27.50"E	2949060.983	10641759.000				
Length: Tangent: Chord: Middle Ordinate: External: Tangent Back Direction: Radial Direction: Chord Direction: Radial Direction: Tangent Ahead Direction:	95.18 48 94.79 3.77 3.82 N34°34'48.20"E 555°25'11.80"E N43°40'10.35"E S37°14'27.50"E N52°45'32.50"E		10641759.000 10641802.060				
Length: Tangent: Chord: Middle Ordinate: External: Tangent Back Direction: Radial Direction: Chord Direction: Radial Direction: Tangent Ahead Direction:	95.18 48 94.79 3.77 3.82 N34°34'48.20"E S55°25'11.80"E N43°40'10.35"E S37°14'27.50"E N52°45'32.50"E						


4:00:15 PM 1005999\10054

12/19/2023 R:\1005000-

DATE: FILE:

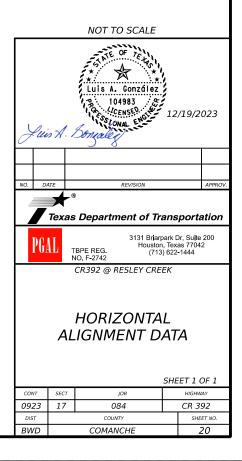

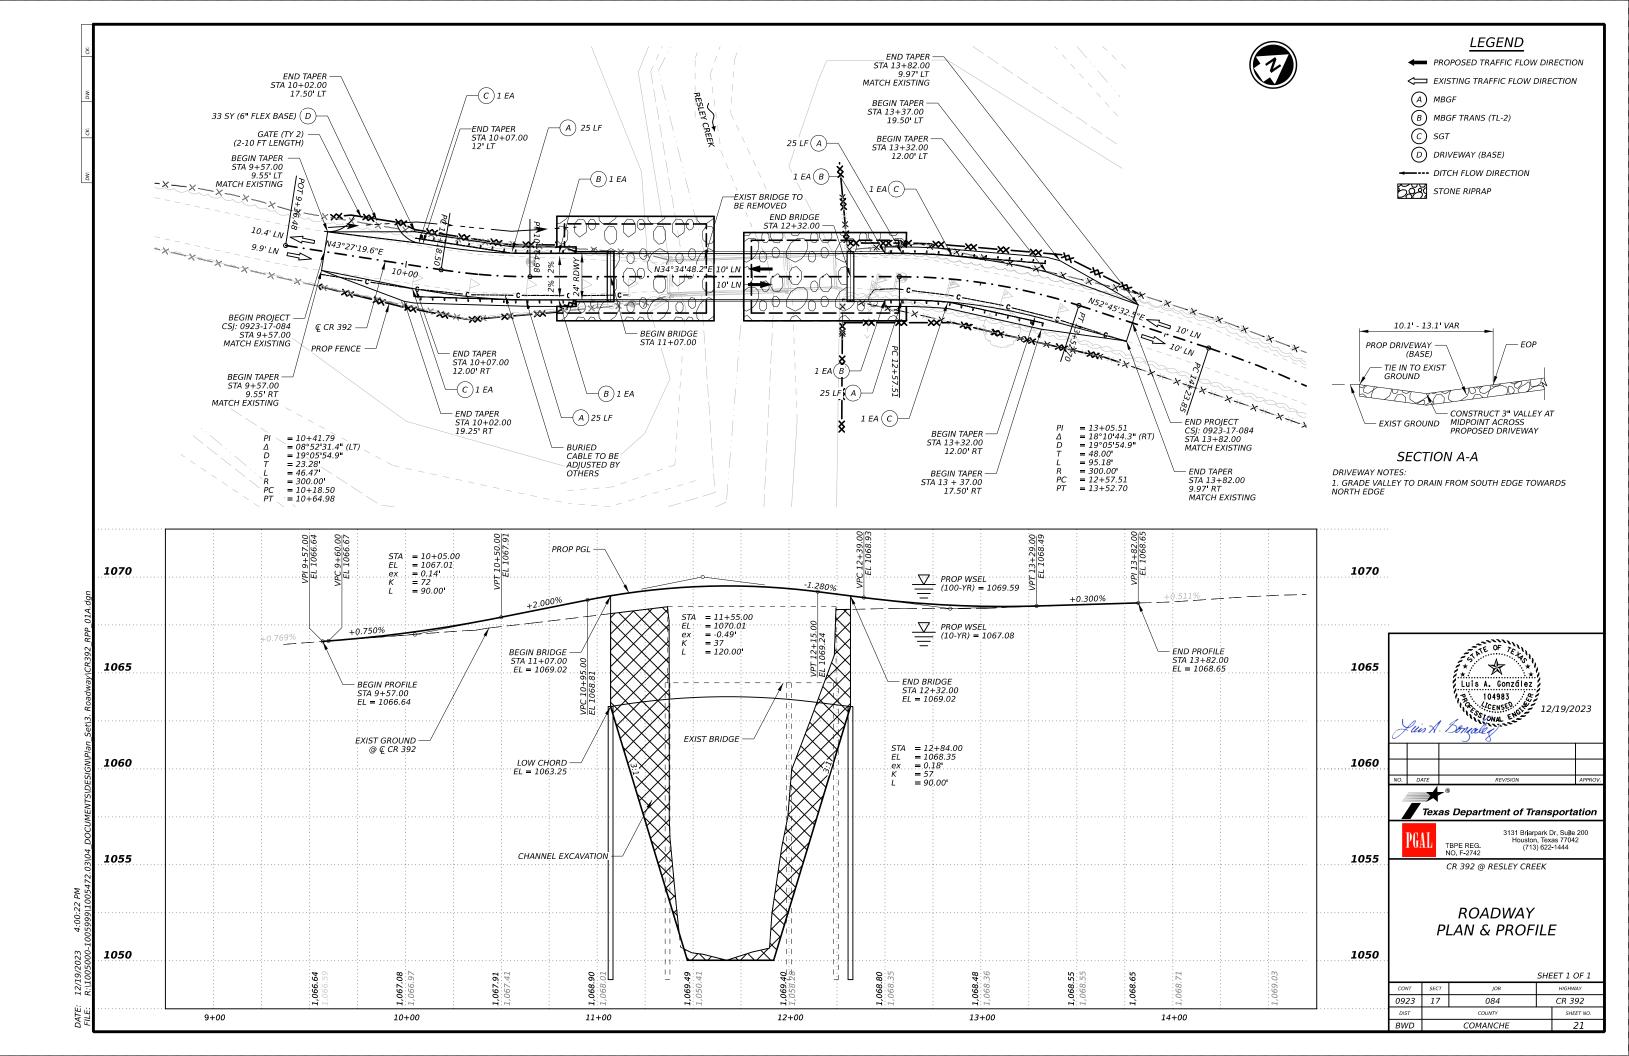

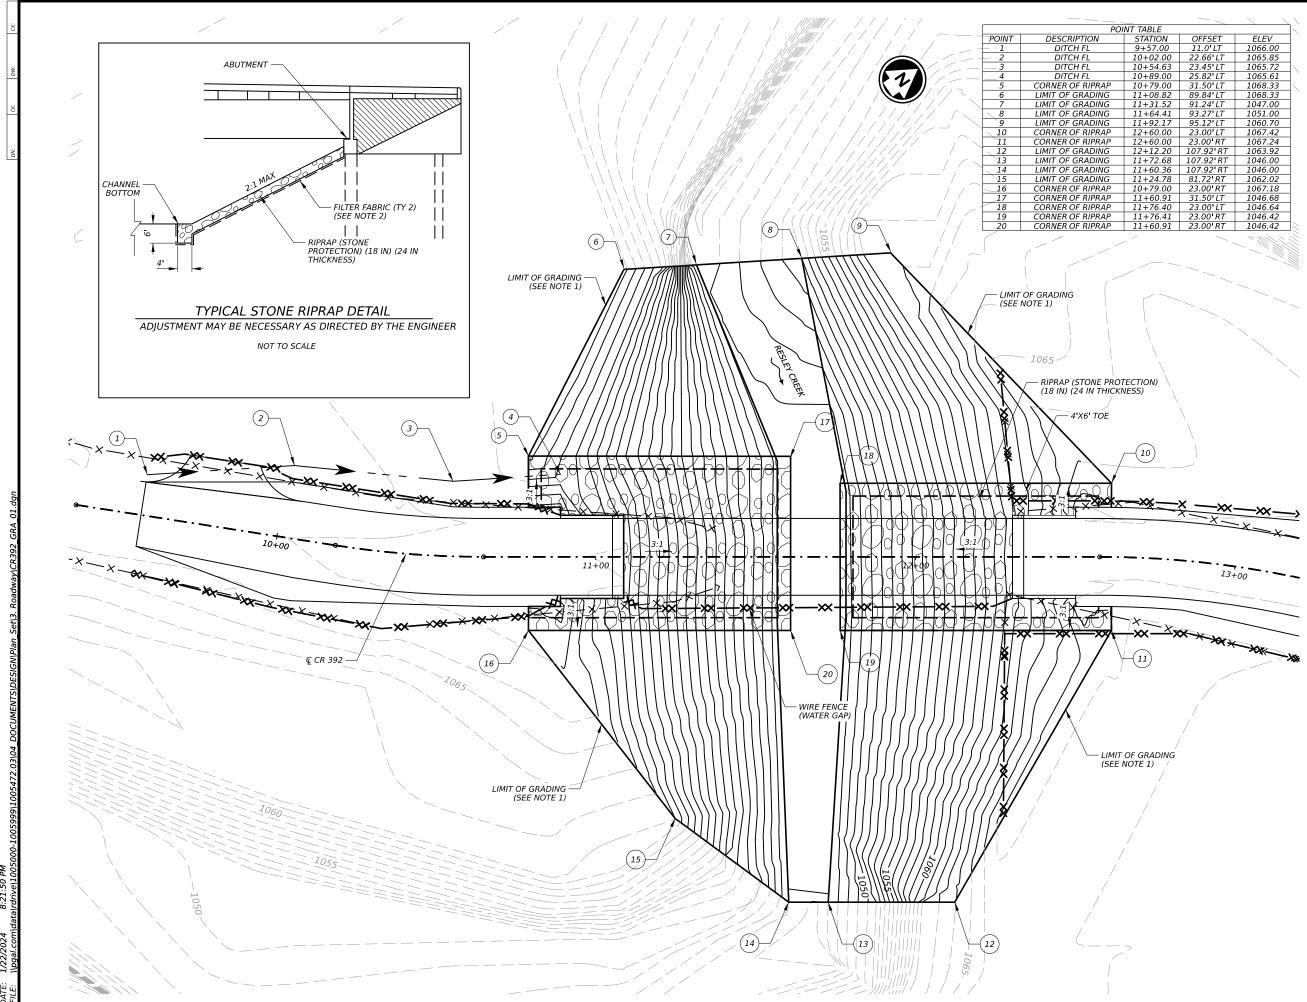


			_			$\langle \langle \rangle$
INT TABLE						
STATIO	V	OFFSE	T	EL	EV	Ì
9+57.0	0	11.0'	LT	106	6.00	
10+02.0	00	22.66'	LT	106.	5.85	
10+54.6	53	23.45	LT	106	5.72	_ \
10+89.0	00	25.82'	LT	106	5.61	Ì
10+79.0	00	31.50	LT	106	8.33	_ \
11+08.8	32	89.84	LT	106	8.33	Ì
11+31.5	52	91.24	LT	104	7.00	
11+64.4	41	93.27	LT	105	1.00	
11+92.1	17	95.12	LT	106	0.70	
12+60.0	00	23.00'	LT	106	7.42	
12+60.0	00	23.00'	RT	106	7.24	
12+12.2	20 1	107.92	RT	106.	3.92	
11+72.6	58 .	107.92	RT	104	6.00	
11+60.3	36 .	107.92	RT	104	6.00	
11+24.7	78	81.72'	RT	106.	2.02	
10+79.0	00	23.00'	RT	106	7.18	
11+60.9	91	31.50	LT	104	6.68	
11+76.4	10	23.00'	LT	104	6.64	
11+76.4	41	23.00'	RT	104	6.42	
11+60.9	91	23.00'	RT	104	6.42	
/			<u> </u>	~ ()		




## <u>NOTES</u>

- BRUSH REMOVAL AND TREE REMOVAL REQUIRED FOR CLEARING AREAS WITHIN THE GRADING LIMITS OF THE PROJECT ARE CONSIDERED SUBSIDIARY TO BID ITEM 100 "PREPARING ROW.
- 2. FILTER FABRIC IS SUBSIDIARY TO ITEM 432.

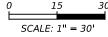


		SCALE: 1'' = 30'	
S	luis A.	Luis A. González 104983 Sonal Englishing Luis A. González 1/22/20. Sonal Englishing Lizz/20.	24
			1
NO.	DATE	REVISION	APPROV.
1	Tex	<sup>®</sup> as Department of Transporta	ation
	PGAL	3131 Briarpark Dr, Suite Houston, Texas 7704 TBPE REG. (713) 622-1444 NO. F-2742	
		CR392 @ RESLEY CREEK	
R	IPRA	P, GRADING & FEN LAYOUT	'CE
		SUEET 1 (	7E 1

			SHE	ET 1 OF 1
CONT	SECT	JOB		HIGHWAY
0923	17	084		CR 392
DIST		COUNTY		SHEET NO.
BWD		COMANCHE		22

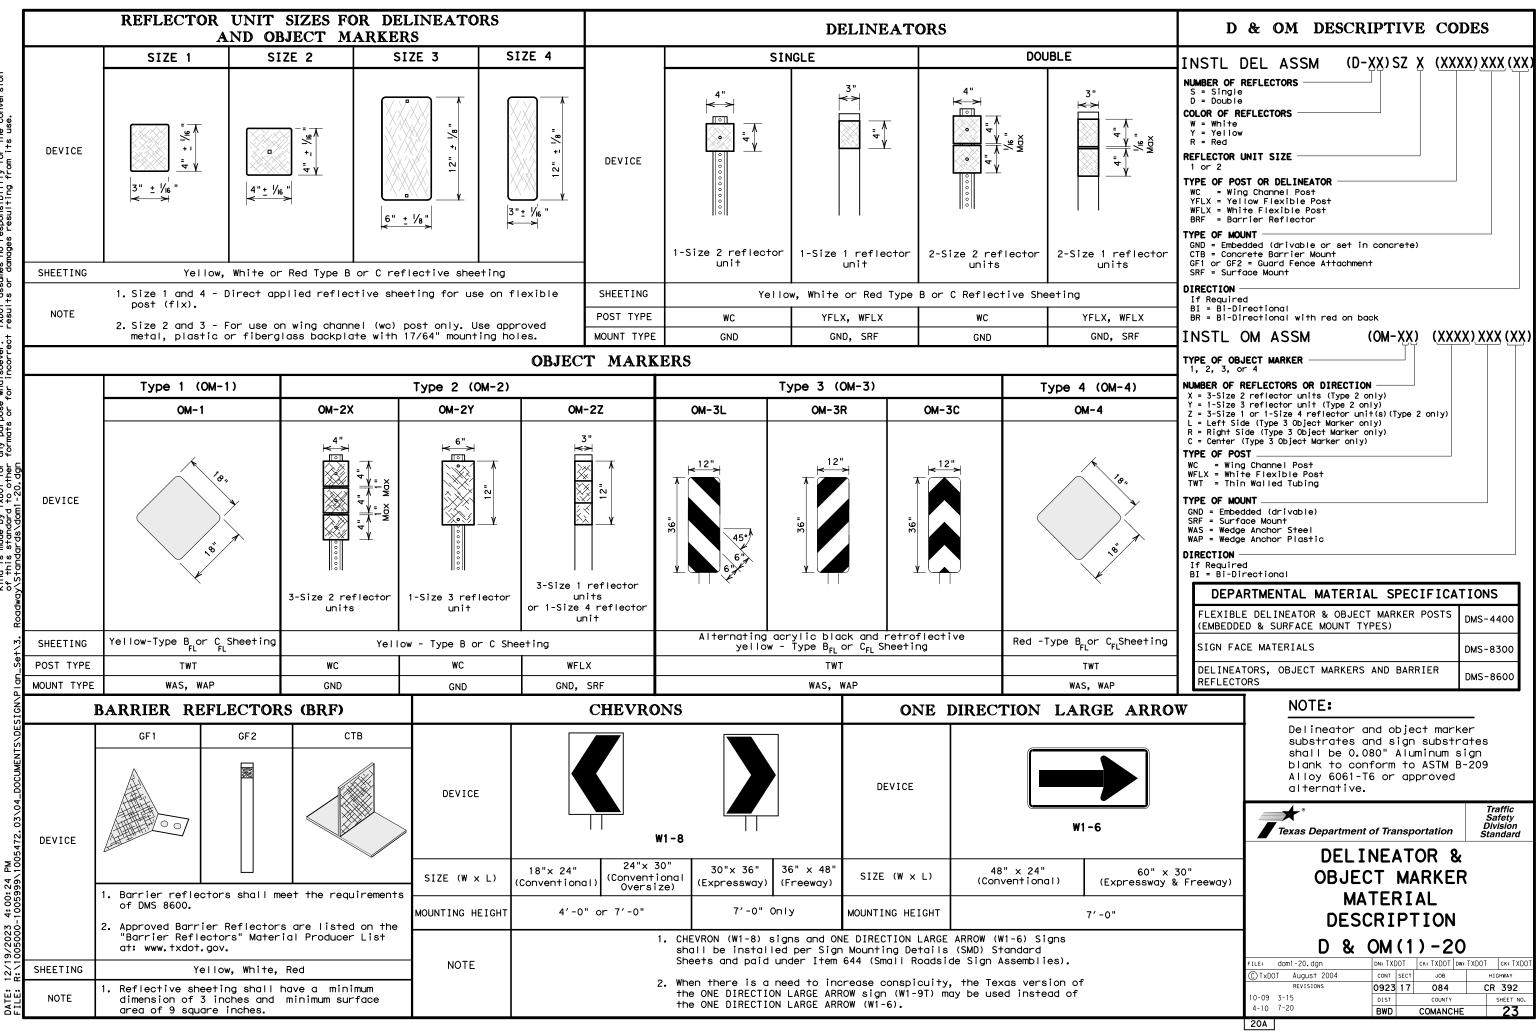

"Texas Engineering Practice Act". No warranty of any TXDOT assumes no responsibility for the conversion of results or damages resulting fram its use. a whatsoever. DISCLAIMER: The use of this standard is govern kind is made by TNOT for any purpose of this standard to other formats or ``^^aaarAs\Ann1-20, dan

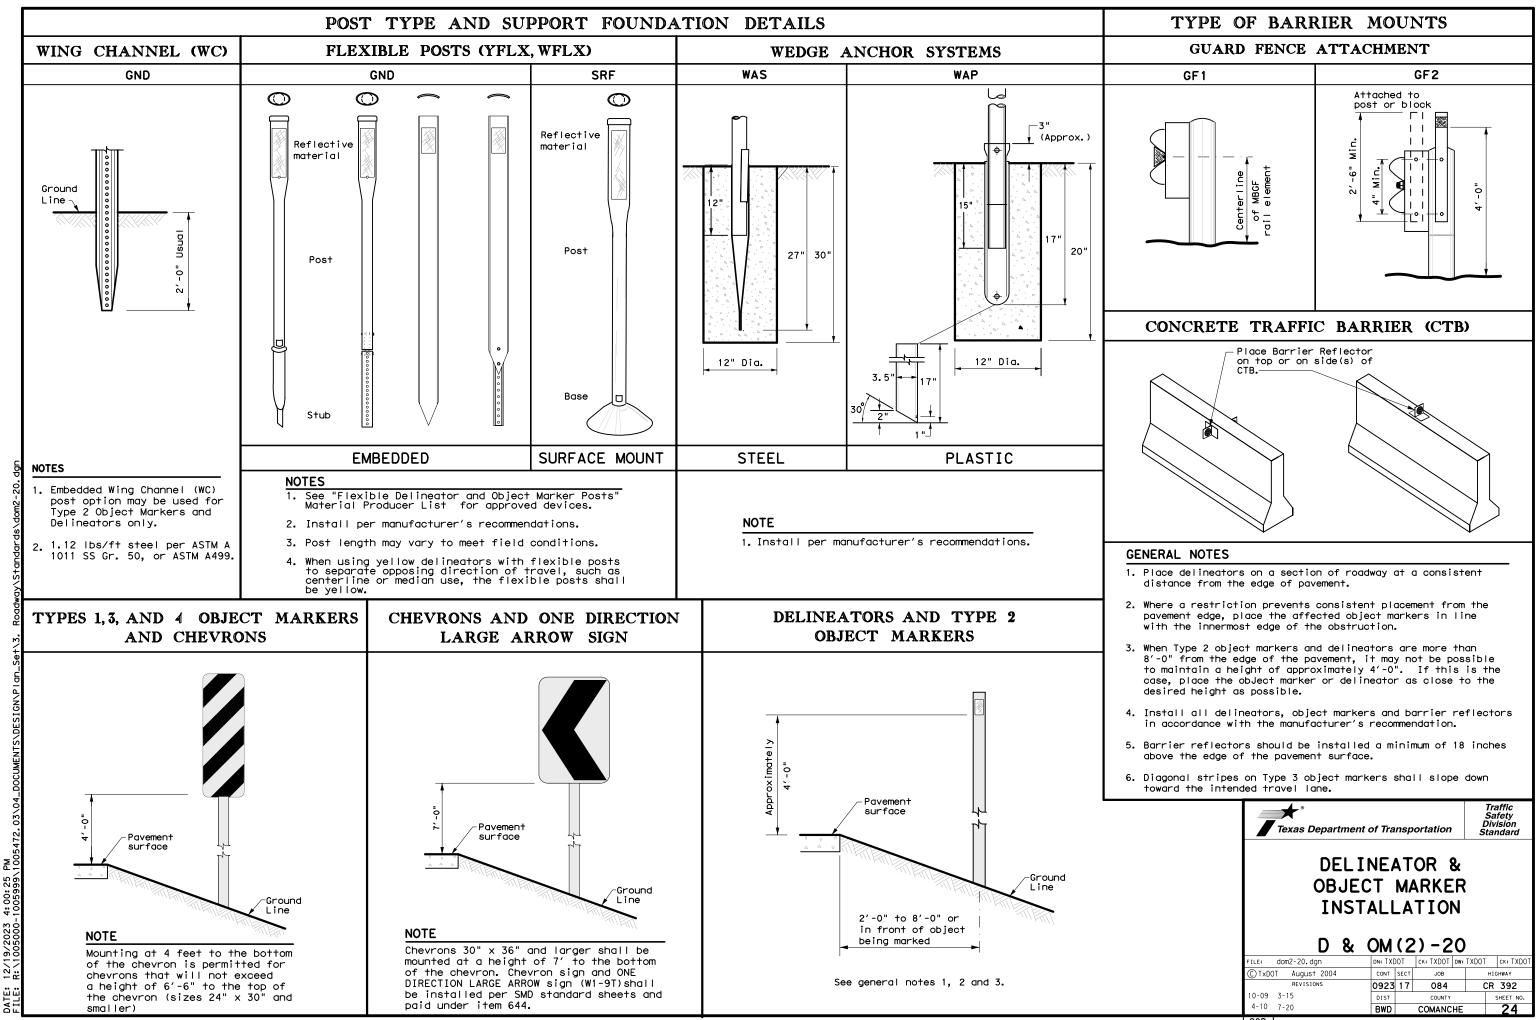


of this standard is governed by the "Texas Engineering Practice Act". No warranty of any by TXDOT for any purpose whatsoever. TXDOT assumes no responsibility for the conversion dard to other formats or for incorrect results or damages resulting from its use. DISCLAIMER: The use o Kind is made of this stand

12/19/2023 B: \1005000

20B

# MINIMUM WARNING DEVICES AT CURVES WITH ADVISORY SPEEDS


Amount by which Advisory Speed	Curve Advisory Speed				
is less than Posted Speed	Turn (30 MPH or less)	Curve (35 MPH or more)			
5 MPH & 10 MPH	• RPMs	• RPMs			
15 MPH & 20 MPH	• RPMs and One Direction Large Arrow sign	<ul> <li>RPMs and Chevrons; or</li> <li>RPMs and One Direction Large Arrow sign where geometric conditions or roadside obstacles prevent the installation of chevrons.</li> </ul>			
25 MPH & more	<ul> <li>RPMs and Chevrons; or</li> <li>RPMs and One Direction Large Arrow sign where geometric conditions or roadside obstacles prevent the installation of chevrons</li> </ul>	• RPMs and Chevrons			
SUGGES'	TED SPACING FOR ON HORIZONTAL (	-			

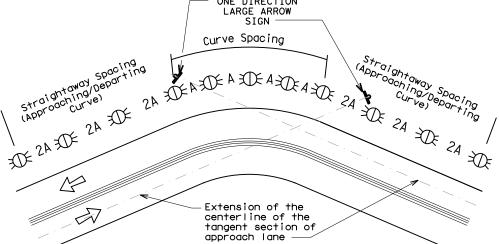

# NOTE

ONE DIRECTION LARGE ARROW (W1-6) sign should be located at approximately and perpendicular to the extension of the centerline of the tangent section of approach lane.

# SUGGESTED SPACING FOR CHEVRONS ON HORIZONTAL CURVES

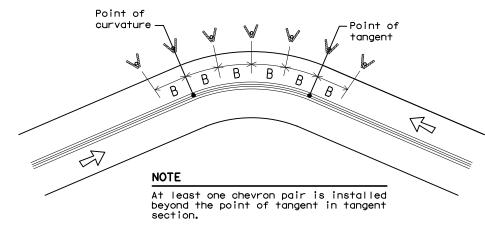

	LINEA	SPAC	ND CHE	VRUN
WHEN	N DEGREE	OF CURVE	OR RADIUS	IS KNOWN
			FEET	
)egree of Curve	Radius of Curve	Spacing in Curve	Spacing in Straightawa	Chevron Spacing in y Curve
		٨	2A	B
1	5730	A 225	450	
2	2865	160	320	
2	1910	130	260	200
4	1433	110	280	160
5	1146	100	220	160
6	955	90	180	160
7	819	85	170	160
8	716	75	150	160
9	637	75	150	120
10	573	70	140	120
11	521	65	130	120
12	478	60	120	120
13	441	60	120	120
14	409	55	110	80
15	382	55	110	80
16	358	55	110	80
19	302	50	100	80
23	249	40	80	80
29	198	35	70	40
38	150	30	60	40
57	101	20	40	40
rve d acing aced ed du	lelineato should at 2A. T	r approa include nis spac ign prep	ch and depa 3 delineato ing should aration or	rture rs be
		mon		
וע		SPAC	AND CHE CING	VKUN
WHEN (	DEGREE OF	CURVE C	OR RADIUS IS	NOT KNOWN
Advis Spee		•	Spacing in	Chevron Spacing in

SPACING								
WHEN DEGREE OF CURVE OR RADIUS IS NOT KNOWN								
Advisory Speed (MPH)	Spacing in Curve	Spacing in Straightaway	Chevron Spacing in Curve					
	А	2×A	В					
65	130	260	200					
60	110	220	160					
55	100	200	160					
50	85	170	160					
45	75	150	120					
40	70	140	120					
35	60	120	120					
30	55	110	80					
25	50	100	80					
20	40	80	80					
15	35	70	40					

If the degree of curve is not known, delineator spacing may be determined based on the Advisory Speed of the curve. Use the delineator curve spacing for each Advisory Speed (MPH).

DELINEATOR AND OBJECT MARKER APPLICATION AND SPACING							
CONDITION	REQUIRED TREATMENT	MINIMUM SPACING					
Frwy./Exp. Tangent	RPMs	See PM-series and FPM-series standard sheets					
Frwy./Exp. Curve	Single delineators on right side	See delineator spacing table					
Frwy/Exp.Ramp	Single delineators on at least one side of ramp (should be on outside of curves) (see Detail 3 on D&OM(4))	100 feet on ramp tangents Use delineator spacing table for ramp curves ("straightway spacing" does not apply to ramp curves)					
Acceleration/Deceleration Lane	Double delineators (see Detail 3 on D&OM(4))	100 feet (See Detail 3 on D & OM (4))					
Truck Escape Ramp	Single red delineators on both sides	50 feet					
Bridge Rail (steel or concrete)and Metal Beam Guard Fence	Bi-Directional Delineators when undivided with one lane each direction Single Delineators when multiple lanes each direction	Equal spacing (100'max) but not less than 3 delineators					
Concrete Traffic Barrier (CTB) or Steel Traffic Barrier	Barrier reflectors matching the color of the edge line	Equal spacing 100′ max					
Cable Barrier	Reflectors matching the color of the edge line	Every 5th cable barrier post (up to 100'max)					
Guard Rail Terminus/Impact Head	Divided highway - Object marker on approach end Undivided 2-lane highways - Object marker on approach and departure end	Requires reflective sheeting provided by manufacturer per D & OM (VIA) or a Type 3 Object Marker (OM-3) in front of the terminal end See D & OM (5) and D & OM (6)					
Bridges with no Approach Rail	Type 3 Object Marker (OM-3) at end of rail and 3 single delineators approaching rail	See D & OM(5)					
Reduced Width Approaches to Bridge Rail	Type 2 and Type 3 Object Markers (OM-3) and 3 single delineators approaching bridge	Requires reflective sheeting provided by manufacturer per D & OM (VIA) or a Type 3 Object Marker (OM-3) in front of the terminal end					
		See D & OM (5)					
Culverts without MBGF	Type 2 Object Markers	See Detail 2 on D & OM(4)					
Crossovers	Double yellow delineators and RPMs	See Detail 1 on D & OM (4)					
Pavement Narrowing (lane merge) on Freeways/Expressway	Single delineators adjacent to affected lane for full length of transition	100 feet					
NOTES							

- or barrier reflectors are placed.
- 3. Single red delineators may be mounted on the back side of delineator posts for wrong way driver applications

	LEGEND					
Ř	Bi-directic Delineator					
Я	Delineator					
-	Sign					


12/19/2023 4:00:28 PM R:\1005000-1005999\100

DATE: FILE:


1. Unless indicated otherwise, the delineator or barrier reflector color shall conform to the color of the pavement edge line on the side of the road where the delineators

2. Barrier reflectors may be used to replace required delineators.

	Texas Departmen	nt of Trai	nsp	ortation		Sa Div	affic fety ision ndard
	DEL: OBJE						
onal	PLACEM					S	
			_		_		
	D &	OM (	(3	)-2	0		
	FILE: dom3-20.dgn	DN: TXD	ЭT	ск: TXDOT	Dw: TXDO	Т	ск: TXDOT
	© TxDOT August 2004	CONT	SECT	JOB		нIC	GHWAY
	REVISIONS	0923	17	084		CR	392
	3-15 8-15	DIST		COUNTY			SHEET NO.
	8-15 7-20	BWD		COMANC	HE		25
	200						

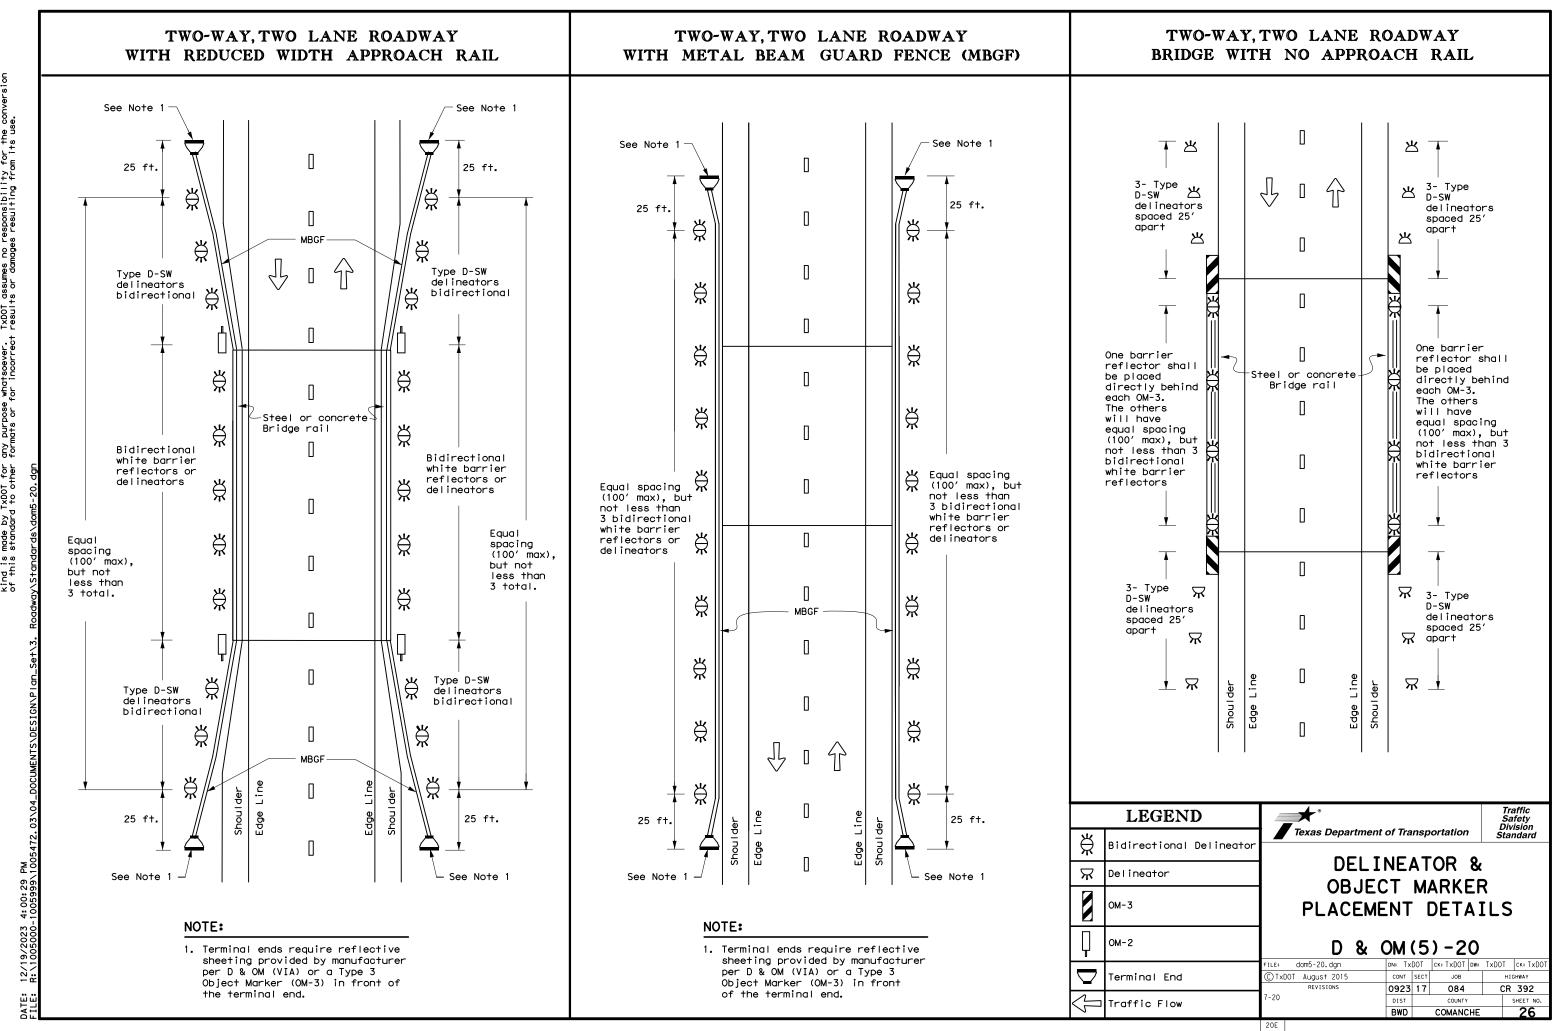


DISCLAIMER: The use of this standard is governed by the "Texas Engineering Practice Act". No warranty of any Kind is made by TXDOT for any purpose whatsoever. TXDOT assumes no responsibility for the conversion of this standard to other formats or for incorrect results or damages resulting from its use.

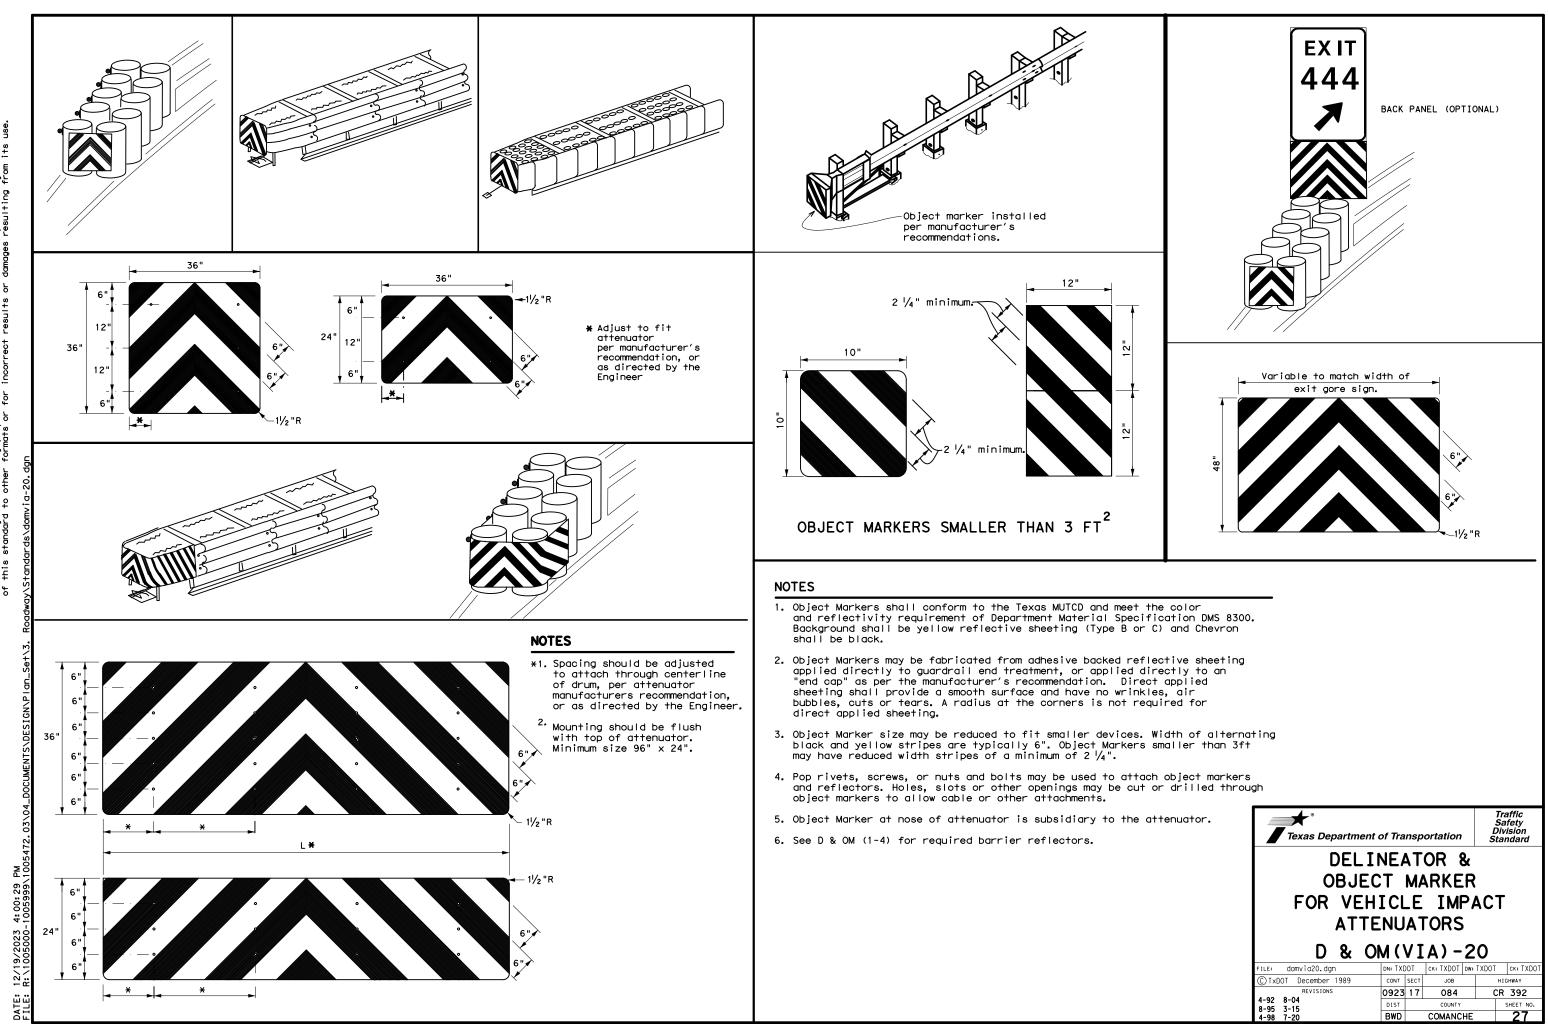

DISCLAIMER: The use of this standard is governed by the "Texas Engineering Practice Act". No warranty of any Kind is made by TxDDT for any purpose whatsoever. TxDDT assumes no responsibility for the conversion of this standard to other formats or for incorrect results or damages resulting from its use.

206

]

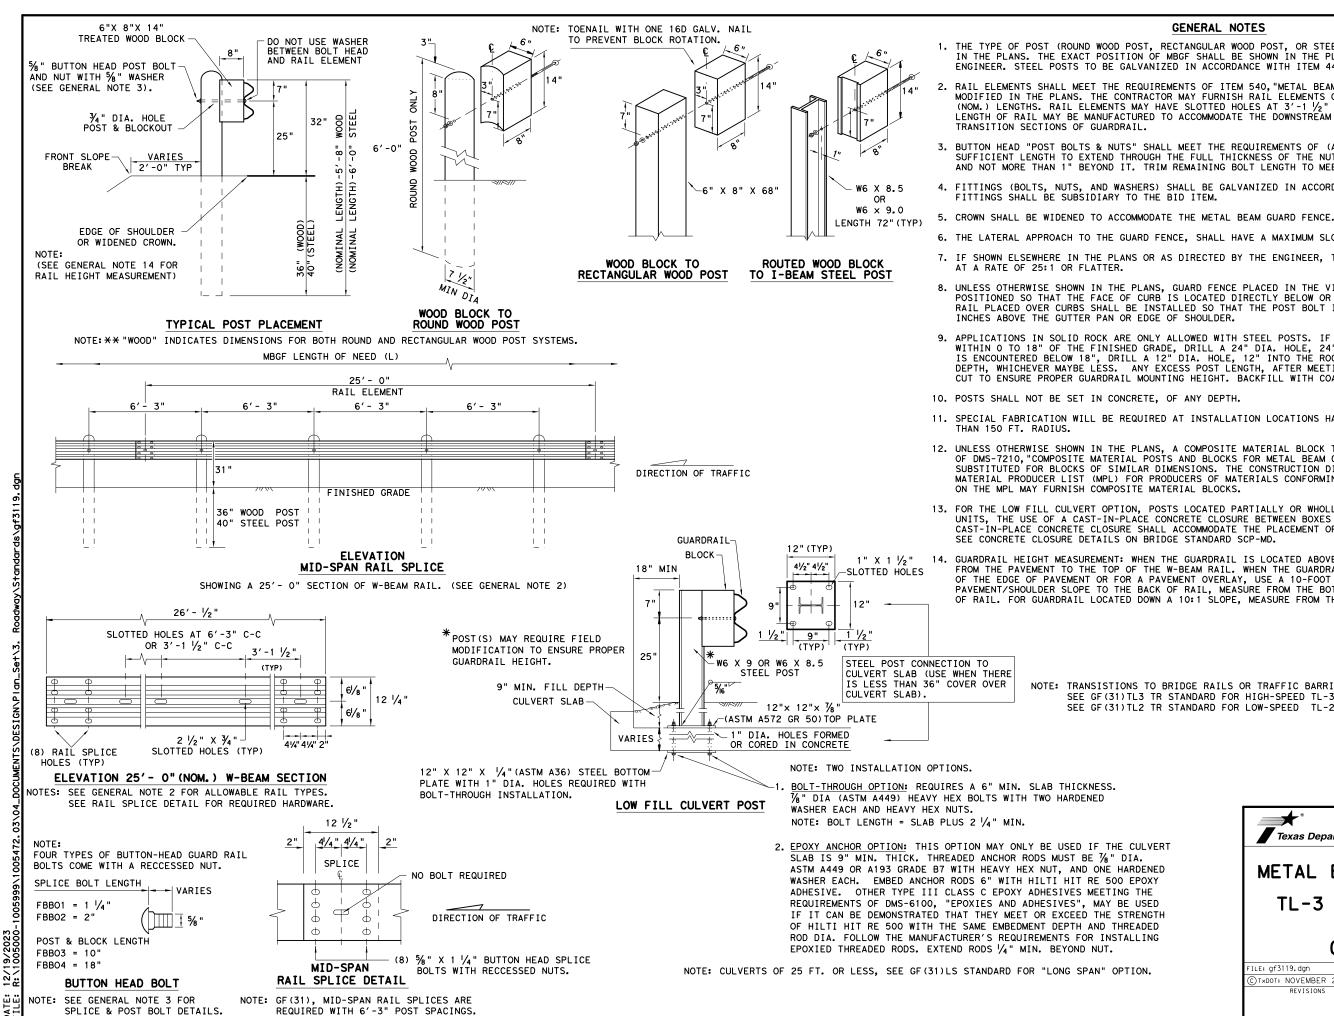

### GENERAL NOTES

1. THE TYPE OF POST (ROUND WOOD POST, RECTANGULAR WOOD POST, OR STEEL POST) WILL BE AS SHOWN IN THE PLANS. THE EXACT POSITION OF MBGF SHALL BE SHOWN IN THE PLANS OR AS DIRECTED BY THE ENGINEER. STEEL POSTS TO BE GALVANIZED IN ACCORDANCE WITH ITEM 445. "GALVANIZING.

RAIL ELEMENTS SHALL MEET THE REQUIREMENTS OF ITEM 540, "METAL BEAM GUARD FENCE" EXCEPT AS MODIFIED IN THE PLANS. THE CONTRACTOR MAY FURNISH RAIL ELEMENTS OF 25'- 0", OR 12'- 6" (NOM.) LENGTHS. RAIL ELEMENTS MAY HAVE SLOTTED HOLES AT  $3'-1 \frac{1}{2}$ " C-C OR 6'-3" C-C. A SPECIAL LENGTH OF RAIL MAY BE MANUFACTURED TO ACCOMMODATE THE DOWNSTREAM ANCHOR TERMINAL (DAT) AND THE

BUTTON HEAD "POST BOLTS & NUTS" SHALL MEET THE REQUIREMENTS OF (ASTM A307), AND SHALL BE OF SUFFICIENT LENGTH TO EXTEND THROUGH THE FULL THICKNESS OF THE NUT AND 5/4" WASHER (FWC16g) AND NOT MORE THAN 1" BEYOND IT. TRIM REMAINING BOLT LENGTH TO MEET REQUIRED LENGTH.

4. FITTINGS (BOLTS, NUTS, AND WASHERS) SHALL BE GALVANIZED IN ACCORDANCE WITH ITEM 445, "GALVANIZING. FITTINGS SHALL BE SUBSIDIARY TO THE BID ITEM.

6. THE LATERAL APPROACH TO THE GUARD FENCE, SHALL HAVE A MAXIMUM SLOPE OF 1V:10H.

7. IF SHOWN ELSEWHERE IN THE PLANS OR AS DIRECTED BY THE ENGINEER, THE GUARD FENCE MAY BE FLARED

8. UNLESS OTHERWISE SHOWN IN THE PLANS. GUARD FENCE PLACED IN THE VICINITY OF CURBS SHALL BE POSITIONED SO THAT THE FACE OF CURB IS LOCATED DIRECTLY BELOW OR BEHIND THE FACE OF THE RAIL. RAIL PLACED OVER CURBS SHALL BE INSTALLED SO THAT THE POST BOLT IS LOCATED APPROXIMATELY 25

9. APPLICATIONS IN SOLID ROCK ARE ONLY ALLOWED WITH STEEL POSTS. IF SOLID ROCK IS ENCOUNTERED WITHIN O TO 18" OF THE FINISHED GRADE, DRILL A 24" DIA. HOLE, 24" INTO THE ROCK. IF SOLID ROCK IS ENCOUNTERED BELOW 18", DRILL A 12" DIA. HOLE, 12" INTO THE ROCK OR TO THE STANDARD EMBEDMENT DEPTH, WHICHEVER MAYBE LESS. ANY EXCESS POST LENGTH, AFTER MEETING THESE DEPTHS, MAY BE FIELD CUT TO ENSURE PROPER GUARDRAIL MOUNTING HEIGHT. BACKFILL WITH COARSE AGGREGATE MATERIAL.

11. SPECIAL FABRICATION WILL BE REQUIRED AT INSTALLATION LOCATIONS HAVING A CURVATURE OF LESS


12. UNLESS OTHERWISE SHOWN IN THE PLANS, A COMPOSITE MATERIAL BLOCK THAT MEETS THE REQUIREMENTS OF DMS-7210, "COMPOSITE MATERIAL POSTS AND BLOCKS FOR METAL BEAM GUARD FENCE" MAY BE SUBSTITUTED FOR BLOCKS OF SIMILAR DIMENSIONS. THE CONSTRUCTION DIVISION, TXDOT MAINTAINS A MATERIAL PRODUCER LIST (MPL) FOR PRODUCERS OF MATERIALS CONFORMING TO DMS-7210 ONLY PRODUCERS

13. FOR THE LOW FILL CULVERT OPTION, POSTS LOCATED PARTIALLY OR WHOLLY BETWEEN PRECAST BOX CULVERT UNITS, THE USE OF A CAST-IN-PLACE CONCRETE CLOSURE BETWEEN BOXES IS REQUIRED. THE LENGTH OF THE CAST-IN-PLACE CONCRETE CLOSURE SHALL ACCOMMODATE THE PLACEMENT OF THE LOW FILL CULVERT OPTION.


14. GUARDRAIL HEIGHT MEASUREMENT: WHEN THE GUARDRAIL IS LOCATED ABOVE PAVEMENT, MEASURE THE HEIGHT S FROM THE PAVEMENT TO THE TOP OF THE W-BEAM RAIL. WHEN THE GUARDRAIL IS LOCATED UP TO 2 FT. OFF OF THE EDGE OF PAVEMENT OR FOR A PAVEMENT OVERLAY, USE A 10-FOOT STRAIGHTEDGE TO EXTEND THE PAVEMENT/SHOULDER SLOPE TO THE BACK OF RAIL, MEASURE FROM THE BOTTOM OF STRAIGHTEDGE TO THE TOP OF RAIL. FOR GUARDRAIL LOCATED DOWN A 10:1 SLOPE, MEASURE FROM THE NOMINAL TERRAIN.

> NOTE: TRANSISTIONS TO BRIDGE RAILS OR TRAFFIC BARRIERS. SEE GF (31) TL3 TR STANDARD FOR HIGH-SPEED TL-3 TRANSITIONS. SEE GF (31) TL2 TR STANDARD FOR LOW-SPEED TL-2 TRANSITIONS.



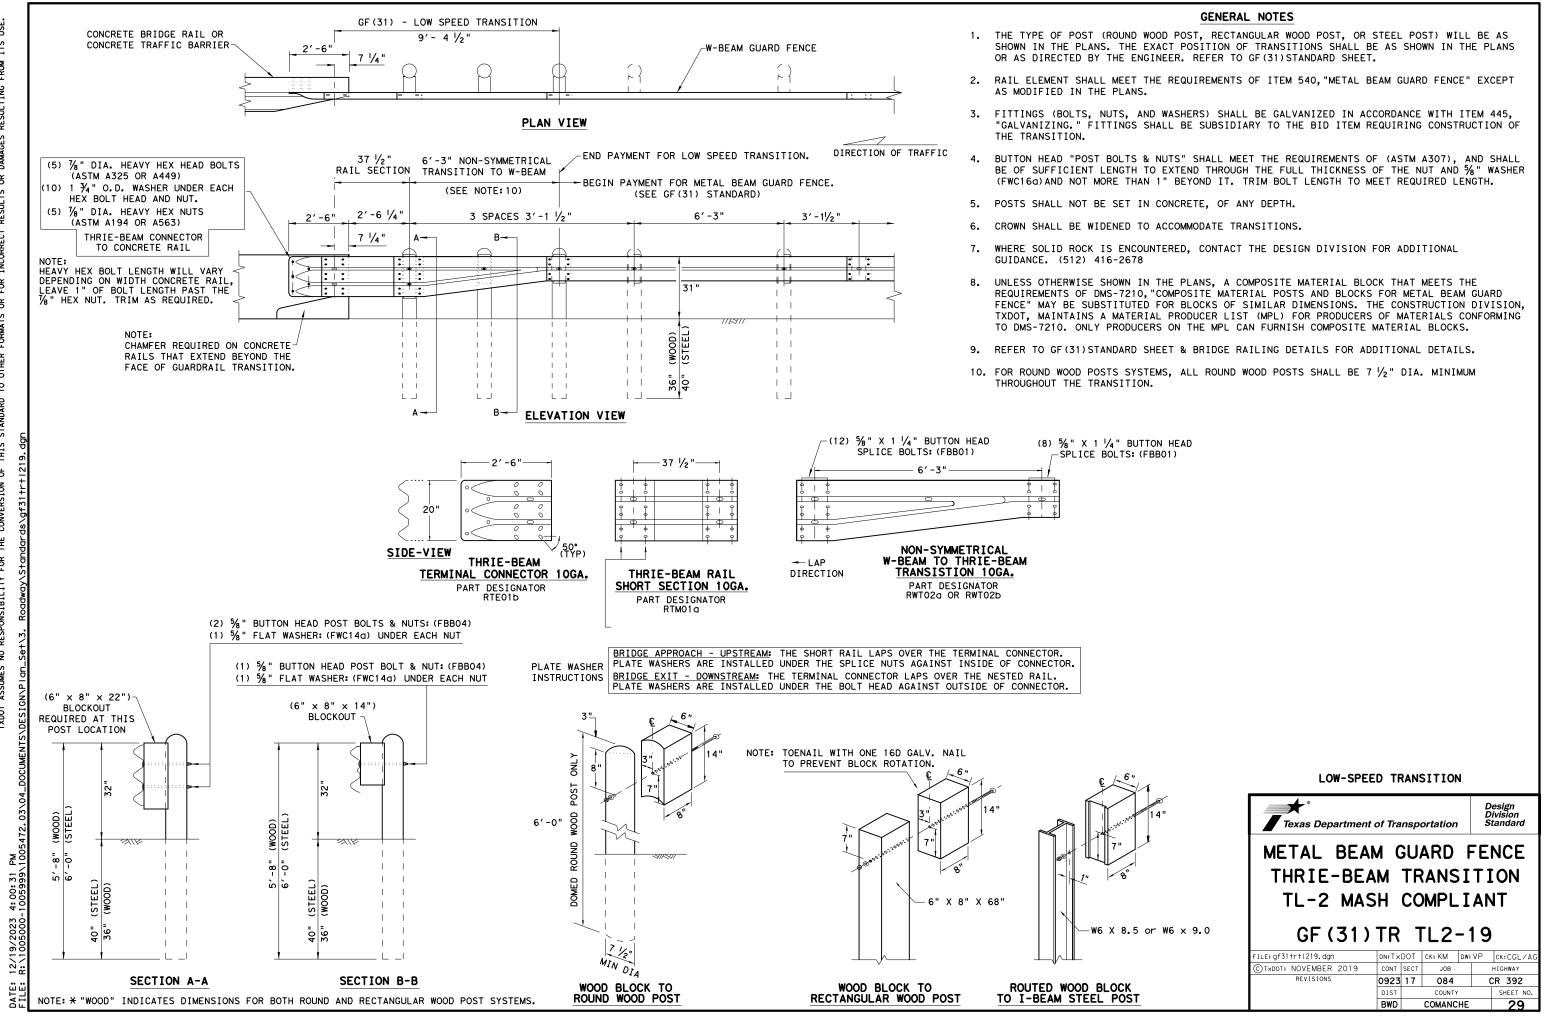


DISCLAIMER: THE USE OF THIS STANDARD IS GOVERNED BY TXDOT ASSUMES NO RESPONSIBILITY FOR THE

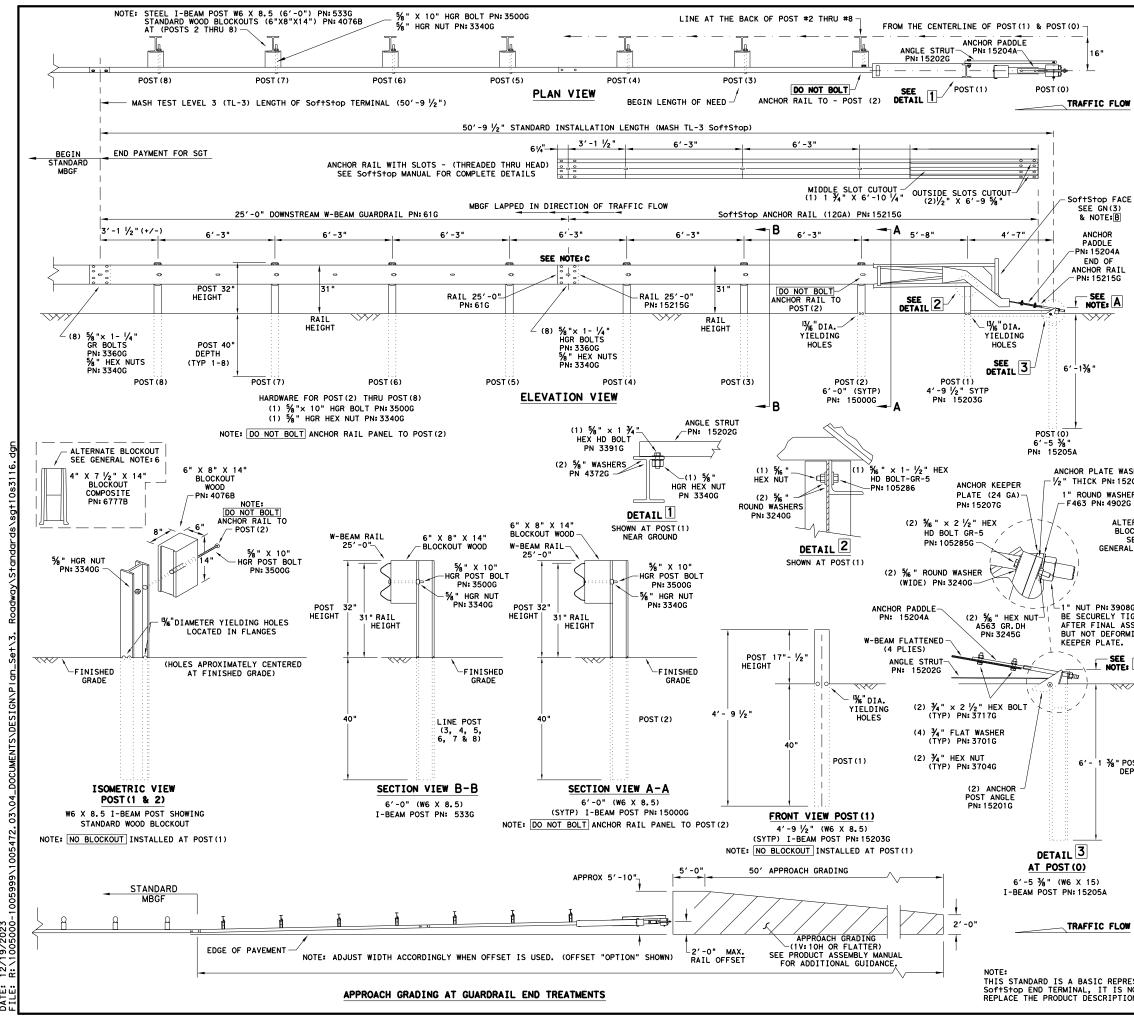

12/19/2023 B: \1005000 DATE:


			GENERAL NOTES					
1.	FOR SPECI OF THE SY 2525 N. S	FIC INF STEM, C TEMMONS	ORMATION REGARDING INSTALLATION AND TECHNIC/ DNTACT: TRINITY HIGHWAY AT 1(888)323-6374. FREEWAY, DALLAS, TX 75207	AL GUIDANCE				
			, REPAIR AND MAINTENANCE REFER TO THE; MINAL, PRODUCT DESCRIPTION ASSEMBLY MANUAL.	PN: 620237B				
	FRONT FAC	E OF TH	SITY REFLECTIVE SHEETING, "OBJECT MARKER" OF E DEVICE PER MANUFACTURER'S RECOMMENDATIONS. ALL CONFORM TO THE STANDARDS REQUIRED IN TEX					
			DUT) INSTALLATION AND GUIDANCE SEE TXDOT'S U P STANDARD.	ATEST				
5.	HARDWARE ITEM 445,	(BOLTS, "GALVAN	NUTS, & WASHERS) SHALL BE GALVANIZED IN AC( IZING". FITTINGS SHALL BE SUBSIDIARY TO THE	CORDANCE WITH BID ITEM.				
	A COMPOSITE MATERIAL BLOCKOUT THAT MEETS THE REQUIREMENTS OF DMS-7210, MAY BE SUBSTITUTED FOR BLOCKOUTS OF SIMILAR DIMENSIONS. SEE CONSTRUCTION DIVISION MATERIAL PRODUCER LIST (MPL) FOR CERTIFIED PRODUCERS.							
7. ACE	IF SOLID ROCK IS ENCOUNTERED SEE THE MANUFACTURER'S INSTALLATION MANUAL AND REFER TO THE LATEST ROADWAY MBGF STANDARD FOR INSTALLATION GUIDANCE.							
8.	POSTS SHA	LL NOT	BE SET IN CONCRETE.					
9.	IT IS ACC GRADE LIN	EPTABLE E OR WI	TO INSTALL THE SOFTSTOD IMPACT HEAD PARALLE TH AN UPWARD TILT.	EL TO THE				
10.	DO NOT AT	ТАСН ТН	E SoftStop SYSTEM DIRECTLY TO A RIGID BARRIE	R.				
11. II. I	UNDER NO BE CURVED	CIRCUMS	TANCES SHALL THE GUARDRAIL WITHIN THE SOF+S	OP SYSTEM				
12.	A FLARE R FROM ENCR ELIMINATE	ATE OF OACHING D FOR S	UP TO 25:1 MAY BE USED TO PREVENT THE TERMIN ON THE SHOULDER. THE FLARE MAY BE DECREASED PECIFIC INSTALLATIONS, IF DIRECTED BY THE ED	NAL HEAD ) OR NGINEER.				
			TALLATION HEIGHT OF FULLY ASSEMBLED ANCHOR F OM 3- $34$ " MIN. TO 4" MAX. ABOVE FINISHED GRAD					
			5852B RIGHT-SIDE (HIGH INTENSITY REFLECTIVE					
	-		5851B LEFT-SIDE (HIGH INTENSITY REFLECTIVE SPLICE LOCATED BETWEEN LINE POST(4)AND LINE					
			IL PANEL 25'-0" PN: 61G					
	I 1		RAIL 25′-O" PN:15215G RDRAIL IN DIRECTION OF TRAFFIC FLOW.					
			MAIN SYSTEM COMPONENTS					
	PART 6202378		MAIN SYSTEM COMPONENTS PRODUCT DESCRIPTION ASSEMBLY MANUAL (LATE:	ST REV )				
	15208A	1	SoftStop HEAD (SEE MANUAL FOR RIGHT-LEFT					
	15215G	1	SoftStop ANCHOR RAIL (12GA) WITH CUTOUT					
WASHER 15206G	61G 15205A	1	SoftStop DOWNSTREAM W-BEAM RAIL (12GA) (2 POST #0 - ANCHOR POST (6'- 5 7/8")	25'- 0")				
SHER	15203A	1	POST #1 - (SYTP) $(4' - 9 \frac{1}{2}')$					
D2G	15000G	1	POST #2 - (SYTP) (6'- 0")					
LTERNATE /	533G	6	POST #3 THRU #8 - I-BEAM (W6 x 8.5) (6'- (	)")				
ilockout $<$	4076B	7	BLOCKOUT - WOOD (ROUTED) (6" x 8" x 14") BLOCKOUT - COMPOSITE (4" x 7 $\frac{1}{2}$ " x 14")					
SEE RAL NOTE:6	15204A	1	ANCHOR PADDLE					
	152076	1	ANCHOR KEEPER PLATE (24 GA)					
	15206G 15201G	1	ANCHOR PLATE WASHER ( 1/2" THICK ) ANCHOR POST ANGLE (10" LONG)					
	15202G	1	ANGLE STRUT					
08G SHALL			HARDWARE					
TIGHTENED ASSEMBLY.	4902G	1	1" ROUND WASHER F436					
RMING THE	3908G	1	1" HEAVY HEX NUT A563 GR.DH					
•	37176	2	$\frac{3}{4}$ " x 2 $\frac{1}{2}$ " HEX BOLT A325					
	3701G 3704G	4	¾" ROUND WASHER F436¾" HEAVY HEX NUT A563 GR.DH					
	3360G	16	5/8" × 1 1/4" W-BEAM RAIL SPLICE BOLTS HGR					
~~~	3340G	25	% W-BEAM RAIL SPLICE NUTS HGR % x 10" HGR POST BOLT A307					
	3500G 3391G	7	$\frac{7}{8}$ × 10 <sup></sup> HGR POST BOLT A307 $\frac{5}{8}$ × 1 $\frac{3}{4}$ HEX HD BOLT A325					
	4489G	1	5/8" × 9" HEX HD BOLT A325					
	43726	4	%" WASHER F436					
	105285G 105286G	2	%6 " × 2 ½ " HEX HD BOLT GR-5 %6 " × 1 ½ " HEX HD BOLT GR-5					
POST DEPTH	32400	6	5/6 " ROUND WASHER (WIDE)					
(II	3245G	3	% " HEX NUT A563 GR.DH					
	5852B		HIGH INTENSITY REFLECTIVE SHEETING - SEE I					
			Texas Department of Transportation	Design Division Standard				
			TRINITY HIGHWAY	(				
			SOFTSTOP END TERM					
			MASH - TL-3					
.OW			SGT (10S) 31-16					
				/D				
			LE: SG#10S3116 DN: TXDOT CK: KM DW: DTXDOT: JULY 2016 CONT SECT JOB	/P CK: MB/VP HIGHWAY				
PRESENTATI			REVISIONS 0923 17 084	CR 392				
S NOT INTE TION ASSEM		L.	DIST COUNTY	SHEET NO.				
			BWD COMANCHE	30				

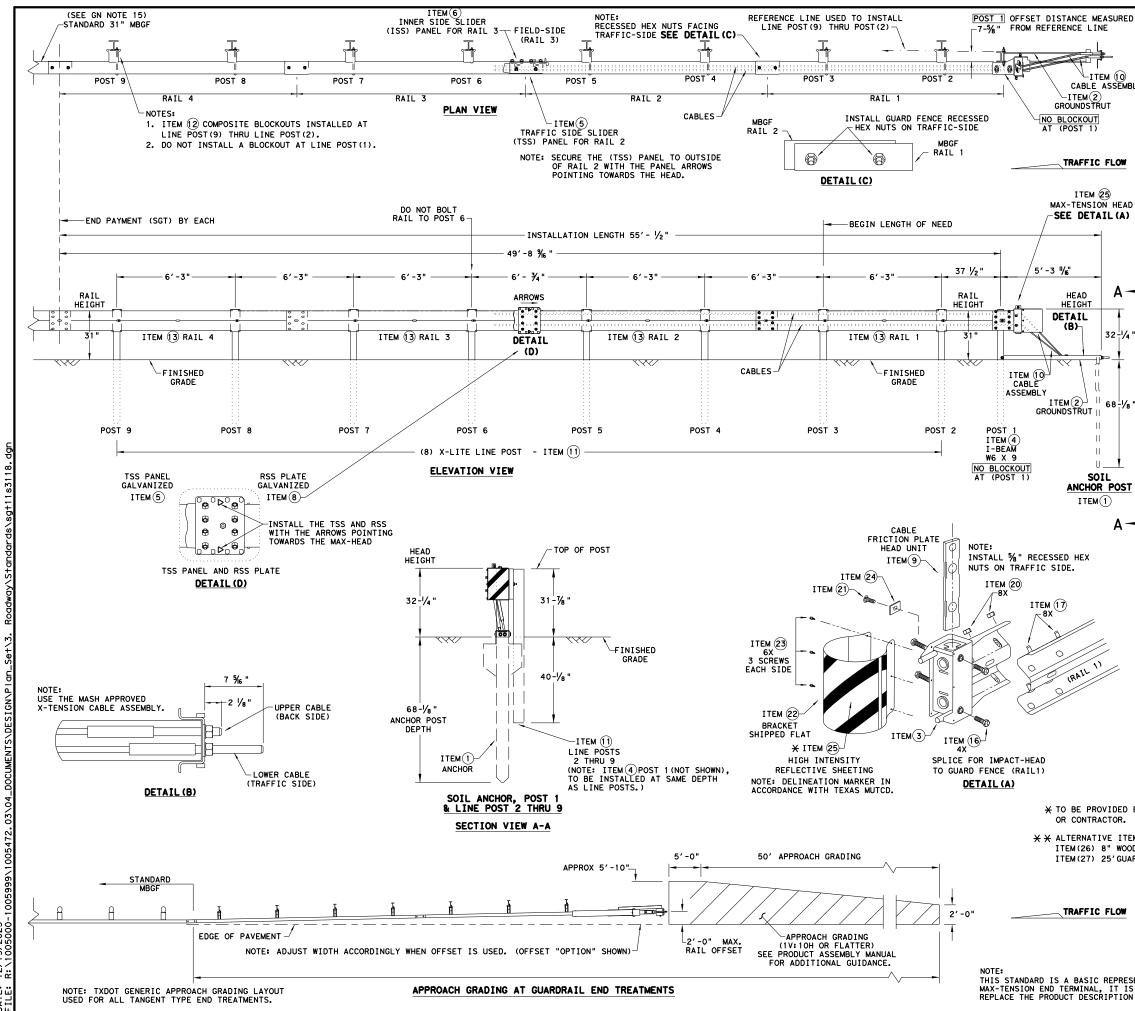

DISCLAIMER: The use of this standard is governed by the "Texas Engineering Practice Act". No warranty of any kind is made by TXDOT for any purpose whatsoever. TXDOT assumes no responsibility for the conversion of this standard to other formats or for incorrect results or damages resulting from its use.

of this standard DATE: 12/19/2023 FILE: R:\1005000-1005990\1005472\_03\04\_DOCUMENTS\DESIGN\Plan\_Sat\3\_ Roadway\Standards\sat

URED					GENERAL NOTES				
	1.	FOR SPEC GUIDANCE (LTS) - B	IFIC IN OF TH ARRIER	NFORMATION E SYSTEM, SYSTEMS,	CONTACT: LINDSAY TRANSPORTATION S CONTACT: LINDSAY TRANSPORTATION S INC. AT (707) 374-6800	CAL OLUTION	NS		
0		FOR INST INSTALLA	ALLATIO TION I	ON, REPAIF NSTRUCTIO	R, & MAINTENANCE REFER TO THE; MAX N MANUAL. P/N MANMAX REV D (ECN 35	-TENSIC	N		
SEMBLY	3.	APPLY HI FRONT FA MARKER S	GH INTI CE OF HALL C	ENSITY REF THE DEVIC ONFORM TO	FLECTIVE SHEETING, "OBJECT MARKER" E PER MANUFACTURE'S RECOMMENDATION THE STANDARDS REQUIRED IN TEXAS M	ON THE S. OBJE UTCD.	ECT		
	4.			E-OUT) INS RIP STAND	STALLATION AND GUIDANCE SEE TXDOT'S ARD.	S LATES	бт		
LOW	5.			ONENTS ARE SE STATED	E GALVANIZED PER ASTM A123 OR EQUIN	/ALENT			
					WIDE FLANGE POST WITH COMPOSITE (				
HEAD . <b>(A)</b>	<ol> <li>COMPOSITE MATERIAL BLOCKOUT THAT MEETS THE REQUIREMENTS OF DMS-7210, MAY BE SUBSTITUTED FOR BLOCKOUTS SIMILAR DIMENSIONS. SEE CONSTRUCTION DIVISION MATERIAL PRODUCER LIST (MPL)FOR CERTIFIED PRODUCERS.</li> <li>REFER TO INSTALLATION MANUAL FOR SPECIFIC PANEL LAPPING GUIDANCE.</li> </ol>								
					ANUAL FOR SPECIFIC PANEL LAPPING GU TERED SEE THE MANUFACTURER'S INSTAU				
		MANUAL F	OR INS	TALLATION	GUIDANCE. IN CONCRETE.				
		A DRIVI	NG CAP	WITH A TI	IMBER OR PLASTIC INSERT SHALL BE US				
A –	12				T DAMAGE TO THE GALVANIZING ON TOP .L NEVER BE INSTALLED WITHIN A CUR\				
		OF GUAR	DRAIL.		R IS REQUIRED. MARKER SHALL BE IN A				
2-1/4 "	13.	WITH TE	XAS MU	TCD.	·				
<b>†</b>	14.	ARE ALS			TH 12'-6" MBGF PANELS, 25'-0" MBGF	PANELS	,		
	15.			12'-6" OF NSION SYS	12GA. MBGF IS REQUIRED IMMEDIATELY TEM.	OOWNS	TREAM		
8-1/8"					1				
		ITEM#		NUMBER	DESCRIPTION SOIL ANCHOR - GALVANIZED		QTY 1		
		2		510061-00	GROUND STRUT - GALVANIZED		1		
1		3		610062-00	MAX-TENSION IMPACT HEAD		1		
		4	BSI-16	610063-00	W6×9 I-BEAM POST 6FTGALVANIZED		1		
POST		5	BSI-16	510064-00	TSS PANEL - TRAFFIC SIDE SLIDER		1		
		6	-	510065-00	ISS PANEL - INNER SIDE SLIDER		1		
							1		
Δ		7		510066-00	TOOTH - GEOMET RSS PLATE - REAR SIDE SLIDER				
••				510067-00					
		9	B06105		CABLE FRICTION PLATE - HEAD UNIT		1		
		10	BSI-16	510069-00	CABLE ASSEMBLY - MASH X-TENSION		2		
		11	BSI-10	012078-00	X-LITE LINE POST-GALVANIZED		8		
		12	B09053	34	8" W-BEAM COMPOSITE-BLOCKOUT XT110		8		
		13	BSI-40	004386	12'-6" W-BEAM GUARD FENCE PANELS 12	2GA.	4		
		14	BSI-11	02027-00	X-LITE SQUARE WASHER		1		
		15	BSI-20		5/8" X 7" THREAD BOLT HH (GR. 5) GEOME	ET	1		
		16	BSI-20		3/4" X 3" ALL-THREAD BOLT HH (GR.5)		4		
					,,				
		17	400111		5/8" X 1 1/4" GUARD FENCE BOLTS (GR. 2	MGAL	48		
		18	200184		% X 10" GUARD FENCE BOLTS MGAL		8		
/		19	200163		% WASHER F436 STRUCTURAL MGAL		2		
		20	400111	6	5% RECESSED GUARD FENCE NUT (GR.2)		59		
		21	BSI-20	001888	5%8" X 2" ALL THREAD BOLT (GR.5)GEOM	иет	1		
		22	BSI-17	701063-00	DELINEATION MOUNTING (BRACKET)		1		
		23	BSI-20	001887	1/4" X 3/4" SCREW SD HH 410SS		7		
		24	400205	51	GUARDRAIL WASHER RECT AASHTO FWR03		1		
	×	25	SEE NO	TE BELOW	HIGH INTENSITY REFLECTIVE SHEETING		1		
ι.	2.~	26	400233	57	8" W-BEAM TIMBER-BLOCKOUT, PDB01B		8		
*	÷×	27	BSI-40	04431	25' W-BEAM GUARDRAIL PANEL,8-SPACE	,12GA.	2		
		28	MANMAX	(Rev-(D)	MAX-TENSION INSTALLATION INSTRUCTI	ONS	1		
DED BY	יח י	STRIBUTOR	,			Desi	ign T		
OR.	51		•		•	Divis	sion		
				Ter	xas Department of Transportation	Stan	dard		
		T SHOWN.							
		CKOUTS NCE PANEL	<u>د</u>						
JOARD	- F E	NOL FANEL		ΜΔΧ	-TENSION END TER	MIN			
					MASH - TL-3				
					$WAJH = IL^{-}J$				
LOW									
					SGT (11S) 31-18				
				FILE: sg+	11s3118.dgn DN:TxDOT CK:KM DW:	: T×DOT	ск: CL		
				-	FEBRUARY 2018 CONT SECT JOB		HWAY		
		ION OF TH		>	REVISIONS 0923 17 084		392		
		INTENDED			DIST COUNTY	· · · ·	HEET NO.		
TION A	133E	MBLY MANU	ML.			-+	<b>31</b>		
					BWD COMANCHE		JI		

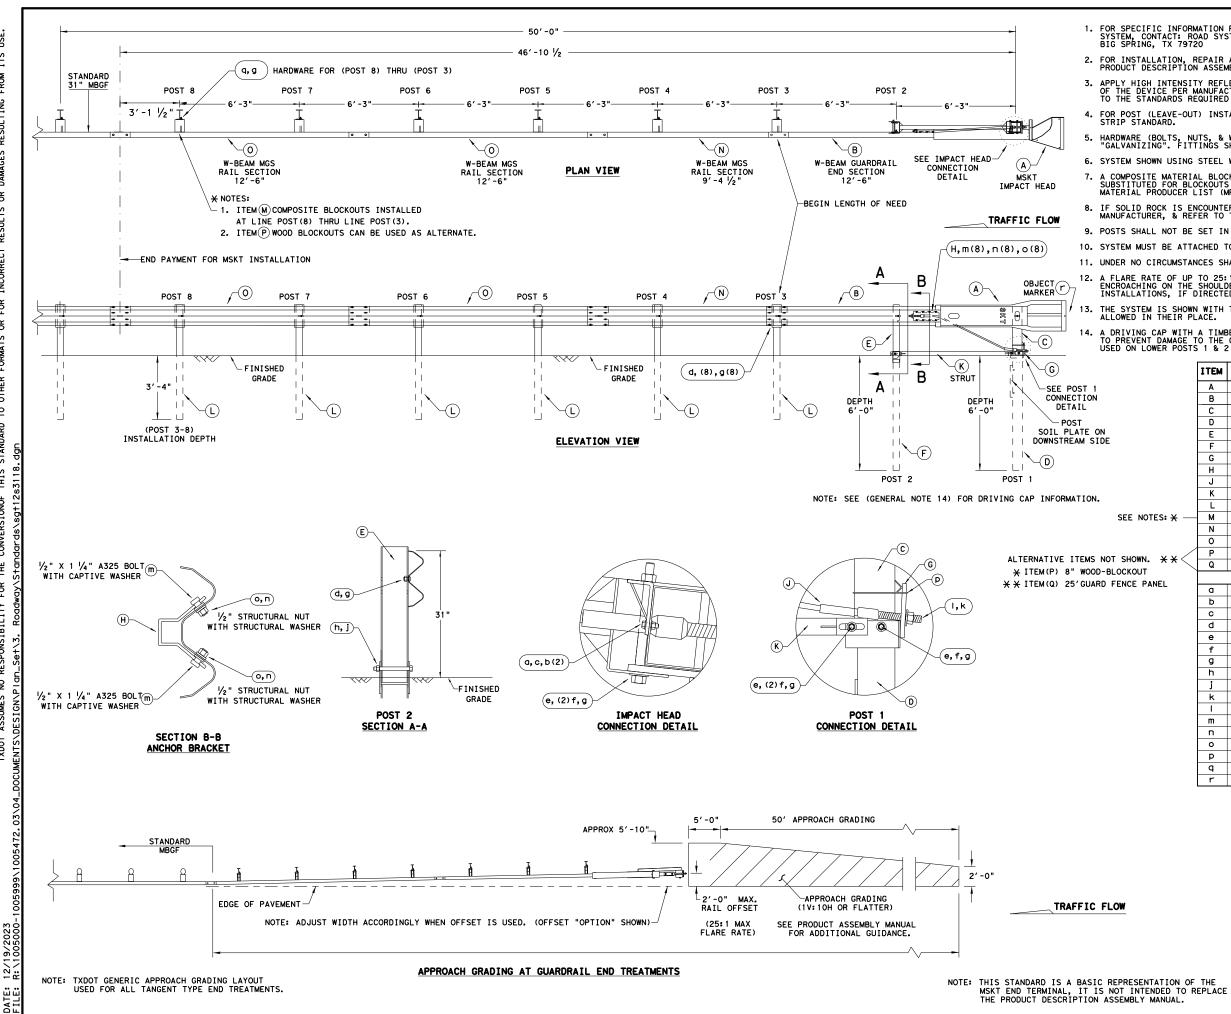

### GENERAL NOTES

1. FOR SPECIFIC INFORMATION REGARDING INSTALLATION AND TECHNICAL GUIDANCE OF THE SYSTEM, CONTACT: ROAD SYSTEMS, INC. (432)263-2435. 3616 OLD HOWARD COUNTY AIRPORT, BIG SPRING, TX 79720

FOR INSTALLATION, REPAIR AND MAINTENANCE REFER TO THE: MSKT END TERMINAL, PRODUCT DESCRIPTION ASSEMBLY MANUAL (PUBLICATION~062717).

3. APPLY HIGH INTENSITY REFLECTIVE SHEETING, "OBJECT MARKER" ON THE FRONT FACE OF THE DEVICE PER MANUFACTURER'S RECOMMENDATIONS. OBJECT MARKER SHALL CONFORM TO THE STANDARDS REQUIRED IN TEXAS MUTCD.

FOR POST (LEAVE-OUT) INSTALLATION AND GUIDANCE SEE TXDOT'S LATEST ROADWAY MOW STRIP STANDARD.

5. HARDWARE (BOLTS, NUTS, & WASHERS) SHALL BE GALVANIZED IN ACCORDANCE WITH ITEM 445, "GALVANIZING". FITTINGS SHALL BE SUBSIDIARY TO THE BID ITEM. 6. SYSTEM SHOWN USING STEEL WIDE FLANGE POSTS WITH COMPOSITE BLOCKOUTS.

7. A COMPOSITE MATERIAL BLOCKOUTS THAT MEETS THE REQUIREMENTS OF DMS-7210, MAY BE SUBSTITUTED FOR BLOCKOUTS OF SIMILAR DIMENSIONS. SEE CONSTRUCTION DIVISION MATERIAL PRODUCER LIST (MPL) FOR CERTIFIED PRODUCERS.

8. IF SOLID ROCK IS ENCOUNTERED IN THE AREA OF (POST 1) AND / OR (POST 2) CONTACT THE MANUFACTURER, & REFER TO THE LATEST ROADWAY MBGF STANDARD FOR INSTALLATION GUIDANCE 9. POSTS SHALL NOT BE SET IN CONCRETE.

10. SYSTEM MUST BE ATTACHED TO STANDARD 31" MBGF.

11. UNDER NO CIRCUMSTANCES SHALL THE GUARDRAIL WITHIN THE MSKT SYSTEM BE CURVED.

12. A FLARE RATE OF UP TO 25:1 MAY BE USED TO PREVENT THE TERMINAL HEAD FROM ENCROACHING ON THE SHOULDER. THE FLARE MAY BE DECREASED OR ELIMINATED FOR SPECIFIC INSTALLATIONS, IF DIRECTED BY THE ENGINEER.


13. THE SYSTEM IS SHOWN WITH TWO 12'-6" MBGF PANELS, ONE 25'-0" MBGF PANEL IS ALSO ALLOWED IN THEIR PLACE.

A DRIVING CAP WITH A TIMBER OR PLASTIC INSERT SHALL BE USED WHEN DRIVING POSTS 3-8 TO PREVENT DAMAGE TO THE GALVANIZING ON TOP OF THE POST. SPECIAL DRIVING CAP TO BE USED ON LOWER POSTS 1 & 2 TO PREVENT DAMAGE TO THE WELDED PLATES.

	ITEM	QTY	MAIN SYSTEM COMPONENTS	ITEM NUMBERS				
	Α	1	MSKT IMPACT HEAD	MS3000				
	В	1	W-BEAM GUARDRAIL END SECTION, 12 Ga.	SF1303				
	С	1	POST 1 - TOP (6" X 6" X 1/8" TUBE)	MTPHP1A				
	D	1	POST 1 - BOTTOM (6' W6X15)	MTPHP1B				
	E	1	POST 2 - ASSEMBLY TOP	UHP2A				
	F	1	POST 2 - ASSEMBLY BOTTOM (6' W6X9)	HP2B				
	G	1	BEARING PLATE	E750				
	н	1	CABLE ANCHOR BOX	S760				
	J	1	BCT CABLE ANCHOR ASSEMBLY	E770				
	К	1	GROUND STRUT	MS785				
	L	6	W6x9 OR W6x8.5 STEEL POST	P621				
e notes: 🗙 —	м	6	COMPOSITE BLOCKOUTS	CBSP-14				
	N	1	W-BEAM MGS RAIL SECTION (9'-4 1/2")	G12025				
	0	2	W-BEAM MGS RAIL SECTION (12'-6")	G1203A				
	Р	6	WOOD BLOCKOUT 6" X 8" X 14"	P675				
$10$ WN. $\times$ $\times$ $<$	Q	1	W-BEAM MGS RAIL SECTION (25'-0")	G1209				
OUT		SMALL HARDWARE						
E PANEL	a	2	5/6 " × 1 " HEX BOLT (GRD 5)	B5160104A				
	b	4	5/6 " WASHER	W0516				
	с	2	% " HEX NUT	N0516				
	d	25	5/8" Dia. x 1 1/4" SPLICE BOLT (POST 2)	B580122				
	е	2	5% " Dia. × 9" HEX BOLT (GRD A449)	B580904A				
	f	3	5% " WASHER	W050				
	g	33	‰" Dia. H.G.R NUT	N050				
	h	1	3/4" Dia. × 8 1/2" HEX BOLT (GRD A449)	B340854A				
	j	1	¾" Dia. HEX NUT	N030				
	k	2	1 ANCHOR CABLE HEX NUT	N100				
	1	2	1 ANCHOR CABLE WASHER	W100				
	m	8	1/2" × 1 1/4" A325 BOLT WITH CAPTIVE WASHER	SB12A				
	n	8	1/2" STRUCTURAL NUTS	N012A				
	0	8	1 1/16 " O.D. × 96 " I.D. STRUCTURAL WASHERS	W012A				
	P	1	BEARING PLATE RETAINER TIE	CT-100ST				
	q	6	5%8" × 10" H.G.R. BOLT	B581002				
	r	1	OBJECT MARKER 18" X 18"	E3151				
		_						
			Toxas Department of Transportation	Design Division Standard				

Texas Department of Transportation Standard SINGLE GUARDRAIL TERMINAL MSKT-MASH-TL-3 SGT (12S) 31-18

	BWD	COMANCHE			70	
	DIST	COUNTY SHEE			SHEET NO.	
REVISIONS	0923	17	084		CR 392	
C) TxDOT: APRIL 2018	CONT	SECT	JOB		HIGHWAY	
FILE: sg+12s3118.dgn	DN: T>	DOT	ск:км	DW	:VP	CK:CL

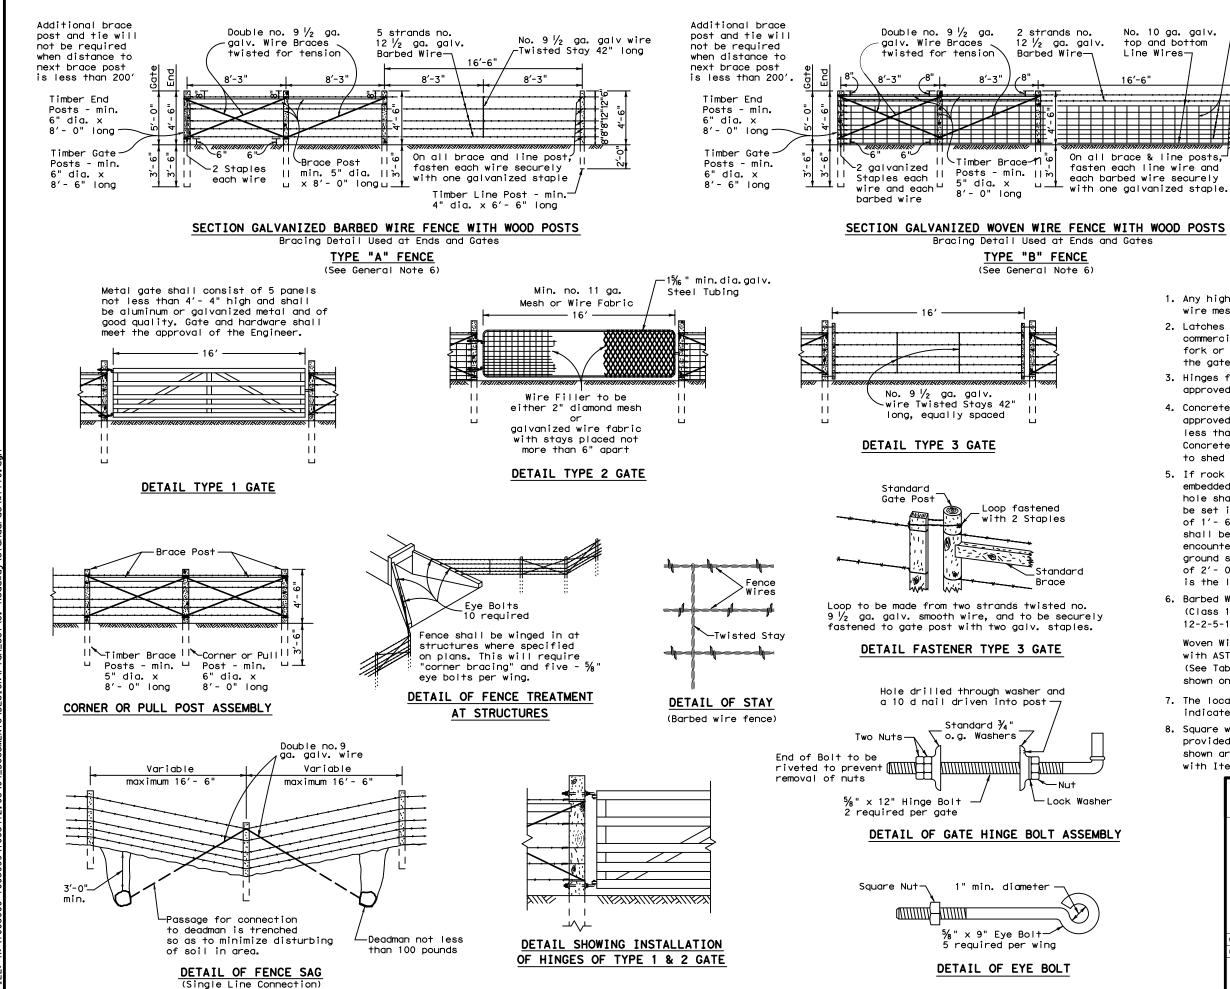

tat i+s for any purpose s resulting from TxDOT Ğρ is made results any kind incorrect anty of or for 1 ats Por Lo Engineering Practice Act". of this standard to other "Texas [ the cov rned by for the this standard is gove tes no responsibility DISCLAIMER: The use of TxDOT assum

12/19/2023

No. 10 ga. galv. top and bottom Line Wires-

No. 12 1/2 ga. galv. -Line Wires and Vertical Stays

Ш

Timber Line Post - min. 4" dia. x 6'- 6" long

### TABLE OF EQUIVALENT SIZES FOR OPTIONAL SHAPE

Minimum Diameter of Round Post (Inches)	Minimum Equivalent Dimension for Each Side of Square Post (Inches)
4	3 1/2
5	4 1/2
6	5 1⁄4


# GENERAL NOTES

- 1. Any high point which interferes with the placing of wire mesh shall be excavated to provide 2" clearance.
- 2. Latches for Type 1 and Type 2 gates shall be good commercial quality and design latches of the spring, fork or chain type. All latches shall be suitable for the gate and shall be approved by the Engineer.
- 3. Hinges for Type 2 gates shall be commercial design approved by the Engineer suitable for post and gate.
- 4. Concrete shall be of the design and consistency approved by the Engineer and shall contain not less than 4 sacks of cement per cubic yard. Concrete footings are to be crowned at the top to shed water.
- 5. If rock is encountered at a depth less than the embedded depth required, a 15" or larger diameter hole shall be drilled for the post and the post shall be set in concrete. If rock is encountered at a depth of 1'- 6" or more below the ground surface, the hole shall be drilled to the required depth. If rock is encountered at a depth less than 1'- 6" below the ground surface, the holes shall be drilled a minimum of 2'- 0" into the rock or to the depth whichever is the lesser depth.
- 6. Barbed Wire shall be in accordance with ASTM A 121 (Class 1) Design designation 12-2-4-1 4R or 12-2-5-1 4R, or as approved by the Engineer.

Woven Wire Fence (Type B) shall be in accordance with ASTM A 116 (Class 1) No. 12-1/2 Grade 60 (See Table 1 ASTM A 116) to the height and design shown on the plans, or as approved by the Engineer.

- 7. The location of gates and corner posts will be as indicated elsewhere on these plans.
- 8. Square wood posts may be used in lieu of round posts provided minimum equivalent size requirements, as shown are met. All wood posts shall be in accordance with Item 552, "Wire Fence."


	Texas Departm	ent of Trans	portatior		Design Division Standard			
BARBED WIRE AND WOVEN WIRE FENCE (WOOD POSTS)								
	-							
	-	/F (1)						
FILE:	-			Dw: VP	CK:			
FILE:	wf110.dgn	/F (1) ·	-10	DW: VP	CK: HIGHWAY			
	wf110.dgn	/F (1) •	-10 ск: АМ ст јов	Dw: VP				
	wf110.dgn DT 1994	<b>/F (1)</b> • DN: TXDOT CONT SEC	-10 ск: АМ ст јов		HIGHWAY			

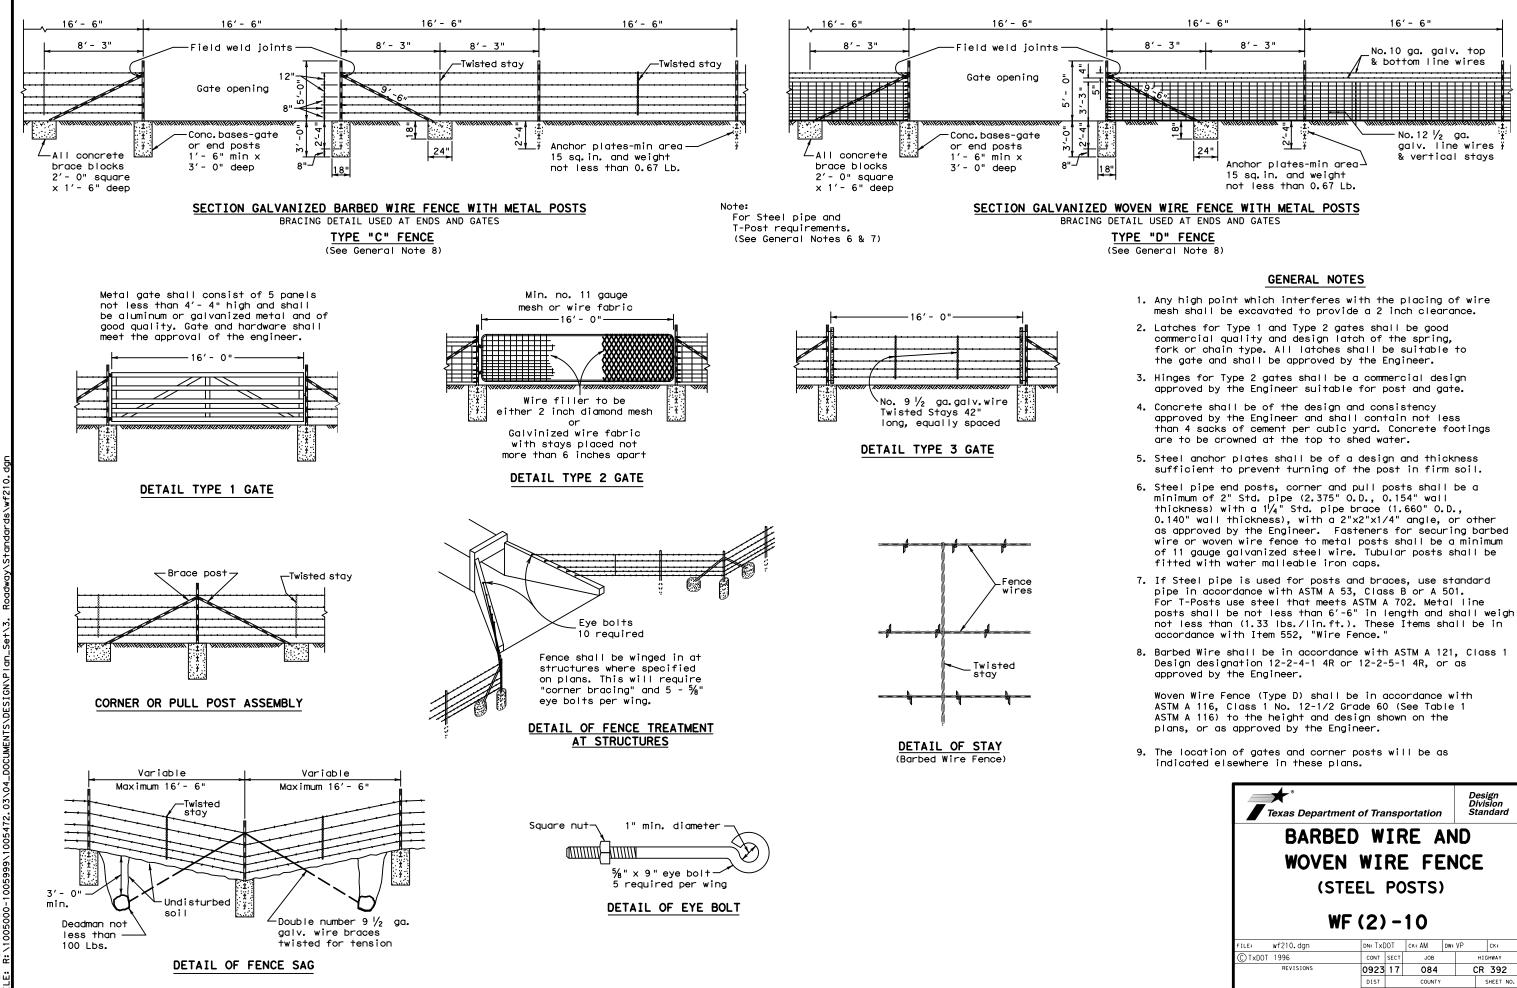

oeve use. what: 1 its for any purpose is resulting from TxDOT ያዖ is made results any kind incorrect anty of or for i warr 1ats P P P Engineering Practice Act". of this standard to other "Texas f the cov this standard is governed by mes no responsibility for the DISCLAIMER: The use of t TXDOT assume

> 12/19/2023 P:\1005000 DATE:

	Texas Departm	ent of Transp	oortation	Design Division Standard			
	BARBI	ED WI	RE A	ND			
	WOVE	N WIR	E FE	INCE			
(STEEL POSTS)							
	()	IEEL FV	,3,3,				
		IF (2) -					
FILE:			10	рж: VP ск:			
	W	IF (2) -	10				
	wf210.dgn	<b>/F (2) –</b>	<b>10</b>	DW: VP CK:			
	wf210.dgn DT 1996	IF (2) -	<b>10</b> ск: АМ јов	DW: VP CK: HIGHWAY			

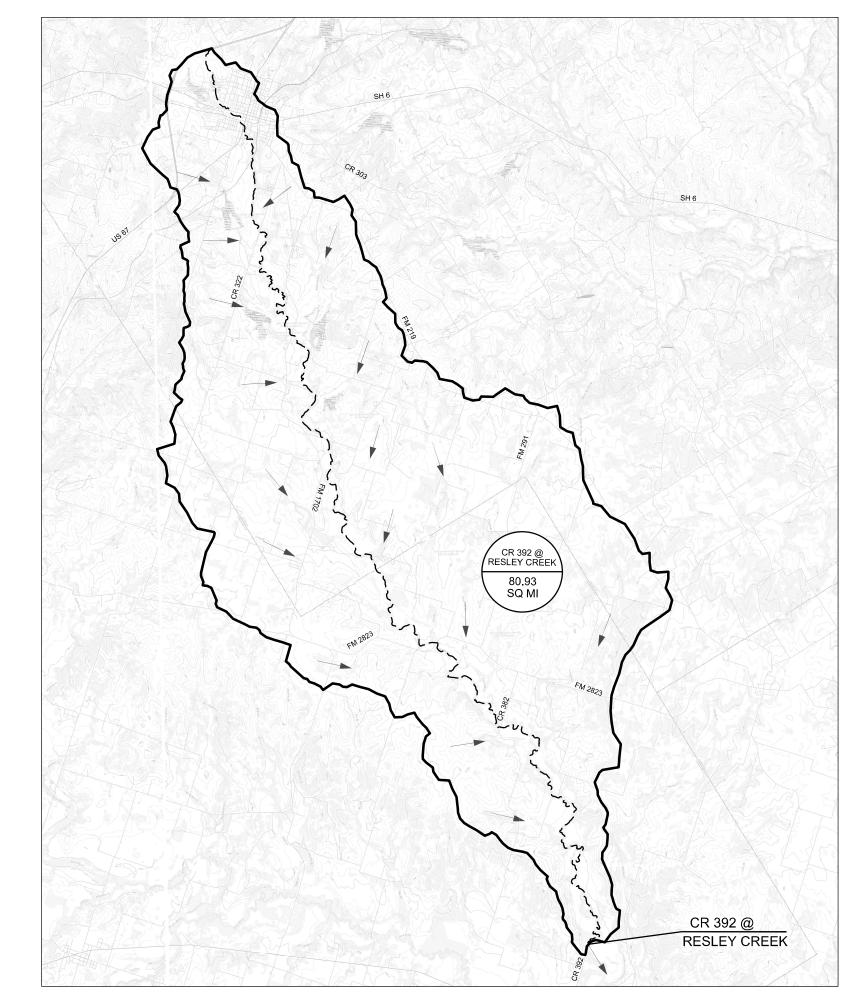

AREA = 80.93 SQ MI MEAN ANNUAL PRECIPITATION = 31 IN SLOPE = 0.0033 FT/FT OMEGA = -0.106

	OMEGA	EM REGRE	SSION COEF	FICIENTS		
RETURN INTERVAL	2-YR	5-YR	10-YR	25-YR	50-YR	100-YR
AEP (PERCENT)	50%	20%	10%	4%	2%	1%
PROBABILITY	P = 0.5	P = 0.2	P = 0.1	P = 0.04	P = 0.02	P = 0.01
а	50.98	16.62	13.62	11.79	11.17	10.82
b	-50.3	-15.32	-11.97	-9.819	-8.997	-8.448
с	1.398	1.308	1.203	1.14	1.105	1.071
d	0.27	0.372	0.403	0.446	0.476	0.507
е	0.776	0.885	0.918	0.945	0.961	0.969
LAMBDA	-0.0058	-0.0215	-0.0289	-0.0374	-0.0424	-0.0467
	ESTIN		DISCHARG	ES, CFS		
QT =	1893	4102	5920	8915	11613	14902

# LEGEND


DRAINAGE AREA ID

- AREA (AC) — DRAINAGE FLOW DIRECTION
- DRAINAGE DIVIDE
- — LONGEST FLOW PATH



### NOTES:

- 1. TOPOGRAPHIC CONTOUR FROM USGS 1-METER DEM (2016 BRAZOS RIVER BASIN LIDAR) AND USGS OUADRANGLE MAPS: COMYN, TX, 2022 DUBLIN, TX, 2022 ALEXANDER, TX, 2022 PROCTOR, TX, 2022 EDNA HILL, TX, 2022 CARLTON, TX, 2022 LAMKIN, TX, 2022 GENTRY MILL, TX, 2022
- 2. FLOWS COMPUTED USING OMEGA EM REGRESSION EQUATIONS AS PRESENTED IN TXDOT HYDRAULIC DESIGN MANUAL, CH 4, SEC 10.
- 3. DESIGN STORM FREQUENCY IS THE 10-YR STORM AND THE CHECK STORM FREQUENCY IS THE 100-YR STORM.
- ALL CALCULATIONS IN ACCORDANCE WITH TxDOT HYDRAULIC DESIGN MANUAL, SEPT 2019.

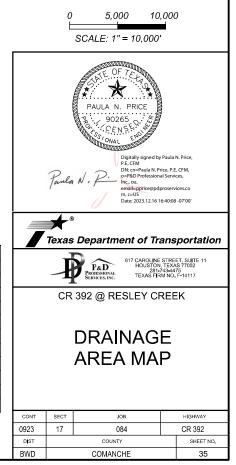

PA 05 3.23 Proi 12/16/2 7-\02 E

DATE

REACH					HEC-RAS	RIVER: RE	SLEY CREEK	REACH: C	R 392				
	RIVER		DIAN	Q TOTAL	MIN CH EL	W.S. ELEV	CRIT W.S.	E.G. ELEV	E.G. SLOPE	VEL CHNL	FLOW AREA	TOP WIDTH	FROU
REACH	STA	PROFILE	PLAN	(CFS)	(FT)	(FT)	(FT)	(FT)	(FT/FT)	(FT/S)	(SQ FT)	(FT)	CH
CR 392	8551.9	10-yr	Exist	5920	1059.35	1075.46		1075.85	0.001258	5.8	2140.59	1361	0.2
CR 392	8551.9	10-yr	Prop 11-30	5920	1059.35	1075.46		1075.85	0.001257	5.8	2142.25	1362.83	0.2
CR 392	8551.9	100-yr	Exist	14902	1059.35	1077.58		1077.84	0.001228	6.21	5797.21	1936	0.2
CR 392	8551.9	100-yr	Prop 11-30	14902	1059.35	1077.58		1077.84	0.001228	6.21	5797.45	1936.01	0.2
CR 392	7889	10-yr	Exist	5920	1059.57	1073.43	1069.16	1074.49	0.003496	8.59	967.64	591.97	0.4
CR 392	7889	10-yr	Prop 11-30	5920	1059.57	1073.40	1069.16	1074.49	0.003545	8.64	954.09	583.01	0.4
CR 392	7889	100-yr	Exist	14902	1059.57	1076.81		1077.04	0.001254	5.97	5973.97	1891.18	0.2
CR 392	7889	100-yr	Prop 11-30	14902	1059.57	1076.81		1077.04	0.001253	5.96	5975.13	1891.2	0.2
CR 392	6844.2	10-yr	Exist	5920	1057.94	1071.51		1072.06	0.001566	6.04	1069.65	118.67	0.3
CR 392	6844.2	10-yr	Prop 11-30	5920	1057.94	1071.45		1072.01	0.001591	6.07	1063.43	118	0.3
CR 392	6844.2	100-yr	Exist	14902	1057.94	1076.07		1076.32	0.000821	5.41	6474.11	1846.25	0.2
CR 392	6844.2	100-yr	Prop 11-30	14902	1057.94	1076.08		1076.32	0.00082	5.41	6476.36	1846.31	0.2
CR 392	5518.3	10-yr	Exist	5920	1053.04	1069.39		1070.03	0.001504	6.51	1069.29	157.68	0.3
CR 392	5518.3	10-yr	Prop 11-30	5920	1053.04	1069.28		1069.94	0.001548	6.58	1052.19	156.78	0.3
CR 392	5518.3	100-yr	Exist	14902	1053.04	1074.96	1067.82	1075.31	0.000946	6.43	7748.83	1992.31	0.2
CR 392	5518.3	100-yr	Prop 11-30	14902	1053.04	1074.96	1067.82	1075.32	0.000945	6.43	7754.18	1992.49	0.2
CR 392	4912.4	10-yr	Exist	5920	1052.23	1068.03		1068.89	0.00236	7.52	832.87	95.02	0.3
CR 392	4912.4	10-yr	Prop 11-30	5920	1052.23	1067.86		1068.76	0.002475	7.64	817.07	93.62	0.4
CR 392	4912.4	100-yr	Exist	14902	1052.23	1070.57	1068.29	1073.96	0.007783	15.09	1293.16	637.8	0.7
CR 392	4912.4	100-yr	Prop 11-30	14902	1052.23	1070.55	1068.29	1073.96	0.007815	15.11	1285.26	615.86	0.7
CR 392	4408.7	10-yr	Exist	5920	1051.25	1067.74		1068.08	0.000842	5.17	1878.03	381.32	0.2
CR 392	4408.7	10-yr	Prop 11-30	5920	1051.25	1067.54		1067.9	0.000903	5.32	1799.9	378.71	0.2
CR 392	4408.7	100-yr	Exist	14902	1051.25	1070.97		1071.63	0.001624	8.15	4483.07	1422.11	0.3
CR 392	4408.7	100-yr	Prop 11-30	14902	1051.25	1070.95		1071.61	0.00164	8.18	4454.61	1420.72	0.3
													0.0
CR 392	4243.4	10-yr	Exist	5920	1051.32	1067.79	1057.93	1067.95	0.00036	3.59	2731.79	569	0.1
CR 392	4243.4	10-yr	Prop 11-30	5920	1051.32	1067.59	1057.93	1067.76	0.000383	3.67	2645.16	543.6	0.1
CR 392	4243.4	10-yr	Exist	14902	1051.32	1037.03	1062.84	1071.38	0.00071	5.76	6355.89	1375.15	0.1
CR 392 CR 392	4243.4	100-yr	Prop 11-30	14902	1051.32	1071.07	1062.84	1071.36	0.000715	5.76	6331.9	1375.15	0.2
UK 392	4245.4	100-yi	F10p 11-30	14502	1051.52	1071.05	1002.04	1071.30	0.000715	5.11	0331.9	1372.45	0.2
CR 392	3775.5	10-yr	Exist	5920	1050.72	1066.77	1060.43	1067.56	0.002083	7.29	983.29	399.08	0.3
CR 392 CR 392	3775.5	10-yr	Prop 11-30	5920	1050.72	1066.84	1060.43	1067.50	0.002083	6.48	1594.13	409.12	0.3
CR 392 CR 392	3775.5	10-yr	Exist	14902	1050.72	1060.84	1060.39	1070.64	0.001033	11.22	3265.48	1025.5	0.5
CR 392	3775.5	100-yr	Prop 11-30	14902	1050.72	1069.03	1066.61	1070.59	0.004501	11.71	3059.76	910.78	0.5
CD 202	3719.6	10-yr	Exist	5920	1050.11	1066.82	1059.04	1067.4	0.001534	6.13	989.84	221 17	0.3
CR 392												331.17	
CR 392	3719.6	10-yr	Prop 11-30	5920	1047.78	1067.08	1056.52	1067.25	0.000227	3.46	2262.24	407.61	0.1
CR 392	3719.6 3719.6	100-yr	Exist Prop 11-30	14902 14902	1050.11 1047.78	1069.04 1069.59	1065.18 1061.42	1070.41 1070.23	0.003629	<u>10.45</u> 6.81	2970.91 4296.29	1012.62	0.5
CR 392	3719.0	100-yr	PTOP 11-30	14902	1047.70	1009.59	1001.42	1070.23	0.000697	0.01	4290.29	1378.61	0.0
CR 392	3694.5			Bridge									
011 332	3034.3			Blidge									
CR 392	3666.5	10-yr	Exist	5920	1049.8	1066.5	1057.97	1067.01	0.001248	5.75	1029.93	349.7	0.2
CR 392	3666.5	10-yr	Prop 11-30	5920	1047.78	1066.69	1056.49	1066.89	0.000258	3.61	2076.61	430.73	0.1
CR 392	3666.5	100-yr	Exist	14902	1049.8	1069.42	1063.66	1070.36	0.002369	8.88	3893.55	1389.53	0.1
CR 392	3666.5	100-yr	Prop 11-30	14902	1047.78	1069.55	1061.43	1070.14	0.0002505	6.63	4695.05	1394.73	0.4
011 002	0000.0	100-yi	1100 11-00	14002	1047.70	1000.00	1001.40	1070.14	0.000004	0.00	4000.00	1004.70	
CR 392	3615.7	10-yr	Exist	5920	1049.57	1066.44	1058.52	1066.95	0.001201	5.83	1247.88	569.35	0.2
CR 392 CR 392	3615.7	10-yr	Prop 11-30	5920	1049.57	1066.49	1058.52	1066.82	0.001201	5.08	2050.48	5/3.04	0.2
CR 392 CR 392	3615.7	10-yr	Exist	14902	1049.57	1068.49	1058.55	1000.02	0.000907	7.58	5322.27	1507.94	0.2
CR 392 CR 392	3615.7	100-yr	Prop 11-30	14902	1049.57	1069.51	1065.59	1070.07	0.001521	7.58	5322.27	1507.94	0.3
011 082	3013.7	100-yi	100 11-30	14002	1040.07	1009.01	1000.01	1070.07	0.001321	1.00	5522.21	1301.34	0.3
			1								1		
CB 303	2810.0	10.10	Eviet	5020	1047.6	1066		1066.25	0.000549	1 10	1065 22	700.03	0.4
CR 392	2819.9 2819.9	10-yr 10-yr	Exist Prop 11-30	5920 5920	1047.6 1047.6	1066		1066.25 1066.25	0.000548	4.19	1965.33 1965.33	799.03	
CR 392	2819.9	10-yr	Prop 11-30	5920	1047.6	1066		1066.25	0.000548	4.19	1965.33	799.03	0.2
CR 392 CR 392	2819.9 2819.9	10-yr 100-yr	Prop 11-30 Exist	5920 14902	1047.6 1047.6	1066 1068.83		1066.25 1069.17	0.000548 0.000842	4.19 5.82	1965.33 5275.09	799.03 1312.41	0.2 0.2
CR 392	2819.9	10-yr	Prop 11-30	5920	1047.6	1066		1066.25	0.000548	4.19	1965.33	799.03	0.2 0.2
CR 392 CR 392 CR 392	2819.9 2819.9 2819.9	10-yr 100-yr 100-yr	Prop 11-30 Exist Prop 11-30	5920 14902 14902	1047.6 1047.6 1047.6	1066 1068.83 1068.83		1066.25 1069.17 1069.17	0.000548 0.000842 0.000842	4.19 5.82 5.82	1965.33 5275.09 5275.09	799.03 1312.41 1312.41	0.2 0.2 0.2
CR 392 CR 392 CR 392 CR 392	2819.9 2819.9 2819.9 2819.9 2284.7	10-yr 100-yr 100-yr 100-yr	Prop 11-30 Exist Prop 11-30 Exist	5920 14902 14902 5920	1047.6 1047.6 1047.6 1046.1	1066 1068.83 1068.83 1065.27		1066.25 1069.17 1069.17 1065.43	0.000548 0.000842 0.000842 0.014285	4.19 5.82 5.82 2.24	1965.33 5275.09 5275.09 2022.21	799.03 1312.41 1312.41 643.56	0.2
CR 392 CR 392 CR 392 CR 392 CR 392 CR 392	2819.9 2819.9 2819.9 2284.7 2284.7	10-yr 100-yr 100-yr 10-yr 10-yr 10-yr	Prop 11-30 Exist Prop 11-30 Exist Prop 11-30	5920 14902 14902 5920 5920	1047.6 1047.6 1047.6 1046.1 1046.1	1066 1063.83 1068.83 1065.27 1065.27		1066.25 1069.17 1069.17 1065.43 1065.43	0.000548 0.000842 0.000842 0.014285 0.014285	4.19 5.82 5.82 2.24 2.24	1965.33 5275.09 5275.09 2022.21 2022.21	799.03 1312.41 1312.41 643.56 643.56	0.2 0.2 0.2 0.2
CR 392 CR 392 CR 392 CR 392 CR 392 CR 392 CR 392	2819.9 2819.9 2819.9 2284.7 2284.7 2284.7	10-yr 100-yr 100-yr 10-yr 10-yr 100-yr	Prop 11-30 Exist Prop 11-30 Exist Prop 11-30 Exist	5920 14902 14902 5920 5920 14902	1047.6 1047.6 1047.6 1046.1 1046.1 1046.1	1066 1063.83 1068.83 1065.27 1065.27 1063.33		1066.25 1069.17 1069.17 1065.43 1065.43 1065.43	0.000548 0.000842 0.000842 0.014285	4.19 5.82 5.82 2.24 2.24 1.06	1965.33 5275.09 5275.09 2022.21 2022.21 6347.2	799.03 1312.41 1312.41 643.56 643.56 1677.07	0.2 0.2 0.2 0. 0. 0.
CR 392 CR 392 CR 392 CR 392 CR 392 CR 392	2819.9 2819.9 2819.9 2284.7 2284.7	10-yr 100-yr 100-yr 10-yr 10-yr 10-yr	Prop 11-30 Exist Prop 11-30 Exist Prop 11-30	5920 14902 14902 5920 5920	1047.6 1047.6 1047.6 1046.1 1046.1	1066 1063.83 1068.83 1065.27 1065.27		1066.25 1069.17 1069.17 1065.43 1065.43	0.000548 0.000842 0.000842 0.014285 0.014285 0.0014285	4.19 5.82 5.82 2.24 2.24	1965.33 5275.09 5275.09 2022.21 2022.21	799.03 1312.41 1312.41 643.56 643.56	0.2 0.2 0.2 0. 0. 0.
CR 392 CR 392 CR 392 CR 392 CR 392 CR 392 CR 392 CR 392	2819.9 2819.9 2819.9 2284.7 2284.7 2284.7 2284.7	10-yr 100-yr 100-yr 10-yr 10-yr 100-yr 100-yr	Prop 11-30 Exist Prop 11-30 Exist Prop 11-30 Exist Prop 11-30	5920 14902 14902 5920 5920 14902 14902	1047.6 1047.6 1047.6 1046.1 1046.1 1046.1 1046.1	1066 1068.83 1068.83 1065.27 1065.27 1068.33 1068.33		1066.25 1069.17 1069.17 1065.43 1065.43 1068.43 1068.43	0.000548 0.000842 0.000842 0.014285 0.014285 0.0014285 0.002467 0.002467	4.19 5.82 5.82 2.24 2.24 1.06 1.06	1965.33 5275.09 5275.09 2022.21 2022.21 6347.2 6347.2	799.03 1312.41 1312.41 643.56 643.56 1677.07 1677.07	0.2 0.2 0.2 0. 0. 0. 0.0
CR 392 CR 392 CR 392 CR 392 CR 392 CR 392 CR 392 CR 392	2819.9 2819.9 2819.9 2284.7 2284.7 2284.7 2284.7 2284.7 2284.7 1424.9	10-yr 100-yr 100-yr 10-yr 10-yr 100-yr 100-yr 100-yr	Prop 11-30 Exist Prop 11-30 Exist Prop 11-30 Exist Prop 11-30 Exist	5920 14902 14902 5920 5920 14902 14902 5920	1047.6 1047.6 1047.6 1046.1 1046.1 1046.1 1046.1 1046.1 1044.77	1066 1068.83 1068.83 1065.27 1065.27 1068.33 1068.33 1068.33		1066.25 1069.17 1069.17 1065.43 1065.43 1068.43 1068.43 1068.43 1068.43	0.000548 0.000842 0.000842 0.014285 0.014285 0.002467 0.002467 0.002467	4.19 5.82 5.82 2.24 2.24 1.06 1.06 6.64	1965.33 5275.09 5275.09 2022.21 6347.2 6347.2 1135.04	799.03 1312.41 1312.41 643.56 643.56 1677.07 1677.07 173.97	0.1 0.2 0.2 0.2 0.2 0.2 0.2 0.2 0.2 0.0 0.0
CR 392 CR 392 CR 392 CR 392 CR 392 CR 392 CR 392 CR 392 CR 392 CR 392	2819.9 2819.9 2819.9 2284.7 2284.7 2284.7 2284.7 2284.7 1424.9 1424.9	10-yr 100-yr 100-yr 10-yr 10-yr 100-yr 100-yr 100-yr 10-yr 10-yr	Prop 11-30 Exist Prop 11-30 Exist Prop 11-30 Exist Prop 11-30 Exist Prop 11-30	5920 14902 14902 5920 5920 14902 14902 5920 5920 5920	1047.6 1047.6 1047.6 1046.1 1046.1 1046.1 1046.1 1046.1 1044.77 1044.77	1066 1068.83 1068.83 1065.27 1065.27 1068.33 1068.33 1068.33 1062.03		1066.25 1069.17 1069.17 1065.43 1065.43 1068.43 1068.43 1068.43 1068.68	0.000548 0.000842 0.000842 0.014285 0.014285 0.002467 0.002467 0.002467 0.001487 0.001487	4.19 5.82 5.82 2.24 2.24 1.06 1.06 6.64 6.64	1965.33 5275.09 2022.21 2022.21 6347.2 6347.2 6347.2 1135.04	799.03 1312.41 1312.41 643.56 643.56 1677.07 1677.07 1677.07 173.97 173.97	0.2 0.2 0.2 0.2 0.2 0.2 0.2 0.2 0.2 0.2
CR 392 CR 392	2819.9 2819.9 2819.9 2284.7 2284.7 2284.7 2284.7 2284.7 1424.9 1424.9 1424.9	10-yr 100-yr 100-yr 10-yr 10-yr 100-yr 100-yr 10-yr 10-yr 10-yr 10-yr	Prop 11-30 Exist Prop 11-30 Exist Prop 11-30 Exist Prop 11-30 Exist Prop 11-30 Exist	5920 14902 14902 5920 5920 14902 14902 5920 5920 5920 14902	1047.6 1047.6 1047.6 1046.1 1046.1 1046.1 1046.1 1046.1 1044.77 1044.77 1044.77	1066 1063.83 1065.83 1065.27 1065.27 1063.33 1068.33 1062.03 1062.03 1062.03 1066.72		1066.25 1069.17 1069.17 1065.43 1065.43 1068.43 1068.43 1068.68 1062.68 1062.68 1067.17	0.000548 0.000842 0.000842 0.014285 0.014285 0.002467 0.002467 0.002467 0.001487 0.001487 0.001487	4.19 5.82 5.82 2.24 2.24 1.06 1.06 6.64 6.64 7.11	1965.33 5275.09 5275.09 2022.21 6347.2 6347.2 6347.2 1135.04 1135.04 1135.04 5261.37	799.03 1312.41 1312.41 643.56 643.56 1677.07 1677.07 1677.07 173.97 173.97 1710.34	0.1 0.2 0.2 0.1 0.1 0.0 0.0 0.0 0.3 0.3 0.3
CR 392 CR 392 CR 392 CR 392 CR 392 CR 392 CR 392 CR 392 CR 392 CR 392	2819.9 2819.9 2819.9 2284.7 2284.7 2284.7 2284.7 2284.7 1424.9 1424.9	10-yr 100-yr 100-yr 10-yr 10-yr 100-yr 100-yr 100-yr 10-yr 10-yr	Prop 11-30 Exist Prop 11-30 Exist Prop 11-30 Exist Prop 11-30 Exist Prop 11-30	5920 14902 14902 5920 5920 14902 14902 5920 5920 5920	1047.6 1047.6 1047.6 1046.1 1046.1 1046.1 1046.1 1046.1 1044.77 1044.77	1066 1068.83 1068.83 1065.27 1065.27 1068.33 1068.33 1068.33 1062.03		1066.25 1069.17 1069.17 1065.43 1065.43 1068.43 1068.43 1068.43 1068.68	0.000548 0.000842 0.000842 0.014285 0.014285 0.002467 0.002467 0.002467 0.001487 0.001487	4.19 5.82 5.82 2.24 2.24 1.06 1.06 6.64 6.64	1965.33 5275.09 2022.21 2022.21 6347.2 6347.2 6347.2 1135.04	799.03 1312.41 1312.41 643.56 643.56 1677.07 1677.07 1677.07 173.97 173.97	0.1 0.2 0.2 0.1 0.1 0.0 0.0 0.0 0.3 0.3 0.3
CR 392 CR 392	2819.9 2819.9 2819.9 2284.7 2284.7 2284.7 2284.7 2284.7 1424.9 1424.9 1424.9 1424.9	10-yr 100-yr 100-yr 10-yr 10-yr 100-yr 100-yr 100-yr 100-yr 100-yr	Prop 11-30 Exist Prop 11-30 Exist Prop 11-30 Exist Prop 11-30 Exist Prop 11-30 Exist Prop 11-30	5920 14902 14902 5920 5920 14902 14902 5920 5920 14902 14902	1047.6 1047.6 1046.1 1046.1 1046.1 1046.1 1046.1 1044.77 1044.77 1044.77	1066 1063.83 1065.83 1065.27 1065.27 1065.27 1068.33 1068.33 1062.03 1062.03 1066.72 1066.72		1066.25 1069.17 1069.17 1065.43 1065.43 1068.43 1068.43 1062.68 1062.68 1062.717 1067.17	0.000548 0.000842 0.000842 0.014285 0.014285 0.002467 0.002467 0.002467 0.001487 0.001487 0.001487 0.001247	4.19 5.82 5.82 2.24 2.24 1.06 1.06 6.64 6.64 7.11 7.11	1965.33 5275.09 5275.09 2022.21 2022.21 6347.2 6347.2 1135.04 1135.04 1135.04 5261.37 5261.37	799.03 1312.41 1312.41 643.56 643.56 1677.07 1677.07 173.97 173.97 1710.34 1710.34	0.2 0.2 0.2 0.2 0.2 0.2 0.2 0.2 0.2 0.0 0.0
CR 392 CR 392	2819.9 2819.9 2819.9 2284.7 2284.7 2284.7 2284.7 2284.7 1424.9 1424.9 1424.9 1424.9 1424.9 1424.9	10-yr 100-yr 100-yr 10-yr 100-yr 100-yr 100-yr 100-yr 100-yr 100-yr 100-yr 100-yr	Prop 11-30 Exist Prop 11-30 Exist Prop 11-30 Exist Prop 11-30 Exist Prop 11-30 Exist Prop 11-30 Exist	5920 14902 14902 5920 5920 14902 14902 5920 5920 5920 14902 14902 14902	1047.6 1047.6 1046.1 1046.1 1046.1 1046.1 1046.1 1044.77 1044.77 1044.77 1044.77 1044.77	1066 1063.83 1063.83 1065.27 1065.27 1065.27 1068.33 1068.33 1062.03 1062.03 1062.03 1066.72 1066.72 1059.88		1066.25 1069.17 1069.17 1065.43 1065.43 1068.43 1068.43 1062.68 1062.68 1067.17 1067.17 1067.17	0.000548 0.000842 0.000842 0.014285 0.014285 0.002467 0.002467 0.002467 0.001487 0.001487 0.001487 0.001427 0.001247 0.001247	4.19 5.82 5.82 2.24 2.24 1.06 1.06 6.64 6.64 7.11 7.11 8.73	1965.33 5275.09 2022.21 2022.21 6347.2 6347.2 1135.04 1135.04 1135.04 5261.37 5261.37 678.23	799.03 1312.41 1312.41 643.56 643.56 1677.07 1677.07 173.97 173.97 1710.34 1710.34 1710.34 66.72	0.: 0.2 0.2 0.2 0.2 0.2 0.2 0.2 0.2 0.2 0.0 0.0
CR 392 CR 392	2819.9 2819.9 2819.9 2284.7 2284.7 2284.7 2284.7 2284.7 2284.7 1424.9 1424.9 1424.9 1424.9 1424.9 736.2	10-yr 100-yr 100-yr 10-yr 100-yr 100-yr 100-yr 100-yr 100-yr 100-yr 100-yr 100-yr 100-yr	Prop 11-30 Exist Prop 11-30 Exist Prop 11-30 Exist Prop 11-30 Exist Prop 11-30 Exist Prop 11-30 Exist Prop 11-30	5920 14902 14902 5920 5920 14902 14902 5920 5920 14902 14902 14902 14902 5920 5920	1047.6 1047.6 1046.1 1046.1 1046.1 1046.1 1046.1 1044.77 1044.77 1044.77 1044.77 1044.77 1044.71	1066 1063.83 1068.83 1065.27 1065.27 1068.33 1068.33 1062.03 1062.03 1066.72 1066.72 1066.72 1059.88 1059.88		1066.25 1069.17 1069.17 1065.43 1065.43 1068.43 1068.43 1068.43 1062.68 1062.68 1067.17 1067.17 1067.17 1061.06	0.000548 0.000842 0.000842 0.014285 0.014285 0.002467 0.002467 0.002467 0.001487 0.001487 0.001487 0.001487 0.001247 0.001247 0.00387 0.00387	4.19 5.82 5.82 2.24 2.24 1.06 1.06 1.06 6.64 6.64 7.11 7.11 7.11 8.73 8.73	1965.33 5275.09 2022.21 2022.21 6347.2 6347.2 6347.2 1135.04 1135.04 5261.37 5261.37 5261.37 678.23 678.23	799.03 1312.41 1312.41 643.56 643.56 1677.07 1677.07 1677.07 173.97 173.97 1710.34 1710.34 1710.34 66.72 66.72	0.: 0.2 0.2 0.2 0.2 0.2 0.2 0.2 0.2 0.3 0.3 0.3 0.3 0.3 0.3 0.3 0.4 0.4
CR 392 CR 392	2819.9 2819.9 2819.9 2284.7 2284.7 2284.7 2284.7 2284.7 1424.9 1424.9 1424.9 1424.9 1424.9 736.2 736.2 736.2	10-yr 100-yr 100-yr 10-yr 100-yr 100-yr 100-yr 100-yr 100-yr 100-yr 100-yr 100-yr 100-yr 100-yr 100-yr	Prop 11-30 Exist Prop 11-30 Exist Prop 11-30 Exist Prop 11-30 Exist Prop 11-30 Exist Prop 11-30 Exist Prop 11-30 Exist	5920 14902 14902 5920 5920 14902 14902 5920 5920 14902 14902 5920 5920 5920 5920 14902	1047.6 1047.6 1047.6 1046.1 1046.1 1046.1 1046.1 1046.1 1044.77 1044.77 1044.77 1044.77 1044.77 1044.71 1045.11	1066 1063.83 1065.83 1065.27 1065.27 1068.33 1068.33 1062.03 1062.03 1066.72 1066.72 1066.72 1059.88 1059.88 1065.4	1064.64	1066.25 1069.17 1069.17 1065.43 1065.43 1068.43 1068.43 1068.43 1062.68 1062.68 1067.17 1067.17 1061.06 1061.06 1066.09	0.000548 0.000842 0.000842 0.014285 0.014285 0.002467 0.002467 0.002467 0.001487 0.001487 0.001487 0.001247 0.001247 0.00387 0.00387 0.00387	4.19 5.82 5.82 2.24 2.24 1.06 1.06 1.06 6.64 6.64 7.11 7.11 8.73 8.73 8.73 8.35	1965.33 5275.09 5275.09 2022.21 6347.2 6347.2 6347.2 1135.04 1135.04 1135.04 5261.37 5261.37 5261.37 678.23 678.23 678.23 4165.85	799.03 1312.41 1312.41 643.56 643.56 1677.07 1677.07 1677.07 173.97 173.97 1710.34 1710.34 1710.34 66.72 66.72 1839.91	0.3 0.2 0.2 0.2 0.2 0.2 0.2 0.2 0.3 0.3 0.3 0.3 0.3 0.4 0.4 0.4
CR 392 CR 392	2819.9 2819.9 2819.9 2284.7 2284.7 2284.7 2284.7 2284.7 2284.7 1424.9 1424.9 1424.9 1424.9 1424.9 736.2	10-yr 100-yr 100-yr 10-yr 100-yr 100-yr 100-yr 100-yr 100-yr 100-yr 100-yr 100-yr 100-yr	Prop 11-30 Exist Prop 11-30 Exist Prop 11-30 Exist Prop 11-30 Exist Prop 11-30 Exist Prop 11-30 Exist Prop 11-30	5920 14902 14902 5920 5920 14902 14902 5920 5920 14902 14902 14902 14902 5920 5920	1047.6 1047.6 1046.1 1046.1 1046.1 1046.1 1046.1 1044.77 1044.77 1044.77 1044.77 1044.77 1044.71	1066 1063.83 1068.83 1065.27 1065.27 1068.33 1068.33 1062.03 1062.03 1066.72 1066.72 1066.72 1059.88 1059.88	1064.64	1066.25 1069.17 1069.17 1065.43 1065.43 1068.43 1068.43 1068.43 1062.68 1062.68 1067.17 1067.17 1067.17 1061.06	0.000548 0.000842 0.000842 0.014285 0.014285 0.002467 0.002467 0.001487 0.001487 0.001487 0.001487 0.001247 0.001247 0.00387 0.00387	4.19 5.82 5.82 2.24 2.24 1.06 1.06 1.06 6.64 6.64 7.11 7.11 7.11 8.73 8.73	1965.33 5275.09 2022.21 2022.21 6347.2 6347.2 6347.2 1135.04 1135.04 5261.37 5261.37 5261.37 678.23 678.23	799.03 1312.41 1312.41 643.56 643.56 1677.07 1677.07 1677.07 173.97 173.97 1710.34 1710.34 1710.34 66.72 66.72	0.3 0.2 0.2 0.2 0.2 0.2 0.2 0.2 0.3 0.3 0.3 0.3 0.3 0.4 0.4 0.4
CR 392 CR 392	2819.9 2819.9 2819.9 2284.7 2284.7 2284.7 2284.7 2284.7 1424.9 1424.9 1424.9 1424.9 1424.9 1424.9 736.2 736.2 736.2	10-yr 100-yr 100-yr 100-yr 100-yr 100-yr 100-yr 100-yr 100-yr 100-yr 100-yr 100-yr 100-yr 100-yr	Prop 11-30 Exist Prop 11-30 Exist Prop 11-30 Exist Prop 11-30 Exist Prop 11-30 Exist Prop 11-30 Exist Prop 11-30 Exist Prop 11-30	5920 14902 14902 5920 5920 14902 14902 5920 5920 14902 14902 5920 5920 14902	1047.6 1047.6 1047.6 1046.1 1046.1 1046.1 1046.1 1044.77 1044.77 1044.77 1044.77 1044.77 1045.11 1045.11 1045.11	1066 1063.83 1065.83 1065.27 1065.27 1063.33 1062.03 1062.03 1062.03 1066.72 1066.72 1066.72 1059.88 1059.88 1065.4		1066.25 1069.17 1069.17 1065.43 1065.43 1068.43 1062.68 1062.68 1062.68 1067.17 1067.17 1061.06 1061.06 1066.09 1066.09	0.000548 0.000842 0.000842 0.014285 0.014285 0.002467 0.002467 0.001487 0.001487 0.001487 0.001247 0.001247 0.00387 0.00387 0.00387 0.00322	4.19 5.82 5.82 2.24 2.24 1.06 1.06 6.64 6.64 6.64 7.11 7.11 8.73 8.73 8.35 8.35	1965.33 5275.09 5275.09 2022.21 6347.2 6347.2 6347.2 1135.04 1135.04 1135.04 5261.37 5261.37 5261.37 678.23 678.23 678.23 4165.85	799.03 1312.41 1312.41 643.56 643.56 1677.07 1677.07 173.97 173.97 1710.34 1710.34 1710.34 66.72 66.72 66.72 1839.91 1839.91	0.3 0.2 0.2 0.2 0.2 0.2 0.2 0.2 0.2 0.2 0.3 0.3 0.3 0.3 0.3 0.3 0.3 0.3 0.3 0.3
CR 392 CR 392	2819.9 2819.9 2819.9 2284.7 2284.7 2284.7 2284.7 2284.7 1424.9 1424.9 1424.9 1424.9 1424.9 1424.9 736.2 736.2 736.2 736.2 736.2	10-yr 100-yr 100-yr 10-yr 100-yr 100-yr 100-yr 100-yr 100-yr 100-yr 100-yr 100-yr 100-yr 100-yr 100-yr 100-yr 100-yr	Prop 11-30 Exist Prop 11-30 Exist Prop 11-30 Exist Prop 11-30 Exist Prop 11-30 Exist Prop 11-30 Exist Prop 11-30 Exist Prop 11-30 Exist	5920 14902 14902 5920 5920 14902 14902 5920 5920 5920 14902 14902 5920 5920 5920 14902 14902 14902	1047.6 1047.6 1046.1 1046.1 1046.1 1046.1 1046.1 1044.77 1044.77 1044.77 1044.77 1044.77 1045.11 1045.11 1045.11 1045.11	1066 1063.83 1068.83 1065.27 1065.27 1068.33 1068.33 1062.03 1062.03 1066.72 1066.72 1059.88 1059.88 1055.4 1065.4 1065.4 1065.4		1066.25 1069.17 1069.17 1065.43 1065.43 1068.43 1068.43 1062.68 1062.68 1067.17 1067.17 1061.06 1061.06 1066.09 1066.09 1058.92	0.000548 0.000842 0.000842 0.014285 0.014285 0.002467 0.002467 0.001487 0.001487 0.001487 0.001247 0.001247 0.00387 0.00387 0.00387 0.00222 0.00222	4.19 5.82 5.82 2.24 2.24 1.06 1.06 6.64 6.64 6.64 7.11 7.11 8.73 8.73 8.73 8.35 8.35 9.44	1965.33 5275.09 2022.21 2022.21 6347.2 6347.2 6347.2 1135.04 1135.04 1135.04 5261.37 5261.37 678.23 678.23 678.23 678.23 4165.85 4165.85	799.03 1312.41 1312.41 643.56 643.56 1677.07 1677.07 173.97 1710.34 1710.34 1710.34 1710.34 66.72 66.72 66.72 1839.91 1839.91 1839.91	0.3 0.2 0.2 0.2 0.2 0.2 0.2 0.2 0.2 0.2 0.0 0.0
CR 392 CR 392	2819.9 2819.9 2819.9 2284.7 2284.7 2284.7 2284.7 2284.7 1424.9 1424.9 1424.9 1424.9 1424.9 1424.9 736.2 736.2 736.2 736.2 736.2 736.2	10-yr 100-yr 100-yr 10-yr 100-yr 100-yr 100-yr 100-yr 100-yr 100-yr 100-yr 100-yr 100-yr 100-yr 100-yr 100-yr 100-yr	Prop 11-30 Exist Prop 11-30 Exist Prop 11-30 Exist Prop 11-30 Exist Prop 11-30 Exist Prop 11-30 Exist Prop 11-30 Exist Prop 11-30 Exist Prop 11-30	5920 14902 14902 5920 5920 14902 14902 1047.6 1047.6 1046.1 1046.1 1046.1 1046.1 1046.1 1044.77 1044.77 1044.77 1044.77 1044.77 1045.11 1045.11 1045.11 1045.11 1044.3	1066 1063.83 1068.83 1065.27 1065.27 1068.33 1062.03 1062.03 1066.72 1066.72 1059.88 1059.88 1059.88 1055.4 1065.4 1065.4 1057.53 1057.53	1064.64	1066.25 1069.17 1069.17 1065.43 1065.43 1068.43 1068.43 1062.68 1062.68 1067.17 1067.17 1067.17 1061.06 1066.09 1066.09 1058.92 1058.92	0.000548 0.000842 0.000842 0.014285 0.014285 0.002467 0.002467 0.002467 0.001487 0.001487 0.001487 0.001247 0.001247 0.00387 0.00387 0.00387 0.00222 0.00222	4.19 5.82 5.82 2.24 2.24 1.06 1.06 1.06 6.64 6.64 7.11 7.11 8.73 8.73 8.35 8.35 8.35 9.44 9.44	1965.33 5275.09 5275.09 2022.21 6347.2 6347.2 6347.2 1135.04 1135.04 5261.37 5261.37 5261.37 5261.37 678.23 678.23 678.23 4165.85 4165.85 4165.85	799.03 1312.41 1312.41 643.56 643.56 1677.07 1677.07 173.97 173.97 1710.34 1710.34 1710.34 66.72 66.72 66.72 1839.91 1839.91 1839.91 70.44 70.44	0.3 0.2 0.2 0.2 0.2 0.2 0.2 0.2 0.2 0.2 0.2
CR 392 CR 392	2819.9 2819.9 2819.9 2284.7 2284.7 2284.7 2284.7 2284.7 1424.9 1424.9 1424.9 1424.9 1424.9 736.2 736.2 736.2 736.2 736.2 736.2 256.1 256.1	10-yr 100-yr 100-yr 10-yr 100-yr 100-yr 100-yr 100-yr 100-yr 100-yr 100-yr 100-yr 100-yr 100-yr 100-yr 100-yr 100-yr 100-yr	Prop 11-30 Exist Prop 11-30 Exist Prop 11-30 Exist Prop 11-30 Exist Prop 11-30 Exist Prop 11-30 Exist Prop 11-30 Exist Prop 11-30 Exist Prop 11-30 Exist	5920 14902 14902 5920 5920 14902 14902 5920 5920 14902 14902 14902 5920 5920 14902 14902 14902 14902	1047.6 1047.6 1046.1 1046.1 1046.1 1046.1 1046.1 1044.77 1044.77 1044.77 1044.77 1044.77 1045.11 1045.11 1045.11 1045.11 1044.3 1044.3	1066 1063.83 1065.27 1065.27 1065.27 1068.33 1068.33 1062.03 1062.03 1066.72 1066.72 1066.72 1059.88 1059.88 1059.88 1055.4 1065.4 1065.4 1057.53 1057.53 1063.61	1064.64	1066.25 1069.17 1069.17 1065.43 1065.43 1068.43 1068.43 1068.68 1062.68 1067.17 1067.17 1061.06 1061.06 1066.09 1066.09 1066.92 1058.92 1058.92	0.000548 0.000842 0.000842 0.014285 0.014285 0.002467 0.002467 0.002467 0.001487 0.001487 0.001487 0.001247 0.001247 0.00387 0.00387 0.00387 0.00222 0.00222 0.00222 0.005084 0.005084 0.005084	4.19 5.82 5.82 2.24 2.24 1.06 1.06 1.06 6.64 6.64 7.11 7.11 8.73 8.73 8.35 8.35 9.44 9.44 9.87	1965.33 5275.09 5275.09 2022.21 6347.2 6347.2 6347.2 6347.2 1135.04 1135.04 1135.04 5261.37 5261.37 5261.37 5261.37 678.23 678.23 678.23 4165.85 4165.85 4165.85	799.03 1312.41 1312.41 643.56 643.56 1677.07 1677.07 173.97 173.97 1710.34 1710.34 1710.34 66.72 66.72 1839.91 1839.91 1839.91 70.44 70.44 1548.04	0.3 0.2 0.2 0.0 0.0 0.0 0.0 0.3 0.3 0.3 0.3 0.3 0.3
CR 392 CR 392	2819.9 2819.9 2819.9 2284.7 2284.7 2284.7 2284.7 2284.7 1424.9 1424.9 1424.9 1424.9 1424.9 1424.9 736.2 736.2 736.2 736.2 736.2 736.2	10-yr 100-yr 100-yr 10-yr 100-yr 100-yr 100-yr 100-yr 100-yr 100-yr 100-yr 100-yr 100-yr 100-yr 100-yr 100-yr 100-yr	Prop 11-30 Exist Prop 11-30 Exist Prop 11-30 Exist Prop 11-30 Exist Prop 11-30 Exist Prop 11-30 Exist Prop 11-30 Exist Prop 11-30 Exist Prop 11-30	5920 14902 14902 5920 5920 14902 14902 1047.6 1047.6 1046.1 1046.1 1046.1 1046.1 1046.1 1044.77 1044.77 1044.77 1044.77 1044.77 1045.11 1045.11 1045.11 1045.11 1044.3	1066 1063.83 1068.83 1065.27 1065.27 1068.33 1062.03 1062.03 1066.72 1066.72 1059.88 1059.88 1059.88 1055.4 1065.4 1065.4 1057.53 1057.53	1064.64	1066.25 1069.17 1065.43 1065.43 1065.43 1068.43 1068.43 1062.68 1062.68 1067.17 1067.17 1067.17 1061.06 1066.09 1066.09 1058.92 1058.92	0.000548 0.000842 0.000842 0.014285 0.014285 0.002467 0.002467 0.002467 0.001487 0.001487 0.001487 0.001247 0.001247 0.00387 0.00387 0.00387 0.00222 0.00222	4.19 5.82 5.82 2.24 2.24 1.06 1.06 1.06 6.64 6.64 7.11 7.11 8.73 8.73 8.35 8.35 8.35 9.44 9.44	1965.33 5275.09 5275.09 2022.21 6347.2 6347.2 6347.2 1135.04 1135.04 5261.37 5261.37 5261.37 5261.37 678.23 678.23 678.23 4165.85 4165.85 4165.85	799.03 1312.41 1312.41 643.56 643.56 1677.07 1677.07 173.97 173.97 1710.34 1710.34 1710.34 66.72 66.72 66.72 1839.91 1839.91 1839.91 70.44 70.44	0.3 0.2 0.2 0.0 0.0 0.0 0.0 0.3 0.3 0.3 0.3 0.3 0.3
CR 392 CR 392	2819.9 2819.9 2819.9 2284.7 2284.7 2284.7 2284.7 2284.7 2284.7 1424.9 1424.9 1424.9 1424.9 1424.9 1424.9 736.2 736.2 736.2 736.2 736.2 736.2 736.2 736.2 736.2	10-yr 100-yr 100-yr 100-yr 100-yr 100-yr 100-yr 100-yr 100-yr 100-yr 100-yr 100-yr 100-yr 100-yr 100-yr 100-yr 100-yr 100-yr	Prop 11-30 Exist Prop 11-30	5920 14902 14902 5920 5920 14902 14902 5920 5920 14902 14902 5920 5920 14902 14902 14902	1047.6 1047.6 1047.6 1046.1 1046.1 1046.1 1046.1 1044.77 1044.77 1044.77 1044.77 1045.11 1045.11 1045.11 1045.11 1044.3 1044.3 1044.3	1066 1063.83 1065.27 1065.27 1065.27 1068.33 1062.03 1062.03 1066.72 1066.72 1066.72 1059.88 1059.88 1055.4 1065.4 1065.4 1065.5 1065.5 1065.61	1064.64 1063.61 1063.61	1066.25 1069.17 1069.17 1065.43 1065.43 1068.43 1068.43 1062.68 1062.68 1067.17 1067.17 1061.06 1061.06 1066.09 1066.09 1058.92 1058.92 1058.92 1064.75	0.000548 0.000842 0.000842 0.014285 0.014285 0.002467 0.002467 0.001487 0.001487 0.001487 0.001247 0.001247 0.001247 0.00387 0.00222 0.00222 0.00222 0.005084 0.005084 0.005084	4.19 5.82 5.82 2.24 2.24 1.06 1.06 6.64 7.11 7.11 8.73 8.73 8.35 8.35 8.35 9.44 9.44 9.87 9.87	1965.33 5275.09 5275.09 2022.21 6347.2 6347.2 6347.2 1135.04 1135.04 5261.37 5261.37 678.23 678.23 678.23 4165.85 4165.85 4165.85 626.93 626.93 6223.3 3223.3	799.03 1312.41 1312.41 643.56 643.56 1677.07 1677.07 173.97 173.97 1710.34 1710.34 1710.34 66.72 66.72 66.72 1839.91 1839.91 1839.91 70.44 70.44 1948.04	0.3 0.2 0.2 0.0 0.0 0.0 0.3 0.3 0.3 0.3 0.3 0.3 0.4 0.4 0.5 0.5 0.5 0.4 0.4
CR 392 CR 392	2819.9 2819.9 2819.9 2284.7 2284.7 2284.7 2284.7 2284.7 1424.9 1424.9 1424.9 1424.9 1424.9 1424.9 1424.9 736.2 736.2 10-yr 100-yr 100-yr 10-yr 100-yr 100-yr 100-yr 100-yr 100-yr 100-yr 100-yr 100-yr 100-yr 100-yr 100-yr 100-yr 100-yr 100-yr 100-yr 100-yr 100-yr	Prop 11-30 Exist Prop 11-30 Exist Prop 11-30 Exist Prop 11-30 Exist Prop 11-30 Exist Prop 11-30 Exist Prop 11-30 Exist Prop 11-30 Exist Prop 11-30 Exist Prop 11-30 Exist	5920 14902 14902 5920 5920 14902 14902 5920 5920 5920 14902 14902 14902 14902 14902 14902 14902 14902 14902 14902 5920 5920 5920 5920	1047.6 1047.6 1046.1 1046.1 1046.1 1046.1 1046.1 1044.77 1044.77 1044.77 1044.77 1044.77 1044.77 1045.11 1045.11 1045.11 1044.3 1044.3 1044.3 1044.3	1066 1063.83 1068.83 1065.27 1065.27 1068.33 1062.03 1062.03 1066.72 1066.72 1059.88 1059.88 1055.4 1065.4 1065.4 1057.53 1057.53 1063.61 1063.61	1064.64 1063.61 1063.61 1052.16	1066.25 1069.17 1069.17 1065.43 1065.43 1068.43 1068.43 1062.68 1062.68 1067.17 1067.17 1061.06 1061.06 1066.09 1066.09 1058.92 1058.92 1058.92 1064.75 1064.75	0.000548 0.000842 0.000842 0.014285 0.014285 0.002467 0.002467 0.001487 0.001487 0.001487 0.001487 0.001247 0.001247 0.00387 0.00387 0.00222 0.00222 0.00222 0.005084 0.005084 0.003371 0.003371	4.19 5.82 5.82 2.24 2.24 1.06 1.06 6.64 6.64 7.11 7.11 8.73 8.73 8.73 8.35 8.35 9.44 9.44 9.44 9.87 9.87 6.5	1965.33 5275.09 2022.21 2022.21 6347.2 6347.2 6347.2 1135.04 1135.04 1135.04 5261.37 5261.37 678.23 678.23 678.23 678.23 4165.85 4165.85 9 626.93 626.93 626.93 3222.3 3223.3 1139.91	799.03 1312.41 1312.41 643.56 643.56 1677.07 1677.07 173.97 1710.34 1710.34 1710.34 1710.34 1710.34 1710.34 1710.34 1710.34 1710.34 170.34 170.34 1839.91 1839.91 1839.91 70.44 70.44 1948.04 1948.04 152.87	0.3 0.2 0.2 0.2 0.2 0.2 0.2 0.2 0.2 0.2 0.2
CR 392 CR 392	2819.9 2819.9 2819.9 2284.7 2284.7 2284.7 2284.7 2284.7 2284.7 1424.9 1424.9 1424.9 1424.9 1424.9 1424.9 736.2 736.2 736.2 736.2 736.2 736.2 736.2 736.2 736.2	10-yr 100-yr 100-yr 100-yr 100-yr 100-yr 100-yr 100-yr 100-yr 100-yr 100-yr 100-yr 100-yr 100-yr 100-yr 100-yr 100-yr 100-yr	Prop 11-30 Exist Prop 11-30	5920 14902 14902 5920 5920 14902 14902 5920 5920 14902 14902 5920 5920 14902 14902 14902	1047.6 1047.6 1047.6 1046.1 1046.1 1046.1 1046.1 1044.77 1044.77 1044.77 1044.77 1045.11 1045.11 1045.11 1045.11 1044.3 1044.3 1044.3	1066 1063.83 1065.27 1065.27 1065.27 1068.33 1062.03 1062.03 1066.72 1066.72 1066.72 1059.88 1059.88 1055.4 1065.4 1065.4 1065.5 1065.5 1065.61	1064.64 1063.61 1063.61	1066.25 1069.17 1069.17 1065.43 1065.43 1068.43 1068.43 1062.68 1062.68 1067.17 1067.17 1061.06 1061.06 1066.09 1066.09 1058.92 1058.92 1058.92 1064.75	0.000548 0.000842 0.000842 0.014285 0.014285 0.002467 0.002467 0.001487 0.001487 0.001487 0.001247 0.001247 0.001247 0.00387 0.00222 0.00222 0.00222 0.005084 0.005084 0.005084	4.19 5.82 5.82 2.24 2.24 1.06 1.06 6.64 7.11 7.11 8.73 8.73 8.35 8.35 8.35 9.44 9.44 9.87 9.87	1965.33 5275.09 5275.09 2022.21 6347.2 6347.2 6347.2 1135.04 1135.04 5261.37 5261.37 678.23 678.23 678.23 4165.85 4165.85 4165.85 626.93 626.93 6223.3 3223.3	799.03 1312.41 1312.41 643.56 643.56 1677.07 1677.07 173.97 173.97 1710.34 1710.34 1710.34 66.72 66.72 66.72 1839.91 1839.91 1839.91 70.44 70.44 1948.04	0.3 0.2 0.2 0.0 0.0 0.0 0.3 0.3 0.3 0.3 0.3 0.3 0.4 0.4 0.5 0.5 0.5 0.4 0.4

RS 7885 RS 49 RS 4

0

PLAN: PROP 11-30 RESLEY CREEK CR 392 RS: 3694.5					
E.G. US. (FT)	1067.25	ELEMENT			
W.S. US. (FT)	1067.08	E.G. ELEV (FT)			
Q TOTAL (CFS)	5920	W.S. ELEV (FT)			
Q BRIDGE (CFS)	5707.81	CRIT W.S. (FT)			
Q WEIR (CFS)	212.19	MAX CHL DEPTH (FT)			
WEIR STA LFT (FT)	1791.1	VEL TOTAL (FT/S)			
WEIR STA RGT (FT)	2094.22	FLOW AREA (SQ FT)			
WEIR SUBMERG	0.11	FROUDE # CHL			
WEIR MAX DEPTH (FT)	0.71	SPECIF FORCE (CU FT)			
MIN EL WEIR FLOW (FT)	1067.01	HYDR DEPTH (FT)			
MIN EL PRS (FT)	1063.77	W.P. TOTAL (FT)			
DELTA EG (FT)	0.37	CONV. TOTAL (CFS)			
DELTA WS (FT)	0.39	TOP WIDTH (FT)			
BR OPEN AREA (SQ FT)	1186.66	FRCTN LOSS (FT)			
BR OPEN VEL (FT/S)	4.81	C & E LOSS (FT)			
BR SLUICE COEF		SHEAR TOTAL (LB/SQ FT)			
BR SEL METHOD	Press/Weir	POWER TOTAL (LB/FT S)			


PLAN: PROP 11	-30 RESLEY CF	REEK CR 392 RS: 3694.5
E.G. US. (FT)	1070.23	ELEMENT
W.S. US. (FT)	1069.59	E.G. ELEV (FT)
Q TOTAL (CFS)	14902	W.S. ELEV (FT)
Q BRIDGE (CFS)	6291.89	CRIT W.S. (FT)
Q WEIR (CFS)	8610.11	MAX CHL DEPTH (FT)
WEIR STA LFT (FT)	896.91	VEL TOTAL (FT/S)
WEIR STA RGT (FT)	2328.9	FLOW AREA (SQ FT)
WEIR SUBMERG	0.73	FROUDE # CHL
WEIR MAX DEPTH (FT)	3.68	SPECIF FORCE (CU FT)
MIN EL WEIR FLOW (FT)	1067.01	HYDR DEPTH (FT)
MIN EL PRS (FT)	1063.77	W.P. TOTAL (FT)
DELTA EG (FT)	0.09	CONV. TOTAL (CFS)
DELTA WS (FT)	0.04	TOP WIDTH (FT)
BR OPEN AREA (SQ FT)	1186.66	FRCTN LOSS (FT)
BR OPEN VEL (FT/S)	5.3	C & E LOSS (FT)
BR SLUICE COEF		SHEAR TOTAL (LB/SQ FT)
BR SEL METHOD	Press/Weir	POWER TOTAL (LB/FT S)

1371.87


1114.9


1476.49

1219.85

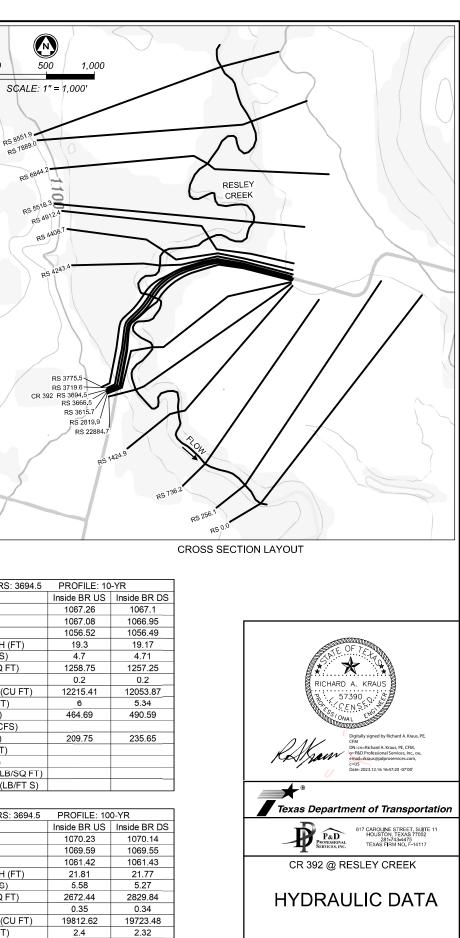

SHEET 1 OF 2					
CONT	SECT JOB HIGHWAY		HIGHWAY		
0923	17	084	CR 392		
DIST	COUNTY			SHEET NO.	
BWD		COMANCHE	36		

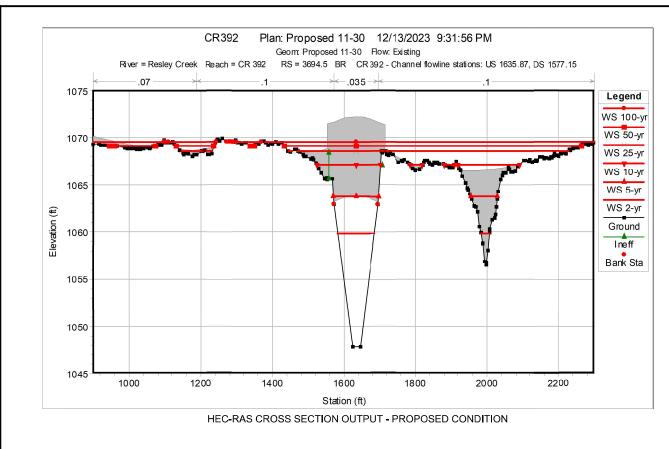

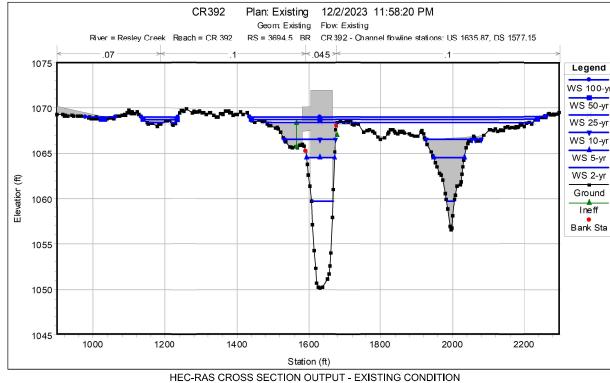

## NOTES:

1. PROPOSED BIRDGE IS LOCATED AT HEC-RAS RS 3694.5. UPSTREAM CROSS SECTION IS AT HEC-RAS RS 3719.6 AND DOWNSTREAM CROSS SECTION IS AT HEC-RAS RS 3666.5.

PERPENDICULAR TO CHANNEL.


2. PROPOSED BRIDGE IS


- 3. PROPOSED OVERALL BRIDGE WIDTH IS 26.0 FT. OVERALL BRIDGE LENGTH IS 125.0 FT.
- 4. RESLEY CREEK AT CR 392 IS NOT INCLUDED IN A FEMA FLOOD INSURANCE STUDY.



HYDRAULIC METHOD:

- (V 6.4.1) MODEL CREATED FOR RESLEY CREEK AT CR 392. FILENAME: CR392.prj EXIST COND PLAN: "EXISTING" PROP COND PLAN: "PROPOSED 11-30"
- 2. HEC-RAS CROSS SECTIONS FROM FIELD SURVEY, USGS 1 M DEM DATA AND PROPOSED BRIDGE LAYOUT.

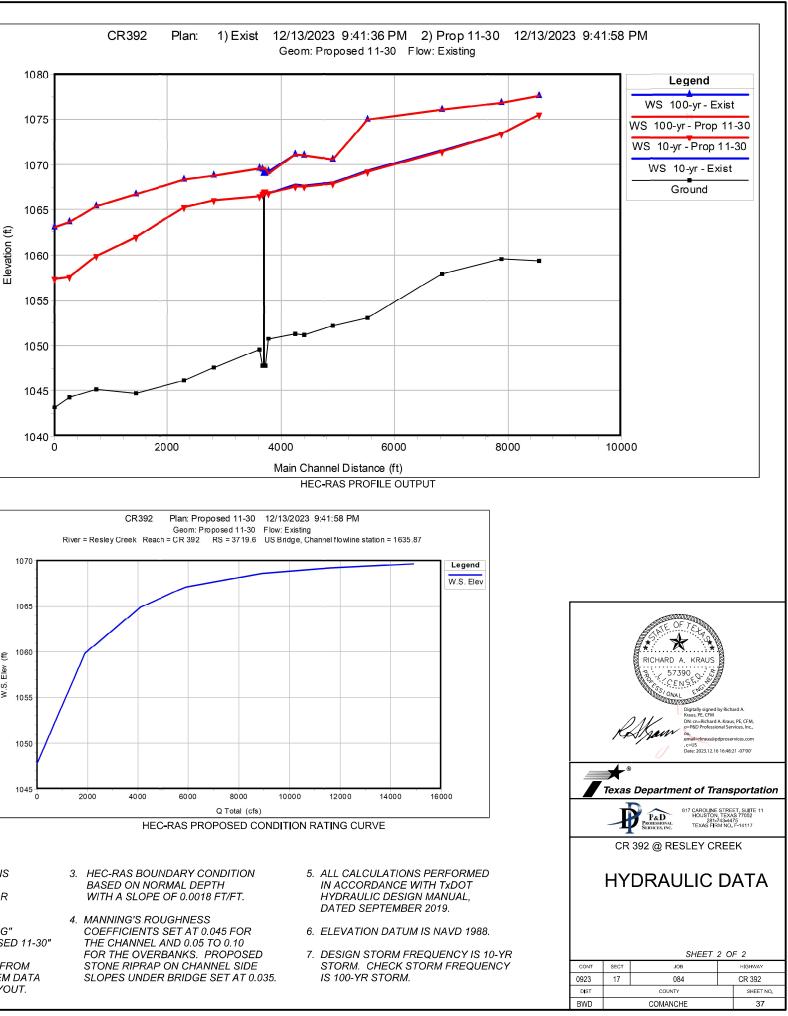

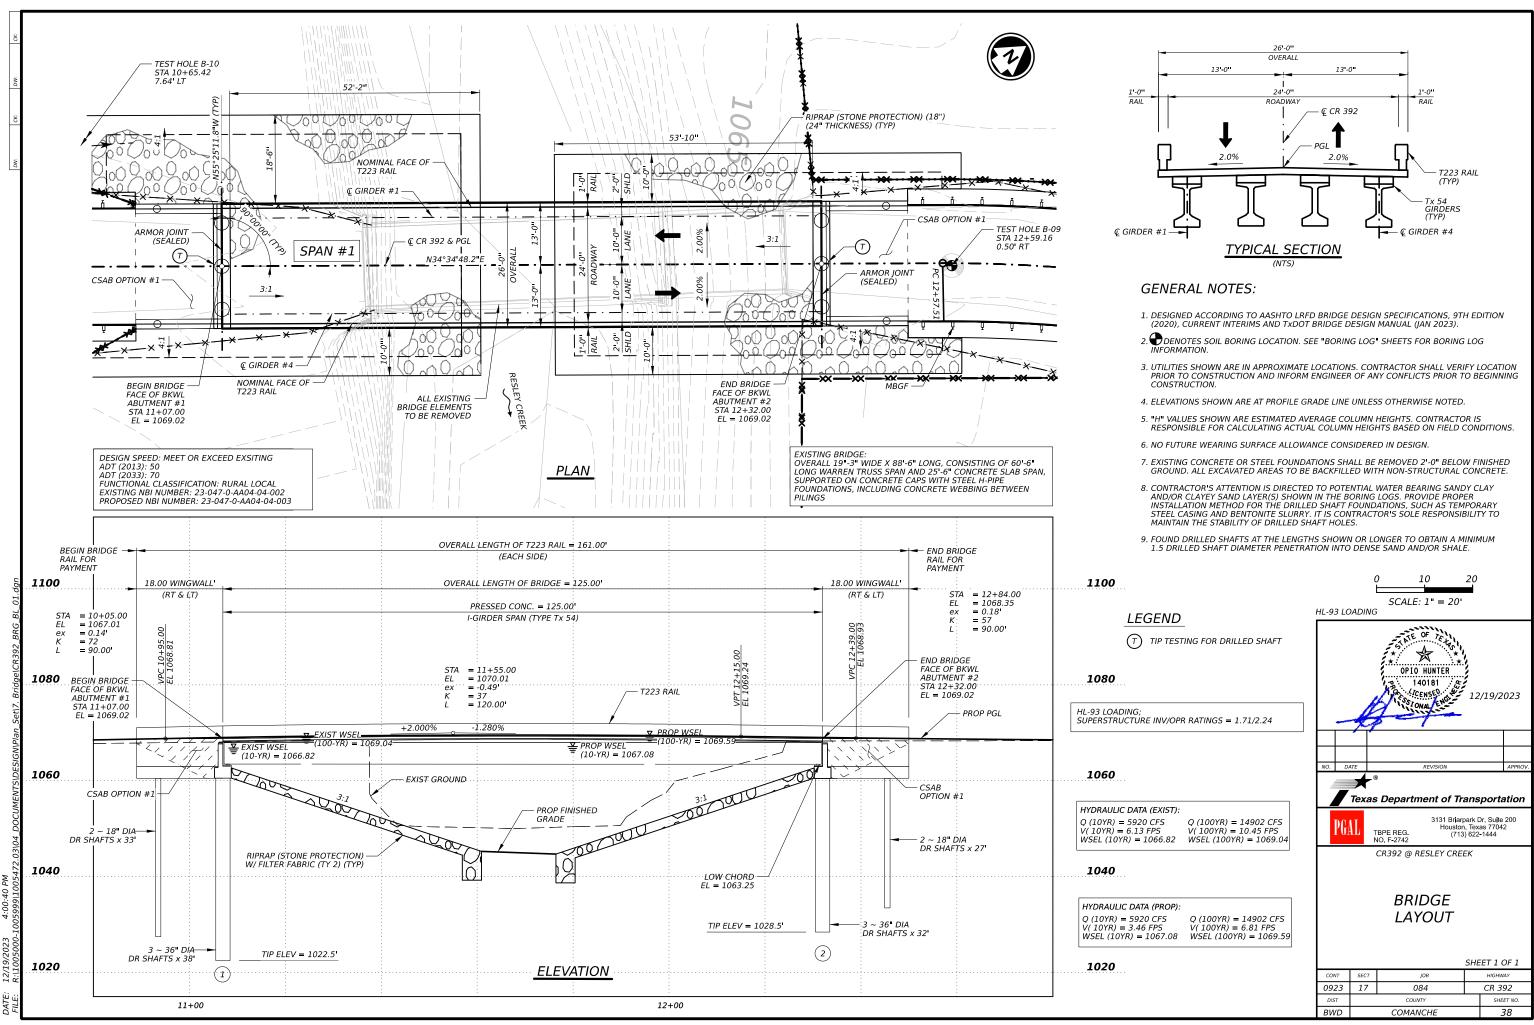





1 of 2 DRILLING LOG Tense Department of Theresponselon County Commanche Hole B-09 District Brownwood Highway CR-392 WinCore Bridge 6/3/2023 Structure Date 0923-17-084 Version 3.3 CSJ Station 12+59.16 Grnd. Elev. 1068.37 ft Offset 0.50 RT GW Elev. N/A Triaxial Test Properties L O G Texas Cone Lateral Deviator Press. Stress (psi) (psi) MC LL PI Den. (pcf) Strata Description Additional Remarks Elev. (ft) Penetrometer (pcf) SAND, CLAYEY, gray -with calcareous nodules 0'-2' (SC) 5 29 16 -#200=39%, N=12 N=24, P=4.5+ 7 1064.4 4 (6) 8 (6) CLAY, LEAN, WITH SAND, soft to very stiff, dark gray -with calcareous 5'-9' and 12'-14' (CL) 5 1 Crumb=2, P=0.5 13 5 89.7 15 115.2 P=4.5+ 42 (6) 31 (6) 10 8 44 27 -#200=80%, N=22, P=4.5+ 1 N=23, P=4.5+ 14 / 1054.4 11 (6) 14 (6) SAND, CLAYEY, slightly compact 15 to compact, gray -with calcareous nodules 15'-17' and 23'-25' and 14 N=15, P=4.5+ ferrous traces 17'-19' (SC) 8 26 12 -#200=38%, N=34, P=4.5+ 25 (6) 34 (6) 20 \_ -#200=34%, D50=0.19mm, N=24, P=3.0 1043.425 18 (6) 16 (6) CLAY, LEAN, stiff, light gray (CL) 1 1 N=27, Sulfate=47ppm 16 1038.430 50 (5) 50 (3) SANDSTONE, soft, gray -with fat clay seams 35'-40' REC=41.7%, RQD=6.7%, P=4.5+ 35 -50 (5) 50 (2.5) 12 REC=25%, RQD=0%, P=4.5+ ABUT 2 TIP ELEV = 1028.5' 1028.440 -Remarks: Groundwater was encountered at a depth of 25' below existing grade during drilling. Drilling started on 6/3/2023 and ended on 6/4/2023. Survey Coordinates (TSPC, Grid, Zone 4203): Easting:2948908.42; Northing:10641372.27, Lat/Long: N31.846167749, W98.232523455 The ground water elevation was not determined during the course of this boring. Organization: AVILES ENGINEERING CORP. Driller: TGB Logger: DGN Z:\Engineering\Reports\2023\G107-23 Five On-Off System Replacement Bridges in Brownwood District - PGAL\Wincore\B-09.CLG PLATE A-3

		DR	ILLING	LO	G			2 of 2	
WinCore Version 3.3		inty Commanche hway CR-392 J 0923-17-084	Hole Structure Station	B-09 Bridge 12+59.16			D	bistrict Brownwood bate 6/3/2023 Grnd. Elev. 1068.37 ft	
	L Toyas Cono		Offset Triaxia	0.50 RT	F	Propertie		W Elev. N/A	
	L Texas Cone O Penetrometer 50 (2) 50 (1)	Strata Description SHALE, hard, dark gray, with cer sand layer	Press. (psi)	Deviator Stress (psi)	MC	LL PI	Wet Den. (pcf)	Additional Remarks	
_					16	56 32		REC=18.3%, RQD=0%, #200=98%, P=4.5+	
1023.445 —	50 (2) 50 (0.25)	SANDSTONE, hard to very hard, gray							
 50 —	50 (2) 50 (1)		0	48.3	15		122.2	_ REC=35%, RQD=7.1%, P=4.5+	<u>NOTES</u>
  55	50 (1) 50 (0.5)				7			_ REC=39.2%, RQD=8.8%	<ol> <li>BORING LOGS SHOWN ON THIS SHEET ARE WITHOUT MODIFICATION AS PRODUCED IN GEOTECHNICAL STUDY "REPORT NO. G107-23C", DATED 12/18/2023, PREPARED BY AVILES ENGINEERING CORPORATION FOR TXDOT ON CONTRACT NO. 36-010P5091, WA#3.</li> </ol>
	50 (1) 50 (0.5)		0	260.6	8		123.3	_ REC=39.2%, RQD=8.3%, P=4.5+	
1003.465	50 (0.25) 50 (0)	SAND, POORLY GRADED, WITH very dense, light gray, with cen sand seams (SP-SM)						NO RECOVERY	
998.4 70	50 (1) 50 (0.5)	SANDSTONE, soft to hard, light gray -with fat clay seams 70'-75			6			REC=22.9%, RQD=0%, -#200=10%, D50=0.14mm, P=0.5	THE OF TEN
	50 (4) 50 (1)	gray -with fat only scalins ro -ro	0	52.1	16		131.7	_REC=15.8%, RQD=7.5%, P=4.5+	Luis A. González 13. 104983 Sciense Juis A. Bonalez Juis A. Bonalez
988.4 80					5			REC=71.7%, RQD=14.2%, P=4.5+ TD=80'	NO. DATE REVISION APPROV.
Remarks		ncountered at a depth of 25' belo pordinates (TSPC, Grid, Zone 4203						d on 6/3/2023 and ended on Lat/Long: N31.846167749, W98.232523455	Texas Department of Transportation
The groun	d water elevation was	not determined during the course c	f this boring.						PGAL TBPE REG. 3131 Briarpark Dr, Suite 200 Houston, Texas 77042 (713) 622-1444
Driller: T		Logger: DGN	nwood District - PGAI	\\//incore\B-0	900	Organi	zation:	AVILES ENGINEERING CORP.	NO. F-2742 CR392 @ RESLEY CREEK
2. Chymreen	igii (eponisizozo) (o no - 20 m	re on on of skann replacement on oges in orde		Wincore D-0	5.020			PLATE A-3	BORING LOGS
									SHEET 1 OF 2           CONT         SECT         JOB         HIGHWAY           0923         17         084         CR 392
									DIST COUNTY SHEET NO. BWD COMANCHE 39

Tas		DRILL	ING LO	DG			2 of 2	
WinCore		Inty Commanche Hole hway CR-392 Struct	B-09 ure Bridge	•			District Brownwood Date 6/3/2023	
Version 3.3	CS	J 0923-17-084 Station Offset					Grnd. Elev. 1068.37 ft GW Elev. N/A	
L			Triaxial Test		Propertie	es		
Elev. O (ft) G	Benetrometer	Strata Description SHALE, hard, dark gray, with cemented sand layer	Lateral Deviato Press. Stress (psi) (psi)	MC	LL PI	Wet Den. (pcf)	Additional Remarks	
				16	56 32		REC=18.3%, RQD=0%, #200=98%, P=4.5+	
1023.445	50 (2) 50 (0.25)	SANDSTONE, hard to very hard, gray					-#200=98%, P=4.5+	
-			0 48.3	15		122.2	_ REC=35%, RQD=7.1%, P=4.5+	
50 — — —	50 (2) 50 (1)							NOTES 1. BORING LOGS SHOWN ON THIS SHEET ARE WITHOUT MODIFICATION AS PRODUCED IN
-				7			_ REC=39.2%, RQD=8.8%	GEOTECHNICAL STUDY "REPORT NO. G107-23C", DATED 12/18/2023, PREPARED BY AVILES
55 — —	50 (1) 50 (0.5)							ENGINEERING CORPORATION FOR TXDOT ON CONTRACT NO. 36-0IDP5091, WA#3.
-			0 260.6	8		123.3	REC=39.2%, RQD=8.3%, P=4.5+	
60 —	50 (1) 50 (0.5)	-						
							NO RECOVERY	
1003.465	50 (0.25) 50 (0)	SAND, POORLY GRADED, WITH SILT, very dense, light gray, with cemented sand seams (SP-SM)						
				6			REC=22.9%, RQD=0%, -#200=10%, D50=0.14mm, P=0.5	THE OF TOUL
998.4 70	50 (1) 50 (0.5)	SANDSTONE, soft to hard, light gray -with fat clay seams 70'-75'						Luis A. González
- 75 -	50 (4) 50 (1)		0 52.1	16		131.7	REC=15.8%, RQD=7.5%, P=4.5+	104983 (5) (CENSE) (12/19/2023 (S) (MAL ENGLAND
-		-						Juis A. Bongalez
-				5			REC=71.7%, RQD=14.2%, P=4.5+ TD=80'	NO. DATE REVISION APPROV
		ncountered at a depth of 25' below exist					d on 6/3/2023 and ended on	
	-		-	Northin	ng:106413	372.27,	Lat/Long: N31.846167749, W98.232523455	Texas Department of Transportation
rne ground	water elevation was	s not determined during the course of this bo	oning.					PGAL TBPE REG. NO. F-2742 3131 Briarpark Dr, Suite 200 Houston, Texas 77042 (713) 622-1444
Driller: TGI		Logger: DGN	strict - PGAL\Wincore\	B-09.CLG	Organi	zation:	AVILES ENGINEERING CORP.	CR392 @ RESLEY CREEK
							PLATE A-3	BORING LOGS
								SHEET 1 OF 2 CONT SECT JOB HIGHWAY
								0923         17         084         CR 392           DIST         COUNTY         SHEET NO.
								BWD COMANCHE 39

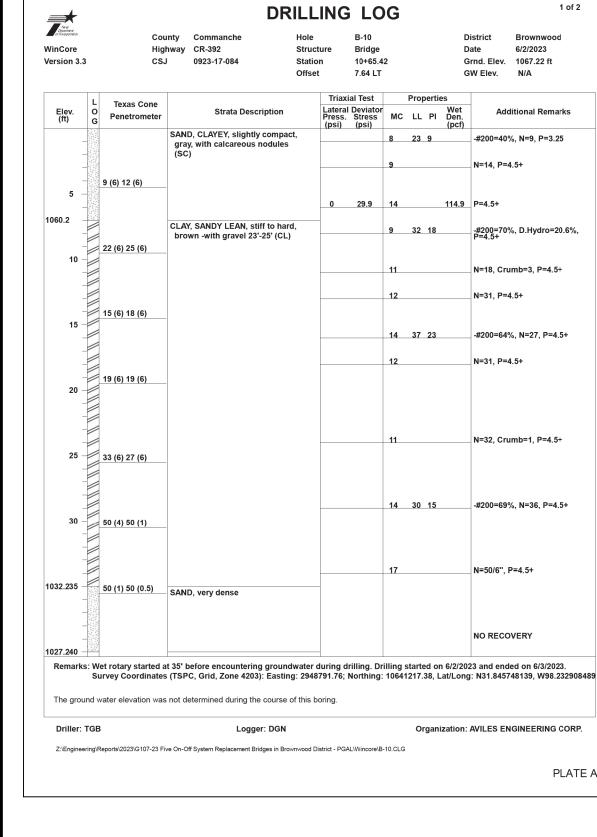

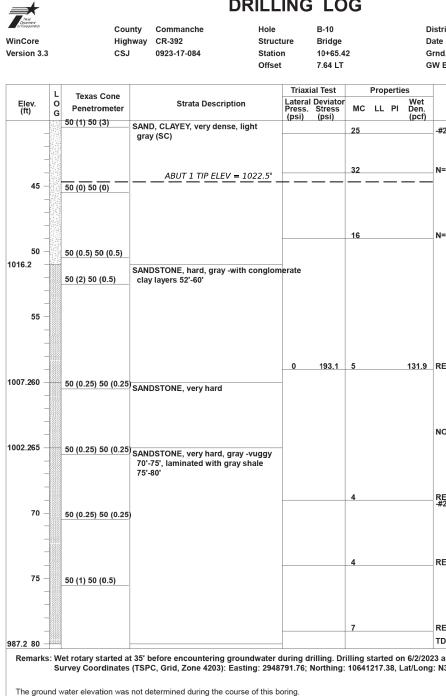

DRILLING LOG

Logger: DGN

Z:\Engineering\Reports\2023\G107-23 Five On-Off System Replacement Bridges in Brownwood District - PGAL\Wincore\B-10.CLG

PLATE A-4

Driller: TGB

1 of 2

Brownwood

6/2/2023

Additional Remarks

N/A

-#200=40%, N=9, P=3.25

-#200=70%, D.Hydro=20.6%, P=4.5+

N=18, Crumb=3, P=4.5+

-#200=64%, N=27, P=4.5+

N=32, Crumb=1, P=4.5+

-#200=69%, N=36, P=4.5+

N=50/6", P=4.5+

NO RECOVERY

Organization: AVILES ENGINEERING CORP.

N=31, P=4.5+

N=31, P=4.5+

N=14, P=4.5+

Grnd. Elev. 1067.22 ft

District

GW Elev.

Date

Properties

Md 4:26:13 1 DMTE DATE:

	2 of 2		
D G	istrict Brownwood ate 6/2/2023 rrnd. Elev. 1067.22 ft W Elev. N/A		
Properties Wet LL PI Den.	Additional Remarks		
(pcf)	-#200=56%, N=50/3", P=0.25		
	N=50/3"		
	N=50/3''		
			NOTES 1. BORING LOGS SHOWN ON THIS SHEET ARE WITHOUT MODIFICATION AS PRODUCED IN GEOTECHNICAL STUDY "REPORT NO. G107-23C", DATED 12/18/2023, REPARED BY AVILES ENGINEERING CORPORATION FOR TXDOT ON CONTRACT NO. 36-01DP5091, WA#3.
131.9	REC=30.1%, RQD=5.7%, P=4.5+		
	NO RECOVERY		
	REC=10.8%, RQD=10.8%, #200=33%, D50=0.13mm, P=4.5+		THE OF TELL
	REC=45%, RQD=9.2%, P=4.5+		Luis A. González 104983 Jais A. Bongalez Jais A. Bongalez
	REC=42.5%, RQD=6.7%, P=4.5+		
tarted on 6/2/20	TD=80' 23 and ended on 6/3/2023.		NO. DATE REVISION APPROV.
	: N31.845748139, W98.232908489		Texas Department of Transportation
Organization:	AVILES ENGINEERING CORP.		DGAL       3131 Brianpark Dr, Suite 200 Houston, Texas 77042         TBPE REG.       (713) 622-1444         CR392 @ RESLEY CREEK
	PLATE A-	4	BORING LOGS
			SHEET 2 OF 2
			CONT         SECT         JOB         HIGHWAY           0923         17         084         CR 392
			0923         17         064         CR 392           DIST         COUNTY         SHEET NO.
			BWD COMANCHE 40

		SUM	MARY OF ES	TIMATED BR.	IDGE QUA	NTITIES					
ITEM	400 6005	402 6001	416 6001	416 6004	420 6013	422 6001	425 6039	432 6033	450 6006	454 6004	4021 6001
DESCRIPTION	CEM STABIL BKFL	TRENCH EXCAVATION PROTECTION	DRILL SHAFT (18 IN)	DRILL SHAFT (36 IN)	* CL C CONC (ABUT)	REINF CONC SLAB	PRESTR CONC GIRDER (TX54)	** RIPRAP (STONE PROTECTION) (18 IN)	RAIL (TY T223)	ARMOR JOINT (SEALED)	*** TIP TESTING (DRILL SHAFT
UNIT	CY	LF	LF	LF	СҮ	SF	LF	СҮ	LF	LF	EA
ABUTMENT 1	69	60	80	135	27.6			416.9	36.0	23	1
ABUTMENT 2	69	60	70	120	27.6			363.4	36.0	23	1
125.00 PRSTR CONC I-GIRDER UNIT						3,250	498.00		250.0		
OVERALL TOTAL	138	120	150	255	55.2	3,250	498.00	780.3	322	46	2

\* ABUTMENT CONC QUANTITY INCLUDES THE SHEAR KEY VOLUME

\*\* FILTER FABRIC (TY 2) REQUIRED UNDERNEATH SRR, THIS IS SUBSIDIARY TO ITEM 432.


\*\*\* DRILLED SHAFT TESTING NOTES:


THERMAL INTEGRITY PROFILER (TIP) TESTING OF DRILLED SHAFT (SS 4021-6004) PERFORM THE NONDESTRUCTIVE TESTING (NDT) METHOD TERMED TIP TESTING TO CHECK THE INTEGRITY OF DESIGNATED PRODUCTION DRILLED SHAFTS AS SHOWN ON PLANS. COORDINATE TESTING WITH THE ENGINEER A MINIMUM OF ONE WEEK PRIOR TO THE DESIRED TESTING DATE.

### BEARING SEAT ELEVATIONS

BEAM 1 BEAM 2 BEAM 3 BEAM 4 ABUT 1 (FWD) 1063.118 1063.251 1063.251 1063.118

BEAM 1 BEAM 2 BEAM 3 BEAM 4 ABUT 2 (BK) 1063.104 1063.237 1063.237 1063.237

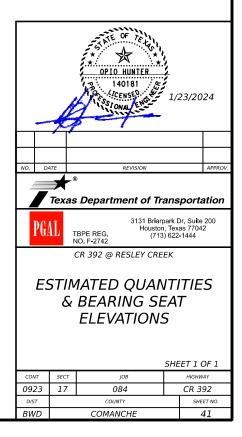

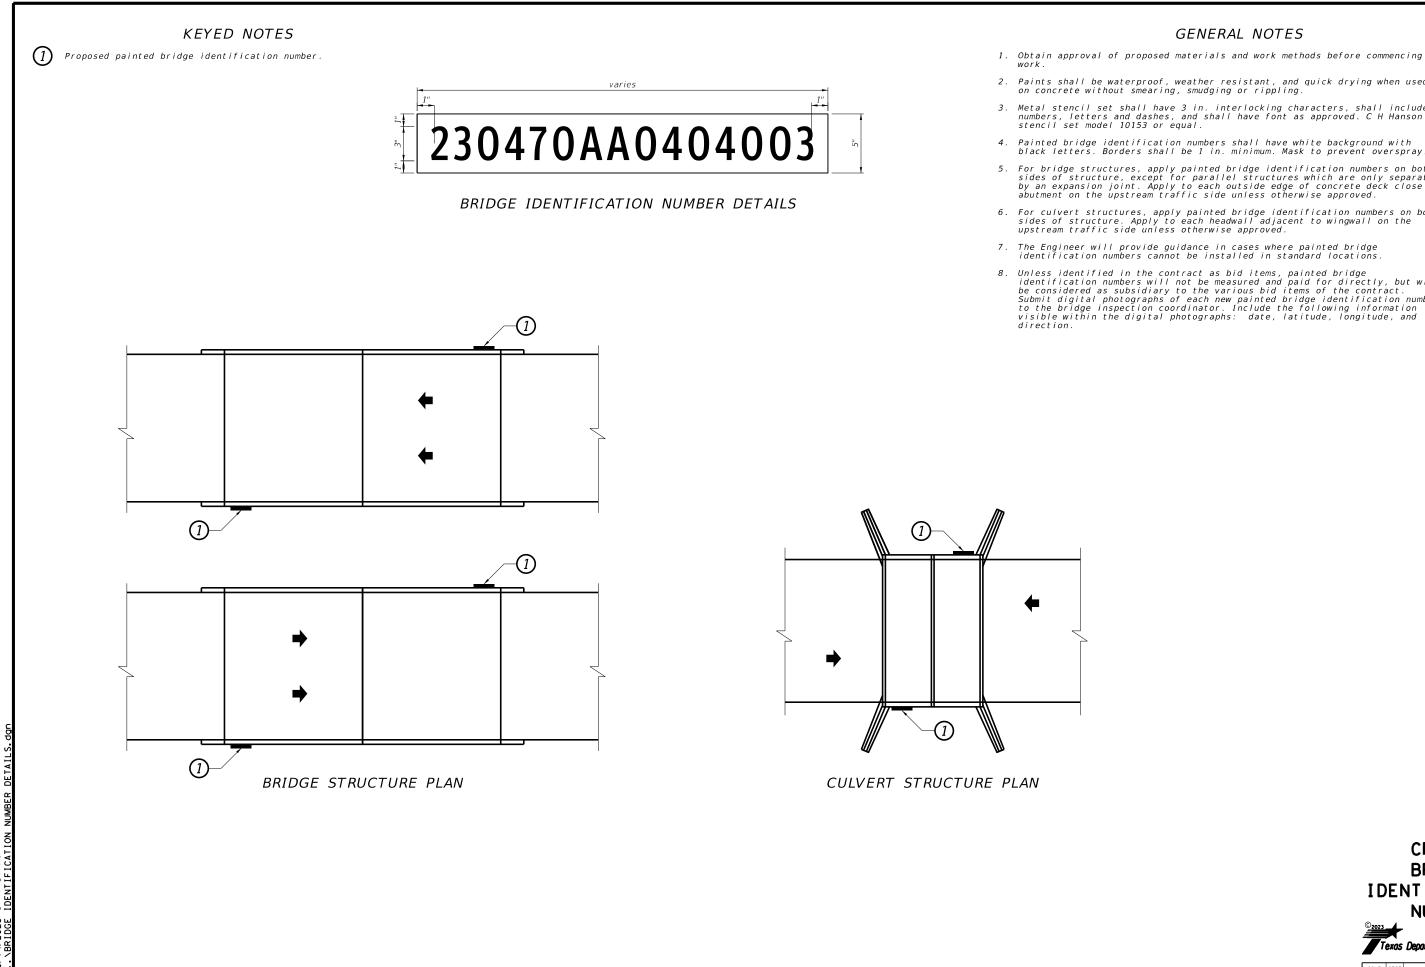

### GENERAL NOTES

Paints shall be waterproof, weather resistant, and quick drying when used on concrete without smearing, smudging or rippling.

Metal stencil set shall have 3 in. interlocking characters, shall include numbers, letters and dashes, and shall have font as approved. C H Hanson

Painted bridge identification numbers shall have white background with black letters. Borders shall be 1 in. minimum. Mask to prevent overspray.

5. For bridge structures, apply painted bridge identification numbers on both sides of structure, except for parallel structures which are only separated by an expansion joint. Apply to each outside edge of concrete deck close to abutment on the upstream traffic side unless otherwise approved.

6. For culvert structures, apply painted bridge identification numbers on both sides of structure. Apply to each headwall adjacent to wingwall on the upstream traffic side unless otherwise approved.


The Engineer will provide guidance in cases where painted bridge identification numbers cannot be installed in standard locations.


8. Unless identified in the contract as bid items, painted bridge identification numbers will not be measured and paid for directly, but will be considered as subsidiary to the various bid items of the contract. Submit digital photographs of each new painted bridge identification number to the bridge inspection coordinator. Include the following information visible within the digital photographs: date, latitude, longitude, and directions

# CR 392 BRIDGE IDENTIFICATION NUMBER

Texos Department of Transportation®

CONT	SECT	JOB		HIGHWAY
0923	17	084	C	R 392
DIST		COUNTY		SHEET NO.
BWD		COMANCHE		42

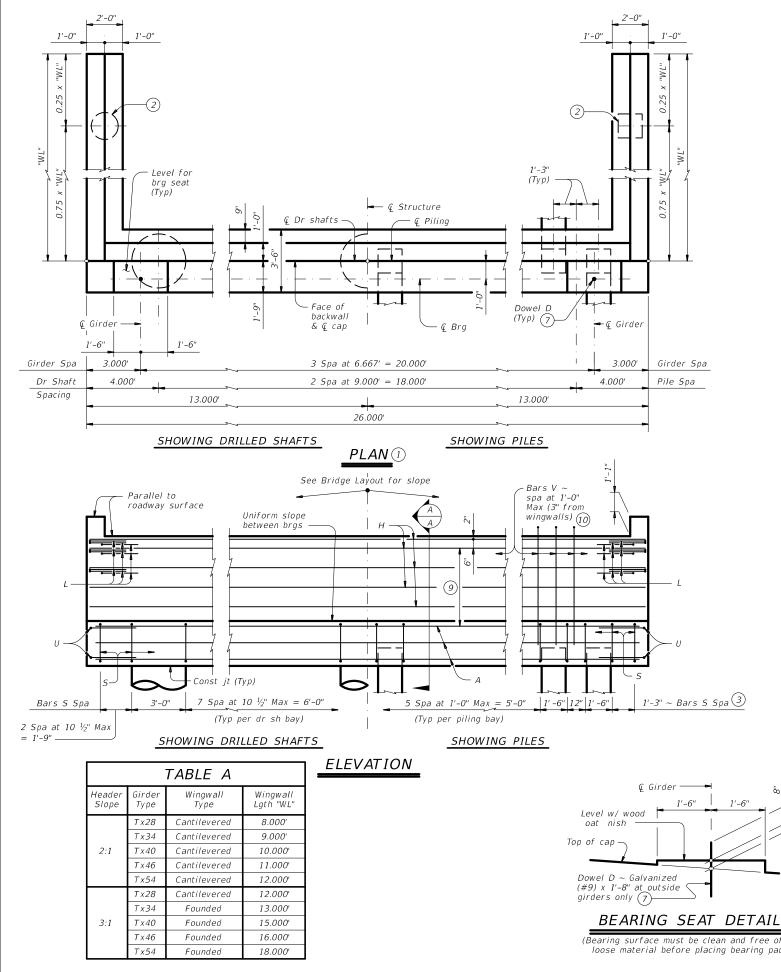

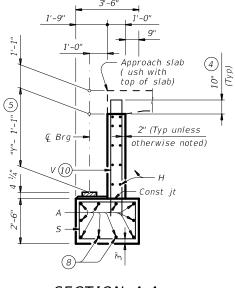

SECTION A-A (With approach slab) (6)

(1) See Table A for variable dimensions based on header slope and girder type.

- 2 See Table A to determine if wingwall foundations are required.
- ③ For piling larger than 16" adjust Bars S spacing as required to avoid piling.
- (4) Increase as required to maintain 3" from nished grade.
- 5 See Span details for "Y" value.
- 6 See Bridge Layout to determine if approach slab is present.

7 Omit Dowels D at end of multi-span unit. Adjust reinforcing steel total accordingly.

- 8 With pile foundations, move Bars A shown to clear piles.
- 9 Spacing based on girder type: Tx28 ~ 3 spaces at 1'-0" Max Tx34 ~ 3 spaces at 1'-0" Max Tx40 ~ 4 spaces at 1'-0" Max Tx46 ~ 4 spaces at 1'-0" Max Tx54 ~ 5 spaces at 1'-0" Max


10 Field bend as needed to clear piles.

(Bearing surface must be clean and free of all

loose material before placing bearing pad.)

### TABLE OF FOUNDATION LOADS

Span Length	All Girde	er Types
Ft	Tons/Shaft	Tons/Pile
40	64	54
45	69	56
50	73	59
55	77	61
60	81	63
65	85	65
70	88	67
75	92	69
80	96	71
85	100	73
90	104	75
95	108	77
100	111	79
105	115	80
110	119	82
115	123	84
120	126	86
125	130	88

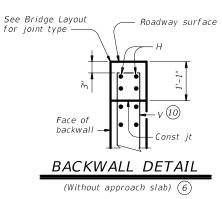

#### GENERAL NOTES:

Designed according to AASHTO LRFD Bridge Design Speci cations. See Bridge Layout for header slope and foundation

type, size and length. See Common Foundation Details (FD) standard sheet

for all foundation details and notes. See Concrete Riprap (CRR) standard sheet or Stone Riprap (SRR) standard sheet for riprap attachment details, if applicable.

See applicable rail details for rail anchorage in wingwalls. These abutment details may be used with standard


SIG-24 only.


Cover dimensions are clear dimensions, unless noted otherwise. Reinforcing bar dimensions shown are out-to-out of bar.

### MATERIAL NOTES:

Provide Class C concrete (f'c = 3,600 psi). Provide Class C (HPC) concrete if shown elsewhere in the plans. Provide Grade 60 reinforcing steel. Galvanize dowel bars D.

HL93 LOADING			T 1	OF 3							
Texas Department	of Tra	nsp	ortation		DI	ridge ivision andard					
ABU											
TYPE TX28 THRU TX54											
PRESTR C	PRESTR CONC I-GIRDERS										
24'	ROA	D	NAY								
		Α	IG-2	24							
FILE: IG-AIG2400-17.dgn	DN: TA	R	ск: КСМ	DW:	JTR	ск: TAR					
CTxDOT August 2017	CONT	SECT	JOB			HIGHWAY					
REVISIONS	0923 17		084		C	R 392					
	DIST		COUNTY			SHEET NO.					
	BWD		COMANC	HE		43					

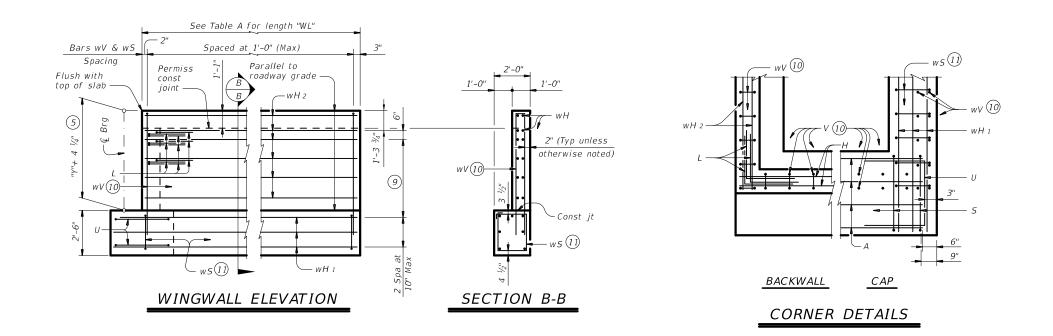

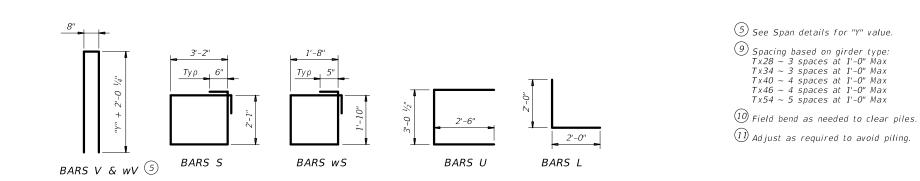

HL93 LOADING		SHEET 2 OF 3								
Texas Department	of Transportation Standard									
ABU	ΤM	ΙE	NTS							
TYPE TX.	28	ΤН	RU T	X	54					
PRESTR CONC I-GIRDERS										
24'				_						
		А	IG-2	24						
FILE: IG-AIG2400-17.dgn	DN: TA	R	ск: КСМ	DW:	JTR	ск: TAR				
CTxDOT August 2017	CONT	SECT	JOB		Н	IGHWAY				
REV1510N5	0923 17		084		CR 392					
	DIST		COUNTY		SHEET N					
	BWD		COMANC	ΉE		44				

# TABLES OF ESTIMATED QUANTITIES WITH 21 HEADER SLOPE

							ADLL	5 01 L.		AILD	, QU	ANT	TILSV	/ 1 / / / /	2.1 1				2)					
	ΤΥΡΕ	Тх28	3 Girders			ΤΥΡΕ	Tx34	4 Girders			TYPE Tx40 Girders				TYPE Tx46 Girders				TYPE Tx54 Girders					
Bar	No.	Size	Length	Weight	Bar	No.	Size	Length	Weight	Bar	No.	Size	Length	Weight	Bar	No.	Size	Length	Weight	Bar	No.	Size	Length	Weight
Α	10	#11	25'-0"	1,328	A	10	#11	25'-0"	1,328	A	10	#11	25'-0"	1,328	A	10	#11	25'-0"	1,328	А	10	#11	25'-0"	1,328
D(7)	2	#9	1'-8"	11	D(7)	2	#9	1'-8"	11	D(7)	2	#9	1'-8"	11	D(7)	2	#9	1'-8"	11	D(7	2	#9	1'-8"	11
Н	8	#6	25'-8"	308	Н	8	#6	25'-8"	308	Н	10	#6	25'-8"	386	Н	10	#6	25'-8''	386	Н	12	#6	25'-8''	463
L	18	#6	4'-0"	108	L	18	#6	4'-0''	108	L	18	#6	4'-0''	108	L	18	#6	4'-0''	108	L	18	#6	4'-0''	108
5	22	#5	11'-6"	264	5	22	#5	11'-6"	264	5	22	#5	11'-6"	264	5	22	#5	11'-6"	264	5	22	#5	11'-6"	264
U	4	#6	8'-1"	49	U	4	#6	8'-1"	49	U	4	#6	8'-1''	49	U	4	#6	8'-1"	49	U	4	#6	8'-1"	49
V	25	#5	11'-4"	296	V	25	#5	12'-4''	322	V	25	#5	13'-4"	348	V	25	#5	14'-4"	374	V	25	#5	15'-8''	409
wH1	14	#6	9'-5"	198	wH1	14	#6	10'-5"	219	wH1	14	#6	11'-5"	240	wH1	14	#6	12'-5"	261	wH1	14	#6	13'-5"	282
wH2	20	#6	7'-8"	230	wH2	20	#6	8'-8''	260	wH2	24	#6	9'-8''	348	wH2	24	#6	10'-8"	385	wH2	28	#6	11'-8"	491
wS	18	#4	7'-10''	94	wS	20	#4	7'-10''	105	wS	22	#4	7'-10"	115	wS	24	#4	7'-10"	126	wS	26	#4	7'-10''	136
wV	18	#5	11'-4"	213	wV	20	#5	12'-4"	257	wV	22	#5	13'-4"	306	wV	24	#5	14'-4"	359	wV	26	#5	15'-8"	425
Reinfo	rcing St	eel	Lb	3,099	Reinfo	orcing St	teel	Lb	3,231	Reinfo	orcing St	eel	Lb	3,503	Reinfo	orcing St	teel	Lb	3,651	Reinfo	orcing S	teel	Lt	3,966
Class	"C" Conc	rete	CY	15.2	Class	"C" Cond	rete	СҮ	16.6	Class	"C" Conc	rete	CY	18.1	Class	"C" Conc	rete	CY	19.7	Class	"C" Cond	crete	C)	21.6

# TABLES OF ESTIMATED QUANTITIES WITH 3:1 HEADER SLOPE 12


	TYPE	Tx2	8 Girder	5		ΤΥΡΕ	Tx3	4 Girders	;		ТҮРЕ	Tx40	) Gir	ders			ΤΥΡ
Bar	No.	Size	Length	Weight	Bar	No.	Size	Length	Weight	Bar	No.	Size	Len	igth	Weight	Bar	No.
Α	10	#11	25'-0"	1,328	A	10	#11	25'-0"	1,328	А	10	#11	25'	-0"	1,328	Α	10
D(7)	2	#9	1'-8"	11	D(7)	2	#9	1'-8"	11	D(7)	2	#9	1'-	-8''	11	D(7)	) 2
H	8	#6	25'-8''	308	Н	8	#6	25'-8''	308	н	10	#6	25'	-8"	386	Н	10
L	18	#6	4'-0''	108	L	18	#6	4'-0''	108	L	18	#6	4'-	-0"	108	L	18
5	22	#5	11'-6"	264	5	22	#5	11'-6"	264	S	22	#5	11'	-6"	264	5	22
U	4	#6	8'-1"	49	U	4	#6	8'-1"	49	U	4	#6	8'-	-1"	49	U	4
V	25	#5	11'-4''	296	V	25	#5	12'-4''	322	V	25	#5	13'	-4"	348	V	25
wH1	14	#6	13'-5"	282	wH1	14	#6	14'-5"	303	wH1	14	#6	16'	-5"	345	wH1	14
wH2	20	#6	11'-8"	350	wH2	20	#6	12'-8''	381	wH2	24	#6	14'	-8"	529	wH2	24
wS	26	#4	7'-10''	136	wS	28	#4	7'-10"	147	wS	32	#4	7'-	10"	167	wS	34
wV	26	#5	11'-4"	307	wV	28	#5	12'-4"	360	wV	32	#5	13'	-4"	445	wV	34
														i			
Reinfo	orcing St	eel	Lb	3,439	Reinfo	orcing St	teel	Lb	3,581	Reinfo	rcing St	teel		Lb	3,980	Reinfo	orcing
Class	"C" Conc	rete	СҮ	17.8	Class	"C" Conc	crete	CY	19.3	Class	"C" Conc	rete		СҮ	21.7	Class	"C" Cc


⑦ Omit Dowels D at end of multi-span unit. Adjust reinforcing steel total accordingly.

Quantities shown are for one abutment only (with approach slab). With no approach slab, add 1.0 CY Class "C" concrete and 154 lbs reinforcing steel for 4 additional Bars H.

	ΤΥΡΕ	Tx4	6 Gir	ders			
	No.	Size	Len	gth	Weight		
	10	#11	25'	5'-0" 1,3.			
7)	2	#9	1'-	-8"	11		
	10	#6	25'	-8"	386		
	18	#6	4'-	-0"	108		
	22	#5	11'	-6"	264		
	4	#6	8'-	49			
	25	#5	14'	374			
	14	#6	17'	366			
	24	#6	15'	565			
	34	#4	7'-	178			
	34	#5	14'	-4"	508		
nf o	orcing St	Lb	4,137				
55	"C" Conc	СҮ	23.4				

	ΤΥΡΕ	Tx5	4 Gir	ders	
Bar	No.	Size	Len	igth	Weight
А	10	#11	25'	-0"	1,328
D(7)	2	#9	1'-	-8"	11
Н	12	#6	25'	-8"	463
L	18	#6	4'-	-0"	108
5	22	#5	11'	-6"	264
U	4	#6	8'-	49	
V	25	#5	15'	-8"	409
wH1	14	#6	19'	-5"	408
wH2	28	#6	17'	-8"	743
wS	38	#4	7'-	10"	199
wV	38	#5	15'	-8"	621
Reinfo	4,603				
Class	"C" Conc	rete		СҮ	26.4

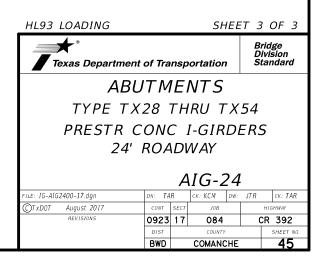

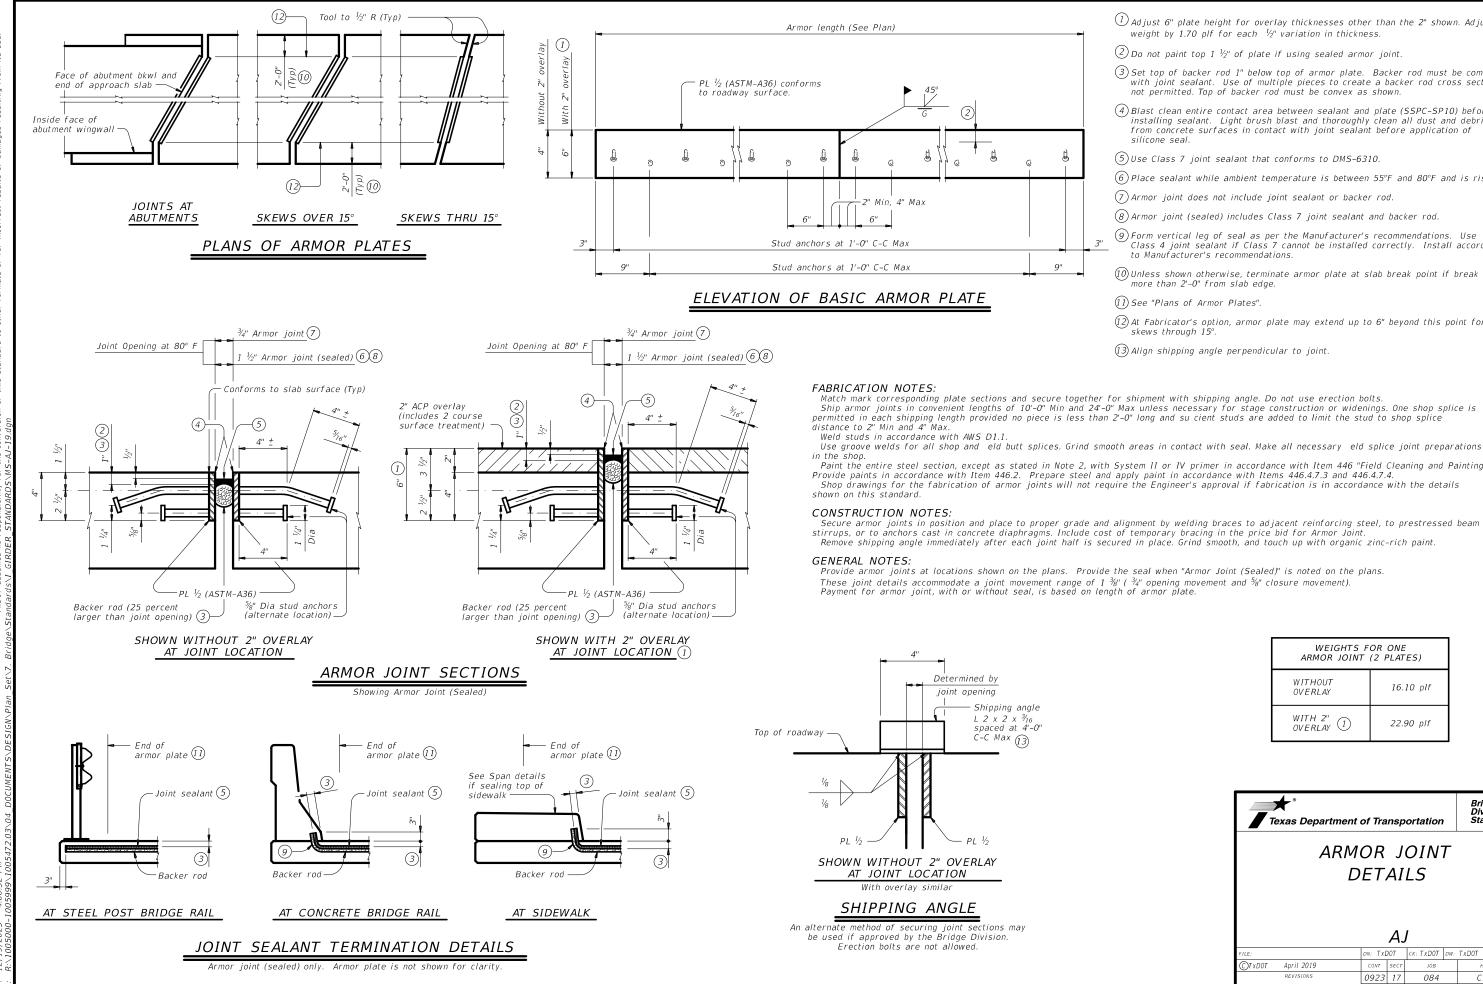


- (1) Adjust 6" plate height for overlay thicknesses other than the 2" shown. Adjust weight by 1.70 plf for each  $\frac{1}{2}$ " variation in thickness.
- (2) Do not paint top 1  $\frac{1}{2}$ " of plate if using sealed armor joint.
- 3 Set top of backer rod 1" below top of armor plate. Backer rod must be compatible with joint sealant. Use of multiple pieces to create a backer rod cross section is not permitted. Top of backer rod must be convex as shown.
- (4) Blast clean entire contact area between sealant and plate (SSPC-SP10) before installing sealant. Light brush blast and thoroughly clean all dust and debris from concrete surfaces in contact with joint sealant before application of silicone seal.
- (5) Use Class 7 joint sealant that conforms to DMS-6310.
- (6) Place sealant while ambient temperature is between 55°F and 80°F and is rising.
- (7) Armor joint does not include joint sealant or backer rod.
- (8) Armor joint (sealed) includes Class 7 joint sealant and backer rod.
- (9) Form vertical leg of seal as per the Manufacturer's recommendations. Use Class 4 joint sealant if Class 7 cannot be installed correctly. Install according to Manufacturer's recommendations.
- (10) Unless shown otherwise, terminate armor plate at slab break point if break is more than 2'-0" from slab edge.
- (11) See "Plans of Armor Plates".
- (2) At Fabricator's option, armor plate may extend up to 6" beyond this point for skews through 15°.
- (13) Align shipping angle perpendicular to joint.
- Ship armor joints in convenient lengths of 10'-0" Min and 24'-0" Max unless necessary for stage construction or widenings. One shop splice is permitted in each shipping length provided no piece is less than 2'-0" long and su cient studs are added to limit the stud to shop splice
- Use groove welds for all shop and eld butt splices. Grind smooth areas in contact with seal. Make all necessary eld splice joint preparations
- Paint the entire steel section, except as stated in Note 2, with System II or IV primer in accordance with Item 446 "Field Cleaning and Painting Steel." Provide paints in accordance with Item 446.2. Prepare steel and apply paint in accordance with Items 446.4.7.3 and 446.4.7.4. Shop drawings for the fabrication of armor joints will not require the Engineer's approval if fabrication is in accordance with the details
- Remove shipping angle immediately after each joint half is secured in place. Grind smooth, and touch up with organic zinc-rich paint.

WEIGHTS FOR ONE ARMOR JOINT (2 PLATES)						
WITHOUT OVERLAY	16.10 plf					
WITH 2" OVERLAY	22.90 plf					

	╈ exas Department d	of Trans <sub>i</sub>	portation	1	Di	idge vision andard				
	ARMOR JOINT									
	D	ETA	ILS							
		A	J							
FILE:		A	- -	DW:	TxD0T	ск: TxD0T				
FILE: ©T XDOT	April 2019	, , ,	ск: TxD0T	DW:	-	ск: TxD0T нібнwav				
	April 2019 Revisions	DN: ТхDOT	ск: TxDOT JOB	DW:	/					
	1	DN: TXDOT CONT SECT	ск: TxDOT JOB		/	HIGHWAY				

Varies Varies Limit of CSB (1)► Limit of CSB ① Wingwall -MSE retaining wall Select II zone (MSE walls) -Bridge -Bridge deck deck --Cement stabilized back II 5 Embankment stabilized area back II (4)(5)Varies /aries ar (A)Face of Face of abut bkwl abut bkwl Select II zone (MSE walls) Wingwall MSE retaining wall OPTION 1 ~ PLAN WITH WINGWALLS OPTION 1 ~ PLAN WITH MSE RETAINING WALLS Cast-in-place retaining walls similar. Pavement thickness Typ pavement See appropriate details End of section elsewhere for dimension End of End of approach Bridge wingwall (1) wingwall (1)approach slab slab Pavement -No steeper than 1:1 1 No steeper, than 1:1 (1) (2) -Cement stabilized back II 5 Cement stabilized (2) 2'-0" 2'-0" Abutment -Abutment -WITHOUT APPROACH SLAB WITH APPROACH SLAB (Showing BAS-C, BAS-A similar.) SECTION A-A

whatso its use. anty of any kind is made by TxDOT for any purpose or for incorrect results or damages resulting from No warr. formats Act". other RDER\_ ΜŠ 4:00:53 f -1005999\ 

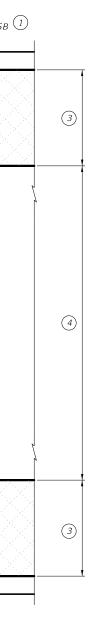

- (1) Usual limit of Cement Stabilized Back II is at end of wingwall. Extend CSB limits as required to maintain a slope no steeper than 1:1 at bottom of back II.
- Bench back II as shown with 12" (approximate) bench depths.
- (3) Where MSE retaining walls are present, adjust CSB limits to accommodate the select II zone. See retaining wall details for additional information.
- When distance between select II zones is less than 5'-0", MSE select II may be substituted for cement stabilized back II with approval from the Engineer.
- (5) If shown in the plans, owable back II can be used as a substitute for cement stabilized back II with the following constraints:

constraints: a). If owable back II is to be placed over MSE back II, then a Iter fabric will be placed over the MSE back II prior to placement of the owable II; and b). Place owable II in lifts not exceeding 2 feet in height. Place each successive lift when the previous lift has sti ened/hardened (i.e. has lost its owability).

### GENERAL NOTES:

See the Bridge Layout for selected Option. Option 1 is intended for construction only requiring plasticity index (PI) controlled embankment II or excavation in competent soils/rocks in order to construct the abutment. Option 2 is intended for new construction requiring high plasticity embankment II with a PI greater than 30 or pavement built in poor native soil. Poor soils are de ned as high plasticity clays or expansive clays.

Construct abutment back II in accordance with Item 400, "Excavation and Back II for Structures". Provide Cement Stabilized Back II (CSB) meeting the requirements of Item 400, "Excavation and


Back II for Structures", to the limits shown at bridge abutments. If required elsewhere in the plans, provide

Flowable Back II meeting the requirements of Item 401, "Flowable Back II", to the limits shown at bridge abutments.

Details are drawn showing left forward skew. See Bridge Layout for actual skew direction. These details do not apply when Concrete Block


retaining walls are used in lieu of wingwalls.

SHEET 1 OF 2									
Texas Department of Transportation Standard									
ABUTME	CEMENT STABILIZED ABUTMENT BACKFILL BRIDGE ABUTMENT								
		С.	SAB						
FILE: MS-CSAB-23.dgn	DN: TX	DOT	ск: ТхДОТ	DW:	TxD0T	ск: ТхДОТ			
CTxDOT April 2019	CONT SECT JOB HIGHWAY								
REVISIONS	0923 17 084 CR 392								
02-20: Added Option 2. 03-23: Updated General Notes.	DIST		COUNTY			SHEET NO.			
	BWD		COMANC	ΉĒ		47			

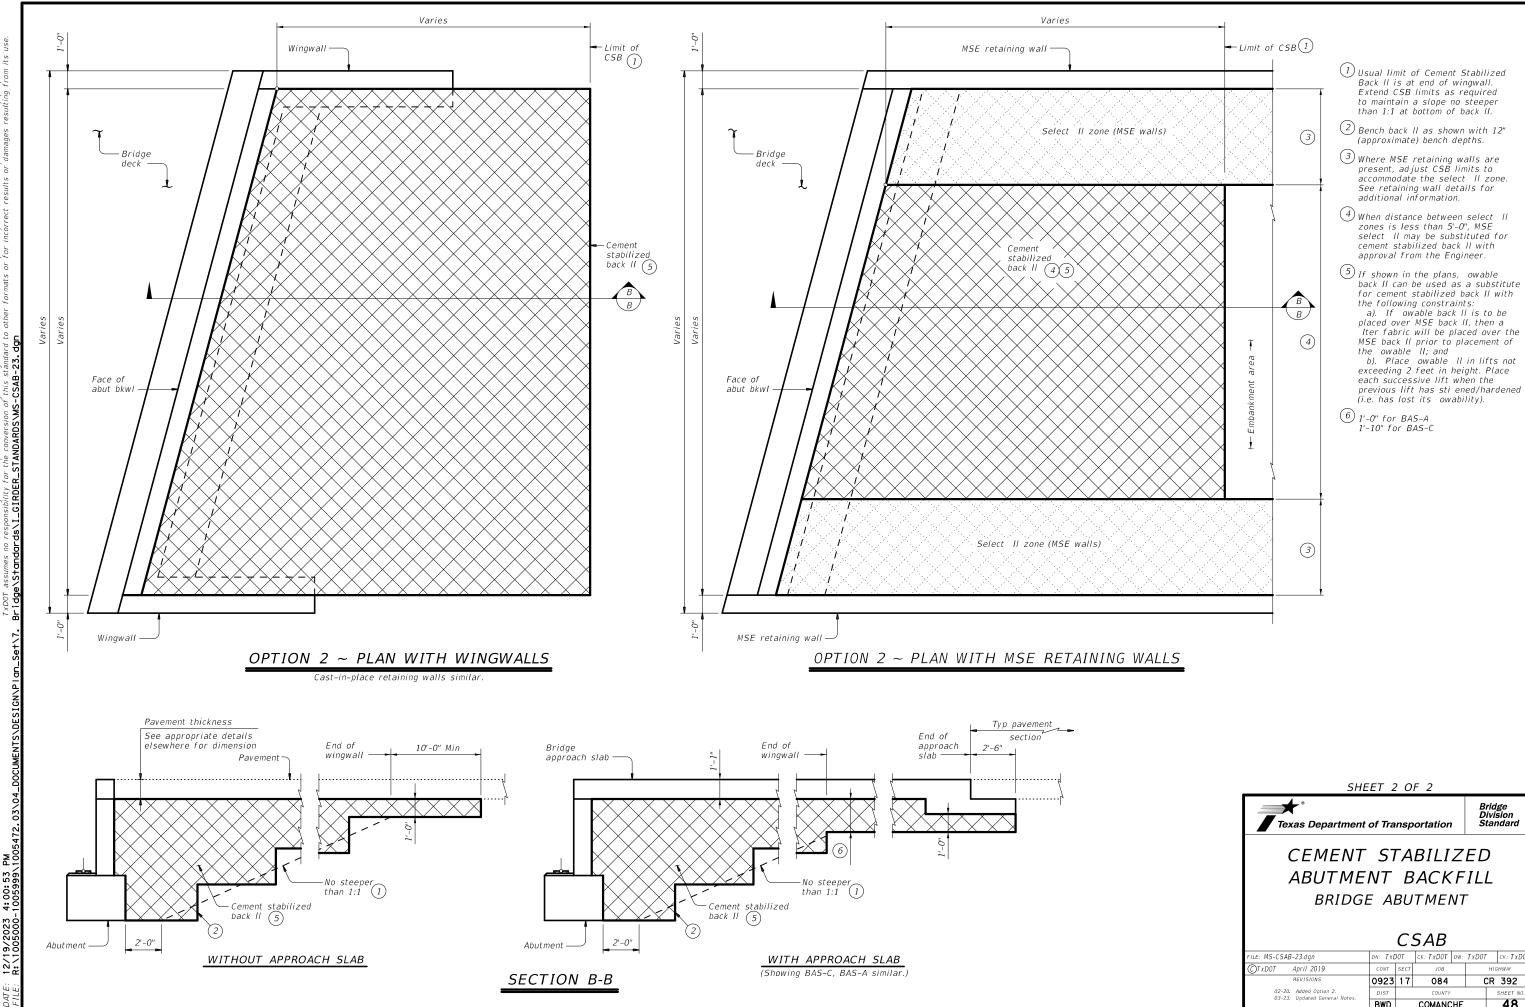


whatso its use. No warranty of any kind is made by TxDOT for any purpose formats or for incorrect results or damages resulting from ractice Act". ard to other Engineering Pro of this standar AS-CSAB-23. d the "Texas Eng conversion of NDARDS\MS-I the sta nsibility for \_GIRDER\_S respoi his DIS( Μd 12/19/2023 4:00:53 R:\1005000-1005999\

SHEET 2 OF 2								
Texas Department of Transportation								
CEMENT ABUTME BRIDGE	NT	В	ACK	F	ILL			
		С.	SAB					
FILE: MS-CSAB-23.dgn	DN: TX	DOT	ск: ТхДОТ	DW:	TxD0T	ск: ТхДОТ		
CTxDOT April 2019	CTXDOT April 2019 CONT SECT JOB HIGHWAY							
REVISIONS 0923 17 084 CR 392								
02-20: Added Option 2. 03-23: Updated General Notes.	DIST		COUNTY			SHEET NO.		
05-25. Optialed General Notes.	BWD		COMANC	ΉE		48		

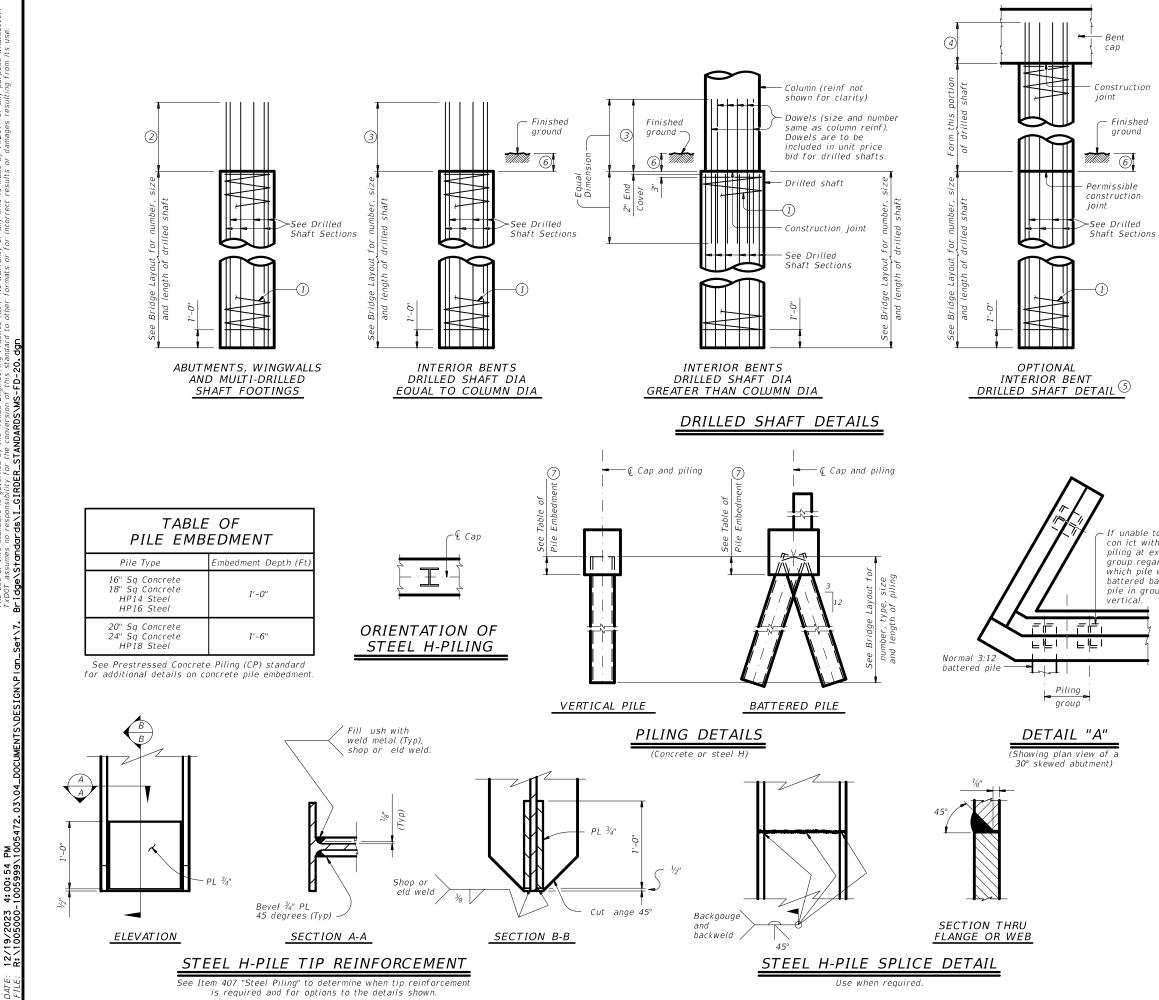

No warranty of any kind is made by TxDOT for any purpose whatso formats or for incorrect results or damages resulting from its use. Act". other ice to IRDER\_ this 4:00:54 PM -1005999\100

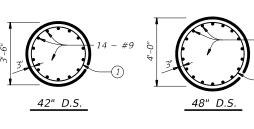


#9

DRILLED SHAFT SECTIONS


(1)



18 ~ #9

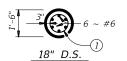



30" D.S.

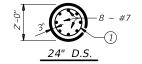

- If unable to avoid con ict with wingwall piling at exterior pile group regardless of which pile would be battered back, one pile in group may be

- 1) #3 spiral at 6" pitch (one and a half at turns top and bottom).
- ② Min extension into supported element: #6 Bars = 1'-11" #7 Bars = 2'-0" #9 Bars = 2'-3"
- ③ Min lap with column reinf: #7 Bars = 2'-11" #9 Bars = 3'-9" #11 Bars = 4'-8"
- (4) Min extension into supported element: #6 Bars = 1'-11" #7 Bars = 2'-3" #9 Bars = 2'-9"
- 5 Drilled shafts may extend to the bottom of bent caps for "H" heights of 6 ft and less (as shown on the Bridge Layout), if approved. This option can only be used when the drilled shaft diameter equals the column diameter. Obtain approval of the forming method above the ground line prior to construction. No adjustments in payment will be made if this option is used.
- ⑥ 1'-0" Min, unless shown otherwise on plans.
- 🕖 Or as shown on plans.

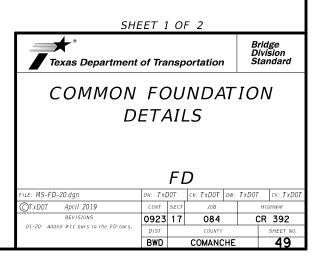

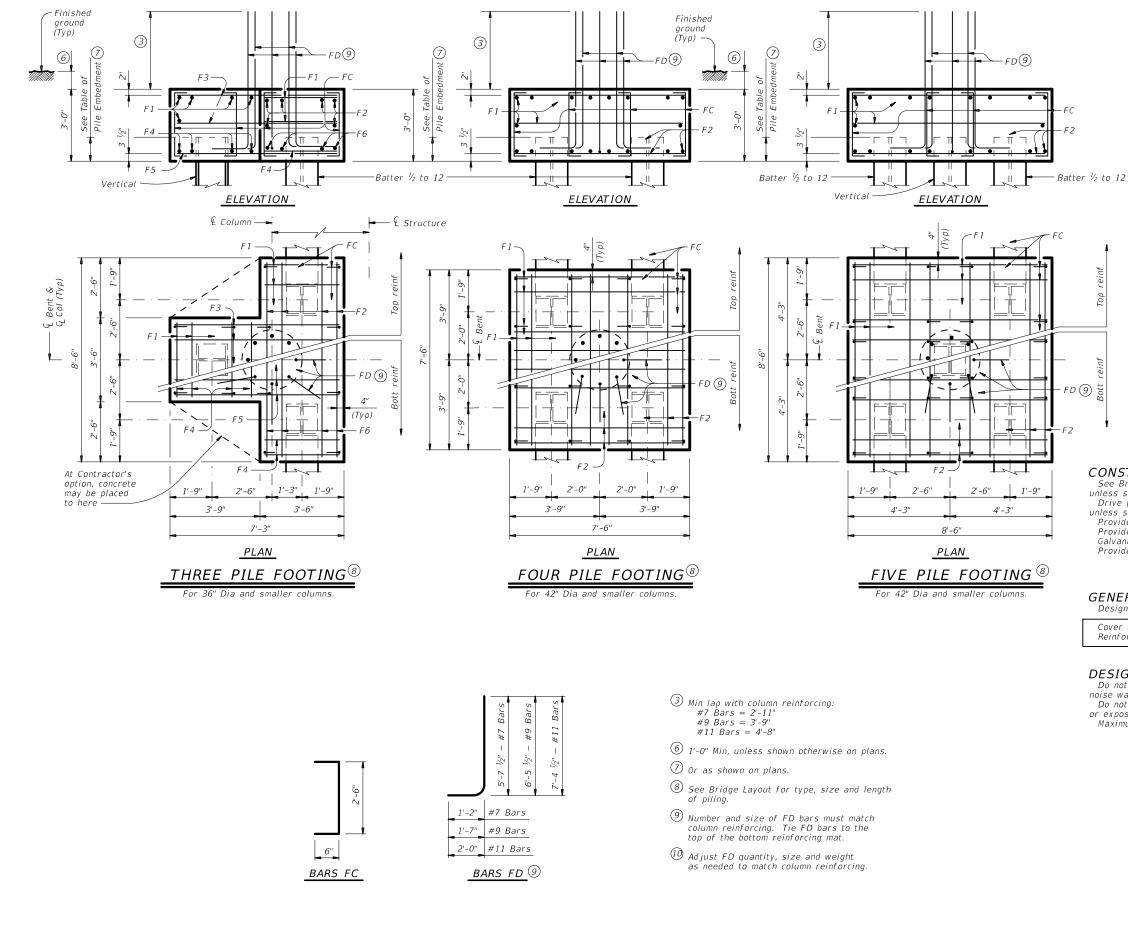

No warranty of any kind is made by TxDOT for any purpose whatso formats or for incorrect results or damages resulting from its use. Act". other to e by IRDER\_ respon **is\I**\_ sta this DISC The 12/19/2023 4:00:55 PM R:\1005000-1005999\10C DATE:

TABLE OF FOOTING
QUANTITIES FOR
<i>30" COLUMNS</i>

ONE 3 PILE FOOTING									
Bar	No.	Size	Lengt	Weight					
F 1	11	#4	3'- 2	"	23				
F2	6	#4	8'- 2	"	33				
F3	6	#4	6'- 11	l″	28				
F4	8	#9	3'- 2	"	86				
F5	4	#9	6'- 11	l"	94				
F6	4	#9	8'- 2	"	111				
FC	12	#4	3'- 6	"	28				
FD 10	8	#9	8'- 1	"	220				
Reinf	orcing	Steel		Lb	623				
Class	"С" Сс	oncrete		СҮ	4.8				
		ONE 4	PILE FOOT	「ING					
Bar	No.	Size	Lengt	h	Weight				
F 1	20	#4	7'- 2	"	96				
F2	16	#8	7'- 2	"	306				
FC	16	#4	3'- 6	"	37				
FD 1 Ø	8	#9	8'- 1	"	220				
Reinf	orcing	Steel		Lb	659				
Class	"С" Сс	oncrete		СҮ	6.3				
		ONE 5	PILE FOOT	FING					
Bar	No.	Size	Lengt	h	Weight				
F 1	20	#4	8'- 2	"	109				
F2	16	#9	8'- 2	"	444				
FC	24	#4	3'- 6	"	56				
FD 🚺	8	#9	8'- 1	"	220				
Reinf	orcing	Steel		Lb	829				
Class	"С" Сс	oncrete		СҮ	8.0				

### CONSTRUCTION NOTES:

See Bridge Layout for foundation type required. Use these foundation details unless shown otherwise.

Drive piling under abutment wingwalls to a minimum resistance of 10 Tons/Pile unless shown otherwise.

Provide Class C Concrete (f'c = 3,600 psi), unless shown otherwise. Provide Grade 60 reinforcing steel. Galvanize reinforcing if shown elsewhere in the plans.

Provide bar laps for drilled shaft reinforcing, where required, as follows: Uncoated or galvanized (#6) ~ 2'-6" Uncoated or galvanized (#7) ~ 2'-11" Uncoated or galvanized (#9) ~ 3'-9"

GENERAL NOTES: Designed according to AASHTO LRFD Bridge Design Speci cations.

Cover dimensions are clear dimensions, unless noted otherwise. Reinforcing bar dimensions shown are out-to-out of bar.


**DESIGNER NOTES:** Do not use the drilled shaft details shown on this standard for retaining wall,

Do not use the footings shown on this standard in direct contact with salt water or exposed to salt water spray.

Maximum allowable pile loads for the footings shown are:

72	Tons/Pile	with	24"	Dia	Columns
80	Tons/Pile	with	30"	Dia	Columns
100	Tons/Pile	with	36"	Dia	Columns
120	Tons/Pile	with	42"	Dia	Columns


of Tra	nsp	ortation	,		lge sion ndard		
COMMON FOUNDATION DETAILS							
	ΗL	)					
DN: TXL	DOT	ск: ТхДОТ	DW:	TxD0T	ск: ТхD0Т		
CONT	SECT	JOB		HI	GHWAY		
0923	17	084		CR	392		
DIST		COUNTY			SHEET NO.		
BWD		COMANC	HE		50		
	FC ET A DN: Tx[ CONT 0923 DIST	FOU ETAIL FL DN: TXD0T CONT SECT 0923 17 DIST	FOUNDA ETAILS by: TxDot cs: TxDot cont sect job 0923 17 084 dist county	FD           DNI: T.X.DOT         CKI: T.X.DOT         DWI:           CONT         SECT         JOB           0923         17         084           DIST         COUNTY         COUNTY	of Transportation FOUNDATION FOUNDATION ETAILS PM: TXDOT CK: TXDOT OW: TXDOT CONT SECT JOB ИН 0923 17 084 СК DIST ССИЛТУ		

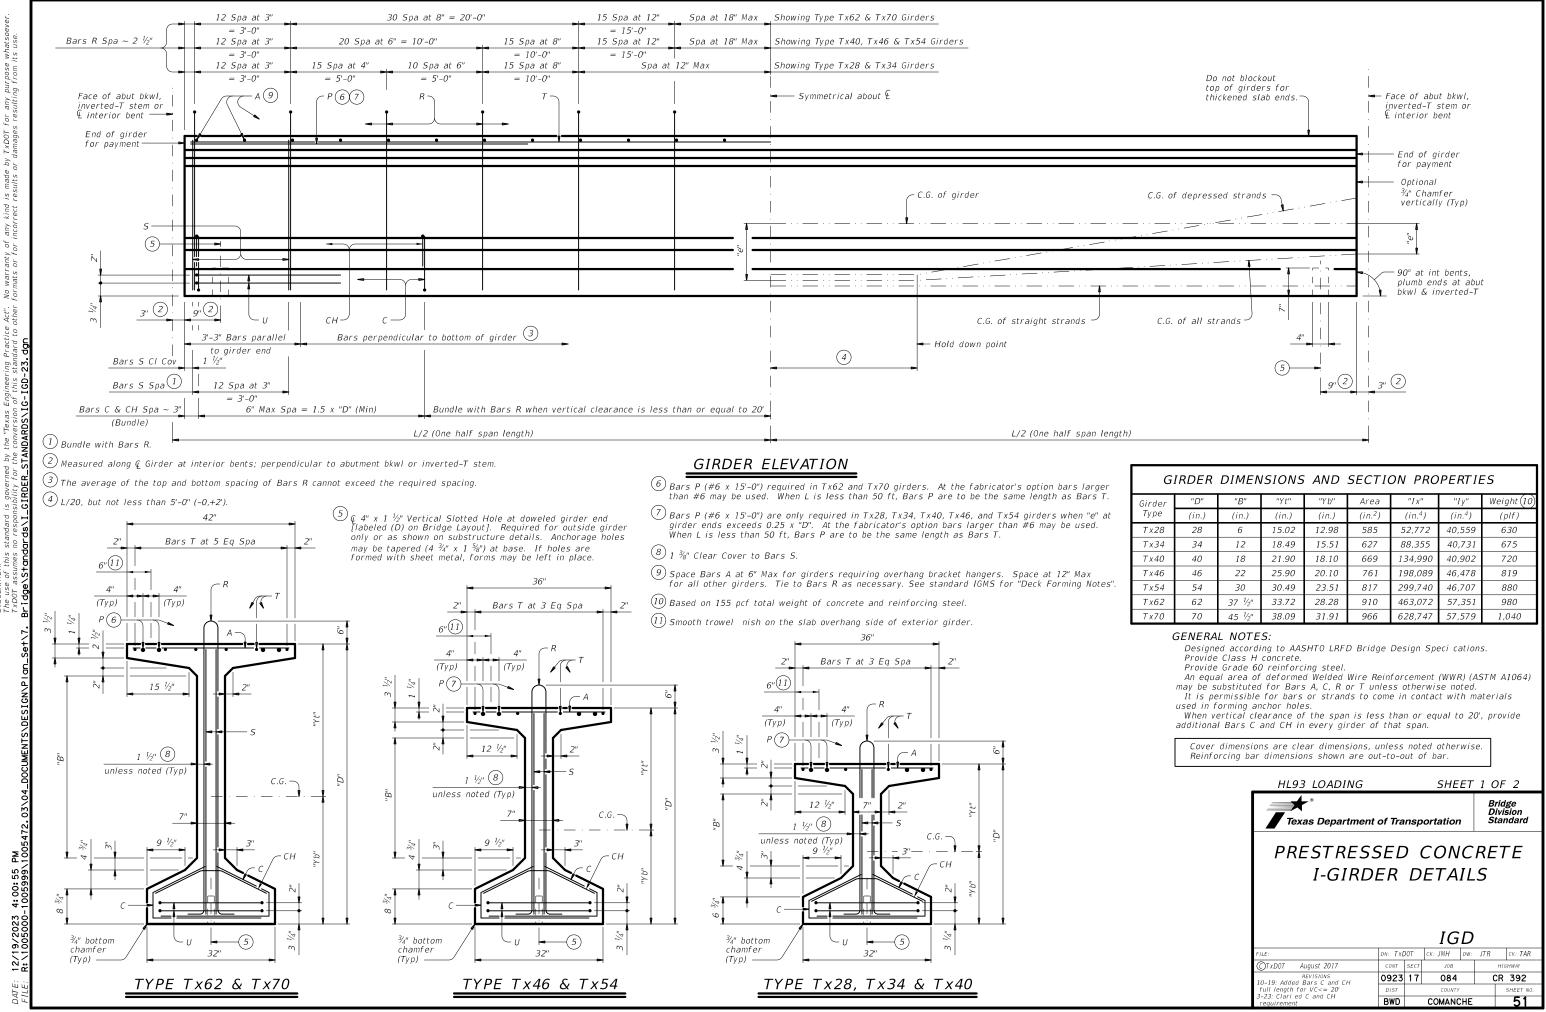

for

No


GIRDER DIMENSIONS AND SECTION PROPERTIES										
Girder	"D"	"B"	"Yt"	"Y b"	Area	"I x"	"Iy"	Weight (10)		
Туре	(in.)	(in.)	(in.)	(in.)	(in.²)	(in.4)	(in. <sup>4</sup> )	(plf)		
T x 28	28	6	15.02	12.98	585	52,772	40,559	630		
Tx34	34	12	18.49	15.51	627	88,355	40,731	675		
Tx40	40	18	21.90	18.10	669	134,990	40,902	720		
Tx46	46	22	25.90	20.10	761	198,089	46,478	819		
Tx54	54	30	30.49	23.51	817	299,740	46,707	880		
Tx62	62	37 <sup>1</sup> /2"	33.72	28.28	910	463,072	57,351	980		
Tx70	70	45 ½"	38.09	31.91	966	628,747	57,579	1,040		

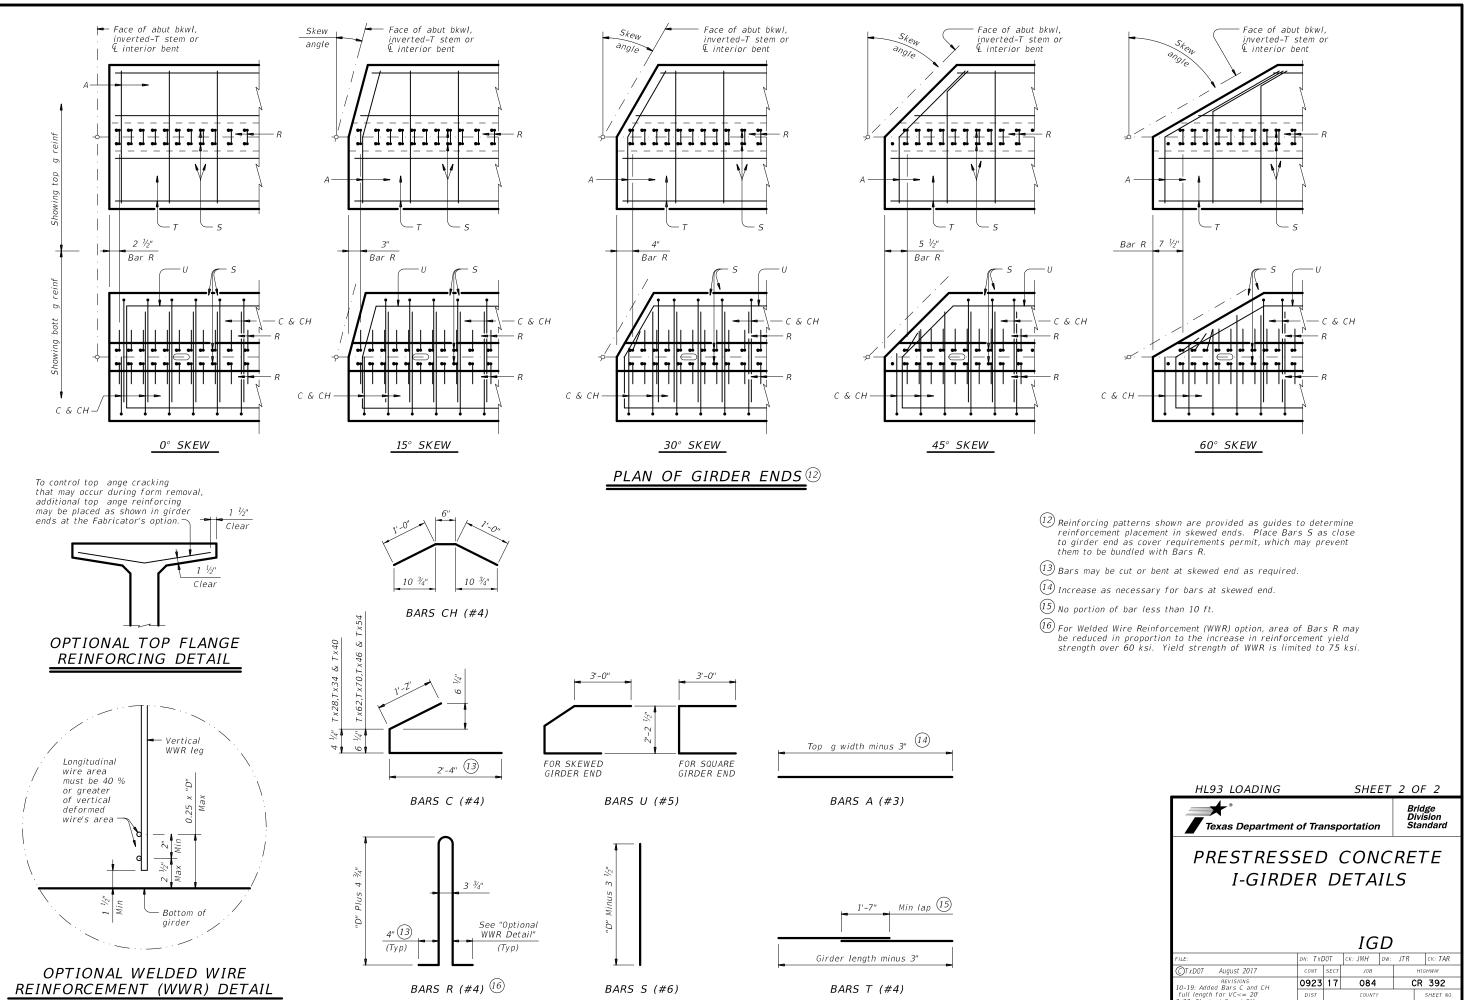

e whatso its use. No warranty of any kind is made by TxDOT for any purpose formats or for incorrect results or damages resulting from Act". other ice to 29 RDF his DIS( The Σç 4:00:56 F -1005999\1 12/19/2023 B: \1005000-


DATE:

_						
FILE:	DN: TXD	DOT	ск: ЈМН	DW:	JTR	ск: TAR
©TxDOT August 2017	CONT	SECT	JOB		ŀ	HIGHWAY
REVISIONS 10-19: Added Bars C and CH	0923	17	084		CI	7392
full length for VC<= 20' 3-23: Clari ed C and CH	DIST		COUNTY			SHEET NO.
requirement	BWD		COMANC	HE		52

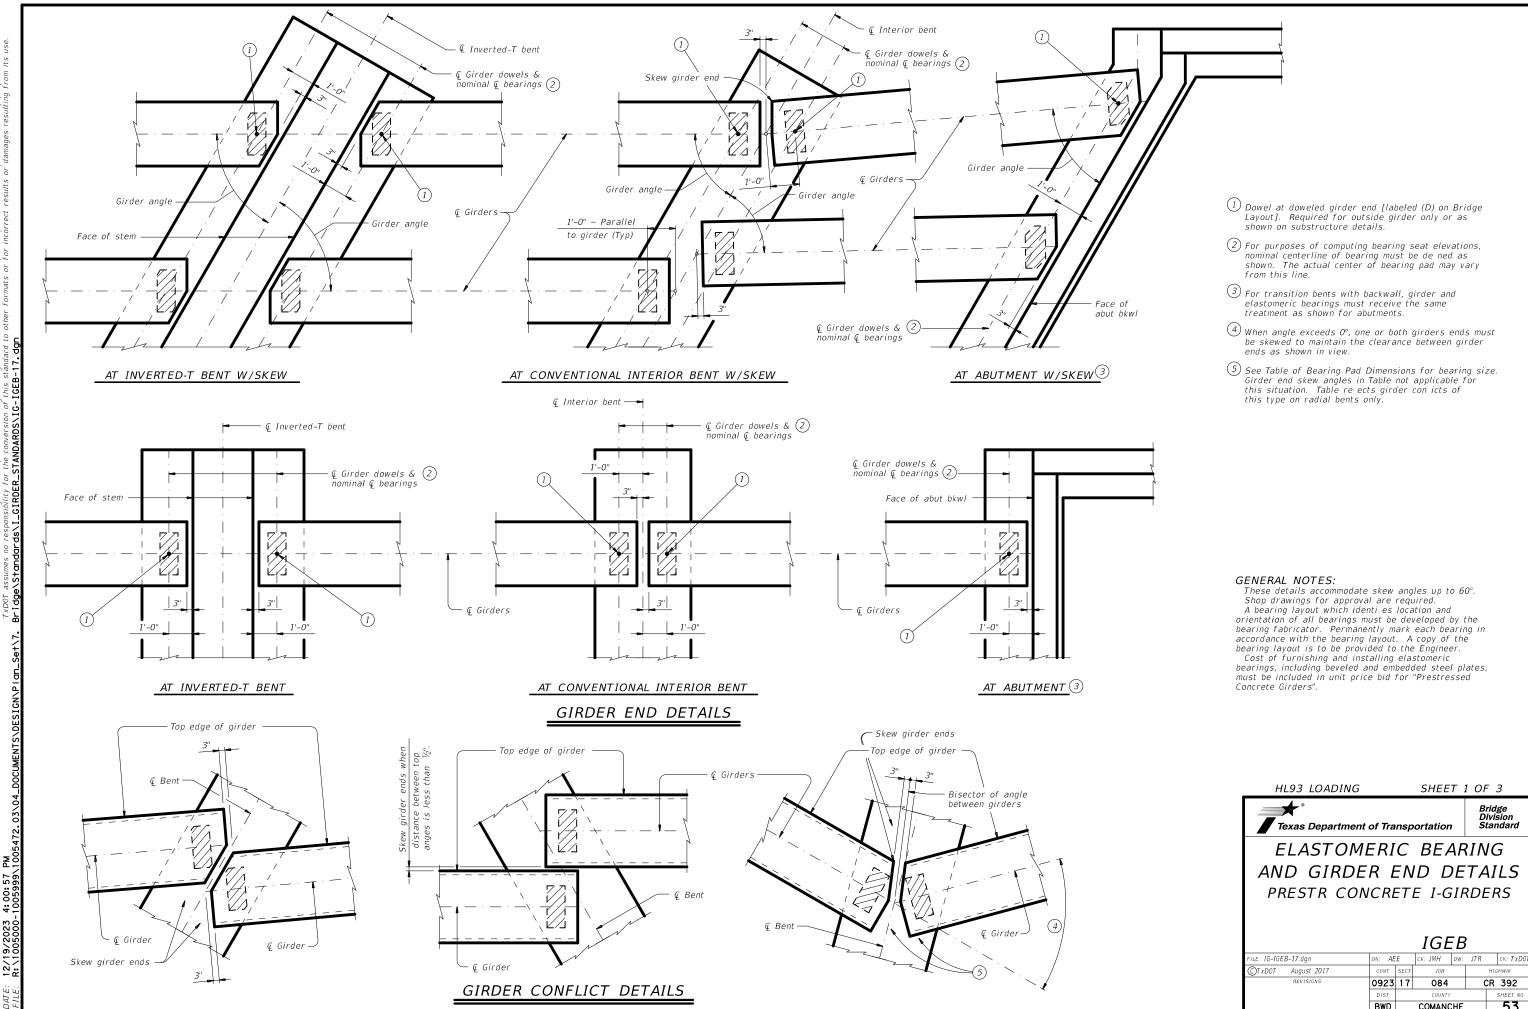

No warranty of any kind is made by TxDOT for any purpose whatso formats or for incorrect results or damages resulting from its use. Act". other actice governe bility fo IRDER\_ respon stai this this AIMER Se of DISC The ( TXD0 12/19/2023 4:00:57 PM R:\1005000-1005999\100

HL93 LOADING			SHEE	Т	1 OF	3			
Texas Department of Transportation									
FILE: IG-IGEB-17.dgn	DN: AE	E	ск: ЈМН	DW:	JTR	ск: ТхДОТ			
CTxDOT August 2017	CONT	SECT	JOB			HIGHWAY			
REVISIONS	0923	17	084		C	R 392			
	DIST		COUNTY			SHEET NO.			
	BWD		COMANC	HE		53			

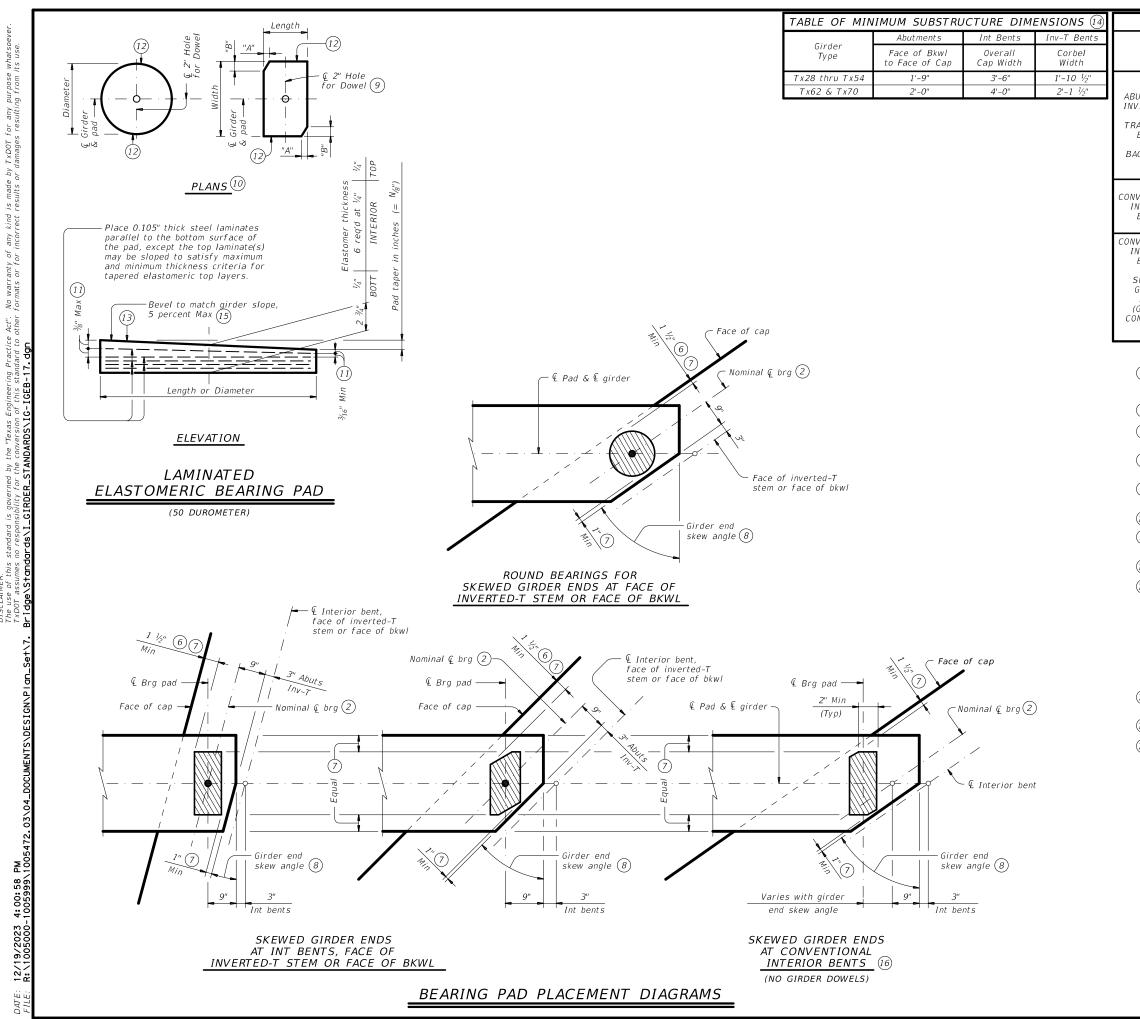

his

TABLE OF BEARING PAD DIMENSIONS										
Bent Type	Girder Type	Bearing Type	Girder End Skew Angle	Pad Size Lgth x Wdth	Pad Dimen					
type	type	(13)	Range	Egen x math	"A"	"B"				
		G-1-"N"	0° thru 21°	8" x 21"						
BUTMENTS, VERTED-T	Т x 28,Т x 34, Т x 40.Т x 46	G-2-"N"	21°+ thru 30°	8" x 21"	1 1/2"	2 ½"				
	& Tx54	G-3-"N"	30°+ thru 45°	9" x 21"	4 ½"	4 ½"				
AND RANSITION		G-4-"N"	45°+ thru 60°	15" Dia						
BENTS		G-5-"N"	0° thru 21°	9" x 21"						
WITH	Т x62 &	G-6-"N"	21°+ thru 30°	9" x 21"	1 1/2"	2 ½"				
ACKWALLS	Тх70	G-7-"N"	30°+ thru 45°	10" x 21"	4 ½"	4 ½"				
		G-8-"N"	45°+ thru 60°	10" x 21"	7 ¼″	4 <sup>1</sup> / <sub>4</sub> "				
	Tx28,Tx34,									
IVENTIONAL INTERIOR	Tx40,Tx46									
BENTS	& Tx54	G-1-"N"	0° thru 60°	8" x 21"						
	Tx62 & Tx70	G-5-"N"	0° thru 60°	9" x 21"						
IVENTIONAL		G-1-"N"	0° thru 18°	8" x 21"						
NTERIOR BENTS	Т x 28,Т x 34, Т x 40.Т x 46	G-2-"N"	18°+ thru 30°	8" x 21"	1 1/2"	2 ½"				
WITH	& Tx54	G-9-"N"	30°+ thru 45°	8" x 21"	3"	3"				
SKEWED		G-10-"N"	45°+ thru 60°	9" x 21"	6"	3 1/2"				
GIRDER ENDS		G-5-"N"	0° thru 18°	9" x 21"						
(GIRDER	Т x62 &	G-5-"N"	18°+ thru 30°	9" x 21"						
ONFLICTS)	т <i>х</i> 70	G-11-"N"	30°+ thru 45°	9" x 21"	1 1/2"	1 1/2"				
(16)		G-12-"N"	45°+ thru 60°	9" x 21"	3"	1 3⁄4"				

2 For purposes of computing bearing seat elevations, nominal centerline of bearing must be de ned as shown. The actual center of bearing pad may vary from this line.

6 3" for inverted-T.

7 Place centerline pad as near nominal centerline bearing as possible between limits shown.

(8) Girder end skew angle is equal to 90° minus the girder angle except at some con icting girders.

(9) Provide 2" dia hole only at locations required. See Substructure details for location.

(10) See Table of Bearing Pad Dimensions for dimensions.

(11) Maximum and minimum layer thicknesses shown are for elastomer only, on tapered layers.

(12) Locate Permanent Mark here.

 $\fbox{13}$  Indicate BEARING TYPE on all pads. For tapered pads, locate BEARING TYPE on the high side. The Fabricator must include the value of "N" (amount of taper in  $\frac{1}{8}$ " increments) in this mark. Examples: N=0, (for 0" taper)

N=1, (for  $\frac{1}{8}$ " taper)

N=2, (for  $\frac{1}{4}$ " taper) (etc.)


Fabricated pad top surface slope must not vary from plan girder slope by more than  $\left(\begin{array}{c} 0.0625'' \\ 0.0625'' \end{array}\right)$  IN/IN. Length or Dia

 $\stackrel{(14)}{\longrightarrow}$  Substructure dimensions must satisfy the minimums provided to accommodate the elastomeric bearings shown on this standard.

(15) See sheet 3 of 3 for beveled plate use when slopes exceed 5 percent.

(16) If girder end is skewed for a girder con ict at an interior bent and a beveled sole plate is required, use bearing type for abutments at this location. Location of bearing centerline is to be set as for abutments in this case.


HL93 LOADING			SHEE	ΤŻ	2 OF	3
Texas Department	of Tra	nsp	ortatior	1	Div	dge rision Indard
ELASTOM	ERI	Ċ	BEA	4F	RIN	G
AND GIRDE	RE	ΞN	D D	)E	ΤA	ILS
PRESTR CON	ICRI	ET.	E I-G	ΞŦ	RDE	RS
			IGE	ΞB	}	
FILE: IG-IGEB-17.dgn	DN: AE	E	ск: ЈМН	DW:	JTR	ск: ТхДОТ
CTxDOT August 2017	CONT	SECT	JOB		H	IGHWAY
REVISIONS	0923	17	084		CF	₹ 392
	DIST		COUNTY	·		SHEET NO.
	BWD		COMANO	CHE		54

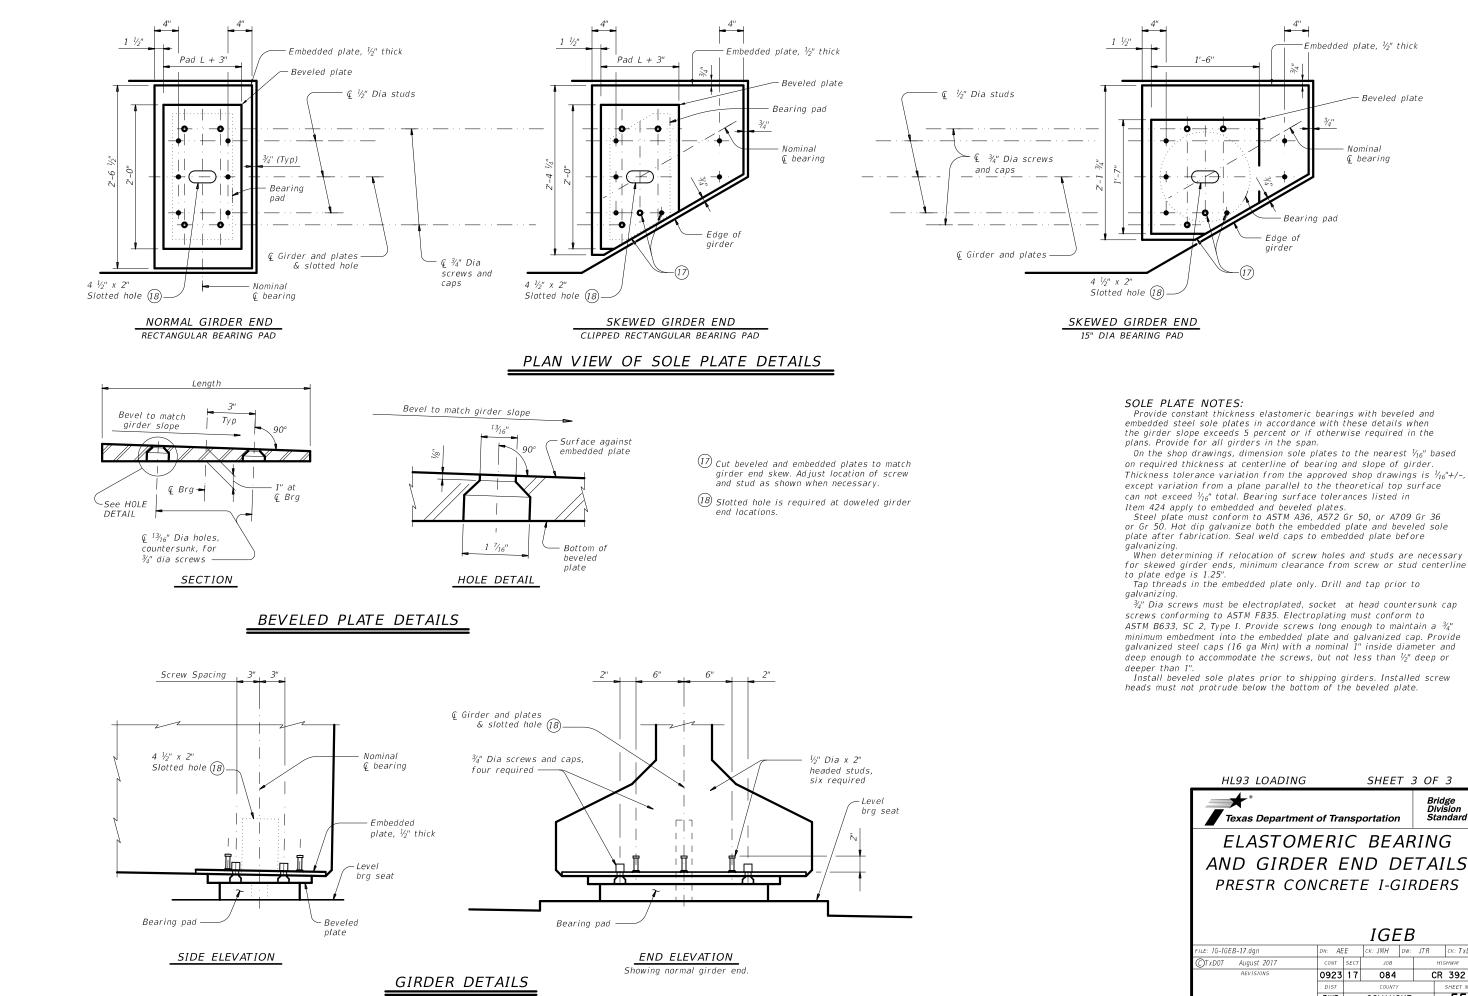



except variation from a plane parallel to the theoretical top surface


deep enough to accommodate the screws, but not less than  $\frac{1}{2}$  deep or

HL93 LOADING			SHEET	Г 3	3 OF	= 3
Texas Department	of Tra	nsp	ortation		D	ridge ivision tandard
ELASTOM	ERI	С	BEA	٩R	RIN	IG
AND GIRDE	RE	ΞN	D D	ΡĒ	ΤA	ILS
PRESTR CON	CRI	ΞT	E I-G	ĪF	RDE	RS
			IGE	B	1	
FILE: IG-IGEB-17.dgn	DN: AE	Ε	ск: ЈМН	DW:	JTR	ск: ТхD0Т
CTxDOT August 2017	CONT	SECT	JOB			HIGHWAY
REVISIONS	0923	17	084		C	R 392
	DIST		COUNTY			SHEET NO.
	BWD		COMANC	ΉE		55

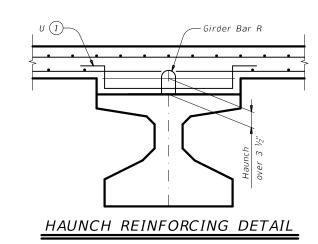

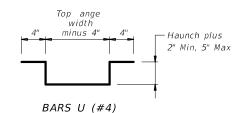


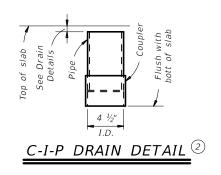

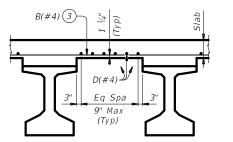


# TYPICAL PART TRANSVERSE SLAB SECTION WITHOUT PCP

Top reinforcing steel not shown for clarity.

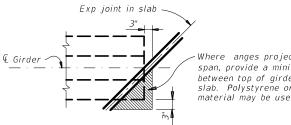



Where anges project under slab of adjacent span, provide a minimum of ½" clearance between top of girder and bottom of adjacent slab. Polystyrene or other suitable compressible material may be used as a ller.


# TREATMENT AT GIRDER END FOR SKEWED SPANS

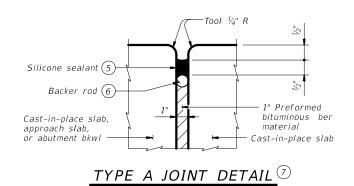

- (1) Space Bars U with girder Bars R in all areas where measured haunch exceeds 3  $\frac{1}{2}$ ".
- 2 Roughen outside of PVC with coarse rasp or equal to ensure bond with cast-in-place concrete.
- Bars B(#4) spaced at 9" Max with 2" end cover. Overhang option, Contractor's may end alternating bars B(#4) at centerline outside girder.
- (4) Provide Grade 60 reinforcing steel. Provide bar laps, where required, as follows: Uncoated ~ #4 = 1'-7" Epoxy coated ~ #4 = 2'-5"
- (5) Class 7 silicone sealant that conforms to DMS-6310. Install when ambient temperature is between 55°F and 85°F and rising. Engineer to determine allowable hours for sealant application.
- (6) 1 ¼" backer rod must be compatible with joint sealant. Use of multiple pieces to create a backer rod cross section is not permitted. Top of backer rod must be convex as shown.
- The maximum distance between Type A expansion joints is 100'. See Bridge Layout for location of joints.
- (8) Drain entrance formed in rail or sidewalk.
- ${\textcircled{9}}$  Water may not be discharged onto girders.
- (10) All drain pipe and ttings to be 4" diameter (Sch 40) PVC. See Item 481 "Pipe for Drains" for pipe, connections and solvent welding. Bend reinforcing steel to clear PVC 1". Drain length and location is as directed by the Engineer. Drains are not permitted over roadways or railways, or within 10-0" of bent caps. Degrease outside of exposed PVC, apply acrylic water base primer, then coat with same surface nishing material as used for outside girder face. Variations of the above designs, as required for the type of rail used and its location on the structure, may be installed with the approval and direction of the Engineer.

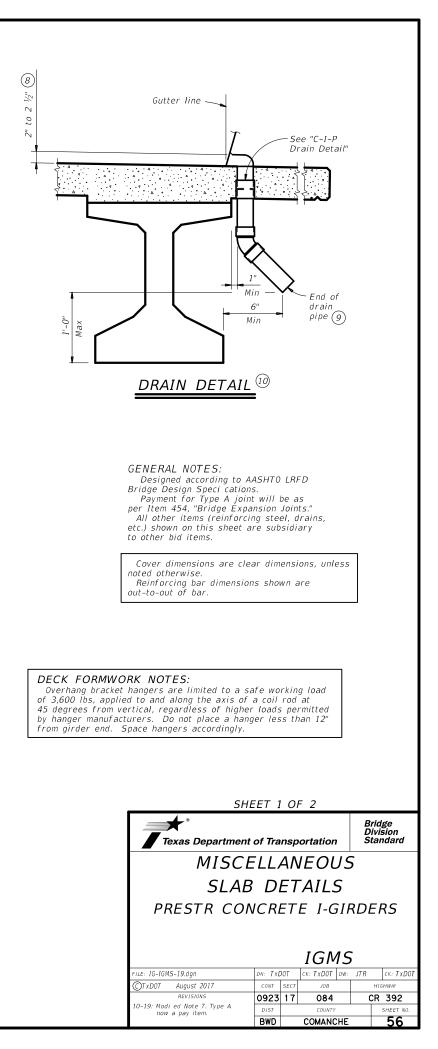

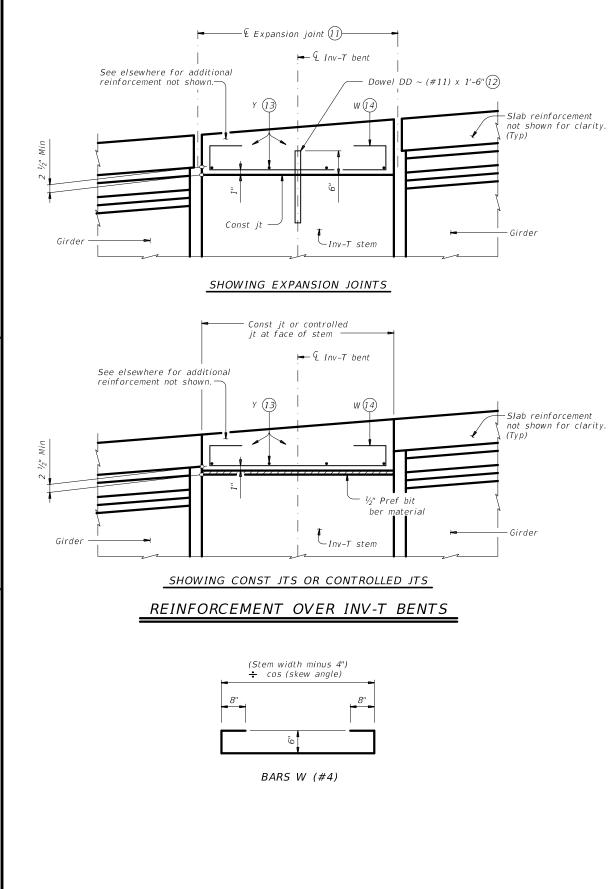

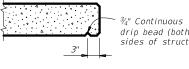

drip bead (both sides of struct)


DRIP BEAD DETAIL

1) See Layout for joint type.

2 Dowels DD (#11) spaced at 5 Ft Max. See Inv-T bents for quantity and location.

- (13) Space Bars Y (#4) at 12" Max. Use 2" end cover. Number of Bars Y must satisfy spacing limit. Place parallel to bent.
- (14) Space Bars W at 12" Max (3" from end of cap). Tilt if necessary to maintain cover requirements. Place parallel to longitudinal slab reinforcement.


15 See Span details for type of joint and joint locations.

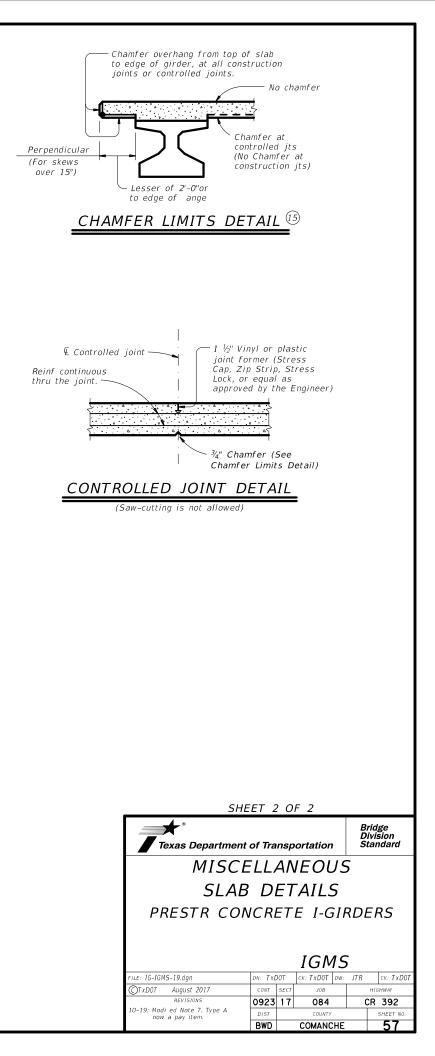

			DES	SIGNED	GIRDE	RS					ESSED	CONC	RETE		OPTIC	ONAL DESI	GN				ATING
STRUCTURE	SPAN	GIRDER	GIRDER	NON-		STRESSI	NG STRA			STF	RAND TERN	RELEASE	MINIMUM	DESIGN LOAD COMP	DESIGN LOAD	REQUIRED MINIMUM	DISTR	LOAD IBUTION	]	FACT	DRS
	NO.	NO.	TYPE	STD STRAND PATTERN	TOTAL NO.	SIZE	STRGTH fpu	"e" ⊈	"e" END	NO.	TO END	STRGTH 1 f'ci	28 DAY COMP STRGTH f'c	COMP STRESS (TOP @) (SERVICE I)	TENSILE STRESS (BOTT ©) (SERVICE III)	ULTIMATE MOMENT CAPACITY (STRENGTH I)		2)	STREN	GTH I	SERVICE III
				<b> </b> '		(in)	(ksi)	(in)	(in)		(in)	(ksi)	(ksi)	fct(ksi)	fcb(ksi)	(kip-ft)	Moment	Shear	Inv	0pr	Inv
	40 45	ALL ALL	Т x 28 Т x 28		10 12	0.6 0.6	270 270	10.48 10.48	10.48 10.48			4.000 4.500	5.000 5.000	1.055 1.332	-1.423 -1.744	1382 1525	0.670 0.650	0.850 0.850	1.56 1.58	2.02 2.05	1.98 1.79
	50	ALL	Tx28		12	0.6	270	10.48	10.48			4.200	5.000	1.645	-2.113	1657	0.630	0.860	1.25	1.62	1.25
pe Tx28 Girders 24' Roadway	55	ALL	T x 28		14	0.6	270	10.48	9.62	2	8.5	4.000	5.000	1.969	-2.490	1919	0.610	0.860	1.27	1.64	1.11
8.5" Slab	60 65	ALL ALL	Т x 28 Т x 28		18 22	0.6 0.6	270 270	10.04 9.75	7.81 6.12	4	14.5 24.5	4.000 4.300	5.600 5.900	2.320 2.716	-2.901 -3.337	2206 2486	0.600 0.580	0.870 0.870	1.43 1.55	1.86 2.00	1.14 1.14
	70	ALL	T x 28		26	0.6	270	9.56	6.48	4	24.5	5.200	6.300	3.131	-3.802	2793	0.570	0.870	1.26	1.89	1.01
	75	ALL	Tx28	'	28	0.6	270	9.48	6.62	4	24.5	5.600	7.800	3.572	-4.291	3110	0.560	0.880	1.38	1.81	1.08
	40 45	ALL ALL	T x 34 T x 34		10 10	0.6 0.6	270 270	13.01 13.01	13.01 13.01			4.000 4.500	5.000 5.500	0.835 1.050	-1.089 -1.332	1605 1750	0.690 0.670	0.830 0.840	1.85 1.90	2.40 2.46	2.60 2.42
	50	ALL	Tx34		12	0.6	270	13.01	13.01			4.000	5.000	1.294	-1.612	1868	0.650	0.840	1.53	1.98	1.81
e Tx34 Girders	55 60	ALL ALL	Т x 34 Т x 34		12 14	0.6 0.6	270 270	13.01 13.01	13.01 12.44	2	6.5	4.000 4.000	5.000 5.000	1.553 1.845	-1.904 -2.231	1981 2287	0.630 0.620	0.840 0.850	1.24 1.27	1.61 1.64	1.33 1.22
24' Roadway 8.5" Slab	65	ALL	Tx34		16	0.6	270	12.76	11.76	4	8.5	4.000	5.000	2.161	-2.579	2605	0.610	0.850	1.25	1.62	1.06
	70	ALL ALL	Tx34 Tx34		20 24	0.6 0.6	270 270	12.41 12.18	9.61 7.84	4 4	18.5 30.5	4.000 4.300	5.100 5.400	2.461 2.818	-2.902 -3.283	2888 3223	0.590 0.580	0.850 0.860	1.46 1.57	1.89 2.04	1.13 1.15
	80	ALL	Tx34		24	0.6	270	12.18	7.84 8.09	4	30.5	4.300	5.700	3.168	-3.660	3554	0.580	0.860	1.39	1.96	1.13
	85	ALL	Тх34		30	0.6	270	11.81	7.81	6	26.5	5.400	6.100	3.567	-4.078	3909	0.560	0.860	1.46	2.00	1.04
	40	ALL	T x 40		10	0.6	270	15.60	15.60		]	4.000	5.000	0.697	-0.889	1671	0.720	0.820	2.10	2.73	3.15
	45 50	ALL ALL	Т x 40 Т x 40	1	10 12	0.6 0.6	270 270	15.60 15.60	15.60 15.60			4.000 4.000	5.000 5.000	0.873 1.065	-1.080 -1.299	1972 2276	0.690 0.670	0.820 0.830	1.74 1.78	2.26 2.31	2.50 2.33
	55	ALL	T x 40	1	12	0.6	270	15.60	15.60			4.000	5.000	1.283	-1.538	2237	0.650	0.830	1.46	1.90	1.80
T.: 40 C' '	60 65	ALL ALL	T x 40 T x 40	1	14 14	0.6 0.6	270 270	15.60 15.60	15.60 15.60			4.200 4.000	5.000 5.000	1.522 1.780	-1.801 -2.081	2434 2688	0.640 0.630	0.830 0.840	1.49 1.24	1.93 1.60	1.66 1.25
e Tx40 Girders 24' Roadway	70	ALL	T x 40		16	0.6	270	15.35	14.85	4	6.5	4.000	5.000	2.035	-2.349	2989	0.610	0.840	1.24	1.65	1.17
8.5" Slab	75	ALL	T x 40		18	0.6	270 270	15.16 14.87	14.27	4 4	8.5 24.5	4.000	5.000	2.328	-2.657	3337	0.600	0.840	1.28	1.66 1.90	1.05
	80 85	ALL ALL	T x 40 T x 40		22 26	0.6 0.6	270	14.87 14.68	11.24 9.76	4	24.5 36.5	4.000 4.400	5.000 5.100	2.616 2.930	-2.961 -3.287	3681 4041	0.590 0.580	0.850 0.850	1.47 1.60	2.08	1.11 1.22
	90	ALL	Tx40		28	0.6	270	14.60	10.03	4	36.5	4.800	5.500	3.259	-3.626	4410	0.570	0.850	1.55	2.01	1.07
	95 100	ALL ALL	T x 40 T x 40		32 36	0.6 0.6	270 270	14.23 13.93	8.60 8.93	6 6	36.5 36.5	5.100 5.800	5.800 6.600	3.620 4.006	-3.991 -4.393	4799 5245	0.560 0.560	0.850 0.850	1.62 1.47	2.10 1.94	1.06 1.06
	40	ALL	Tx46		10	0.6	270	17.60	17.60	-		4.000	5.000	0.613	-0.708	1732	0.740	0.810	2.35	3.05	3.78
	45 50	ALL	T x 46		10	0.6	270 270	17.60	17.60			4.000	5.000	0.768	-0.865	2066	0.720	0.810	1.93	2.50	3.01
	50	ALL ALL	Т x 46 Т x 46		12 12	0.6 0.6	270	17.60 17.60	17.60 17.60			4.000 4.000	5.000 5.000	0.937 1.127	-1.042 -1.235	2452 2726	0.700 0.680	0.820 0.820	1.97 1.63	2.55 2.11	2.81 2.22
	60	ALL	Tx46		14	0.6	270	17.60	17.60			4.000	5.000	1.332	-1.438	2951	0.660	0.820	1.68	2.18	2.10
	65 70	ALL ALL	Т x 46 Т x 46		14 14	0.6 0.6	270 270	17.60 17.60	17.60 17.60			4.000 4.000	5.000 5.000	1.557 1.798	-1.662 -1.898	2905 3157	0.650 0.640	0.820 0.830	1.41 1.18	1.82 1.52	1.64 1.25
pe Tx46 Girders 24' Roadwav	75	ALL	Tx46		16	0.6	270	17.35	16.85	4	6.5	4.000	5.000	2.050	-2.137	3495	0.620	0.830	1.23	1.59	1.17
8.5" Slab	80 85	ALL ALL	Tx46 Tx46		18 22	0.6 0.6	270 270	17.16 16.88	16.27 15.06	4 4	8.5 14.5	4.000 4.000	5.000 5.000	2.304 2.591	-2.384 -2.656	3859 4249	0.610 0.600	0.830 0.830	1.25 1.46	1.63 1.89	1.09 1.30
	90	ALL	Tx46		22	0.6	270	16.77	14.10	4	20.5	4.000	5.000	2.870	-2.923	4631	0.590	0.830	1.40	1.88	1.06
	95	ALL	T x 46		28	0.6	270	16.60	11.46	4	40.5	4.200	5.000	3.192	-3.234	5087	0.590	0.840	1.57	2.03	1.08
	100 105	ALL ALL	T x 46 T x 46		32 36	0.6 0.6	270 270	16.23 15.94	9.48 9.94	6 6	42.5 42.5	4.400 5.000	5.000 5.800	3.524 3.856	-3.542 -3.851	5513 5937	0.580 0.570	0.840 0.840	1.65 1.72	2.14 2.23	1.07 1.17
	110	ALL	Tx46		38	0.6	270	15.81	10.45	6	40.5	5.400	6.300	4.200	-4.169	6370	0.560	0.840	1.67	2.16	1.04
	115	ALL	Tx46		42	0.6	270	15.60	10.75	6	40.5	6.000	7.000	4.584	-4.532	6886	0.560	0.840	1.46	1.96	1.05

TYPE Tx46

TYPE  $T \times 40$ 

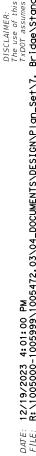

4:0

TYPE  $T \times 34$ 

TYPE  $T \times 28$ 

### NON-STANDARD STRAND PATTERNS

PATTERN	STRAND ARRANGEMENT AT € OF GIRDER

(1) Based on the following allowable stresses (ksi):

Compression = 0.65 f'ci

Tension =  $0.24 \sqrt{f'ci}$ 

Optional designs must likewise conform.

(2) Portion of full HL93.

### DESIGN NOTES:

Designed according to AASHTO LRFD Bridge Design Speci cations. Load rated using Load and Resistance Factor Rating according to AASHTO Manual for Bridge Evaluation.

Optional designs for girders 120 feet or longer must have a calculated residual camber equal to or greater than that of the designed girder.

Prestress losses for the designed girders have been calculated for a relative humidity of 60 percent. Optional designs must likewise conform.

### FABRICATION NOTES:

Provide Class H concrete. Provide Grade 60 reinforcing steel bars.

Use low relaxation strands, each pretensioned to 75 percent of fpu.

Strand debonding must comply with Item 424.4.2.2.2.4. Full-length debonded strands are only permitted in positions marked  $\Delta$ . Double wrap full-length debonded strands in outer most position of each

When shown on this sheet, the Fabricator has the option of furnishing either the designed girder or an approved optional design. All optional design submittals must be signed, sealed and

dated by a Professional Engineer registered in the State of Texas. Seal cracks in girder ends exceeding 0.005" in width as directed by the Engineer. The fabricator is permitted to decrease the spacing of Bars R and S by providing additional bars to help limit crack width provided the decreased spacing results in no less than 1" clear between bars. The fabricator must take an approved corrective action if cracks greater than 0.005" form on a repetitive basis.


### DEPRESSED STRAND DESIGNS:

Locate strands for the designed girder as low as possible on the 2" grid system unless a non-standard strand pattern is indicated. Fill row "2.5", then row "4.5", then row "6.5", etc., beginning each row in the "A" position and working outward until the required number of strands is reached. All strands in the "A" position must be depressed, maintaining the 2" spacing so that, at the girder ends, the upper two strands are in the position shown in the table.

HL93 LOADING			SHE	ET î	OF 2
Texas Department	of Tra	nsp	oortation	D	ridge ivision tandard
PRESTRESS I-GIRDEF DE		T,	ANDA		
24'	ROA	٩D	WAY		
	1	G	SD-24		
FILE: IG-IGSD24-21.dgn	DN: EF	С	CK: AJF DW:	EFC	CK: TAR
CTxDOT August 2017	CONT	SECT	JOB		HIGHWAY
REVISIONS 10-19: Redesianed airders.	0923	17	084	(	CR 392
1-21: Added load rating.	DIST		COUNTY		SHEET NO.
	BWD		COMANCHE		58

			DES	SIGNED	GIRDE	RS				DEPR	ESSED	СОМС	RETE		OPTIC	ONAL DESIG	GN				ATING
STRUCTURE	SPAN NO.	GIRDER NO.	GIRDER TYPE	NON- STD STRAND PATTERN	PRES TOTAL NO.		STRGTH	"e" ⊈	"e" END		RAND TERN	RELEASE STRGTH	MINIMUM 28 DAY COMP STRGTH f'c	DESIGN LOAD COMP STRESS (TOP Ç) (SERVICE I)	DESIGN LOAD TENSILE STRESS (BOTT ©) (SERVICE 111)	REQUIRED MINIMUM ULTIMATE MOMENT CAPACITY (STRENGTH I)	DISTRI FAC	LOAD IBUTION TOR 2	STREN	FACT (	SERVICE
						(in)	(ksi)	(in)	(in)		(in)	(ksi)	(ksi)	fct(ksi)	fcb(ksi)	(kip-ft)	Moment	Shear	Inv	0pr	Inv
	40	ALL	Tx54		8	0.6	270	21.01	21.01			4.000	5.000	0.511	-0.578	1798	0.770	0.800	2.05	2.66	3.76
	45	ALL	T x 54		10	0.6	270	21.01	21.01			4.000	5.000	0.636	-0.703	2126	0.740	0.800	2.24	2.90	3.69
	50	ALL	Tx54		12	0.6	270	21.01	21.01			4.000	5.000	0.781	-0.850	2533	0.720	0.810	1.81	2.35	2.91
	55	ALL	Tx54		12	0.6	270	21.01	21.01			4.000	5.000	0.938	-1.007	2951	0.700	0.810	1.90	2.46	2.79
	60	ALL	T x 54		12	0.6	270	21.01	21.01			4.000	5.000	1.108	-1.173	3271	0.680	0.810	1.60	2.07	2.25
	65	ALL	Tx54		14	0.6	270	21.01	21.01			4.000	5.000	1.285	-1.348	3547	0.670	0.810	1.66	2.16	2.16
	70	ALL	T x 54		14	0.6	270	21.01	21.01			4.000	5.000	1.482	-1.540	3502	0.660	0.820	1.41	1.82	1.73
	75	ALL	Tx54		16	0.6	270	20.76	20.26	4	6.5	4.000	5.000	1.689	-1.733	3745	0.640	0.820	1.47	1.91	1.66
Type Tx54 Girders	80	ALL	T x 54		16	0.6	270	20.76	20.76			4.000	5.000	1.912	-1.944	4001	0.630	0.820	1.26	1.63	1.30
24' Roadway 8.5" Slab	85	ALL	Tx54		18	0.6	270	20.56	19.67	4	8.5	4.000	5.000	2.148	-2.166	4406	0.620	0.820	1.07	1.39	1.00
0.5 5140	90	ALL	T x 54		20	0.6	270	20.41	19.21	4	10.5	4.000	5.000	2.379	-2.384	4806	0.610	0.820	1.33	1.73	1.16
	95	ALL	T x 54		22	0.6	270	20.28	18.46	4	14.5	4.000	5.000	2.639	-2.624	5234	0.600	0.820	1.35	1.75	1.07
	100	ALL	Tx54		26	0.6	270	20.08	16.39	4	28.5	4.000	5.000	2.896	-2.871	5699	0.600	0.830	1.52	1.97	1.14
	105	ALL	Tx54		30	0.6	270	19.81	12.21	6	44.5	4.000	5.000	3.180	-3.130	6153	0.590	0.830	1.51	1.96	1.02
	110	ALL	Tx54		32	0.6	270	19.63	11.38	6	50.5	4.100	5.000	3.477	-3.400	6619	0.580	0.830	1.63	2.12	1.03
	115	ALL	Tx54		36	0.6	270	19.34	12.01	6	50.5	4.700	5.500	3.786	-3.679	7096	0.570	0.830	1.60	2.07	1.00
	120	ALL	Tx54		38	0.6	270	19.22	13.22	6	44.5	5.200	6.100	4.116	-3.985	7646	0.570	0.830	1.65	2.14	1.01
	125	ALL	Tx54		42	0.6	270	19.01	12.72	6	50.5	5.600	6.600	4.415	-4.257	8113	0.570	0.830	1.71	2.24	1.09
	125	ALL	1,7,54		72	0.0	270	19.01	12.72		50.5	5.000	0.000	4.415	-4.2.57	0115	0.500	0.050	1.7 1	2.24	1.03
	60	ALL	Tx62		12	0.6	270	25.78	25.78			4.000	5.000	0.878	-0.986	3525	0.700	0.800	1.81	2.35	2.73
	65	ALL	Tx62		12	0.6	270	25.78	25.78			4.000	5.000	1.016	-1.133	3847	0.690	0.800	1.89	2.45	2.64
	70	ALL	Tx62		14	0.6	270	25.78	25.78			4.000	5.000	1.171	-1.293	4173	0.680	0.810	1.61	2.08	2.16
	75	ALL	Tx62		14	0.6	270	25.78	25.78			4.000	5.000	1.332	-1.455	4132	0.660	0.810	1.68	2.18	2.10
	80	ALL	Tx62		16	0.6	270	25.53	25.53			4.000	5.000	1.506	-1.633	4429	0.650	0.810	1.45	1.88	1.72
	85	ALL	Tx62		16	0.6	270	25.53	25.53			4.000	5.000	1.691	-1.819	4610	0.640	0.810	1.24	1.61	1.37
ype Tx62 Girders	90	ALL	Tx62		16	0.6	270	25.53	25.53			4.000	5.000	1.885	-2.013	5051	0.630	0.810	1.29	1.68	1.31
24' Roadway 8.5" Slab	95	ALL	Tx62		20	0.6	270	25.18	24.78	4	6.5	4.000	5.000	2.081	-2.209	5493	0.620	0.820	1.11	1.44	1.02
5.5 5rus	100	ALL	Тх62		22	0.6	270	25.05	23.96	4	10.5	4.000	5.000	2.295	-2.420	5959	0.610	0.820	1.16	1.50	1.01
	105	ALL	Tx62		24	0.6	270	24.94	23.28	4	14.5	4.000	5.000	2.514	-2.642	6475	0.610	0.820	1.37	1.78	1.10
	110	ALL	Tx62		26	0.6	270	24.85	22.70	4	18.5	4.000	5.000	2.723	-2.850	6936	0.600	0.820	1.39	1.80	1.03
	115	ALL	Tx62		30	0.6	270	24.58	17.78	6	40.5	4.000	5.000	2.963	-3.083	7440	0.590	0.820	1.56	2.02	1.09
	120	ALL	Tx62		34	0.6	270	24.25	15.07	6	58.5	4.200	5.000	3.213	-3.325	7957	0.580	0.820	1.55	2.01	1.00
	125	ALL	Tx62		36	0.6	270	24.11	17.11	6	48.5	4.700	5.600	3.480	-3.591	8551	0.580	0.820	1.64	2.13	1.04
	130	ALL	Tx62		40	0.6	270	23.88	16.68	6	54.5	5.100	6.100	3.733	-3.836	9072	0.570	0.820	1.52	2.09	1.02
	135	ALL	Tx62		42	0.6	270	23.78	16.35	6	58.5	5.300	6.300	4.002	-4.104	9676	0.570	0.830	1.61	2.18	1.05



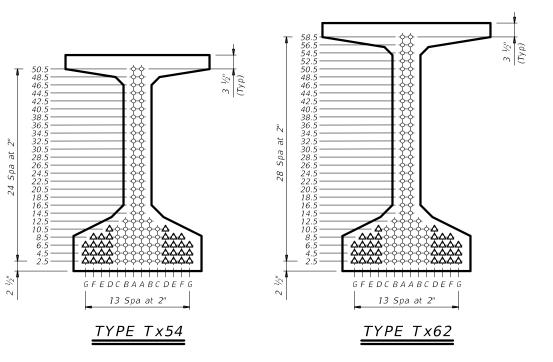

DATE: 12/19/2023 4:01:02 PM TXD07 ass FILE: R:\1005000-1005999\1005472.03\04\_DOCUMENTS\DESIGN\P1an\_Set\7. Bridge\S


NON	I-STANDARD STRAND PATTERNS
PATTERN	STRAND ARRANGEMENT AT € OF GIRDER


1) Based on the following allowable stresses (ksi): Compression = 0.65 f'ci

Tension =  $0.24 \sqrt{f'ci}$ 


Optional designs must likewise conform.

(2) Portion of full HL93.

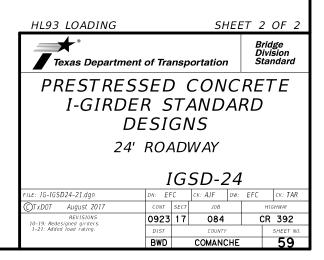


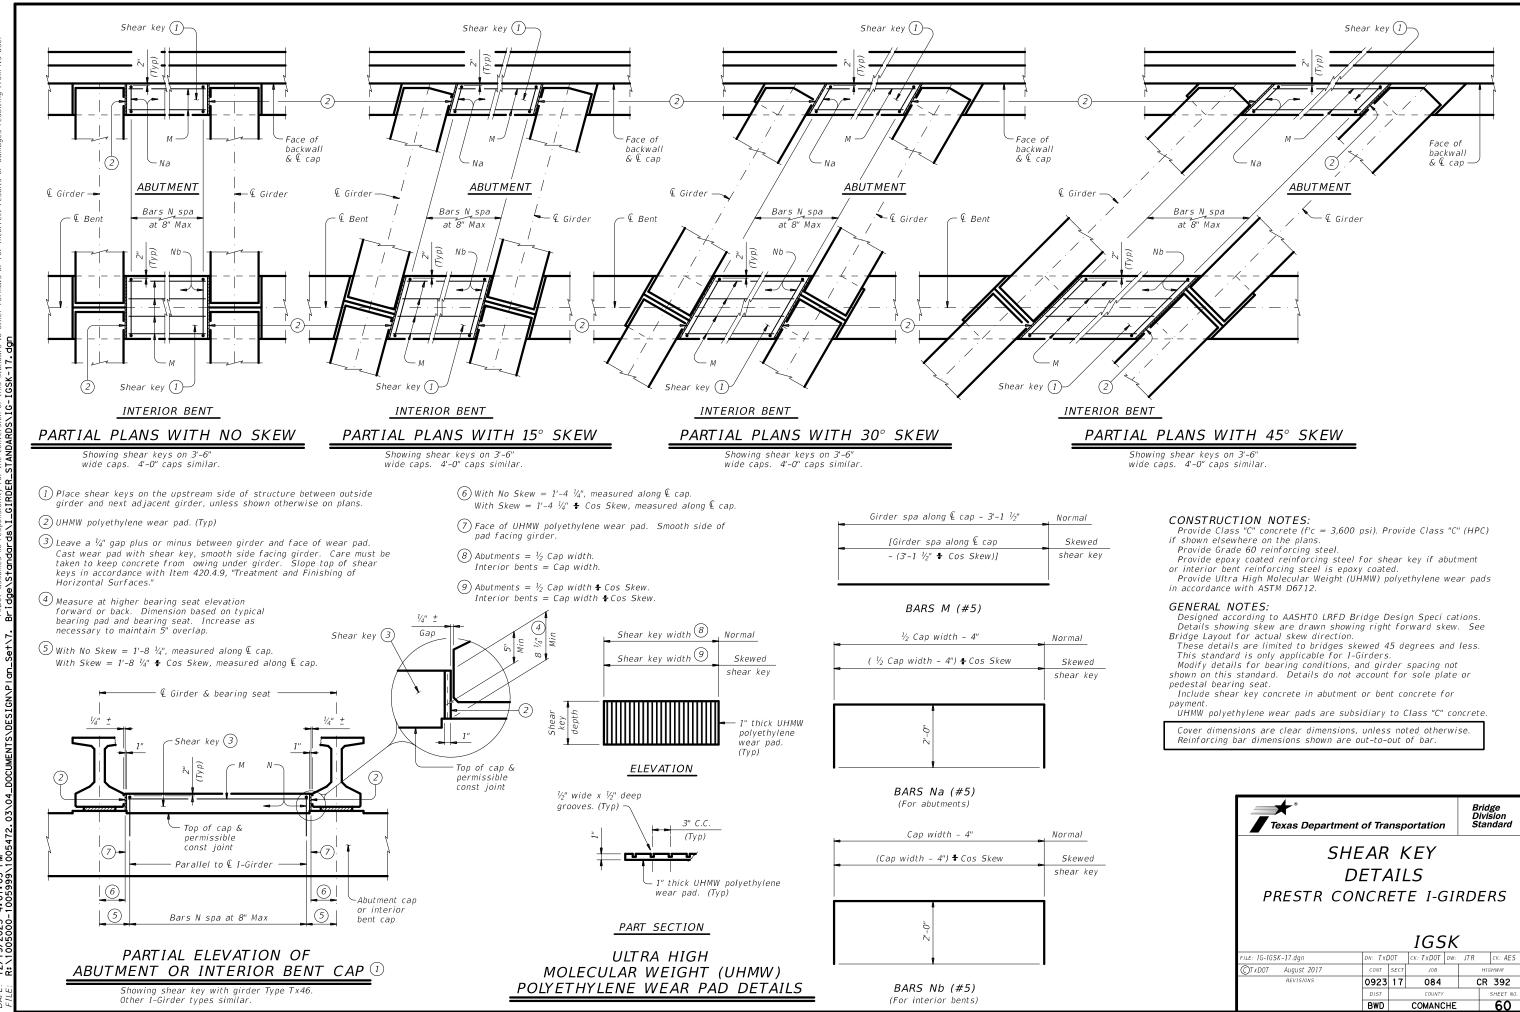

Texas Departme	ent of Trai	nsp	ortation		DI	ridge ivision andard
	HEAR DETA	-	_S			
PRESTR CO	ONCRE	ΞT	E I-G	Ϊŀ	RDE	ERS
PRESTR CO	ONCRE	ΞT	e I-G IGS			ERS
PRESTR CO			IGS			CK: AES
	DN: TXDI		IGS	K	JTR	
FILE: IG-IGSK-17.dgn	DN: TXDI CONT	OT	IGS	K	JTR	ск: АЕ5
FILE: IG-IGSK-17.dgn ©TxDOT August 2017	DN: TXDI CONT	OT SECT	IGS ck: TxDOT JOB	K	JTR	ск: AES HIGHWAY

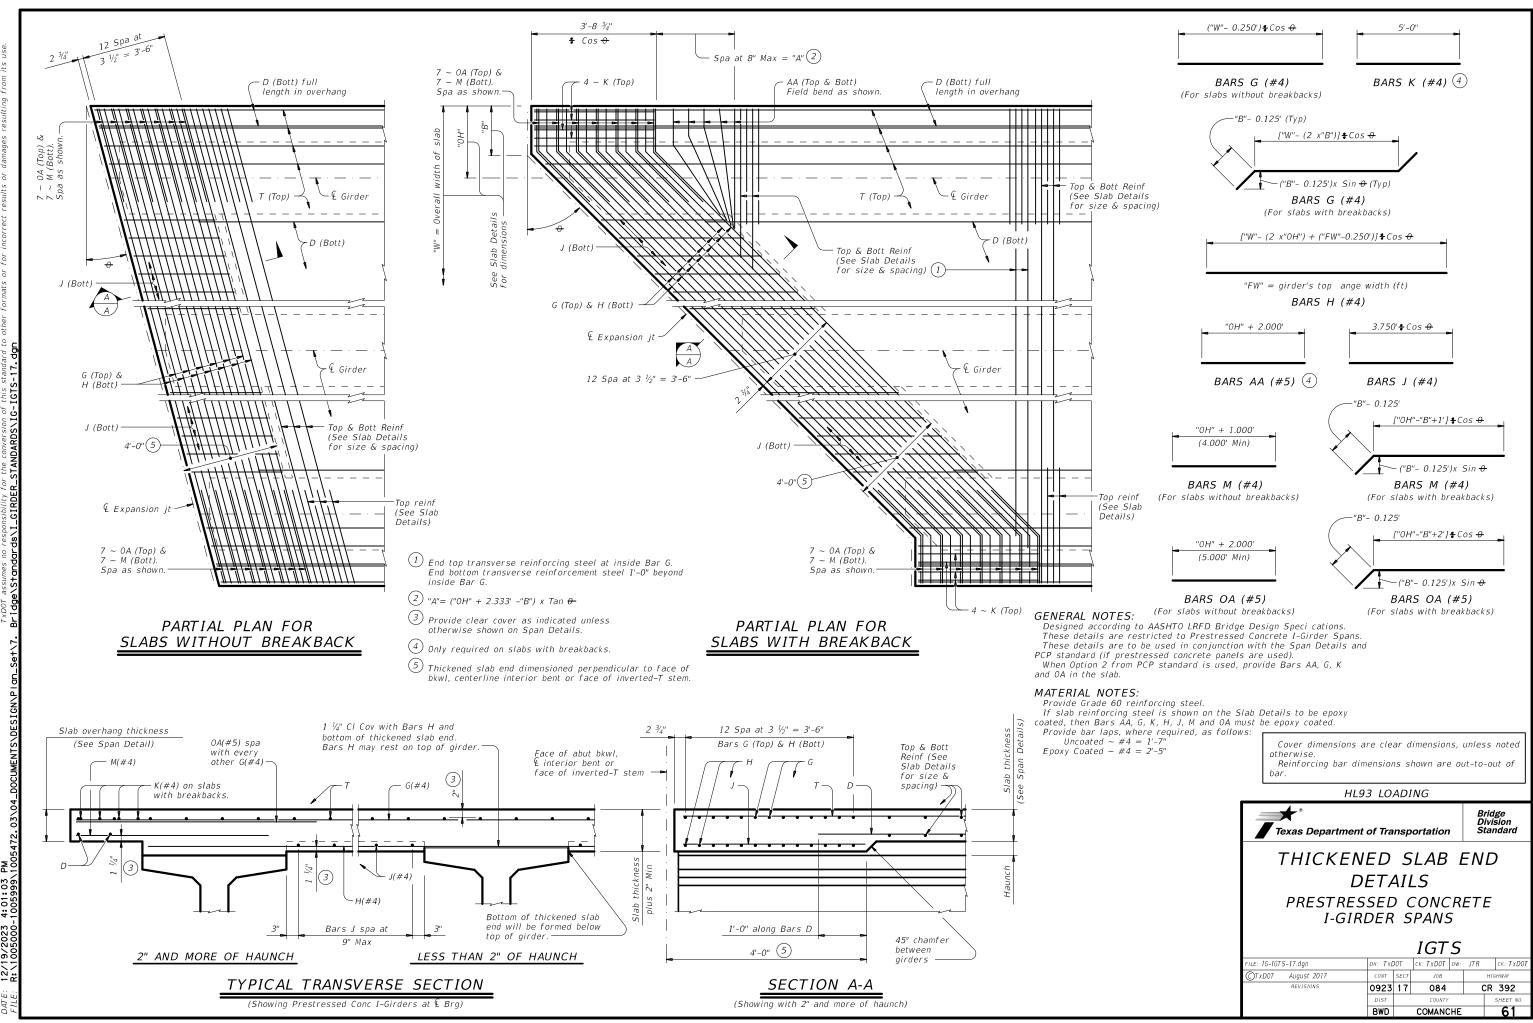

wh its purpose ing from i any sulti any kind is made by TxD0T for incorrect results or damages re anty of or for i warr mats No Act". ther ΜŠ 4:01:03 f -1005999\1 12/19/2023 P: \1005000

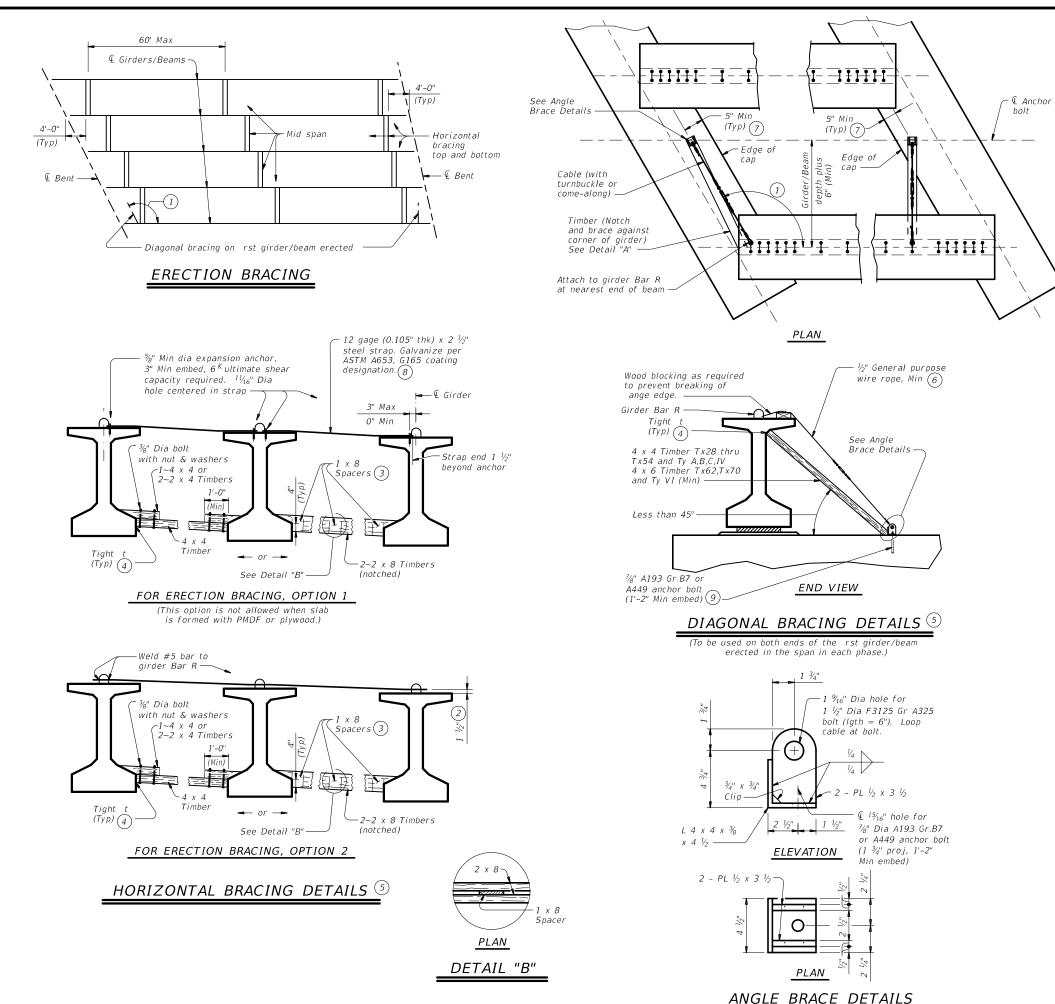

### HAULING & ERECTION:

The Contractor's attention is directed to the possible lateral instability of prestressed concrete girders and beams over 130' long, especially during hauling and erection. The use of the following methods to improve stability is encouraged: Locate lifting devices at the maximum practical distance from girder ends; use external lateral sti ening devices during hauling and erection; lift with vertical lines using two machines; and take care in handling to minimize inertial and impact forces.


### ERECTION BRACING:

Erection bracing details shown are considered the minimum for ful lling the bracing requirements of Item 425.

Required erection bracing must be placed immediately after erection of each girder and remain in place until additional bracing as required for slab placement is in place. This standard is needed in all cases to meet requirements for Slab Placement Bracing.

### PHASED CONSTRUCTION:

Place erection and slab placement bracing for all girders in a phase as shown in these details. For phases after rst, also place erection and slab placement bracing between outer girder of completed phase and adjacent girder of current phase. When the phase construction joint is between girders, top bracing can be omitted.

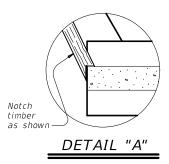


- (1) If angle shown exceeds 120 degrees, move diagonal brace to other side of girder/beam and place square to girder/beam. This may prevent exterior girder from being erected rst.
- (2) Place and weld #5 bars as shown during erection. If forming deck with prestressed panels, bars can be temporarily removed, one at a time, during panel erection. Re-install bar prior to additional panel erection. Bars can rest on panels and be bent down and welded to girder Bars R (See Sheet 2 of 2).
- (3) Clear distance between spacers must not exceed 3'. Nail together with 16d nails.
- $(\underbrace{4})$  Use wedges as necessary to obtain tight t. Nail wedges to timbers.
- (5) Pressure treated landscape timbers can not be used.
- (6) All hardware used with cable must be able to develop a minimum 25 kips breaking strength. Use thimbles at all loops in cable. Install cable clamps with saddles bearing against the live end and U-bolts bearing aginst the dead end.
- (7) It is acceptable to tie anchor bolts to cap reinforcement.

Prior to installing, eld bend strap to lay ush on both girders' top ange and slope between ange tips.

(9) Anchor bolt may be drilled and epoxied in place. Provide 25k minimum pullout. Core drill hole.


SHEET 1 OF 2										
Texas Department of Transportation Bridge Standard										
MINIMUM ERECTION AND										
BRACING F	REC	$\mathcal{U}$	IREM	ΞN	TS					
PRESTRES. I-GIRDERS										
	٨	1E	BR(C)	)						
FILE: IG-MEBR(C)-17.dgn	DN: TX	DOT	CK: TXDOT DW:	T x D 0 T	ск: ТхДОТ					
CTxDOT August 2017	CONT	SECT	JOB		HIGHWAY					
REVISIONS	0923	17	084	(	CR 392					
	DIST		COUNTY		SHEET NO.					
	BWD		COMANCHE		62					

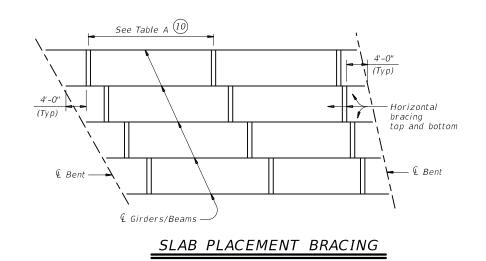

		TAB	LE A		
OPTION 1-RI	GID BRACING (ST	EEL STRAP)	OPTION 2-FLEX	IBLE BRACING (NC	D. 5 OVER PCP)
	Maximum Bra	acing Spacing		Maximum Bra	acing Spacing
Girder or Beam Type	Slab Overhang less than 4'-0" (11)	Slab Overhang 4'-0" and greater (11)	Girder or Beam Type	Slab Overhang less than 4'-0" $\begin{pmatrix} 11 \end{pmatrix}$	Slab Overhang 4'-0" and greater (11)
Tx28	¼ points	1⁄4 points	Тх28	¼ points	½ points
Tx34	½ points	1/4 points	Tx34	¼ points	½ points
Tx40	1⁄4 points	½ points	T x 40	¼ points	½ points
Tx46	¼ points	1/8 points	Tx46	½ points	½ points
Tx54	¼ points	½ points	Tx54	¼ points	½ points
Tx62	¼ points	½ points	Tx62	¼ points	½ points
T x 70	¼ points	½ points	T x70	¼ points	½ points
А	¹⁄₂ points	¹⁄8 points	А	2.0 ft	1.5 ft
В	½ points	½ points	В	3.0 ft	2.0 ft
С	¼ points	½ points	С	4.5 ft	2.0 ft
IV	1⁄4 points	½ points	IV	¼ points	4.0 ft
VI	¼ points	½ points	VI	¼ points	4.0 ft

x 8

Spacer

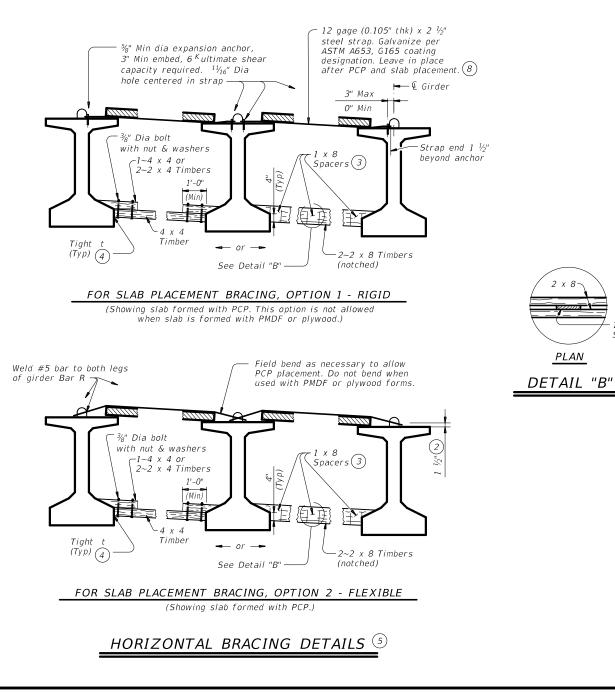

- (2) Place and weld #5 bars as shown during erection. If forming deck with prestressed panels, bars can be temporarily removed, one at a time, during panel erection. Re-install bar prior to additional panel erection. Bars can rest on panels and be bent down and welded to girder Bars R.
- (3) Clear distance between spacers must not exceed 3'. Nail together with 16d nails.
- 4 Use wedges as necessary to obtain tight t. Nail wedges to timbers.
- (5) Pressure treated landscape timbers can not be used.
- (8) Prior to installing, eld bend strap to lay ush on both girders' top ange and slope between ange tips.
- 10 Bracing spacing (  $rac{1}{4}$  and  $rac{1}{8}$  points ) measured between  $\,$  rst and last typical brace location.
- (1) Measure slab overhang from centerline of girder or beam. When overhang varies in span, determine bracing spacing based on largest overhang.

### SLAB PLACEMENT BRACING:

The details for slab placement bracing are considered minimum for ful lling the requirements of Speci cation Items 422 and 425. Required slab placement bracing must remain in place until slab concrete has attained a compressive strength of 3000 psi.

### GENERAL NOTES:

Bracing details for spans longer than 150' are not provided. The Contractor must submit proposed bracing details for such conditions to the Engineer for approval prior to erection.

Systems equal to or better than those shown may be used provided details of such systems are submitted to and approved by the Engineer prior to erection.


Use of these systems or details does not relieve the Contractor of the responsibility for the adequacy of the bracing and the safety of the structure.

Removal of bracing for short periods of time to align girders and beams is permissible.

All turn-buckles, come-alongs, anchors and other connections must be capable of developing the full strength of the cable shown.

Furnish anchor bolts and nuts in accordance with Item 449, "Anchor Bolts".

SHE	ET 2	2 0	F 2		
Texas Department	of Tra	nsp	ortation		lge sion ndard
MINIMUM	ERI	ΞC	TION	A٨	ID
BRACING F	REC	$\mathcal{U}($	IREM	EN7	5
PRESTRES	SEL		ONCR	FTF	
I-GIRDERS		-			
	٨	1E	BR(C)	)	
FILE: IG-MEBR(C)-17.dgn	DN: TX	DOT	CK: TXDOT DW:	TxD0T	ск: ТхD0Т
©TxDOT August 2017	CONT	SECT	JOB	HI	GHWAY
REVISIONS	0923	17	084	CR	392
	DIST		COUNTY		SHEET NO.
	BWD		COMANCHE		63

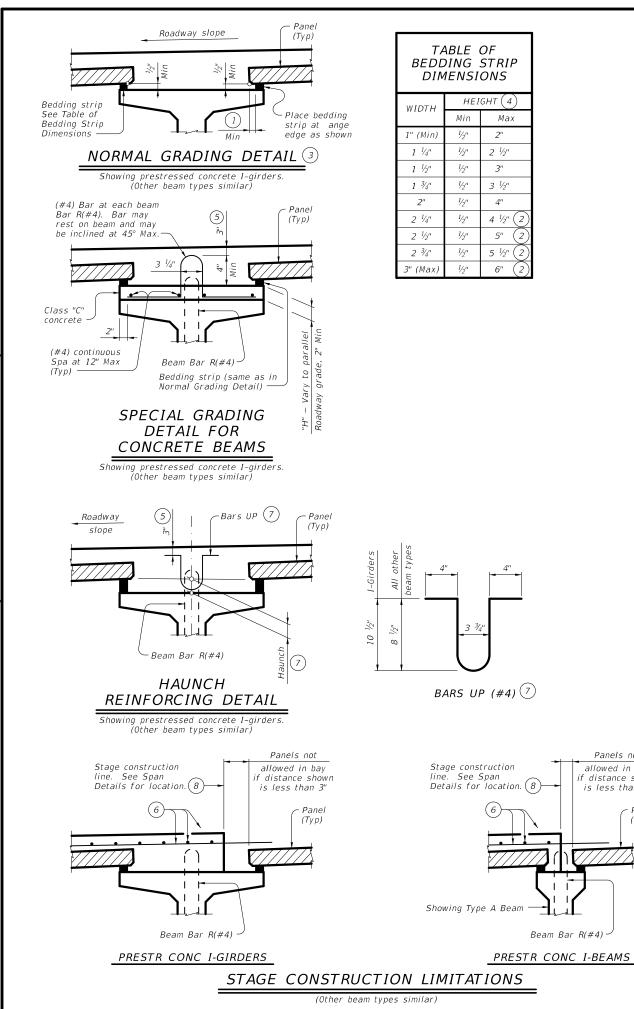

 $\left(1
ight)$  2" Min for I-girders, 1  $\frac{1}{2}$ " Min for all other beam types.

(2) Allowed for prestressed concrete I-girders, not allowed on other beam types.

(3) To reduce the quantity of cast-in-place concrete, bedding strip thickness may be increased in 1/4" increments. Bedding strips must be comprised of one layer. Bond bedding strips to the beams with an adhesive compatible with bedding strips. Bedding strips over 2.5" high may need to be bonded to panels. The same thickness strip must be used under any one panel edge and the maximum change in thickness between adjacent panels is  $\frac{1}{4}$ ". Alternatively, bedding strips may be cut to grade. Panels may be supported by an alternate method, using a commercial product, if approved by the Engineer of Bridge Design, Bridge Division. If bedding strips exceed 6" high for I-Girders, 4" high for all other beam types, use Special Grading Detail for Concrete Beams or submit an alternate method to the Bridge Division for approval.

(4) Height must not exceed twice the width.

Panels not

allowed in hav

f distance showr

is less than 3"

Panel


(Typ)

(5) Provide clear cover as indicated unless otherwise shown on Span Details.

- (6) See Span Details and Thickened Slab End Details for top slab reinforcement and clear cover. Transverse top slab reinforcement may rest on top of prestressed concrete panels if necessary to maintain clear cover.
- (7) Space Bars UP(#4) with Beam Bars R(#4) in all areas where measured haunch exceeds 3  $\frac{1}{2}''$  with I-girders, and 3" for all other beam types. Epoxy coating for Bars UP is not required.


(8) Do not locate construction joints on top of a panel.

(9) Butt adjacent bedding strips together with adhesive. Cut v-notches, approx ¼" deep, in the top of the bedding strips at 8' o.c..

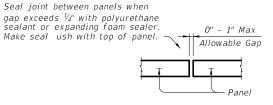



(Panel reinforcing not shown for clarity. The gap cannot be considered as a panel fabrication tolerance. Adjust panel placement to minimize joint openings.)

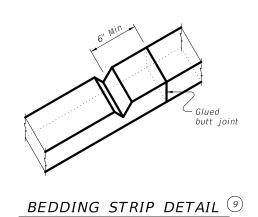

### CONSTRUCTION NOTES:

Erected panels must bear uniformly on bedding strips of extruded polystyrene placed along top ange edges.

Placing panels to minimize joint openings is recommended. If additional blocking is needed, special grading details for supporting the panels and extra reinforcing between beam and slab will be considered subsidiary to deck construction.

Bars U, shown on PCP-FAB, may be bent over or cut o if necessary.

Care must be taken to ensure proper cleaning of construction debris and consolidation of concrete material under the edges of the panels. Bedding strips must be placed at beam ange edges so that adequate space is provided for the mortar to ow a minimum of 1  $\frac{1}{2}$ " under the panels as the slab concrete is placed.

To allow the proper amount of mortar to ow between beam and panel, the minimum vertical opening must be at least  $\frac{y_{\rm m}}{2}$ . Roadway cross-slope reduces the opening available for entry of the mortar. Bedding strips varying in thickness across the beam are therefore required.

For clear span between U-beams less than or equal to 18", see Permissible Slab Forming Detail on Miscellaneous Slab Detail sheets, UBMS.

#### MATERIAL NOTES:

Provide Grade 60 reinforcing steel in the cast-in-place slab. See Table of Reinforcing Steel for size and spacing of reinforcement.

If the top and bottom layer of reinforcing steel is shown on the Span Details to be epoxy coated, then the D, E, P, & Z bars must be epoxy coated.

Provide bar Laps, where required, as follows: Uncoated  $\sim #4 = 1'-7'$ 

Epoxy Coated  $\sim #4 = 2'-5''$ 

#### GENERAL NOTES:

Designed according to AASHTO LRFD Bridge Design Speci cations.

Panel placement may follow either Option 1 or Option 2 except Option 1 must be used if the skew exceeds 45 dearees.

Use of Prestressed Concrete Panels is not permitted for horizontally curved steel plate or tub girders. See Span Details for other possible restrictions on their use.

These details are to be used in conjunction with the Span Details, PCP-FAB and other applicable standard drawings.

When panel support (bedding strips) deviates from what is shown herein, provide details signed and sealed by a professional Engineer.


Any additional reinforcement or concrete required on this standard is considered subsidiary to the bid Item "Reinforced Concrete Slab".

Cover dimensions are clear dimensions, unless noted otherwise Reinforcing bar dimensions shown are out-to-out of har


HL93 LOADING


SHEET 1 OF 4

Bridge Division Texas Department of Transportation Standard PRESTRESSED CONCRETE PANELS DECK DETAILS PCPLE: MS-PCP-23.dan DN: TXDOT CK: TXDOT DW: JTR CK: JMH TxDOT April 2019 JOB 0923 17 084 CR 392 **REVISIONS** /2023: Removed ton anne tension BWD COMANCHE 64

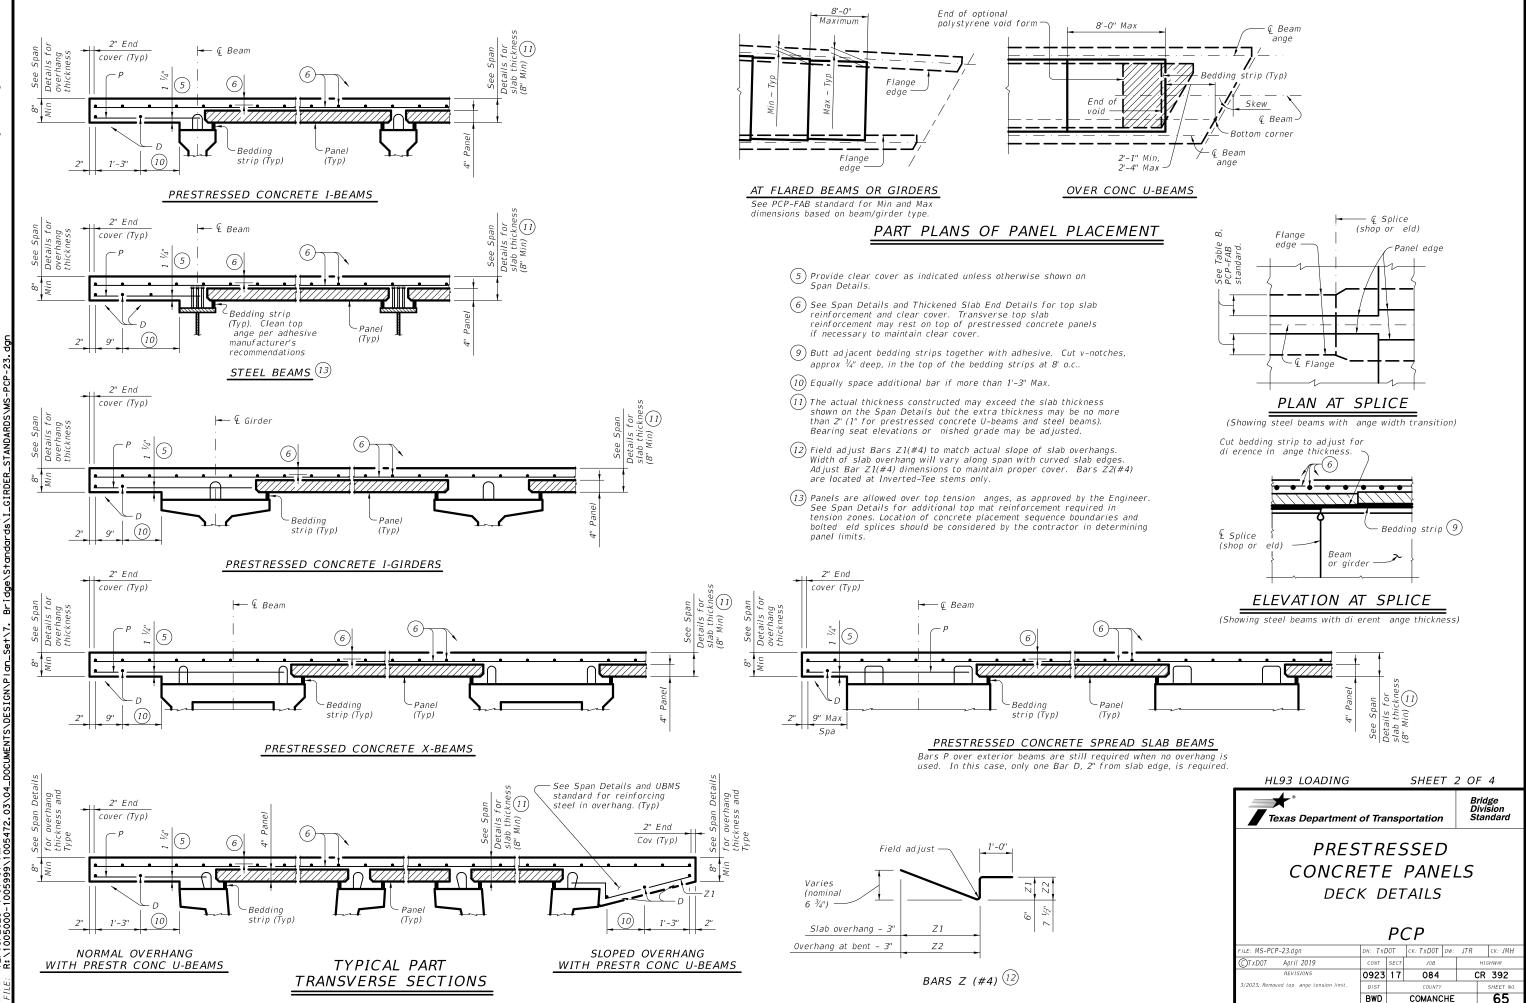

4:01:07 PM 1005999\100 12/19/2023 R:\1005000-DATE:

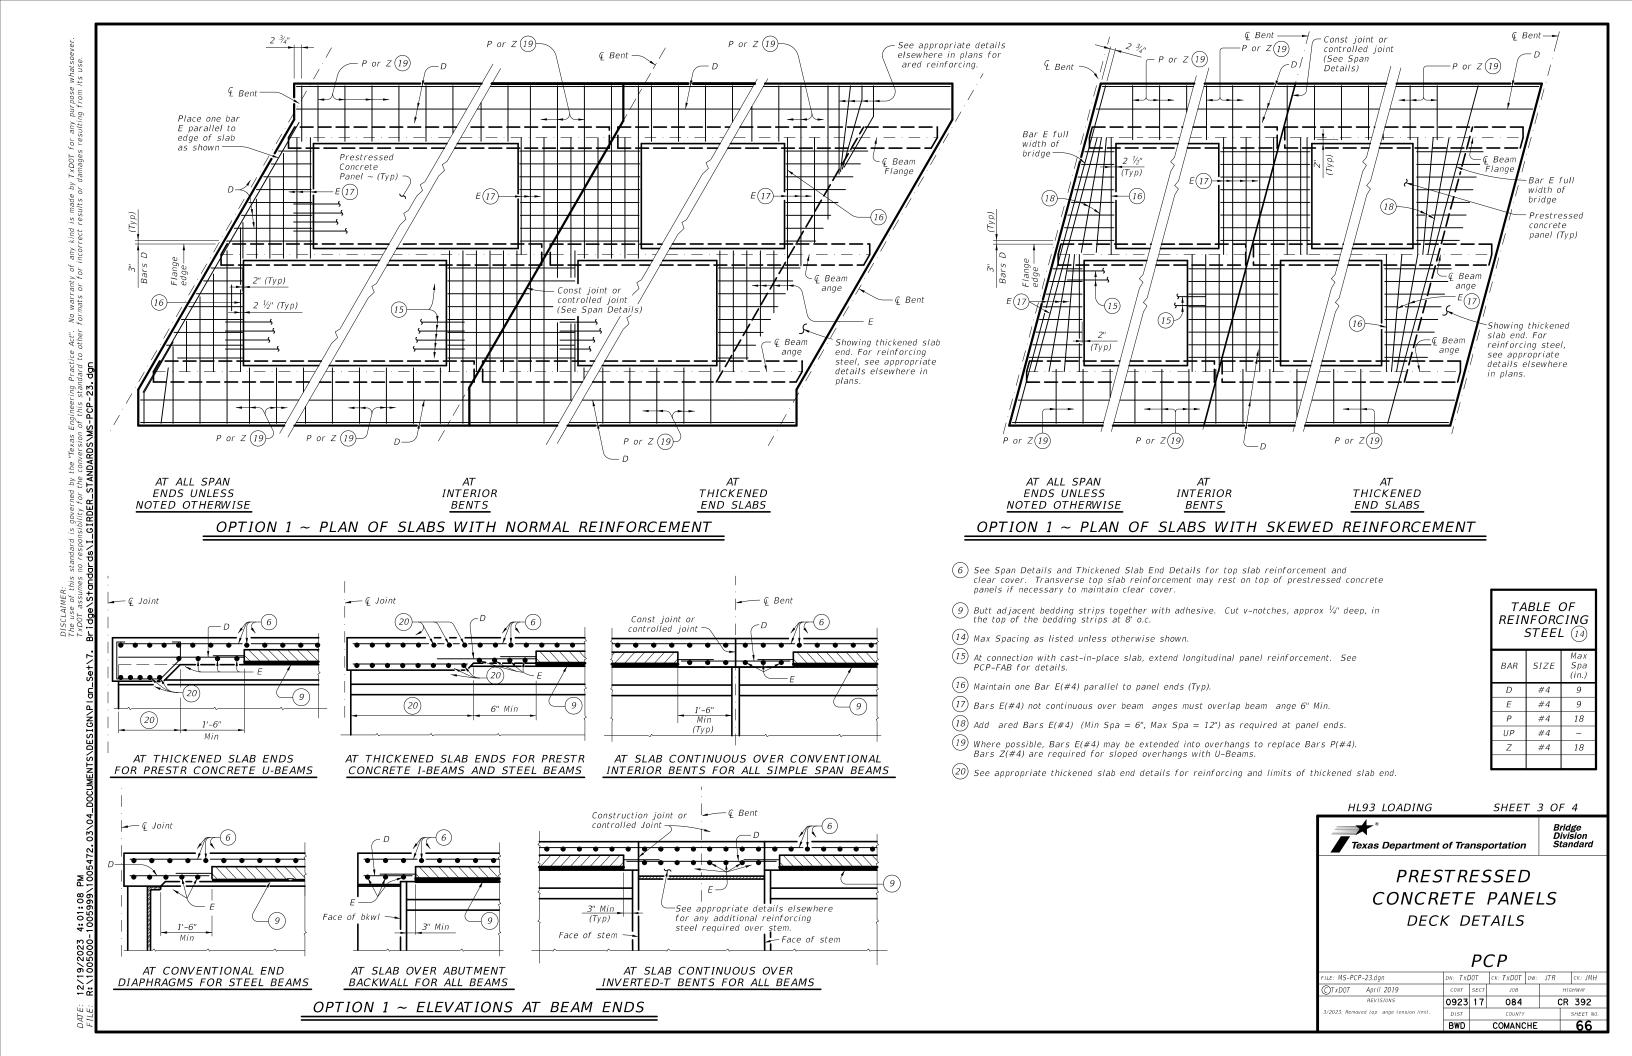

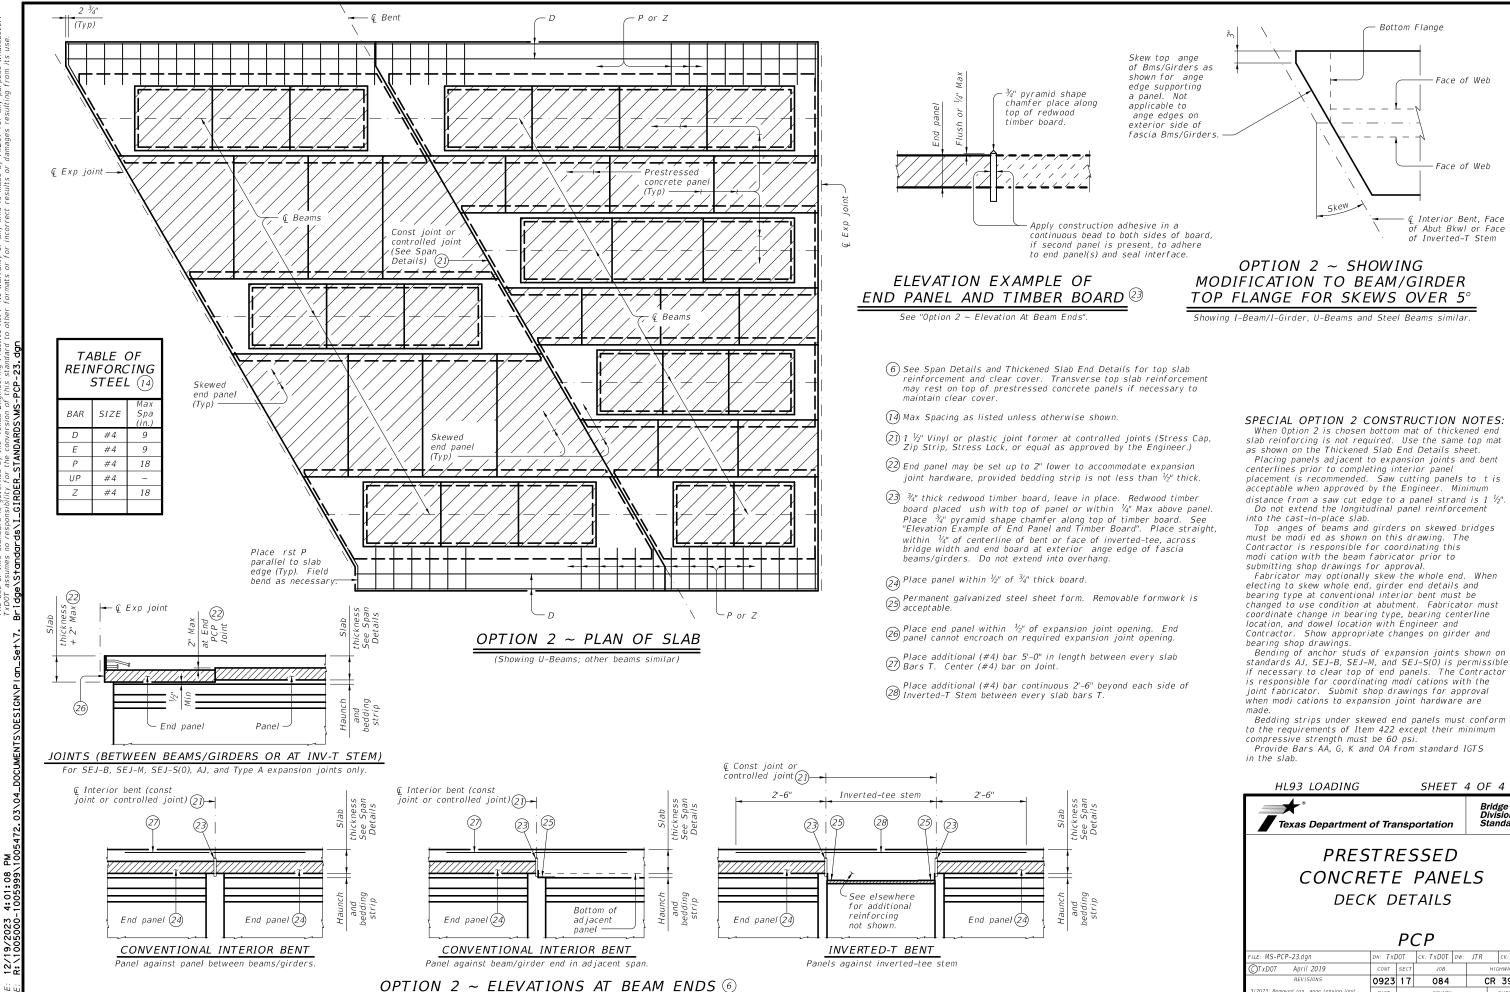

it s is made by TxDOT for any purpose results or damages resulting from any kind incorrect anty of or for i warr No Act". other

HL93 LOADING			SHEE	Τ 4	4 OF	4				
Image: Second system         Bridge Division           Image: Texas Department of Transportation         Standard										
PRES CONCRI DECI	ETE	Ē	PAN		_S					
		P	СР							
FILE: MS-PCP-23.dgn	DN: TX	DOT	ск: ТхДОТ	DW:	JTR	ск: ЈМН				
CTxDOT April 2019	CONT	SECT	JOB		h	IIGHWAY				
REVISIONS	0923	17	084		CF	392				
3/2023: Removed top ange tension limit.	DIST		COUNTY			SHEET NO.				
	BWD		COMANC	HE		67				

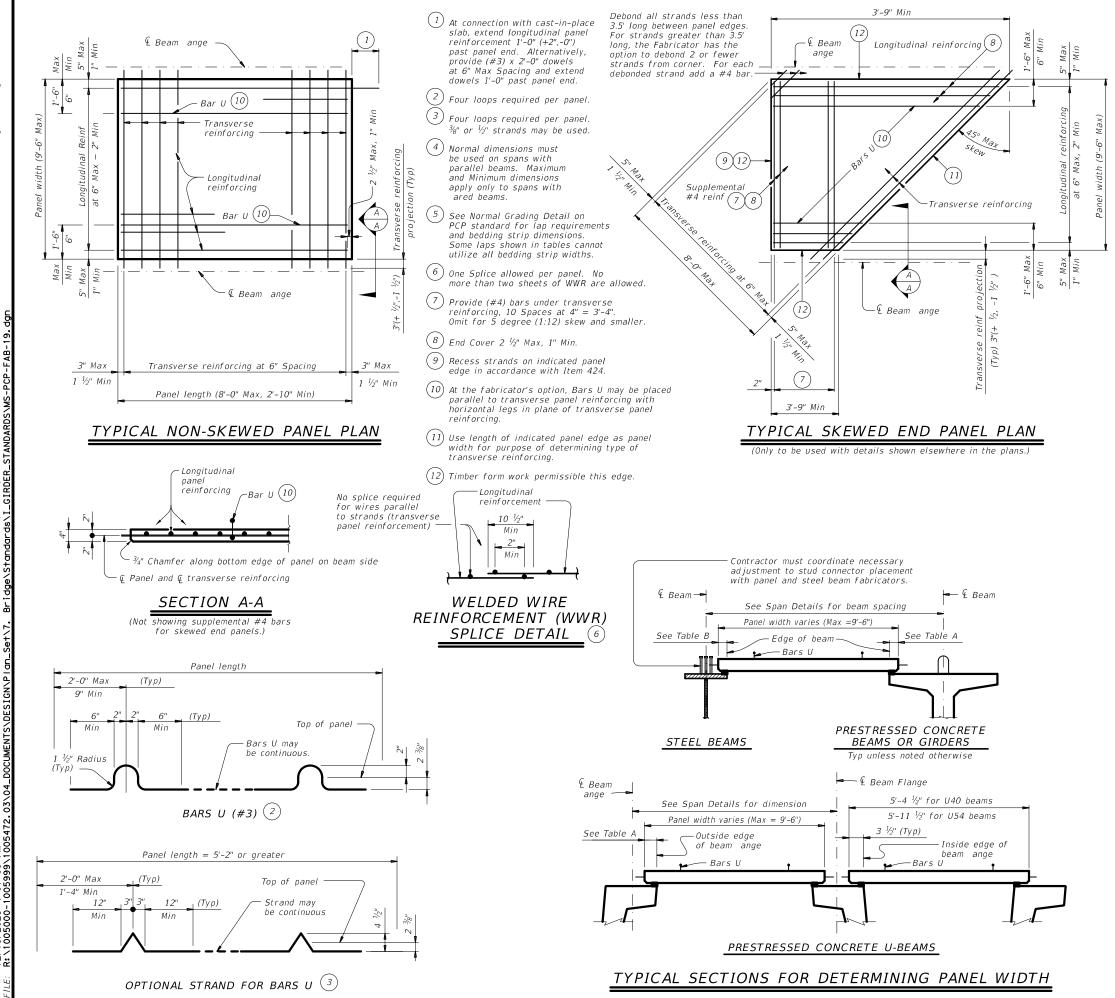


TABLE A $(4)(5)$								
Beam Type	Normal (In.)	Min (In.)	Max (In.)					
А	3	2 ½	3 1/2					
В	3	2 1/2	3 1/2					
С	4	3	4 ½					
IV	6	4	7 ½					
VI	6 ½	4 ½"	8 ½					
U40 - 54	5 ½	5 ½	7					
Tx28-70	6	5	7 1/2					
XB20 - 40	4	3	4 ½					
XSB12 - 15	4	3	4 ½					

TABLE B $(4)(5)$										
op Flange Width	Normal (In.)	Min (In.)	Max (In.)							
11" to 12"	2 <sup>3</sup> ⁄4	2 ½	2 <sup>3</sup> / <sub>4</sub>							
Over 12" to 15"	3 ¼	3	3 ¼							
Over 15" to 18"	4	3	4 <sup>3</sup> ⁄4							
Over 18"	5	3 1/2	6 ¼							

#### GENERAL NOTES:

Provide Class H concrete for panels. Release strength f'ci=3,500 psi. Minimum 28 day strength f'c=5,000 psi.

Provide ¾ chamfer along bottom edge of panel on beam side. Do not use epoxy-coated reinforcing steel bar or strand in panels.

Remove laitance from top panel surface.

Finish top of panel to a roughness between a No. 6 and No. 9 concrete surface pro le, inclusive, as speci ed by the International Concrete Repair Institute (ICRI).

Shop drawings for the fabrication of panels will not require the Engineer's approval if fabrication is in accordance with the details shown on this standard

A panel layout which identi es location of each panel must be developed by the Fabricator. Permanently mark each panel in accordance with the panel layout. A copy of the layout is to be provided to the Engineer.

#### TRANSVERSE PANEL REINFORCEMENT:

For panel widths over 5', use  $\frac{3}{8}$ " or  $\frac{1}{2}$ " Dia (270k) prestressing strands with a tension of 14.4 kips per strand.

For panel widths over 3'-6" up to and including 5', use  $\frac{3}{8}$ " or  $\frac{1}{2}$ " Dia (270k) prestressing strands with a tension of 14.4 kip per strand. Optionally, (#4) Grade 60 reinforcing bars may be used in lieu of prestressed strands. For panel widths up to 3'-6", use (#4) Grade 60 reinforcing bars (prestressed

strands alone are not allowed). Place transverse panel reinforcement at panel centroid and space at 6" Max

### LONGITUDINAL PANEL REINFORCEMENT:

Any of the following options may be used for longitudinal panel


reinforcement: 1. (#3) Grade 60 reinforcing steel at 6" Max Spacing. No splices allowed. 2.  $\frac{3}{6}$ " Dia prestressing strands at 4  $\frac{1}{2}$ " Max Spacing (unstressed). No splices allowed.

3.  $\frac{1}{2}$ " Dia prestressing strands at 6" Max Spacing (unstressed). No splices allowed.

4. Deformed Welded Wire Reinforcement (WWR) (ASTM A1064) providing 0.22 sq in per foot of panel width. Wires larger than D11 not permitted. Provide transverse wires to ensure proper handling of reinforcing. One splice per panel is allowed. See WWR Splice Detail.

No combination of longitudinal reinforcement options in a panel is allowed Place longitudinal panel reinforcement above or below transverse panel reinforcement. Must be placed above transverse panel reinforcement for skewed end panels with supplemental (#4) reinforcement.

HL93 LOADING							
Texas Department of Transportation							
PRESTRESSED CONCRETE PANEL FABRICATION DETAILS							
PCP-FAB							
FILE: MS-PCP	-FAB-19.dgn	DN: TX	DOT	CK: TXDOT DW:	JTR	ςκ: AES	
(C)T x DOT	April 2019	CONT	SECT	JOB	H	IIGHWAY	
	REVISIONS	0923	17	084	CI	392	
		DIST		COUNTY		SHEET NO.	
		BWD		COMANCHE		68	

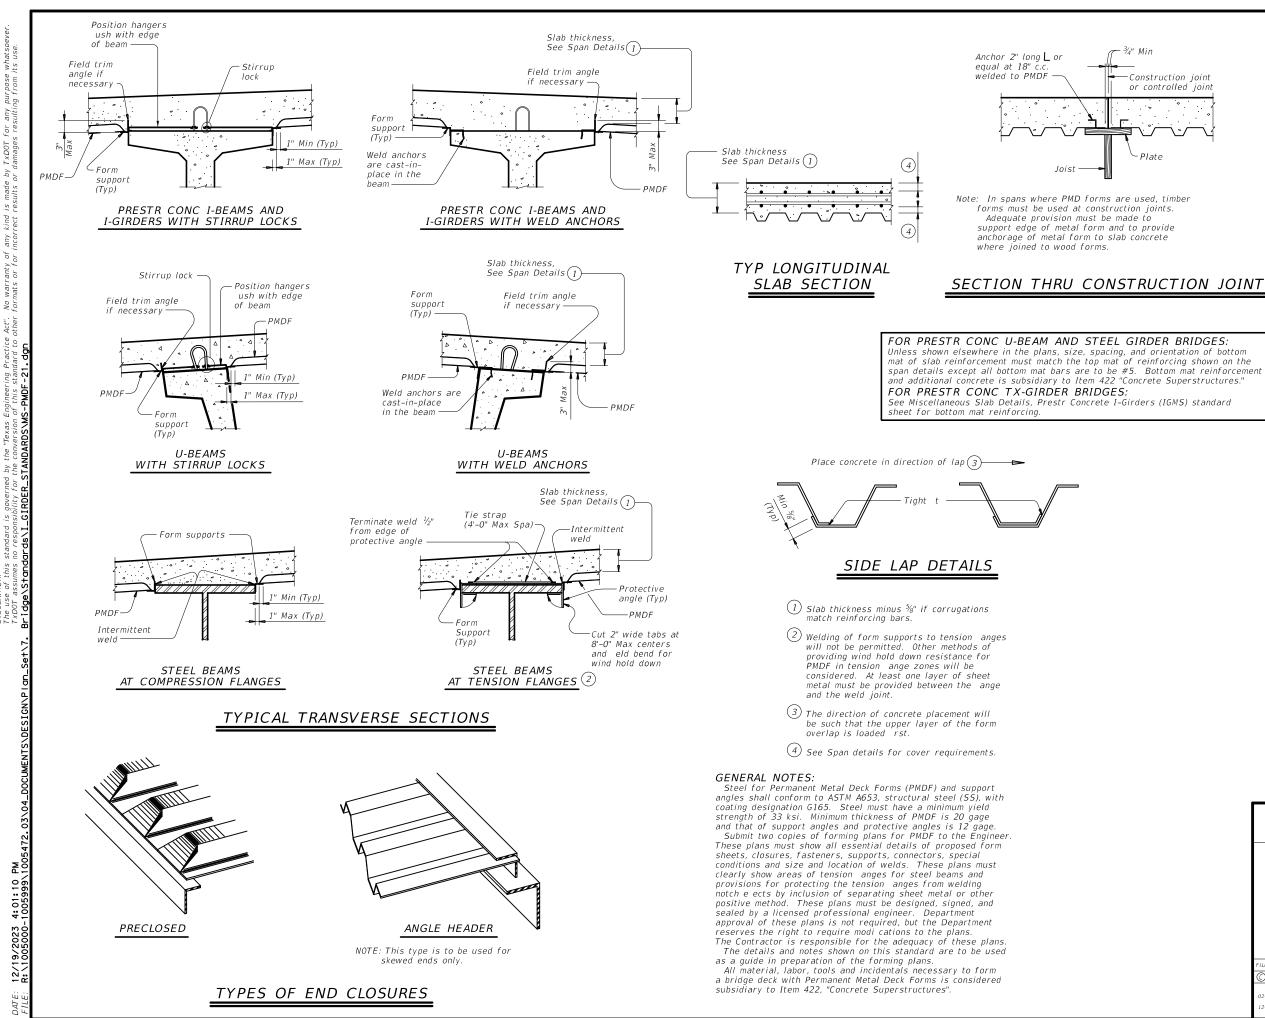

- 3⁄4" Min

-Construction joint or controlled ioint



Plate

DESIGN NOTES: As a minimum, PMDF and support angles must be designed for the dead load of the form, reinforcement and concrete plus 50 psf for construction loads. Flexural stresses due to these design loads must not exceed 75 percent of the yield strength of the steel. Allowable stress for weld metal must be 12,400 psi. Maximum de ection under the weight of forms. reinforcement and concrete or 120 psf, whichever is greater, shall not exceed the following:

> 1/180 of the form design span, but not more than 0.50", for design spans of 10' or less.

1/240 of the form design span, but not more than 0.75", for design spans greater than 10'.

1/240 of the form design span, but not more than 0.75", for all design spans of railroad overpass bridge spans fully or partially over railroad right-of-way, and for all bridge spans of railroad underpass structures.

The form design span must not be less than the clear distance between beam anges, measured parallel to the form utes, minus 2".

#### CONSTRUCTION NOTES:

Form sheets must not be permitted to rest directly on the top of beam anges. Form sheets must be securely fastened to form supports and must have a minimum bearing length of one inch at each end. Form supports must be placed in direct contact with beam anges

All attachments must be made by permissible welds, screws, bolts, clips or other means shown on the forming plans. All sheet metal assembly screws must be installed with torque-limiting devices to prevent stripping. Only welds or bolts must be used to support vertical loads.

Welding and welds must be in accordance with the provisions of Item 448, "Structural Field Welding", pertaining to llet welds. All welds must be made by a quali ed welder


in accordance with Item 448. All permanently exposed form metal, where the galvanized coating has been damaged, must be thoroughly cleaned and repaired in accordance with Item 445, "Galvanizing". Minor heat discoloration in areas of welds need not be touched up.

Flutes must line up uniformly across the entire width of the structure where main reinforcing steel is located in the ute.


Construction joints will not be permitted unless shown on the plans. The location of and forming details for any construction joint used must be shown on the forming plans. Forms below a construction joint must be removed after curing of the slab. A sequence for uniform vibration of concrete


must be approved by the Engineer prior to concrete placement. Attention must be given to prevent damage to the forms, yet provide proper vibration to prevent voids or honeycomb in the utes and at headers and/or construction joints.

SHEET 1 OF 2								
Texas Department		lge sion ndard						
PERMANENT METAL DECK FORMS PMDF								
FILE: MS-PMDF-21.dgn	DN: TXL			DW:	TxD0T	ск: TxD0T		
©TxDOT April 2019	CONT	SECT	JOB		HI	SHWAY		
REVISIONS	0923	17	084		CR	392		
			COUNTY			SHEET NO.		
12-21: Updated max de ection for RR.	BWD		COMANC	HE		69		

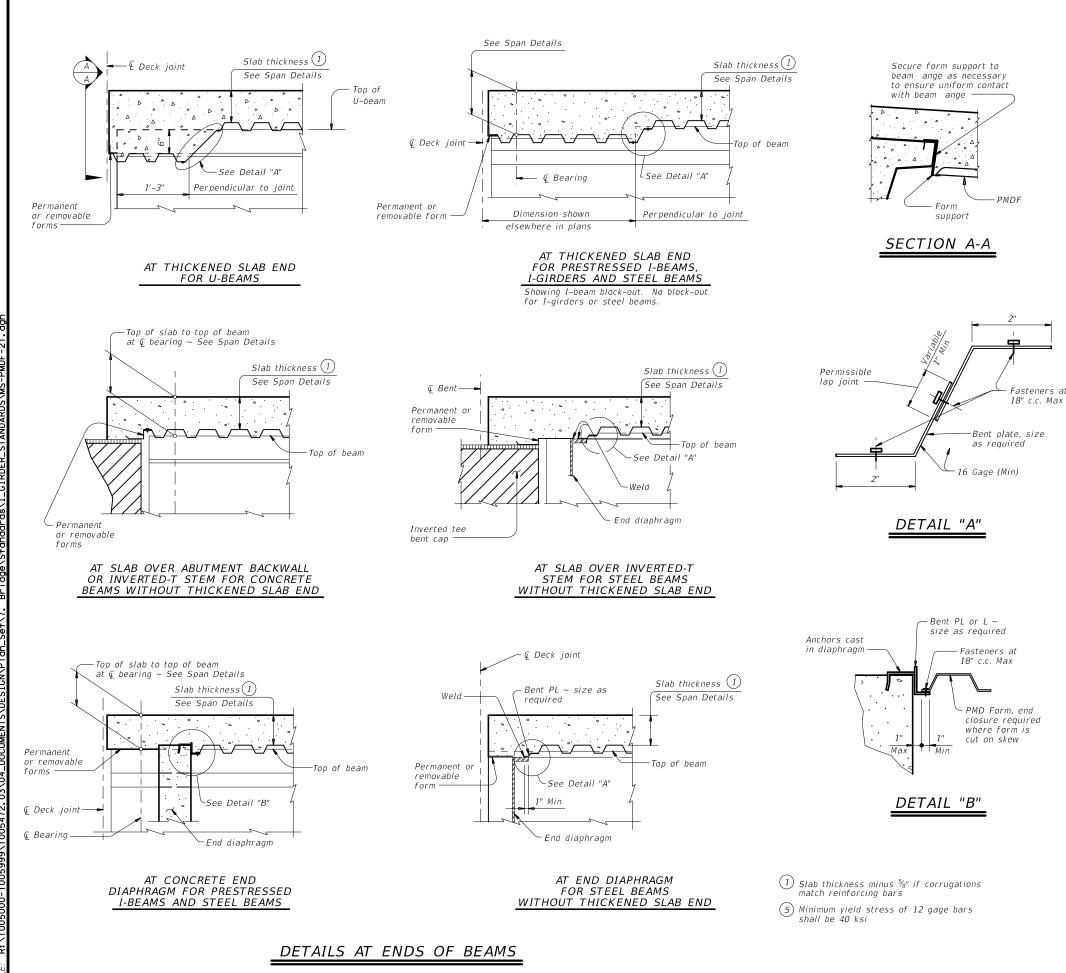

its use. No warranty of any kind is made by TxDOT for any purpose formats or for incorrect results or damages resulting from Act". other e, by governe bility fo. IRDER\_ ndard respon **ds/1\_** sta his ΜŠ 4:01:11 f 12/19/2023

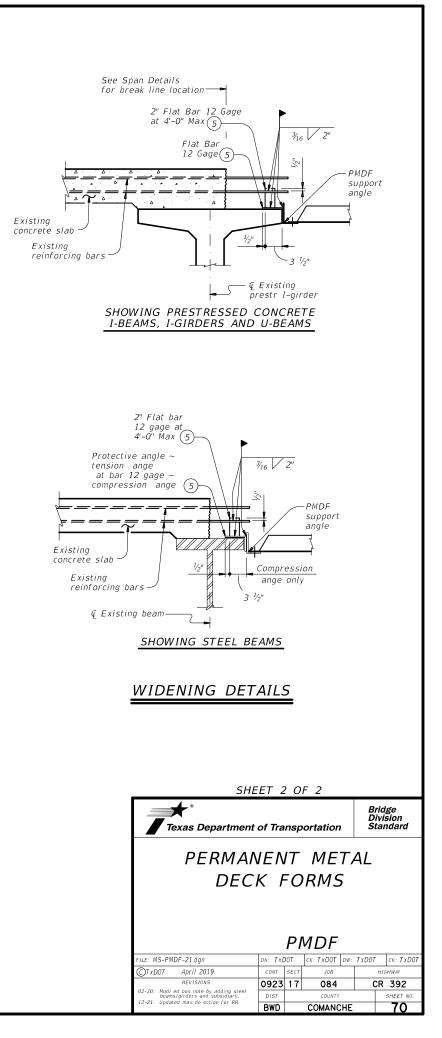

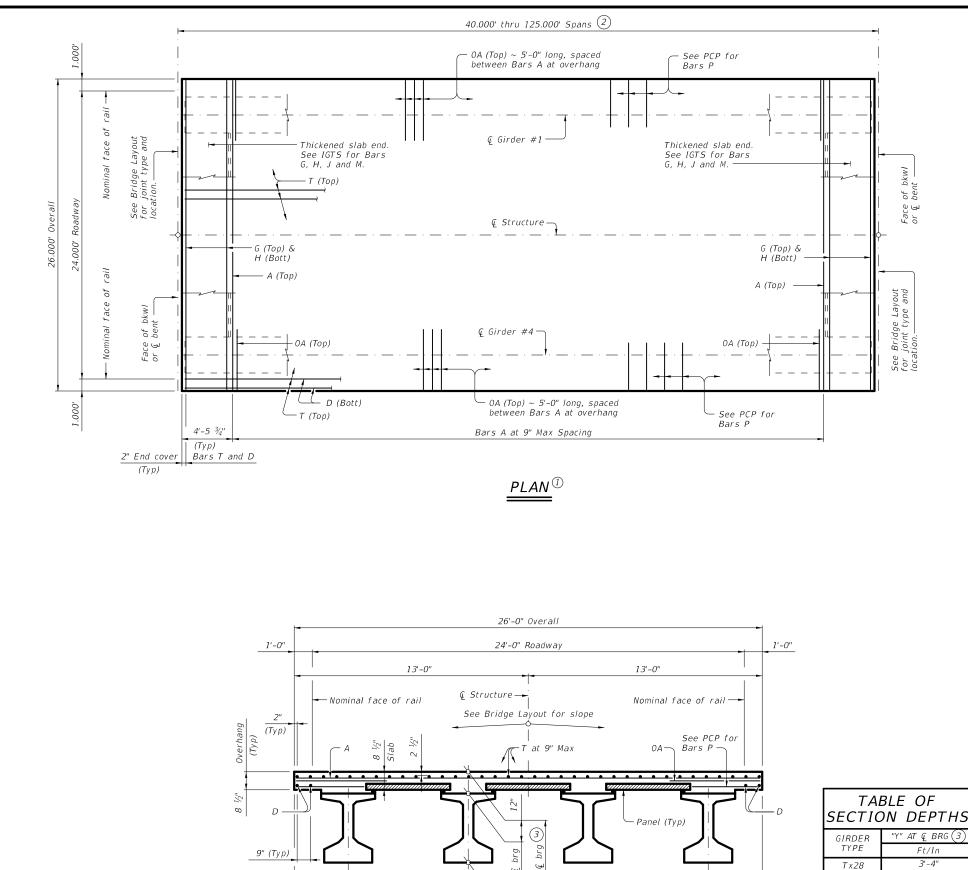



🗕 🕻 Girder #1



@ Girder #4 ─►

3.000'

(Showing girder type Tx46)

3 Spa at 6.667' = 20.000'

at Ç at

DATE:

BAR	TABLE
BAR	SIZE
Α	#4
D	#4
G	#4
Н	#4
J	#4
М	#4
0A	#5
Р	#4
Т	#4

If multi-span units (with slab continuous over interior bents) are indicated on the Bridge Layout, see standard IGCS for adjustment to slab reinforcement and quantities.

(2) Span lengths for Prestressed Concrete I-Girder type: Type Tx28 for spans lengths 40.000' thru 75.000'. Type Tx34 for spans lengths 40.000' thru 85.000'. Type Tx40 for spans lengths 40.000' thru 100.000'. Type Tx46 for spans lengths 40.000' thru 115.000'. Type Tx54 for spans lengths 40.000' thru 125.000'.

3'-10"

4'-4''

4' - 10''

5'-6"

Tx34

Tx40

Tx46

Tx54

(3) "Y" value shown is based on theoretical girder camber, dead load de ection from an 8  $\frac{1}{2}$  concrete slab, a constant roadway grade, and using precast panels (PCP). The Contractor will adjust this value as necessary for any roadway vertical curve.

HL93 LOADING	10	F 2						
Texas Department	of Tra	nsp	ortation	Di	idge vision andard			
PRESTRESSED CONCRETE I-GIRDER SPANS (TYPE Tx28 THRU Tx54) 24' ROADWAY SIG-24								
FILE: IG-SIG2400-23.dgn	DN: JN	H	CK: NRN DW:	JTR	ск: TAR			
©TxDOT August 2017	CONT	SECT	JOB		HIGHWAY			
REVISIONS	0923	17	084	С	R 392			
10-19: Increased "X" and "Y" Values. 01-23: Removed PCP(0) reference.	DIST		COUNTY		SHEET NO.			
	BWD		COMANCHE		71			

# TABLE OF DEAD LOAD DEFLECTIONS

TYPE

SPAN LENGTH

Ft 40

45

50

55 60 65


70 75 80

115

TYPE	Tx28 GII	RDERS	TYPE	Tx34 GIH	RDERS
SPAN LENGTH	"A"	"B"	SPAN LENGTH	"A"	<i>"B"</i>
Ft	Ft	Ft	Ft	Ft	Ft
40	0.007	0.010	40	0.004	0.006
45	0.012	0.017	45	0.007	0.010
50	0.019	0.027	50	0.011	0.016
55	0.028	0.040	55	0.017	0.024
60	0.041	0.057	60	0.024	0.034
65	0.056	0.079	65	0.033	0.047
70	0.077	0.108	70	0.046	0.064
75	0.102	0.143	75	0.061	0.085
			80	0.079	0.111
			85	0.102	0.143

SPAN	Tx40 GII	
LENGTH	"A"	"B"
Ft	Ft	Ft
40	0.003	0.004
45	0.005	0.007
50	0.007	0.010
55	0.011	0.016
60	0.016	0.022
65	0.022	0.031
70	0.030	0.042
75	0.040	0.056
80	0.052	0.073
85	0.066	0.093
90	0.084	0.118
95	0.105	0.147
100	0.130	0.182

						TAR	LE OF	ECTIM			TIES
						TADI				UANTI	ILS
Tx46 GII	RDERS	TYPE	Tx54 GIH	4 GIRDERS				Prestres	sed Concrete	Girders	TOTAL 5
"A"	"B"	SPAN LENGTH	"A"	"B"		SPAN LENGTH	REINF CONCRETE SLAB	ABUT TO 4	INT BT	ABUT TO 4	TOTAL REINF STEEL
Ft	Ft	Ft	Ft	Ft				INT BT	INT BT	ABUT	
0.002	0.003	40	0.001	0.002		Ft	SF	LF	LF	LF	Lb
0.004	0.005	45	0.002	0.003		40	1,040	158.00	158.00	158.00	2,392
0.005	0.007	50	0.004	0.005		45	1,170	178.00	178.00	178.00	2,691
0.008	0.011	55	0.005	0.007		50	1,300	198.00	198.00	198.00	2,990
0.011	0.015	60	0.007	0.010		55	1,430	218.00	218.00	218.00	3,289
0.015	0.021	65	0.010	0.014		60	1,560	238.00	238.00	238.00	3,588
0.021	0.029	70	0.014	0.019		65	1,690	258.00	258.00	258.00	3,887
0.027	0.038	75	0.018	0.025		70	1,820	278.00	278.00	278.00	4,186
0.036	0.050	80	0.024	0.033		75	1,950	298.00	298.00	298.00	4,485
0.046	0.064	85	0.030	0.042		80	2,080	318.00	318.00	318.00	4,784
0.057	0.080	90	0.038	0.053		85	2,210	338.00	338.00	338.00	5,083
0.071	0.100	95	0.047	0.066		90	2,340	358.00	358.00	358.00	5,382
0.088	0.124	100	0.058	0.082		95	2,470	378.00	378.00	378.00	5,681
0.108	0.151	105	0.071	0.100		100	2,600	398.00	398.00	398.00	5,980
0.130	0.182	110	0.086	0.121		105	2,730	418.00	418.00	418.00	6,279
0.156	0.219	115	0.103	0.144		110	2,860	438.00	438.00	438.00	6,578
		120	0.123	0.172		115	2,990	458.00	458.00	458.00	6,877
		125	0.145	0.203		120	3,120	478.00	478.00	478.00	7,176
					•	125	3,250	498.00	498.00	498.00	7,475

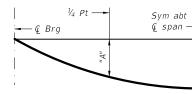

# DEAD LOAD DEFLECTION DIAGRAM

Calculated de ections shown are due to the concrete slab on interior girders only (Ec = 5000 ksi). Adjust values as required for exterior girders and if optional slab forming is used. These values may require eld veri cation.

DATE:

€ span —

# (5) Reinforcing steel weight is calculated using an approximate factor of 2.3 lbs/SF.

(4) Fabricator will adjust lengths for girder slopes as required.

### MATERIAL NOTES:

Provide Class 5 concrete (f'c = 4,000 psi). Provide Class 5 (HPC) concrete if shown elsewhere in the plans.

Provide Grade 60 reinforcing steel.

Provide bar laps, where required, as follows: Uncoated  $\sim #4 = 1'-7"$ Epoxy coated  $\sim #4 = 2'-5"$ 

Deformed welded wire reinforcement (WWR) (ASTM A1064) of equal size and spacing may be substituted for Bars A, D, OA, P or T unless noted otherwise.

### GENERAL NOTES:

Designed according to AASHTO LRFD Bridge Design Speci cations.

Multi-span units, with slab continuous over interior bents, may be formed with the details shown on this sheet and the I-Girder Continuous Slab Detail (IGCS) standard. See I-Girder Thickened Slab End Details (IGTS) standard

for details and quantity adjustments.


See Prestressed Concrete Panels (PCP) standard and Prestressed Concrete Panel Fabrication Details (PCP-FAB) standard for panel details not shown.


See I-Girder Miscellaneous Slab Details (IGMS) standard for miscellaneous details. See applicable rail details for rail anchorage in slab.

See Permanent Metal Deck Forms (PMDF) standard for details and quantity adjustments if this option is used. This standard does not support the use of transition bents.


Cover dimensions are clear dimensions, unless noted otherwise.

HL93 LOADING SHEET 2 OF 2									
Image: Texas Department of Transportation     Bridge Division Standard									
PRESTRESSED CONCRETE I-GIRDER SPANS (TYPE Tx28 THRU Tx54) 24' ROADWAY									
FILE: IG-SIG2400-23.dgn	DN: JN		IG-2	. 🛨 DW: JTF	R ск: TAR				
©TxDOT August 2017	CONT	SECT	JOB		HIGHWAY				
REVISIONS	0923	0923 17 084			CR 392				
10-19: Increased "X" and "Y" Values. 01-23: Removed PCP(0) reference.	DIST	IST COUNTY			SHEET NO.				
	BWD		COMANC	HE	72				

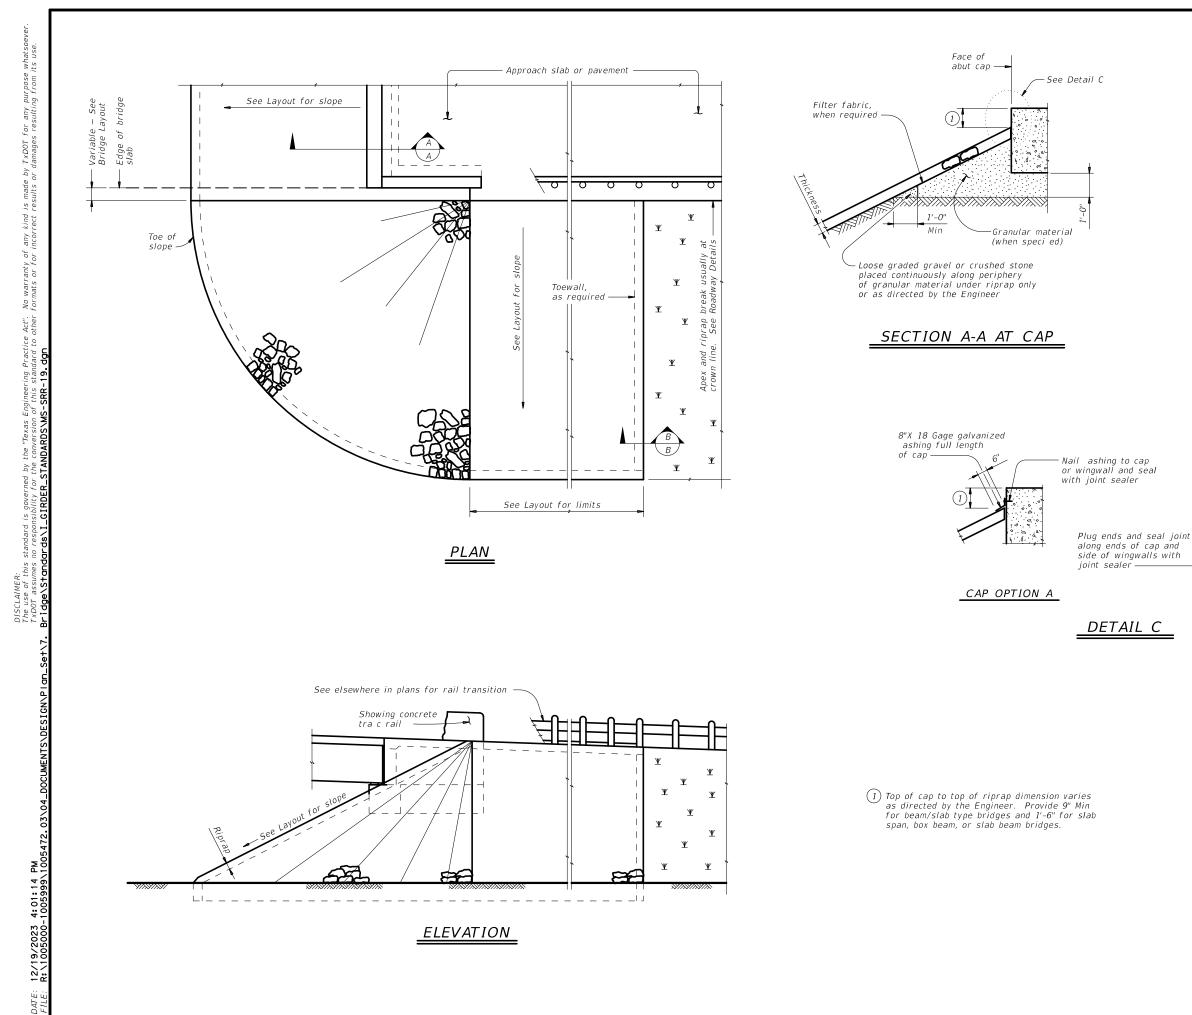

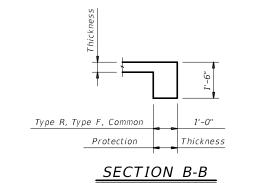


Provide toewall when shoulder drain is located adjacent to limits of stone riprap. Omit toewall when thickness of protection riprap is greater than 18".

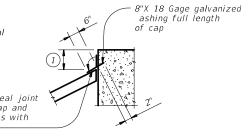



CAP OPTION B

**GENERAL NOTES:** Refer to Item 432, "Riprap" for stone size and gradation, and construction details. See Layout for limits and thickness of riprap speci ed. See elsewhere in plans for locations and details of shoulder drains.

SHEET 1 OF 2							
Texas Department	of Tra	nsp	ortation	1	Div	dge ision ndard	
STONE RIPRAP							
		_					
		Sł	RR				
FILE: MS-SRR-19.dgn	DN: AE	5	ск: JGD	DW:	BWH	ск: AES	
CTxDOT April 2019	CONT	SECT	JOB		Н	IGHWAY	
REVISIONS	0923	17	084		CF	392	
	DIST		COUNT	(		SHEET NO.	
	BWD		COMAN	CHE		73	

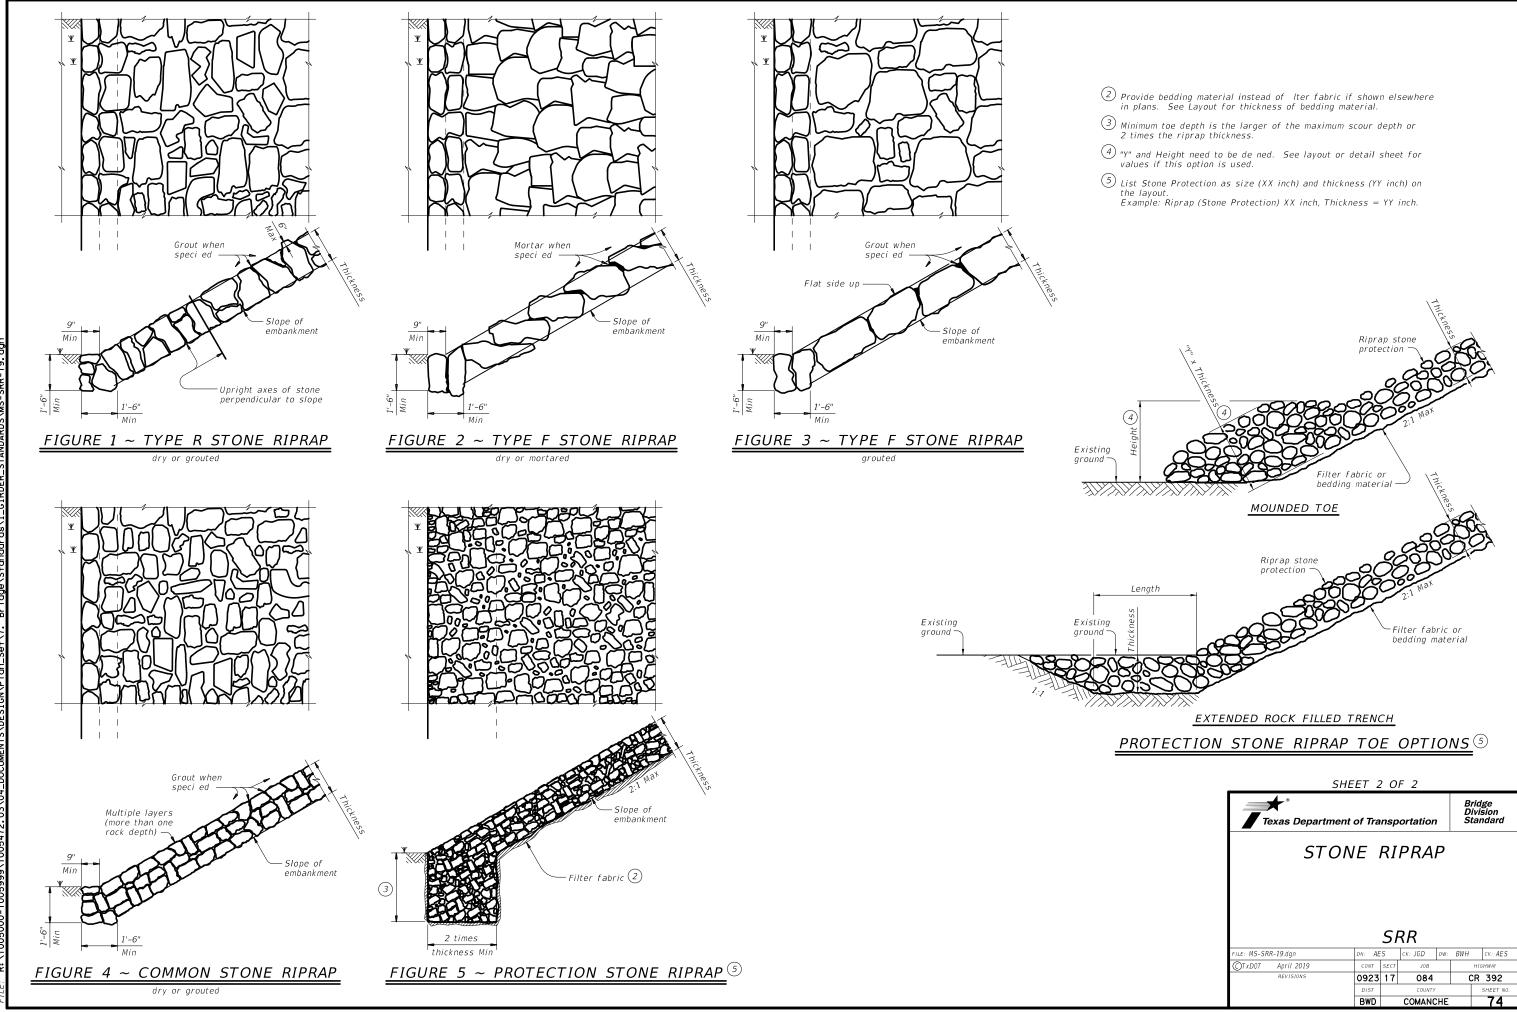

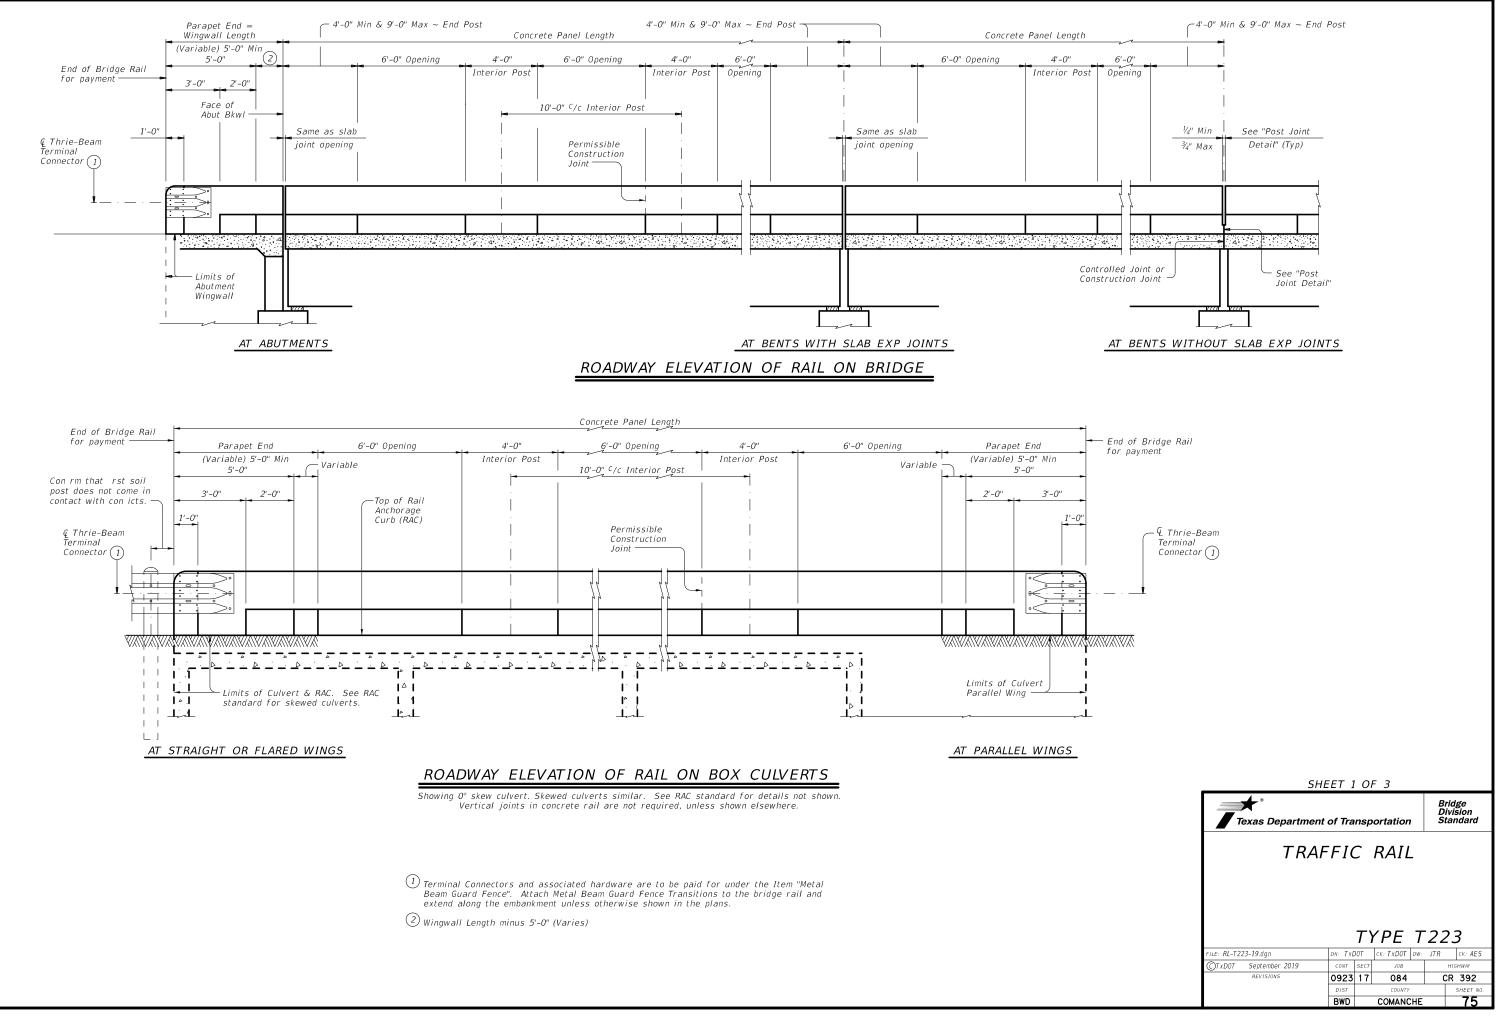

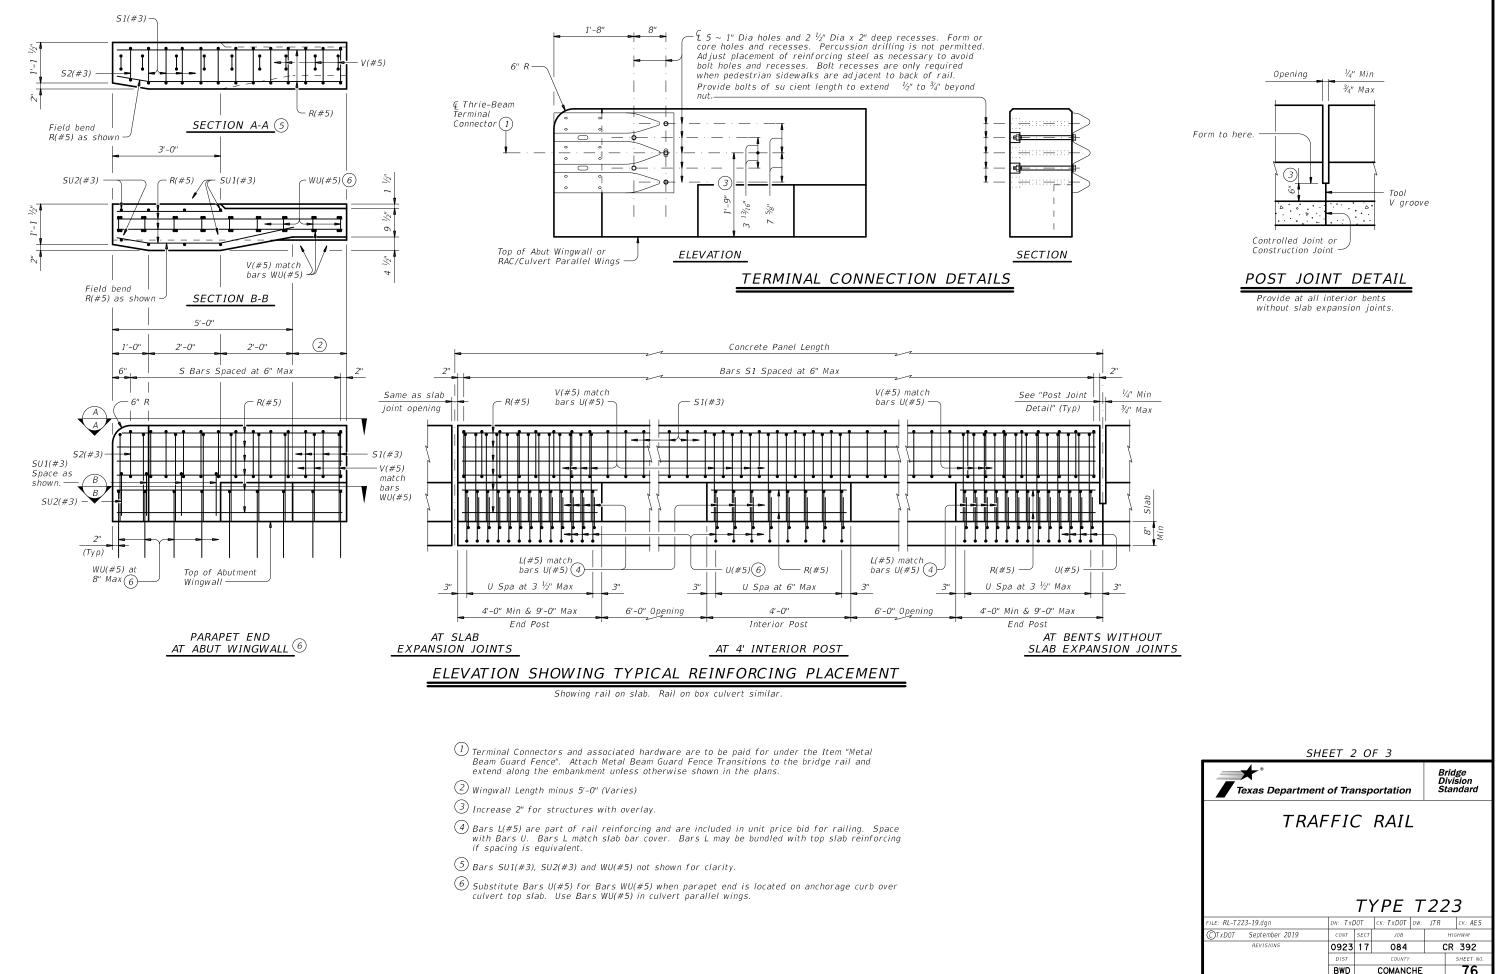

whatso its use.

No warranty of any kind is made by TxDOT for any purpose formats or for incorrect results or damages resulting from


Act". other

his

ΜŠ

12/19/2023 4:01:16 P:\1005000-10059<u>9</u>9\

DATE:

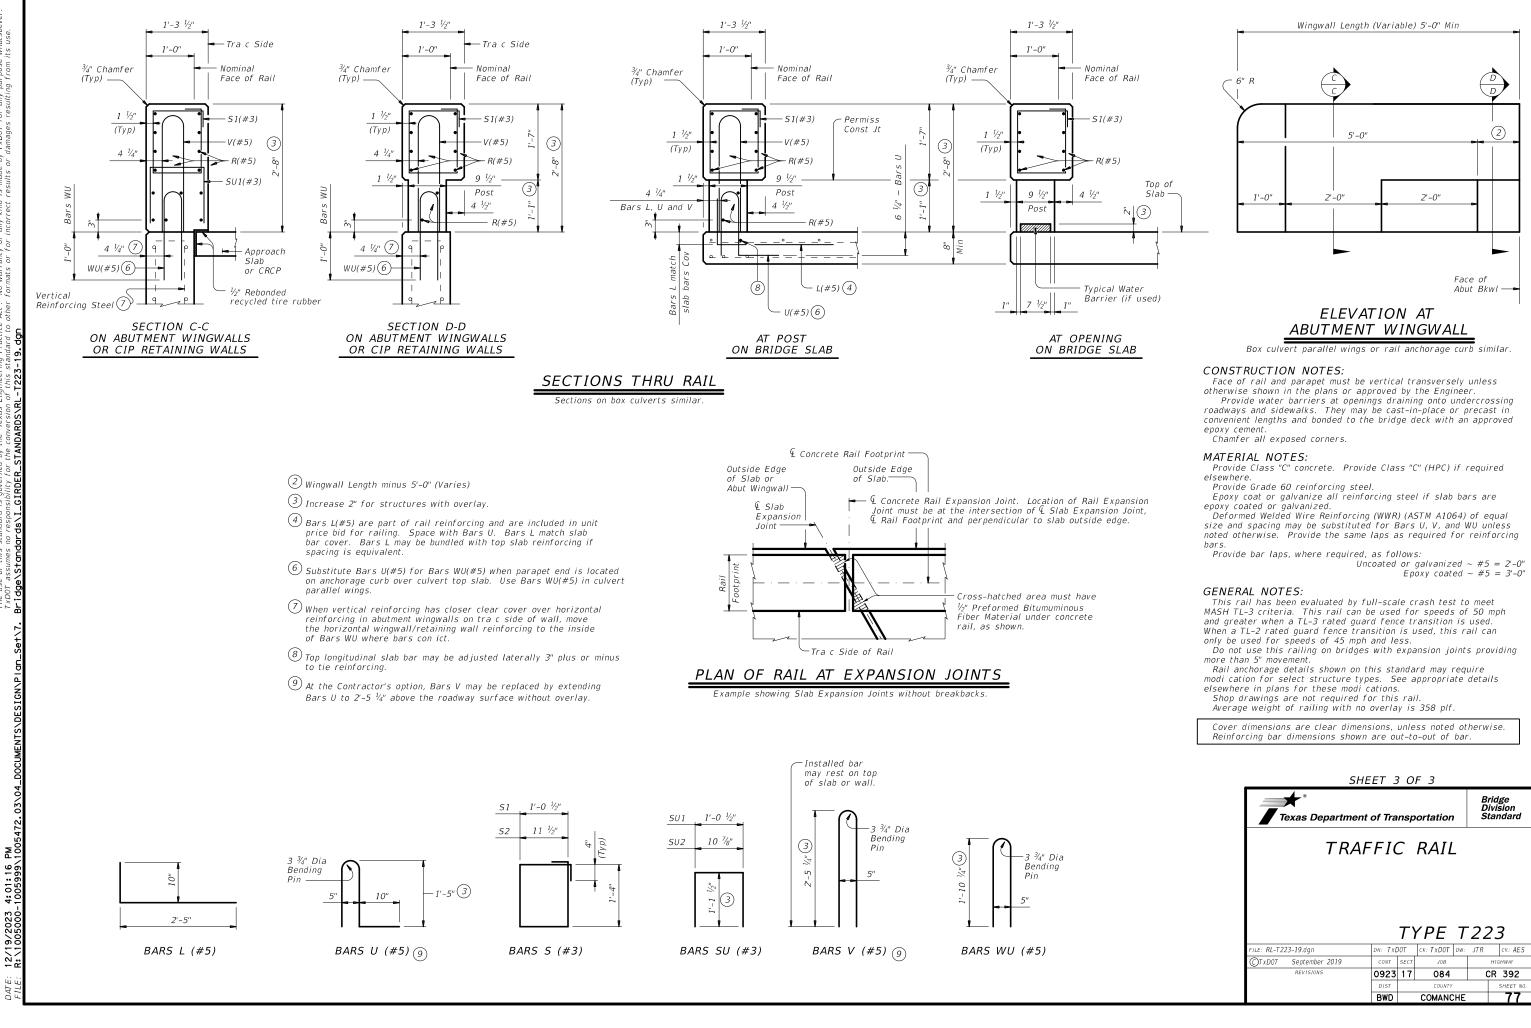

whatso its use.

No warranty of any kind is made by TxDOT for any purpose formats or for incorrect results or damages resulting from

Act". other

his

	T	YPE	T	22	?3
N/ -	TYDOT	CK. TYDOT	0.0	ITD	CK.

FILE: RL-1225-19.091		DN: IXL	101	CK: TXDUT	DW:	JIR	UK: AES
©TxD0T Se	ptember 2019	CONT	SECT	JOB		H	IGHWAY
R	EVISIONS	0923	17	084		CF	392
		DIST		COUNTY			SHEET NO.
		BWD		COMANC	HE		77

ſ	During the planning phase of project development the follow	•			III. Cultu	ral Resources	VI. Hazardous Material or Cont	mination Issues
	have been developed during coordination with resource ager public. Any change orders and/or deviations from the fin	•	•	(Addresses any special circ		resources, such as archeological or historic sites.)	(Addresses any previously identified high risk sites associated with hazardous	
	to the commencement of construction activities, as additional	•	•			flint, pottery, etc.; cease work in the immediate area and		
4	I. Clean Water Act, Sec. 402 Texas Poll			No Action Required			Comply with the Hazard Communication Act (the Act) for per hazardous materials by conducting safety meetings prior to making workers aware of potential hazards in the workplace	beginning construction and
201	(Addresses CGP and MS4 Storm Water requirements for the project.						provided with personal protective equipment appropriate for	
271	(In the event that the Contractor Implements a PSL on or within one mil	ile of the project, a Site Notice and/or o	a NOI will apply.)				Obtain and keep on-site Material Safety Data Sheets (MSDS used on the project, which may include, but are not limit	
red 6/	No Action Required Required Action			Action No. 1.	Station (Rt/Lt) 	Commitment 	Paints, acids, solvents, asphalt products, chemical addit compounds or additives. Provide protected storage, off ba	ves, fuels and concrete curing re ground and covered, for
. YQ	Action No. 1 Con	mmitment No. 1					products which may be hazardous. Maintain product labelli	
dgn UF	of surface area. The contractor is responsible It	efer to the SW3P Plan Sheet, will address sweeping, cher anitary waste, and all other	nical storage,				Maintain an adequate supply of on-site spill response mate In the event of a spill, take actions to mitigate the spi in accordance with safe work practices, and contact the D immediately. The Contractor shall be responsible for the	I as indicated in the MSDS, strict Spill Coordinator
17083. 0	of Highways, Street, and Bridges (2014 Edition, Section 7.7.6, Page 42). The total disturbed acreage is the combined acreage to be disturbed						of all product spills. Contractor will follow all applicable storage and managem liquid petroleum products, and other chemical liquids as j	
-0923	on the project and the contractor's PSL. The EPIC must be updated if the disturbed area						TCEQ Construction General Permit for storm water management Contact the Engineer if any of the following are detected:	
I VEP I C	increases to one or more acres during the course of construction (refer to following sections). It may become necessary to post MS	S4 operators that receives d	ischarge from the				Dead or distressed vegetation (not identified as normal Trash piles, drums, canisters, barrels, etc. Undesirable smells/odors	
ento	a site notice and/or NOI for the project and/ pro or PSL.	roject: -N/A-					Underground storage tanks Evidence of leaching or seepage of substances	
a mo	II. Clean Water Act, Section	n 401 and 404 Complian	ce			tion Resources	Any other evidence indicating possible hazardous materia	uls or contamination discovered on-site
ro	(Addresses Nationwide Permits, Individual Permits, and Wetlands,)			(Addresses any special circ that will occur as part of th	umstances associated with vegetation project.)	on, such as large trees to be avoided, or mitigation		
ss∖E∩v	(Filling, dredging, or excavating in any water bodies, rivers, creeks, in the USACE permit and approved by the Engineer.) (When temporary fill is implemented, only stated TxDOT standards wil			No Action Required	Required Actio		Does the project involve any bridge class structure rehab structure not including box culverts)?	litation or replacements (bridge class
ache	obtained from the Enginéer. No equipment is allowed in any stream temporary stream crossings or drill pads.)	channel below the Ordinary High Water N	lark except on		_		Yes	No No
Appro	No Action Required 🛛 🖌 404 Permit and 401 (	Certification Required		Action No.	Station (Rt/Lt)	Commitment Avoid non-mow locations for stockpiles and	If "No", then no further action is required. If "Yes", then TxDOT is responsible for completing an asb	
pup	Permit Required Action Water	rs of the US A	pp, Plan Sheet(s)			equipment parking/storage.	Are the results of the asbestos inspection positive (is	
- Replace Bridge	NWP ∎14 Adher to permit and Resle general/regional conditions	ey Creek S	ee Bridge Layout	2.	Project Limits	Preserve native vegetation to the extent practical. Contractor must adhere to Construction Specification Requirements Specs 162, 164, 192, 193, 506, 730, 751, 752 in order to comply with requirements for invasive species, beneficial landscaping, and tree/brush removal commitments.	Yes If "Yes", then TxDOT must retain a Texas Department of Stu- asbestos consultant to assist with the notification, deve perform management activities as necessary. The notifica- least 15 working days prior to scheduled abatement and/or If "No", then TxDOT is still required to notify DSHS 15 wo	op abatement/mitigation procedures, and ion form to DSHS must be postmarked at demolition.
kesley Cr.							demolition. In either case, the Contractor is responsible for providin and/or demolition with careful coordination between the En to minimize construction delays and subsequent claims.	gineer and asbestos consultant in order
382 @ F				,		ed, Endangered Species, Critical Habitat, es, and Migratory Bird Treaty Act (MBTA)	Bridges on this project may contain Lead-Containing Paint The location of (LCP) is identified in the General Notes.	(LCP) or other items that contain lead.
СR	Best Management Practices for applicable 401 Genera			(Addresses any special habi observed and might be impo	tat that may need to be avoided, lis acted within the project area, and	ts any threatened or endangered species where habitat was lists any precautions such as nesting seasons for migratory birds.)	Standard Specifications shall be utilized for this projec	·.
083	General Condition 12 - Categories I and II BMPs ( Category I (Erosion Control)	required			_		VII. Other Environmento	
1	Temporary Vegetation	Blankets, Matting		No Action Required	Required Actio	n	(Addresses any other environmental issues that may not have been covered in oth	
ĥ	Mulch							
60	Interceptor Swale	Diversion Dike		Species Potentially wit		Habitat Description	No Action Required 🗌 Required Action	
he	Erosion Control Compost	🗌 Mulch Filter Berms ar	nd Socks	Project Area & Descript				
anc	Compost Filter Berms and Socks	Compost Blankets				d be various species in the project Zone-tailed Hawk, Avoid placing Project		
۳. ۲	Category II (Sedimentation Control)			-		er ants. If there are large nests observed	Action No. Station (Rt/Lt) Commitm	ent
.s/(	Sand Bag Berm	Rock Berm				nmental Coordinator prior to cutting down. m to any species should be avoided.Contact		
* ÷	Silt Fence	🗌 Hay Bale Dike		-		Chisholm (325) 643-0442 with any questions.		
* C	Triangular Filter Dike	Brush Berms					LIST OF ABBREVIATIONS	CR 392
* *∍ c	Stone Outlet Sediment Traps	Sediment Basins					BMP: Best Management Practice CCP: Construction General Permit	ENVIRONMENTAL
* F 5	Erosion Control Compost	🕊 Mulch Filter Berms or	nd Socks				DSH5: Texas Department of State Health Services FEMA: Federal Emergency Management Agency	PERMITS, ISSUES,
ж о Оес	Compost Filter Berms and Socks			The Misselson Died Tee			FHWA: Federal Highway Administration MOA: Memorandum of Agreement	AND COMMITMENTS
× 5 ×	General Condition 25 - Category III BMPs require	ed				hat it is unlawful to kill, capture, collect, gratory bird, nest, young, feather, or egg in	MOU: Memorandum of Understanding MS4: Municipal Separate Stormwater Sewer System MBTA: Migratory Bird Treaty Act	
* * * 3 8 TEA	Category III (Post-Construction TSS Control)			part or in whole, witho	out a federal permit iss	ued in accordance within the Act's policies and	MBIA: Migratory Bird ireaty Act NOI: Notice of Intent NOT: Notice of Termination	(EPIC)
*** SG	Retention/Irrigation	Constructed Wetlands				affected by the proposed project. The nests from any structure where work would be	NWP: Nationwide Permit SPCC: Spill Prevention Control and Countermeasure	©2023
4/2 WDC	Extended Detention Basin Vegetative Filter Strips	Wet Basins	bee			ary. In addition, the contractor will be	SW3P: Storm Water Pollution Prevention Plan PCN: Pre-Construction Notification	Texas Department of Transportation
ed by ***********************************	Vegetative Filter Strips Grassy Swales	Vegetation-Lined Dito	6 IE 3			ing nests between March 1 and August 31, per the	TCEQ: Texas Commission on Environmental Quality	
	Grassy swales     Erosion Control Compost	Mulch filter Berms an	nd Socks			(EPIC) plans. In the event that migratory birds ction, adverse impacts on protected birds, active	TPDES: Texas Pollutant Discharge Elimination System TPWD: Texas Parks and Wildlife Department TxDDI: Texas Department of Transportation	CONT         SECT         JOB         HIGHWAY           0923         17         084         CR 392
Prepar DATE: FILE:	Compost Filter Berms and Socks	Sedimentation Chamber		nests, eggs, and/or you			T&Diff Texas beparament of Transportation T&E: Threatened and Endangered Species USACE: U.S. Army Corp of Engineers USFWS: U.S. Fish and Wildlife Service	DIST COUNTY SHEET NO. BWD COMANCHE 78

Korrester in the second s	This SWP3 has been developed in accordance with TxDOT policy for projects disturbing less than 1 acre of soil, and not part of a larger common plan of development.	in Attachment 1.2 of this SWF preconstruction meetings or d process. Please choose from	e Environmental Layout Sheets 23. PSLs may be identified during luring the construction the options below:	<ul> <li>1.10 POTENTIAL POLLUTANT</li> <li>X Sediment laden stormwater from disturbed area</li> <li>X Fuels, oils, and lubricants from and storage</li> </ul>	m stormwater conveyance over construction vehicles, equipment
Type         Sheet #s         Construction decirs and waste from various construction applicable storements practice storements practice storements practice and waste from outputs construction applicable storements practice storements practice storements practice storements practice storements and waste from outputs construction applicable storements practice storements practice storements practice storements and waste from outputs construction applicable storements practice storements and waste from outputs construction applicable storements practice storements and waste from outputs construction applicable storements and waste from outputs construction applicable storements and approaches.         Construction decirs and waste from outputs construction applicable storements and matching promoted applicable storements and approaches.         Construction decirs and waste from outputs construction applicable storements and by the contractor and historements and matching promoted applicable storements and by the contractor and historements and from outputs construction applicable storements and from outputs construction applicable storements and from outputs construction applicable storements and from outputs and promoted applicable storements and from outputs applicable storements and from outputs and promoted applicable storements and from outputs applicable storements and from output storementstore decirations applicable down output storements and		□ PSLs determined during co	nstruction	activities	
This SWP3 is consistent with requirements presented in projects entiremental presented in the projects entiremental presented in the project sentence matrix presented in the sentence matrix present sentence matrix presents present in the project sentence matrix presents present in the project sentence matrix presents present in the project sentence material proper present present in the project sentence matrix presents present in the project sentence matrix presents present in the project sentence matrix presents present presents in the project sentence matrix presents present present present in the project sentence matrix presents present pre		•		X Construction debris and waste	-
1.0 SITE/PROJECT DESCRIPTION       X Traff from various construction activities/receptacles         1.1 PROJECT CONTROL SECTION JOB (CSJ):       X Long-term stockples of material and waste         1.2 PROJECT LIMITS:       Image: Construction activities/receptacles         Tor	applicable stormwater plans, and the project's environmental			X Contaminated water from excav	
1.1 PROJECT CONTROL SECTION JOB (CSJ):       CSJ: 0923-17-084         1.2 PROJECT LIMITS:				X Trash from various construction	n activities/receptacles
1.2 PROJECT LIMITS:	1.1 PROJECT CONTROL SECTION JOB (CSJ):			X Long-term stockpiles of materia	al and waste
To:	1.2 PROJECT LIMITS:	-		□ Other:	
1.3 PROJECT COORDINATES:       All off-ROW PSLs required by the Contractor are the Contractor and promits required by lock, state, federal laws for off-ROW PSLs. The contractor shall secure all provide diagrams, areas of disturbance, acreage, and by lock, state, federal laws for off-ROW PSLs. within one mile of the project.          Other:         1.4 TOTAL PROJECT AREA (Acres): 0.91          Description         Is for all off-ROW PSLs within one mile of the project.           1.1 RECEIVING WATERS:         Recolving within some mile of the project.          1.5 TOTAL AREA TO BE DISTURBED (Acres): 0.35          I.9 CONSTRUCTION ACTIVITY:         Replacement of bridge consisting of replace bridge         and approaches.           1.9 CONSTRUCTION ACTIVITY:         Recolving within some mile or the project.          1.7 MAJOR SOIL TYPES:          Is and the AOI: Occasionally its of the AOI: Occasionally its of the AOI: Occasionally its of the AOI: Occasionally its off and approaches, safety and reparse subgrade for proposed pavement widening         and approaches, well drained, low runoff, slight erosion         well drained, low runoff, slight erosion         Achieve site stabilization and remove sediment and erosion controls massures         Other:					
BEGIN: (Lat) 31*50/45.86°N       _(Long) 98*1474.82°W         END: (Lat) 31*50/22.36°N       _(Long) 98*1406.15°W         1.4 TOTAL PROJECT AREA (Acres): 0.91			the Contractor are the Contractor's		
END:       (Lat) 31*30*22:30 R. (_Cong): 96*14*06.15 W         1.4 TOTAL PROJECT AREA (Acres):       0.91         1.5 TOTAL AREA TO BE DISTURBED (Acres):       0.35         1.6 NATURE OF CONSTRUCTION ACTIVITY:       Explacement of bridge consisting of replace bridge and approaches.       1.9 CONSTRUCTION ACTIVITIES:         1.7 MAJOR SOIL TYPES:       X Mobilization       X Mobilization         Soil Type       Description       Cassified existing portion, silght erosion         10% (Frio) silty clay, (0)       100% of the ADJ, coccasionally for other and claws as a starting position thow there are subgrade for proposed pavement widening       Reside of the across targe as a starting and the across stopes at and graps coches.         10% (Frio) silty clay, (0)       100% of the ADJ, coccasionally for other ADJ (coccasionally for the ADJ, coccasionally for the ADJ, coccasionally for the ADJ, coccasionally for the ADJ. Coccasionaly for the ADJ. Coccasionally for the ADJ. Coccasionally	BEGIN: (Lat)_31°50'45.86"N,(Long)_98°13'14.82"W	responsibility. The Contractor	shall secure all permits required	Other:	
1.5 TOTAL AREA TO BE DISTURBED (Acres): 0.35         1.6 NATURE OF CONSTRUCTION ACTIVITY:         Replacement of bridge consisting of replace bridge and approaches.         1.7 MAJOR SOIL TYPES:         Soil Type         Description         Sill coded, high water holding capacity, to 1) percent slopes         (100% (Frio) slip (cay, (0) (100% (Fri	END: (Lat) 31°50'22.36"N ,(Long) 98°14'06.15"W	-			
1.5 TOTAL AREA TO BE DISTUREED (Acres): 0.35       1.9 CONSTRUCTION ACTIVITY:         1.6 NATURE OF CONSTRUCTION ACTIVITY:       (Use the following list as a starting point when developing the and paproaches.       1.9 CONSTRUCTION ACTIVITY:         Replacement of bridge consisting of replace bridge and paproaches.       1.9 CONSTRUCTION ACTIVITY:       Receiving waters must be depicted on the Environmental Layout #for ecciving waters must be depicted on the Environmental Layout #for ecciving waters must be depicted on the Environmental Layout #for ecciving waters must be depicted on the Environmental Layout #for ecciving waters must be depicted on the Environmental Layout #for ecciving waters must be depicted on the Environmental Layout #for ecciving waters must be depicted on the Environmental Layout #for ecciving waters must be depicted on the Environmental Layout #for ecciving waters must be depicted on the Environmental Layout #for ecciving waters must be depicted on the Environmental Layout #for ecciving waters must be depicted on the Environmental Layout #for ecciving waters must be depicted on the Environmental Layout #for ecciving waters must be depicted on the Environment #for ecciving waters must be depicted on the Environment #for ecciving waters must be depicted on the Environment #for ecciving waters must be depicted on the Environment #for ecciving waters must be depicted on the Environment #for ecciving waters must be depicted on the Environment #for ecciving waters must be depicted on the Environment #for ecciving waters must be depicted on the Environment #for ecciving waters must be depicted on the Environment #for ecciving waters must be depicted on the Environment #for ecciving waters must be depicted on the Environment #for ecciving waters.         100% (Frio) silty clay, (0       100% of the AOI, Occasionally #for exceeded preve	1.4 TOTAL PROJECT AREA (Acres): 0.91	BMPs for all off-ROW PSLs w	ithin one mile of the project.		
Replacement of bridge consisting of replace bridge       Construction Activity Schedule and Ceasing Record in Attachment 2.3.)       Tributaries       Classified Waterbody         1.7 MAJOR SOIL TYPES:       Soil Type       Description       X Install sediment and erosion controls       Blade existing pavement       No TMDLs or I-Plans were identified.         100% (Frio) sity clay, (0       100% of the AOI, Occasionally widering       Widening       Remove existing controls state and prepare subgrade for proposed pavement widening       No TMDLs or I-Plans were identified.         X Install sediment and erosion controls       Blade existing controls, safety end treatments (SETs)       No TMDLs or I-Plans were identified.         X Install roopsed pavement pains       Remove existing matel beam guraf fence (MBGF), bridge rail       No TMDLs or I-Plans were identified.         X Install move existing curve existing cur				Receiving waters must be depicte Sheets in Attachment 1.2 of this S	
and approaches.       Attachment 2.3.)       Xattachment 2.3.)       * Attachment 2.3.)         Attachment 2.3.)       Xabilization       * Leon River below Proctor Lake-Category: 5:0 Parameter: Bacterian water (Recreating Use)         1.7 MAJOR SOIL TYPES:       Blade existing topsoli into windrows, prep ROW, clear and grub       * Resley Creek (1221A)       * Leon River below Proctor Lake-Category: 5:0 Parameter: Bacterian water (Recreating Use)         100% (Frio) sity clay, (0)       100% of the AOI, Occasionally       Scial Type       Scial Type       No TMDLs or I-Plans were identified.         100% (Frio) sity clay, (0)       100% of the AOI, Occasionally       Remove existing nutlers, safety end treatments (SETs)       No TMDLs or I-Plans were identified.         100% (Frio) sity clay, (0)       100% of the AOI, Occasionally       Remove existing nutlers, safety end treatments (SETs)       No TMDLs or I-Plans were identified.         100% (Frio) sity clay, (0)       100% of the AOI, Occasionally       Remove existing nutlers, safety end treatments (SETs)       No TMDLs or I-Plans were identified.         100% of the AOI, I coccasionally       Remove existing nutlers, safety end treatments (SETs)       X Remove existing nutlers, safety end treatments (SETs)       X Install proposed pavement per plans       No TMDLs or I-Plans were identified.         1       Install orders, safety end treatments       SETs       X Install mow strip, MBGF, bridge rail       * Addd (*) for Impaired waterbodies with pollutant in ().<					Classified Waterbody
X Install sediment and erosion controls         1.7 MAJOR SOIL TYPES:         Soil Type         100% (Frio) silty clay, (0)         100% of the AOI, Occasionally         to 1) percent slopes         (0)         (Frio) silty clay, (0)         100% of the AOI, Occasionally         weel in water (Recreating Use)         No TMDLs or I-Plans were identified.         X Grading operations, excavation, and embankment         Coded, high water holding capacity, well drained, low runoff, slight erosion         Remove existing culverts, safety end treatments (SETs)         X Remove existing metal beam guard fence (MBGF), bridge rail         X Place flex base         X Rework slopes, grade ditches         Blade windrowed material back across slopes         X Achieve site stabilization and remove sediment and erosion control measures         Other:         Other:			-		*Leon River below Proctor Lake-122
1.7 MAJOR SOIL TYPES:       X Remove existing pavement       X Grading operations, excavation, and embankment       No TMDLs or I-Plans were identified.         100% (Frio) silty clay, (0) to 1) percent slopes       100% of the AOI, Occasionally model, high water holding capacity, well drained, low runoff, slight erosion       Remove existing culverts, safety end treatments (SETs)       No TMDLs or I-Plans were identified.         X Install proposed pavement       Widening       Remove existing culverts, safety end treatments (SETs)       No TMDLs or I-Plans were identified.         X Install proposed pavement per plans       Install culverts, culvert extensions, SETs       No TMDLs or I-Plans were identified.         X Install proposed pavement per plans       Install culverts, culvert extensions, SETs       No TMDLs or I-Plans were identified.         X Install proposed pavement per plans       Install culverts, culvert extensions, SETs       No TMDLs or I-Plans were identified.         X Install proposed pavement per plans       Install culverts, culvert extensions, SETs       X Install mow strip, MBGF, bridge rail         X Rework slopes, grade ditches       Blade windrowed material back across slopes       * Add (*) for Impaired waterbodies with pollutant In ().         * Add (*) for Impaired waterbodies with pollutant In ().       Other:       Other:       Other:         Other:       Other:       Other:       Other:       Other:       Other:         Other:       Other: <td></td> <td></td> <td>controls</td> <td>Resley Creek (1221A)</td> <td></td>			controls	Resley Creek (1221A)	
Soil Type       Description       X Grading operations, excavation, and embankment         100% (Frio) silty clay, (0)       100% of the AOI, Occasionally flooded, high water holding capacity, well drained, low runoff, slight erosion       Eccavate and prepare subgrade for proposed pavement widening         2       Remove existing culverts, safety end treatments (SETs) X Remove existing metal beam guard fence (MBGF), bridge rail X Install proposed pavement per plans Install culverts, culvert extensions, SETs X Remove kisting erail X Place flex base X Rework slopes, grade ditches Blade windrowed material back across slopes X Achieve site stallization and remove sediment and erosion control measures       * Add (*) for Impaired waterbodies with pollutant in ().	1 7 MAJOR SOIL TYPES	<b>U</b>	indrows, prep ROW, clear and grub	No TMDLs or I-Plans were identified.	
100% (Frio) silty clay, (0)       100% of the AOI, Occasionally flooded, high water holding capacity, well drained, low runoff, slight erosion       Excavate and prepare subgrade for proposed pavement widening         Remove existing culverts, safety end treatments (SETs)       X Remove existing metal beam guard fence (MBGF), bridge rail X Install proposed pavement per plans         Install culverts, culvert extensions, SETs       X Install mow strip, MBGF, bridge rail X Place flex base         Blade windrowed material back across slopes       X Revegetation of unpaved areas         X Achieve site stabilization and remove sediment and erosion control measures       • Add (*) for Impaired waterbodies with pollutant in ().	Soil Type Description	÷.	tion, and embankment		
to 1) percent slopes       Noduet, fight water holding capacity, well drained, low runoff, slight erosion       Remove existing culverts, safety end treatments (SETs)         X Remove existing ulverts, culvert extensions, SETs       Install proposed pavement per plans       Install culverts, culvert extensions, SETs         X Install mow strip, MBGF, bridge rail       X Place flex base       X Rework slopes, grade ditches       Islade windrowed material back across slopes         X Revegetation of unpaved areas       X Achieve site stabilization and remove sediment and erosion control measures       Other:	100% (Frio) silty clay (0 100% of the AOI, Occasionally		rade for proposed pavement		
X Install proposed pavement per plans         Install culverts, culvert extensions, SETs         X Install mow strip, MBGF, bridge rail         X Place flex base         X Rework slopes, grade ditches         Blade windrowed material back across slopes         X Achieve site stabilization and remove sediment and erosion control measures         Other:         Other:	Lito 1) percent slopes incoded, high water holding capacity,		afety end treatments (SETs)		
Install culverts, culvert extensions, SETs         X Install mow strip, MBGF, bridge rail         X Place flex base         X Rework slopes, grade ditches         Blade windrowed material back across slopes         X Revegetation of unpaved areas         X Achieve site stabilization and remove sediment and erosion control measures         Other:         Other:		X Remove existing metal bear	m guard fence (MBGF), bridge rail		
X Install mow strip, MBGF, bridge rail         X Place flex base         X Rework slopes, grade ditches         Blade windrowed material back across slopes         X Revegetation of unpaved areas         X Achieve site stabilization and remove sediment and erosion control measures         Other:         Other:         Other:			•		
X Rework slopes, grade ditches       Blade windrowed material back across slopes         Blade windrowed material back across slopes       X Revegetation of unpaved areas         X Achieve site stabilization and remove sediment and erosion control measures       * Add (*) for impaired waterbodies with pollutant in ().         Other:       Other:       Other:		🛛 🛪 Install mow strip, MBGF, bri			
Blade windrowed material back across slopes         X Revegetation of unpaved areas         X Achieve site stabilization and remove sediment and erosion control measures         Other:         Other:			29		
X Achieve site stabilization and remove sediment and erosion control measures Other:				Add (*) for impaired waterbodie	s with pollutant in ().
erosion control measures           Other:           Other:					
Other:           Other:					
Other:			a remove sealment and		
		erosion control measures			
		erosion control measures Other: Other:			

#### 1.12 ROLES AND RESPONSIBILITIES: TxDOT

X Development of plans and specifications

X Perform SWP3 inspections

X Maintain SWP3 records and update to reflect daily operations □ Other: \_\_\_\_\_

Other: \_\_\_\_\_\_

#### **1.13 ROLES AND RESPONSIBILITIES: CONTRACTOR**

- X Day To Day Operational Control X Maintain schedule of major construction activities X Install, maintain and modify BMPs
- □ Other:

□ Other: \_\_\_\_\_

### STORMWATER POLLUTION PREVENTION PLAN (SWP3) (Less Than 1 Acre) <sup>© 2023</sup> July 2023 Sheet 1 of 2 Texas Department of Transportation ED.RD. IV.NO. PROJECT NO. SHEET NO. 23 79 STATE DIST. STATE COUNTY TEXAS BWD COMANCHE CONT. SECT. JOB HIGHWAY NO. 17 0923 084 CR 392

### 2.0 BEST MANAGEMENT PRACTICES (BMPs) AND CONTROLS, INSPECTION, AND MAINTENANCE

The Contractor shall be the responsible party for implementing the BMPs described herein and for complying with the SWP3 for control of erosion and sedimentation during day-to-day operations. The Contractor shall implement changes to this SWP3 approved by TxDOT within the times specified in this SWP3 or the CGP.

#### 2.1 EROSION CONTROL AND SOIL STABILIZATION BMPs:

#### T/P

- □ □ Protection of Existing Vegetation
- □ □ Vegetated Buffer Zones
- □ X Soil Retention Blankets
- Geotextiles
- □ □ Mulching/ Hydromulching
- □ □ Soil Surface Treatments
- X 

  Temporary Seeding
- □ X Permanent Planting, Sodding or Seeding
- X 🗆 Biodegradable Erosion Control Logs
- □ □ Rock Filter Dams/ Rock Check Dams
- □ □ Vertical Tracking
- □ □ Interceptor Swale
- 🛛 🗶 Riprap
- □ □ Diversion Dike
- Temporary Pipe Slope Drain
- Embankment for Erosion Control
- Paved Flumes
- □ □ Other: \_\_\_\_
- Other: \_\_\_\_\_\_
- □ □ Other:\_\_\_\_\_
- □ □ Other:

#### 2.2 SEDIMENT CONTROL BMPs:

#### T/P

- X 🗆 Biodegradable Erosion Control Logs Dewatering Controls
- □ □ Inlet Protection
- □ □ Rock Filter Dams/ Rock Check Dams
- □ □ Sandbag Berms
- X 🗆 Sediment Control Fence
- X Stabilized Construction Exit
- Floating Turbidity Barrier
- □ □ Vegetated Buffer Zones
- □ □ Vegetated Filter Strips
- □ □ Other:\_\_\_\_\_
- □ □ Other:\_\_\_\_\_
- □ □ Other:\_\_\_\_\_
- □ □ Other:\_\_\_\_\_

Refer to the Environmental Layout Sheets/ SWP3 Layout Sheets located in Attachment 1.2 of this SWP3

2.3	PERMANENT	CONTROLS:

(Coordinate post-construction BMPs with appropriate TxDOT maintenance sections.)

BMPs To Be Left In Place Post Construction:

Туре	Stationing			
Туре	From	То		
No permanent controls are planned.				
Refer to the Environmental Layo located in Attachment 1.2 of this		3 Layout Sheets		

#### 2.4 OFFSITE VEHICLE TRACKING CONTROLS:

- X Excess dirt/mud on road removed daily
- Haul roads dampened for dust control
- X Loaded haul trucks to be covered with tarpaulin
- X Stabilized construction exit
- Daily street sweeping
- Other: DIRT/MUD WILL BE REMOVED FROM ROADWAY AS NECESSARY

Other:\_\_\_\_\_

Other:\_\_\_\_\_

Other:

#### 2.5 POLLUTION PREVENTION MEASURES:

Other:

Other:\_\_\_\_\_

- X Chemical Management
- X Concrete and Materials Waste Management
- X Debris and Trash Management
- X Dust Control
- Sanitary Facilities

Other:\_\_\_\_\_

□ Other: \_\_\_\_\_

### 2.6 VEGETATED BUFFER ZONES:

Natural vegetated buffers shall be maintained as feasible to protect adjacent surface waters. If vegetated natural buffer zones are not feasible due to site geometry, the appropriate additional sediment control measures have been incorporated into this SWP3.

Type	Stati	Stationing		
Туре	From	То		
Infeasible, insufficient space between toe of slope and fence line.				
SCF & ECL	9+57.00	13+82.00		
Refer to the Environmental Layour	t Sheets/ SWP3	Layout Sheets		
located in Attachment 1.2 of this S		-		

### 2.7 ALLOWABLE NON-STORMWATER DISCHARGES:

- X Fire hydrant flushings
- X Irrigation drainage
- X Pavement washwater (where spills or leaks have not occurred, and detergents are not used)
- X Potable water sources
- X Springs
- X Uncontaminated groundwater
- X Water used to wash vehicles or control dust
- X Other allowable non-stormwater discharges as allowed by TPDES GP TXR150000.

#### 2.8 DEWATERING:

Dewatering discharges of accumulated stormwater, groundwater, and surface water including discharges from dewatering of trenches, excavations, foundations, vaults, and other points of accumulation are prohibited unless managed by appropriate controls to prevent and minimize the offsite discharge of sediment and other pollutants.

#### 2.9 INSPECTIONS:

All disturbed areas and erosion and sediment control devices shall be inspected at least once every seven (7) days. Inspections shall be performed by TxDOT as indicated on the Field Inspection and Maintenance Report Form 2118 and retained in Attachment 2.3 of this SWP3 .

#### 2.10 MAINTENANCE:


Control measures shall be properly installed according to specifications. If it is determined that a BMP or control measure is not operating effectively, maintenance must be accomplished as soon as possible and before the next anticipated rain event, but in no case later than 7 calendar days after being able to access the site. Maintenance shall be performed by the Contractor as indicated on the Field Inspection and Maintenance Report Form 2118 and retained in Attachment 2.3 of this SWP3.

# STORMWATER POLLUTION **PREVENTION PLAN (SWP3)** (Less Than 1 Acre)


<sup>223</sup> July 2023 Sheet 2 of 2


Texas Department of Transportation

FED. RD. DIV. NO.		PROJECT NO.			
23					80
STATE		STATE DIST.	COUNTY		
TEXA	S	BWD	COMANCHE		
CONT.		SECT.	JOB	HIGHWAY N	٥.
0923	3	17	084	CR 39	2

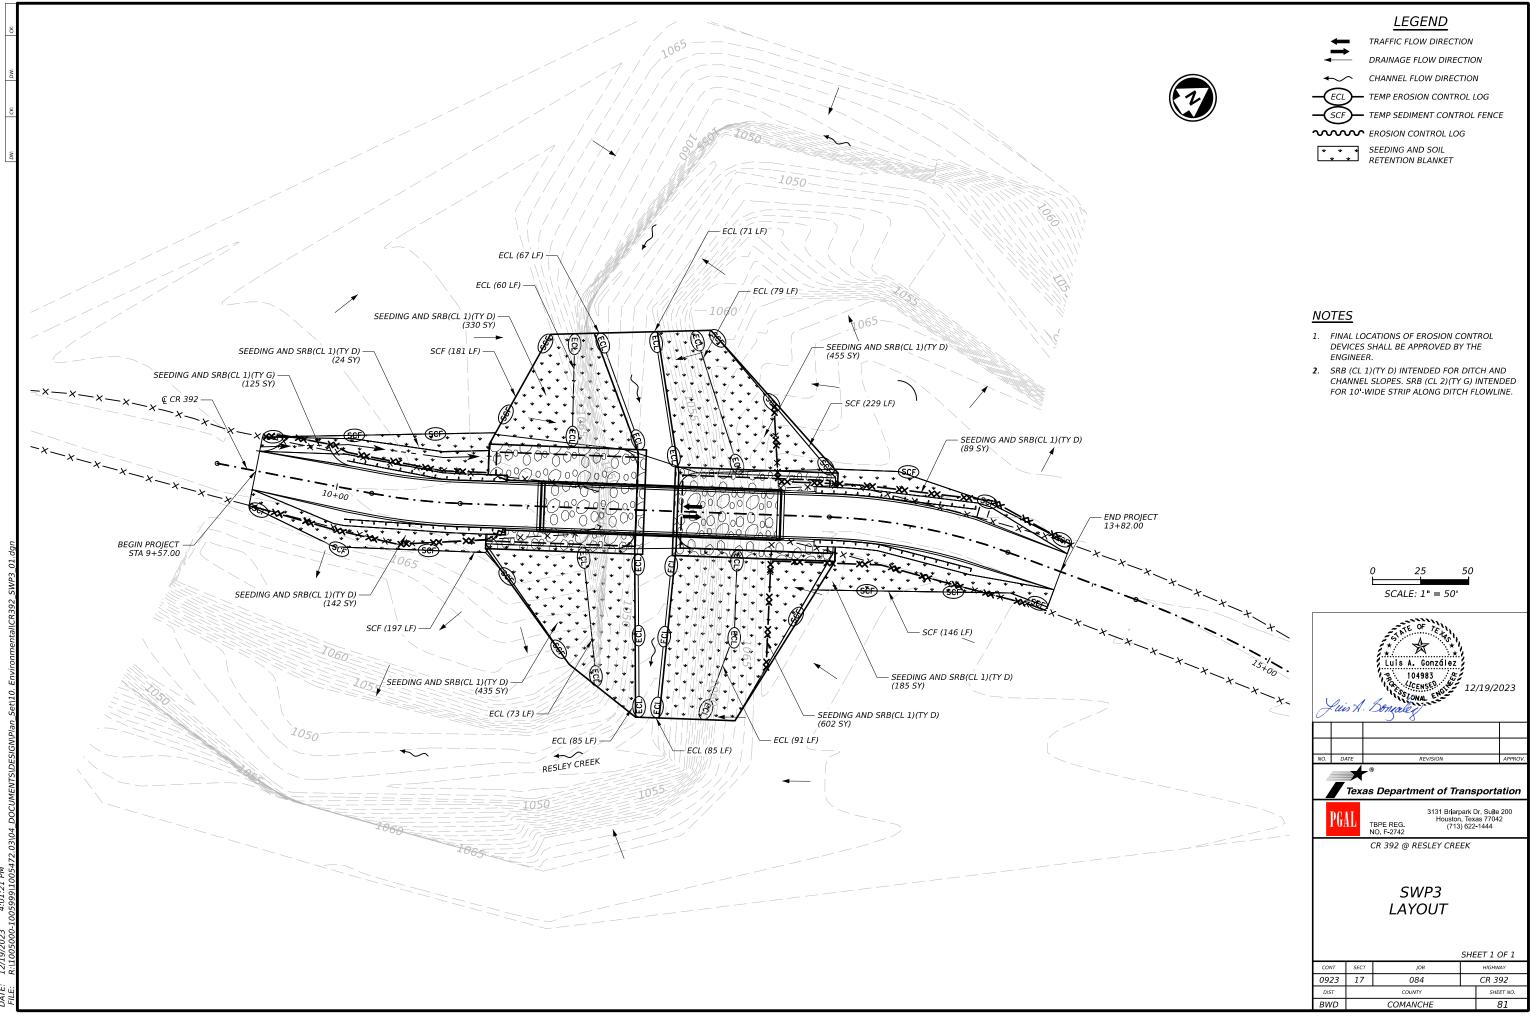



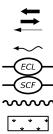

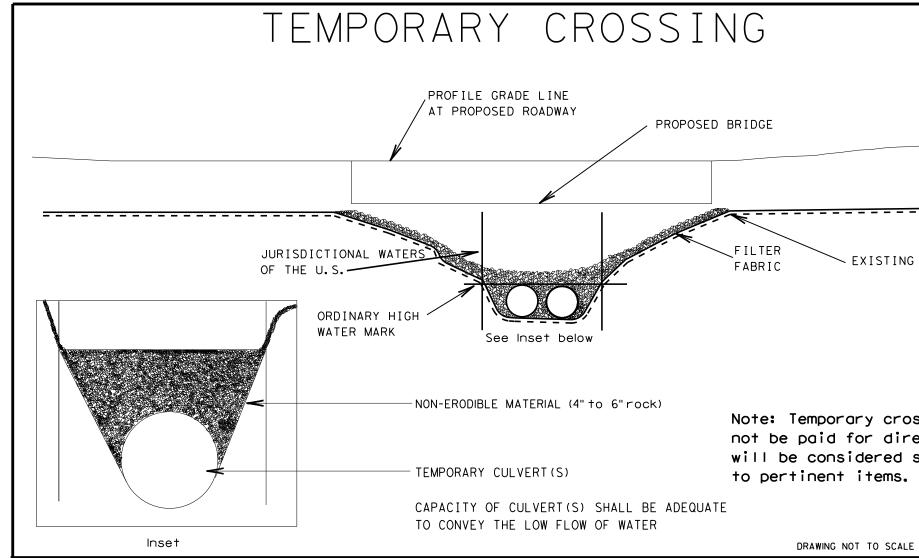


	GROUND	
dire	sing ctly subsid	but


# CR 392 TEMP CROSSING DETAIL 0923-17-084

Texas Department of Transportation®

ĺ	CONT	SECT JOB			HIGHWAY
	0923	17 084		C	R 392
I	DIST		COUNTY		SHEET NO.
	BWD		COMANCHE		82

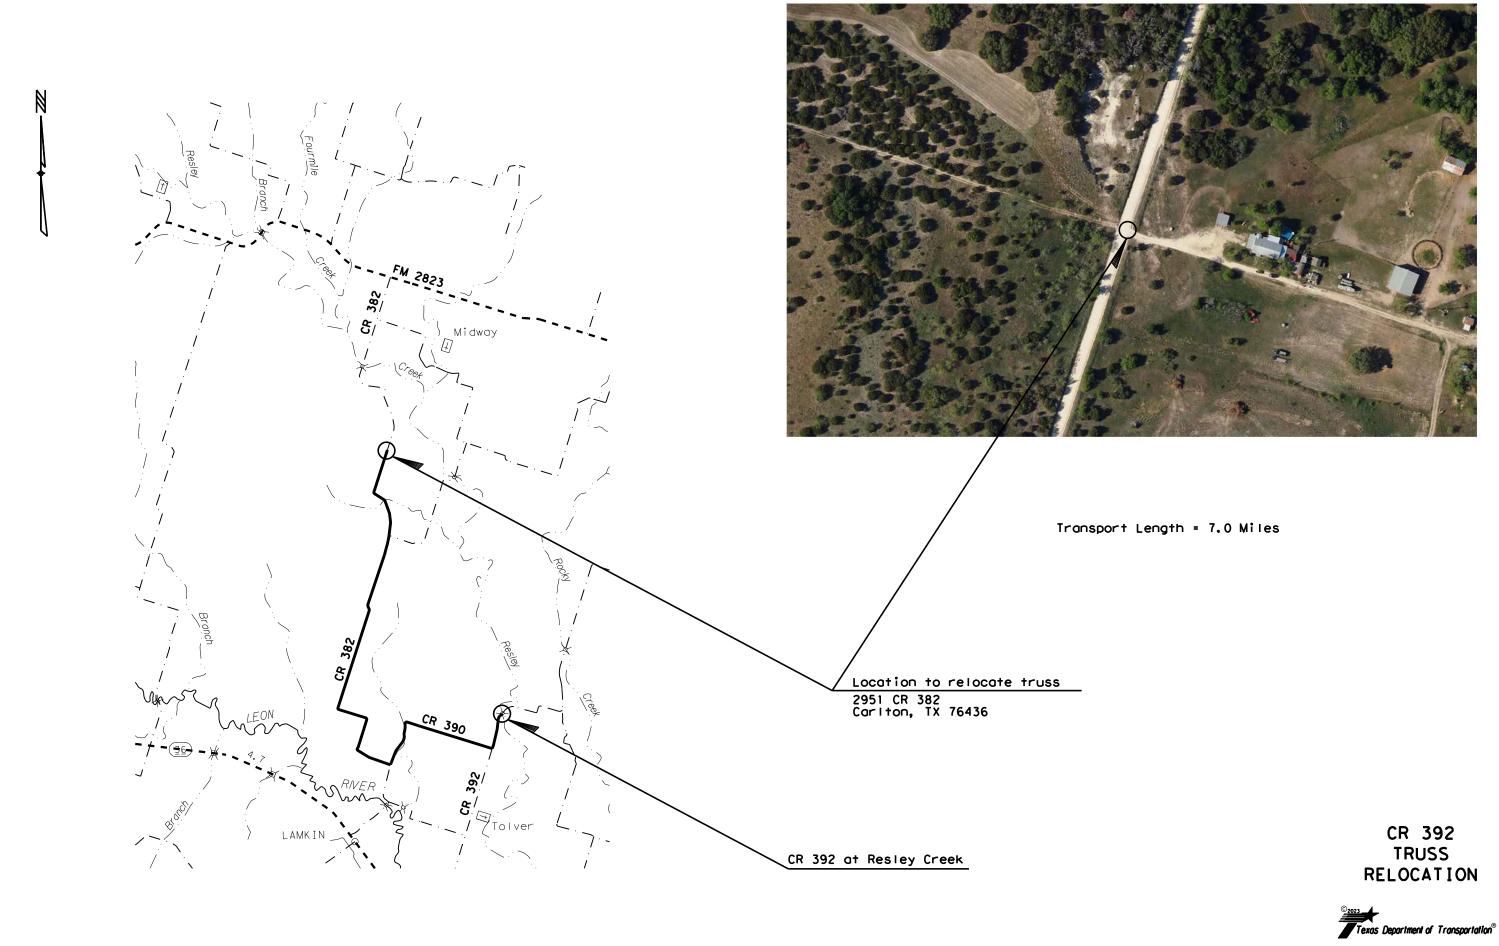

CONT	SECT	JOB		HIGHWAY		
0923	17	084	C	R 392		
DIST		COUNTY		SHEET NO.		
BWD		COMANCHE		83		

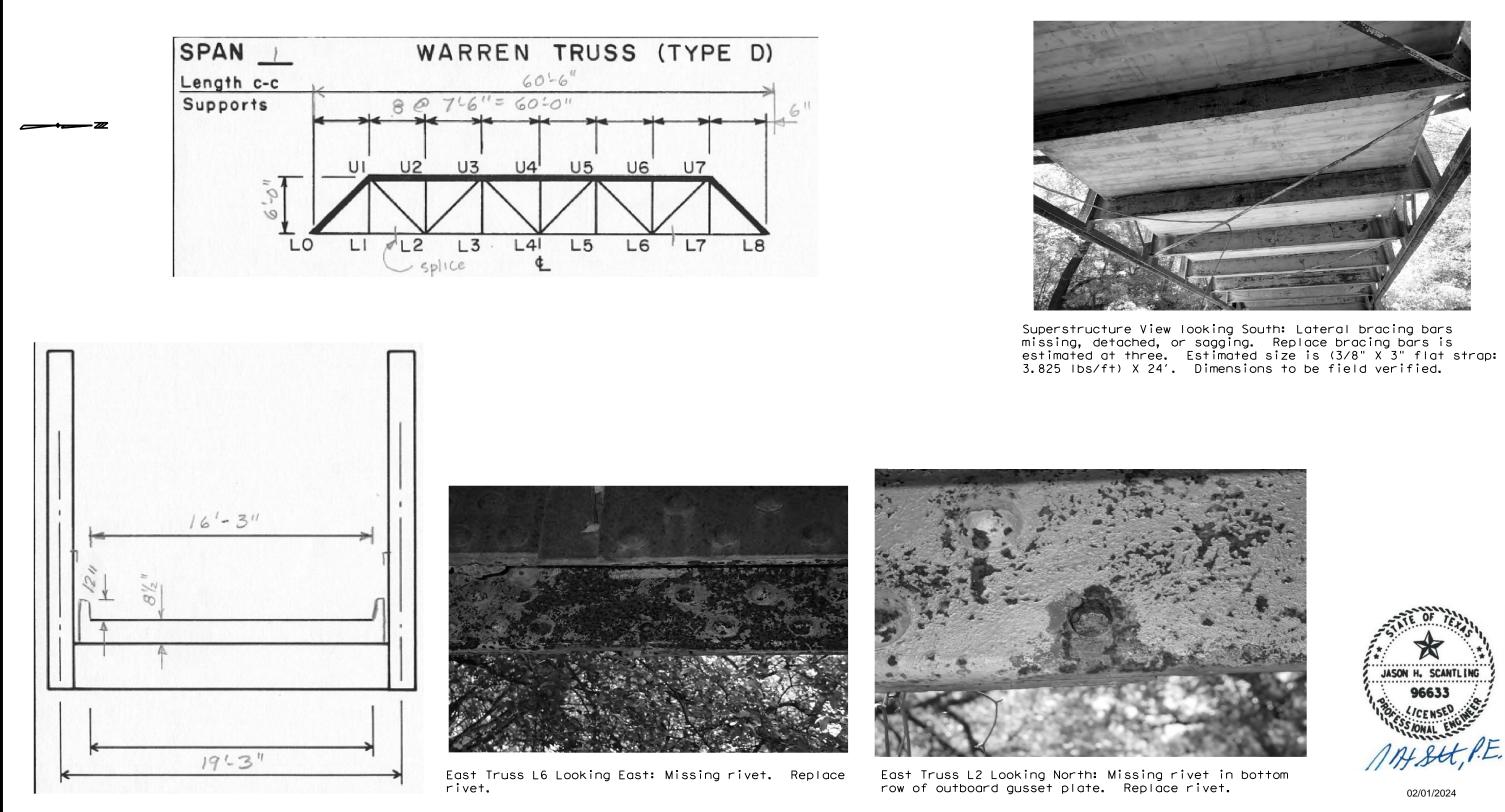

ITEM	CODE	DESCRIPTION	UNIT	QUANTITY
0784	6027	REP STL BRIDGE MEMBER (LATERAL BRACING)	LS	1
0784	6038	REP STL BRIDGE MEMBER(REPL RIVET/BOLT)	ΕA	2
4022	6001	REMOV AND RELOCAT EXISTING TRUSS BRIDGE	LS	0.5


\* Quantity includes removing deck from the truss and lifting and relocating truss to the new location and placing on supports provided by the recipient.

Contractor is required to submit a lifting plan to the Engineer.


# CR 392 TRUSS RELOCATION




BWD		COMANCHE		84		
DIST		COUNTY		SHEET NO.		
0923	17	084	C	R 392		
CONT	SECT	JOB		HIGHWAY		

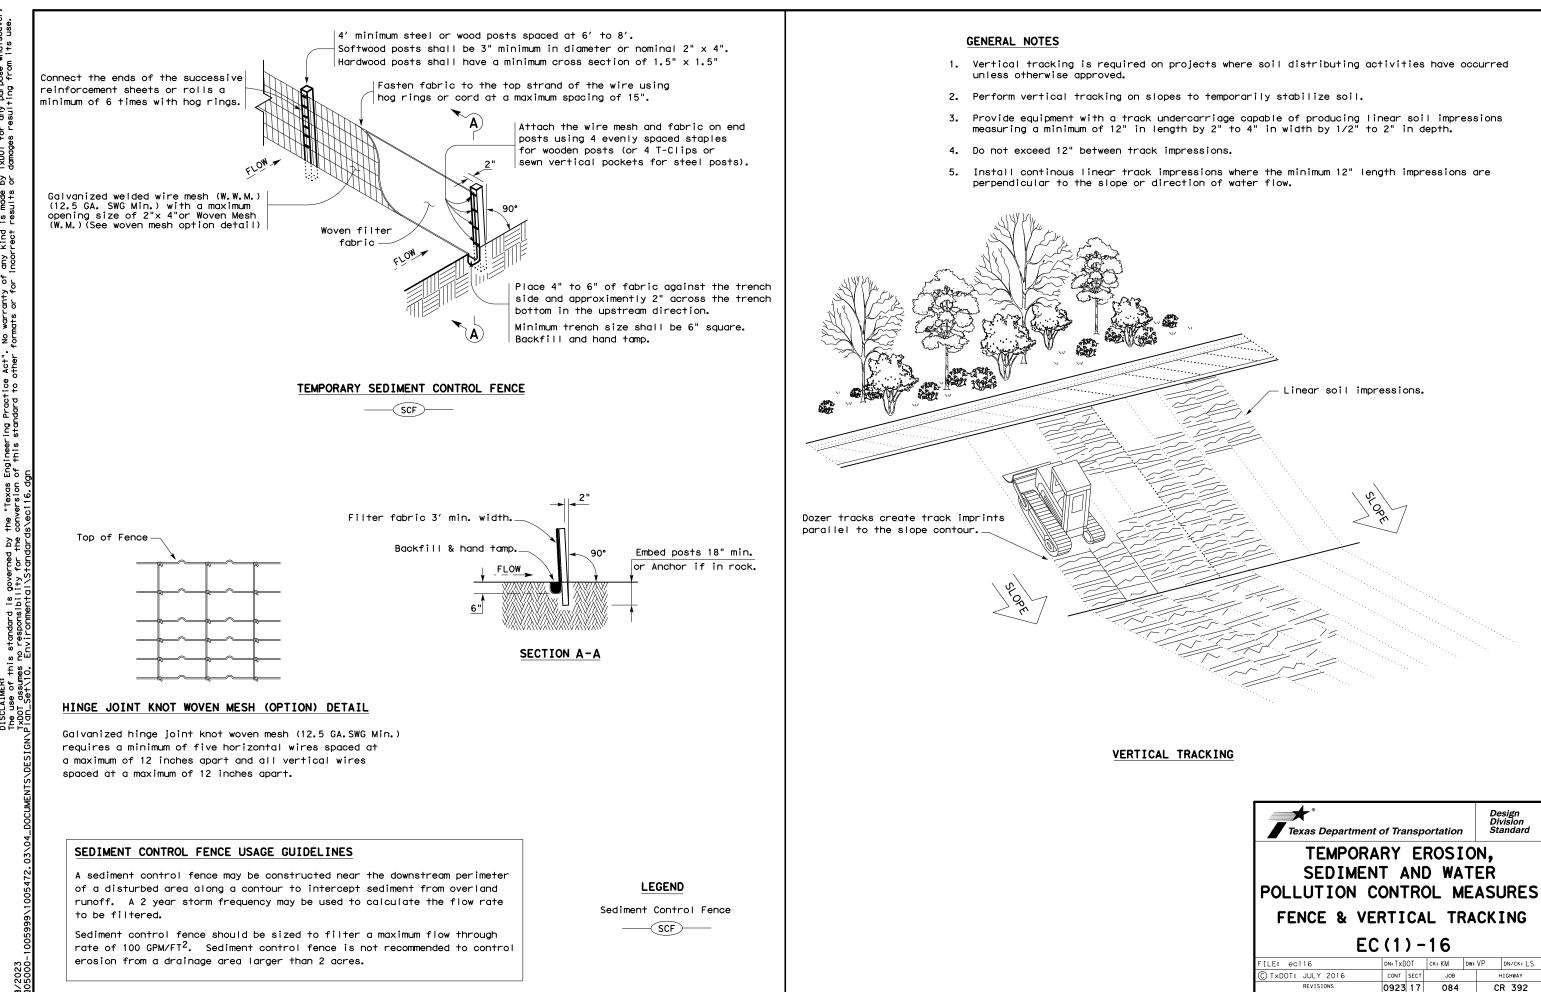


Texas Departme	D	Design Division Standard					
TEMPORARY EROSION, SEDIMENT AND WATER POLLUTION CONTROL MEASURES							
FENCE & VERTICAL TRACKING							
EC(1)-16							
FILE: ec116	DN: TxDOT	ck⊧KM D	w:VP	DN/CK: LS			
				HIGHWAY			
C TXDOT: JULY 2016	CONT SE	CT JOB		HIGHWAY			
C TXDOT: JULY 2016 REVISIONS	CONT SE 0923 1			HIGHWAY			
0			(				

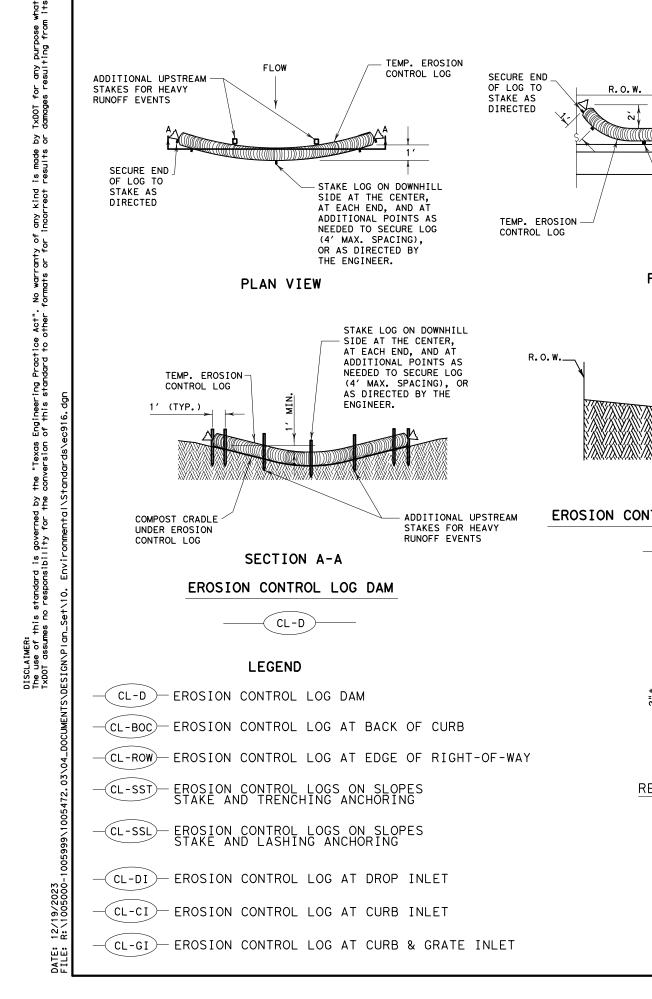


soevel use.

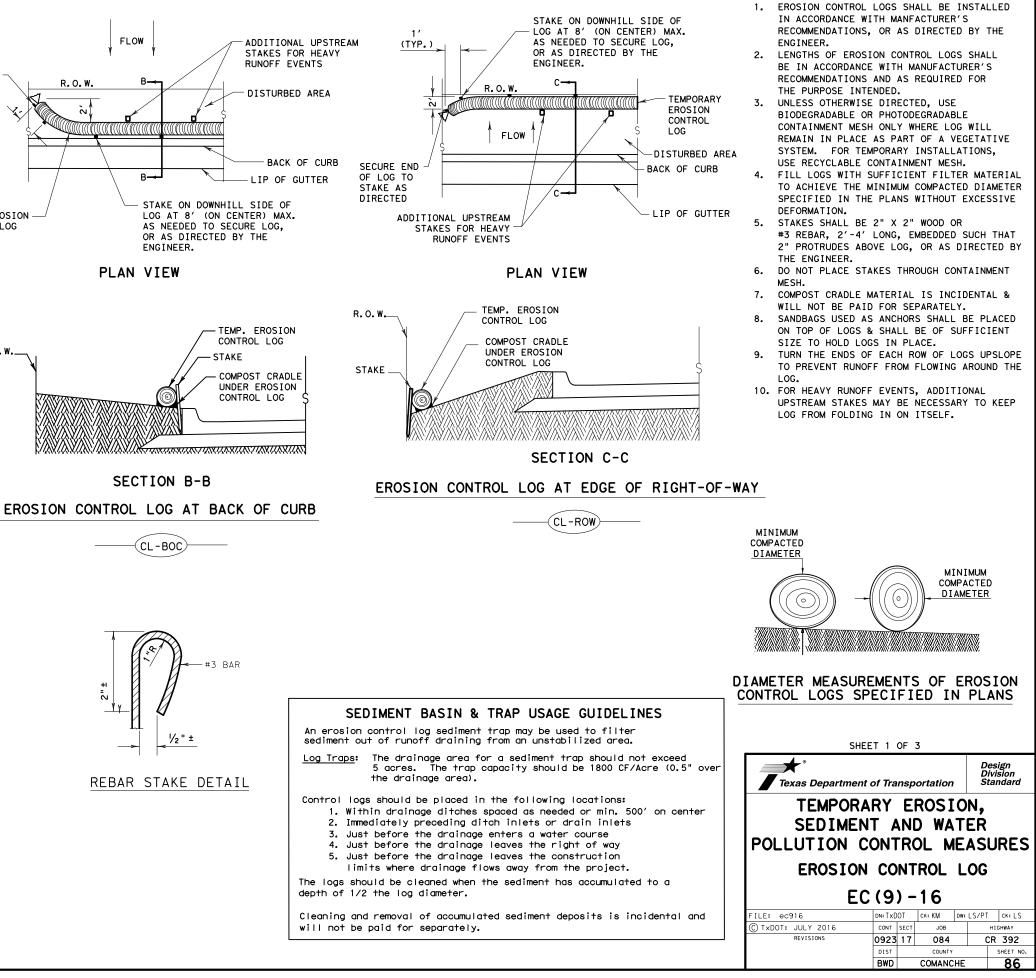


GENERAL NOTES:

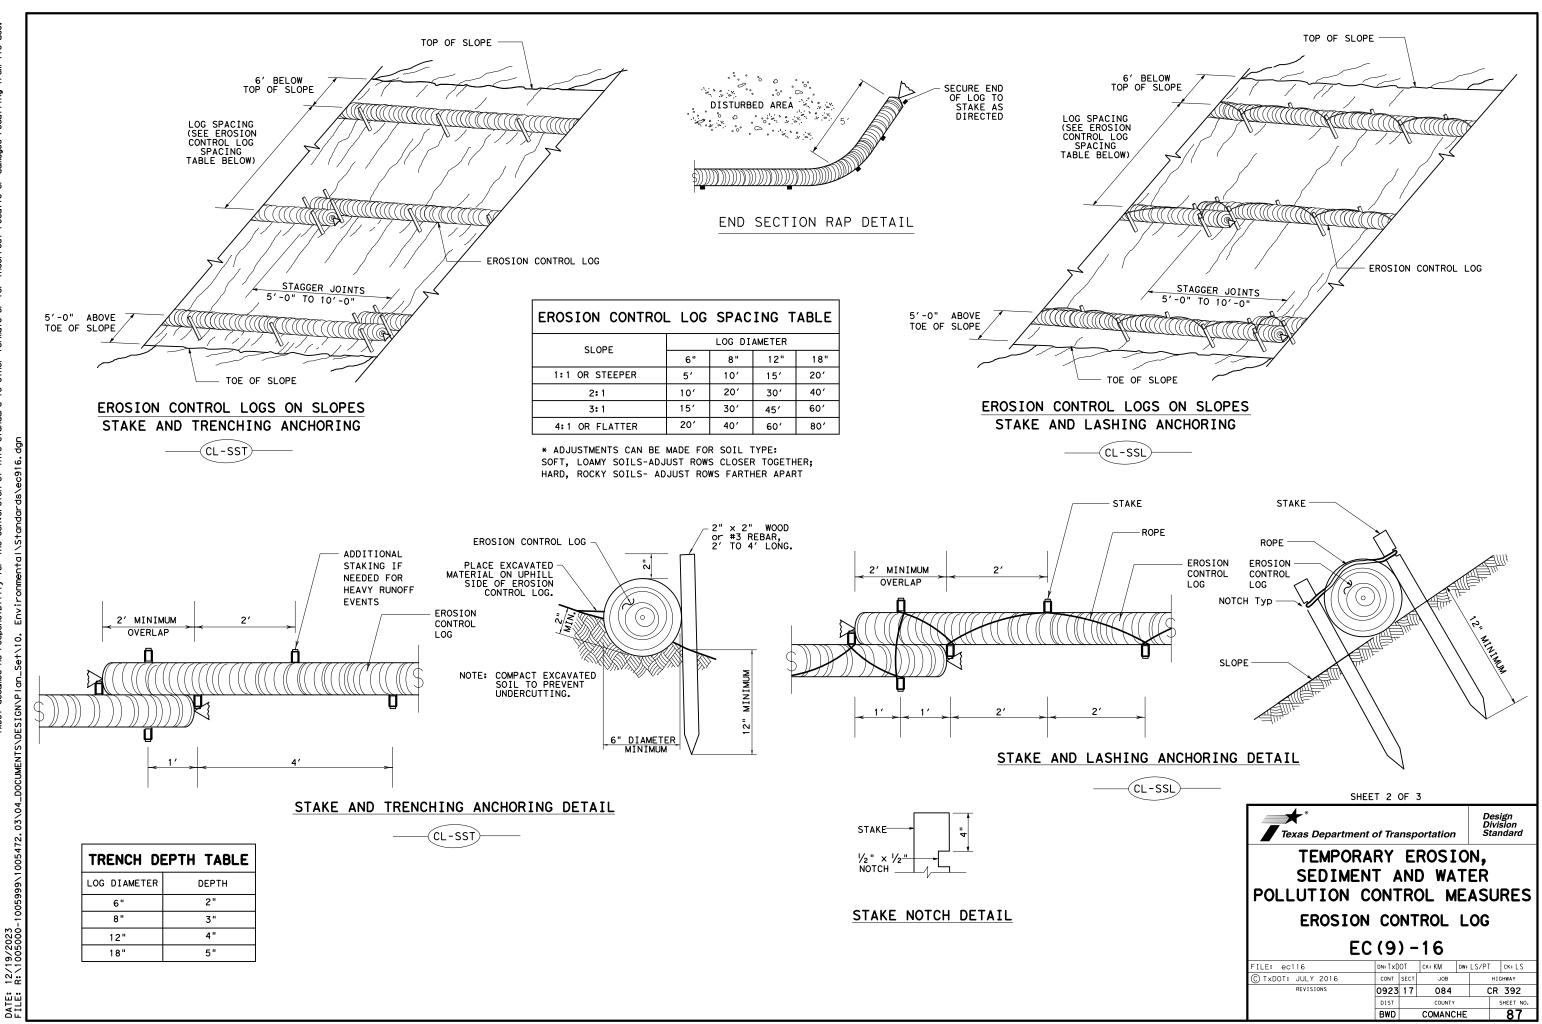

by TxDOT for any purpose whatsoever or damages resulting from its use. this standard is governed by the "Texas Engineering Practice Act". No warranty of any kind is made hes no responsibility for the conversion of this standard to other formats or for incorrect results DISCLAIMER: The use of 1 T×DOT assume

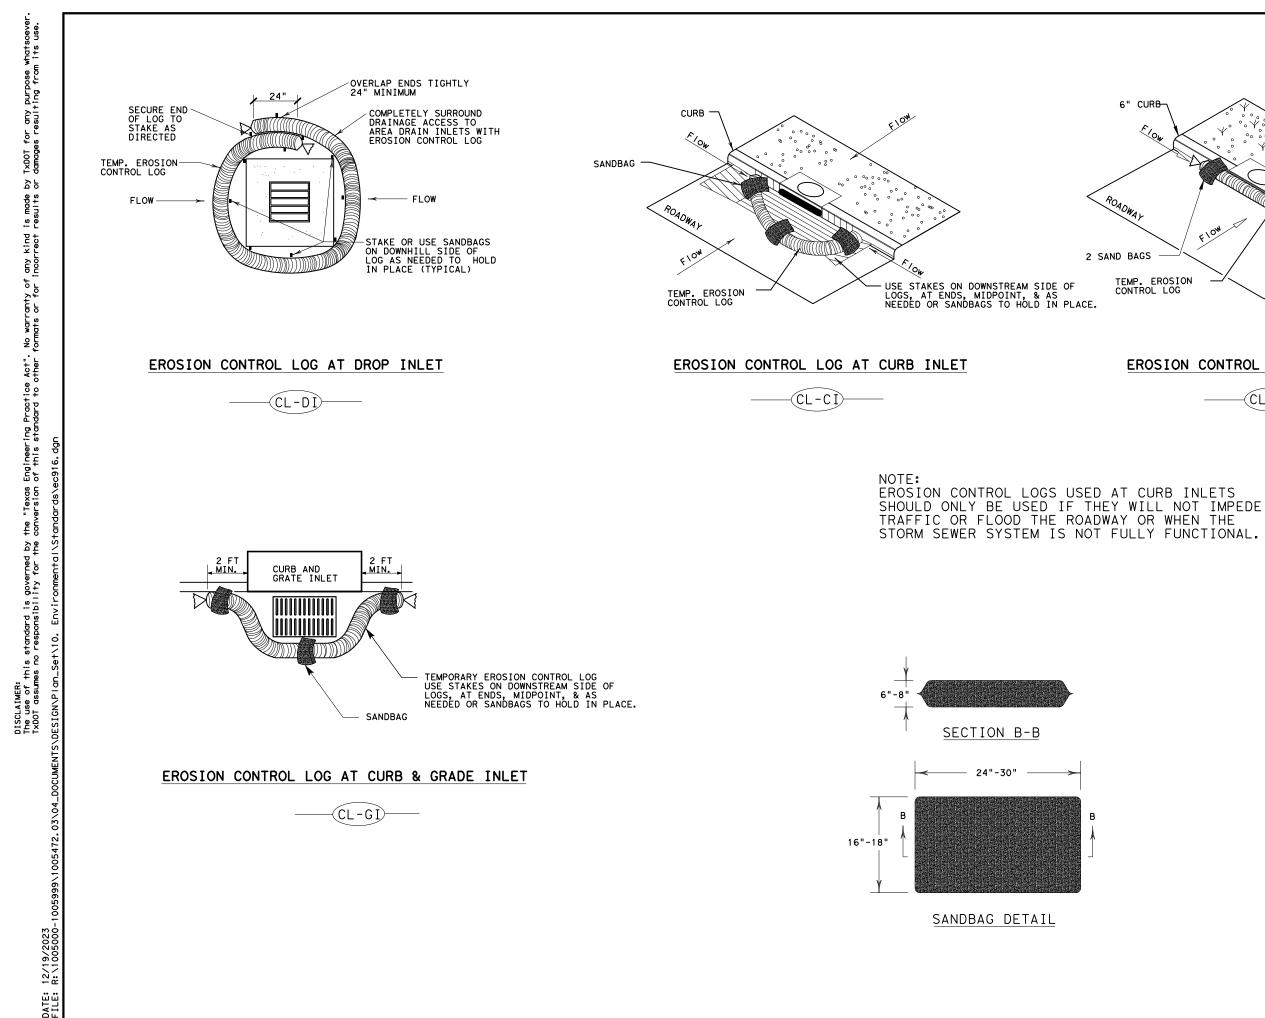

ROADWAY

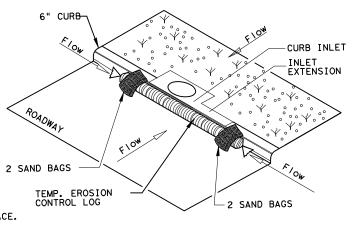

#### EROSION CONTROL LOG AT CURB INLET

(CL-CÌ)

