
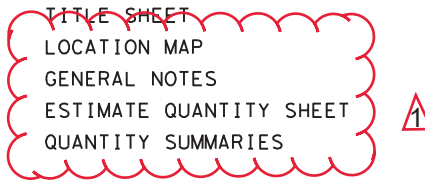


6/9/2022 8:04:10 AM T:\LFKDDM\Maint Contracts\0-RMC - Routine Maintenance Contracts\FY22 Plans\6407-22-001 MILL & INLAY (NORTH)FY 2023\DGN\TitleSheet\Mill & Inlay (NORTH).c

INDEX OF SHEETS

SHEET NO.	DESCRIPTION
<b>GENERAL</b>	
1	TITLE SHEET
2-3	LOCATION MAP
4, 4A-4D	GENERAL NOTES
5	ESTIMATE QUANTITY SHEET 
6-9	QUANTITY SUMMARIES
<b>TRAFFIC CONTROL PLAN</b>	
# 10-21	BC (1)-14 THRU BC (12)-14
# 22	TCP (2-1)-18
# 23	TCP (2-2)-18
# 24	TCP (2-3)-18
# 25	TCP (2-4)-18
# 26	TCP (2-6)-18
# 27	TCP (3-1)-13
# 28	TCP (3-2)-13
# 29	TCP (3-3)-14
# 30	WZ (BRK) -13
# 31	WZ (RS) -22
# 32	WZ (STPM) -13
# 33-34	MAINTENANCE WORK ZONE SPEED LIMIT SIGNS
<b>ROADWAY DETAILS</b>	
35	FLEXIBLE PAVEMENT REPAIR DETAILS
# 36	PM(1) -20
# 37	PM(2) -20
# 38	PM(3) -20
# 39	TYPICAL PAVEMENT MARKING DETAILS (LUFKIN DISTRICT STANDARD)
<b>ENVIRONMENTAL</b>	
40	EPIC



STATE OF TEXAS  
DEPARTMENT OF TRANSPORTATION

PLANS OF PROPOSED  
STATE HIGHWAY ROUTINE MAINTENANCE CONTRACT  
TYPE OF WORK:

**MILL & INLAY, OVERLAY & BASE REPAIR (NORTH)**

RMC 6407-22-001

**US 59, ETC.**

ANGELINA, ETC.

LIMITS: VARIOUS LOCATIONS IN THE ANGELINA, NACOGDOCHES  
AND SHELBY COUNTY MAINTENANCE SECTIONS

SEE SHEETS 2 AND 3  
FOR LOCATION MAPS

BARRICADES AND WARNING SIGNS

**PROJECT LIMIT BARRICADES WILL NOT BE REQUIRED.**  
THE CONTRACTOR SHALL PROVIDE AND ERECT WARNING SIGNS  
IN ACCORDANCE WITH THE BARRICADE & CONSTRUCTION  
STANDARDS, TCP STANDARDS, THE "TEXAS MANUAL ON  
UNIFORM TRAFFIC CONTROL DEVICES" AND AS DIRECTED.



DocuSigned by:  
Jeremy King, P.E. 6/29/2022  
5135292FE4184A4... DATE

\* THE STANDARD SHEETS SPECIFICALLY IDENTIFIED ABOVE  
HAVE BEEN SELECTED BY ME OR UNDER MY RESPONSIBLE  
SUPERVISION AS BEING APPLICABLE TO THIS PROJECT.

SPECIFICATIONS ADOPTED BY THE TEXAS DEPARTMENT OF TRANSPORTATION  
NOVEMBER 1, 2014 AND SPECIAL SPECIFICATION ITEMS INCLUDED IN THE  
CONTRACT SHALL GOVERN ON THIS PROJECT.


©2022 BY TEXAS DEPARTMENT OF TRANSPORTATION. ALL RIGHTS RESERVED.  Addendum #1 7/22/2022



RECOMMENDED FOR LETTING:  
DocuSigned by:  
Jeremy King, P.E. 6/29/2022  
DISTRICT MAINTENANCE ENGINEER DATE  
5135292FE4184A4...  
APPROVED FOR LETTING:  
DocuSigned by:  
[Signature] 6/29/2022  
DIRECTOR OF OPERATIONS DATE




LOCATION NUMBER	COUNTY	HIGHWAY	DIRECTION	LIMITS	
				FROM	TO
1	ANGELINA	US 69 (LOOP)	SB	END OF CONC. @ KURTH DR. OVERPASS RM 416+0.075	RAIL ROAD TRACKS RM 742+0.227
1A	ANGELINA	US 69 (LOOP)	SB	1000' SOUTH OF CONC. RM 416+0.264	NEW HOT MIX RM 742+0.215
1B	ANGELINA	US 69 (LOOP)	SB	CHANGE OF PAVEMENT S OF FM 2251 RM 416+0.601	RM 742+0.212
1C	ANGELINA	US 69 (LOOP)	SB	FRONT OF BROOKSHIRE WAREHOUSE RM 416+1.288	CHANGE OF PAVEMENT RM 742+0.057
1D	ANGELINA	US 69 (LOOP)	SB	FRONT OF BROOKSHIRE WAREHOUSE RM 416+1.139	CONCRETE ISLAND RM 742+0.218
1E	ANGELINA	US 69 (LOOP)	NB	START AT SPENCE ST RM 416+1.686	WEST GATE LN SS 72 RM 714+0.796
1F	ANGELINA	US 69 (LOOP)	NB	CHANGE OF PAVEMENT RM 416+0.336	ETECH 1ST DRIVE RM 714+1.169
1G	ANGELINA	US 69 (LOOP)	NB	FRONT OF EXPO CENTER @ C.O.P. RM 416+1.250	SH 94 RAMP RM 742+0.234
2	ANGELINA	US 59	SB	START AT RIVER BRIDGE RM 378+0.958	HILL'S DRIVEWAY RM 388+1.909
2A	ANGELINA	US 59	SB	LAST CROSSOVER BEFORE FM 2021 RM 382+0.467	FM 58 RM 714+0.022
2B	ANGELINA	US 59	SB	LAST CROSSOVER BEFORE FM 2021 RM 382+0.467	W. PARKER ST RM 338+1.112
2C	ANGELINA	US 59	NB	CONCRETE NORTH OF FM 2021 RM 382+0.468	LUMBER YARD RM 376+1.030
2D	ANGELINA	US 59	NB	BOX 110 RM 380+1.768	BOX 6814 RM 380+1.665
2E	ANGELINA	US 59	NB	BOX 7786 RM 380+1.769	NORTH OF BOX 7930 RM 380+1.666
2F	ANGELINA	US 59	NB	LAST CROSSOVER BEFORE RIVER BRIDGE RM 378+0.890	ICE ON BRIDGE SIGN RM 378+1.085
2G	ANGELINA	US 59	NB	END OF GUARDRAIL BEFORE RIVER BRIDGE RM 378+0.667	RIVER BRIDGE RM 378+0.707
2H	ANGELINA	US 59	SB	3.1 MILES S OF MOFFETT OVERPASS RM 388+1.040	800' SOUTH @ BRIDGE SECK RM 388+1.191
2I	ANGELINA	US 59	SB	3.3 MILES S OF MOFFETT OVERPASS RM 390+0.172	800' SOUTH @ BRIDGE DECK RM 390+0.323
2J	ANGELINA	US 59	NB	1.2 MILES N OF END OF CONC. RM 386+0.283	500' NORTH RM 386+0.189
2K	ANGELINA	US 59	SB	1.9 MILES S OF FM 819 RM 394-0.405	2.5 MILES S OF FM 819 RM 394+0.556
2L	ANGELINA	US 59	SB	INTERSECTION OF SL 210 RM 400+0.115	400' SOUTH RM 400+0.190
3	NACOGDOCHES	BU 59	NB/SB	PARKER ST RM 338+1.084	BOWIE ST RM 338+1.671

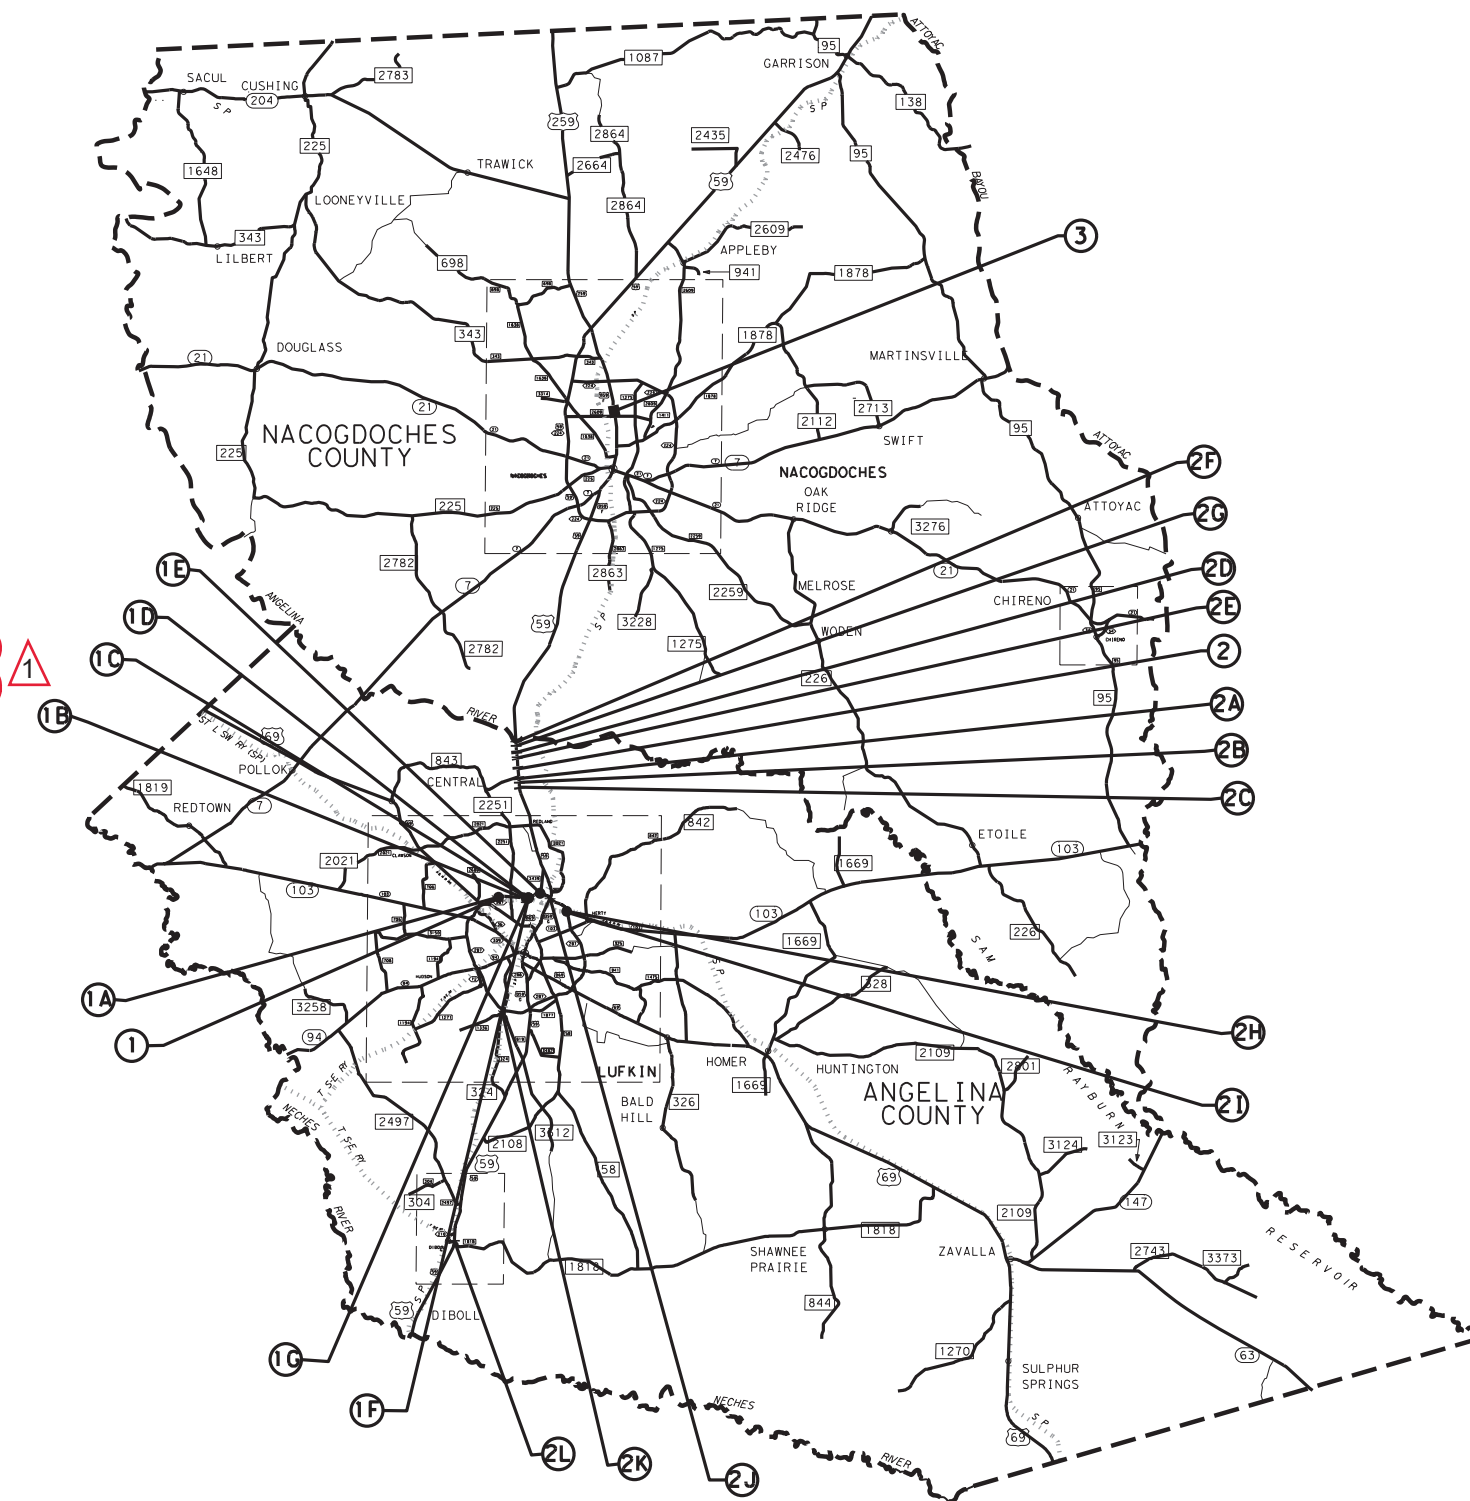

N. T. S.

LOCATION MAPS

© 2022  
  
 Texas Department of Transportation  
 SHEET 1 OF 2

CONT	SECT	JOB	HIGHWAY
6407	22	001	US 59, ETC.
DIST	COUNTY		SHEET NO.
LFK	ANGELINA, ETC.		2

1 Addendum #1 7/22/2022

**Project Number:** RMC 6407-22-001

**Control:** 6407-22-001

**County:** Angelina, ETC.

**Highway:** US 59, ETC.

**ITEM 8: PROSECUTION AND PROGRESS**

For this project, 36 working days will be computed and charged in accordance with Item 8, Section 3.1.4, "Standard Workweek".

Time charges shall begin to accrue 7 calendar days after the authorization date to begin work unless otherwise approved by the Engineer. If work commences during the school year, the contractor shall not close any lanes prior to 8:30 AM.

Work for Location Number 3, BU 59 from Parker St. to Bowie St. in Nacogdoches County shall be completed at night unless otherwise approved by the Engineer.

All night work on the project shall be performed between the hours of 8 PM and 6 AM, unless otherwise approved in writing. No work will be allowed on Saturdays or between the hours of 6 AM and 8 PM on Sunday through Friday, unless otherwise approved in writing.

Along outside pavement edges construct a 3:1 maximum taper or backfill the same day as shown on the plans or as directed.

Remove and properly dispose of any piles of asphaltic concrete and all other debris left on the right of way daily.

**ITEM 351: FLEXIBLE BASE STRUCTURE REPAIR**

For base repair, place hot-mix asphalt pavement in compacted lifts of 4 in. maximum, unless otherwise directed.

Furnish hot-mix asphalt pavement in accordance with Item 3076 D-GR HMA (SQ) TY-B PG 64-22.

**ITEM 354: PLANING AND TEXTURING PAVEMENT**

All planed areas shall be inlaid with HMA on the same day of the planing operation.

Complete planing operations in adjacent lanes and shoulders to the same point at the end of each day.

RAP produced from this project may be used in the HMA mixtures.

All RAP not utilized in the HMA shall remain the property of the contractor, with the exception of the following:

Angelina County Maintenance: Material from US 69 and US 59 will be delivered to the Angelina Maintenance Yard stockpiled located at 1410 Kurth Drive Lufkin TX 75901 as directed.

Nacogdoches County Maintenance: Material from BUS 59 will be delivered to the Nacogdoches Maintenance Yard stockpiled located at 918 Industrial Blvd Nacogdoches TX 75961 as directed. Shelby County Maintenance: Material from US 59 and SH 7 will be delivered to the Shelby

**Project Number:** RMC 6407-22-001

**Control:** 6407-22-001

**County:** Angelina, ETC.

**Highway:** US 59, ETC.

Maintenance Yard stockpiled located at 638 State Highway 7 East Center TX 75935 as directed. Blade the existing paved shoulders prior to planing operations to remove existing overgrowth. This work will be subsidiary to Item 354.

Use an approved ski device to control longitudinal grade.

Where the underlying flexible base is exposed during the planing operation, prime this area with an asphalt at a rate as directed and patch with an approved HMA material, at the end of the day's operation in which it occurs. These items of work will not be paid for directly but will be subsidiary to Item 354.

**ITEM 502: BARRICADES, SIGNS, AND TRAFFIC HANDLING**

Traffic Control Plan (TCP):

~~The Maintenance Section Supervisor and Area Engineer shall decide if the "Maintenance Work Zone Speed Limit Signs" are needed. If needed, these signs will not be paid for directly, but will be considered subsidiary to item 502.~~

Location Numbers 1 - 2L (US 69 & US 59 - Angelina County) require speed reduction signs during construction. Fabricate, provide, and maintain speed limit signs (45 mph) as shown on the applicable Maintenance Work Zone Speed Limit Signs standard. Remove or cover regulatory (black and white) speed limit signs, when not applicable. These signs are required for both lanes of travel on divided highways regardless of the location of work.

Furnishing, erecting, relocating, and removing temporary speed zone signs is subsidiary to Item 502.

Install vertical panels or drums at 100-ft. spacings where drop-offs or construction work occurs along edges of existing pavement. Unless otherwise authorized, these shall remain in place until final striping.

Project limit barricades will not be required. Daily lane closure signage with contract description information sign will be required.

Ensure the Contractor's Responsible Person (CRP) for Barricades, Signs and Traffic Handling is available at all times and able to receive instructions from the Engineer or authorized Department representative. The CRP shall be a person that is usually at the project site during normal working hours.

For protection of the traveling public, direct traffic through the work area using signs, flaggers and other devices. Required signs are shown in the plans on the Barricade and Construction Standards and Traffic Control Plan Sheets. The latest edition of the "Texas Manual on Uniform Traffic Control Devices" shall also be used as a guide for handling traffic on this project.

Install "No Center Line" (CW8-12) signs as directed.



Addendum #1 7/22/2022



# Estimate & Quantity Sheet

CONTROLLING PROJECT ID 6407-22-001 DISTRICT Lufkin COUNTY Angelina  
HIGHWAY US0059

CONTROL SECTION JOB		6407-22-001		TOTAL EST.	TOTAL FINAL
PROJECT ID		A00188329			
COUNTY		Angelina			
HIGHWAY		US0059			
ALT	BID CODE	DESCRIPTION	UNIT	EST.	FINAL
	351-6008	FLEXIBLE PAVEMENT STRUCTURE REPAIR(12")	SY	262.000	<del>262.000</del>
	354-6176	PLANE ASPH CONC PAV (1 1/2" TO 2 1/2")	SY	77,909.000	77,909.000 <sup>1</sup>
	500-6001	MOBILIZATION	LS	1.000	<del>1.000</del>
	502-6001	BARRICADES, SIGNS AND TRAFFIC HANDLING	MO	3.000	<del>3.000</del>
	662-6112	WK ZN PAV MRK SHT TERM RMV (W)(4")	LF	3,941.000	3,941.000
	662-6113	WK ZN PAV MRK SHT TERM RMV (Y)(4")	LF	9,604.000	9,604.000 <sup>1</sup>
	666-6299	RE PM W/RET REQ TY I (W)4"(BRK)(090MIL)	LF	15,168.000	15,168.000
	666-6302	RE PM W/RET REQ TY I (W)4"(SLD)(090MIL)	LF	32,505.000	32,505.000
	666-6311	RE PM W/RET REQ TY I (Y)4"(BRK)(090MIL)	LF	6,000.000	<del>6,000.000</del>
	666-6314	RE PM W/RET REQ TY I (Y)4"(SLD)(090MIL)	LF	26,505.000	26,505.000 <sup>1</sup>
	668-6076	PREFAB PAV MRK TY C (W) (24") (SLD)	LF	366.000	<del>366.000</del>
	668-6077	PREFAB PAV MRK TY C (W) (ARROW)	EA	5.000	5.000
	668-6085	PREFAB PAV MRK TY C (W) (WORD)	EA	5.000	<del>5.000</del>
	672-6007	REFL PAV MRKR TY I-C	EA	414.000	414.000
	672-6009	REFL PAV MRKR TY II-A-A	EA	786.000	786.000 <sup>1</sup>
	3077-6033	SP MIXESSP-CSAC-A PG76-22	TON	5,856.000	<del>5,856.000</del>
	3077-6075	TACK COAT	GAL	1,596.000	<del>1,596.000</del>
	3079-6011	PFC-C PG76-22 SAC-A	TON	2,036.000	2,036.000 <sup>1</sup>
	3079-6023	TACK COAT	GAL	740.000	740.000
	6185-6002	TMA (STATIONARY)	DAY	30.000	30.000
	6185-6005	TMA (MOBILE OPERATION)	DAY	36.000	36.000

<sup>1</sup> Addendum #1 7/22/2022

DISTRICT	COUNTY	CCSJ	SHEET
Lufkin	Angelina	6407-22-001	5



### SUMMARY OF MILL & INLAY ITEMS

6/14/2022 4:14:46 PM T:\LFK\DOM\Maint Contracts\0\_RMC - Routine Maintenance Contracts\FY22 Plans\6407-22-001 MILL & INLAY (NORTH)FY 2023\DGN\RMC 6407-22-001\_MNT\_QSUM\_DIST\_MI

LOCATION NUMBER	COUNTY	HIGHWAY NO.	LIMITS		ROADWAY DIMENSIONS				ITEM NO.	354 6176	3077 6033	3077 6075	3079 6011	3079 6023	① CONTRACTOR INFORMATION ONLY
			FROM	TO	LENGTH	ESTD MILL DEPTH	AVG. SURF WIDTH	PLANE ASP CONC PAV (1 1/2" TO 2 1/2")	② ③ INLAY					APPROXIMATE NO. OF TRAFFIC CONTROL SETUPS	
									② ③ MILL	④ INLAY					EA
					FT	MI	IN	FT	SY	TON	GAL	TON	GAL		
1	ANGELINA	US 69 (LOOP)	END OF CONC. @ KURTH DR. OVERPASS RM 416+0.075	1000' SOUTH OF CONC. RM 416+0.264	1,000	0.189	2	24	2,667	293	80			2	
1A	ANGELINA	US 69 (LOOP)	1000' SOUTH OF CONC. RM 416+0.264	1874' SOUTH RM 416+0.618	1,874	0.355	2	12	2,499	275	75			1	
1B	ANGELINA	US 69 (LOOP)	CHANGE OF PAVEMENT S OF FM 2251 RM 416+0.601	NORTH OF MARTIN LUTHER KING DR. RM 416+0.147	2,400	0.455	2	12	3,200	352	96			1	
1C	ANGELINA	US 69 (LOOP)	FRONT OF BROOKSHIRE WAREHOUSE RM 416+1.288	AT THE CHANGE OF PAVEMENT RM 416+1.477	1,000	0.189	2	12	1,333	147	40			1	
1D	ANGELINA	US 69 (LOOP)	FRONT OF BROOKSHIRE WAREHOUSE RM 416+1.139	AT THE CHANGE OF PAVEMENT RM 416+1.477	1,785	0.338	2	12	2,380	262	71			1	
1E	ANGELINA	US 69 (LOOP)	START AT SPENCE ST RM 416+1.686	325' N OF SPENCE ST RM 416+1.625	325	0.062	2	12	433	48	13			1	
1F	ANGELINA	US 69 (LOOP)	CHANGE OF PAVEMENT RM 416+0.336	1061' NORTH RM 416+0.537	1,061	0.201	2	12	1,415	156	42			1	
1G	ANGELINA	US 69 (LOOP)	FRONT OF EXPO CENTER @ C.O.P. RM 416+1.250	2326' NORTH RM 416+0.810	2,326	0.441	2	12	3,101	341	93			1	
2	ANGELINA	US 59	START AT RIVER BRIDGE RM 378+0.958	300' SOUTH RM 378+1.014											
2A	ANGELINA	US 59	LAST CROSSOVER BEFORE FM 2021 RM 382+0.467	1110' SOUTH RM 382+0.677	1,110	0.210	2	12	1,480			122	44	3	
2B	ANGELINA	US 59	LAST CROSSOVER BEFORE FM 2021 RM 382+0.467	300' SOUTH RM 382+0.523	300	0.056	2	12	400			33	12	1	
2C	ANGELINA	US 59	CONCRETE NORTH OF FM 2021 RM 382+0.468	1525 NORTH RM 382+0.810	1,525	0.289	2	12	2,033			168	61	1	
2D	ANGELINA	US 59	BOX 110 RM 380+1.768	BOX 6814 RM 380+1.665	541	0.103	2	12	721			59	22	1	
2E	ANGELINA	US 59	BOX 7786 RM 380+1.769	NORTH OF BOX 7930 RM 380+1.666	1,201	0.228	2	12	1,601			132	48	1	
2F	ANGELINA	US 59	LAST CROSSOVER BEFORE RIVER BRIDGE RM 378+0.890	ICE ON BRIDGE SIGN RM 378+1.085	1,033	0.195	2	12	1,377			114	41	1	
<b>ANGELINA COUNTY SUBTOTAL</b>									<b>24,640</b>	<b>1,874</b>	<b>510</b>	<b>628</b>	<b>228</b>	<b>17</b>	

- ① FOR CONTRACTOR'S INFORMATION ONLY.
- ② MATCH ADJACENT CURB CROSS SECTION.
- ③ THE ENGINEER WILL MARK THE EXACT AREAS TO BE PLANED. THE CONTRACTOR CAN ONLY MILL WHAT CAN BE REPLACED IN ONE DAY PRODUCTION.
- ④ TACK COAT IS TRACKLESS TACK.

① Addendum #1 7/22/2022

### QUANTITY SUMMARIES

© 2022  
 Texas Department of Transportation  
SHEET 1 OF 4

CONT	SECT	JOB	HIGHWAY
6407	22	001	US 59, ETC.
DIST	COUNTY		SHEET NO.
LFK	ANGELINA, ETC.		6


SUMMARY OF MILL & INLAY ITEMS (CONTINUED)

LOCATION NUMBER	COUNTY	HIGHWAY NO.	LIMITS		ROADWAY DIMENSIONS			ITEM NO.	354 6176	3077 6033	3077 6075	3079 6011	3079 6023	① ① CONTRACTOR INFORMATION ONLY
			FROM	TO	LENGTH	ESTD MILL DEPTH	AVG. SURF WIDTH	PLANE ASP CONC PAV (1 1/2" TO 2 1/2")	SUPERPAVE MIXTURE SP-C SAC-A PG76-22 (@ 220 LB/SY)	④ TACK COAT (0.03 GAL/SY)	PFC-C PG76-22 SAC-A (@ 165 LB/SY)	④ TACK COAT (0.03 GAL/SY)	APPROXIMATE NO. OF TRAFFIC CONTROL SETUPS	
			FT	MI	IN	FT	SY	TON	GAL	TON	GAL	EA		
2G	ANGELINA	US 59	END OF GUARDRAIL BEFORE RIVER BRIDGE RM 378+0.667	RIVER BRIDGE RM 378+0.707	212	0.040	2	11	267			22	8	1
2H	ANGELINA	US 59	3.1 MILES S OF MOFFETT OVERPASS RM 388+1.040	800' SOUTH @ BRIDGE SECK RM 388+1.191	800	0.151	2	13	1,156			95	35	1
2I	ANGELINA	US 59	3.3 MILES S OF MOFFETT OVERPASS RM 390+0.172	800' SOUTH @ BRIDGE DECK RM 390+0.323	800	0.152	2	24	2,133			176	64	1
2J	ANGELINA	US 59	1.2 MILES N OF END OF CONC. RM 386+0.283	500' NORTH RM 386+0.189	500	0.095	2	24	1,333			110	40	1
2K	ANGELINA	US 59	1.9 MILES S OF FM 819 RM 394+0.405	2.5 MILES S OF FM 819 RM 394+0.556	800	0.151	2	12	1,067			88	32	1
2L	ANGELINA	US 59	INTERSECTION OF SL 210 RM 400+0.115	400' SOUTH RM 400+0.190	400	0.075	2	12	533	59	16			1
<b>ANGELINA COUNTY SUBTOTAL</b>								<b>6,489</b>	<b>59</b>	<b>16</b>	<b>491</b>	<b>179</b>	<b>6</b>	
<b>ANGELINA COUNTY TOTAL</b>								<b>31,129</b>	<b>1,933</b>	<b>526</b>	<b>1,119</b>	<b>407</b>	<b>23</b>	
*3	NACOGDOCHES	BU 59	PARKER ST RM 338+1.084	BOWIE ST RM 338+1.671	3,100	0.587	2	60	20,667	2,273	620			3
<b>NACOGDOCHES COUNTY TOTALS</b>								<b>20,667</b>	<b>2,273</b>	<b>620</b>			<b>3</b>	
*4	SHELBY	SH 87	US 59 RM 318+0.051	50' W OF RAILROAD AVE. RM 318+0.021	381	0.072	2	30	1,270	140	38			2
*5	SHELBY	SH 87	50' E OF RAILROAD AVE. RM 318+0.440	PINE ST. RM 318+0.646	1,087	0.206	2	30	5,556	611	167			2
*6	SHELBY	US 59	JUNCTION US 84 RM 328+1.806	RM 330 RM 330+0.000	1,022	0.194	2	52	8,176	899	245			4
*7	SHELBY	US 59	TENAHA RAMPS US 59 RM 328+1.446	TENAHA RAMPS US 96 RM 328+1.636	1,000	0.190	2	100	11,111			917	333	6
<b>SHELBY COUNTY TOTAL</b>								<b>26,113</b>	<b>1,650</b>	<b>450</b>	<b>917</b>	<b>333</b>	<b>14</b>	
<b>PROJECT TOTALS FOR ALL COUNTY</b>								<b>77,909</b>	<b>5,856</b>	<b>1,596</b>	<b>2,036</b>	<b>740</b>	<b>40</b>	

\* LOCATIONS TO BE COMPLETED AT NIGHT.

- ① FOR CONTRACTOR'S INFORMATION ONLY.
- ② MATCH ADJACENT CURB CROSS SECTION.
- ③ THE ENGINEER WILL MARK THE EXACT AREAS TO BE PLANED. THE CONTRACTOR CAN ONLY MILL WHAT CAN BE REPLACED IN ONE DAY PRODUCTION.
- ④ TACK COAT IS TRACKLESS TACK.

QUANTITY SUMMARIES

© 2022  
  
 Texas Department of Transportation  
 SHEET 2 OF 4

CONT	SEC	JOB	HIGHWAY
6407	22	001	US 59, ETC.
DIST	COUNTY		SHEET NO.
LFK	ANGELINA, ETC.		7

① Addendum #1 7/22/2022

6/14/2022 4:14:46 PM T:\LFDOM\Maint Contracts\O\_RMC - Route Maintenance Contracts\FY22 Plans\6407-22-001 MILL & INLAY (NORTH)FY 2023\DGN\RMC 6407-22-001\_MNT\_QSUM\_D IST\_M i

6/14/2022 4:14:47 PM T:\LFKDDM\Maint Contracts\0\_RMC - Routine Maintenance Contracts\FY22 Plans\6407-22-001 MILL & INLAY (NORTH)FY 2023\DGN\RMC 6407-22-001\_MNT\_QSUM\_D IST\_M I

### SUMMARY OF PAVEMENT MARKINGS AND MARKERS

LOCATION NUMBER	COUNTY	HIGHWAY NO.	ITEM NO.	662 6112	662 6113	666 6299	666 6302	666 6311	666 6314	668 6076	668 6077	668 6085	672 6007	672 6009
			WK ZN PAV MRK SHT TERM RMV (W) (4")	WK ZN PAV MRK SHT TERM RMV (Y) (4")	RE PM W/RET REQ TY I (090MIL)				PREFAB PAV MRK TY C (W) (24") (SLD)	PREFAB PAV MRK TY C (W) (ARROW)	PREFAB PAV MRK TY C (W) (WORD)	REFL PAV MRKR TY I-C	REFL PAV MRKR TY II-A-A	
					W (4") BRK	W (4") SLD	Y (4") BRK	Y (4") SLD						
			LF	LF	LF	LF	LF	LF	LF	LF	EA	EA	EA	EA
1	ANGELINA	US 69 (LOOP)	225	450	667	1,000			1,000				14	26
1A	ANGELINA	US 69 (LOOP)	211	422	625	1,874			1,874				24	48
1B	ANGELINA	US 69 (LOOP)	270	540	800	2,400			2,400				31	61
1C	ANGELINA	US 69 (LOOP)	113	225	333	1,000			1,000				14	26
1D	ANGELINA	US 69 (LOOP)	201	402	595	1,785			1,785				23	46
1E	ANGELINA	US 69 (LOOP)	37	73	108	325			325				5	9
1F	ANGELINA	US 69 (LOOP)	119	239	354	1,061			1,061				14	28
1G	ANGELINA	US 69 (LOOP)	262	523	775	2,326			2,326				30	59
2	ANGELINA	US 59												
2A	ANGELINA	US 59	125	250	370	1,110			1,110				15	29
2B	ANGELINA	US 59	34	68	100	300			300				5	9
2C	ANGELINA	US 59	172	343	508	1,525			1,525				20	39
2D	ANGELINA	US 59	61	122	180	541			541				8	15
2E	ANGELINA	US 59	135	270	400	1,201			1,201				16	31
2F	ANGELINA	US 59	116	232	344	1,033			1,033				14	27
<b>ANGELINA COUNTY SUBTOTAL</b>			<b>2,081</b>	<b>4,159</b>	<b>6,159</b>	<b>17,481</b>			<b>17,481</b>	<b>0</b>	<b>0</b>	<b>0</b>	<b>233</b>	<b>453</b>

### \*\* FLEXIBLE PAVEMENT STRUCTURE REPAIR SUMMARY

LOCATION NUMBER	COUNTY	HIGHWAY	LIMITS		ITEM NO.	351 6008
			FROM	TO	FLEXIBLE PAVEMENT STRUCTURE REPAIR (12")	SY
			2H	ANGELINA		
2J	ANGELINA	US 59	1.2 MILES N OF END OF CONC. RM 386+0.283	500' NORTH RM 386+0.189	67	
2K	ANGELINA	US 59	1.9 MILES S OF FM 819 RM 394-0.405	2.5 MILES S OF FM 819 RM 394+0.556	142	
<b>PROJECT TOTALS FOR ANGELINA COUNTY</b>						<b>262</b>

\*\* USE AS DIRECTED

### QUANTITY SUMMARIES

© 2022  
Texas Department of Transportation  
SHEET 3 OF 4

CONT	SECT	JOB	HIGHWAY
6407	22	001	US 59, ETC.
DIST	COUNTY		SHEET NO.
LFK	ANGELINA, ETC.		8

1 Addendum #1 7/22/2022

6/14/2022 4:14:47 PM T:\LFK\DOM\Maint Contracts\0\_RMC - Routine Maintenance Contracts\FY22 Plans\6407-22-001 MILL & INLAY (NORTH)FY 2023\DN\RMC 6407-22-001\_MNT\_QSUM\_DIST\_M i

SUMMARY OF PAVEMENT MARKINGS AND MARKERS (CONTINUED)														
LOCATION NUMBER	COUNTY	HIGHWAY NO.	ITEM NO.	662 6112	662 6113	666 6299	666 6302	666 6311	666 6314	668 6076	668 6077	668 6085	672 6007	672 6009
			WK ZN PAV MRK SHT TERM RMV (W) (4")	WK ZN PAV MRK SHT TERM RMV (Y) (4")	RE PM W/RET REQ TY I (090MIL)				PREFAB PAV MRK TY C (W) (24") (SLD)	PREFAB PAV MRK TY C (W) (ARROW)	PREFAB PAV MRK TY C (W) (WORD)	REFL PAV MRKR TY I-C	REFL PAV MRKR TY II-A-A	
					W (4") BRK	W (4") SLD	Y (4") BRK	Y (4") SLD						
			LF	LF	LF	LF	LF	LF	LF	LF	EA	EA	EA	EA
2G	ANGELINA	US 59 NB	24	48	71	212			212				4	6
2H	ANGELINA	US 59 SB	90	180	267	800			800				11	21
2I	ANGELINA	US 59 SB	180	360	267	800			800				11	21
2J	ANGELINA	US 59 NB	113	225	167	500			500				7	14
2K	ANGELINA	US 59 SB	90	180	267	800			800				11	21
2L	ANGELINA	US 59 SB	45	90	133	400			400				6	11
ANGELINA COUNTY SUBTOTAL			542	1,083	1,172	3,512			3,512				50	94
1 ANGELINA COUNTY TOTAL			2,623	5,242	7,331	20,993			20,993				283	547
3	NACOGDOCHES	BU 59	698	2,792	6,000	6,000	6,000			366	5	5	55	95
NACOGDOCHES COUNTY SUBTOTAL			698	2,792	6,000	6,000	6,000			366	5	5	55	95
4	SHELBY	SH 87	43	171	127	381			381				6	11
5	SHELBY	SH 87	122	489	362	1,087			1,087				15	28
6	SHELBY	US 59	230	460	681	2,044			2,044				28	53
7	SHELBY	US 59	225	450	667	2,000			2,000				27	52
SHELBY COUNTY SUBTOTAL			620	1,570	1,837	5,512			5,512				76	144
1 PROJECT TOTALS FOR ALL COUNTY			3,941	9,604	15,168	32,505	6,000		26,505	366	5	5	414	786

SUMMARY OF TRUCK MOUNTED ATTENUATORS (TMAs)		
COUNTY	ITEM 6185	
	TMA (STATIONARY)	TMA (MOBILE)
(USE AS DIRECTED)	30	36
PROJECT TOTALS FOR ALL COUNTY	30	36

QUANTITY SUMMARIES

© 2022 Texas Department of Transportation  
SHEET 4 OF 4

CONT	SECT	JOB	HIGHWAY
6407	22	001	US 59, ETC.
DIST		COUNTY	SHEET NO.
LFK		ANGELINA, ETC.	9

1 Addendum #1 7/22/2022